

Brampton Encore - 48R - 2 - 28-7 Elev.B Wagner

CENTRAL VAC AND WIRING

Inv.1,680	1 - CONDUIT PIPE- FOR TELEVISION- MUST SPECIFY LOCATION AND TERMINATION POINT
Line25170	Note:
8Dec17 / 8Dec17	

CONCRETE AND DRAIN

Inv.1,680	1 - ROUGH-IN - 3PC BASEMENT ROUGH-IN
Line25179	Note:
8Dec17 / 8Dec17	

Inv.1,680	1 - COLD CELLAR
Line25180	Note:
8Dec17 / 8Dec17	

ELECTRICAL

Inv.1,680	1 - FAMILY ROOM: 110V WALL RECEPTACLE ON DEDICATED CIRCUIT-MUST SPECIFY LOCATION
Line25171	Note:
8Dec17 / 8Dec17	

Inv.1,680	1 - KITCHEN: ADDITIONAL STANDARD FIXTURE ON SAME SWITCH: ABOVE ISLAND FOR FUTURE PENDANT LIGHT
Line25172	Note:
8Dec17 / 8Dec17	

Inv.1,680	1 - KITCHEN: ADDITIONAL STANDARD FIXTURE WITH SWITCH - ABOVE ISLAND FOR FUTURE PENDANT LIGHT
Line25173	Note:
8Dec17 / 8Dec17	

Inv.1,680	1 - FORMAL ROOM: ADDITIONAL STANDARD FIXTURE WITH SWITCH - MUST SPECIFY LOCATION
Line25174	Note:
8Dec17 / 8Dec17	

Inv.1,680	1 - KITCHEN: 110V WALL RECEPTACLE ON DEDICATED CIRCUIT - GAS FIRED APPLIANCE
Line25175	Note:
8Dec17 / 8Dec17	

Exterior Colours

Inv.1,680	1 - EXTERIOR COLOUR PACKAGE: #9
Line25182	Note:
8Dec17 / 8Dec17	

FORMING

Inv.1,680	1 - COLD CELLAR
Line25178	Note:
8Dec17 / 8Dec17	

FRAMING

Inv.1,680	1 - OPTIONAL COFFERED CEILING - FORMAL ROOM (PER ROOM AS PER PLAN)
Line25176	Note:
8Dec17 / 8Dec17	

HVAC

Brampton Encore - 48R - 2 - 28-7 Elev.B Wagner

Inv.1,680	1 - KITCHEN: 110V WALL RECEPTACLE ON DEDICATED CIRCUIT - GAS FIRED APPLIANCE
Line25177	Note:
8Dec17 / 8Dec17	


WINDOWS - BASEMENT

Inv.1,680	4 - BASEMENT WINDOWS - UPGRADE EXISTING BASEMENT WINDOW TO 30 INCH X 16 INCH
Line25181	Note:
8Dec17 / 8Dec17	

BE2-481

The Wagner SEMI SERIES


→ Elevation A • 2,127 sq.ft.
Elevation B • 2,117 sq.ft.
Elevation C • 2,127 sq.ft.
Elevation D • 2,127 sq.ft.

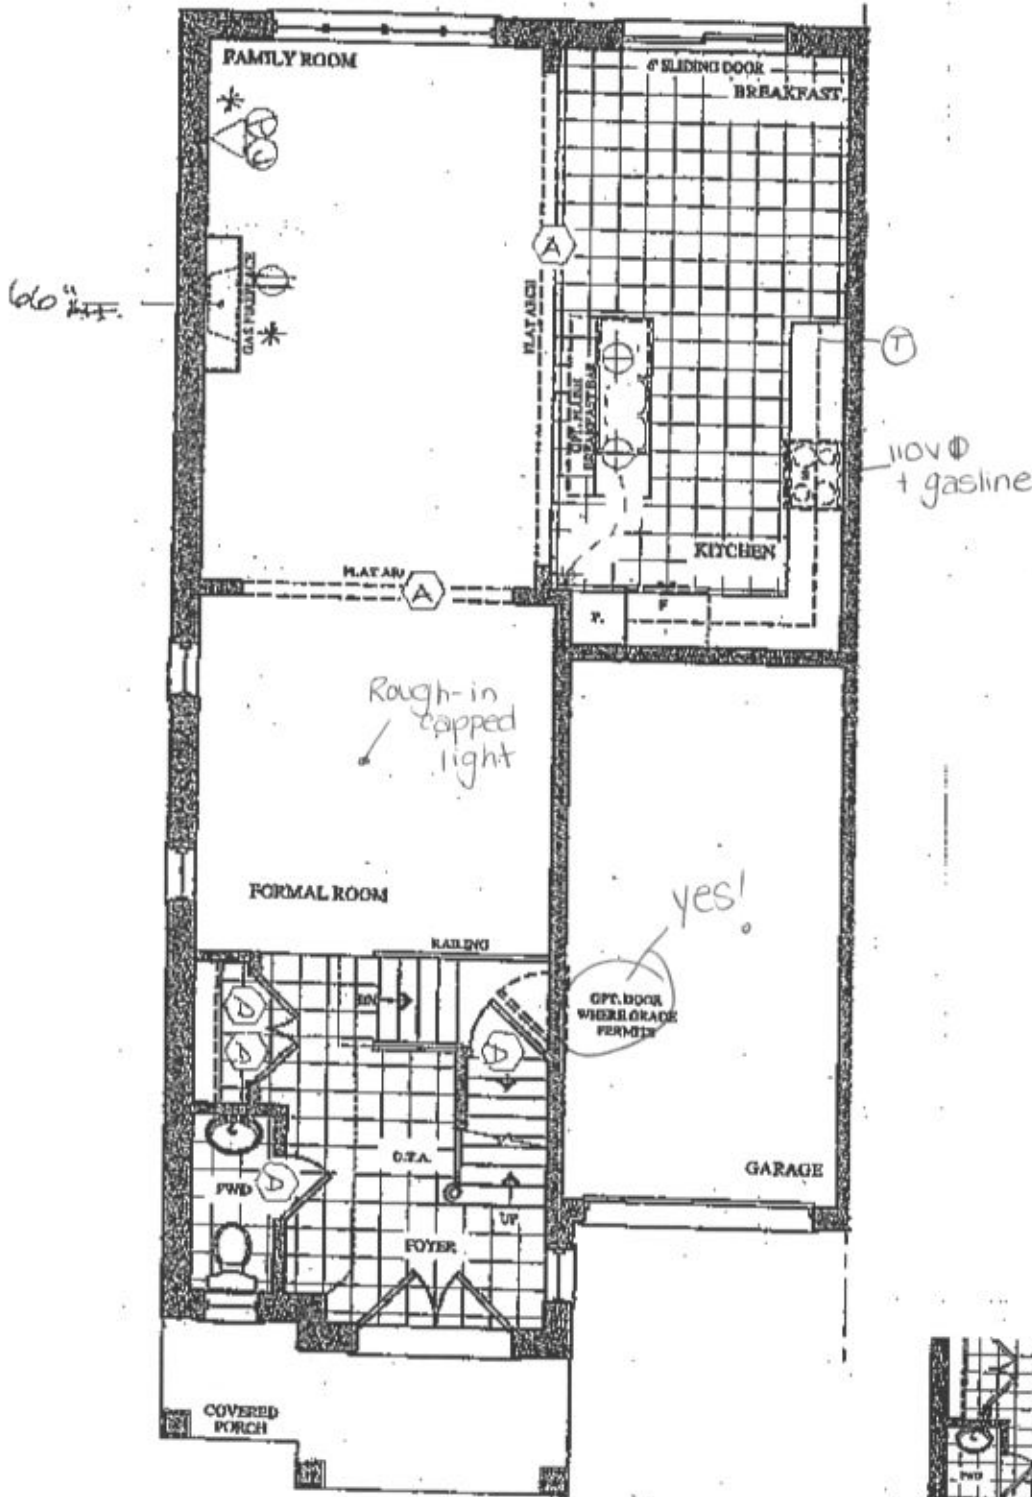

GROUND FLOOR PLAN
ELEV. 'A' & 'B'

LEGEND

- ⊙ ELECT. CLOSET
- * CONDUIT
- ⊙ CAPPED CEILING
R/I/N
- \$ SINGLE POLE
SWITCH
- A 96" DOOR
- D 96" DOOR
- ⊙ PHONE
- ⊙ CABLE

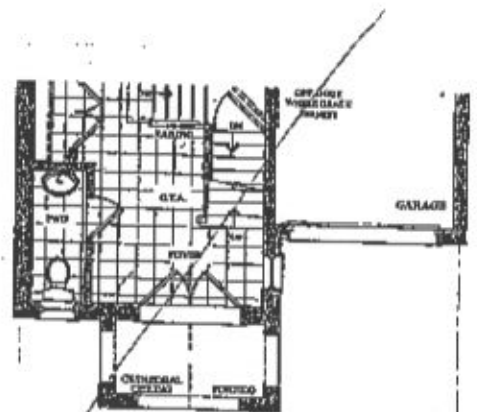


PART. GROUND-FLOOR PLAN
ELEV. 'C' & 'D'


BE2-482

The Wagner SEMI SERIES


→ Elevation A • 2,127 sq.ft.
Elevation B • 2,117 sq.ft.
Elevation C • 2,127 sq.ft.
Elevation D • 2,127 sq.ft.

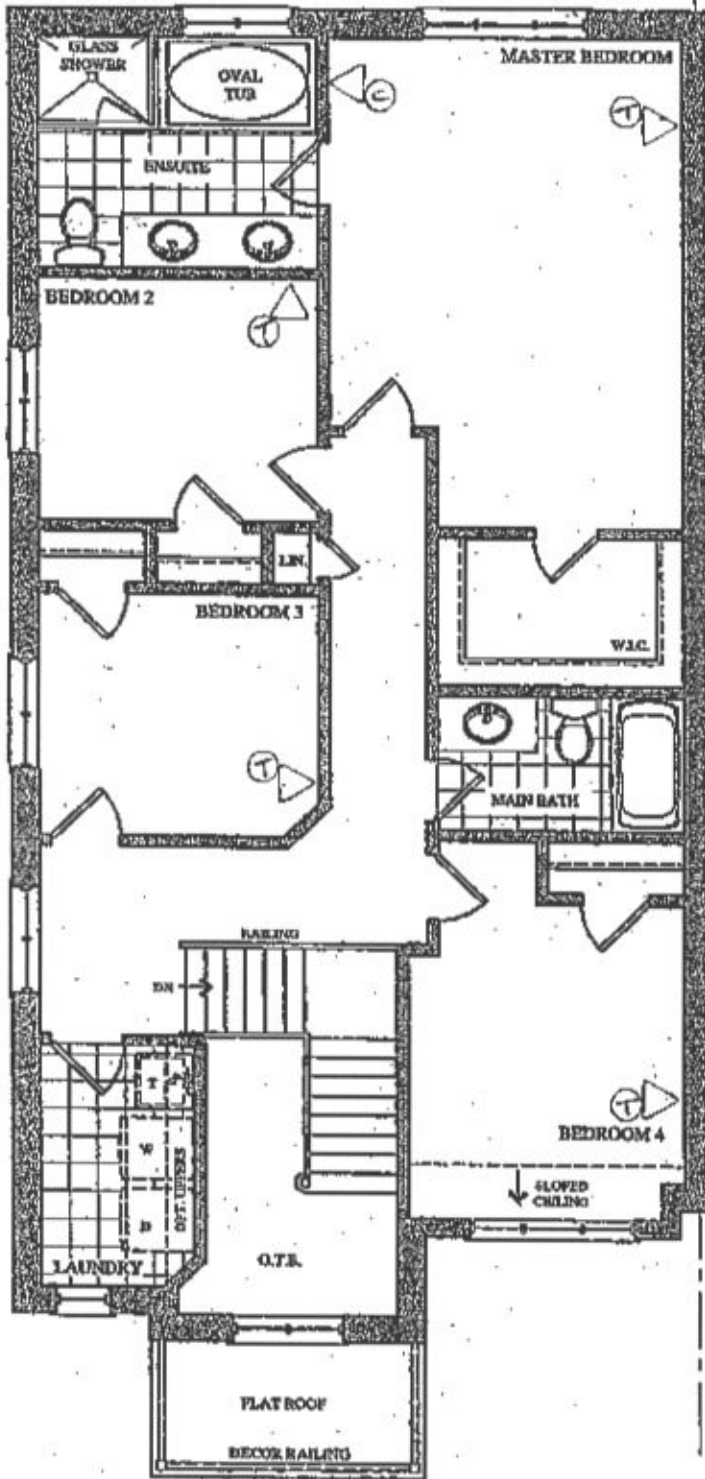


SECOND FLOOR PLAN
ELEV. 'A'

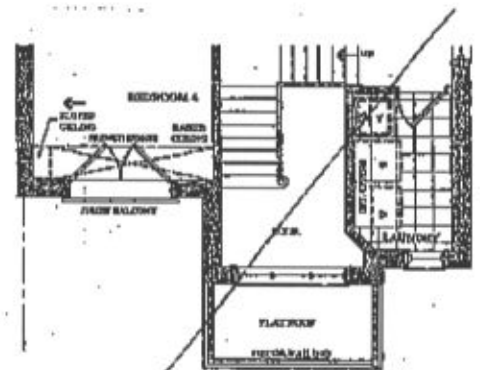

PART. SECOND FLOOR PLAN
ELEV. 'B'

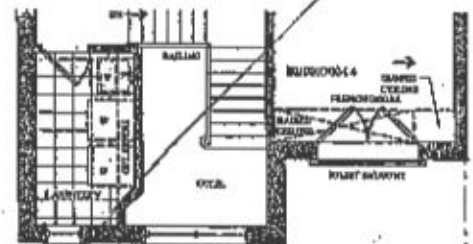

PART. SECOND FLOOR PLAN
ELEV. 'C'

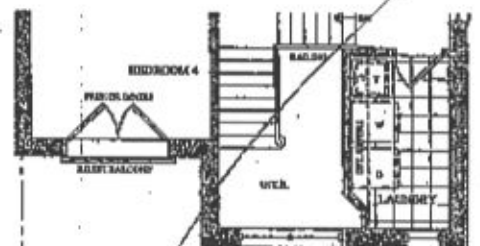


PART. SECOND FLOOR PLAN
ELEV. 'D'


BE2-481

The Wagner SEMI SERIES

→ Elevation A • 2,127 sq.ft.
Elevation B • 2,117 sq.ft.
Elevation C • 2,127 sq.ft.
Elevation D • 2,127 sq.ft.

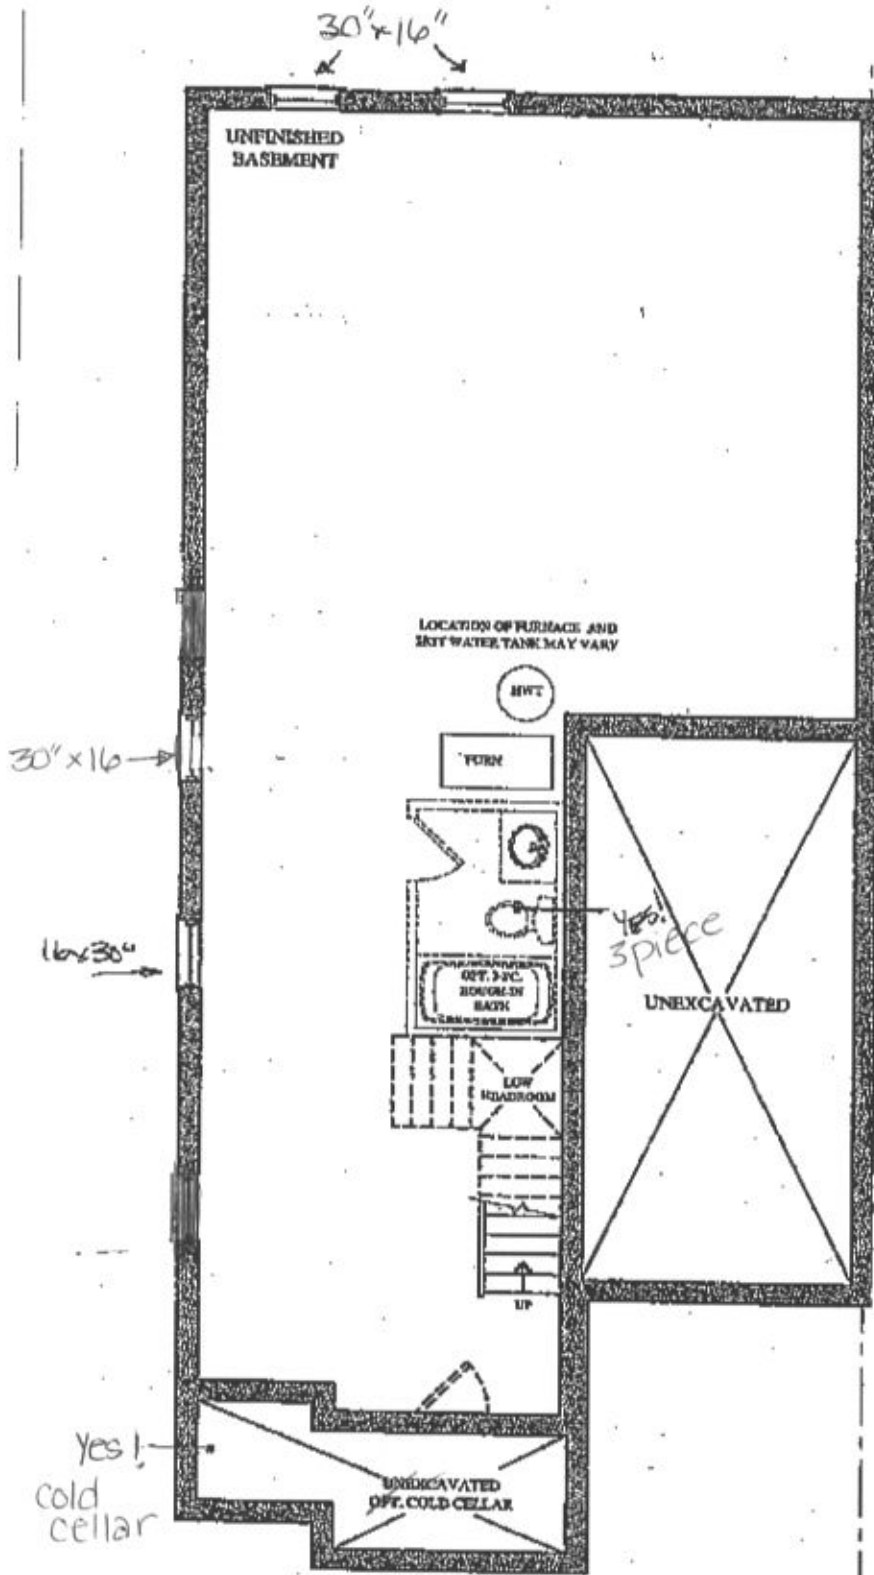

BASEMENT FLOOR PLAN
ELEV. A & B

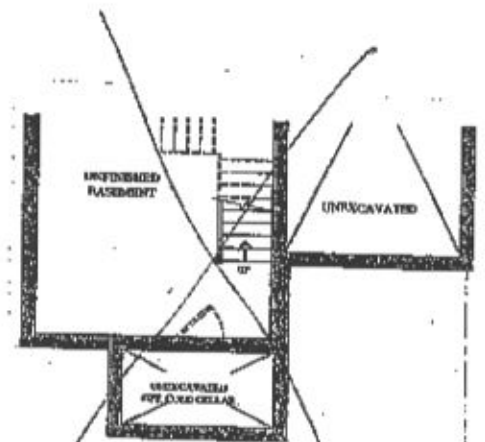

PART. BASEMENT FLOOR PLAN
ELEV. C & D