

Brampton Encore - 48L - 2 - 28-7 Elev.A Wagner

CENTRAL VAC AND WIRING

Inv.1,678	1 - FAMILY ROOM: CONDUIT PIPE- FOR TELEVISION- MUST SPECIFY LOCATION AND TERMINATION POINT
Line25153	Note:
8Dec17 / 8Dec17	

CONCRETE AND DRAIN

Inv.1,678	1 - ROUGH-IN - 3PC BASEMENT ROUGH-IN
Line25162	Note:
8Dec17 / 8Dec17	

Inv.1,678	1 - COLD CELLAR
Line25167	Note:
8Dec17 / 8Dec17	

ELECTRICAL

Inv.1,678	1 - FAMILY ROOM: ABOVE FIREPLACE- 110V WALL RECEPTACLE ON DEDICATED CIRCUIT-MUST SPECIFY LOCATION
Line25154	Note:
8Dec17 / 8Dec17	

Inv.1,678	1 - KITCHEN: ADDITIONAL STANDARD FIXTURE WITH SWITCH - OVER ISLAND FOR FUTURE PENDANT LIGHT
Line25156	Note:
8Dec17 / 8Dec17	

Inv.1,678	1 - KITCHEN: ADDITIONAL STANDARD FIXTURE SAME SWITCH - OVER ISLAND FOR FUTURE PENDANT LIGHT
Line25157	Note:
8Dec17 / 8Dec17	

Inv.1,678	1 - FORMAL ROOM: ADDITIONAL STANDARD FIXTURE ON SEPERATE SWITCH
Line25158	Note:
8Dec17 / 8Dec17	

Inv.1,679	1 - 110V WALL RECEPTACLE ON DEDICATED CIRCUIT - FOR MICROWAVE - MICROWAVE NOT INCLUDED
Line25169	Note:
8Dec17 / 8Dec17	

Exterior Colours

Inv.1,678	1 - EXTERIOR COLOUR PACKAGE # 9
Line25168	Note:
8Dec17 / 8Dec17	

FORMING

Inv.1,678	1 - COLD CELLAR
Line25163	Note:
8Dec17 / 8Dec17	

FRAMING

Inv.1,678	4 - FRAME MAIN FLOOR DOORS AT 96" - ADDED WITH THE ADDITION OF TALLER INTERIOR DOORS
Line25155	Note:
8Dec17 / 8Dec17	

Brampton Encore - 48L - 2 - 28-7 Elev.A Wagner

Inv.1,678	1 - FRAME MAIN FLOOR DOORS AT 96" - ADDED WITH THE ADDITION OF TALLER INTERIOR DOORS
Line25160	Note:
8Dec17 / 8Dec17	

Inv.1,678	2 - FRAME MAIN FLOOR ARCHES AT 96"
Line25165	Note:
8Dec17 / 8Dec17	

HVAC

Inv.1,678	1 - GAS LINE ROUGH - 2ND FLOOR- (2-STOREY MODELS) PLUS 110V PLUG
Line25159	Note:
8Dec17 / 8Dec17	

INTERIOR TRIM AND DOORS

Inv.1,678	4 - FRAME MAIN FLOOR DOORS AT 96" - ADDED WITH THE ADDITION OF TALLER INTERIOR DOORS
Line25164	Note:
8Dec17 / 8Dec17	

Inv.1,678	1 - FRAME MAIN FLOOR ARCHES AT 96"
Line25166	Note:
8Dec17 / 8Dec17	


WINDOWS AND DOORS

Inv.1,678	1 - MAN DOOR GARAGE TO HOUSE - OPTIONAL - IF GRADE PERMITS
Line25161	Note:
8Dec17 / 8Dec17	

Telephone — (T)
 Cable — (C)
 Electrical — (E)

The Wagner SEMI SERIES

Elevation A • 2,127 sq.ft.
 Elevation B • 2,117 sq.ft.
 Elevation C • 2,127 sq.ft.
 Elevation D • 2,127 sq.ft.

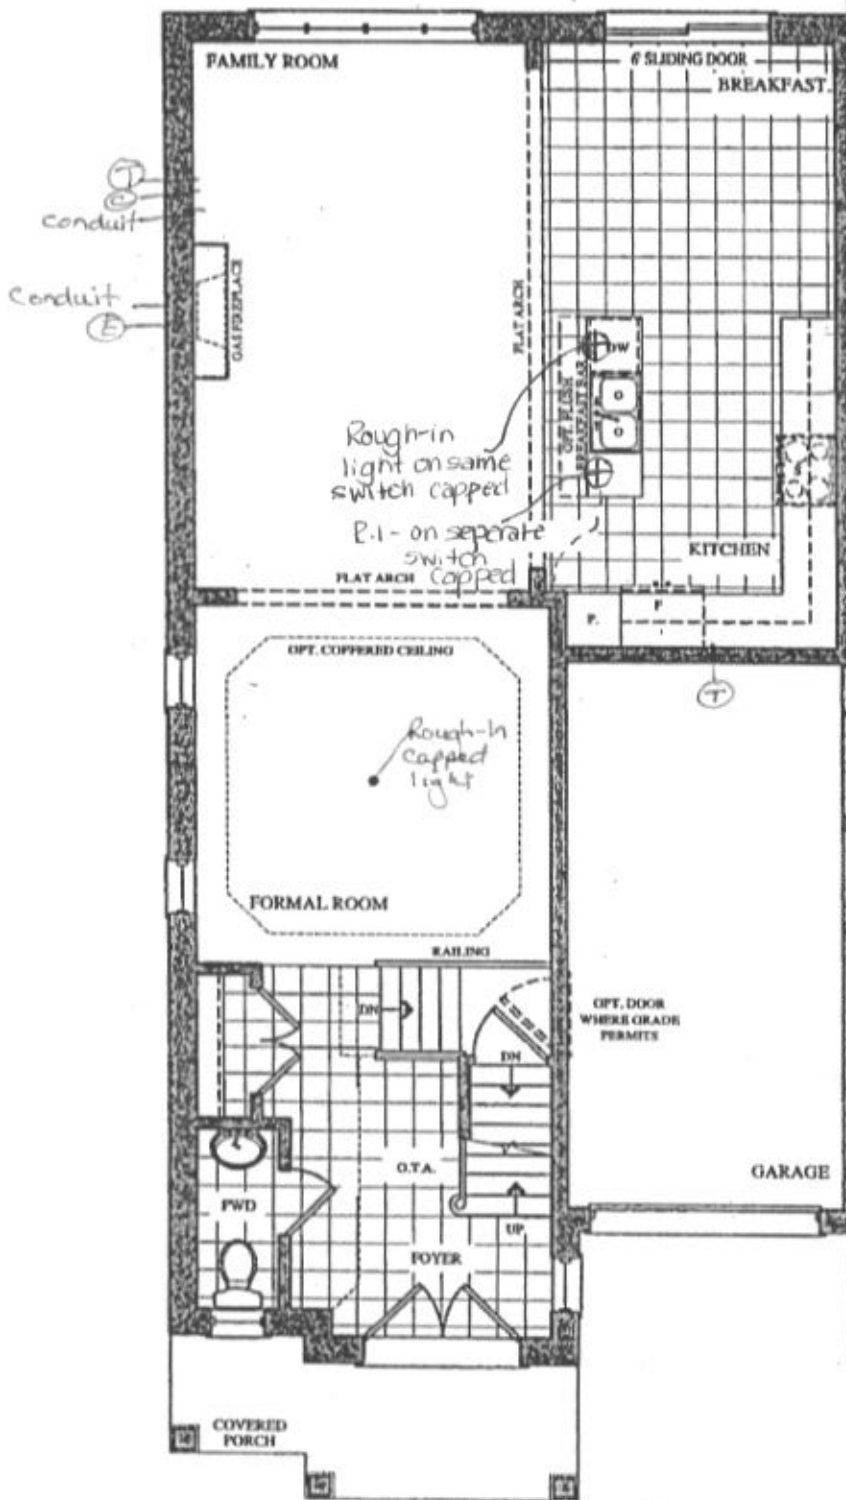

GROUND FLOOR PLAN
ELEV. 'A' & 'B'

Lot 45R




PART. GROUND FLOOR PLAN
ELEV. 'C' & 'D'

Telephone — (T)
Cable — (C)


The Wagner SEMI SERIES

Elevation A • 2,127 sq.ft.
Elevation B • 2,117 sq.ft.
Elevation C • 2,127 sq.ft.
Elevation D • 2,127 sq.ft.

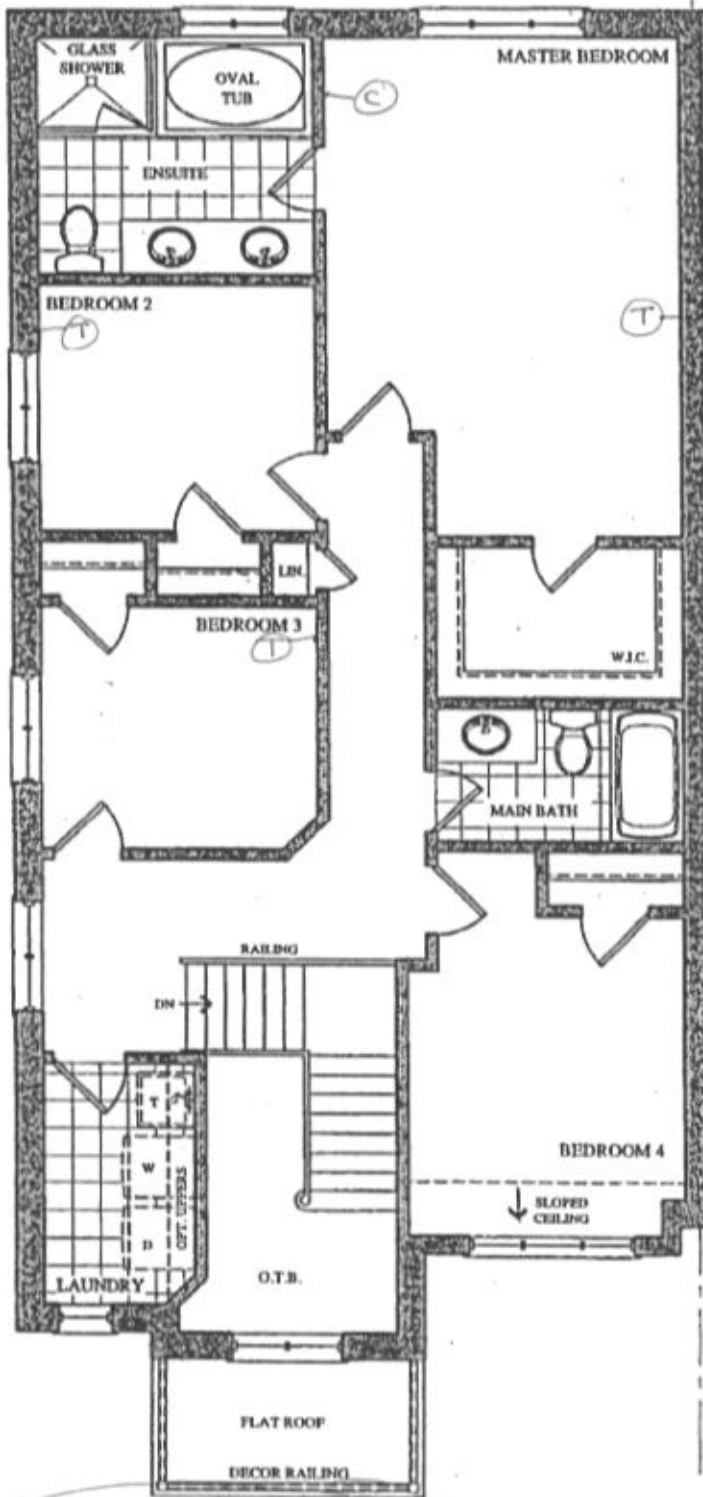


SECOND FLOOR PLAN
ELEV. 'A'


Lot 48R

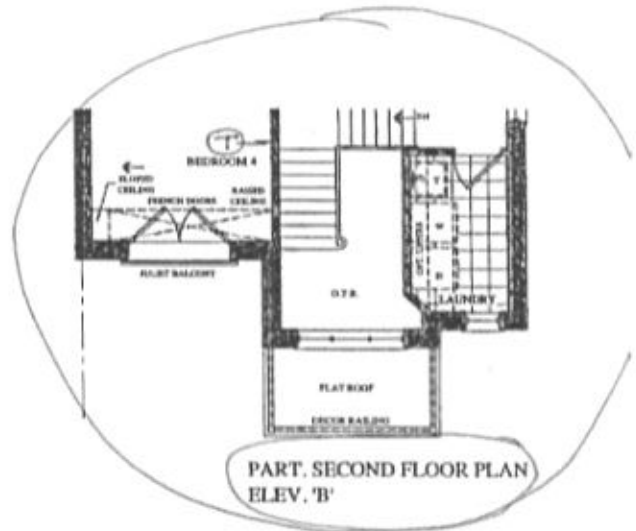

PART. SECOND FLOOR PLAN
ELEV. 'B'

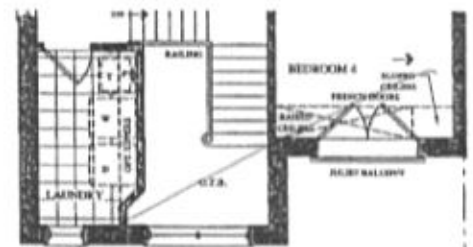

PART. SECOND FLOOR PLAN
ELEV. 'C'

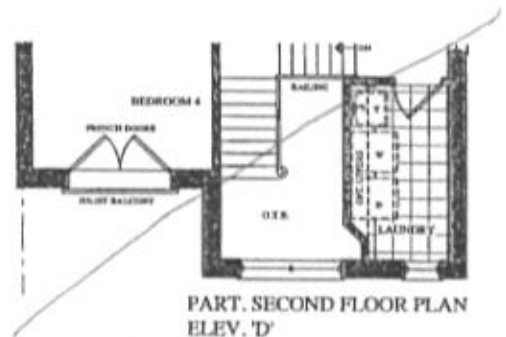


PART. SECOND FLOOR PLAN
ELEV. 'D'


BSMNT WINDOWS
4 x 30" x 16"

The Wagner SEMI SERIES

Elevation A • 2,127 sq.ft.
- Elevation B • 2,117 sq.ft.
Elevation C • 2,127 sq.ft.
Elevation D • 2,127 sq.ft.

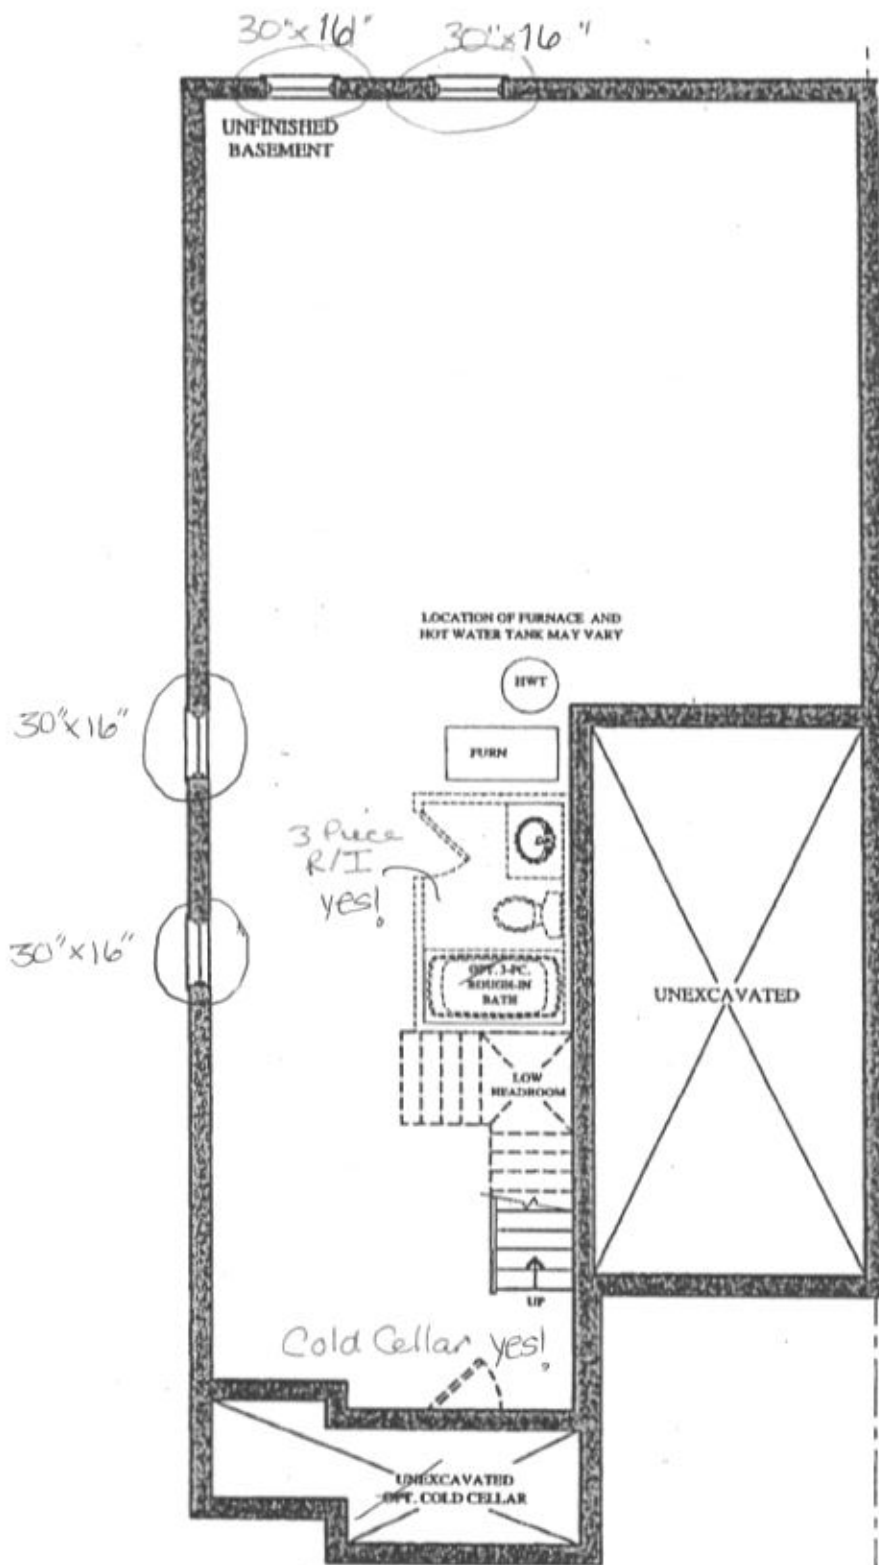

BASEMENT FLOOR PLAN
ELEV. 'A' & 'B'

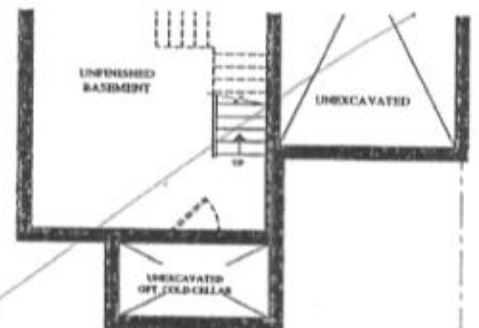

PART. BASEMENT FLOOR PLAN
ELEV. 'C' & 'D'

Lot 48R