

Brampton Encore - 32R - 2 - 28-2 Elev.CR Siren

CONCRETE AND DRAIN

Inv.1,677	1 - ROUGH-IN - 3PC BASEMENT ROUGH-IN
Line25147	Note:
8Dec17 / 8Dec17	
Inv.1,677	1 - COLD CELLAR
Line25148	Note:
8Dec17 / 8Dec17	

DRYWALL

Inv.1,677	1 - SMOOTH CEILINGS - (2-Story Design) 2ND FLOOR
Line25149	Note:
8Dec17 / 8Dec17	

Exterior Colours

Inv.1,677	1 - EXTERIOR COLOUR PACKAGE # 5
Line25152	Note:
8Dec17 / 8Dec17	

FORMING

Inv.1,677	1 - SIDE DOOR- HOME TO EXTERIOR- AS PER PLAN AND GRADE PERMITTING
Line25142	Note:
8Dec17 / 8Dec17	
Inv.1,677	1 - COLD CELLAR
Line25146	Note:
8Dec17 / 8Dec17	

FRAMING

Inv.1,677	1 - OPTIONAL COFFERED CEILING - DINING ROOM (PER ROOM AS PER PLAN)
Line25143	Note:
8Dec17 / 8Dec17	
Inv.1,677	1 - UPGRADE VENTING FOR STOVE TO 8" PIPE EXTERIOR WALL
Line25151	Note:
8Dec17 / 8Dec17	

HVAC

Inv.1,677	1 - UPGRADE VENTING FOR STOVE TO 8" PIPE EXTERIOR WALL
Line25150	Note:
8Dec17 / 8Dec17	

WINDOWS - BASEMENT

Inv.1,677	3 - BASEMENT WINDOWS - UPGRADE EXISTING BASEMENT WINDOW TO 30 INCH X 16 INCH
Line25145	Note:
8Dec17 / 8Dec17	

WINDOWS AND DOORS


Inv.1,677	1 - SIDE DOOR- HOME TO EXTERIOR- AS PER PLAN AND GRADE PERMITTING
Line25144	Note:
8Dec17 / 8Dec17	

Telephone — (T)
 Cable — (C)


The Siren

SEMI SERIES

Elevation A • 1,688 sq.ft.
 Elevation B • 1,677 sq.ft.
 Elevation C • 1,687 sq.ft.

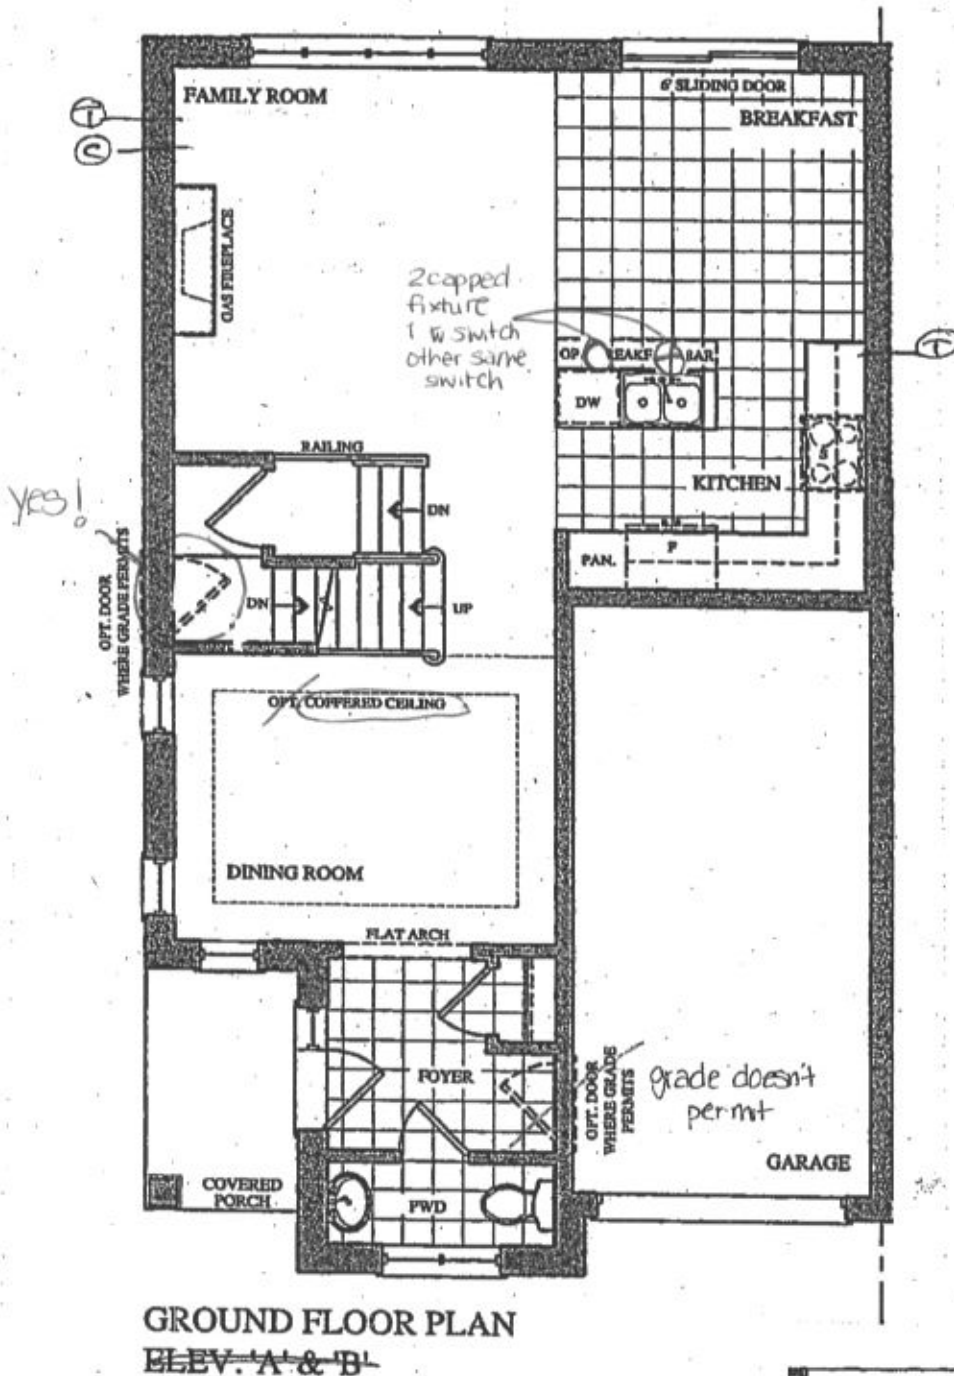

Lot 32R

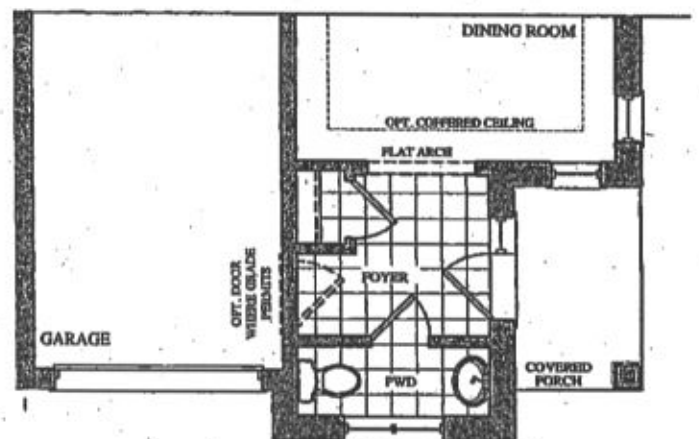


Telephone — (T)
 Cable — (C)

The Siren


SEMI SERIES

Elevation A • 1,688 sq.ft.
 Elevation B • 1,677 sq.ft.
 Elevation C • 1,687 sq.ft.

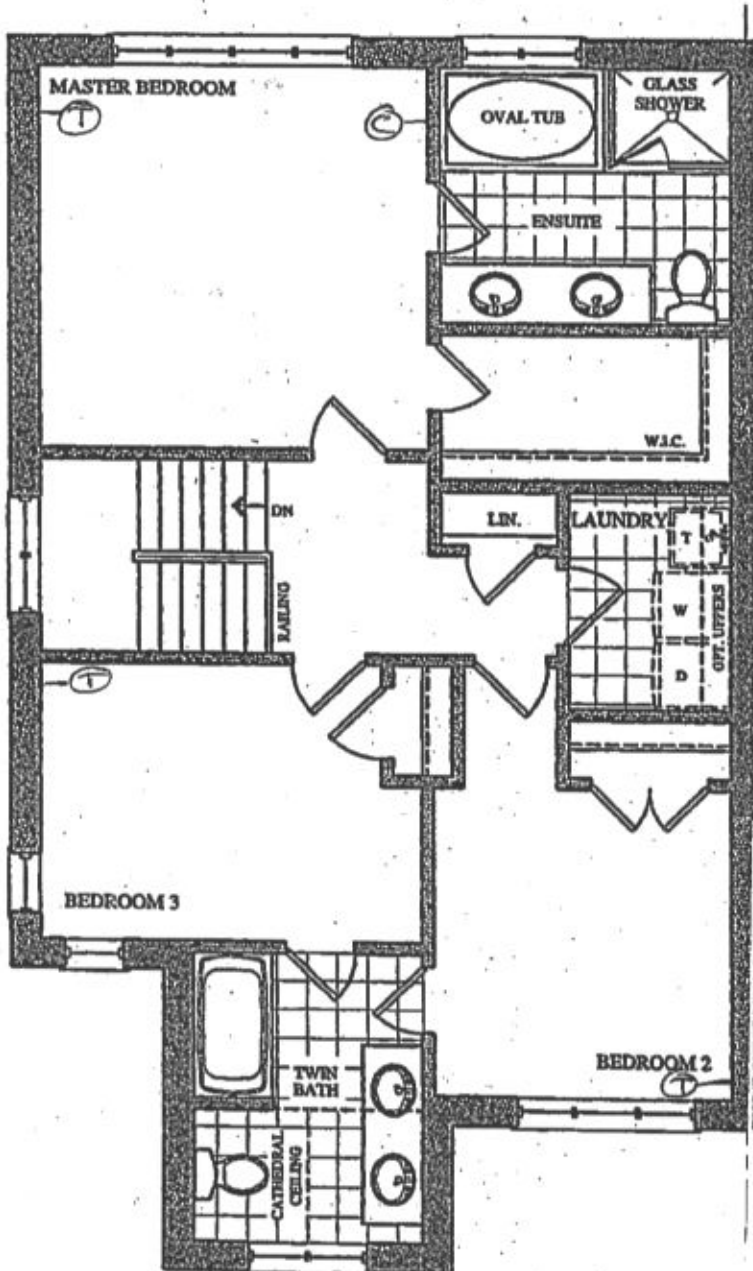


SECOND-FLOOR PLAN
 ELEV. 'A'

Lot 32R

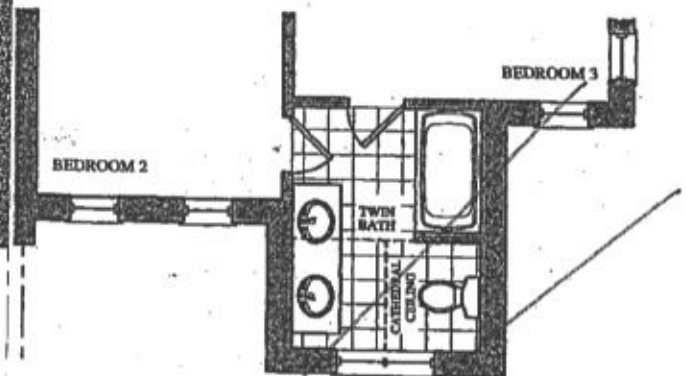

PART. SECOND FLOOR PLAN
 ELEV. 'B'

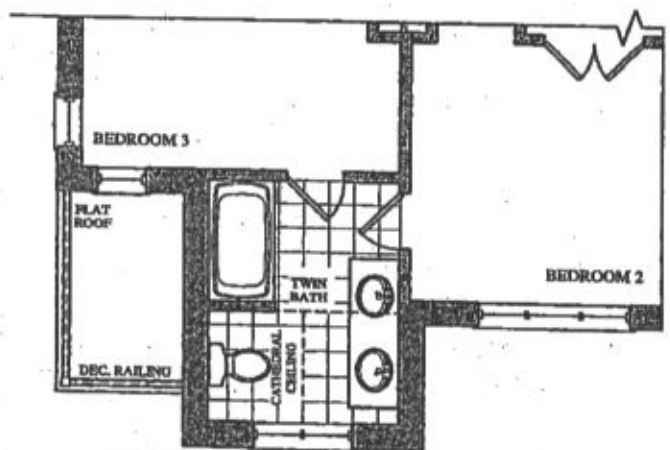


PART. SECOND FLOOR PLAN
 ELEV. 'C'

BSMNT WINDOWS
3 x 30"x16"

The Siren

SEMI SERIES

Elevation A • 1,688 sq.ft.
Elevation B • 1,677 sq.ft.
Elevation C • 1,687 sq.ft.

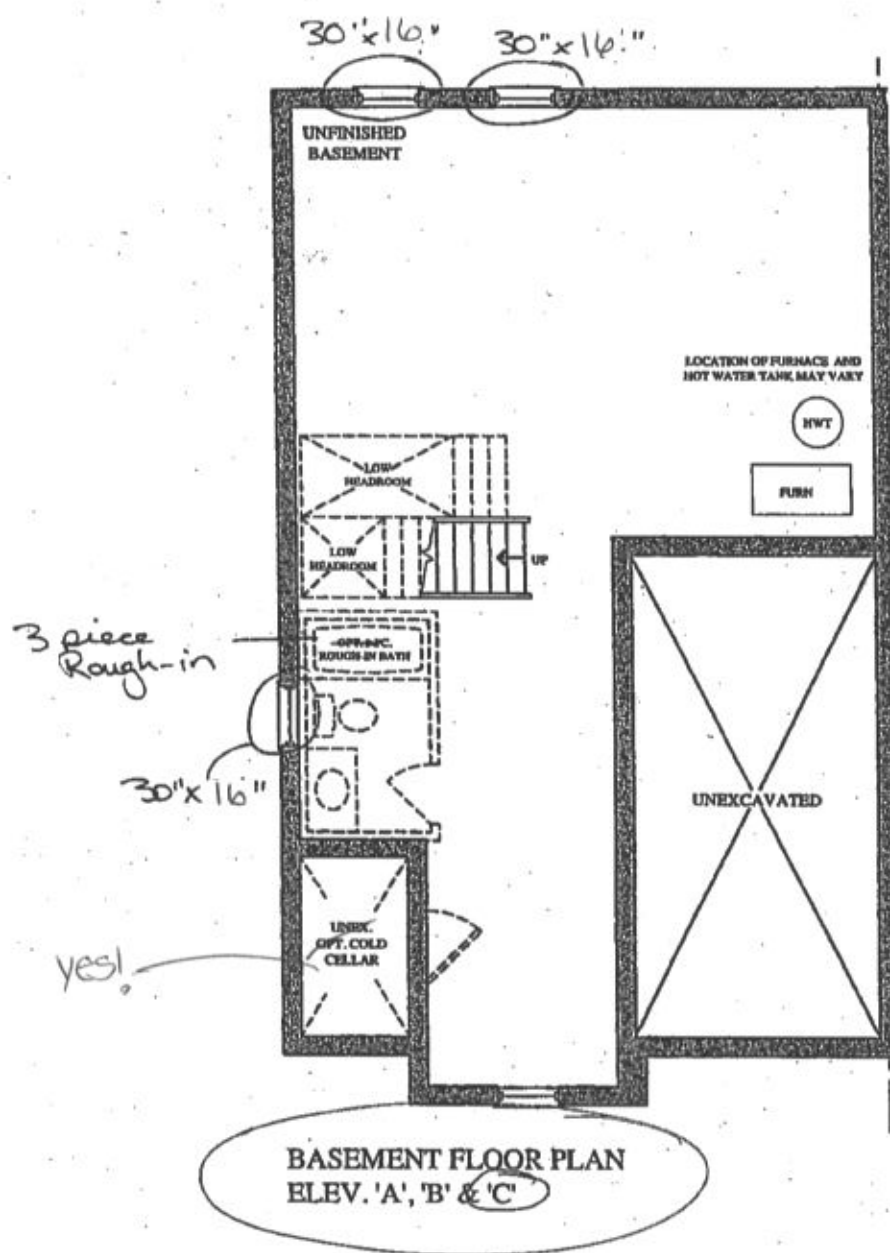

Lot 32R