

CONSTRUCTION SUMMARY

Brampton Encore - 61L - 2 - Unknown
CENTRAL VAC AND WIRING

Inv.1,682	1 - CONDUIT PIPE- FOR TELEVISION- MUST SPECIFY LOCATION AND TERMINATION POINT
Line25194	Note:
11Dec17 / 11Dec17	

CONCRETE AND DRAIN

Inv.1,682	1 - ROUGH-IN - 3PC BASEMENT ROUGH-IN
Line25203	Note:
11Dec17 / 11Dec17	

Inv.1,682	1 - COLD CELLAR
Line25206	Note:
11Dec17 / 11Dec17	

ELECTRICAL

Inv.1,682	1 - KITCHEN CABINET VALANCE LIGHTS (UNDER CABINETS) - WITH STRIP LIGHTS - DOES NOT INCLUDE (AND REQUIRES) KITCHEN UPGRADE PRICING
Line25195	Note:
11Dec17 / 11Dec17	

Inv.1,682	1 - KITCHEN: ROUGH - IN CEILING OUTLET ON SAME SWITCH - DOES NOT INCLUDE FIXTURE - CAPPED FOR FUTURE PENDANT LIGHT OVER ISLAND
Line25196	Note:
11Dec17 / 11Dec17	

Inv.1,682	1 - KITCHEN: ROUGH - IN CEILING OUTLET & SWITCH (WITH COVER PLATE) - DOES NOT INCLUDE FIXTURE - CAPPED FOR FUTURE PENDANT LIGHT OVER ISLAND
Line25199	Note:
11Dec17 / 11Dec17	

Inv.1,682	1 - KITCHEN: GAS LINE ROUGH - FOR FUTURE GAS STOVE- INCLUDE 100V PLUG
Line25207	Note:
11Dec17 / 11Dec17	

Exterior Colours

Inv.1,682	1 - EXTERIOR COLOUR PACKAGE # 6
Line25208	Note:
11Dec17 / 11Dec17	

FORMING

Inv.1,682	1 - SIDE DOOR- HOME TO EXTERIOR- AS PER PLAN AND GRADE PERMITTING
Line25200	Note:
11Dec17 / 11Dec17	

Inv.1,682	1 - COLD CELLAR
Line25201	Note:
11Dec17 / 11Dec17	

HVAC

Inv.1,682	1 - KITCHE: GAS LINE ROUGH - FOR FUTURE GAS STOVE- INCLUDE 100V PLUG
Line25202	Note:
11Dec17 / 11Dec17	

WINDOWS - BASEMENT

Brampton Encore - 61L - 2 - Unknown

Inv.1,682	3 - BASEMENT WINDOWS - UPGRADE EXISTING BASEMENT WINDOW TO 30 INCH X 16 INCH
Line25204	Note:
11Dec17 / 11Dec17	

WINDOWS AND DOORS

Inv.1,682	1 - SIDE DOOR- HOME TO EXTERIOR- AS PER PLAN AND GRADE PERMITTING
Line25205	Note:
11Dec17 / 11Dec17	

Telephone — (T)
 Cable — (C)
 Electrical — (E)


The Siren

SEMI SERIES


Elevation A • 1,688 sq.ft.

Elevation B • 1,677 sq.ft.

Elevation C • 1,687 sq.ft.

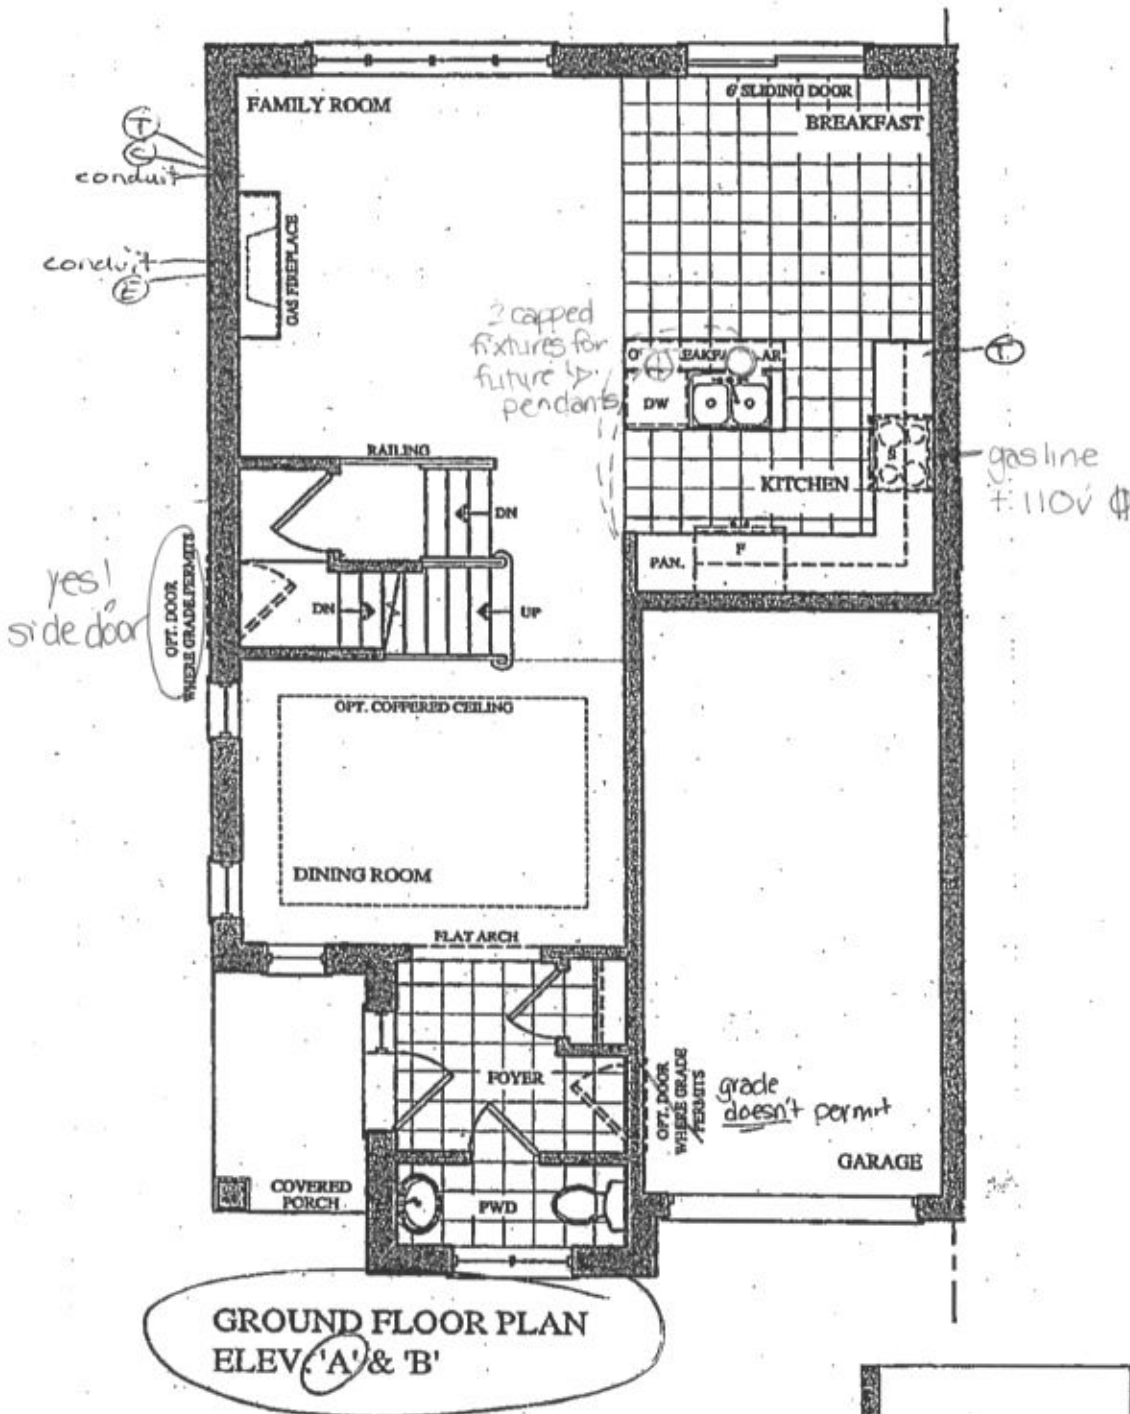

Lot 61L

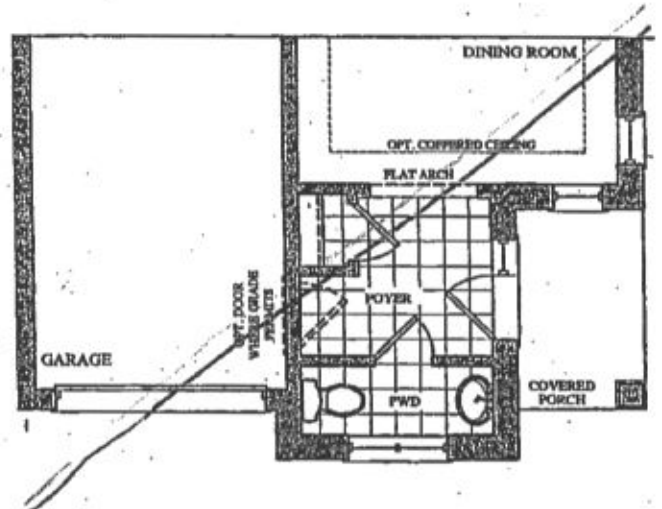


PART. GROUND FLOOR PLAN
ELEV. 'C'

Telephone — (T)
 Cable — (C)


The Siren

SEMI SERIES

Elevation A • 1,688 sq.ft.
 Elevation B • 1,677 sq.ft.
 Elevation C • 1,687 sq.ft.

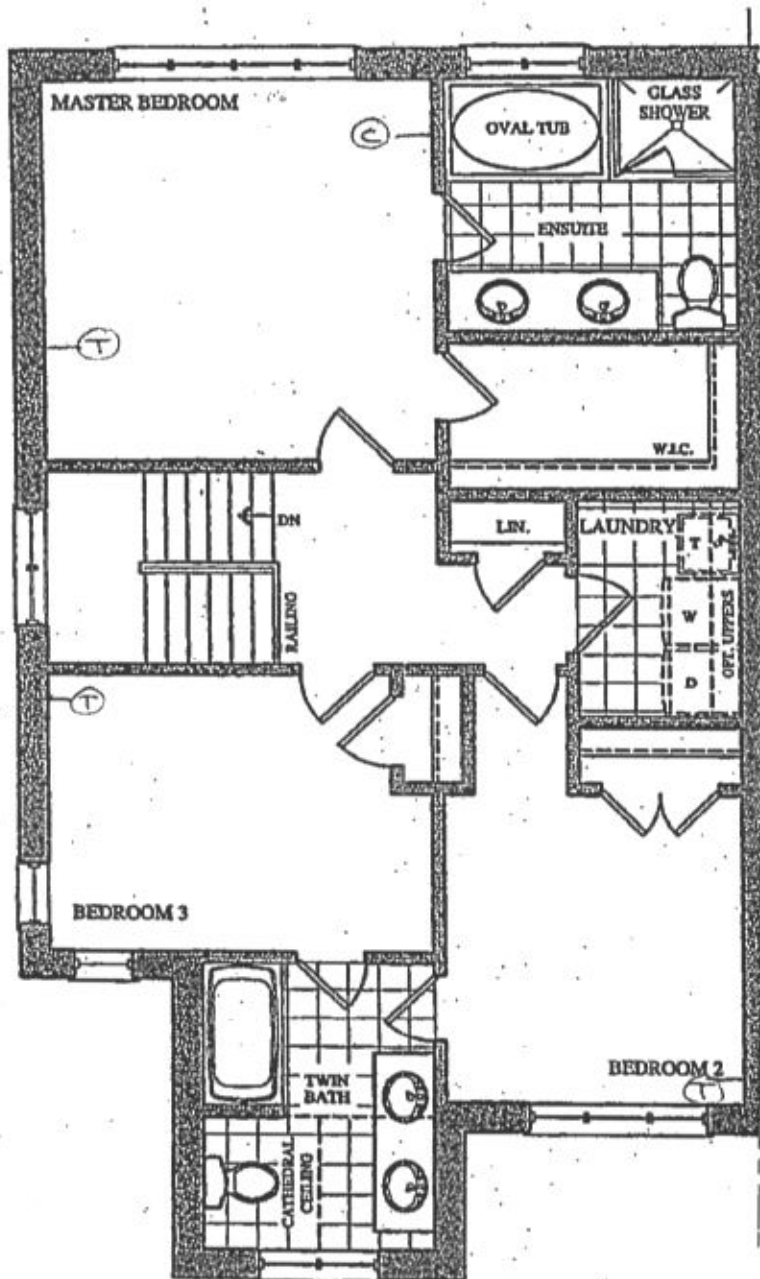


SECOND FLOOR PLAN
 ELEV. 'A'

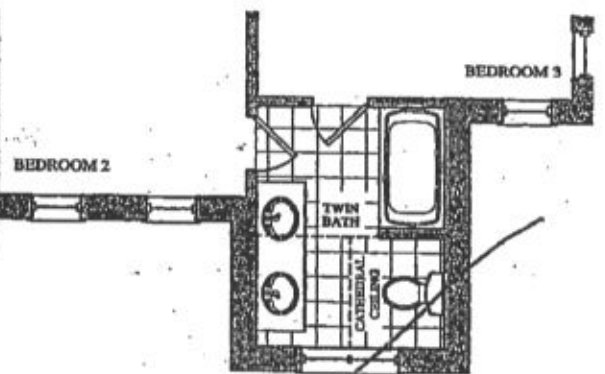


PART. SECOND FLOOR PLAN
 ELEV. 'B'

Lot 672

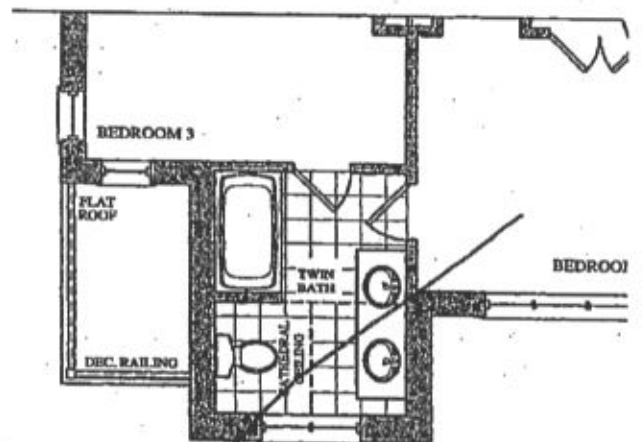

PART. SECOND FLOOR PLAN
 ELEV. 'C'

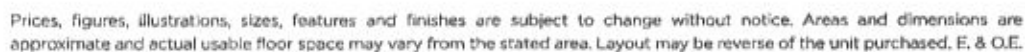

GOLDPARK
WORTH MORE™

Lot 612