



CONSTRUCTION SUMMARY

Brampton Encore - 61L - 2 - 28-2 Elev.A Siren
CENTRAL VAC AND WIRING

Inv.1,682	1 - CONDUIT PIPE- FOR TELEVISION- MUST SPECIFY LOCATION AND TERMINATION POINT
Line25194	Note:
11Dec17 / 18Dec17	

CONCRETE AND DRAIN

Inv.1,682	1 - ROUGH-IN - 3PC BASEMENT ROUGH-IN
Line25203	Note:
11Dec17 / 18Dec17	

Inv.1,682	1 - COLD CELLAR
Line25206	Note:
11Dec17 / 18Dec17	

ELECTRICAL

Inv.1,682	1 - KITCHEN CABINET VALANCE LIGHTS (UNDER CABINETS) - WITH STRIP LIGHTS - DOES NOT INCLUDE (AND REQUIRES) KITCHEN UPGRADE PRICING
Line25195	Note:
11Dec17 / 18Dec17	

Inv.1,682	1 - KITCHEN: ROUGH - IN CEILING OUTLET ON SAME SWITCH - DOES NOT INCLUDE FIXTURE - CAPPED FOR FUTURE PENDANT LIGHT OVER ISLAND
Line25196	Note:
11Dec17 / 18Dec17	

Inv.1,682	1 - KITCHEN: ROUGH - IN CEILING OUTLET & SWITCH (WITH COVER PLATE) - DOES NOT INCLUDE FIXTURE - CAPPED FOR FUTURE PENDANT LIGHT OVER ISLAND
Line25199	Note:
11Dec17 / 18Dec17	

Inv.1,682	1 - KITCHEN: GAS LINE ROUGH - FOR FUTURE GAS STOVE- INCLUDE 100V PLUG
Line25207	Note:
11Dec17 / 18Dec17	

Inv.1,682	1 - FAMILY ROOM: 110V WALL RECEPTACLE ON DEDICATED CIRCUIT-ABOVE FIREPLACE FOR FUTURE TV
Line25325	Note:
11Dec17 / 18Dec17	

Exterior Colours

Inv.1,682	1 - EXTERIOR COLOUR PACKAGE # 6
Line25208	Note:
11Dec17 / 18Dec17	

FORMING

Inv.1,682	1 - SIDE DOOR- HOME TO EXTERIOR- AS PER PLAN AND GRADE PERMITTING
Line25200	Note:
11Dec17 / 18Dec17	

Inv.1,682	1 - COLD CELLAR
Line25201	Note:
11Dec17 / 18Dec17	

HVAC



CONSTRUCTION SUMMARY

Brampton Encore - 61L - 2 - 28-2 Elev.A Siren

Inv.1,682	1 - KITCHEN: GAS LINE ROUGH - FOR FUTURE GAS STOVE- INCLUDE 110V PLUG
Line25202	Note:
11Dec17 / 18Dec17	

WINDOWS - BASEMENT

Inv.1,682	3 - BASEMENT WINDOWS - UPGRADE EXISTING BASEMENT WINDOW TO 30 INCH X 16 INCH
Line25204	Note:
11Dec17 / 18Dec17	

WINDOWS AND DOORS

Inv.1,682	1 - SIDE DOOR- HOME TO EXTERIOR- AS PER PLAN AND GRADE PERMITTING
Line25205	Note:
11Dec17 / 18Dec17	

Telephone — (T)
 Cable — (C)
 Electrical — (E)


The Siren

SEMI SERIES


Elevation A • 1,688 sq.ft.

Elevation B • 1,677 sq.ft.

Elevation C • 1,687 sq.ft.

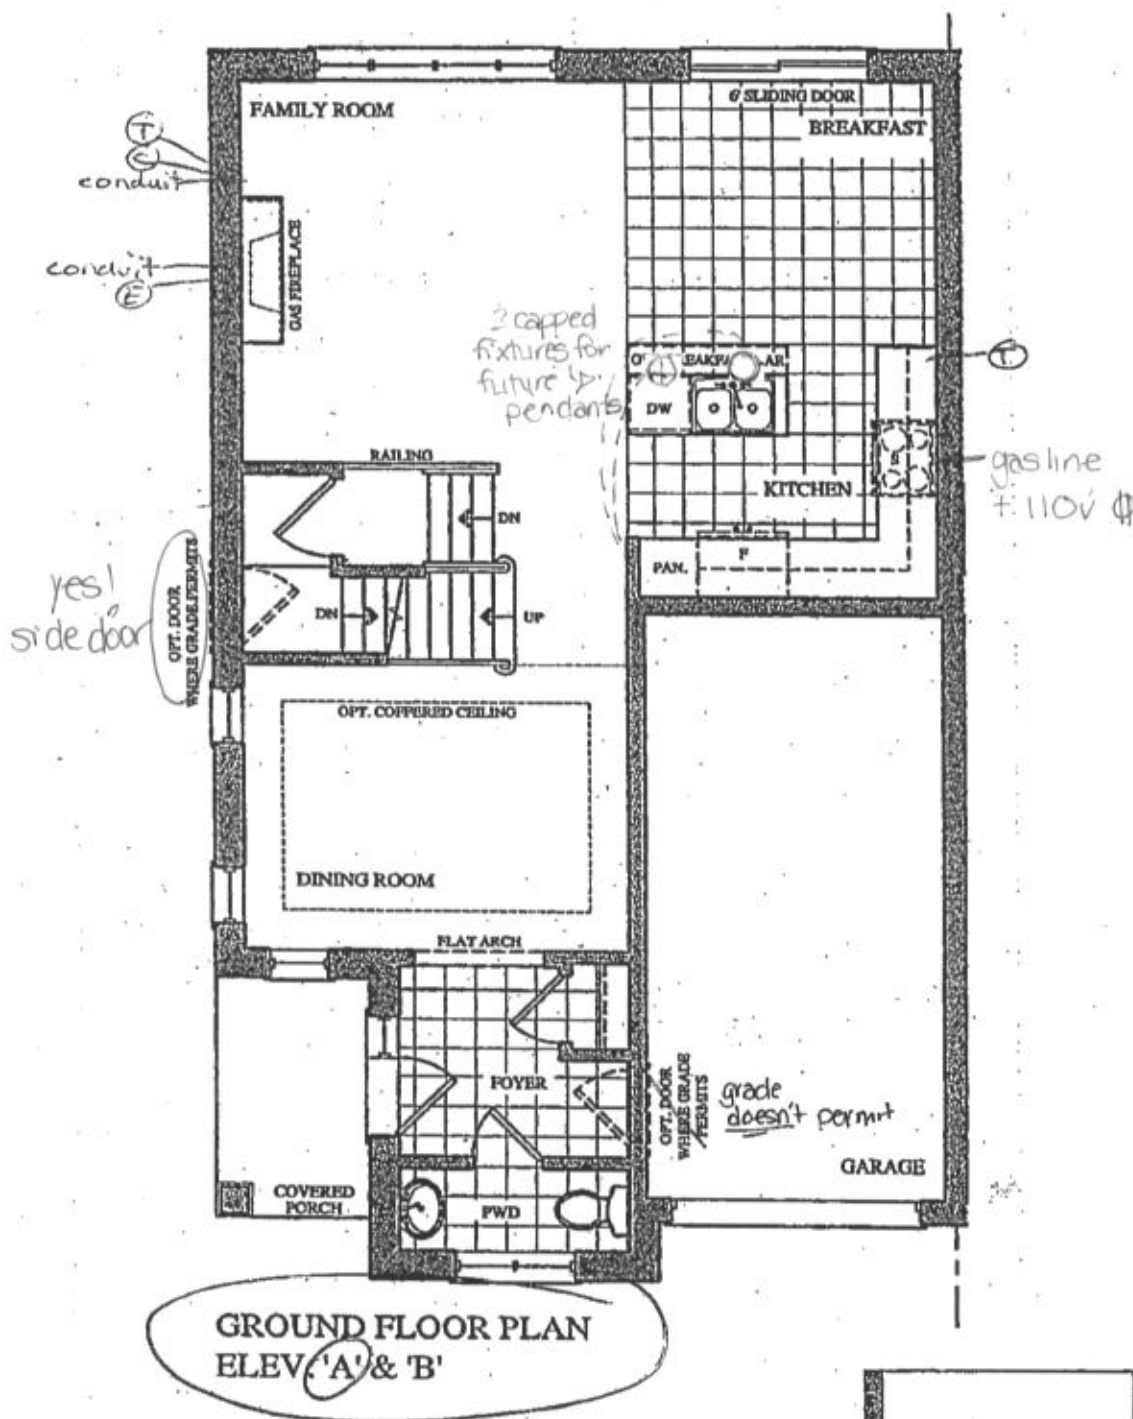

Lot 61L

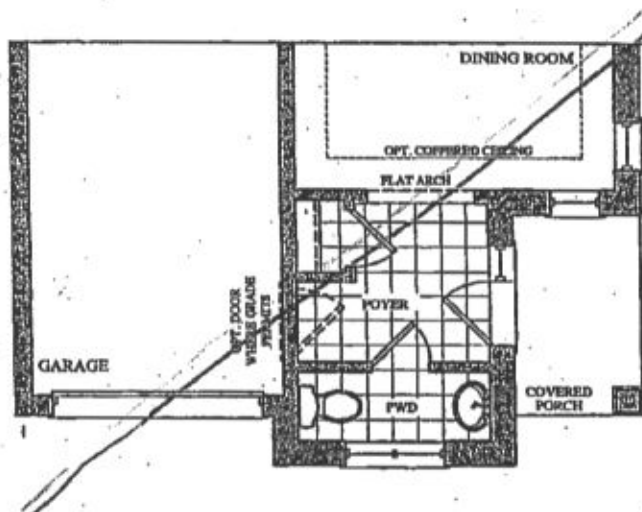


Telephone — (T)
 Cable — (C)

The Siren


SEMI SERIES

Elevation A • 1,688 sq.ft.
 Elevation B • 1,677 sq.ft.
 Elevation C • 1,687 sq.ft.

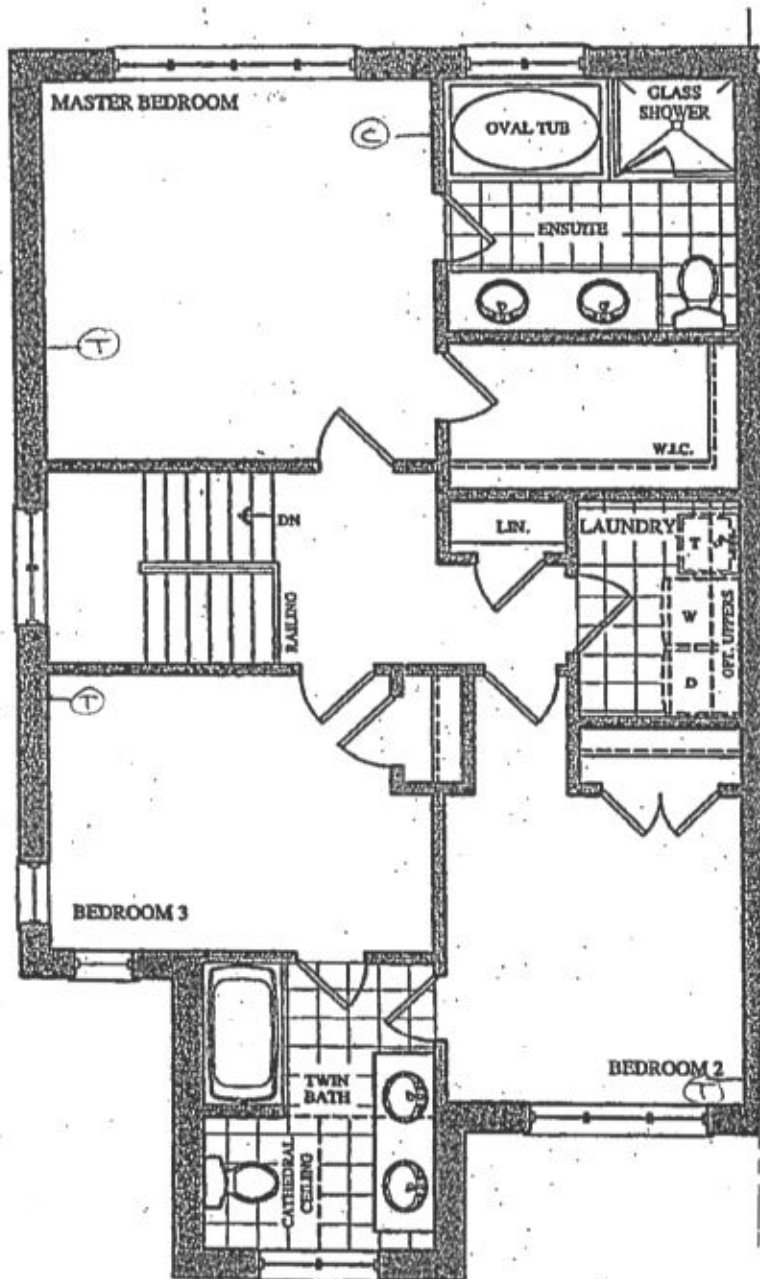


SECOND FLOOR PLAN
 ELEV. 'A'

Lot 672

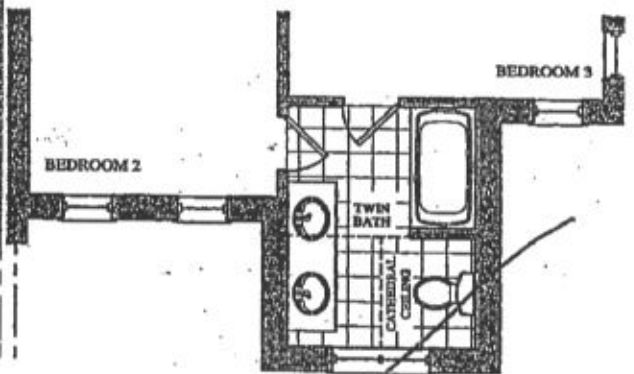

PART. SECOND FLOOR PLAN
 ELEV. 'B'

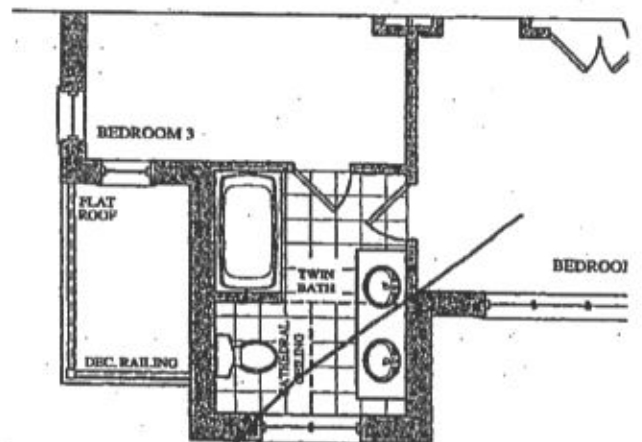


PART. SECOND FLOOR PLAN
 ELEV. 'C'

The Siren

SEMI SERIES

Elevation A • 1,688 sq.ft.
Elevation B • 1,677 sq.ft.
Elevation C • 1,687 sq.ft.

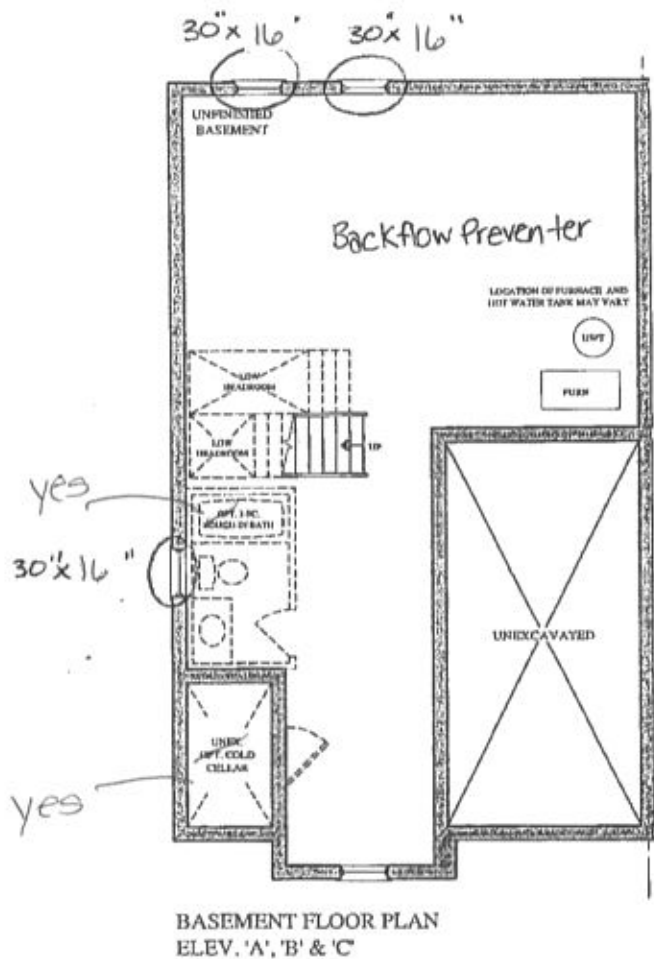

Prices, figures, illustrations, sizes, features and finishes are subject to change without notice. Areas and dimensions are approximate and actual usable floor space may vary from the stated area. Layout may be reverse of the unit purchased. E. & O.E.

GOLDPARK
WORTH MORE™

Lot 612