

Brampton Encore - 89R - 2 - 28-2 Elev.CR Siren

CENTRAL VAC AND WIRING

Inv.1,684	1 - CONDUIT PIPE- FOR TELEVISION- MUST SPECIFY LOCATION AND TERMINATION POINT
Line25326	Note:
11Dec17 / 18Dec17	

CONCRETE AND DRAIN

Inv.1,684	1 - ROUGH-IN - 3PC BASEMENT ROUGH-IN
Line25332	Note:
11Dec17 / 18Dec17	

Inv.1,684	1 - COLD CELLAR
Line25335	Note:
11Dec17 / 18Dec17	

ELECTRICAL

Inv.1,684	1 - KITCHEN: GASLINE AND 110V WALL RECEPTACLE ON DEDICATED CIRCUIT - GAS FIRED APPLIANCE
Line25327	Note:
11Dec17 / 18Dec17	

Inv.1,684	1 - KITCHEN: ROUGH - IN CEILING OUTLET ON SAME SWITCH - DOES NOT INCLUDE FIXTURE - OVER ISLAND FOR FUTURE PENDANT LIGHT
Line25328	Note:
11Dec17 / 18Dec17	

Inv.1,684	1 - KITCHEN: ROUGH - IN CEILING OUTLET & SWITCH (WITH COVER PLATE) - DOES NOT INCLUDE FIXTURE - OVER ISLAND FOR FUTURE PENDANT LIGHT
Line25329	Note:
11Dec17 / 18Dec17	

Exterior Colours

Inv.1,684	1 - EXTERIOR COLOUR PACKAGE #6
Line25336	Note:
11Dec17 / 18Dec17	

FORMING

Inv.1,684	1 - COLD CELLAR
Line25330	Note:
11Dec17 / 18Dec17	

FRAMING

Inv.1,684	1 - DINING ROOM: OPTIONAL COFFERED CEILING - LIVING ROOM (PER ROOM AS PER PLAN)
Line25331	Note:
11Dec17 / 18Dec17	

HVAC

Inv.1,684	1 - KITCHEN: GASLINE AND 110V WALL RECEPTACLE ON DEDICATED CIRCUIT - GAS FIRED APPLIANCE
Line25334	Note:
11Dec17 / 18Dec17	

WINDOWS - BASEMENT

Brampton Encore - 89R - 2 - 28-2 Elev.CR Siren


Inv.1,684	3 - BASEMENT WINDOWS - UPGRADE EXISTING BASEMENT WINDOW TO 30 INCH X 16 INCH
Line25333	Note:
11Dec17 / 18Dec17	

Telephone — ①
Cable — ②

The Siren


SEMI SERIES

Elevation A • 1,688 sq.ft.
Elevation B • 1,677 sq.ft.
Elevation C • 1,687 sq.ft.

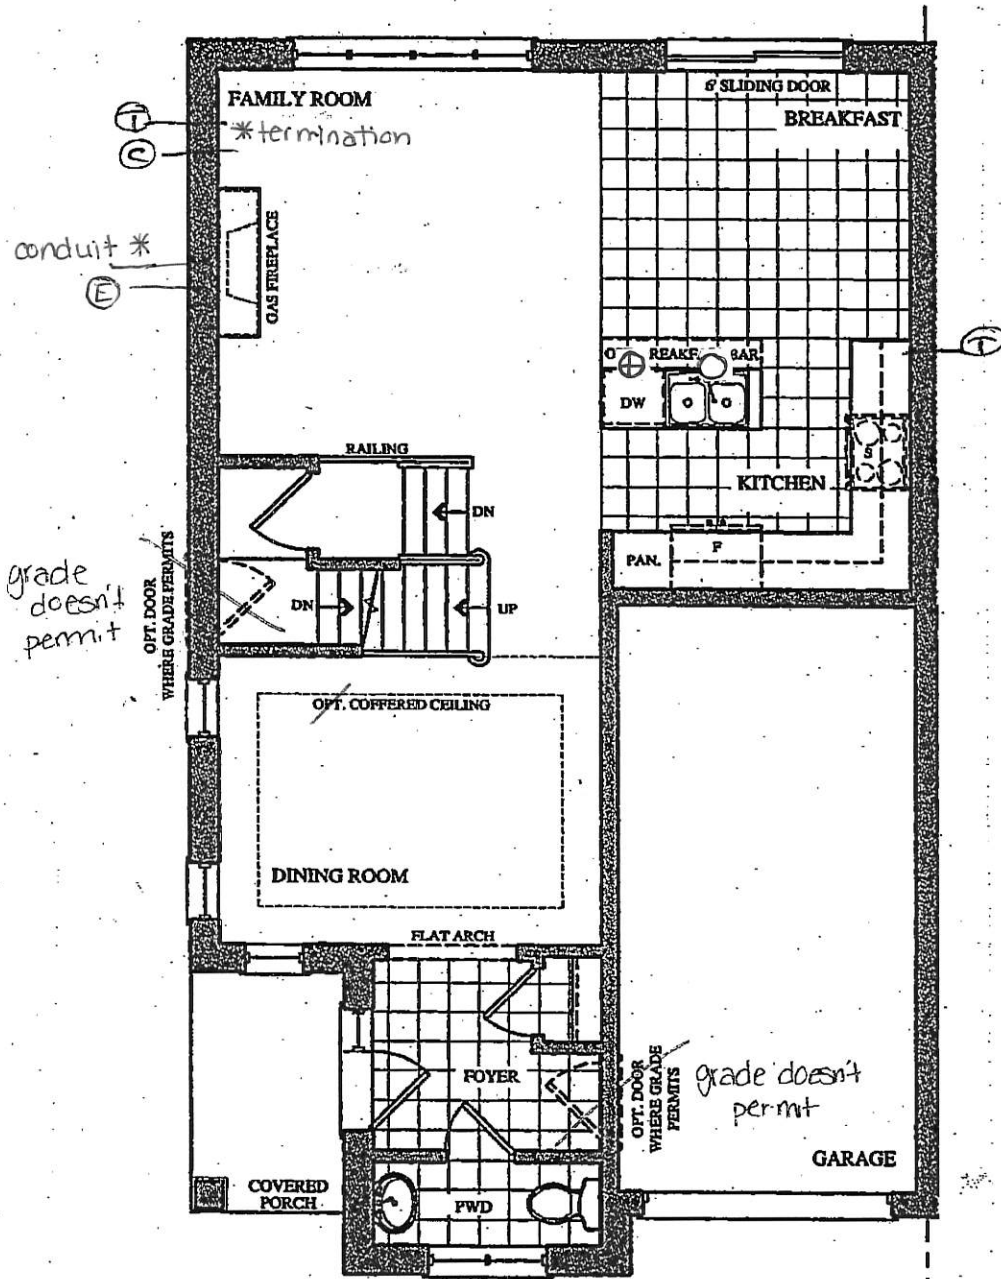

GROUND FLOOR PLAN
ELEV. 'A' & 'B'

Lot 89R

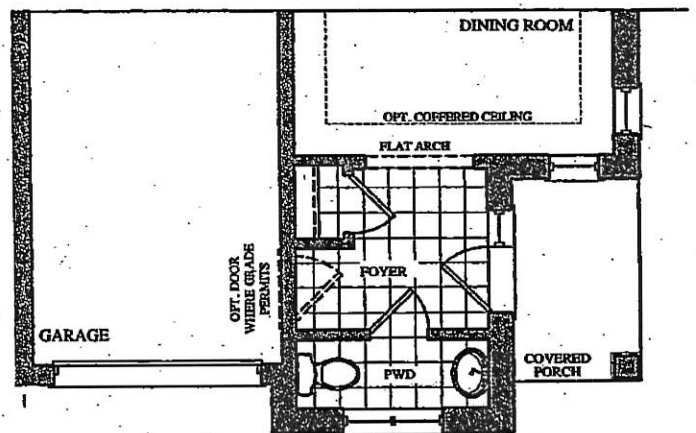


PART. GROUND FLOOR PLAN
ELEV. 'C'

Telephone — (T)
 Cable — (C)

The Siren


SEMI SERIES

Elevation A • 1,688 sq.ft.
 Elevation B • 1,677 sq.ft.
 Elevation C • 1,687 sq.ft.

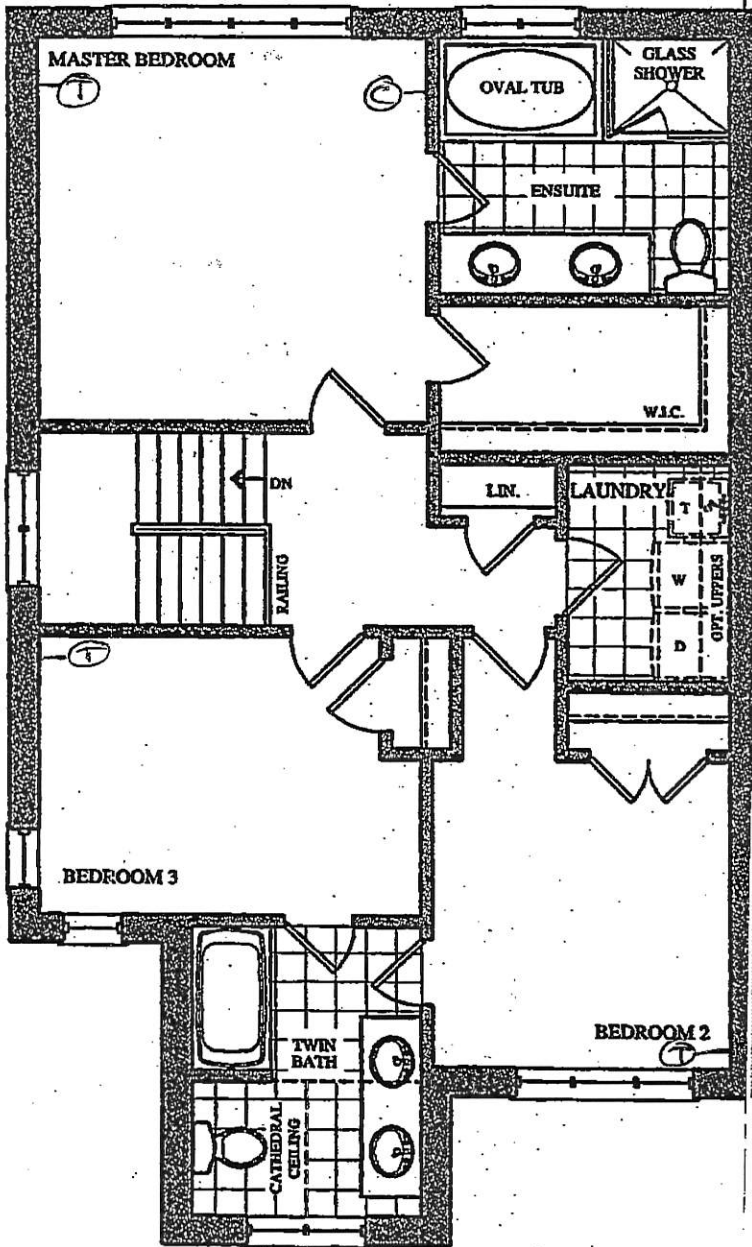


SECOND FLOOR PLAN
 ELEV. 'A'

Lot 89R

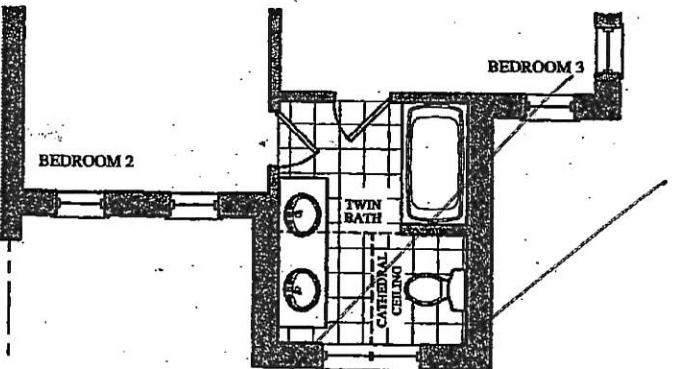

PART. SECOND FLOOR PLAN
 ELEV. 'B'

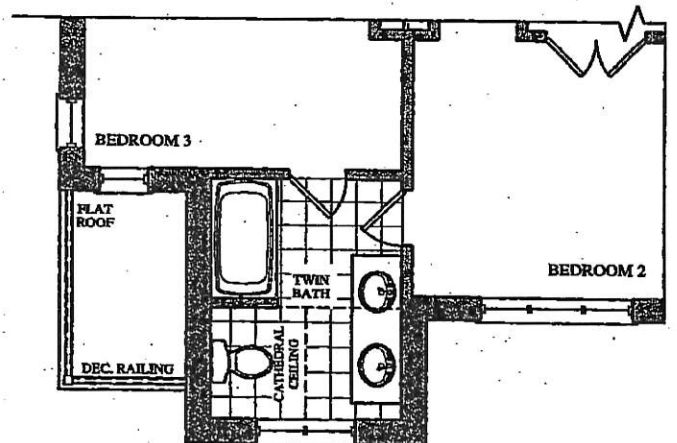


PART. SECOND FLOOR PLAN
 ELEV. 'C'

BSMNT WINDOWS
3x 30"x16"

The Siren

SEMI SERIES

Elevation A • 1,688 sq.ft.
Elevation B • 1,677 sq.ft.
Elevation C • 1,687 sq.ft.

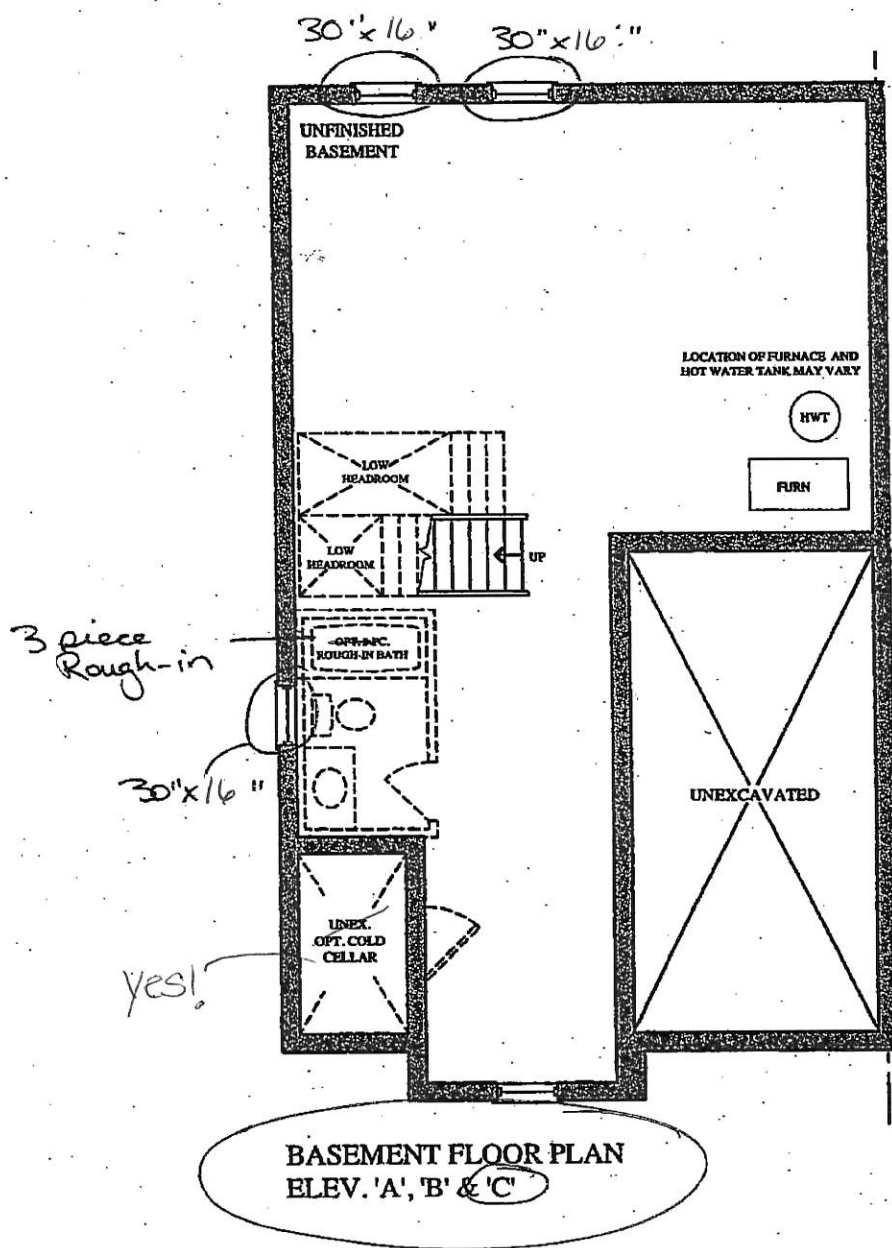

Lot 89R