



CONSTRUCTION SUMMARY

Kleinburg Glen - 15 - 2 - 42-1 Elev.A ROYALTON  
CENTRAL VAC AND WIRING

Inv.1,570	1 - GREAT ROOM- CONDUIT PIPE - FOR TELEVISION - LOCATE APPROX. 66" AFF ABOVE FIREPLACE, TERMINATING BY CABLE
Line24068	Note:
7Sep17 / 7Sep17	

CONCRETE AND DRAIN

Inv.1,570	1 - BACKFLOW PREVENTER VALVE
Line24070	Note:
7Sep17 / 7Sep17	

CROWN MOULDING

Inv.1,719	1 - INSTALL CTR-B07 4 BOX WAFFLE CEILING DETAIL IN DEN- AS PER PLAN PREPARED WITH SITE
Line25599	Note:
24Jan18 / 24Jan18	
Inv.1,719	1 - GREAT ROOM: INSTALL CTR-B07 7 BOX WAFFLE CEILING DETAIL IN GREAT ROOM- AS PER PLAN PREPARED WITH SITE
Line25600	Note:
24Jan18 / 24Jan18	

DRYWALL

Inv.1,570	1 - SMOOTH CEILINGS - (2 - Story Design) 2ND FLOOR
Line24069	Note:
7Sep17 / 7Sep17	
Inv.1,570	1 - MAIN FLOOR CEILING 10FT, 8FT TALLER INTERIOR DOORS, TALLER FLAT ARCHES, REAR AND FRONT WINDOWS WITH TRANSOM, TALLER KITCHEN CABINETS WITH CROWN AND FURRING PANEL, ADDED STAIRS AND PICKETS
Line24072	Note:
7Sep17 / 7Sep17	

ELECTRICAL

Inv.1,570	1 - GAS LINE ROUGH - MAIN FLOOR - (2 STOREY MODELS) FOR GAS STOVE- INCLUDES 110V PLUG ON SEPARATE CIRCUIT
Line24078	Note:
7Sep17 / 7Sep17	
Inv.1,570	1 - KITCHEN-220V Wall Recepticle on dedicated circuit- FOR FUTURE WALL OVEN AND MICROWAVE COMBO
Line24081	Note:
7Sep17 / 7Sep17	
Inv.1,570	1 - KITCHEN- Under Cabinet Valance strip Lighting - DOES NOT INCLUDE KITCHEN VALANCE-
Line24082	Note:
7Sep17 / 7Sep17	
Inv.1,570	1 - MOVE STANDARD CEILING LIGHT TO ABOVE ISLAND. SEE PLAN FOR LOCATION
Line24083	Note:
7Sep17 / 7Sep17	
Inv.1,570	1 - KITCHEN- ROUGH-IN LIGHT ON EXISTING SWITCH- CAPPED (DOESN'T INLCUDE FIXTURE) USE SAME SWITCH AS STANDARD
Line24084	Note:
7Sep17 / 7Sep17	



CONSTRUCTION SUMMARY

Kleinburg Glen - 15 - 2 - 42-1 Elev.A ROYALTON

Inv.1,719	6 - 6x- POTLIGHTS IN GREAT ROOM ON SEPERATE SWITCH- SEE PLAN FOR LOCATIONS
Line25595	Note:
24Jan18 / 24Jan18	
Inv.1,719	6 - 6X-POTLIGHTS IN DINING ROOM ON SEPERATE SWITCH- AS PER PLAN
Line25596	Note:
24Jan18 / 24Jan18	
Inv.1,719	4 - 4X POTLIGHTS IN BREAKFAST ON SEPERATE SWITCH- SEE PLAN FOR LOCATIONS
Line25597	Note:
24Jan18 / 24Jan18	
Inv.1,719	4 - 4X- POTLIGHTS IN DEN ON SEPERATE SWITCH- DELETE STD - SEE PLAN FOR DETAILS
Line25598	Note:
24Jan18 / 24Jan18	
Inv.1,719	1 - GREAT ROOM- Additional Interior Switch FOR POTLIGHTS
Line25601	Note:
24Jan18 / 24Jan18	
Inv.1,719	1 - DINING ROOM- Additional Interior Switch FOR POTLIGHTS
Line25602	Note:
24Jan18 / 24Jan18	
Inv.1,719	1 - BREAKFAST- Additional Interior Switch FOR POTLIGHTS
Line25603	Note:
24Jan18 / 24Jan18	
Inv.1,719	1 - BREAKFAST- Additional Interior Switch FOR POTLIGHTS
Line25604	Note:
24Jan18 / 24Jan18	
Inv.1,719	5 - KITCHEN-5X- POTLIGHTS IN KITCHEN ON SEPERATE SWITCH
Line25605	Note:
24Jan18 / 24Jan18	
Inv.1,719	5 - MAIN HALL- 5X POTLIGHTS IN MAIN HALL ON STD SWITCH
Line25606	Note:
24Jan18 / 24Jan18	
Inv.1,719	3 - LANDINGS-DELETE STD FIXTURES- INSTALL 2X POTLIGHTS- ON UPSTAIRS LANDINGS 1X POLIGHT ON BASEMENT STAIR LANDING - all on std switches
Line25607	Note:
24Jan18 / 24Jan18	
Inv.1,719	1 - POWDER ROOM: DELETE STD WALL FIXTURE AND INSTALL CAPPED FIXTURE IN CEILING USING STD SWITCH
Line25608	Note:
24Jan18 / 24Jan18	

Exterior Colours

Inv.1,570	1 - EXTERIOR COLOUR PACKAGE # 4
Line24066	Note:
7Sep17 / 7Sep17	

FRAMING

Kleinburg Glen - 15 - 2 - 42-1 Elev.A ROYALTON

Inv.1,570	1 - MAIN FLOOR CEILING 10FT, 8FT TALLER INTERIOR DOORS, TALLER FLAT ARCHES, REAR AND FRONT WINDOWS WITH TRANSOM, TALLER KITCHEN CABINETS WITH CROWN AND FURRING PANEL, ADDED STAIRS AND PICKETS
Line24071	Note:
7Sep17 / 7Sep17	

Inv.1,570	1 - MAN DOOR GARAGE TO HOUSE - GRADE PERMITS
Line24080	Note:
7Sep17 / 7Sep17	

HVAC

Inv.1,570	1 - GAS LINE ROUGH - MAIN FLOOR - (2 STOREY MODELS) FOR GAS COOKTOP- INCLUDES 110V PLUG ON SEPARATE CIRCUIT
Line24077	Note:
7Sep17 / 7Sep17	

INTERIOR TRIM AND DOORS

Inv.1,570	1 - MAIN FLOOR CEILING 10FT, 8FT TALLER INTERIOR DOORS, TALLER FLAT ARCHES, REAR AND FRONT WINDOWS WITH TRANSOM, TALLER KITCHEN CABINETS WITH CROWN AND FURRING PANEL, ADDED STAIRS AND PICKETS
Line24073	Note:
7Sep17 / 7Sep17	

KITCHEN AND BATH CABINETRY

Inv.1,570	1 - MAIN FLOOR CEILING 10FT, 8FT TALLER INTERIOR DOORS, TALLER FLAT ARCHES, REAR AND FRONT WINDOWS WITH TRANSOM, TALLER KITCHEN CABINETS WITH CROWN AND FURRING PANEL, ADDED STAIRS AND PICKETS
Line24074	Note:
7Sep17 / 7Sep17	

PAINT



Inv.1,570	1 - MAIN FLOOR CEILING 10FT, 8FT TALLER INTERIOR DOORS, TALLER FLAT ARCHES, REAR AND FRONT WINDOWS WITH TRANSOM, TALLER KITCHEN CABINETS WITH CROWN AND FURRING PANEL, ADDED STAIRS AND PICKETS
Line24075	Note:
7Sep17 / 7Sep17	

WINDOWS - BASEMENT

Inv.1,570	5 - UPGRADE 5 X BASEMENT WINDOWS - 30" X 16"
Line24067	Note:
7Sep17 / 7Sep17	

WINDOWS AND DOORS

Inv.1,570	1 - MAIN FLOOR CEILING 10FT, 8FT TALLER INTERIOR DOORS, TALLER FLAT ARCHES, REAR AND FRONT WINDOWS WITH TRANSOM, TALLER KITCHEN CABINETS WITH CROWN AND FURRING PANEL, ADDED STAIRS AND PICKETS
Line24076	Note:
7Sep17 / 7Sep17	
Inv.1,570	1 - MAN DOOR GARAGE TO HOUSE - GRADE PERMITS
Line24079	Note:
7Sep17 / 7Sep17	

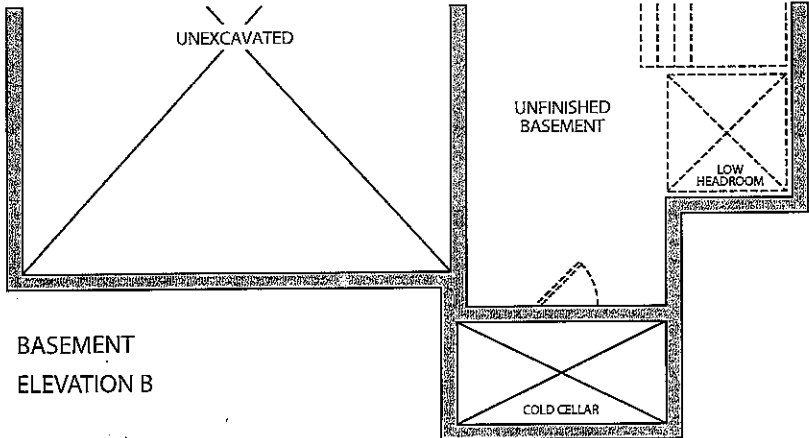
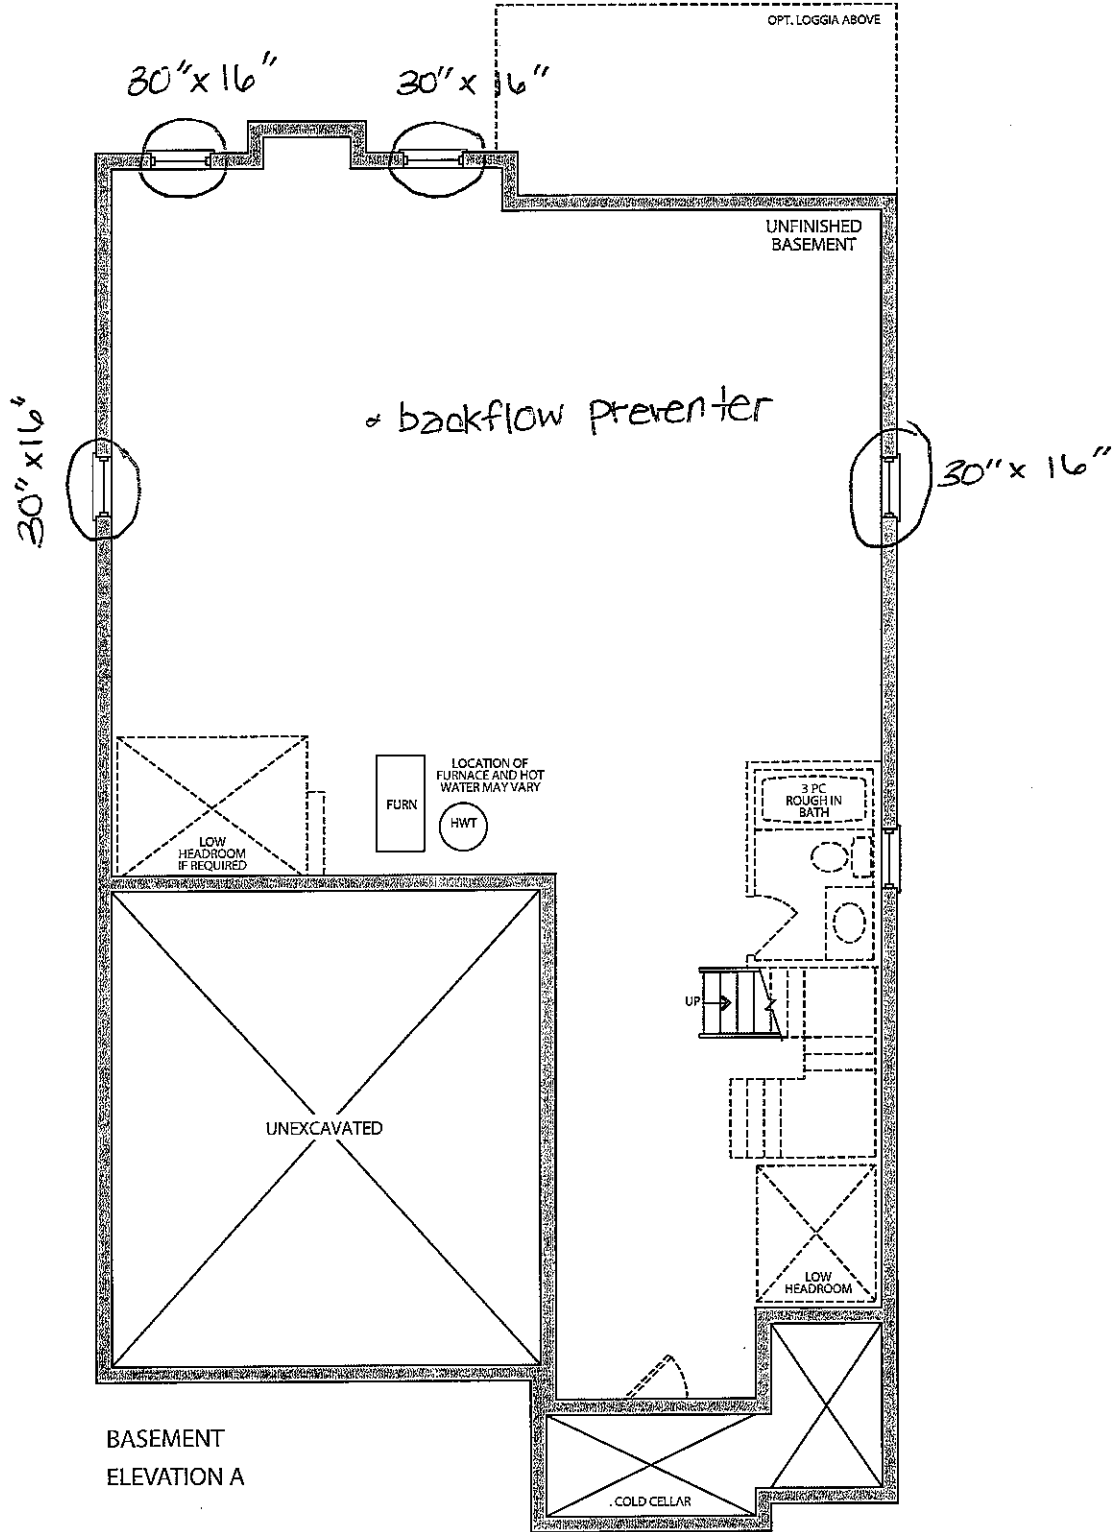


Prices, figures, illustrations, sizes, features and finishes are subject to change without notice. E.&O.E. Areas and dimensions are approximate and actual usable floor space may vary from the stated area. Layout may be reverse of the unit purchased. E. & O.E.

Elevation A • 3,016 sq.ft.


Elevation B • 3,043 sq.ft.

• 10' main floor package

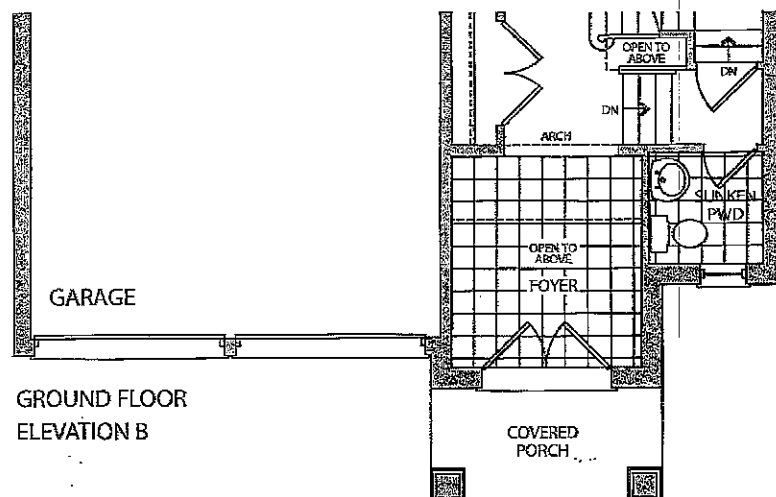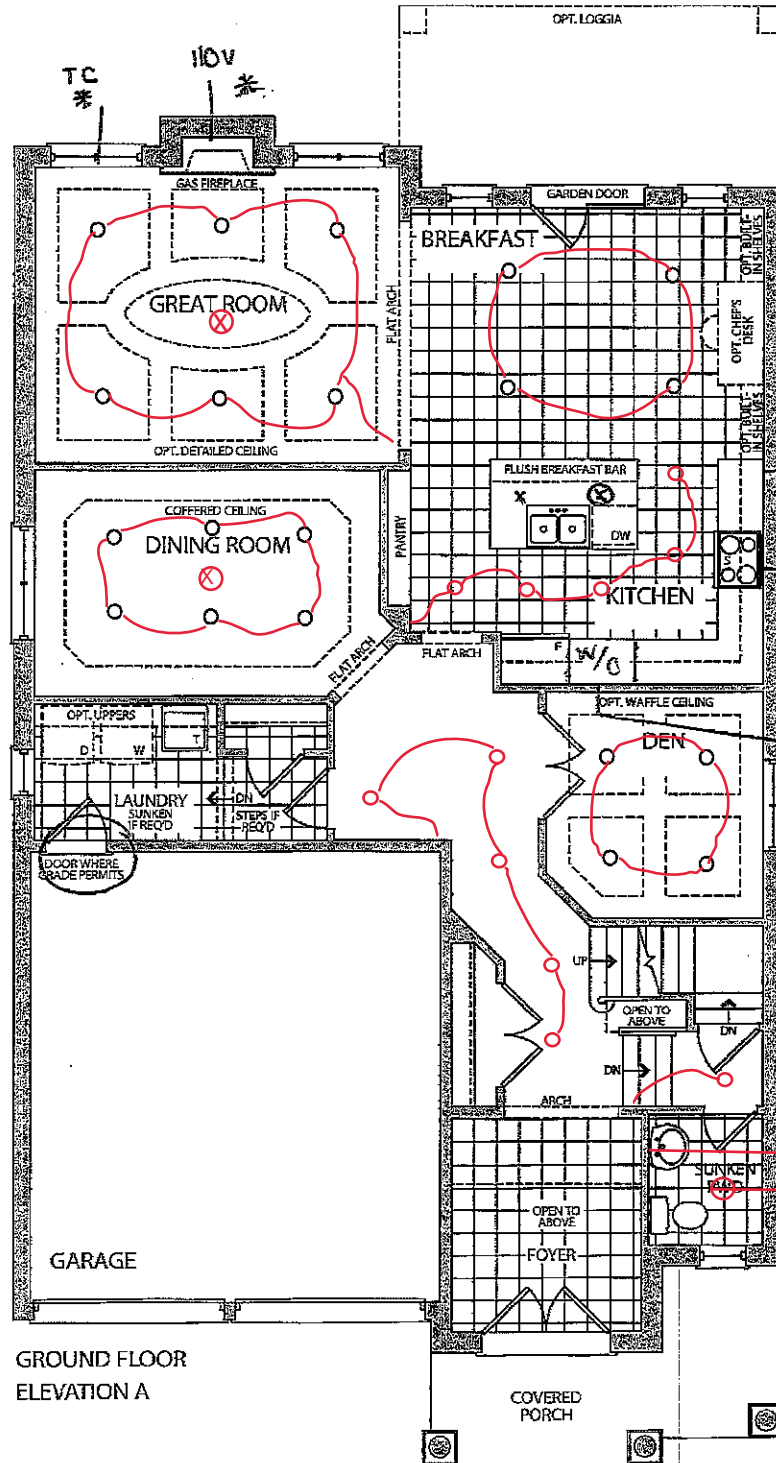


Elevation A • 3,016 sq.ft.  
Elevation B • 3,043 sq.ft.


smooth ceiling

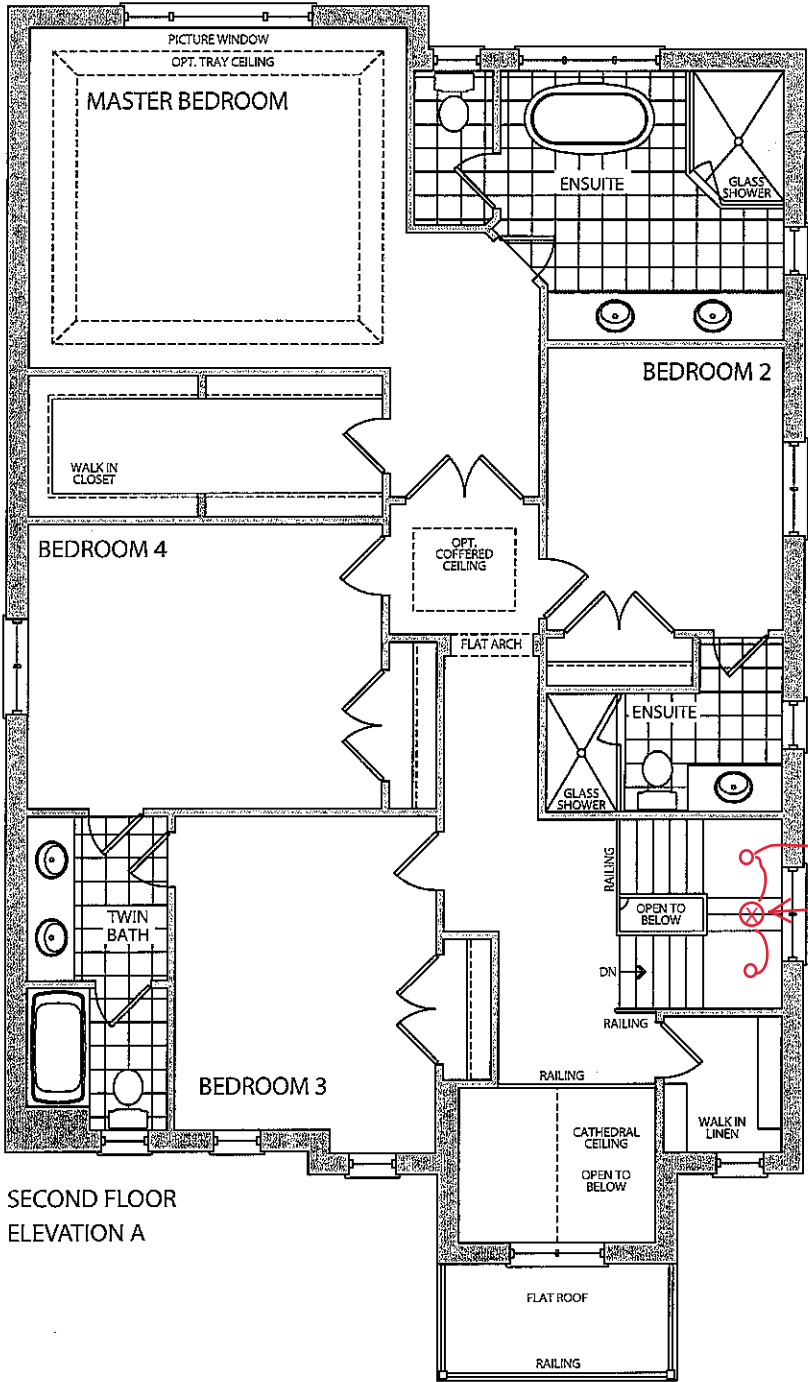


SECOND FLOOR  
ELEVATION A

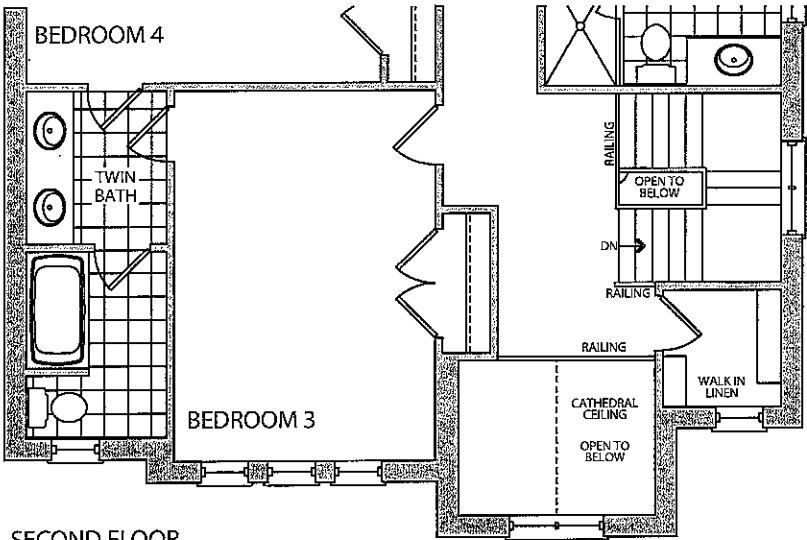

SECOND FLOOR  
ELEVATION B

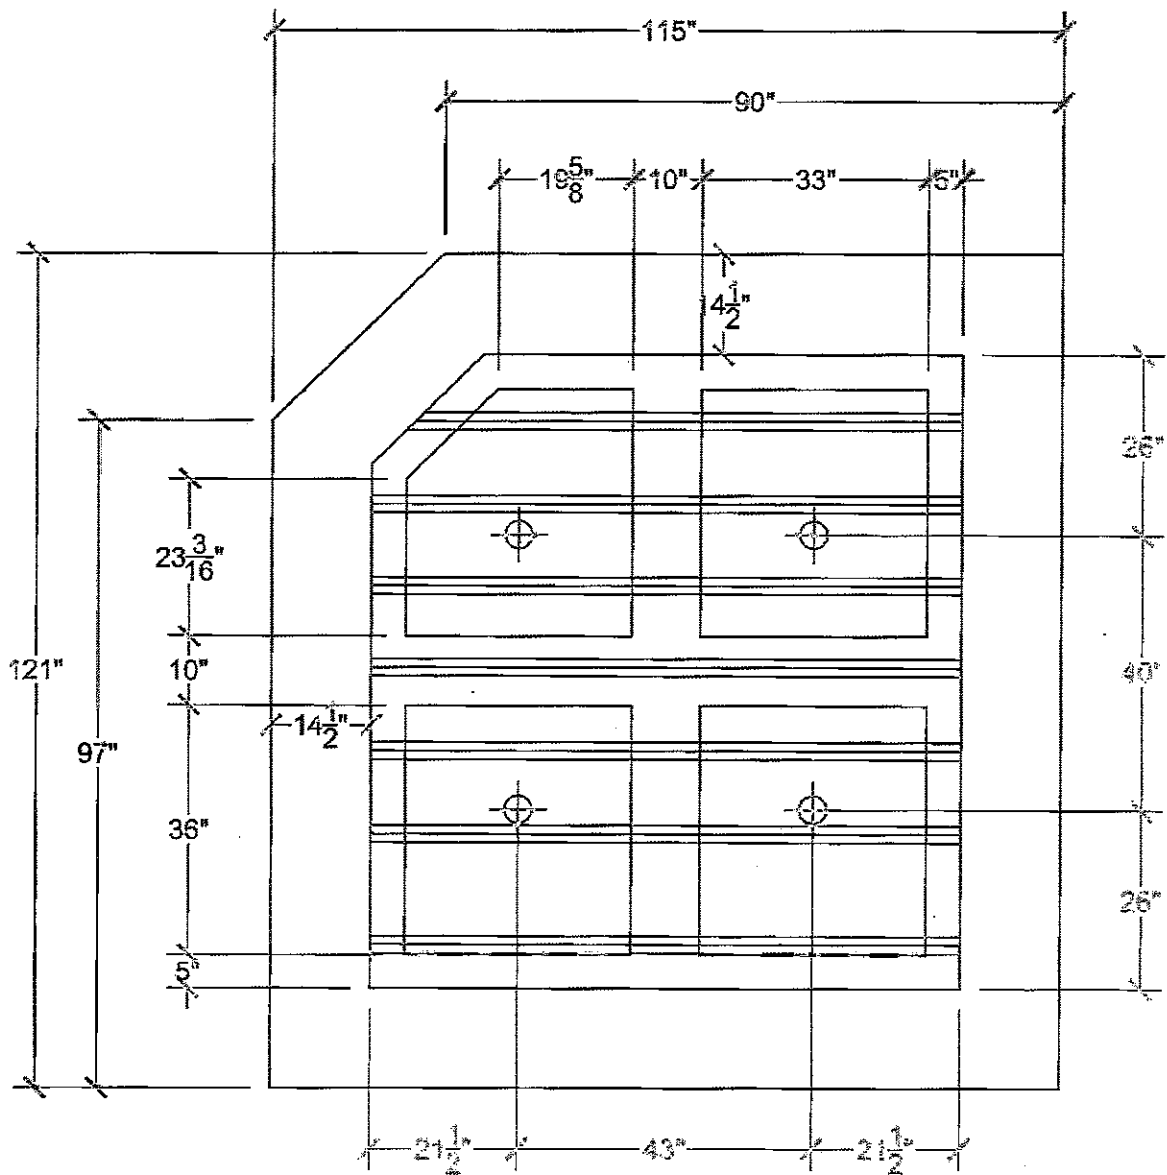

A-1 Lot 15 - Den  
Profile: CTR-B07

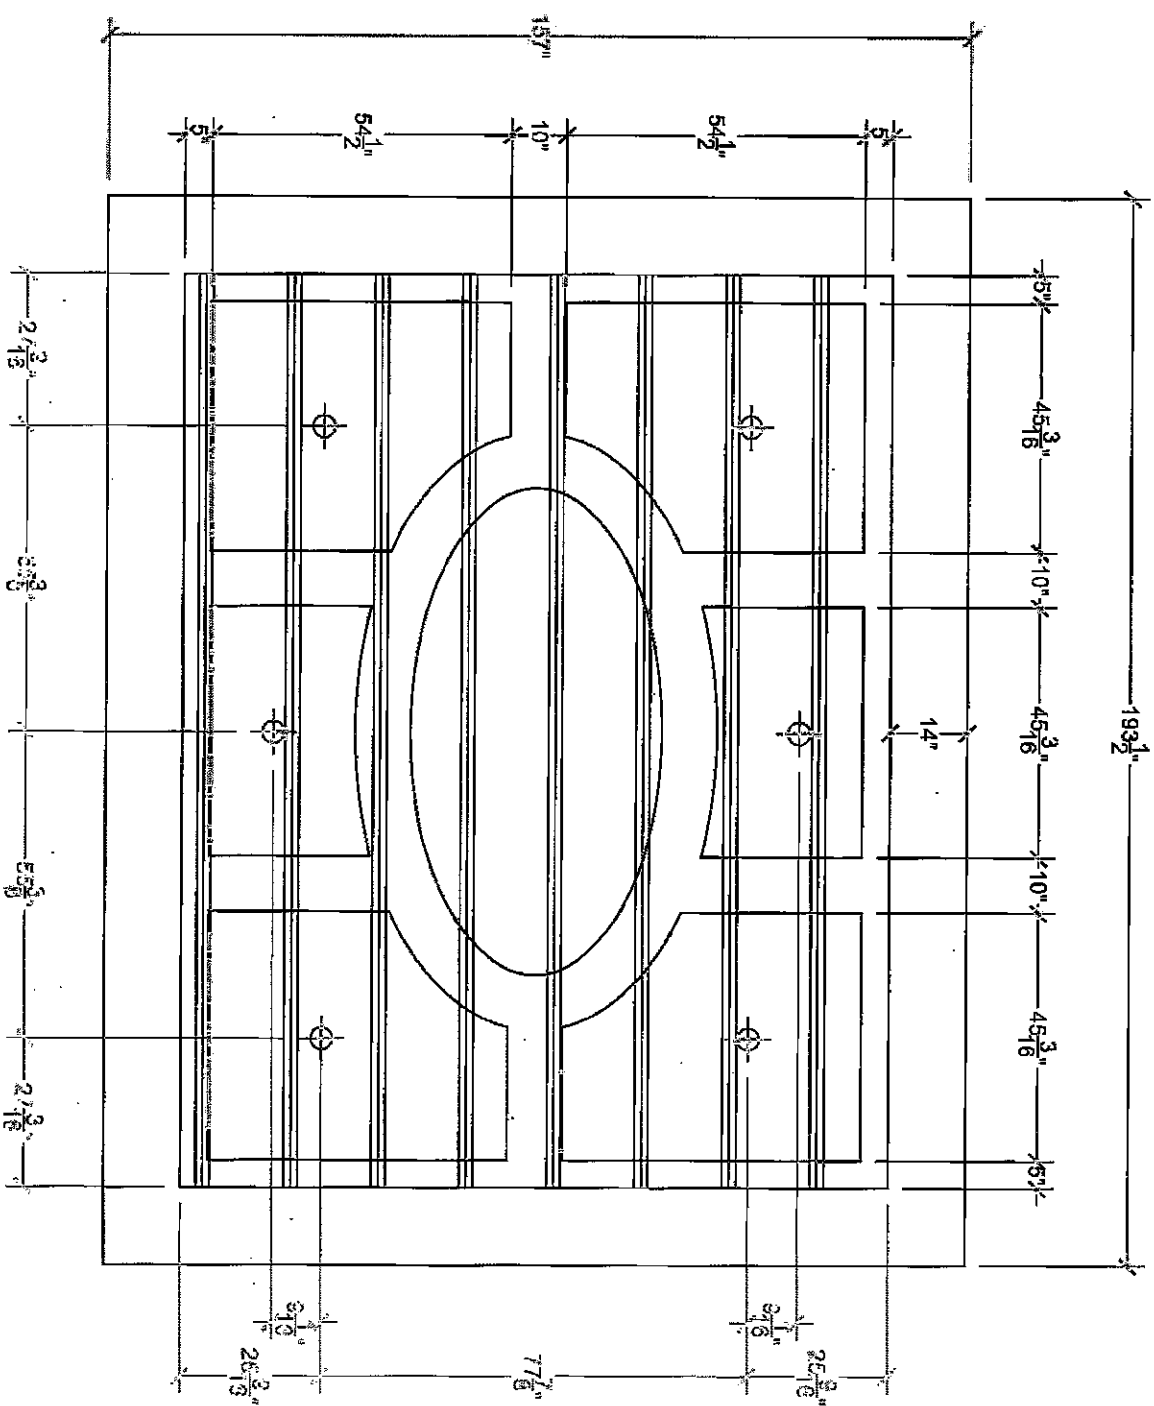

A-2 Lot 15 - Great Room  
Profile: CTR-B07