

Brampton Encore - 7R - 2 - 28-4 Elev.D ROSSINI OPT - OPT 4

CENTRAL VAC AND WIRING

Inv.1,442	1 - THRU OUT: SECURITY UPGRADE: 1 x KEYPAD IN MASTER BEDROOM; 1 x MOTION DETECTOR ON 2ND FLOOR, 1 x GLASSBREAK DETECTOR ON MAIN FLOOR, 1 x MOISTURE SENSOR IN BASEMENT
Line22624	Note:
19Jun17 / 27Sep17	

CERAMIC

Inv.1,688	1 - KITCHEN/BREAKFAST: UPGRADE 2 TILE - 12X24" LAID IN STRAIGHT, STACKED PATTERN -SEE PLAN FOR TILE DIRECTION
Line25284	Note:
14Dec17 / 15Feb18	
Inv.1,688	1 - KITCHEN BACKSPLASH (ABOVE COUNTER & BEHIND STOVE): UPGRADE 2- GLASS MOSAIC #KV.CR.GRY.0,6X1.9BL
Line25285	Note:
14Dec17 / 15Feb18	
Inv.1,688	1 - FOYER FLOOR TILE: UPGRADE 2 TILE - 12X24" LAID IN STRAIGHT, STACKED PATTERN -SEE PLAN FOR TILE DIRECTION
Line25294	Note:
14Dec17 / 15Feb18	

ELECTRICAL

Inv.1,442	4 - LIVING ROOM: POTLIGHT - 4" LED
Line22625	Note: SEE PLAN FOR LOCATION
19Jun17 / 27Sep17	
Inv.1,442	1 - KITCHEN: RELOCATE STANDARD CEILING LIGHT TO APPROX. CENTER ABOVE ISLAND
Line22627	Note:
19Jun17 / 27Sep17	
Inv.1,442	1 - LIVING ROOM: SINGLE POLE SWITCH FOR POT LIGHTS
Line22626	Note: SEE PLAN FOR LOCATION
19Jun17 / 27Sep17	
Inv.1,442	1 - KITCHEN: GAS LINE ROUGH IN COMPLETE WITH 110v ELECTRICAL MAIN FLOOR - FOR FUTURE GAS RANGE
Line24226	Note:
19Jun17 / 27Sep17	
Inv.1,697	1 - KITCHEN CABINTRY: ADJUST UPPER ABOVE STOVE FOR 30" WIDTH MICROWAVE/FAN COMBO (otr) **Leave standard electrical - homeowner to change as required after closing Please install standard hood fan on cabinetry adjusted for otr.
Line25947	Note:
21Dec17 / 15Feb18	

Exterior Colours

Inv.1,442	1 - EXTERIOR COLOUR PACKAGE # 9
Line24227	Note:
19Jun17 / 27Sep17	

FRAMING

Inv.1,442	1 - MAIN FLOOR: EXTENDED HEIGHT ARCHWAY (PRICE PER DOORWAY) - 96"
Line24229	Note:
19Jun17 / 27Sep17	

Brampton Encore - 7R - 2 - 28-4 Elev.D ROSSINI OPT - OPT 4

Inv.1,442	1 - MANDOOR- GARAGE TO EXTERIOR- GRADE PERMITTING
Line24231	Note:
19Jun17 / 27Sep17	
Inv.1,688	1 - CREDIT SIDE ENTRANCE - GRADE DOES NOT ALLOW
Line25281	Note:
14Dec17 / 15Feb18	

GRANITE MARBLE QUARTZ

Inv.1,688	1 - KITCHEN: SLIDE IN STOVE PREP - FOR **STANDARD 30" SLIDE IN STOVE** NO SPECS WILL BE PROVIDED
Line25282	Note:
14Dec17 / 15Feb18	
Inv.1,688	1 - KITCHEN COUNTER: OPTIONAL FLUSH BREAKFAST BAR
Line25283	Note:
14Dec17 / 15Feb18	
Inv.1,688	1 - MASTER ENSUITE: UPGRADE 1 GRANITE
Line25286	Note:
14Dec17 / 15Feb18	
Inv.1,688	1 - MAIN BATHROOM: UPGRADE 1 GRANITE
Line25287	Note:
14Dec17 / 15Feb18	

HVAC

Inv.1,442	1 - 2.0 TON A/C UNIT
Line22629	Note:
19Jun17 / 27Sep17	
Inv.1,442	1 - KITCHEN: GAS LINE ROUGH IN COMPLETE WITH 110v ELECTICAL MAIN FLOOR - FOR FUTURE GAS RANGE
Line22628	Note:
19Jun17 / 27Sep17	
Inv.1,442	1 - HUMIDIFIER: WB3 - 12
Line22630	Note:
19Jun17 / 27Sep17	

INTERIOR TRIM AND DOORS

Inv.1,442	1 - MAIN FLOOR: EXTENDED HEIGHT ARCHWAY (PRICE PER DOORWAY) - 96"
Line22631	Note:
19Jun17 / 27Sep17	

KITCHEN AND BATH CABINETRY

Inv.1,697	1 - KITCHEN CABINETRY: ADJUST UPPER ABOVE STOVE FOR 30" WIDTH MICROWAVE/FAN COMBO (otr)
Line25386	Note: Leave standard electrical - homeowner to change as required after closing Please install standard hood fan on cabinetry adjusted for otr.
21Dec17 / 15Feb18	

MISC.

Inv.1,442	1 - DO NOT INSTALL- TO BE REFUNDED- SIDE DOOR- HOME TO EXTERIOR- AS PER PLAN AND GRADE PERMITTING
Line22633	Note:
19Jun17 / 27Sep17	

Brampton Encore - 7R - 2 - 28-4 Elev.D ROSSINI OPT - OPT 4

Inv.1,442	1 - Purchaser has attended an appointment at the Decor Centre & has DECLINED any additional upgrades and accepts and acknowledges that there will be no further changes/additions/deletions to be made upon signing on June 19 2017.
Line22635	Note:
19Jun17 / 27Sep17	
Inv.1,442	1 - BONUS PACKAGE: \$5,000.00 (INCLUDING TAXES) WORTH OF UPGRADES FROM GOLD PARK HOMES DÉCOR CENTRE IS BEING **DEFERRED** TO THE COLOUR APPOINTMENT.
Line22637	Note:
19Jun17 / 27Sep17	
Inv.1,442	1 - Purchasers are aware & accepts that ANY changes made to upgrades after signing this Purchasers Extra Form are subject to a minimum administration fee of \$500. PLUS a 10% holdback fee.
Line22636	Note:
19Jun17 / 27Sep17	
Inv.1,688	1 - Purchaser has attended an appointment at the Decor Centre & has DECLINED any additional upgrades and accepts and acknowledges that there will be no further structural changes/additions/deletions to be made upon signing on December 14, 2017.
Line25290	Note:
14Dec17 / 15Feb18	
Inv.1,688	1 - Purchasers are aware & accepts that ANY changes made to upgrades after signing this Purchasers Extra Form are subject to a minimum administration fee of \$500. PLUS a 10% holdback fee.
Line25291	Note:
14Dec17 / 15Feb18	
Inv.1,688	1 - BONUS PACKAGE: \$5,000.00 (INCLUDING TAXES) WORTH OF UPGRADES FROM GOLD PARK HOMES DÉCOR CENTRE IS BEING APPLIED TOWARD THE STRUCTURAL APPOINTMENT. PURCHASER HAS A REMAINING AMOUNT OF \$00 (INCLUDING TAXES).
Line25292	Note:
14Dec17 / 15Feb18	

PLUMBING

Inv.1,442	1 - KITCHEN: ROUGH-IN - WATERLINE FOR FRIDGE
Line22632	Note:
19Jun17 / 27Sep17	
Inv.1,442	1 - HUMIDIFIER: WB3 - 12
Line24228	Note:
19Jun17 / 27Sep17	

PLUMBING FIXTURES

Inv.1,688	1 - MAIN BATH: CONTRAC 'CALVIN' OVAL UNDERMOUNT SINK #4220CFY
Line25288	Note:
14Dec17 / 15Feb18	
Inv.1,688	1 - MASTER ENSUITE: CONTRAC COLLETTE RECTANGULAR UNDERMOUNT SINK #4220CIY
Line25293	Note:
14Dec17 / 15Feb18	

STAIRS AND RAILINGS

Inv.1,688	1 - MAIN STAIRS: EUROLINE 1 + V GROOVE
Line25289	Note:
14Dec17 / 15Feb18	

WINDOWS - BASEMENT



CONSTRUCTION SUMMARY

Brampton Encore - 7R - 2 - 28-4 Elev.D ROSSINI OPT - OPT 4

Inv.1,442	2 - BASEMENT WINDOWS - UPGRADE EXISTING BASEMENT WINDOW TO 30 INCH X 24 INCH - MAY REQUIRE INSTALLATION OF WINDOW WELL
Line22634	Note: SEE PLAN FOR LOCATION
19Jun17 / 27Sep17	

WINDOWS AND DOORS

Inv.1,442	1 - MANDOOR- GARAGE TO EXTERIOR- GRADE PERMITTING
Line24230	Note:
19Jun17 / 27Sep17	

Purchaser: Athar Ahmad

Property: 7R

Telephone Res. / Bus: (647) 772-1908

Project: Brampton Encore - Phase 2

Decor Advisor: Yolande Somerville

Model and Elevation: 28-4 Elev.D ROSSINI OPT - OPT 4

Layout Changes: ☐ Yes ☒ No

Sketch Attached: ☒ Yes ☐ No

Exterior Colour Scheme:

1. Cabinetry

	Style and Colour	Counter	Hardware
Kitchen / Breakfast	Siena Oak 'Greystone'	Granite: Grigio Sardo FE20	cs1-23
Laundry Room	n/a	n/a	n/a
Powder Room	n/a	n/a	n/a
Master Ensuite Bathroom	Siena Oak 'Greystone'	*Granite: Black Pearl ✓ FE20	cs1-23
Second Ensuite Bathroom (If Applicable)	Siena Oak 'Greystone'	*Granite: Black Pearl ✓ FE20	cs1-23

Comment

2. Floor Tile

	Selection
Entrance Vestibule	*12x24" Heritage 'Gris' Matte upg 2
Main Hall	n/a
Kitchen / Breakfast	*12x24" Heritage 'Gris' Matte upg 2
Laundry Room	n/a
Powder Room	13x13" Serpentine 'Beyaz-White'
Master Ensuite Bathroom	13x13" Serpentine 'Beyaz-White'
Second Ensuite Bathroom (If Applicable)	13x13" Serpentine 'Beyaz-White'
Lower Landing (If Applicable)	

Comment

3. Wall Tile

	Selection	Listello/Inserts	Describe
	N/A	☐ Yes ☒ No	
Master Ensuite Bathroom			
Tub Deck	8x10" Weave 'White'	☐ Yes ☒ No	
Shower Stall	n/a	☐ Yes ☒ No	
Bathroom Walls	n/a	☐ Yes ☒ No	
Second Ensuite Bathroom (If Applicable)	8x10" Reflection 'White'	☐ Yes ☒ No	
		☐ Yes ☒ No	
Kitchen Backsplash	☒ Yes ☐ No	Backsplash Behind Fridge	none

Comment

Backsplash: Glass Mosaic #KV.CR.GRY.0,6X1.9BL

Purchaser: Athar Ahmad
Telephone Res. / Bus: (647) 772-1908
Decor Advisor: Yolande Somerville

Property: 7R
Project: Brampton Encore - Phase 2
Model and Elevation: 28-4 Elev.D ROSSINI OPT - OPT 4

4. Plumbing Fixtures

☐	Second Ensuite	☐	Powder Room	☐
Master Ensuite Bathroom ☐	Other Room - Specify ☐	☐	Other Washroom	☐

Comment

Standard Except bathroom sinks

5. Hardwood Flooring

Main Hall	Type and Stain Standard 'Natural'	Upper Landing	Type and Stain n/a
Kitchen / Breakfast	n/a	Upper Hall	n/a
Living Room	n/a	Master Bedroom	n/a
Dining Room	Standard 'Natural'	Bedroom #2	n/a
Family Room	Standard 'Natural'	Bedroom #3	n/a
Den/Library	n/a	Bedroom #4	n/a
Entrance Vestibule	n/a	Bedroom #5	n/a
Lower Landing (If Applicable)	n/a	Other Room - Specify	

Comment

6. Carpeting

	Upgrade	Description
Ground Floor	☐	
Second Floor	☐	STD: 'Beige Marble'
	☐	

Upgrade Underpad	Type 	Area
Carpet on Stairs	Capped 	Runner - *Upgrade

Comment

7. Fireplace

	Living Room			Family Room			Other Room - Specify		
	Purchased	As Per Plan	N/A	Purchased	As Per Plan	N/A	Purchased	As Per Plan	N/A
Fireplace Type	☐	☐	☒	☐	☒	☐	☐	☐	☒
Mantle Type				Standard Gas					
Colour / Stain				Standard NF-20					
Surround				Standard White					
Hearth				Standard Nero Marquina					
				none					

Comment



Purchaser: Athar Ahmad

Property: 7R

Telephone Res. / Bus: (647) 772-1908

Project: Brampton Encore - Phase 2

Decor Advisor: Yolande Somerville

Model and Elevation: 28-4 Elev.D ROSSINI OPT - OPT 4

8. Trim Carpentry

Interior Doors Front Door Glass Inserts Door Handles

Interior Trim

Comment

9. Plaster Mouldings and Medallions

Standard Throughout ☐ Yes ☐ No ☒ N/A

Entrance Vestibule			Kitchen/Breakfast		
Main Hall			Den/Library		
Living Room			Lower Landing		
Dining Room			Other Room - Specify		
Family Room					

Comment

10. Railings and Spindles

Railing Package ☒

Railing Colour

Stringer / Riser

Spindle Colour

Treads

Oak Stairs ☒ Yes ☐ No ☐ N/A

Comment

11. Wall Paint / Ceilings

Throughout Finished Areas

Trim Paint

Smooth Ceilings

Ground Floor ☐

Second Floor ☐

Note

Comment



Purchaser: Athar Ahmad
Telephone Res. / Bus: (647) 772-1908
Decor Advisor: Yolande Somerville

Property: 7R
Project: Brampton Encore - Phase 2
Model and Elevation: 28-4 Elev.D ROSSINI OPT - OPT 4

12. Electrical

Hood Fan ☐ White ☒ Stainless ☐ N/A

Above Kitchen Cabinet Light ☐ Yes ☒ No

Below Kitchen Cabinet Light ☐ Yes ☒ No

Standard Appliances ☒

Over The Range Microwave ☐

Chimney Style Fan ☐

Comment

Standard 30" Slide in Range (no specs provided)

13. Heating and Air Conditioning

Air Conditioning

Gas Provisions Stove

Gas Provisions Dryer

Gas Provisions Barbecue


Comment

14. Additional Comments

15. Disclaimers and Notes

- 1) Colours of all materials are as close as possible to builder's selection, but not necessarily identical due to variances in manufacturing.
- 2) Any extras listed above are null and void unless accompanied by a separate invoice/amendment. Said invoice must be paid in full.
- 3) The Purchaser acknowledges that after Interior Colour Selection form is signed and dated, no further changes will be permitted other than re-selection due to unavailability. _____ Purchaser's Initials
- 4) The Purchaser acknowledges reading and accepting the "Gold Park Homes Decor Centre Disclaimers" form. This document contains other miscellaneous disclaimers.

This Interior Colour Selection is final and approved by:

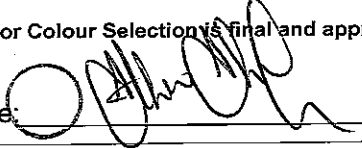Signature:  Date: _____

BEZ-7R
DEC 14 2017


The Rossini SEMI SERIES

Elevation A • 1,911 sq.ft.
Elevation B • 1,902 sq.ft.
Elevation C • 1,966 sq.ft.
Elevation D • 1,971 sq.ft.


KITCHEN
TILE DIRECTION

A → Taller Archway


O → Std light
relocated to
above island

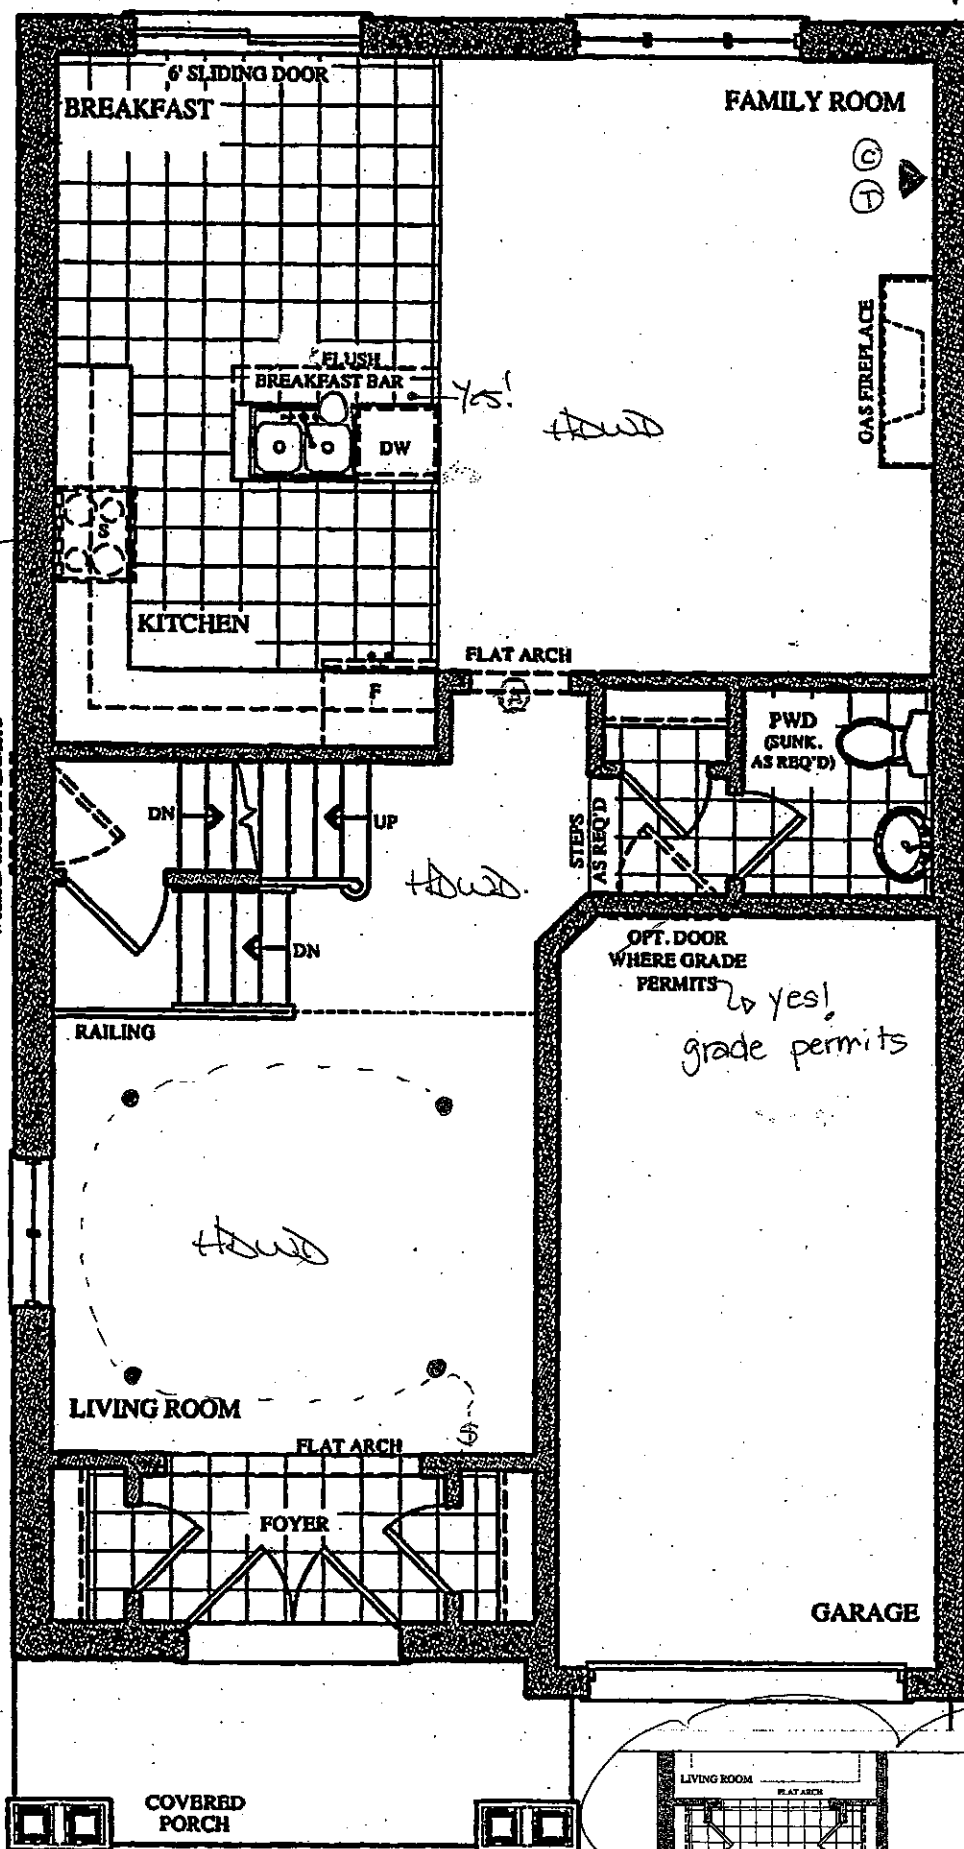

GROUND FLOOR PLAN
ELEV. 'A' & 'B'

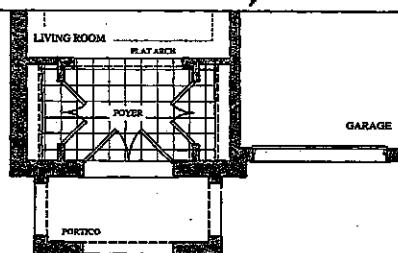

PART. GROUND FLOOR PLAN
ELEV. 'C' & 'D'

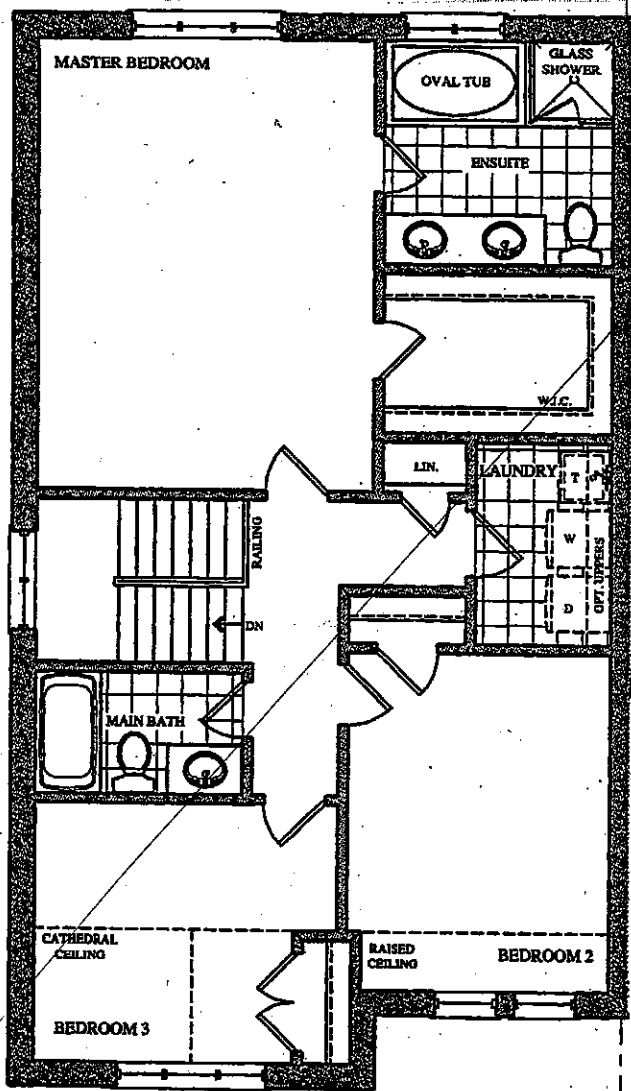


SECOND FLOOR PLAN
ELEV. 'A'


BEZ-7R
DEC 14 2017

The Rossini SEMI SERIES


Elevation A • 1,911 sq.ft.
Elevation B • 1,902 sq.ft.
Elevation C • 1,966 sq.ft.
→ Elevation D • 1,971 sq.ft.

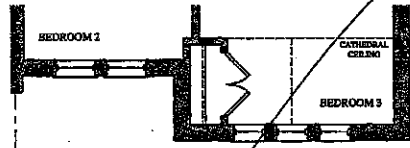


PART. SECOND FLOOR PLAN
ELEV. 'B'

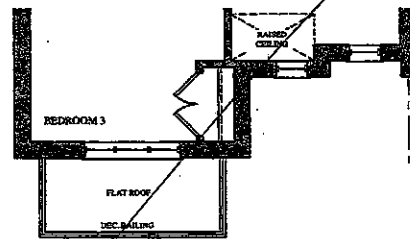


PART. SECOND FLOOR PLAN
ELEV. 'C'

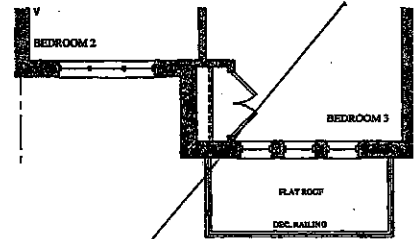


PART. SECOND FLOOR PLAN
ELEV. 'D'

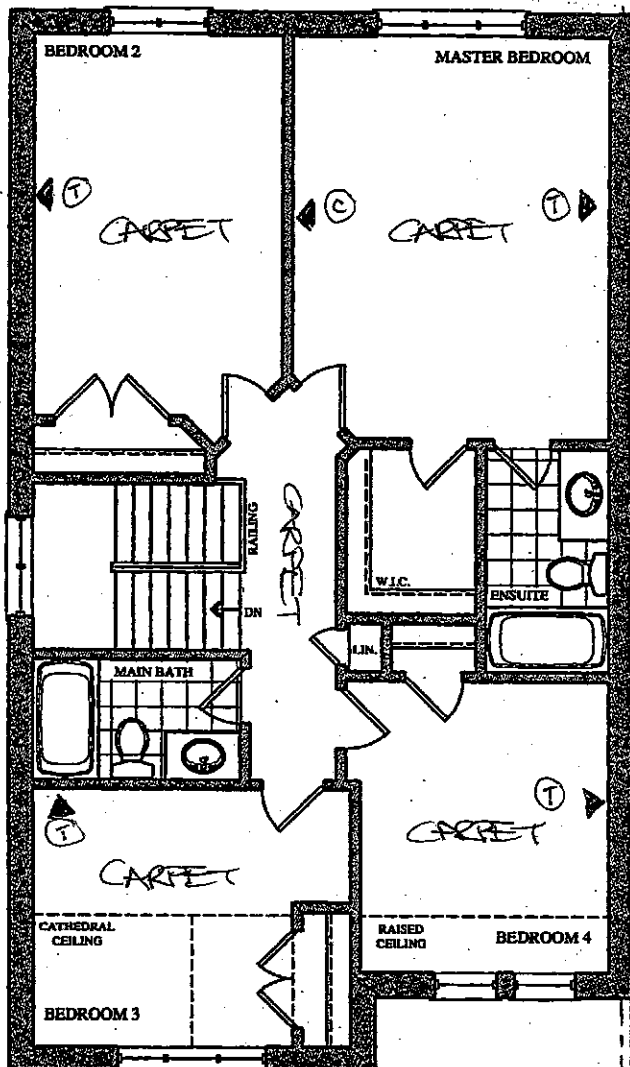


OPT. SECOND FLOOR PLAN
ELEV. 'A'

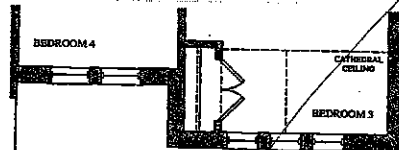

PART. OPT. SECOND FLOOR PLAN
ELEV. 'B'

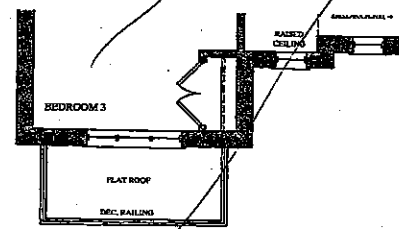

PART. OPT. SECOND FLOOR PLAN
ELEV. 'C'

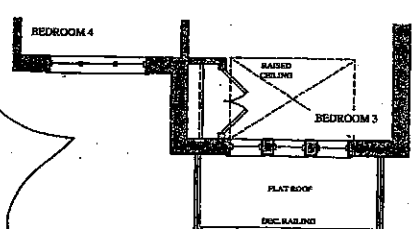



PART. OPT. SECOND FLOOR PLAN
ELEV. 'D'

Rossini

SEMI SERIES

BE2-7R
DEC 14 2017 ①

Elevation A • 1,911 sq.ft.
Elevation B • 1,902 sq.ft.
Elevation C • 1,966 sq.ft.
→ Elevation D • 1,971 sq.ft.

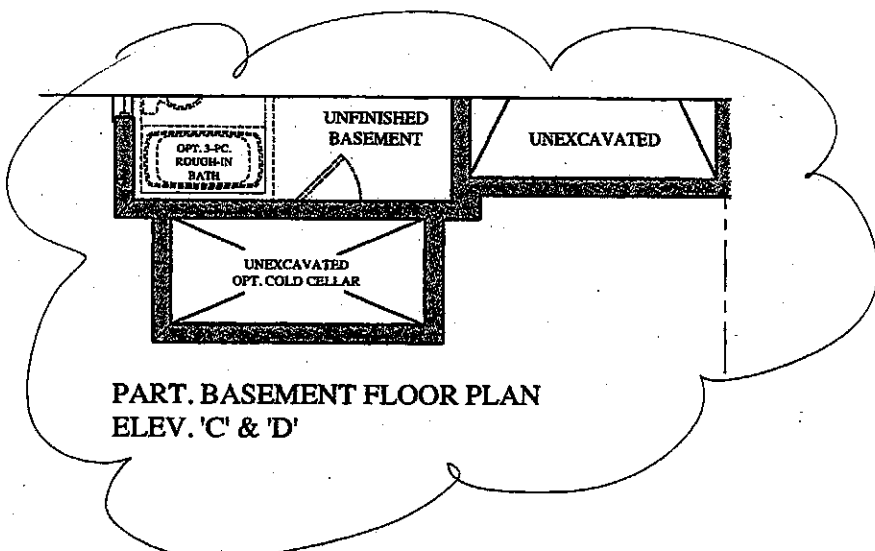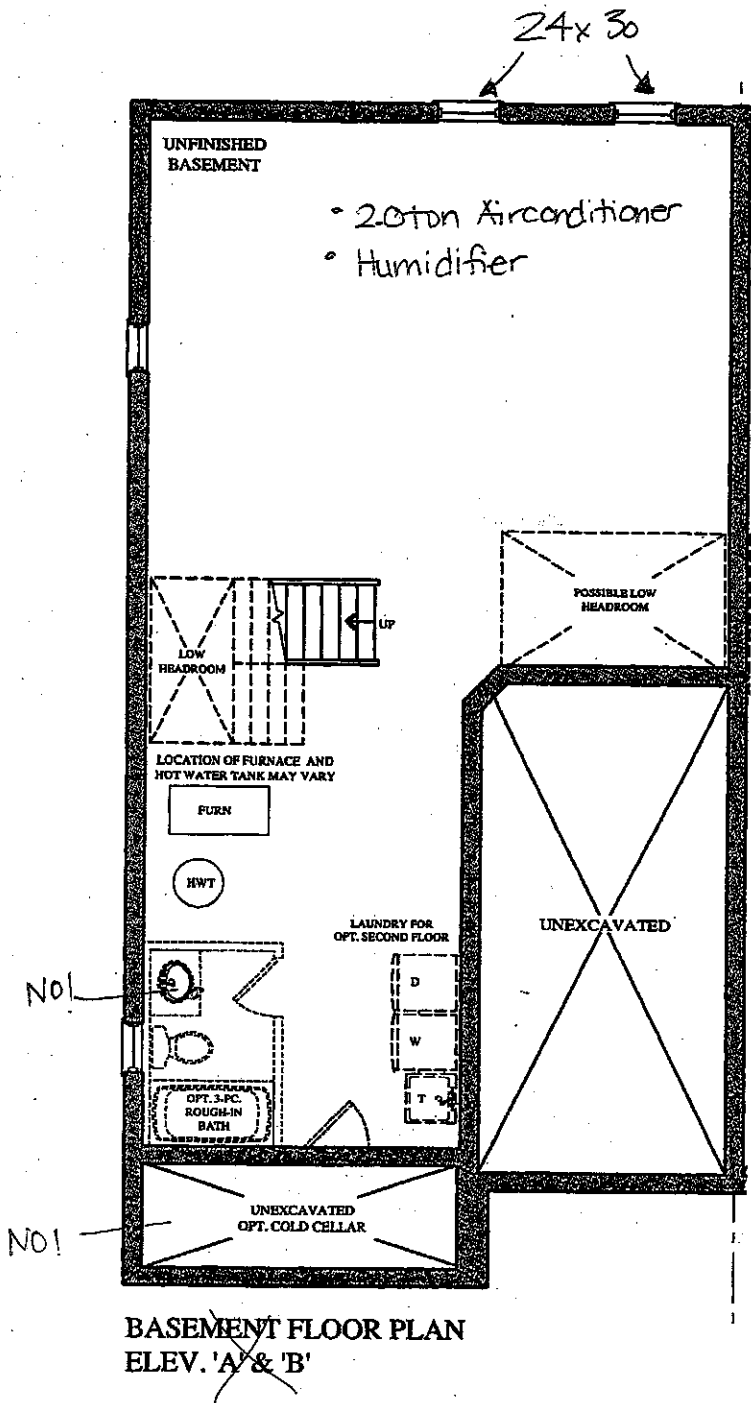

BEZ-7R
DEC 14 2017

QUOTATION

Date: 06/23/16

Trade Name: Gold Park Homes

Site location: Brampton





Model: SD-4

Address:




Project: Encore

Phase:

This layout has been explained to the purchaser by Cortina Kitchens Inc. and is understood by the purchaser.

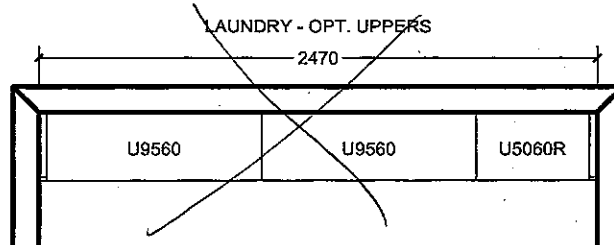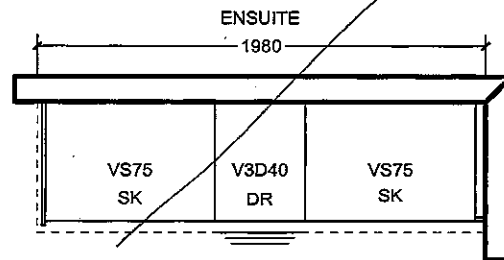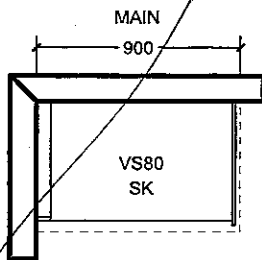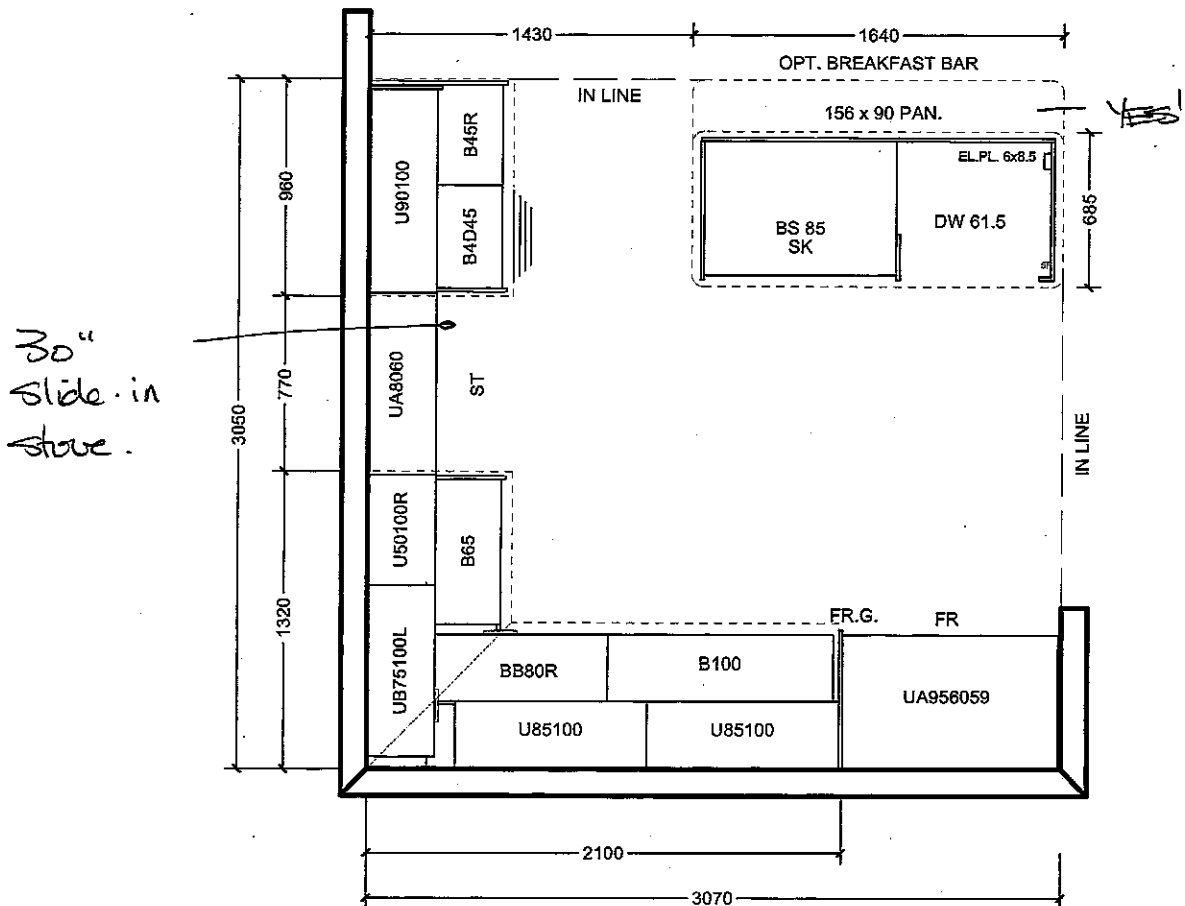

OPT. SECOND FLOOR

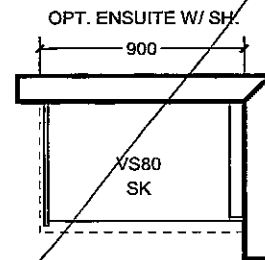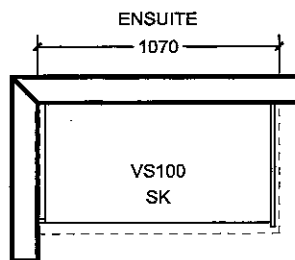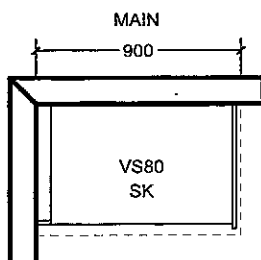All prices subject to confirmation from head office.
This quotation is subject to the terms & conditions set out
in Cortina's Agreement of Purchase and SaleAll agreements are contingent upon strikes, accidents, and delay beyond our control.
Please provide our installer with template for sinkholes or \$150.00 will be charged for callback.

ACCEPTED DATE: _____


CUSTOMER SIGNATURE

SALESPERSON SIGNATURE


CORTINA HEAD OFFICE APPROVAL

ITEM A. Wood grain and colour are characteristics of the product, we cannot guarantee that such grain and colour will always match
ITEM B. Cortina Kitchens reserves the right to alter dimensions and make technical changes without notice.

STANDARD HARDWARE

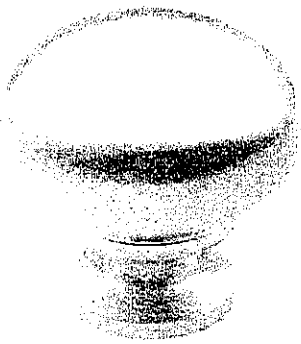BE2-7R
DEC 14 2017


CSI-6

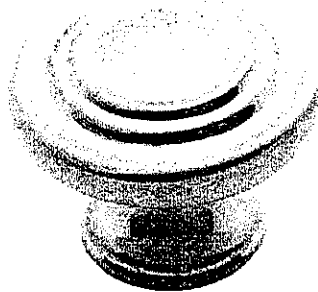

CSI-10




CSI-14

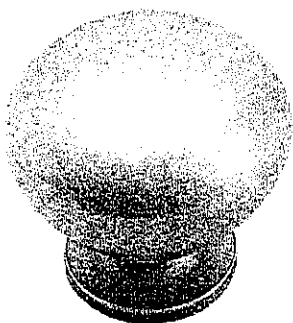


CSI-16




CSI-18

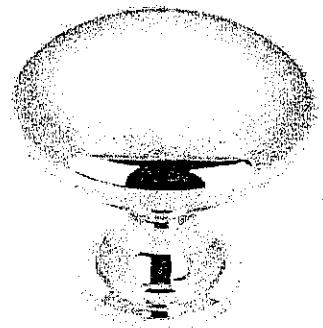


CSI-19

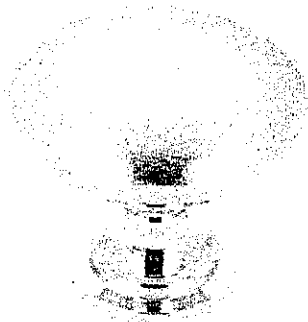


CSI-20

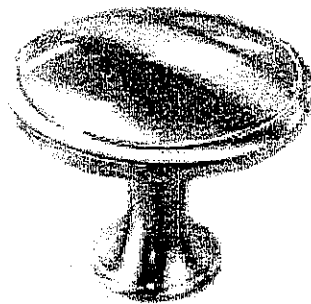


CSI-21

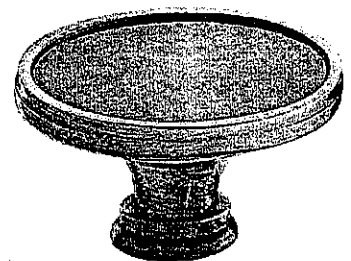


CSI-22

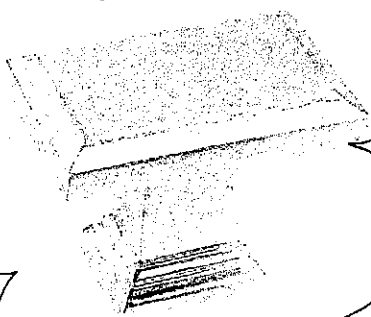

CSI-23

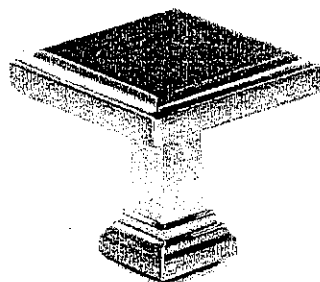THRU
OUT

CSI-24

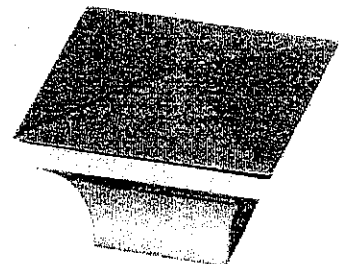

CSI-25

***NOTES:**

- IMAGES ARE FOR QUICK REFERENCE PURPOSES ONLY
- ACTUAL SIZES AND FINISHES AS PER HARDWARE SAMPLE BOARD PROVIDED TO DECOR CENTRE

GOLDPARK

WORTH MORE™



Granite, Marble,
Engineered Surfaces


- Standard 2CM & 3CM
- ⊖ Upgrade 1 2CM & 3CM
- ⊗ Upgrade 1 4 CM
- Upgrade 2

~~FE2-7R~~
DEC 14 2017


20 mm (3/4") Profiles



30mm (1-1/4") Profiles

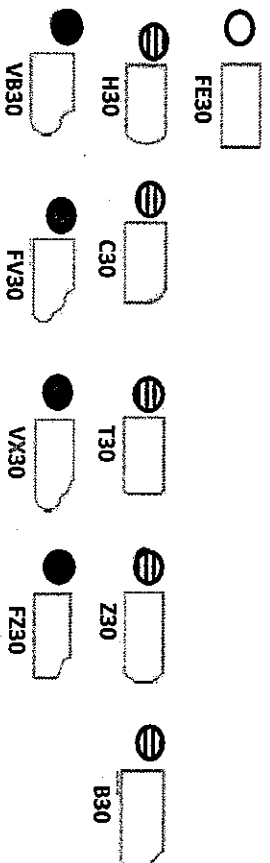

40mm (1-1/2") Profiles

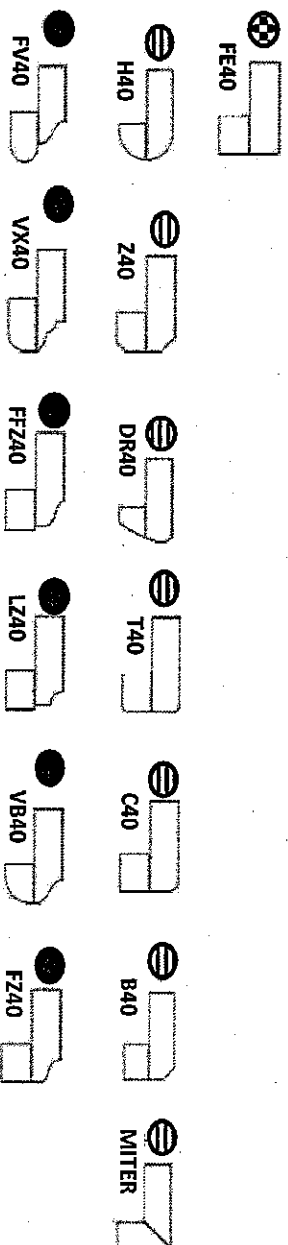

Note: All colours may not be available in 30mm at time ordered. Vendor reserves the right to use 40 mm edges (by lamination process).

*Mitre edge is available in Upgrade 1 for an overall thickness of 2". All other Mitre edge options will be an Upgrade 2 Edge.

Gold Park Homes Décor

GOLDPARK
WORTH MORE™

Centre Disclaimers

Through years of doing business, we at Gold Park Homes have encountered issues beyond our control. The following disclaimers apply to all instances of Purchaser's Extras forms and all Interior Colour Scheme forms.

FIREPLACES

Fireplace Marble: Due to the many variables that can affect the pattern and/or design, frequently the marble installed on the fireplace will not be identical to the samples. We will make every attempt to come as close to the samples as possible, but cannot be responsible for results which differ from the samples.

CERAMIC FLOOR TILE

Many variables including variegation can affect tile colour, pattern and/or design which mean installed tiles may not be identical to the samples. We will make every attempt to come as close as possible, but cannot be responsible for results which differ from the samples.

HARDWOOD FLOORING

The purchaser is advised that cupping and shrinkage are characteristics of hardwood flooring normally appearing after installation, especially when humidity levels are not regulated, and no warranty is provided by the flooring supplier with respect to such cupping and shrinkage. Furthermore, hardwood floors may also heave and warp when located at or close to entrance points of the home, where rain could make its way to the flooring. The vendor agrees to install any hardwood flooring ordered by the purchaser in a good and workmanlike manner, but shall not be responsible for, and is hereby released by the purchaser from responsibility and liability for cupping, shrinkage, heaving and warping of hardwood flooring in the above mentioned circumstances.

STAIRCASE VS FLOORING

WOOD SPECIES DIFFERENCE

The purchaser is aware and therefore accepts and acknowledges that the wood species of the staircase and flooring chosen do not match. This difference might result in an undesirable colour variance.

The purchaser is aware and therefore accepts and acknowledges that though the flooring is of the same species as the staircase the difference in product finishing may result in a stain colour variance.

The purchaser agrees that the vendor is to be exempt from any and all claims by the purchaser regarding this colour variance.

RAILINGS

All railings, pickets, posts, nosing's and stairs come from solid wood and veneered wood materials sourced from multiple locations and sources. As such there will be variations in grains and shades between the various natural components beyond our control. Due to this variance in material, all components will stain with colour or natural finish differently.

Iron pickets are wrought in nature and depending on the manufacturing process will have differences from picket to picket which is normal. Also the finish of the iron pickets is of a powder coated nature. This process can produce minor colour variations or tones. Furthermore, the assembly of the metal pickets can develop a natural rattle over time from vibration in the railing. Minor rattling is normal and is a part of the wrought iron picket assembly.

HOUSE EXTERIORS

Variations in subcontractors across different sites and varying site conditions may result in house exteriors that differ from the artist renderings. We cannot be responsible for results which differ from the artists renderings of elevations.

PLASTER MOULDINGS AND MEDALLIONS

Plaster mouldings will not be installed in open to above areas or areas with 2 storey elements.

STAIN COLOURS

Due to the many variables that can affect the outcome of a stain colour on wood, staircases, railings, and fireplaces, the colour may not be identical to samples. Factors such as density, age, humidity, air temperature, and the uniqueness of each piece of wood can result in wide variations in darkness or lightness. We will make every attempt to come as close to the sample as possible, but cannot be responsible for results which differ from the samples.

Stain on pre-finished hardwood floors will not be an exact match to the stain colours available on stairs, pickets and rails. The purchaser is responsible for choosing the stain on these areas to their satisfaction.

IN-WALL CONDUIT FOR AUDIO/VIDEO CABLES

It is important to note that due to the variation in framing requirements in different parts of your home, conduit lengths and routing can vary. In virtually all instances of ground floor installation (i.e. above a fireplace), conduit will first travel down into the basement below the floor joists, over to the termination point and back up into the main floor. As a result, it is best to measure the length of the conduit after occupancy with a "pull wire" before



purchasing your cables. For above-fireplace installations, the conduit wall plate will be installed approximately 10" above the Fireplace Mantle, unless otherwise specified in the Construction Summary.

APPLIANCE SPECIFICATIONS

All appliance openings are set to builder's standard openings. Please advise Décor Centre at time of your structural appointment if custom sizing of cabinets is required for any built - in appliances. The purchaser is responsible for costs and fees associated with changes to pre-manufactured kitchens made subsequent to colour appointments.

Purchaser accepts & acknowledges that in order to accommodate upgraded appliances, all appliance specifications should be provided at the time of their structural appointment, should this not occur they must be provided to the Décor Center within one (1) week of completion of structural chart. Failure to do so may result in the need to revert to the standard appliance openings or in a delay in construction of your dwelling, as well as a cost of \$500 to re-open your structural file should changes be required. As a result we may be forced to extend the closing of your transaction. Due to failure to complete the above-mentioned selections and at no fault of our own, we reserve our right to hold you responsible for this delayed closing, including charging extra administration cost and interest on the balance due on closing.

 Purchasers Accept Standard Appliance Openings (unless otherwise specified):

Fridge - 37-1/2"W x 73-1/2" High Approx.

Range - 30-1/2"D x 31-1/2"W Approx.

Dishwasher - 24" W Approx.

DELETION OF HOODFAN & CABINETS ABOVE STOVE:

The purchasers are aware that in requesting NOT TO INSTALL builder's standard hood fan and standard cabinets above stove they will receive NO STANDARD HOOD FAN and NO CREDIT. Purchasers are installing their own hood fan after closing and accept that it may waive any warranty associated with such a change.

Purchasers accept and acknowledge that the exhaust fan duct hole may be off-centered with the stove in the kitchen due to purchasers installing their own hood fan after closing. The vendor is exempt from adjusting such openings for the purchasers range hood.

ELECTRICAL FOR APPLIANCES

Pricing is subject to change based on the appliance specifications provided. Purchasers should provide proper appliance specifications and cut-out sheets in order for Gold Park to price extras accordingly.

KITCHEN CABINETS

The kitchen you order/purchase will undoubtedly contain slight colour variations. The degree of these variations is virtually impossible to determine before the kitchen is installed in its intended location. The amount of and type of lighting will also affect various highlights in the finish. Note: No two pieces of wood are identical. Variations in colour tone and grain patterns make a perfect colour match virtually impossible. It is generally agreed that these variations add to the natural beauty of a wood kitchen.

STAIN

Charcoal is a spray stain applied to Oak and Maple products with several characteristics that are important to be aware of when purchasing this product.

1. Shadow lines may be visible at the interior profile edges of a door or drawer front. If movement occurs shadow lines may increase or decrease, depending on the style and/or size of a door or drawer front.
2. Variation and unevenness may be visible in the finish.
3. Hairline cracks at the joints are created over time due to the nature of natural wood, caused by usage, humidity**, or dryness. They tend to be more visible to darker stains, than lighter wood stains.

** Relative humidity is recommended to be between 45% and 55%. Please refer to Cortina Kitchens "Cleaning, Care, Maintenance, & Warranty Information" guide.

Please be advised that Cortina Kitchens will not replace doors and/or parts that exhibit the above characteristics associated with this finish. These characteristics are not avoidable and are a result of the natural characteristics of wood and wood veneer, and the characteristics of darker stains on wood. The Charcoal stain is not available on doors in Group IV, Group IVA, Group V and Group VA.

Cortina Kitchens offers a wide variety of finishes, applied to oak and maple products. The subject finishes include the spray stains Cocoa, Espresso, Graphite as well as wiping stain Ebony.

Due to the very dark stains applied on natural maple and oak doors and joints, several characteristics are important to be noted when purchasing these products.

1. Shadow lines may be visible at the interior profile edges of a door or drawer front. If movement occurs shadow lines may increase or decrease, depending on the style and/or size of a door or drawer front.
2. Variation and unevenness may be visible in the finish.
3. Hairline cracks at the joints are created over time due to the nature of natural wood, caused by usage, humidity, or dryness. They tend to be more visible to darker stains, than lighter wood stains.

Please be advised that Cortina Kitchens will not replace doors nor parts that exhibit the above characteristics associated with this finish. These characteristics are not avoidable and are a result of the natural characteristics of wood and wood veneer, and the characteristics of darker stains on wood.



CABINETRY DOOR HARDWARE

Cortina Kitchens' cabinetry doors and drawer fronts will be drilled to accept a standard knob or handle selected from Cortina's hardware boards. This drilling comes standard with the order, and is done ONLY in our shop, not on the job site.

For those not wanting Cortina's hardware drilling, the following applies:

No holes to be drilled on the doors and drawer fronts should be specified in writing on the colour chart and the P.O. If while in production, Cortina Kitchens misses this request, Cortina Kitchens and the Builder will not be held responsible to replace any or all doors and drawer fronts affected, and the customer agrees to accept the product as is. No hardware will be supplied or credited by Cortina Kitchens with this request. No charge will apply for this request.

PVC DOORS

All cabinets with PVC (Thermofoil) Doors come with melamine gables, panels and kick.

The doors, crown moulding and light valance are PVC wrapped. Open shelves incorporated in design will only be available with melamine interiors. There will be variations in colour shades between the PVC parts (doors, crown and Light valance) and the melamine parts (open shelves, Gables, Panels and Kick) due to the difference in material.

Furring Panel with crown moulding to the ceiling is not available on all PVC door styles due to subtle variations in colour shades between the PVC parts (moulding) and the melamine parts (furring panel) due to the difference in material. Grain directions in wood grain pattern melamine, vary between the furring panel, crown moulding (horizontal) and the PVC doors (vertical).

GRANITE, MARBLE ENGINEERED SURFACES WAIVER

Granite and marble are naturally occurring products, and due to the many variables that can affect the pattern, colour and/or design and "pitting" of natural products slabs installed will not be identical to the samples displayed. We will make every attempt to come as close to the samples as possible, but cannot be responsible for results which differ from the samples. Every effort is made to provide granite counter tops as close as possible but the vendor is not responsible for results which differ from the sample displayed. All countertop surfaces may have seems & product pattern & shade can change in areas containing seems.

RESELECTIONS

It is not uncommon for flooring, such as tile, to become discontinued prior to its installation. Therefore it may be necessary to make a reselection of certain materials sometime during the build process. We cannot assure you that another choice approximating your selection will be available.

PLANS

Plans are subject to change without notice. Actual usable floor space may vary from the stated floor area. Layout for kitchen, furnace, HWT and laundry tub may vary from plan. Vertical and horizontal bulkhead, which are not shown on plan, may be required for plumbing and heating runs. E.& O.E.

PLEASE NOTE:

In the event the work on the house has progressed beyond the point where the items covered by these invoices cannot be installed without entailing any unusual expense, then this order is to be cancelled and any deposit paid in connection with the same is to be refunded to the purchaser.

The vendor will undertake to incorporate the work covered by the sales extra in the construction of the house but will not be liable to the purchaser in any way, if for any reason the work covered by the extra is not carried out. In that event, any monies paid in connection with the same shall be returned to the purchaser.

It is understood and agreed that if for any reason whatsoever the transaction of Purchase and Sale is not completed, the total cost of extras ordered are not refundable to the Purchaser(s).

Extras or changes will not be processed unless signed by the Vendor.

These extras may not be amended without the written consent of Gold Park Homes.

The purchaser(s) and the builder acknowledge and agree that this "Purchaser's Extra" form shall not be deemed to be part of the agreement of purchase and sale entered into between them, nor an addendum thereto.

No postdated cheques will be accepted.

No estimates or orders will be accepted once construction has commenced.

Should a refund be requested on any extras purchased, an 80% reimbursement of the purchase price will be given. (a \$50.00 minimum charge and a maximum \$250.00 charge will apply)

Estimates will only be considered when resubmitted on a signed Purchaser Extras form, accompanied by payment in full.

All prices are estimates only and may be subject to change. Should a change in price occur Gold Park Homes reserves the right to request from the purchaser an adjustment of the price or a refund limited to that item.

Purchasers are aware & accept that ANY changes made to upgrades after signing the Purchasers Extra Form are subject to a minimum administration fee of \$500. PLUS a 10% holdback fee.

Purchasers are aware that any request to add a percentage of upgrades from the purchaser's extras form will be processed only after the builder receives approval letter from the bank.




Please be advised that your failure to finalize your structural or colour selections may result in a delay in construction of your dwelling and we may have to extend closing of your transaction. Due to failure to complete the above-mentioned selections and at no fault of us, we reserve our right to hold you responsible for a delayed closing, including charging extra administration cost and interest on the balance due on closing.

Purchaser has attended a Colour appointment at the Decor Centre & has DECLINED any additional upgrades and accepts and acknowledges that there will be no further structural changes/additions/deletions to be made upon signing.

I hereby acknowledge reading and understanding the above copy and will not hold Gold Park Homes responsible for any issues in relation to above.

Purchasers Signatures

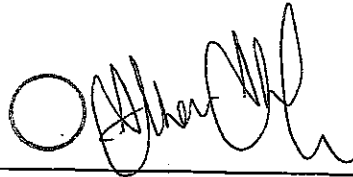

Date _____

BE2-7R