

#### **CONSTRUCTION SUMMARY**

# Brampton Encore - 13R - 2 - 28-3 Elev.D Bruckner ELECTRICAL

Inv.1,728	1 - KITCHEN: DELETE UPPERS ABOVE STOVE FINISH SIDES OF CABINETS - LEAVE APPROX. 36" OPENING FOR FUTURE 30" CHIMNEY-STYLE HOOD FAN- CLIENT TO SUPLY AFTER CLOSING
Line <b>25872</b>	Note:
30Jan18 / 8Feb18	

#### **Exterior Colours**

Inv.1,452	1 - EXTERIOR COLOUR PACKAGE # 4
Line <b>24233</b>	Note:
22Jun17 / 27Sep17	

#### **FRAMING**

Inv. <b>1,589</b>	3 - TALLER MAIN FLOOR ARCHES
Line <b>24234</b>	Note:
27Sep17 / 27Sep17	
Inv. <b>1,618</b>	1 - **NOTE:: FRAME MAIN FLOOR DOORS AT 96" - ADDED WITH THE ADDITION OF TALLER INTERIOR DOORS **INCLUDING GARAGE TO HOUSE DOOR**
Line <b>24428</b>	Note:
12Oct17 / 31Oct17	

#### **GRANITE MARBLE QUARTZ**

Inv.1,728	1 - KITCHEN ISLAND: ADD FLUSH BREAKFAST BAR
Line <b>25668</b>	Note:
30Jan18 / 8Feb18	
Inv. <b>1,728</b>	1 - KITCHEN: SLIDE-IN STOVE PREP
Line <b>25871</b>	Note:
30Jan18 / 8Feb18	

#### **HARDWOOD**

Inv.1,728	1 - MAIN FLOOR: FAMILY ROOM HARDWOOD: UPGRADE 4 VINTAGE 5" WHITE OAK HANDSCRAPED
Line <b>25669</b>	Note:
30Jan18 / 8Feb18	

#### INTERIOR TRIM AND DOORS

Inv.1,452	2 - MAIN FLOOR: EXTENDED HEIGHT ARCHWAY (PRICE PER DOORWAY) -96" ARCHWAYS
Line <b>22728</b>	Note:
22Jun17 / 27Sep17	
Inv. <b>1,589</b>	1 - MISSED ARCH ON PE:1452
Line <b>24235</b>	Note:
27Sep17 / 27Sep17	
Inv. <b>1,618</b>	4 - MAIN FLOOR: STANDARD DOOR EXTENDED HEIGHT 96" (PRICE PER DOOR)- GROUND FLOOR 2 STOREY MODELS
Line <b>24429</b>	Note:
12Oct17 / 31Oct17	

#### KITCHEN AND BATH CABINETRY

Printed and Sent: 08-Feb-18



### CONSTRUCTION SUMMARY

#### Brampton Encore - 13R - 2 - 28-3 Elev.D Bruckner

	Brampton Encore - 13R - 2 - 28-3 Elev.D Bruckner
Inv. <b>1,728</b>	1 - KITCHEN: SLIDE-IN STOVE PREP
Line <b>25664</b>	Note:
30Jan18 / 8Feb18	
Inv.1,728	1 - KITCHEN: DELETE UPPERS ABOVE STOVE, FINISH SIDES OF CABINETS - LEAVE APPROX. 36" OPENING FOR FUTURE 30" CHIMNEY-STYLE HOOD FAN
Line <b>25665</b>	Note:
30Jan18 / 8Feb18	
Inv. <b>1,728</b>	1 - KITCHEN: 2- TONE KITCHEN - UPPERS AND FRIDGE CABINETS TO BE LIGHT, BASE CABINETS (INCLUDING ISLAND) TO BE DARK
Line <b>25666</b>	Note:
30Jan18 / 8Feb18	
Inv. <b>1,728</b>	1 - KITCHEN: UPGRADE HARDWARE
Line <b>25667</b>	Note:
30Jan18 / 8Feb18	
	MISC.
Inv. <b>1,452</b>	1 - Purchaser has attended an appointment at the Decor Centre & has DECLINED any additional upgrades
26	and accepts and acknowledges that there will be no further changes/additions/deletions to be made upon signing on June 22 2017.
Line <b>22729</b>	Note:
22Jun17 / 27Sep17	
Inv. <b>1,452</b>	1 - Purchasers are aware & accepts that ANY changes made to upgrades after signing this Purchasers Extra Form are subject to a minimum administration fee of \$500. PLUS a 10% holdback fee.
Line <b>22730</b>	Note:
22Jun17 / 27Sep17	
Inv.1,452	1 - BONUS PACKAGE: \$5,000.00 (INCLUDING TAXES) WORTH OF UPGRADES FROM GOLD PARK HOMES DÉCOR CENTRE IS BEING APPLIED TOWARD THE STRUCTURAL APPOINTMENT. PURCHASER HAS A REMAINING AMOUNT OF \$3666.60 (INCLUDING TAXES) TO BE USED TOWARD THE COLOUR APPOINTMENT.
Line <b>22731</b>	Note:
22Jun17 / 27Sep17	
Inv.1,589	1 - BONUS PACKAGE: (\$3666.60) REMAINING LESS THIS NEW INVOICE \$330.00. PURCHASER HAS A NEW AMOUNT REMAINING OF \$3336.60
Line <b>24236</b>	Note:
27Sep17 / 27Sep17	
Inv.1,728	1 - Purchaser has attended an appointment at the Decor Centre & has DECLINED any additional upgrades and accepts and acknowledges that there will be no further structural changes/additions/deletions to be made upon signing on January 30, 2018.
Line <b>25672</b>	Note:
30Jan18 / 8Feb18	
Inv.1,728	1 - Purchasers are aware & accepts that ANY changes made to upgrades after signing this Purchasers Extra Form are subject to a minimum administration fee of \$500. PLUS a 10% holdback fee.
Line <b>25673</b>	Note:
30Jan18 / 8Feb18	
Inv.1,728	1 - BONUS PACKAGE: \$141.00 (INCLUDING TAXES) WORTH OF UPGRADES FROM GOLD PARK HOMES DÉCOR CENTRE IS BEING APPLIED TOWARD THIS APPOINTMENT. PURCHASER HAS A REMAINING AMOUNT OF \$00 (INCLUDING TAXES)
Line <b>25674</b>	Note:
30Jan18 / 8Feb18	

#### **PAINTING**

Printed and Sent: 08-Feb-18



#### **CONSTRUCTION SUMMARY**

#### Brampton Encore - 13R - 2 - 28-3 Elev.D Bruckner

Inv.1,728	1 - MAIN STAIRS: STAIN STAIRS	7
Line <b>25671</b>	Note: STAIRS WILL NOT MATCH HARDWOOD IN COLOUR, TEXTURE OR FINISH	
30Jan18 / 8Feb18		

#### STAIRS AND RAILINGS

Inv.1,728	1 - MAIN STAIRS: EUROLINE 1 + V GROOVE	
Line <b>25670</b>	Note: price approved by marcello jan 30 2018	
30Jan18 / 8Feb18		

#### **WINDOWS - BASEMENT**

Inv. <b>1,452</b>	2 - BASEMENT WINDOWS - UPGRADE EXISTING BASEMENT WINDOW TO 30 INCH X 24
	INCH - MAY REQUIRE INSTALLATION OF WINDOW WELL
I : 22726	
Line <b>22726</b>	Note:
22Jun17 / 27Sep17	
Inv. <b>1,618</b>	4 - BASEMENT WINDOWS: LIGHT COLOURED WINDOW FRAMES (TO MATCH REST OF
	HOUSE)
Line24427	Note:
Line24427	Note.
120-417 / 210-417	
12Oct17 / 31Oct17	
Inv. <b>1,618</b>	1 - **DELETE** ITEM 2 FROM PE #1452 'DARK COLOURED FRAME PREMIUM
	N. i
Line <b>24426</b>	Note:
12Oct17 / 31Oct17	
Inv. <b>1,618</b>	1 - BASEMENT WINDOWS - UPGRADE EXISTING BASEMENT WINDOW TO 30 INCH X 24
	INCH - MAY REQUIRE INSTALLATION OF WINDOW WELL
Line24431	Note:
DITION TO I	11010.
12Oct17 / 31Oct17	
120ct1//310ct1/	

#### WINDOWS AND DOORS

	31 AVEC HOME ARRANGE AND AND AND SAFE
Inv.1,452	1 - INSTALL MANDOOR- GARAGE TO HOUSE
Line <b>24232</b>	Note:
22Jun17 / 27Sep17	
Inv. <b>1,618</b>	1 - DOOR FROM HOUSE TO GARAGE: UPGRADE MANDOOR TO 96"
Line <b>24430</b>	Note:
12Oct17 / 31Oct17	

Page 3 of 3

Printed and Sent: 08-Feb-18

# GOLDPARK WORTH MORE

#### INTERIOR COLOUR SCHEME

\*\*\* NOTE: This is not an approved document. Document must be locked \*\*\*

Scheduled Closing Date: Wednesday, May 30, 2018

Purchaser:

Brandon Pires Pasisana

Property: 13R

Telephone Res. / Bus: (647) 456-4528

Project: Brampton Encore - Phase 2

ecor Advisor: Yoland	de Somerville N	Model and Elevation: 28-3 Elev.D Bruckner		
ayout Changes: O Yes	No Sketch Attached:	Yes No Exterior Colour Scheme:		
. Cabinetry	Style and Colour	Counter	Hardware	
Kitchen / Breakfast	**2-TONE KITCHEN	Granite: Grigio Sardo FE 20	*CH-51	
Laundry Room	n/a	n/a	n/a	
Powder Room	n/a	n/a	n/a	
Main Bathroom	P-400 pvc 'white crystal'	P-Lam # 4925k-07	cs1-23	
Master Ensuite			1.05	
Bathroom	M-500 melamine 'mystic' √	P-Lam # 4925k-07	cs1-25	
Second Ensuite Bathroom (If Applicable)	n/a	n/a	n/a	
n/a				
KITCHEN BASE CABINETS (INCL	LUDING ISLAND): M500 MELAMINE 'N	TISHC Y		
Floor Tile	Selection			
Entrance Vestibule	13x13" Serpentine 'Beyaz-wh	ite'		
Main Hall	13x13" Serpentine 'Beyaz-wh			
Kitchen / Breakfast	13x13" Serpentine 'Beyaz-wh	ite'		
Laundry Room	13x13" New Reeds 'Brown' 13x13" Serpentine 'Beyaz-white'			
Powder Room				
Main Bathroom	13x13" New Reeds 'Brown'			
Master Ensuite Bathroom	13x13" Serpentine 'Beyaz-white'			
Second Ensuite Bathroom (If Applicable)	n/a			
Lower Landing (If Applicable)	n/a			
n/a				
Comment . Wall Tile	Selection	Listello/Inserts Describe		
M. Ens Tub skirt/splash	8x10" Weave 'Tender Grey			
WARRING TO THE TAXABLE TO THE TAXABL	•			
Master Ensuite Bathroom				
Tub D	eck 8x10" Weave 'Tender Grey			
Tub Do Shower S	tall 8x10" Weave 'Tender Grey	Yes No		
Tub De Shower S Bathroom W	tall 8x10" Weave 'Tender Grey			
Tub Do Shower S Bathroom Wo Second Ensuite	tall 8x10" Weave 'Tender Grey	Yes No		
Tub De Shower S Bathroom W	8x10" Weave 'Tender Grey alls n/a	Yes No Yes No		
Tub De Shower S Bathroom W Second Ensuite Bathroom (If Applicable) Main Bathroom	alls n/a	Yes No Yes No Yes No		
Tub Do Shower S Bathroom Wa Second Ensuite Bathroom (If Applicable)	alls n/a n/a 8x10" Weave 'Tender Grey n/a 8x10" Uniwall 'White'	Yes No Yes No Yes No Yes No Yes No		

INTERIOR COLOUR SCHEME

\*\*\* NOTE: This is not an approved document. Document must be locked \*\*\*

Scheduled Closing Date: Wednesday, May 30, 2018

Scheduled Closing Date: Wednesday, May 30, 2018

Purchaser:	Brandon Pires Pasis	sana Pr	operty: 13R			
Telephone Res. / Bus:	(647) 456-4528	P	Project: Brampton Encore - Phase 2			
Decor Advisor: Yolande Somerville		Model and Ele	Model and Elevation: 28-3 Elev.D Bruckner			
4. Plumbing Fixtu	ıres					
		Second Ensuite	Powder	Room		
Master Ensuite Batl	hroom	Other Room - Specify				
		Cuter Room - opcony	Other W	<i>l</i> ashroom		
Comment Standard Plumbing Thru C	Out					
Standard Flumbling Tillu C	Jul					
5. Hardwood Floo	orina		,			
J. Hardwood Flot	Type and Stain		Type and	Stain		
Main Hall	n/a	Upper Land	100 E 0 E 0 C C C C C C C C C C C C C C C			
Kitchen / Breakfast	n/a	Upper Hall	n/a			
Living Room	n/a	Master Bedi	room n/a			
Dining Room	n/a	Bedroom #2				
	principles.					
Family Room	*5" Hand Scraped 'G	10-20-10-20-10-20-10-20-20-20-20-20-20-20-20-20-20-20-20-20				
Den/Library	n/a	Bedroom #4				
Entrance Vestibule	n/a	Bedroom #5				
Lower Landing (If Applicable)	n/a	Other Room	- Specify			
Comment						
* 5" Handecraper	Enameered : Vin	tage Gotham white Oak *				
110.000				5		
6. Carpeting	Upgrade	Description				
<b>Ground Floor</b>						
Second Floor		Standard 'Pearl White'				
	Туре		Area			
Upgrade Underpad						
Capped			Runner - *Upgrade			
Carpet on Stairs						
Comment						
Standard Underpad						
7. Fireplace	ving Room	Family Room	O	ther Room - Specify		
L	Purchased As Per Plan	N/A Purchased As Per		Purchased As Per Plan N/A		
	0 0		0	0 0		
Fireplace Type		Standard Gas				
Mantle Type		NF-23				
Colour / Stain		White				
Surround		Nero Marquina				
Hearth		none				
Comment						
				(38)		

#### INTERIOR COLOUR SCHEME

GOLDPARK
WORTH MORE\* \*\*\* NOTE: This is not an approved document. Document must be locked \*\*\*

Scheduled Closing Date: Wednesday, May 30, 2018

Purchaser:

Brandon Pires Pasisana

Property: 13R

Telephone Res. / Bus: (647) 456-4528

**Decor Advisor:** 

Yolande Somerville

Project: Brampton Encore - Phase 2

Model and Elevation: 28-3 Elev.D Bruckner

nterior Doors St	andard	Front	Door Glass Insert	s Standard	Door Handl	<b>es</b> Standar	d
nterior Trim St	andard						
omment							
					- Vigotha-		
Plaster Mould	dings and	d Medallion	s				
Standard Through			● N/A				
intrance Vestibul	е			chen/Breakfast			
lain Hall				n/Library			
iving Room				wer Landing			
Dining Room			Oth	ner Room - Specify			
amily Room							
Comment							
					4.		
,	-						
Railing Package	d Spindle *Euroline 1 + V *Graphite			Spindle Colour	*Black		
Railing Package Railing Colour	*Euroline 1 + V			Spindle Colour Treads	*Black		
Railing Package Railing Colour Stringer / Riser	*Euroline 1 + V *Graphite			SHOW THE STATE OF		○ No	○ N/A
. Railings and Railing Package Railing Colour Stringer / Riser Comment	*Euroline 1 + V *Graphite			Treads	*Graphite		○ N/A
Railing Package Railing Colour Stringer / Riser	*Euroline 1 + V *Graphite			Treads	*Graphite		○ N/A
Railing Package Railing Colour Stringer / Riser	*Euroline 1 + V *Graphite			Treads	*Graphite		○ N/A
Railing Package Railing Colour Stringer / Riser Comment	*Euroline 1 + V *Graphite *Graphite			Treads	*Graphite		○ N/A
Railing Package Railing Colour Stringer / Riser Comment  Wall Paint /	*Euroline 1 + V *Graphite *Graphite	Groove		Treads	*Graphite		○ N/A
Railing Package Railing Colour Stringer / Riser Comment  Wall Paint /	*Euroline 1 + V *Graphite *Graphite	Groove		Treads	*Graphite		○ N/A
Railing Package Railing Colour Stringer / Riser Comment  Wall Paint /	*Euroline 1 + V *Graphite *Graphite	Groove		Treads	*Graphite		○ N/A
Railing Package Railing Colour Stringer / Riser Comment Wall Paint / Throughout Finis	*Euroline 1 + V *Graphite *Graphite	Groove		Treads	*Graphite		○ N/A
Railing Package Railing Colour Stringer / Riser Comment Wall Paint / Throughout Finis	*Euroline 1 + V *Graphite *Graphite  Ceilings hed Areas	Groove		Treads	*Graphite		○ N/A
Railing Package Railing Colour Stringer / Riser	*Euroline 1 + V *Graphite *Graphite  *Graphite  Ceilings hed Areas	Groove		Treads	*Graphite		○ N/A
Railing Package Railing Colour Stringer / Riser Comment  Wall Paint / Throughout Finis  Trim Paint Smooth Ceilings	*Euroline 1 + V *Graphite *Graphite  *Graphite  Ceilings hed Areas  White	Groove		Treads	*Graphite		○ N/A
Railing Package Railing Colour Stringer / Riser Comment  Wall Paint / Throughout Finis  Trim Paint Smooth Ceilings Ground Fl	*Euroline 1 + V *Graphite *Graphite  *Graphite  Ceilings hed Areas  White	Groove		Treads	*Graphite		○ N/A



#### INTERIOR COLOUR SCHEME

\*\*\* NOTE: This is not an approved document. Document must be locked \*\*\*

Scheduled Closing Date: Wednesday, May 30, 2018

Purchaser:


Brandon Pires Pasisana

Property: 13R

Telephone Res. / Bus: (647) 456-4528

Project: Brampton Encore - Phase 2

Telephone Res. / Bus. (04/) 450-4520	Madel and Elevetters 20.3 Elev D. Drustunes
Decor Advisor: Yolande Somerville	Model and Elevation: 28-3 Elev.D Bruckner
12. Electrical  Hood Fan	Above Kitchen Cabinet Light Yes No Below Kitchen Cabinet Light Yes No
13. Heating and Air Conditioning Air Conditioning Gas Provisions Dryer Comment	Gas Provisions Stove Gas Provisions Barbecue
14. Additional Comments	
15. Disclaimers and Notes	
	ction, but not necessarily identical due to variances in manufacturing.
Any extras listed above are null and void unless accompanied by     The Purchaser acknowledges that after Interior Colour Selection than re-selection due to unavailability Purchas	form is signed and dated, no further changes will be permitted other
	Park Homes Decor Centre Disclaimers" form. This document contains
This Interior Colour Selection is final and approved by:	
Signature: Date:	

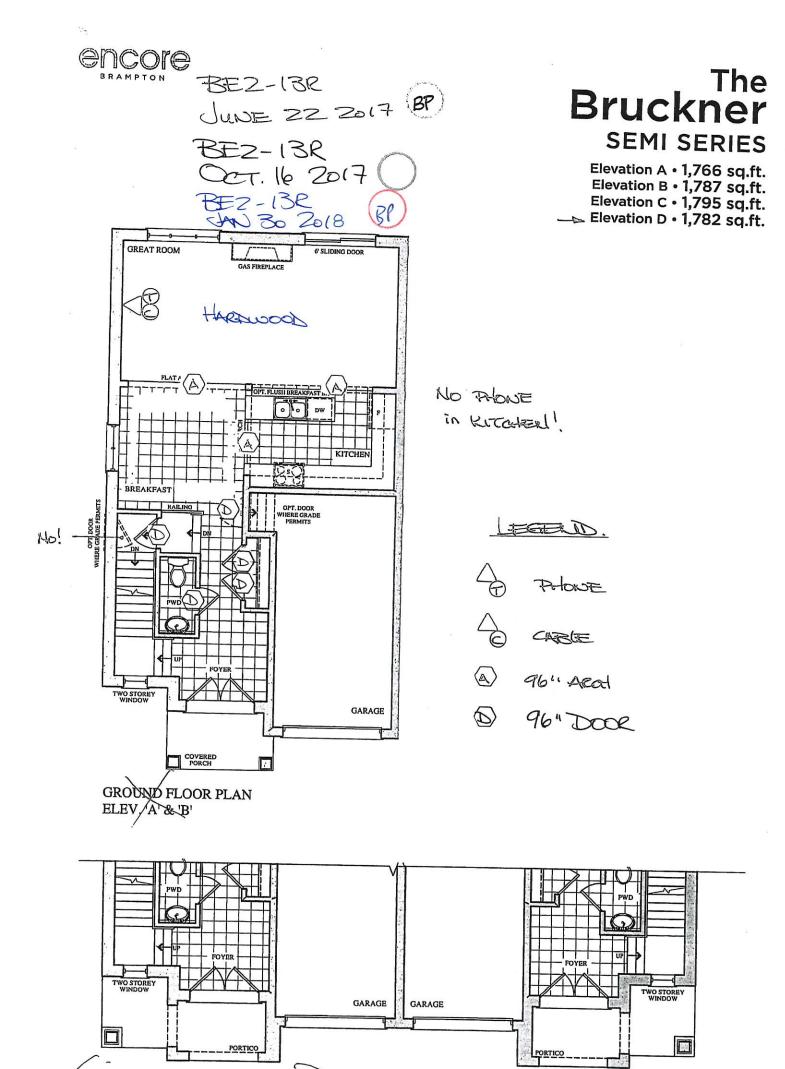

PART. GROUND FLOOR PLAN


ELEV. 'C' & 'D'




BEZ-13R JUNE 22 2017 BP) BEZ-13R OCT. 16 2017 ( BEZ-13R

# The Bruckner SEMI SERIES

Elevation A • 1,766 sq.ft. Elevation B • 1,787 sq.ft. Elevation C • 1,795 sq.ft.

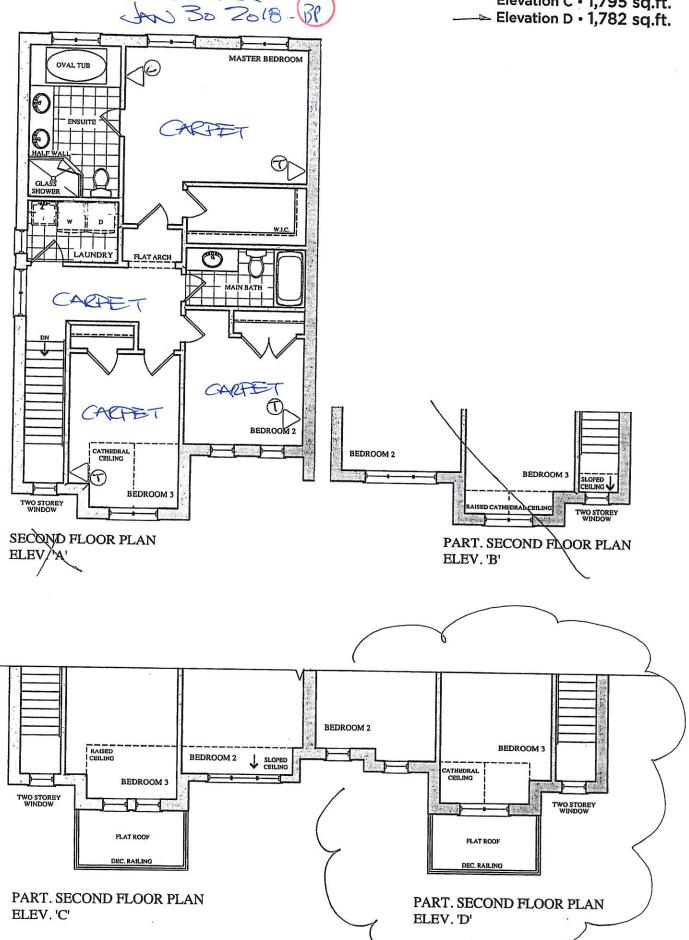

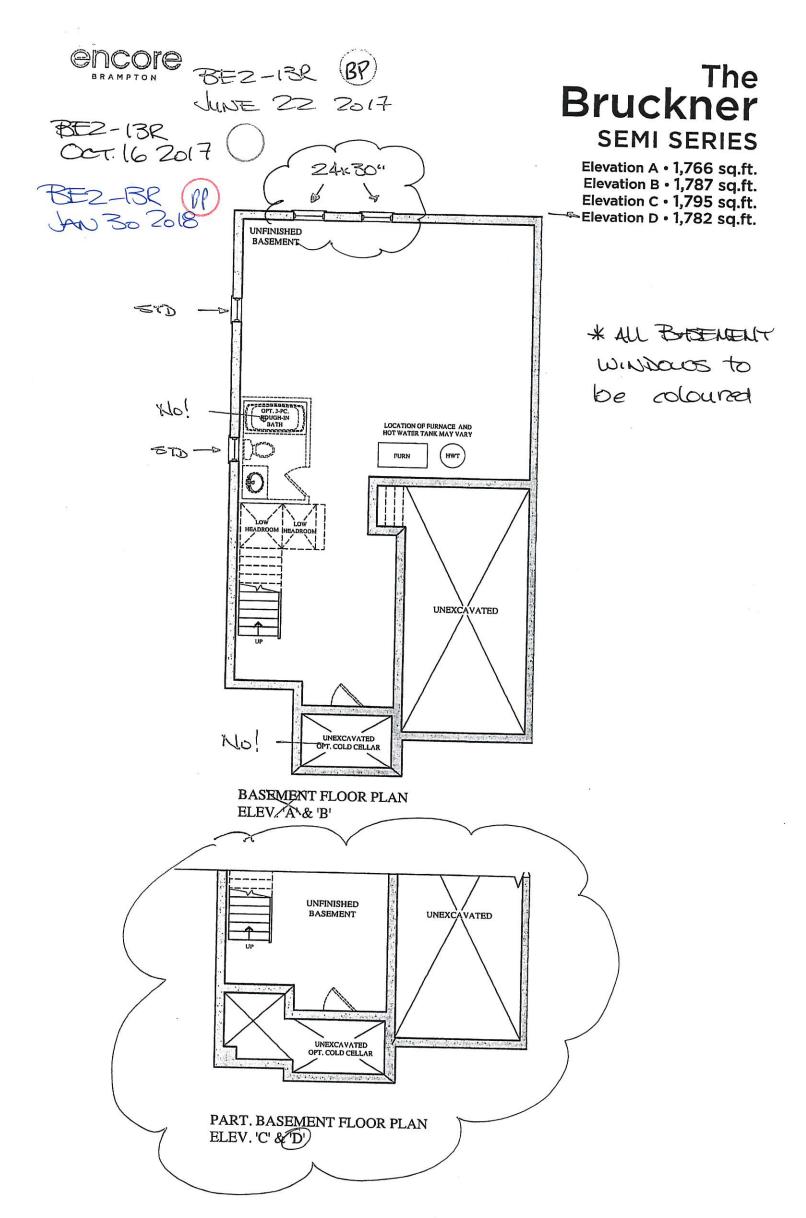

## ÇORTINA

70 Regina Road, Woodbridge, Ontario L4L 8L6 Tel: 905-264-6464 Fax: 905-264-0664 www.CortinaKitchens.com


## BEZ-13R Jan 30 2018 BP


QUOTATION

Date: 06/23/16

Trade Name: Gold Park Homes	Site location: Brampton	Model: SD-3
Address:	Project: Encore	Phase:

This layout has been explained to the purchaser by Cortina Kitchens Inc. and is understood by the purchaser.

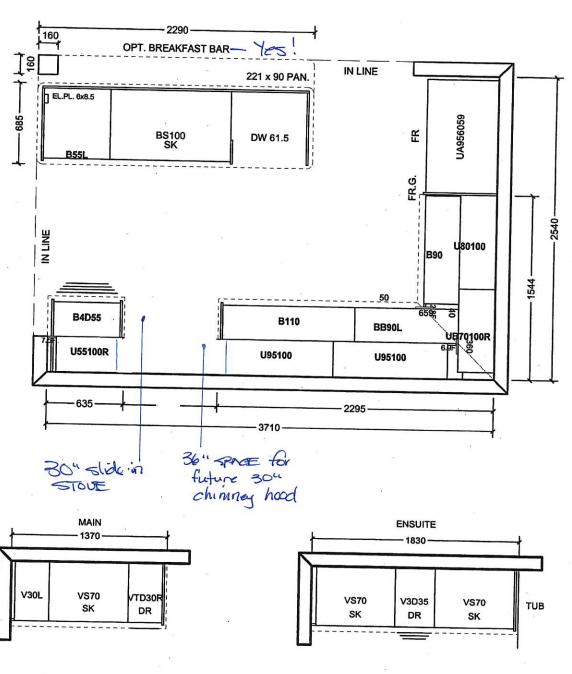

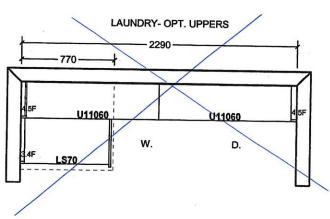

All prices subject to confirmation from head office. This quotation is subject to the terms & conditions set out in Cortina's Agreement of Purchase and Sale

ACCEPTED DATE:

All agreements are contigent upon strikes, accidents, and delay beyond our control. Please provide our installer with template for sinkholes or \$150.00 will be charged for callback.


COSTONIER SIGNATURE	SALESPERSON SIGNATURE	CORTINA HEAD	OFFICE APPROVAL
CUSTOMER SIGNATURE			
		198	

ITEM A. Wood grain and colour are characteristics of the product, we cannot guaruntee that such grian and colour will always match ITEM B. Cortina Kitchens reserves the right to alter dimensions and make technical changes without notice.

# GOLDPARK WORTH MORE



# Granite, Markle, Engineered Surfaces

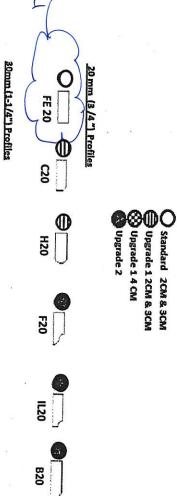

at time ordered. Vendor reserves the right to use 40 mm edges (by lamination process). Note: All colours may not be available in 30mm

VX40

FFZ40

**Z40** 

DR40

0

740

**8**40

10mm (1-1/2") Profiles

C30

T30

**Z30** 

0


FE40

options will be an Upgrade 2 Edge. overall thickness of 2". All other Mitre edge \*Mitre edge is available in Upgrade 1 for an

FZ40

**UPGRADE HARDWARE** 


BEZ-13R Jan 30 2018 PC

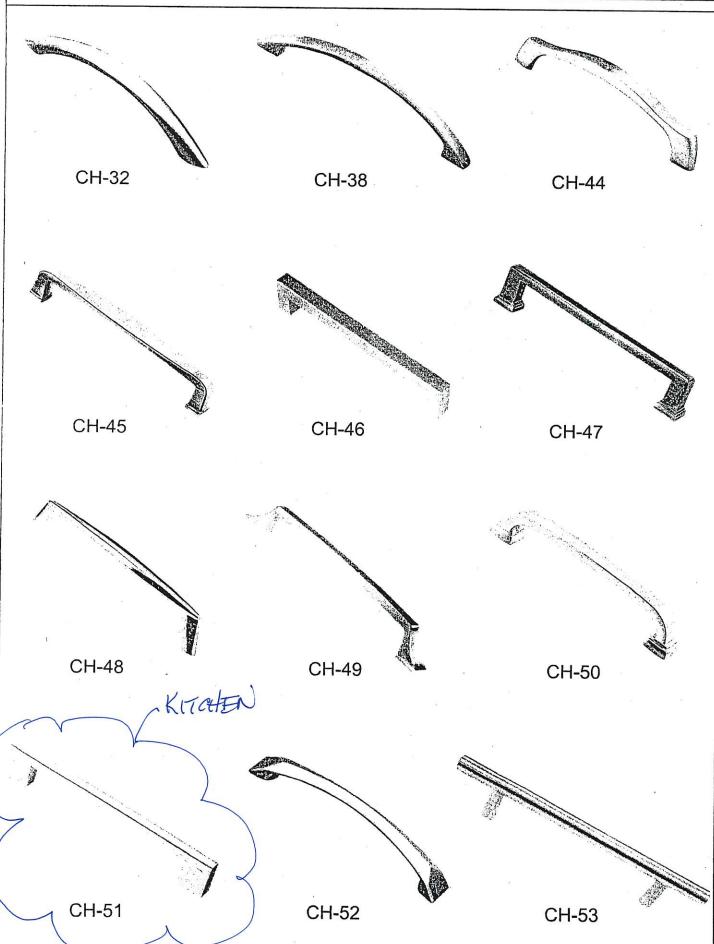

#### \*NOTES:

- IMAGES ARE FOR QUICK REFERENCE PURPOSES ONLY
- ACTUAL SIZES AND FINISHES AS PER HARDWARE SAMPLE BOARD PROVIDED TO DECOR CENTRE


# STANDARD HARDWARE

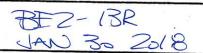








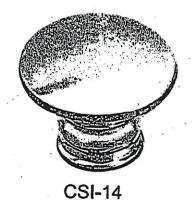






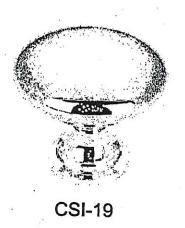








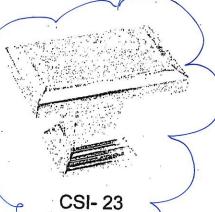



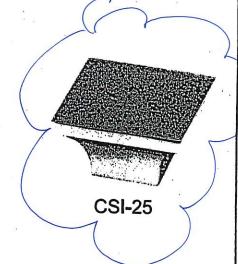

CSI- 24

#### \*NOTES:

- IMAGES ARE FOR QUICK REFERENCE PURPOSES ONLY
- ACTUAL SIZES AND FINISHES AS PER HARDWARE SAMPLE BOARD PROVIDED TO DECOR CENTRE

# GOLDPARK

WORTH MORE"

# Gold Park Homes Décor Centre Disclaimers

Through years of doing business, we at Gold Park Homes have encountered issues beyond our control. The following disclaimers apply to all instances of Purchaser's Extras forms and all Interior Colour Scheme forms.

#### **FIREPLACES**

Fireplace Marble: Due to the many variables that can affect the pattern and/or design, frequently the marble installed on the fireplace will not be identical to the samples. We will make every attempt to come as close to the samples as possible, but cannot be responsible for results which differ from the samples.

#### **CERAMIC FLOOR TILE**



Many variables including variegation can affect tile colour, pattern and/or design which mean installed tiles may not be identical to the samples. We will make every attempt to come as close as possible, but cannot be responsible for results which differ from the samples.

#### HARDWOOD FLOORING

The purchaser is advised that cupping and shrinkage are characteristics of hardwood flooring normally appearing after installation, especially when humidity levels are not regulated, and no warranty is provided by the flooring supplier with respect to such cupping and shrinkage. Furthermore, hardwood floors may also heave and warp when located at or close to entrance points of the home, where rain could make its way to the flooring. The vendor agrees to install any hardwood flooring ordered by the purchaser in a good and workmanlike manner, but shall not be responsible for, and is hereby released by the purchaser from responsibility and liability for cupping, shrinkage, heaving and warping of hardwood flooring in the above mentioned circumstances.

#### STAIRCASE VS FLOORING



#### WOOD SPECIES DIFFERENCE

The purchaser is aware and therefore accepts and acknowledges that the wood species of the staircase and flooring chosen do not match. This difference might result in an undesirable colour variance

The purchaser is aware and therefore accepts and acknowledges that though the flooring is of the same species as the staircase the difference in product finishing may result in a stain colour variance.

The purchaser agrees that the vendor is to be exempt from any and all claims by the purchaser regarding this colour variance.

#### **RAILINGS**



All railings, pickets, posts, nosing's and stairs come from solid wood and veneered wood materials sourced from multiple locations and sources. As such there will be variations in grains and shades between the various natural components beyond our control. Due to this variance in material, all components will stain with colour or natural finish differently.

Iron pickets are wrought in nature and depending on the manufacturing process will have differences from picket to picket which is normal. Also the finish of the iron pickets is of a powder coated nature. This process can produce minor colour variations or tones. Furthermore, the assembly of the metal pickets can develop a natural rattle over time from vibration in the railing. Minor rattling is normal and is a part of the wrought iron picket assembly.

#### HOUSE EXTERIORS

Variations in subcontractors across different sites and varying site conditions may result in house exteriors that differ from the artist renderings. We cannot be responsible for results which differ from the artists renderings of elevations.

#### PLASTER MOULDINGS AND MEDALLIONS

Plaster mouldings will not be installed in open to above areas or areas with 2 storey elements.

#### STAIN COLOURS



Due to the many variables that can affect the outcome of a stain colour on wood, staircases, railings, and fireplaces, the colour may not be identical to samples. Factors such as density, age, humidity, air temperature, and the uniqueness of each piece of wood can result in wide variations in darkness or lightness. We will make every attempt to come as close to the sample as possible, but cannot be responsible for results which differ from the samples.

Stain on pre-finished hardwood floors will not be an exact match to the stain colours available on stairs, pickets and rails. The purchaser is responsible for choosing the stain on these areas to their satisfaction.

#### IN-WALL CONDUIT FOR AUDIO/VIDEO CABLES

It is important to note that due to the variation in framing requirements in different parts of your home, conduit lengths and routing can vary. In virtually all instances of ground floor installation (I.e. above a fireplace), conduit will first travel down into the basement below the floor joists, over to the termination point and back up into the main floor. As a result, it is best to measure the length of the conduit after occupancy with a "pull wire" before

purchasing your cables. For above-fireplace installations, the conduit wall plate will be installed approximately 10" above the Fireplace Mantle, unless otherwise specified in the Construction Summary.

#### APPLIANCE SPECIFICATIONS

All appliance openings are set to builder's standard openings. Please advise Décor Centre at time of your structural appointment if custom sizing of cabinets is required for any built - in appliances. The purchaser is responsible for costs and fees associated with changes to pre-manufactured kitchens made subsequent to colour appointments.

Purchaser accepts & acknowledges that in order to accommodate upgraded appliances, all appliance specifications should be provided at the time of their structural appointment, should this not occur they must be provided to the Décor Center within one (1) week of completion of structural chart. Failure to do so may result in the need to revert to the standard appliance openings or in a delay in construction of your dwelling, as well as a cost of \$500 to re-open your structural file should changes be required. As a result we may be forced to extend the closing of your transaction. Due to failure to complete the above-mentioned selections and at no fault of our own, we reserve our right to hold you responsible for this delayed closing, including charging extra administration cost and interest on the balance due on closing.

Purchasers Accept Standard Appliance Openings (unless otherwise specified):

Fridge - 37-1/2"W x 73-1/2" High Approx.

Range - 30-1/2"D x 31-1/2"W Approx.

Dishwasher - 24" W Approx.

#### DELETION OF HOODFAN & CABINETS ABOVE STOVE:

The purchasers are aware that in requesting NOT TO INSTALL builder's standard hood fan and standard cabinets above stove they will receive NO STANDARD HOOD FAN and NO CREDIT. Purchasers are installing their own hood fan after closing and accept that it may waive any warranty associated with such a change.

Purchasers accept and acknowledge that the exhaust fan duct hole may be off-centered with the stove in the kitchen due to purchasers installing their own hood fan after closing. The vendor is exempt from adjusting such openings for the purchasers range hood.

#### **ELECTRICAL FOR APPLIANCES**

Pricing is subject to change based on the appliance specifications provided. Purchasers should provide proper appliance specifications and cut-out sheets in order for Gold Park to price extras accordingly.

#### KITCHEN CABINETS

The kitchen you order/purchase will undoubtedly contain slight colour variations. The degree of these variations is virtually impossible to determine before the kitchen is installed in its intended location. The amount of and type of lighting will also affect various highlights in the finish. Note: No two pieces of wood are identical. Variations in colour tone and grain patterns make a perfect colour match virtually impossible. It is generally agreed that these variations add to the natural beauty of a wood kitchen.

#### STAIN

Charcoal is a spray stain applied to Oak and Maple products with several characteristics that are important to be aware of when purchasing this product.

- 1. Shadow lines may be visible at the interior profile edges of a door or drawer front. If movement occurs shadow lines may increase or decrease, depending on the style and/or size of a door or drawer front.
- 2. Variation and unevenness may be visible in the finish.
- 3. Hairline cracks at the joints are created over time due to the nature of natural wood, caused by usage, humidity\*\*, or dryness. They tend to be more visible to darker stains, than lighter wood stains.
- \*\* Relative humidity is recommended to be between 45% and 55%. Please refer to Cortina Kitchens "Cleaning, Care, Maintenance, & Warranty Information" guide.

Please be advised that Cortina Kitchens will not replace doors and/or parts that exhibit the above characteristics associated with this finish. These characteristics are not avoidable and are a result of the natural characteristics of wood and wood veneer, and the characteristics of darker stains on wood. The Charcoal stain is not available on doors in Group IVA, Group IVA, Group V and Group VA.

Cortina Kitchens offers a wide variety of finishes, applied to oak and maple products. The subject finishes include the spray stains Cocoa, Espresso, Graphite as well as wiping stain Ebony.

Due to the very dark stains applied on natural maple and oak doors and joints, several characteristics are important to be noted when purchasing these products.

- 1. Shadow lines may be visible at the interior profile edges of a door or drawer front. If movement occurs shadow lines may increase or decrease, depending on the style and/or size of a door or drawer front.
- 2. Variation and unevenness may be visible in the finish.
- 3. Hairline cracks at the joints are created over time due to the nature of natural wood, caused by usage, humidity, or dryness. They tend to be more visible to darker stains, than lighter wood stains.

Please be advised that Cortina Kitchens will not replace doors nor parts that exhibit the above characteristics associated with this finish. These characteristics are not avoidable and are a result of the natural characteristics of wood and wood veneer, and the characteristics of darker stains on wood.

#### CABINETRY DOOR HARDWARE

Cortina Kitchens' cabinetry doors and drawer fronts will be drilled to accept a standard knob or handle selected from Cortina's hardware boards. This drilling comes standard with the order, and is done ONLY in our shop, not on the job site.

For those not wanting Cortina's hardware drilling, the following applies:

No holes to be drilled on the doors and drawer fronts should be specified in writing on the colour chart and the P.O. If while in production, Cortina Kitchens misses this request, Cortina Kitchens and the Builder will not be held responsible to replace any or all doors and drawer fronts affected, and the customer agrees to accept the product as is. No hardware will be supplied or credited by Cortina Kitchens with this request. No charge will apply for this request.



#### **PVC DOORS**

All cabinets with PVC (Thermofoil) Doors come with melamine gables, panels and kick.

The doors, crown moulding and light valance are PVC wrapped. Open shelves incorporated in design will only be available with melamine interiors. There will be variations in colour shades between the PVC parts (doors, crown and Light valance) and the melamine parts (open shelves, Gables, Panels and Kick) due to the difference in material.

Furring Panel with crown moulding to the ceiling is not available on all PVC door styles due to subtle variations in colour shades between the PVC parts (moulding) and the melamine parts (furring panel) due to the difference in material. Grain directions in wood grain pattern melamine, vary between the furring panel, crown moulding (horizontal) and the PVC doors (vertical).



#### GRANITE, MARBLE ENGINEERED SURFACES WAIVER

Granite and marble are naturally occurring products, and due to the many variables that can affect the pattern, colour and/or design and "pitting" of natural products slabs installed will not be identical to the samples displayed. We will make every attempt to come as close to the samples as possible, but cannot be responsible for results which differ from the samples. Every effort is made to provide granite counter tops as close as possible but the vendor is not responsible for results which differ from the sample displayed. All countertop surfaces may have seems & product pattern & shade can change in areas containing seems.

#### RESELECTIONS

It is not uncommon for flooring, such as tile, to become discontinued prior to its installation. Therefore it may be necessary to make a reselection of certain materials sometime during the build process. We cannot assure you that another choice approximating your selection will be available.

#### PLANS

Plans are subject to change without notice. Actual usable floor space may vary from the stated floor area. Layout for kitchen, furnace, HWT and laundry tub may vary from plan. Vertical and horizontal bulkhead, which are not shown on plan, may be required for plumbing and heating runs. E.& O.E.

#### PLEASE NOTE:

In the event the work on the house has progressed beyond the point where the items covered by these invoices cannot be installed without entailing any unusual expense, then this order is to be cancelled and any deposit paid in connection with the same is to be refunded to the purchaser

The vendor will undertake to incorporate the work covered by the sales extra in the construction of the house but will not be liable to the purchaser in any way, if for any reason the work covered by the extra is not carried out. In that event, any monies paid in connection with the same shall be returned to the purchaser.

It is understood and agreed that if for any reason whatsoever the transaction of Purchase and Sale is not completed, the total cost of extras ordered are not refundable to the Purchaser(s).

Extras or changes will not be processed unless signed by the Vendor.

These extras may not be amended without the written consent of Gold Park Homes.

The purchaser(s) and the builder acknowledge and agree that this "Purchaser's Extra" form shall not be deemed to be part of the agreement of purchase and sale entered into between them, nor an addendum thereto. No postdated cheques will be accepted.

No estimates or orders will be accepted once construction has commenced.

Should a refund be requested on any extras purchased, an 80% reimbursement of the purchase price will be given. (a \$50.00 minimum charge and a maximum \$250.00 charge will apply)

Estimates will only be considered when resubmitted on a signed Purchaser Extras form, accompanied by payment in full.

All prices are estimates only and may be subject to change. Should a change in price occur Gold Park Homes reserves the right to request from the purchaser an adjustment of the price or a refund limited to that item.

Purchasers are aware & accept that ANY changes made to upgrades after signing the Purchasers Extra Form are subject to a minimum administration fee of \$500. PLUS a 10% holdback fee.

Purchasers are aware that any request to add a percentage of upgrades from the purchaser's extras form will be processed only after the builder receives approval letter from the bank.

Please be advised that your failure to finalize your structural or colour selections may result in a delay in construction of your dwelling and we may have to extend closing of your transaction. Due to failure to complete the above-mentioned selections and at no fault of us, we reserve our right to hold you responsible for a delayed closing, including charging extra administration cost and interest on the balance due on closing.

Purchaser has attended a Colour appointment at the Decor Centre & has DECLINED any additional upgrades and accepts and acknowledges that there will be no further structural changes/additions/deletions to be made upon signing.

I hereby acknowledge reading and understanding the above copy and will not hold Gold Park Homes responsible for any issues in relation to above.


**Purchasers Signatures** 

Date 4N 30 2018

BE2-13R


#### Clearances and dimensions

To install the range, refer to the following figure.

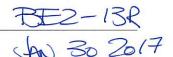



CAUTION This range has been designed to comply with the maximum allowable wood cabinet temperatures of 194 °F. Make sure the wall covering, countertops and cabinets around the range can withstand the heat (up to 194 °F) generated by the range. If not, discoloration, delamination or melting may occur.

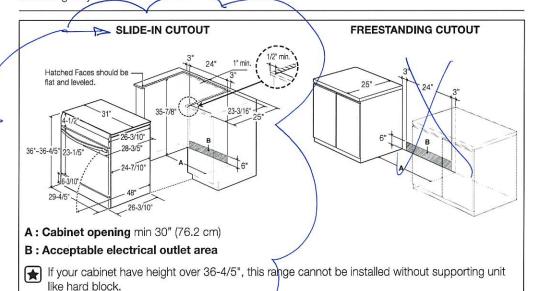


CAUTION You must use the rear filler kit to install the range in a freestanding cutout cabinet. For more information, see "Optional rear filler kit" as shown below.

#### Optional rear filler kit

Used to fill gap between the range back and wall. Adds a filler strip to the rear of the range. This kit can only be used when the opening in the countertop is 25" deep.



If the countertop depth is greater than 25", there will be a gap between the filler kit and the back wall.

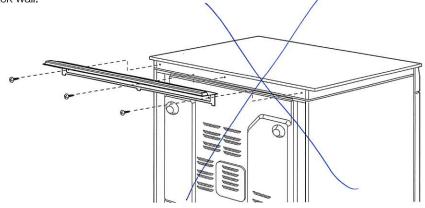

English - 21