

Purchasers: Salvatore Cuzzolino & Felicetta Cuzzolino Property: 16
Telephone Res. / Bus: (416) 505-5961 Project: Kleinburg Glen - Phase 2
Decor Advisor: Yolande Somerville Model and Elevation: 42-1 Elev.B ROYALTON

Layout Changes: Yes No Sketch Attached: Yes No Exterior Colour Scheme:

1. Cabinetry

	Style and Colour	Counter	Hardware
Kitchen / Breakfast	varese pvc 'crystal white'	Granite: Grigio Sardo Edge: FE-20	cs1-23
Laundry Room	n/a	n/a	n/a
Powder Room	n/a	n/a	n/a
n/a	n/a	n/a	n/a
Master Ensuite Bathroom	P-400 pvc 'mystic'	P-Lam #P-344-LM 'Inukshuk Grey'	cs1-24
Second Ensuite Bathroom (If Applicable)	toscana pvc 'antique white'	P-Lam #4588k-07 'Kalahari Topaz'	cs1-23
Twin Bathroom	varese pvc 'mystic'	P-Lam #P345-LM 'Inukshuk Taupe'	cs1-10

Comment

2. Floor Tile

	Selection
Entrance Vestibule	*24x24" Regal Polished 'Shell White'
Main Hall	*24x24" Regal Polished 'Shell White'
Kitchen / Breakfast	*24x24" Regal Polished 'Shell White'
Laundry Room	*12x24" Regal Polished 'Shell White'
Powder Room	*24x24" Regal Polished 'Shell White'
Master Ensuite Bathroom	13x13" Carrara 'White/Grey' → Carrara X Matte 12x24
Second Ensuite Bathroom (If Applicable)	13x13" Mileau 'Fog'
Lower Landing (If Applicable)	n/a
Twin Bathroom	13x3" New Byzantine 'Pentellic Grey'

Comment
Grout lines as small as possible, please!

3. Wall Tile

	Selection	Listello/Inserts	Describe
Master Ensuite Bathroom		Yes No	
Tub Deck	n/a	Yes No	
Shower Stall	*10x16" Carrara 'White/Grey'	Yes No	
Bathroom Walls	n/a	Yes No	
Second Ensuite Bathroom (If Applicable)	8x10" Reflection 'olive'	Yes No	
Twin Bathroom	8x10" Weave 'Tender Grey'	Yes No	
Kitchen Backsplash	Yes No	Backsplash Behind Fridge	none

Comment


KG2-16
APRIL 10 2017




the *Royalton*

Elevation A • 3,016 sq.ft.

Elevation B • 3,043 sq.ft.

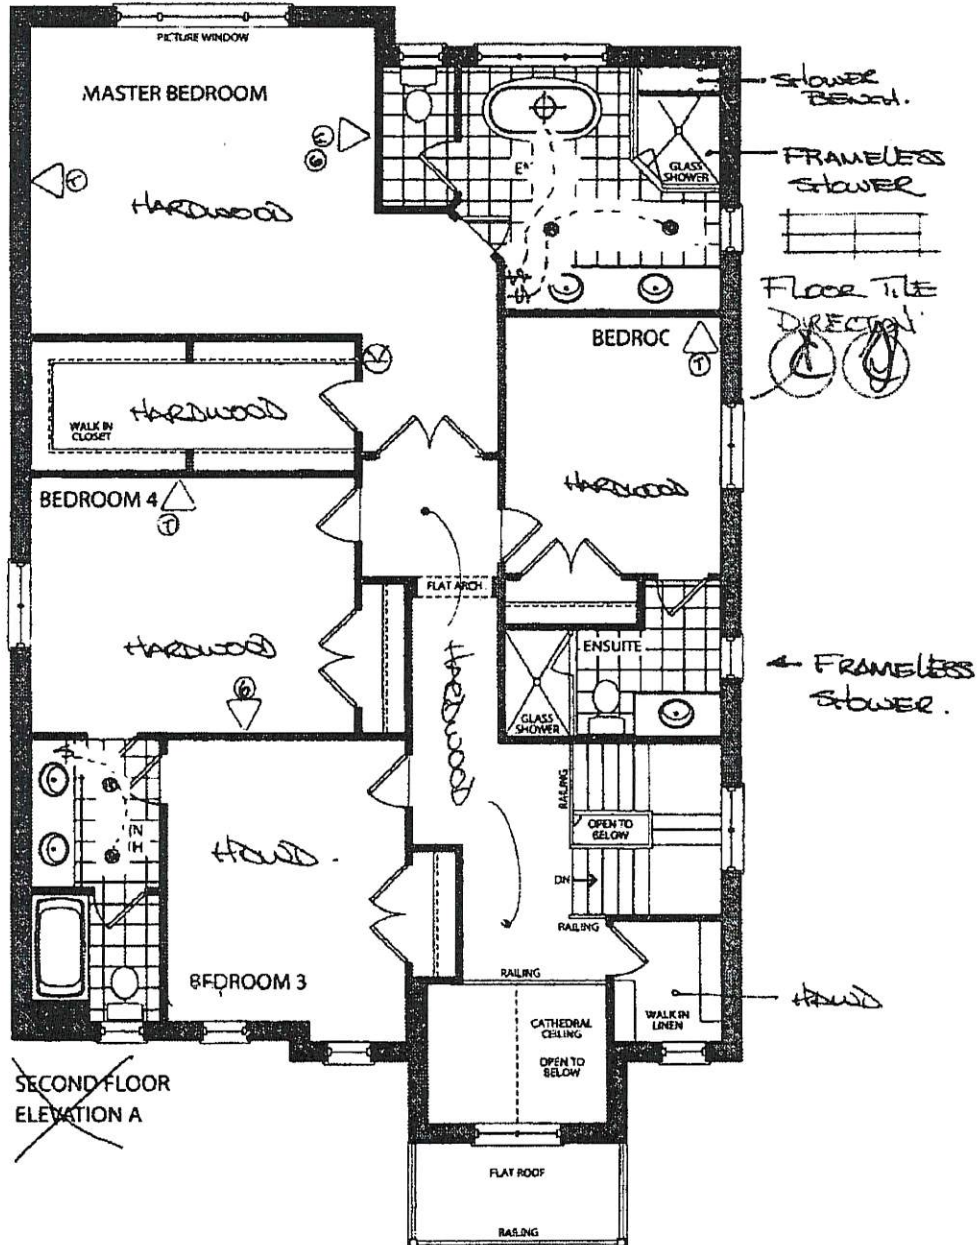

~~SECOND FLOOR
ELEVATION A~~

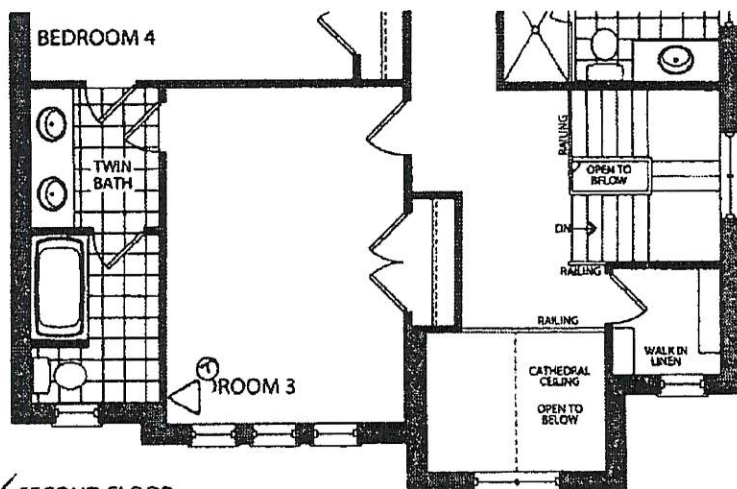

✓ SECOND FLOOR
ELEVATION B