

Purchaser: Vis Mawabi
Telephone Res. / Bus: (647) 233-3866
Decor Advisor: Yolande Somerville

Property: 21
Project: Kleinburg Glen - Phase 2
Model and Elevation: 42-1 Elev.B ROYALTON

Layout Changes: Yes No Sketch Attached: Yes No Exterior Colour Scheme:

1. Cabinetry

	Style and Colour	Counter	Hardware
Kitchen / Breakfast	Siena oak 'Greystone'	Granite: Grigio Sardo Edge: FE-20	cs1-24
Laundry Room	n/a	n/a	n/a
Powder Room	n/a	n/a	n/a
	n/a	n/a	n/a
Master Ensuite Bathroom	Toscana pvc 'crystal white'	P-Lam #1573-60 'Frosty White'	cs1-24
Second Ensuite Bathroom (If Applicable)	Toscana pvc 'crystal white'	P-Lam #1573-60 'Frosty White'	cs1-24
Twin Bath	Siena Oak 'Greystone'	P-Lam #1573-60 'Frosty White'	cs1-24

Comment

2. Floor Tile

	Selection
Entrance Vestibule	N/A see hardwood
Main Hall	N/A
Kitchen / Breakfast	N/A
Laundry Room	12x24 New Byzantine Azzuro
Powder Room	*12x24 ARYA Polished White
Master Ensuite Bathroom	*12x24 ARYA Polished White
Second Ensuite Bathroom (If Applicable)	*12x24 ARYA Polished White
Lower Landing (If Applicable)	N/A
Twin Bath	*12x24 ARYA Polished White

Comment

3. Wall Tile

	Selection	Listello/Inserts	Describe
		Yes No	
Master Ensuite Bathroom			
Tub Deck	N/A	Yes No	
Shower Stall	*4x12 Chess Arctic White	Yes No	
Bathroom Walls	N/A	Yes No	
Second Ensuite Bathroom (If Applicable)	*4x16 CDC Arctic White Bright	Yes No	
Twin Bath	8x10 Weave White	Yes No	
Kitchen Backsplash	Yes No	Backsplash Behind Fridge	


Comment

KGZ-21.
Oct 27 2017

the *Royalton*

Elevation A • 3,016 sq.ft.

Elevation B - 3,043 sq.ft.

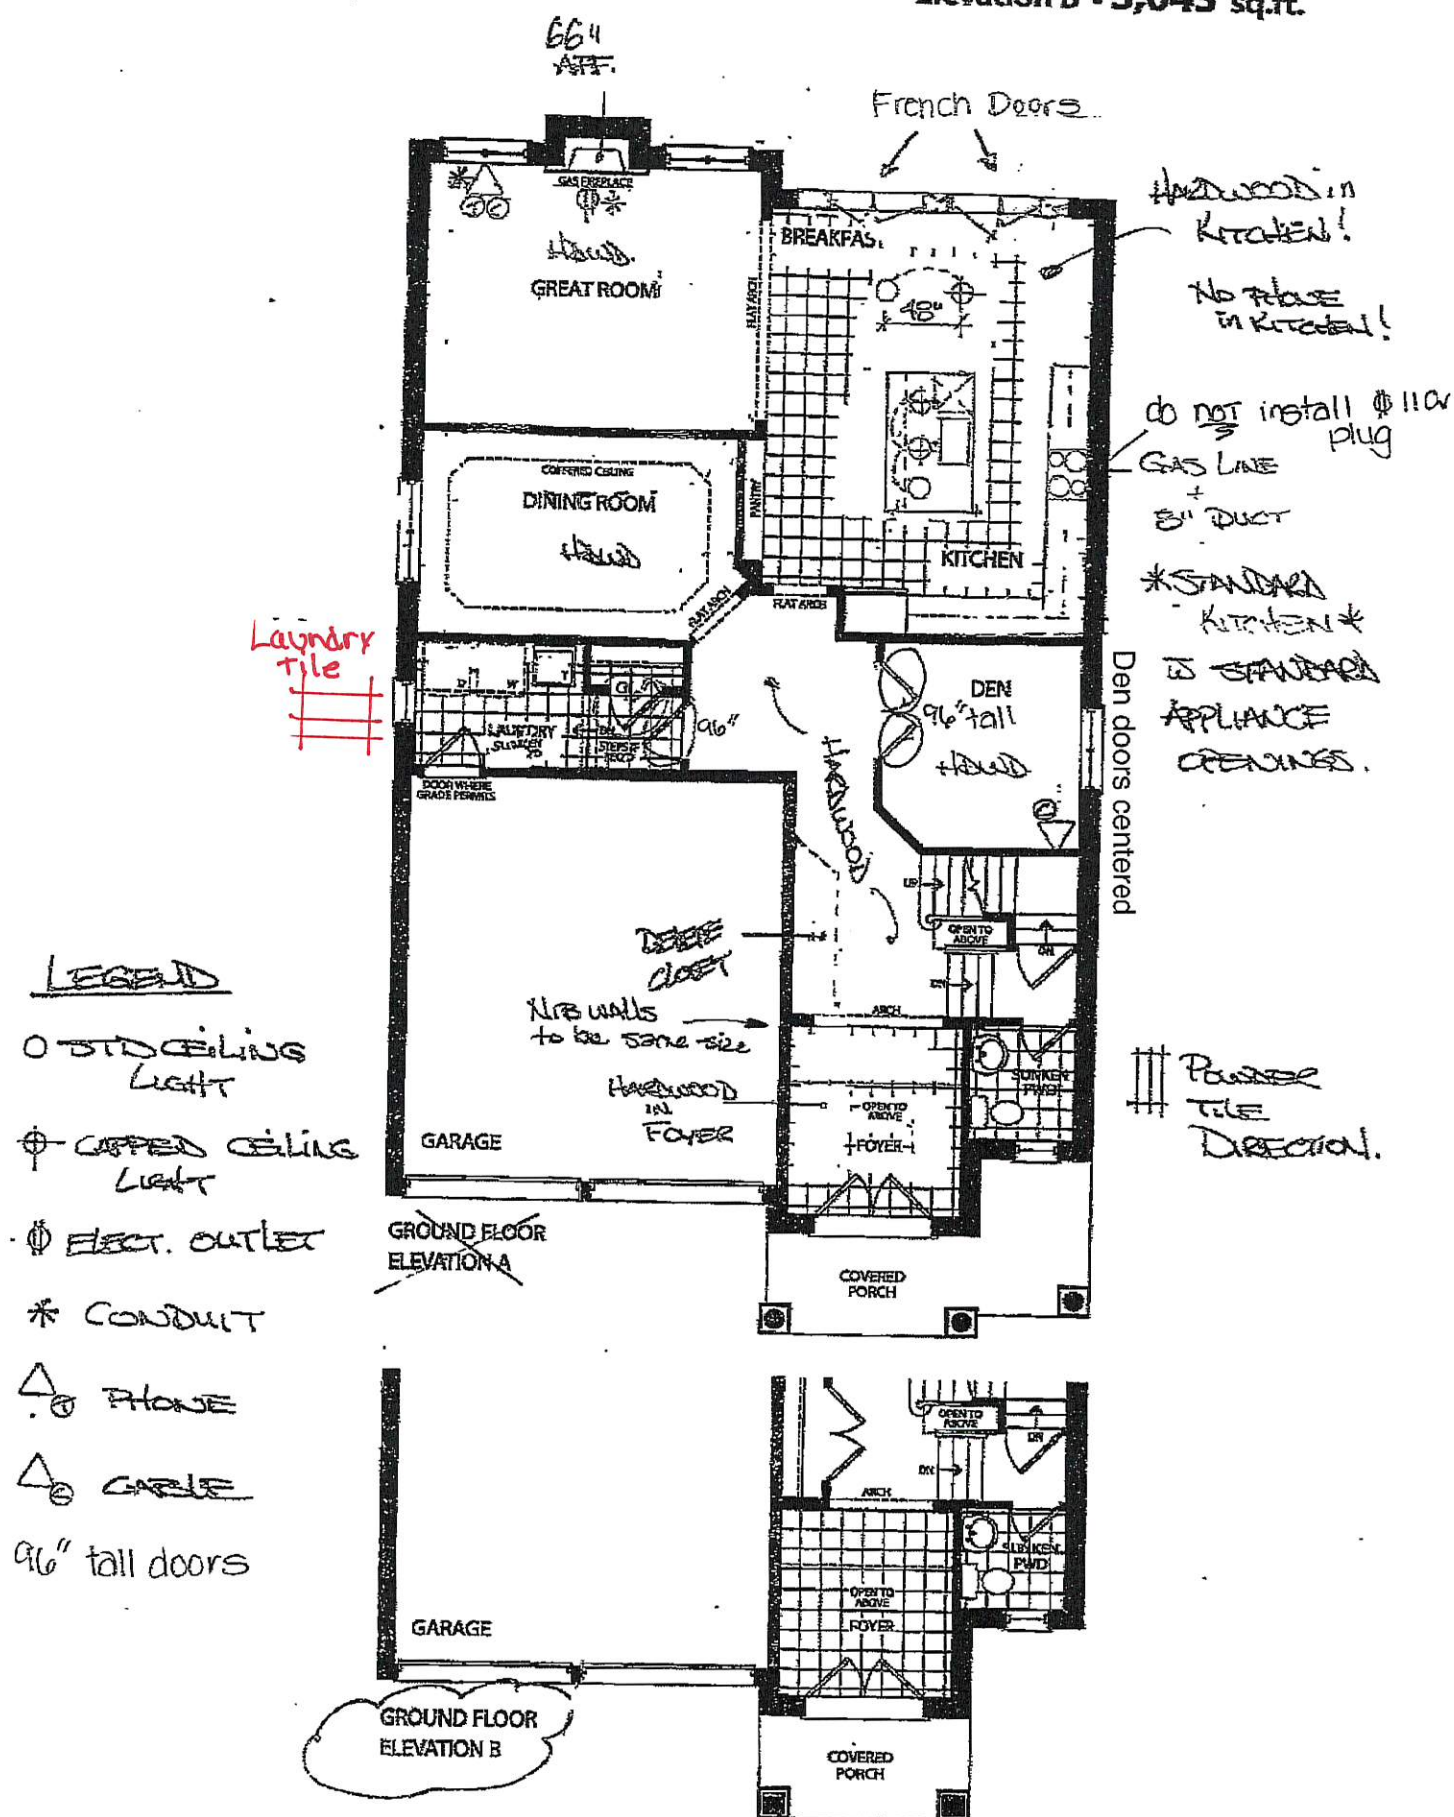

Prices, figures, illustrations, sizes, features and finishes are subject to change without notice. E&OE. Areas and dimensions are approximate and actual usable floor space may vary from the stated area. Layout may be reverse of the unit purchased. E & O.E.

GOLDPARK