

*** NOTE: This is not an approved document. Document must be locked ***

Scheduled Closing Date: Wednesday, October 11, 2017

Purchasers: Karamjit, Singh Minhas & Anupma Minhas
Telephone Res. / Bus: (647) 291-5021
Decor Advisor: Yolande Somerville
Property: 22
Project: Kleinburg Glen - Phase 2
Model and Elevation: 42-3 Elev.B CARLTON Opt 5 Bed

Layout Changes: Yes No Sketch Attached: Yes No Exterior Colour Scheme:

1. Cabinetry

Table with 4 columns: Room, Style and Colour, Counter, Hardware. Rows include Kitchen / Breakfast, Laundry Room, Powder Room, Semi Ensuite 2/3, Master Ensuite Bathroom, Second Ensuite Bathroom (If Applicable), and Semi 4/5.

Comment

Empty text box for comment.

2. Floor Tile

Table with 2 columns: Room, Selection. Rows include Entrance Vestibule, Main Hall, Kitchen / Breakfast, Laundry Room, Powder Room, Semi 2/3, Master Ensuite Bathroom, Second Ensuite Bathroom (If Applicable), Lower Landing (If Applicable), and Semi 4/5.

Comment

Grout lines as small as possible!
Mod Room Floor: 12x24" Timeless pol. Dark grey.

3. Wall Tile

Table with 4 columns: Room, Selection, Listello/Inserts, Describe. Rows include Semi 4/5, Master Ensuite Bathroom (Tub Deck, Shower Stall, Bathroom Walls), Second Ensuite Bathroom (If Applicable), Semi 2/3, Kitchen Backsplash, and Backsplash Behind Fridge.

Comment

Empty text box for comment.

Elevation A • ~~3,354~~ sq.ft.

✓ Elevation B • 3,361 sq.ft.

KG2-22

MAR 19 2017


AM KM

T.V. DIRECTION


DELETE ARCH.

96" TALL
ARCHES

SHOWER!

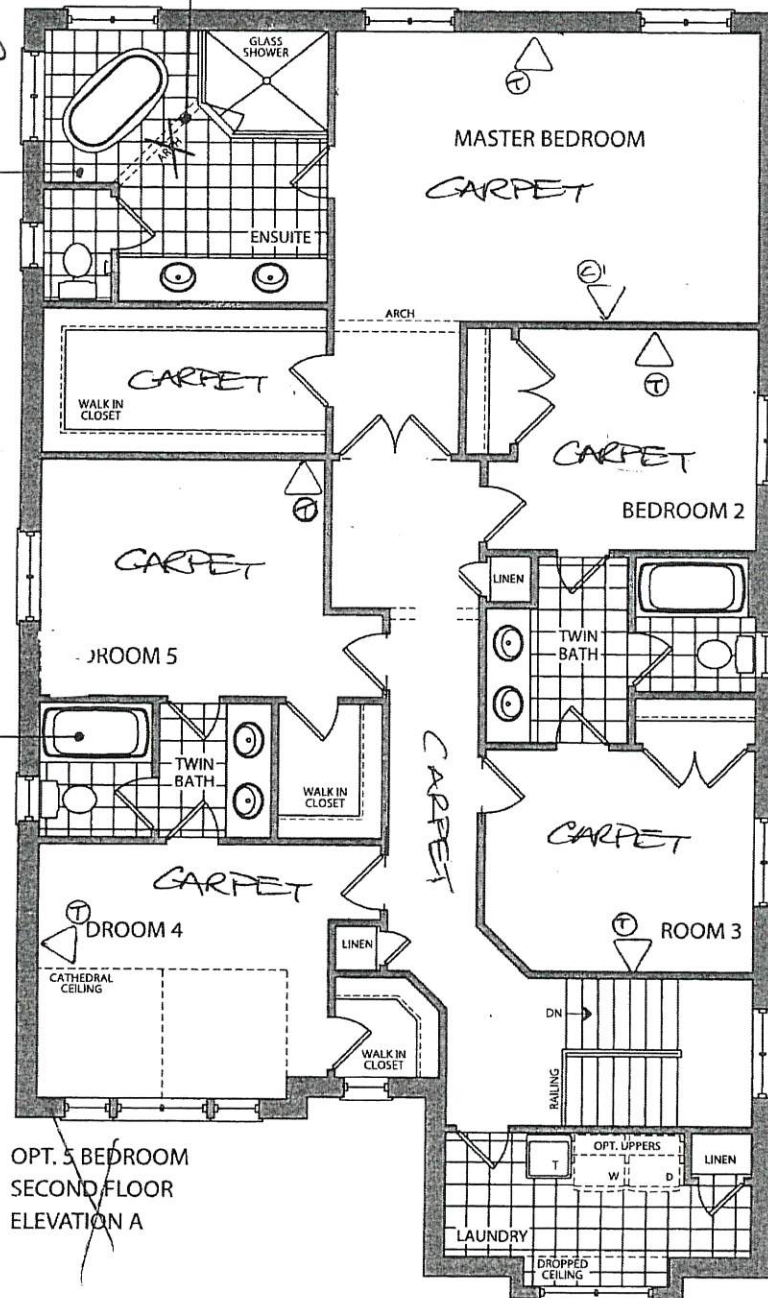

OPT. 5 BEDROOM
SECOND FLOOR
ELEVATION A

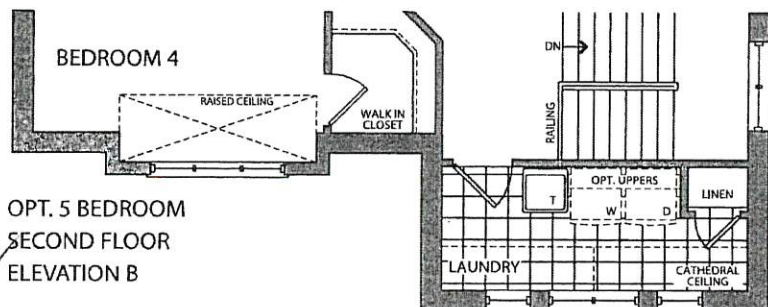

✓ OPT. 5 BEDROOM
SECOND FLOOR
ELEVATION B