

BEZ-2R

QUOTATION

Date: 06/23/16

MARCH 26 2018
Revised APRIL 5 2018

Name: Gold Park Homes


Site location: Brampton

Model: SD-8

dress:

Project: Encore

This layout has been explained to the purchaser by Cortina Kitchens Inc. and is understood by the purchaser.

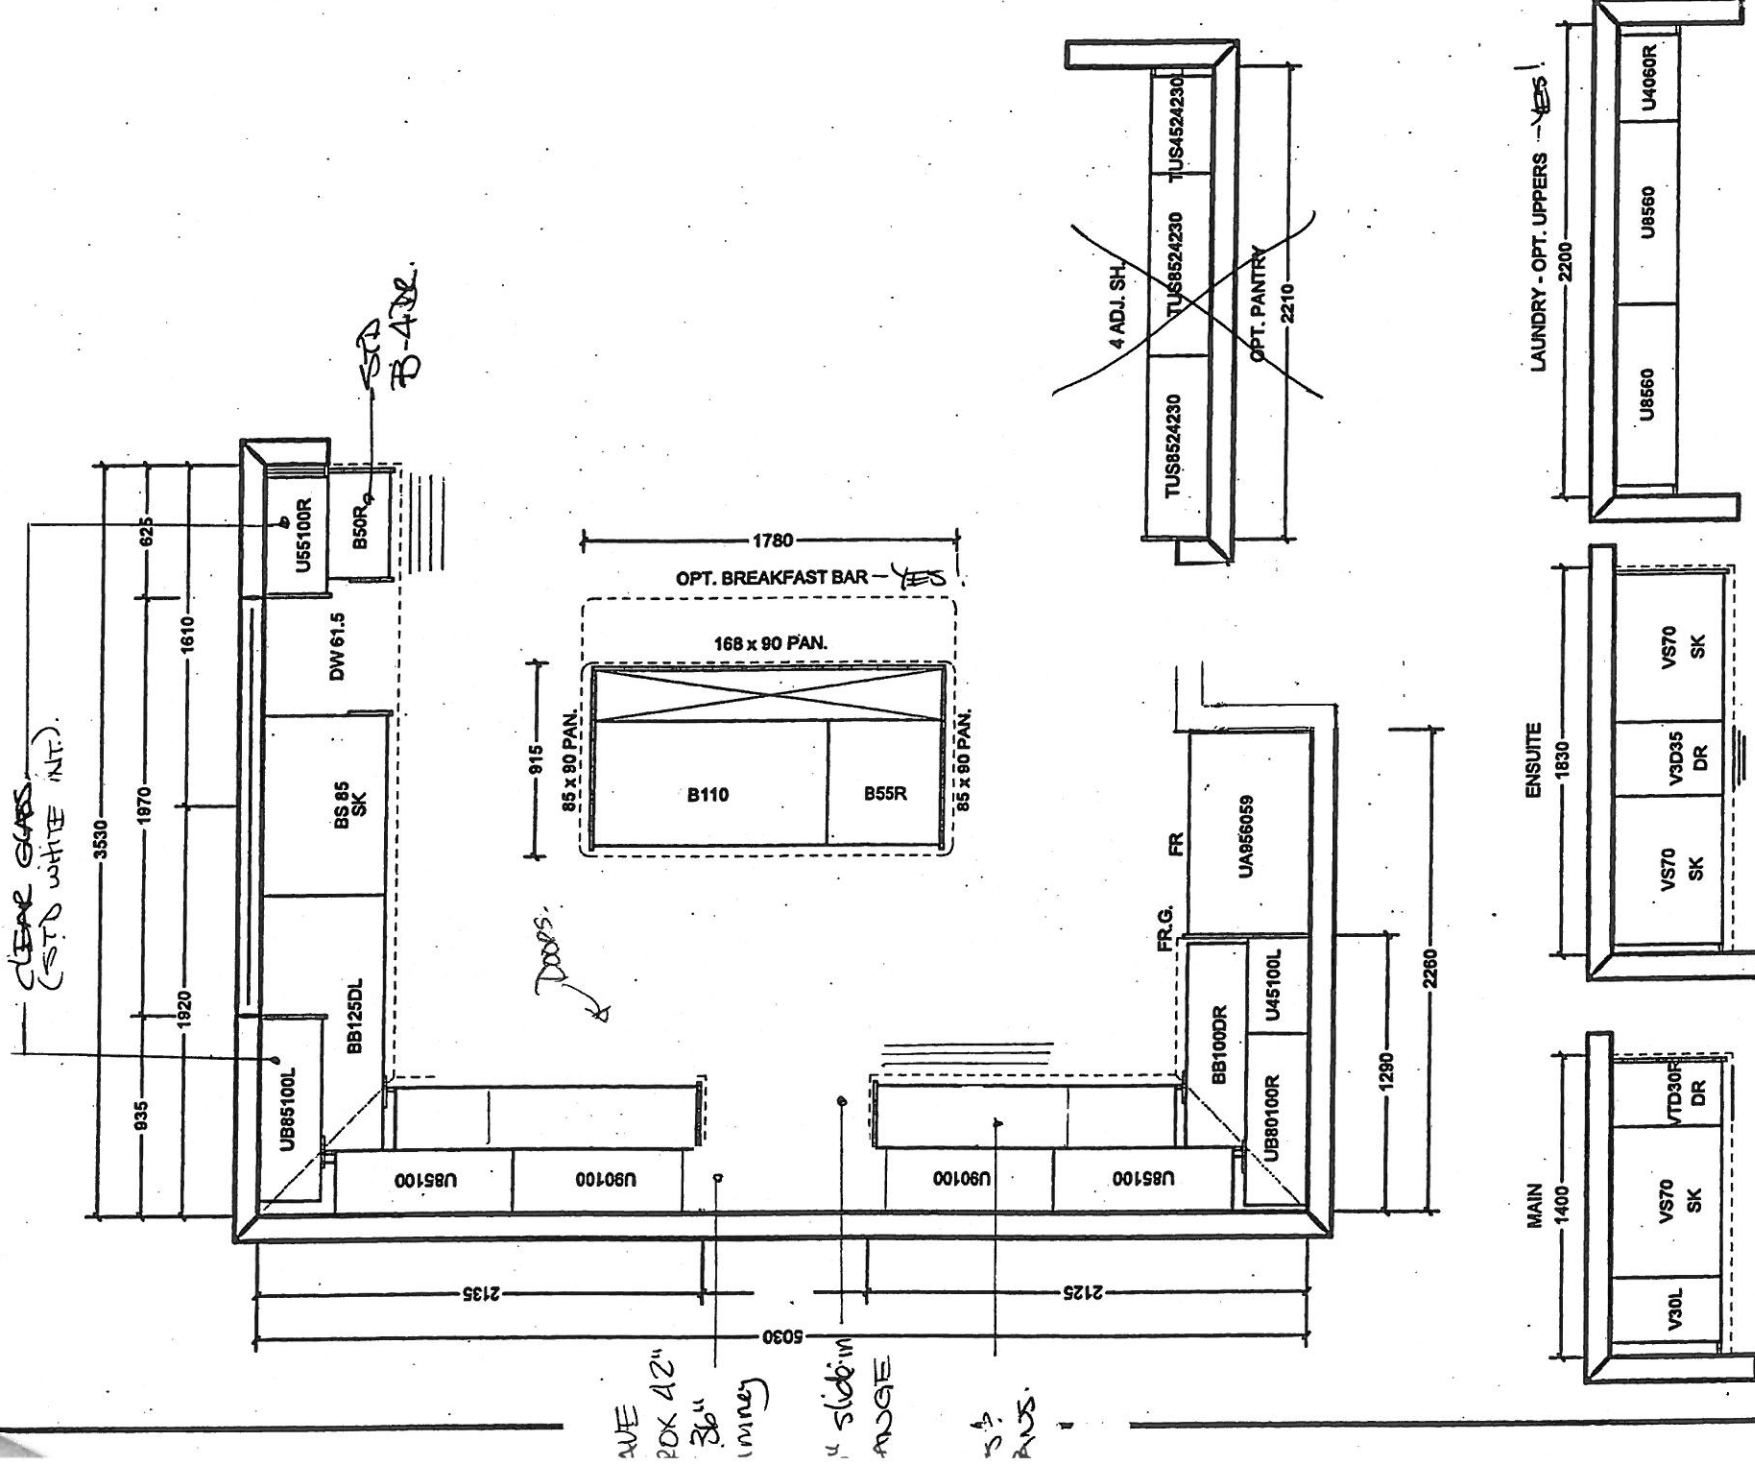

All prices subject to confirmation from head office.

**This quotation is subject to the terms & conditions set out
in Cortina's Agreement of Purchase and Sale**

ACCEPTED DATE:

CUSTOMER SIGNATURE

SALESPERSON SIGNATURE

CORTINA HEAD OFFICE APPROVAL

ITEM A. Wood grain and colour are characteristics of the product, we cannot guarantee that such grain and colour will always match

ITEM B. Cortina Kitchens reserves the right to alter dimensions and make technical changes without notice.

All agreements are contingent upon strikes, accidents, and delay beyond our control. Please provide our Installer with template for sinkholes or \$150.00 will be charged for callback.