

CORTINA
KITCHENS INC.
111 Rye Road, Woodbridge, Ontario L4L 6H6
Tel: 905-881-6664 Fax: 905-881-6665
www.CortinaKitchens.com

BE2-13L.
FEB 22 2018



QUOTATION


Date: 08/23/16

Name: Gold Park Homes	Site location: Brampton	Model: SD-3
Project: Encore	Phase:	




This layout has been explained to the purchaser by Cortina Kitchens Inc. and is understood by the purchaser.

Hand-drawn close

REVISION
APRIL 12 2018

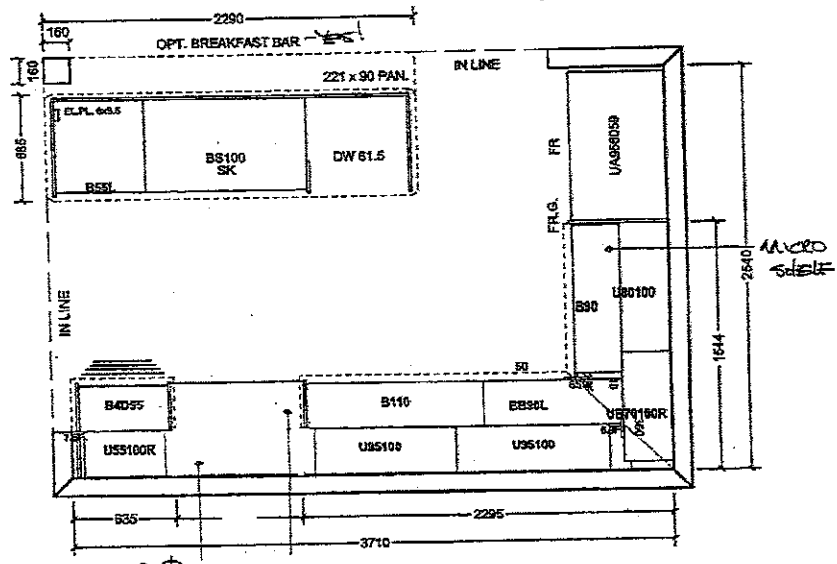

30" slide-in RANGE
36" space for climbing

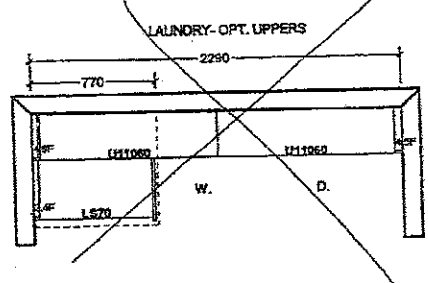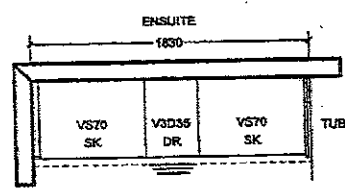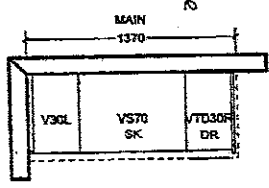

All prices subject to confirmation from head office.
This quotation is subject to the terms & conditions set out in Cortina's Agreement of Purchase and Sale

All agreements are contingent upon strikes, accidents, and delay beyond our control.
Please provide our installer with templates for sinkholes or \$250.00 will be charged for callback.

ACCEPTED DATE: _____

CLIENT SIGNATURE

SALESPERSON SIGNATURE

CORTINA HEAD OFFICE APPROVAL

ITEM A. Wood grain and colour are characteristics of the product; we cannot guarantee that such grain and colour will always match.
ITEM B. Cortina Kitchens reserves the right to alter dimensions and make technical changes without notice.