



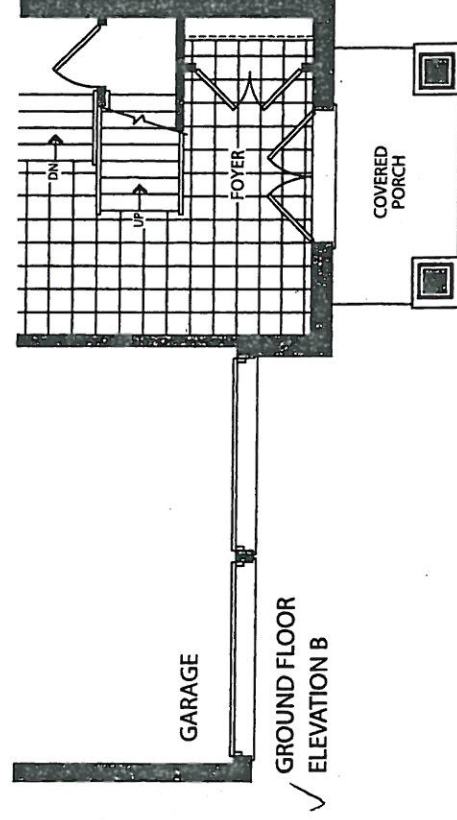

✓ Elevation B • 3,361 sq.ft.

② 12

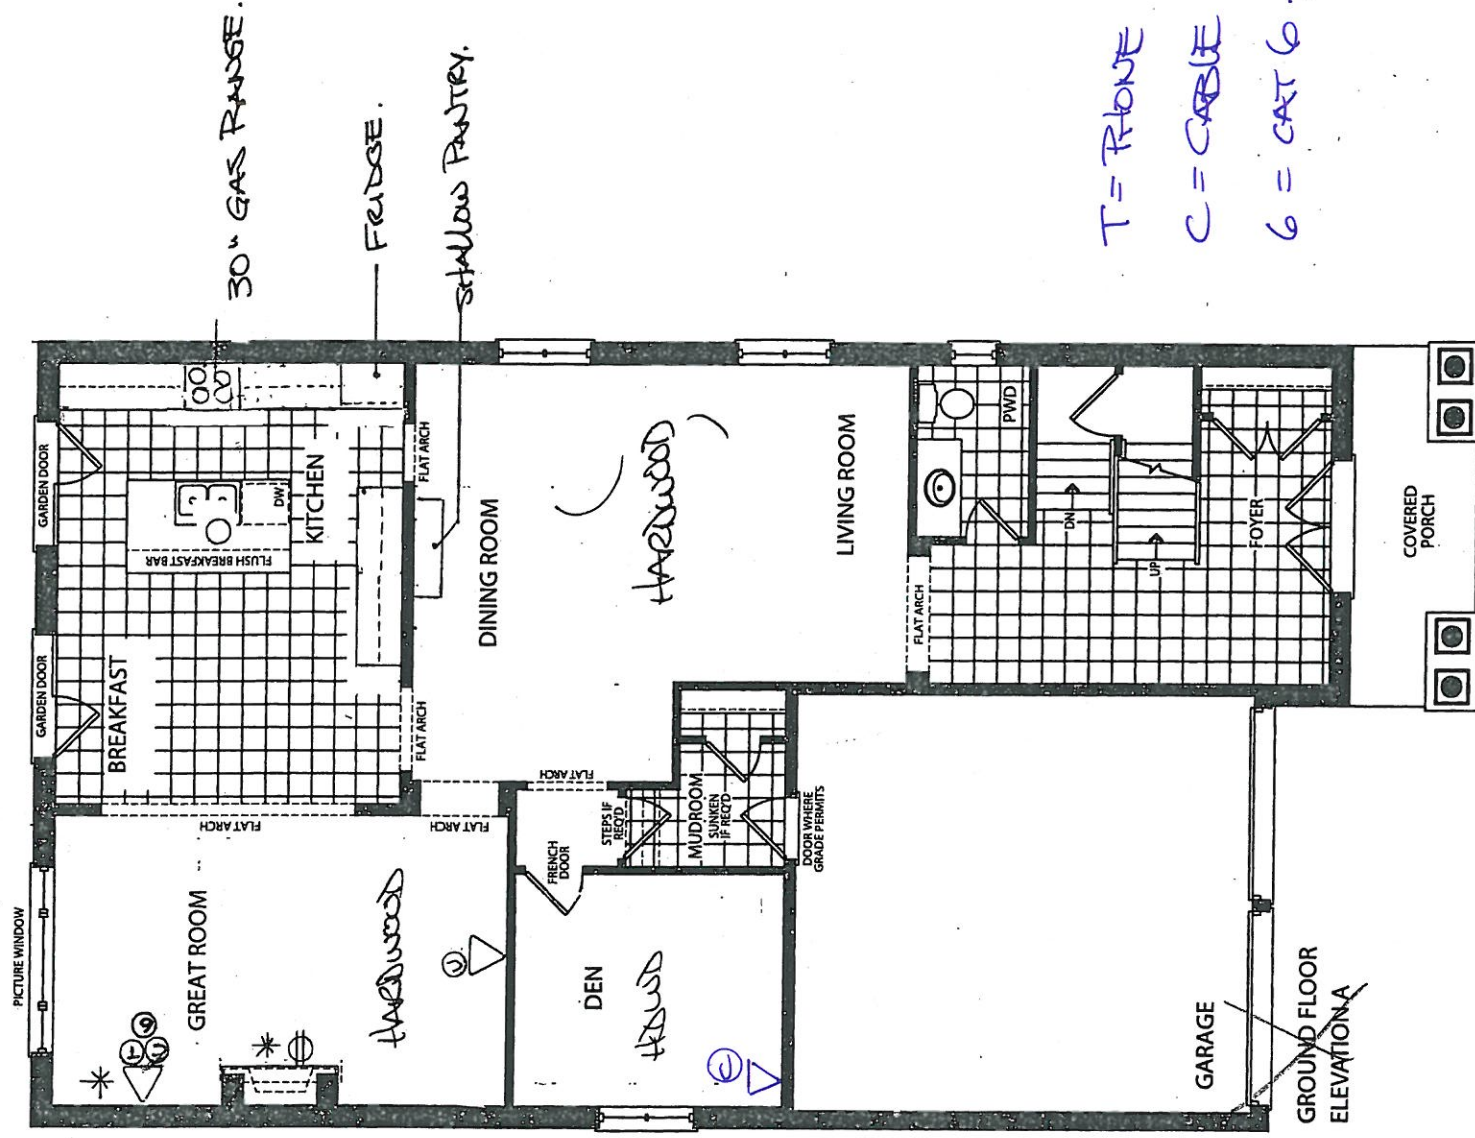