

Kleinburg Glen - 28 - 2 - 42-3 Elev.B CARLTON

CARPET

Inv.1,765	1 - BEDROOM 2 / BEDROOM 3 / BEDROOM 4 CARPET: UPGRADE TO BERBER STYLE CITYVIEW
Line26586	Note:
20Feb18 / 4May18	

CERAMIC

Inv.1,765	1 - FOYER / POWDER ROOM / KITCHEN FLOOR TILE: UPGRADE 5 - 24X24"
Line26567	Note:
20Feb18 / 4May18	
Inv.1,765	1 - KITCHEN: UPGRADE 4 BACKSPLASH TILE (includes behind chimney fan)
Line26569	Note:
20Feb18 / 4May18	
Inv.1,765	1 - MASTER ENSUITE FLOOR TILE: UPGRADE 4 - 12X24" LAID IN STRAIGHT, STACKED PATTERN
Line26575	Note:
20Feb18 / 4May18	
Inv.1,765	1 - MASTER ENSUITE: UPGRADE 2 WALL TILE - LAID IN HORIZONTAL STACKED PATTERN
Line26576	Note:
20Feb18 / 4May18	

CONCRETE AND DRAIN

Inv.1,621	1 - BACKFLOW PREVENTER VALVE
Line24459	Note:
19Oct17 / 19Oct17	

CROWN MOULDING

Inv.1,736	1 - GREAT ROOM: INSTALL WAFFLE CEILING DETAIL AS PER FLOOR PLAN TIC-164
Line25744	Note:
2Feb18 / 2Feb18	
Inv.1,736	1 - DEN: INSTALL WAFFLE CEILING DETAIL AS PER FLOOR PLAN TIC-164
Line25745	Note:
2Feb18 / 2Feb18	
Inv.1,736	1 - DINING ROOM: INSTALL WAFFLE CEILING DETAIL AS PER FLOOR PLAN TIC-164
Line25746	Note:
2Feb18 / 2Feb18	
Inv.1,765	1 - LIVING ROOM: INSTALL WAFFLE CEILING DETAIL AS PER PLAN TIC-164
Line27000	Note:
20Feb18 / 4May18	

DRYWALL

Inv.1,621	1 - MAIN FLOOR CEILING 10FT, 8FT TALLER INTERIOR DOORS, TALLER FLAT ARCHES, REAR AND FRONT WINDOWS WITH TRANSOM, TALLER KITCHEN CABINETS WITH CROWN AND FURRING PANEL, ADDED STAIRS AND PICKETS
Line24452	Note:
19Oct17 / 19Oct17	
Inv.1,621	1 - SMOOTH CEILINGS - (2 - Story Design) 2ND FLOOR
Line24458	Note:
19Oct17 / 19Oct17	

ELECTRICAL

Inv.1,621	1 - KITCHEN- FUTURE WALL OVEN- 220V Wall Recepticle on dedicated circuit
Line24461	Note:
19Oct17 / 19Oct17	
Inv.1,621	1 - Under Cabinet Valance Lighting - DOES NOT INCLUDE VALANCE
Line24462	Note:
19Oct17 / 19Oct17	
Inv.1,621	1 - KITCHEN- FOR FUTURE PENDANT LIGHT- Rough in light on existing switch- Capped (doesn't include fixture)
Line24463	Note:
19Oct17 / 19Oct17	
Inv.1,621	1 - KITCHEN- FOR FUTURE PENDANT LIGHT-Rough in light on separate switch- Capped (doesn't include fixture)
Line24464	Note:
19Oct17 / 19Oct17	
Inv.1,736	5 - GREAT ROOM: INSTALL 5 POTLIGHTS ON SAME SWITCH- SEPARATE SWITCH FROM STD FIXTURE STANDARD FIXTURE AND SWITCH TO REMAIN SEE FLOORPLAN FOR LOCATIONS
Line25726	Note:
2Feb18 / 2Feb18	
Inv.1,736	1 - GREAT ROOM: Additional Interior Switch FOR 5 POTLIGHTS
Line25727	Note:
2Feb18 / 2Feb18	
Inv.1,736	4 - DEN ROOM: INSTALL 4 POTLIGHTS ON STD SWITCH- DELETE STANDARD FIXTURE STD SWITCH TO REMAIN SEE FLOORPLAN FOR LOCATIONS
Line25728	Note:
2Feb18 / 2Feb18	
Inv.1,736	4 - LIVING ROOM: INSTALL 4 POTLIGHTS ON SAME SWITCH
Line25729	Note:
2Feb18 / 2Feb18	
Inv.1,736	1 - LIVING ROOM: Additional Interior Switch FOR 4 POTLIGHTS
Line25730	Note:
2Feb18 / 2Feb18	
Inv.1,736	4 - DINING ROOM: INSTALL 4 POTLIGHTS ON SAME SWITCH- SEPARATE SWITCH FROM STD FIXTURE STANDARD FIXTURE AND SWITCH TO REMAIN SEE FLOORPLAN FOR LOCATIONS
Line25731	Note:
2Feb18 / 2Feb18	
Inv.1,736	1 - DINING ROOM: Additional Interior Switch FOR 4 POTLIGHTS
Line25732	Note:
2Feb18 / 2Feb18	
Inv.1,736	4 - BREAKFAST ROOM: INSTALL 4 POTLIGHTS ON SAME SWITCH- SEPARATE SWITCH FROM STD FIXTURES STANDARD FIXTURES AND SWITCH TO REMAIN SEE FLOORPLAN FOR LOCATIONS
Line25733	Note:
2Feb18 / 2Feb18	
Inv.1,736	4 - BREAKFAST ROOM: Additional Interior Switch FOR 4 POTLIGHTS
Line25734	Note:
2Feb18 / 2Feb18	

Kleinburg Glen - 28 - 2 - 42-3 Elev.B CARLTON

Inv.1,736	5 - KITCHEN: DELETE STD FIXTURES INSTALL 5 POTLIGHTS ON SAME SWITCH
Line25735	Note:
2Feb18 / 2Feb18	
Inv.1,736	1 - KITCHEN: Additional Interior Switch FOR 5 POTLIGHTS
Line25736	Note:
2Feb18 / 2Feb18	
Inv.1,736	1 - SERVICE HALL: DELETE STD FIXTURES INSTALL 1 POTLIGHTS ON SAME SWITCH
Line25737	Note:
2Feb18 / 2Feb18	
Inv.1,736	2 - POWDER ROOM: DELETE STD WALL FIXTURE INSTALL 2 POTLIGHTS ON SAME STD SWITCH
Line25738	Note:
2Feb18 / 2Feb18	
Inv.1,736	5 - FOYER: INSTALL 5 POTLIGHTS ON SAME SWITCH- SEPARATE SWITCH FROM STD FIXTURE STANDARD FIXTURE AND SWITCH TO REMAIN SEE FLOORPLAN FOR LOCATIONS
Line25739	Note:
2Feb18 / 2Feb18	
Inv.1,736	1 - FOYER: Additional Interior Switch FOR 5 POTLIGHTS
Line25740	Note:
2Feb18 / 2Feb18	
Inv.1,736	9 - EXTERIOR SOFFIT LIGHTS: CORNER UPGRADE- 4XPOTLIGHTS IN FRONT SOFFIT 5X POTLIGHTS IN SIDE UPGRADED ELEVATION SOFFIT- SEE ELEVATIONS FOR LOCATIONS
Line25768	Note:
2Feb18 / 2Feb18	
Inv.1,764	1 - Pot Light 4" Halogen 440 WH - Price per potlight- 10 or more
Line25973	Note: Added a sixth potlight in front of the fireplace in the great room, for this inventory home - per M. Pilato 20.Feb.2018
20Feb18 / 20Feb18	
Inv.1,765	1 - KITCHEN: CYCLONE 36" CHIMNEY HOOD FAN #SCB711
Line26571	Note:
20Feb18 / 4May18	

Exterior Colours

Inv.1,621	1 - EXTERIOR COLOUR PACKAGE 8
Line24457	Note:
19Oct17 / 19Oct17	

FRAMING

Inv.1,621	1 - MAIN FLOOR CEILING 10FT, 8FT TALLER INTERIOR DOORS, TALLER FLAT ARCHES, REAR AND FRONT WINDOWS WITH TRANSOM, TALLER KITCHEN CABINETS WITH CROWN AND FURRING PANEL, ADDED STAIRS AND PICKETS
Line24451	Note:
19Oct17 / 19Oct17	
Inv.1,638	2 - 2ND FLOOR- BUILD 2 COFFERED CEILINGS IN UPPER HALLWAY
Line24700	Note:
20Nov17 / 20Nov17	
Inv.1,736	1 - GREAT ROOM: COFFER CEILING FOR FUTURE WAFFLE DETAIL
Line25741	Note:
2Feb18 / 2Feb18	

Kleinburg Glen - 28 - 2 - 42-3 Elev.B CARLTON

Inv.1,736	1 - LIVING/DINING ROOM: COFFER CEILING AS PER FLOOR PLAN
Line25742	Note:
2Feb18 / 2Feb18	

Inv.1,736	1 - DEN: COFFER DEN FOR FUTURE WAFFLE
Line25743	Note:
2Feb18 / 2Feb18	

GRANITE MARBLE QUARTZ

Inv.1,765	1 - KITCHEN: UPGRADE 5 QUARTZ - 3CM
Line26565	Note:
20Feb18 / 4May18	

Inv.1,765	2 - KITCHEN ISLAND: 3CM WATERFALL LEG
Line26566	Note:
20Feb18 / 4May18	

Inv.1,765	1 - POWDER ROOM: UPGRADE 5 COUNTER TOP
Line26570	Note:
20Feb18 / 4May18	

Inv.1,765	1 - MASTER ENSUITE COUNTER: UPGRADE 1 MARBLE
Line26577	Note:
20Feb18 / 4May18	

Inv.1,765	1 - TWIN BATHROOM: UPGRADE 2 QUARTZ
Line26582	Note:
20Feb18 / 4May18	

Inv.1,765	1 - ENSUITE 2: UPGRADE 2 QUARTZ
Line26583	Note:
20Feb18 / 4May18	

HARDWOOD

Inv.1,765	1 - MASTER BEDROOM: UPGRADE 1 HARDWOOD
Line26574	Note:
20Feb18 / 4May18	

HVAC

Inv.1,621	1 - GAS LINE ROUGH - MAIN FLOOR - (2 STOREY MODELS) FOR GAS STOVE- INCLUDES 110V PLUG ON SEPARATE CIRCUIT
Line24460	Note:
19Oct17 / 19Oct17	

INTERIOR TRIM AND DOORS

Inv.1,621	1 - MAIN FLOOR CEILING 10FT, 8FT TALLER INTERIOR DOORS, TALLER FLAT ARCHES, REAR AND FRONT WINDOWS WITH TRANSOM, TALLER KITCHEN CABINETS WITH CROWN AND FURRING PANEL, ADDED STAIRS AND PICKETS
Line24454	Note:
19Oct17 / 19Oct17	

KITCHEN AND BATH CABINETRY

Kleinburg Glen - 28 - 2 - 42-3 Elev.B CARLTON

Inv.1,621	1 - MAIN FLOOR CEILING 10FT, 8FT TALLER INTERIOR DOORS, TALLER FLAT ARCHES, REAR AND FRONT WINDOWS WITH TRANSOM, TALLER KITCHEN CABINETS WITH CROWN AND FURRING PANEL, ADDED STAIRS AND PICKETS
Line24453	Note:
19Oct17 / 19Oct17	
Inv.1,765	1 - KITCHEN: 2-TONE KITCHEN - BASE CABINETS DARK, UPPERS & TALL CABINETS WHITE
Line26558	Note:
20Feb18 / 4May18	
Inv.1,765	1 - KITCHEN: DOUBLE APPLIANCE CABINET WITH DRAWER BELOW AND SLIDE-IN RANGE TOP
Line26559	Note:
20Feb18 / 4May18	
Inv.1,765	3 - KITCHEN: POTS AND PANS DRAWERS
Line26560	Note:
20Feb18 / 4May18	
Inv.1,765	1 - KITCHEN: DEEP GABLE FOR OVEN TOWERS
Line26561	Note:
20Feb18 / 4May18	
Inv.1,765	1 - KITCHEN: WASTE/RECYCLE CENTER
Line26562	Note:
20Feb18 / 4May18	
Inv.1,765	1 - KITCHEN: ADJUST CABINETS FOR 36" STOVE
Line26563	Note:
20Feb18 / 4May18	
Inv.1,765	1 - KITCHEN: DELETE UPPERS, FINISH SIDES OF CABINETS LEAVE APPROX. 42" SPACE FOR 36" CHIMNEY-STYLE HOOD FAN
Line26564	Note:
20Feb18 / 4May18	
Inv.1,765	1 - KITCHEN: UPGRADE HARDWARE
Line26568	Note:
20Feb18 / 4May18	
Inv.1,765	1 - MASTER ENSUITE: UPGRADE HARDWARE
Line26580	Note:
20Feb18 / 4May18	
Inv.1,765	1 - KITCHEN: SWAP STANDARD BANK OF 4 DRAWERS FOR LONG TOP DRAWER (BY PANTRY)
Line26716	Note:
20Feb18 / 4May18	
Inv.1,765	1 - KITCHEN: DEEP PANTRY WITH FINISHED GABLES IN LIEU OF 30CM PANTRY
Line26718	Note:
20Feb18 / 4May18	
Inv.1,765	1 - KITCHEN: STACKED UPPER CABINETS
Line26719	Note:
20Feb18 / 4May18	
Inv.1,765	1 - KITCHEN: CABINETRY VALANCE
Line26746	Note:
20Feb18 / 4May18	

Kleinburg Glen - 28 - 2 - 42-3 Elev.B CARLTON

PAINT

Inv.1,765	1 - MAIN STAIRS: STAIN STAIRS TO MATCH HARDWOOD
Line26581	Note:
20Feb18 / 4May18	

PLUMBING FIXTURES

Inv.1,765	1 - KITCHEN SINK: BLANCO SUPER SINGLE
Line26572	Note:
20Feb18 / 4May18	
Inv.1,765	1 - POWDER ROOM: CONTRAC CAMDEN SQUARE UNDERMOUNT SINK
Line26573	Note:
20Feb18 / 4May18	
Inv.1,765	2 - MASTER ENSUITE: CONTRAC 'COLETTE' RECTANGULAR UNDERMOUNT SINK
Line26578	Note:
20Feb18 / 4May18	
Inv.1,765	2 - TWIN BATHROOM: CONTRAC 'CAMDEN' SQUARE UNDERMOUNT SINK
Line26584	Note:
20Feb18 / 4May18	
Inv.1,765	1 - ENSUITE 2: CONTRAC 'CAMDEN' SQUARE UNDERMOUNT SINK
Line26585	Note:
20Feb18 / 4May18	

STAIRS AND RAILINGS

Inv.1,765	1 - MAIN STAIRS: EUROLINE 1 + V GROOVE
Line26579	Note:
20Feb18 / 4May18	

WINDOWS AND DOORS

Inv.1,621	4 - 4 UPGRADED BASEMENT WINDOWS 16" X 30"
Line24450	Note:
19Oct17 / 19Oct17	
Inv.1,621	1 - MAIN FLOOR CEILING 10FT, 8FT TALLER INTERIOR DOORS, TALLER FLAT ARCHES, REAR AND FRONT WINDOWS WITH TRANSOM, TALLER KITCHEN CABINETS WITH CROWN AND FURRING PANEL, ADDED STAIRS AND PICKETS
Line24455	Note:
19Oct17 / 19Oct17	
Inv.1,621	1 - MANDOOR- GRADE PERMITS
Line24456	Note:
19Oct17 / 19Oct17	

Purchaser: Unsold - 28 Unsold - 28
Telephone Res. / Bus: (905) 760-9595
Decor Advisor: Yolande Somerville

Property: 28
Project: Kleinburg Glen - Phase 2
Model and Elevation: 42-3 Elev.B CARLTON

Layout Changes: Yes No Sketch Attached: Yes No Exterior Colour Scheme:

1. Cabinetry

Table with 4 columns: Room, Style and Colour, Counter, Hardware. Rows include Kitchen / Breakfast, Laundry Room, Powder Room, Twin Bath, Master Ensuite Bathroom, and Second Ensuite Bathroom.

Comment

KITCHEN:
UPPERS AND TALL CABINETS: M-500 melamine 'White Crystal'
BASE CABINETS: M-500 melamine 'Mystic'

2. Floor Tile

Table with 2 columns: Room, Selection. Rows include Entrance Vestibule, Main Hall, Kitchen / Breakfast, Laundry Room, Powder Room, Twin Bath, Master Ensuite Bathroom, Second Ensuite Bathroom, and Lower Landing.

Comment

3. Wall Tile

Table with 4 columns: Room, Selection, Listello/Inserts, Describe. Rows include Master Ensuite Bathroom (Tub Deck, Shower Stall, Bathroom Walls), Second Ensuite Bathroom, Twin Bath, and Kitchen Backsplash.

Comment

Scheduled Closing Date: Thursday, November 02, 2017

Purchaser: Unsold - 28 Unsold - 28

Property: 28

Telephone Res. / Bus: (905) 760-9595

Project: Kleinburg Glen - Phase 2

Decor Advisor: Yolande Somerville

Model and Elevation: 42-3 Elev.B CARLTON

4. Plumbing Fixtures

<input type="text"/>	Second Ensuite	<input type="text"/>	Powder Room	<input type="text"/>	
Master Ensuite Bathroom	<input type="text"/>	Other Room - Specify	<input type="text"/>	Other Washroom	<input type="text"/>
		<input type="text"/>			

Comment

Standard thru out except sinks

5. Hardwood Flooring

	Type and Stain		Type and Stain
Main Hall	<input type="text" value="'Graphite'"/>	Upper Landing	<input type="text" value="n/a"/>
Kitchen / Breakfast	<input type="text" value="n/a"/>	Upper Hall	<input type="text" value="'Graphite'"/>
Living Room	<input type="text" value="'Graphite'"/>	Master Bedroom	<input type="text" value="'Graphite'"/>
Dining Room	<input type="text" value="'Graphite'"/>	Bedroom #2	<input type="text" value="n/a"/>
Family Room	<input type="text" value="'Graphite'"/>	Bedroom #3	<input type="text" value="n/a"/>
Den/Library	<input type="text" value="'Graphite'"/>	Bedroom #4	<input type="text" value="n/a"/>
Entrance Vestibule	<input type="text" value="n/a"/>	Bedroom #5	<input type="text" value="n/a"/>
Lower Landing (If Applicable)	<input type="text" value="n/a"/>	Other Room - Specify	<input type="text"/>

Comment

6. Carpeting

	Upgrade	Description
Ground Floor	<input type="checkbox"/>	<input type="text"/>
Second Floor	<input checked="" type="checkbox"/>	<input type="text" value="Upgrade: Cityview 'Ballgown'"/>
<input type="text"/>	<input type="checkbox"/>	<input type="text"/>

Upgrade Underpad	Type	Area
	<input type="text"/>	<input type="text"/>
Carpet on Stairs	Capped	Runner - *Upgrade
	<input type="text"/>	<input type="text"/>

Comment

Standard Underpad

7. Fireplace

	Living Room			Family Room			Other Room - Specify		
	Purchased	As Per Plan	N/A	Purchased	As Per Plan	N/A	Purchased	As Per Plan	N/A
Fireplace Type	<input type="radio"/>	<input type="radio"/>	<input checked="" type="radio"/>	<input type="radio"/>	<input checked="" type="radio"/>	<input type="radio"/>	<input type="radio"/>	<input type="radio"/>	<input checked="" type="radio"/>
Mantle Type	<input type="text"/>			<input type="text" value="Standard Gas"/>			<input type="text"/>		
Colour / Stain	<input type="text"/>			<input type="text" value="Standard Mediterranean"/>			<input type="text"/>		
Surround	<input type="text"/>			<input type="text" value="Standard"/>			<input type="text"/>		
Hearth	<input type="text"/>			<input type="text" value="none"/>			<input type="text"/>		
	<input type="text"/>			<input type="text" value="Standard"/>			<input type="text"/>		

Comment

Purchaser: Unsold - 28 Unsold - 28

Property: 28

Telephone Res. / Bus: (905) 760-9595

Project: Kleinburg Glen - Phase 2

Decor Advisor: Yolande Somerville

Model and Elevation: 42-3 Elev.B CARLTON

8. Trim Carpentry

Interior Doors Front Door Glass Inserts Door Handles

Interior Trim

Comment

**Standard profile, 96" (10' ceiling package)

9. Plaster Mouldings and Medallions

Standard Throughout ☐ Yes ☐ No ☒ N/A

Entrance Vestibule	<input type="text"/>	<input type="text"/>	Kitchen/Breakfast	<input type="text"/>	<input type="text"/>
Main Hall	<input type="text"/>	<input type="text"/>	Den/Library	<input type="text"/>	<input type="text"/>
Living Room	<input type="text"/>	<input type="text"/>	Lower Landing	<input type="text"/>	<input type="text"/>
Dining Room	<input type="text"/>	<input type="text"/>	Other Room - Specify	<input type="text"/>	<input type="text"/>
Family Room	<input type="text"/>	<input type="text"/>			

Comment

10. Railings and Spindles

Railing Package

Railing Colour <input type="text" value="*Graphite"/>	Spindle Colour <input type="text" value="*Black"/>
Stringer / Riser <input type="text" value="*Graphite"/>	Treads <input type="text" value="*Graphite"/>

Comment

Oak Stairs ☒ Yes ☐ No ☐ N/A

11. Wall Paint / Ceilings

Throughout Finished Areas

Trim Paint

Smooth Ceilings

Ground Floor ☐

Second Floor ☐

Note

Comment

Scheduled Closing Date: Thursday, November 02, 2017

Purchaser: Unsold - 28 Unsold - 28

Property: 28

Telephone Res. / Bus: (905) 760-9595

Project: Kleinburg Glen - Phase 2

Decor Advisor: Yolande Somerville

Model and Elevation: 42-3 Elev.B CARLTON

12. Electrical

Hood Fan ☐ White ☒ Stainless ☐ N/A

Above Kitchen Cabinet Light ☐ Yes ☒ No

Below Kitchen Cabinet Light ☐ Yes ☒ No

Standard Appliances ☐

Over The Range Microwave ☐

Chimney Style Fan ☒

Comment

13. Heating and Air Conditioning

Air Conditioning

Gas Provisions Stove

Gas Provisions Dryer

Gas Provisions Barbecue

Comment

14. Additional Comments

15. Disclaimers and Notes

- 1) Colours of all materials are as close as possible to builder's selection, but not necessarily identical due to variances in manufacturing.
- 2) Any extras listed above are null and void unless accompanied by a separate invoice/amendment. Said invoice must be paid in full.
- 3) The Purchaser acknowledges that after Interior Colour Selection form is signed and dated, no further changes will be permitted other than re-selection due to unavailability. Purchaser's Initials
- 4) The Purchaser acknowledges reading and accepting the "Gold Park Homes Decor Centre Disclaimers" form. This document contains other miscellaneous disclaimers.

This Interior Colour Selection is final and approved by:



Signature: _____ Date: _____

KG 28
April 7 2018



the Carlton

Elevation A • 3,354 sq.ft.

→ Elevation B • 3,361 sq.ft.

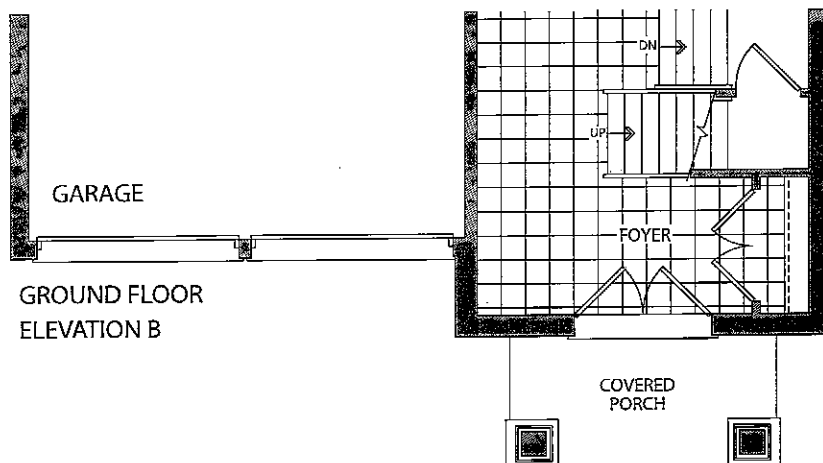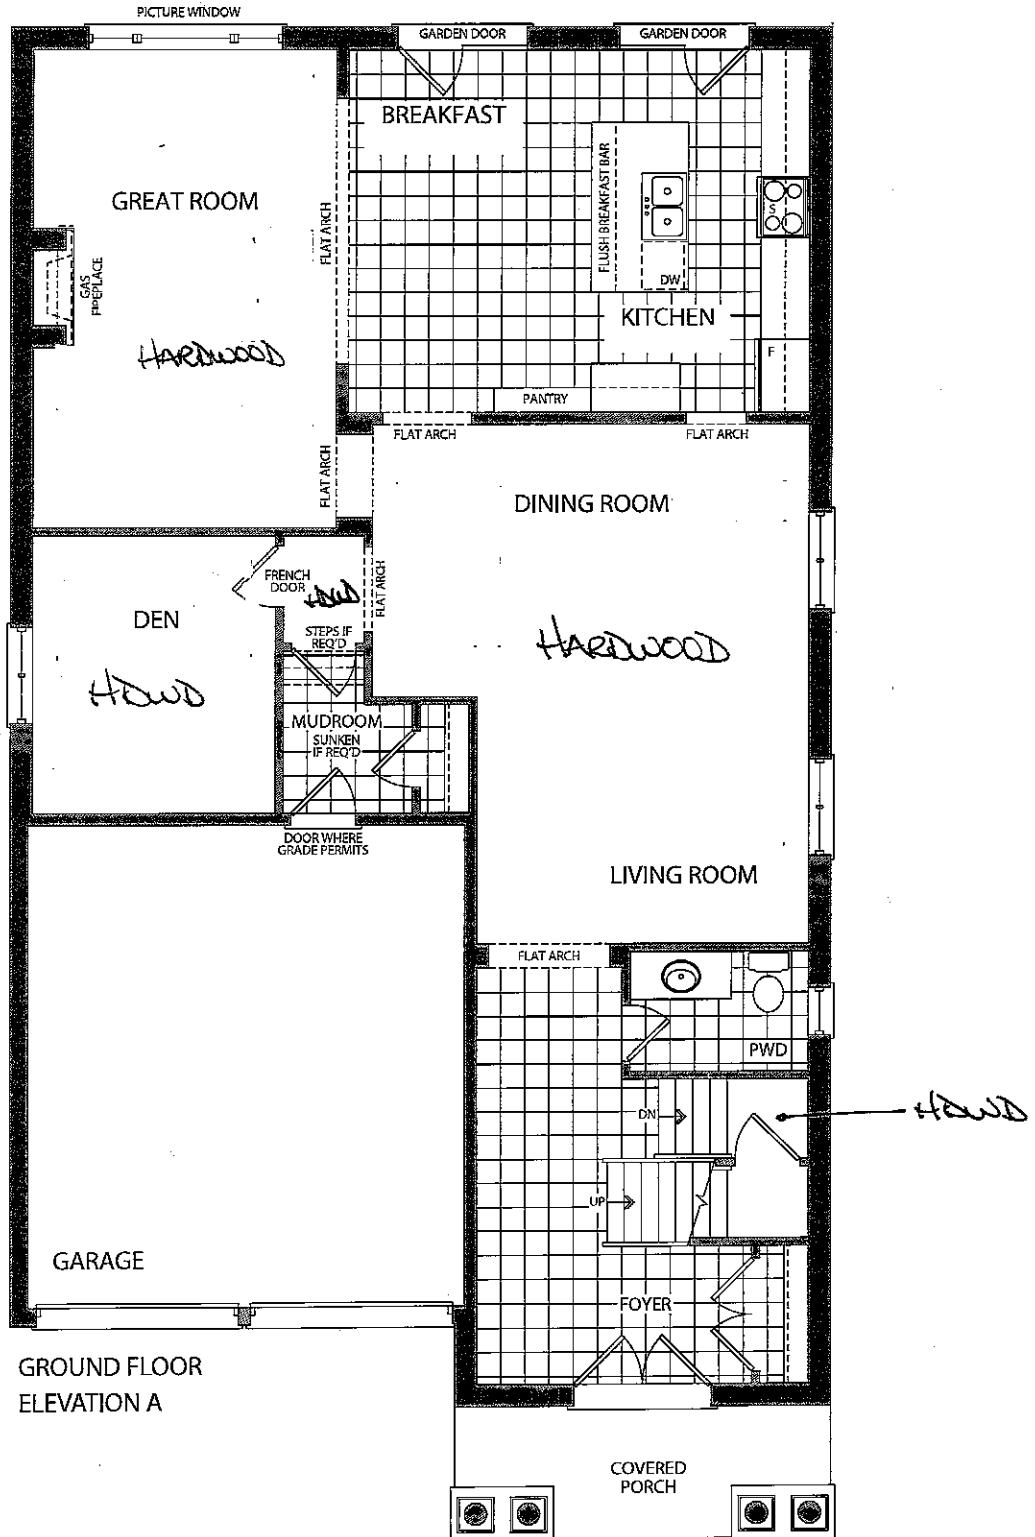



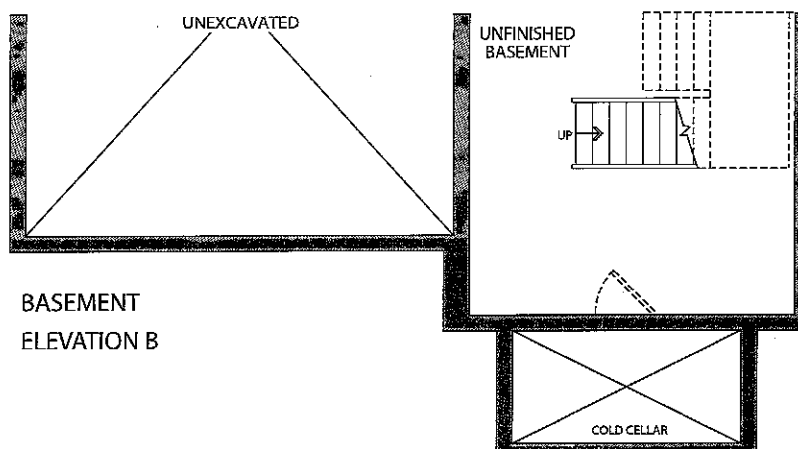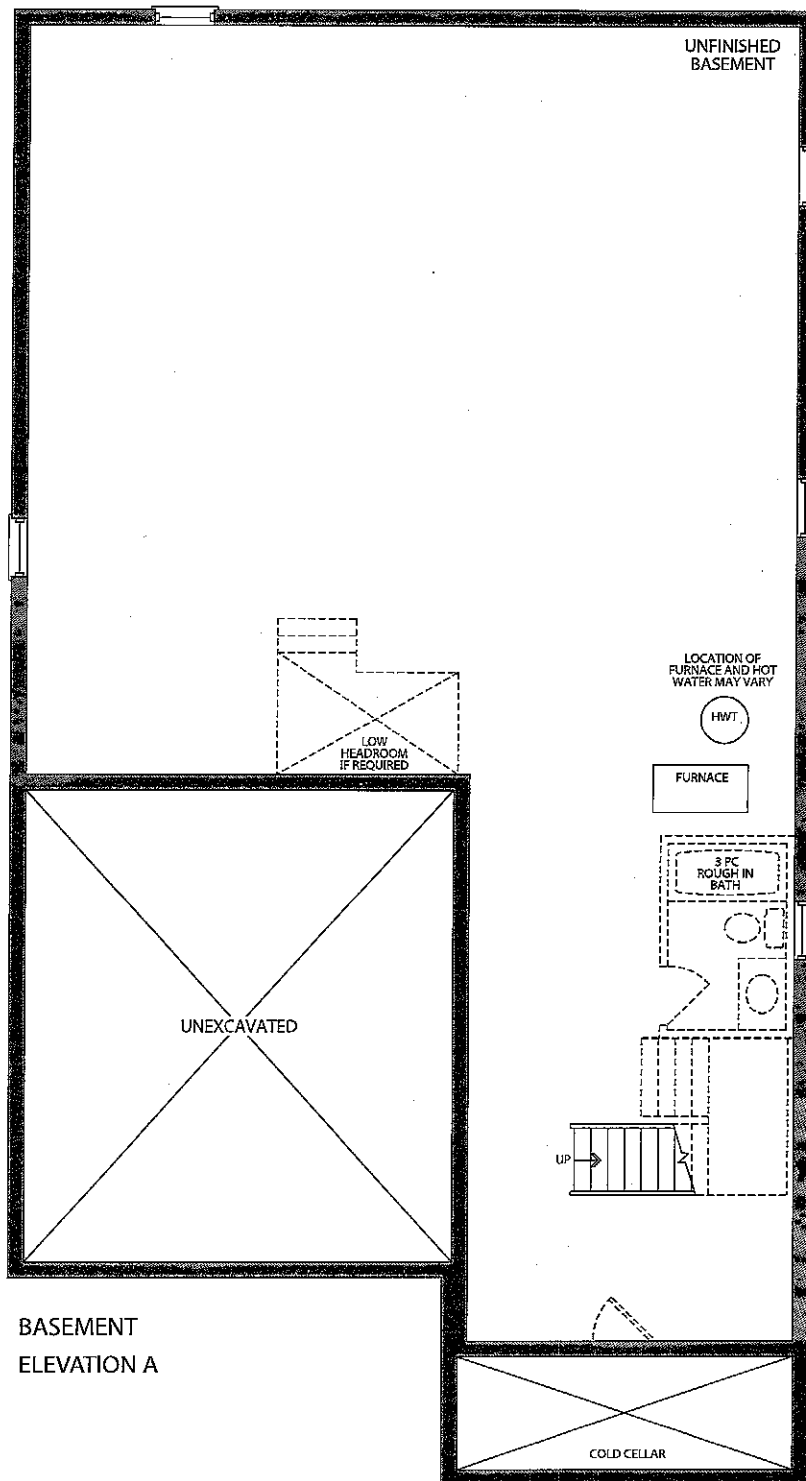

Trade Name: Gold Park Homes	Site location: Kleinburg	Model: 42-3
Address:	Project: Kleinburg Glen	Phase:


This layout has been explained to the purchaser by Cortina Kitchens Inc. and is understood by the purchaser.

* 2-TONE


* STACKED UPPERS

QUARTZ WATER-FALL
(both sides)

RECYCLE

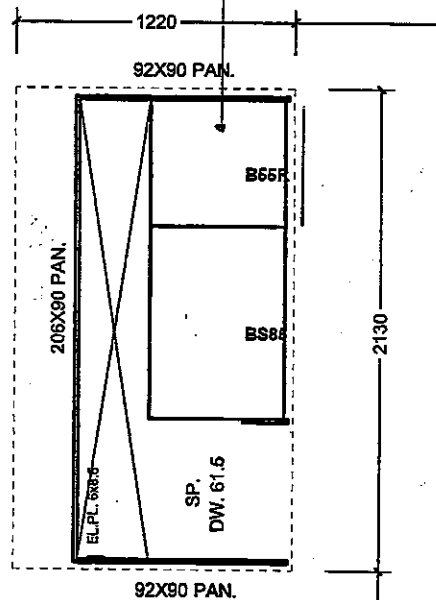


G.B.O.

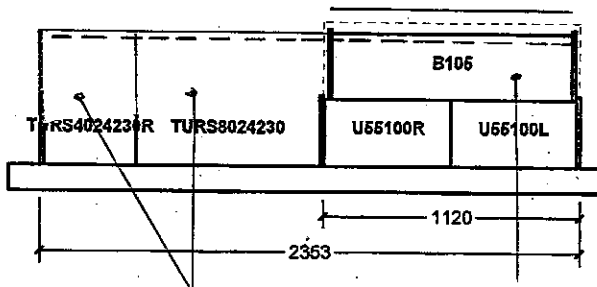

DEEP PANTRY

LONG TOP DRAWER

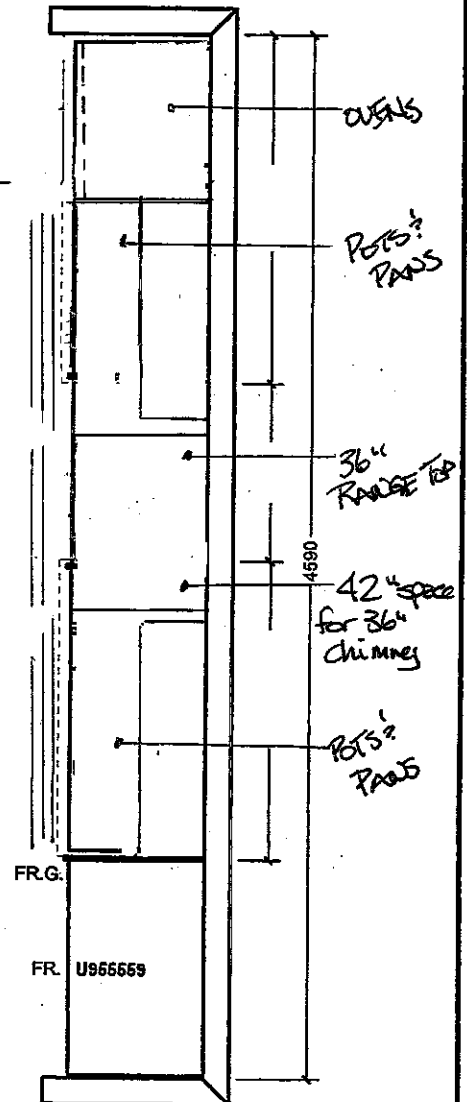

All prices subject to confirmation from head office.
This quotation is subject to the terms & conditions set out

ACCEPTED DATE: _____

All agreements are contingent upon strikes, accidents, and delays beyond our control.
Please provide our installer with template for sinkholes or \$150.00 will be charged for callback.

Item A. Wood grain and colour are characteristics of the product. We cannot guarantee that such grain and colour will always match.
Item B. Cortina Kitchens Inc. reserves the right to alter dimensions and make technical changes without notice.

CORTINA

70 Regina Road, Woodbridge, Ontario L4L 8L8
Tel: 905-204-6464 Fax: 905-204-0884
www.CortinaKitchens.com

K62-28

April 7 2018

QUOTATION

Date: 29/06/16

Trade Name: Gold Park Homes

Site location:






Model: 42-3

Address:





Project: Kleinburg Glen

Phase:

This layout has been explained to the purchaser by Cortina Kitchens Inc. and is understood by the purchaser.

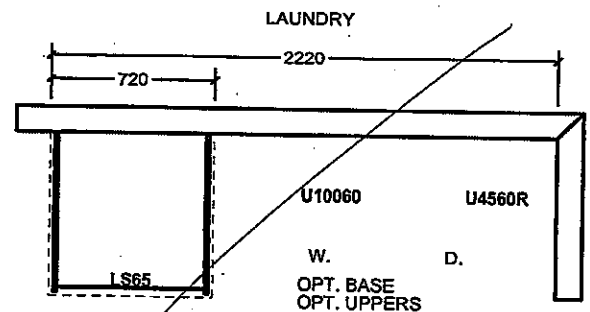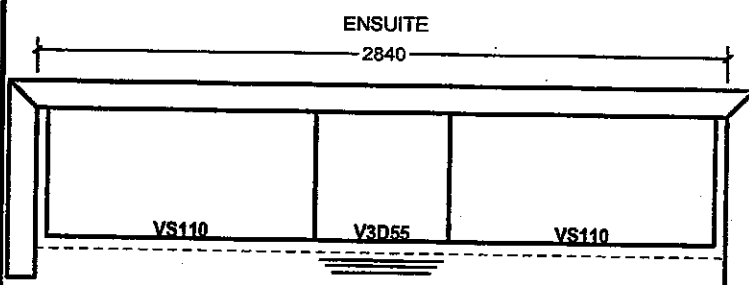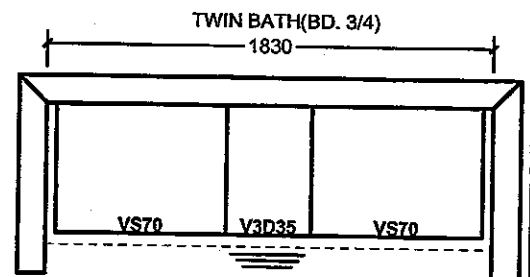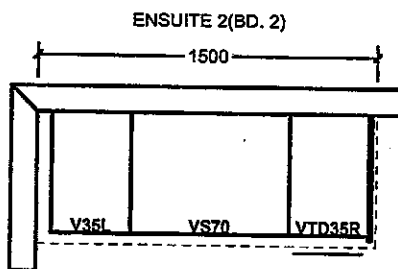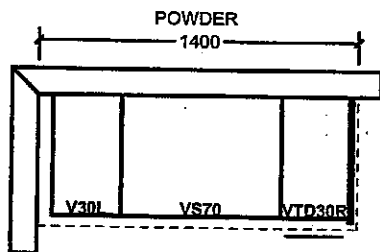

OPT. SECOND FLOOR

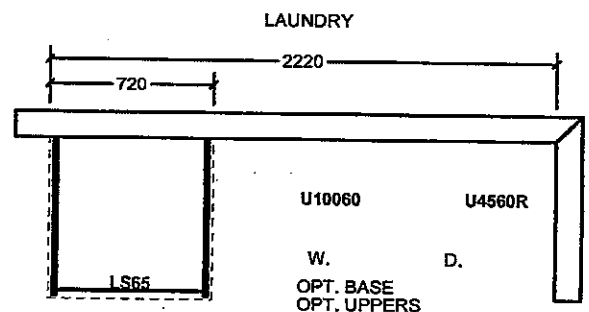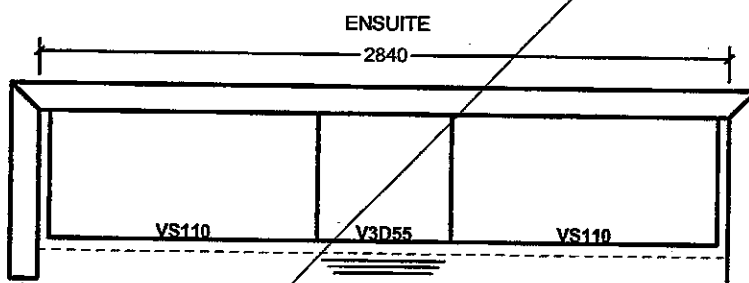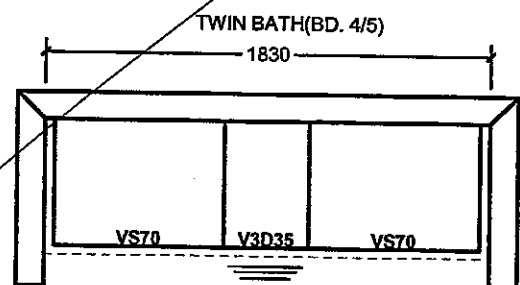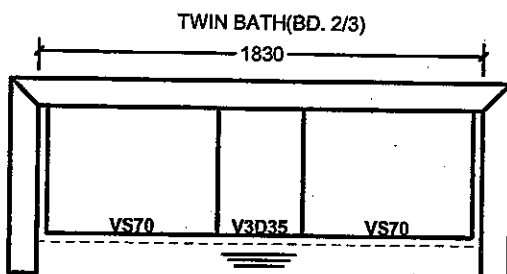

All prices subject to confirmation from head office.
This quotation is subject to the terms & conditions set out

ACCEPTED DATE: _____

All agreements are contingent upon strikes, accidents, and delays beyond our control.
Please provide our installer with template for sinkholes or \$150.00 will be charged for callback.

Item A. Wood grain and colour are characteristics of the product. We cannot guarantee that such grain and colour will always match.
Item B. Cortina Kitchens Inc. reserves the right to alter dimensions and make technical changes without notice.

GOLD PARK

WORTH MORE



Granite, Marble,
Engineered Surfaces

- Standard 2CM & 3CM
- ⊖ Upgrade 1 2CM & 3CM
- ⊗ Upgrade 1 4 CM
- ⊕ Upgrade 2


KG-28

April 16 2018


Backrooms



KITCHEN

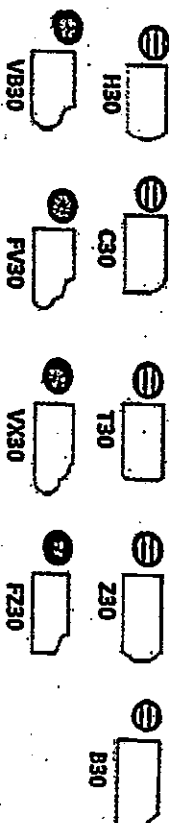

40mm 1 1/2" Profiles

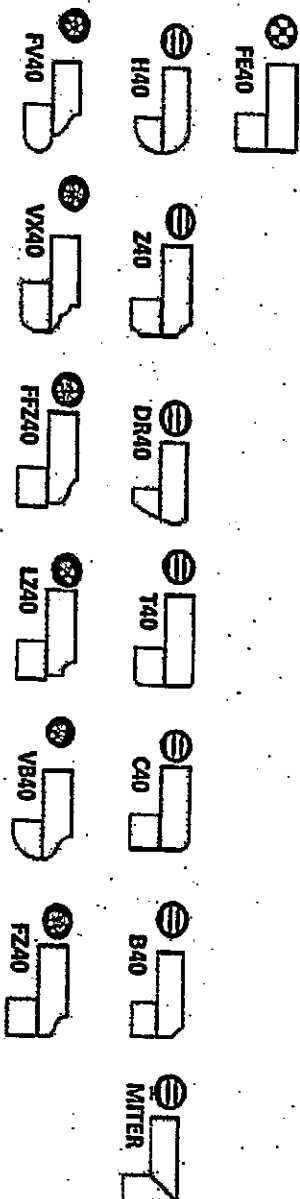


Note: All colours may not be available in 30mm at time ordered. Vendor reserves the right to use 40 mm edges (by lamination process).

*Mitre edge is available in Upgrade 1 for an overall thickness of 2". All other Mitre edge options will be an Upgrade 2 Edge.

SCB711

Cyclone®
Innovation by Design - Since 1991

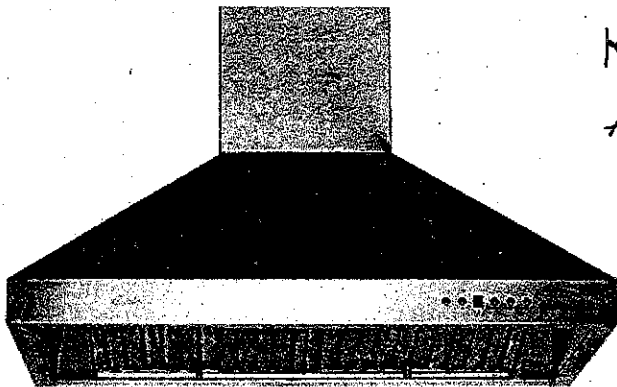


KG-28
April 16 2008

Wall Mount

Bold and masculine by design, the professional grade range hood. A three-speed push button control panel gives you complete control of the fan while bright LED lights illuminate the cooking area. Comes with strong, easily removable, dishwasher-safe baffle filters to keep your kitchen clean and to keep you breathing easy.

Specifications

- Air Flow Volume: 650 CFM
- Electrical Connection: 120V/60Hz
- Electrical Consumption: 200 Watts
- Fan Speed: 1299 RPM
- Finishes: Stainless Steel
- Venting: 6" Round - Top Only
- Dimensions: Width: 30"/36"
Height: 50"
Depth: 24"
- Sones: Min. 2
Max. 7

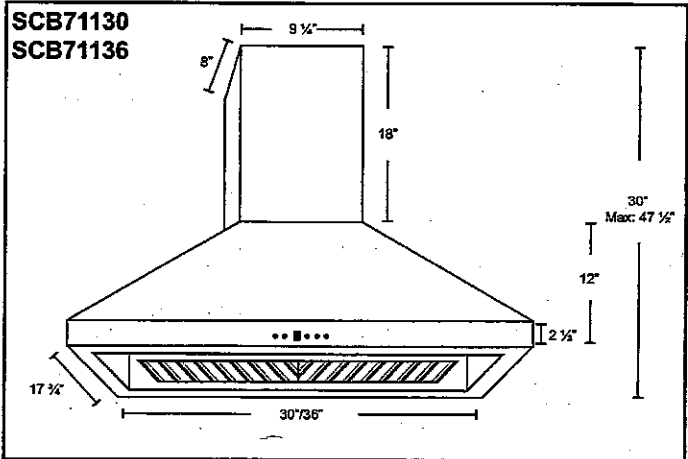

Model	Colour	Venting	Size
SCB71130	Stainless Steel	6"	30"
→ SCB71136	Stainless Steel	6"	36" ←

CORTINA

UPGRADE HARDWARE

KG - 28
APRIL 6 2018

MODIFIED: 19/05/16 K

UPGRADE HARDWARE




CH-32




CH-38




CH-44

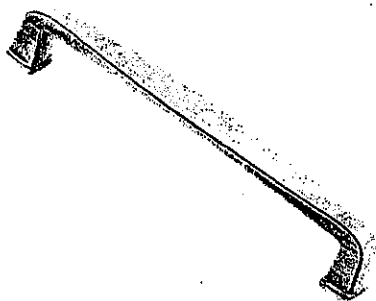


CH-45

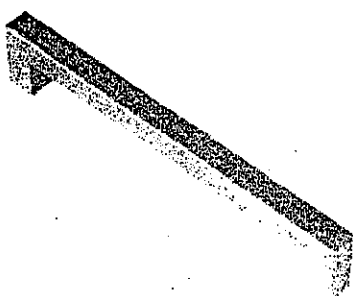


CH-46

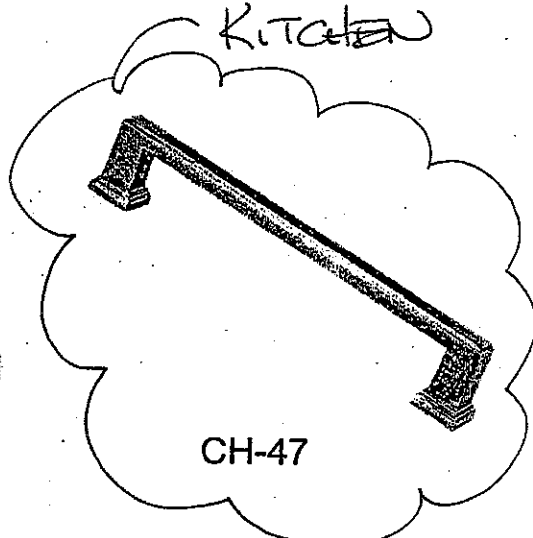


CH-47

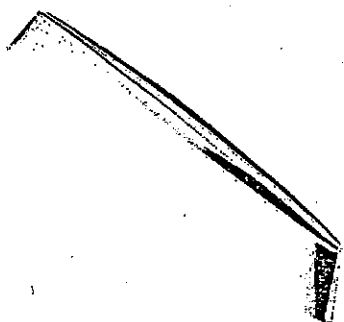


CH-48

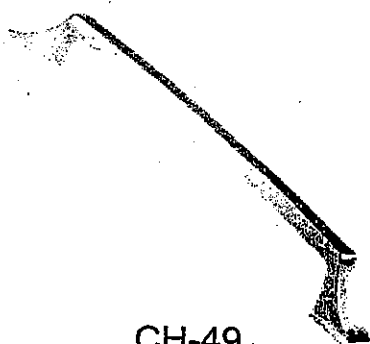


CH-49

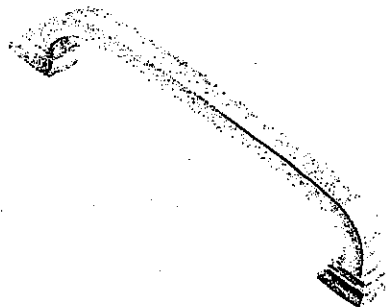


CH-50

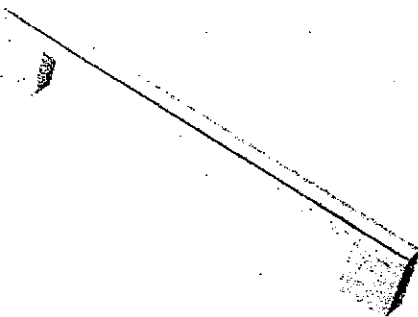

CH-51

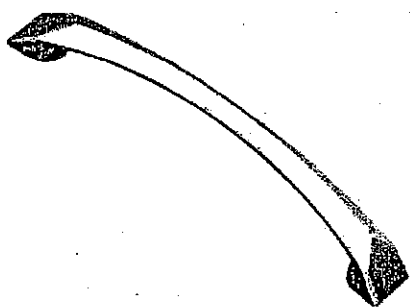

CH-52

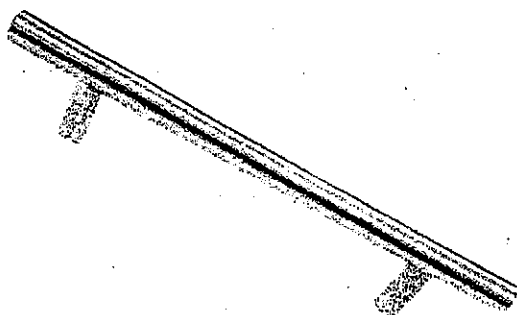

CH-53

***NOTES:**
- IMAGES ARE FOR QUICK REFERENCE PURPOSES ONLY
- ACTUAL SIZES AND FINISHES AS PER HARDWARE
SAMPLE BOARD PROVIDED TO DECOR CENTRE

CORTINA

STANDARD HARDWARE

MODIFIED: 19/05/18

KG-28
April 10 2018

STANDARD HARDWARE




CSI-6




CSI-10




CSI-14

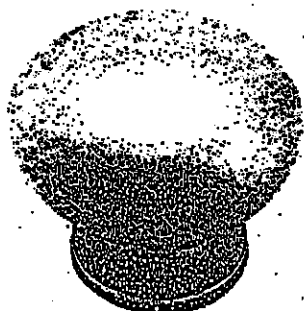

CSI-16

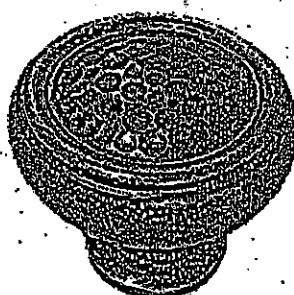

CSI-18

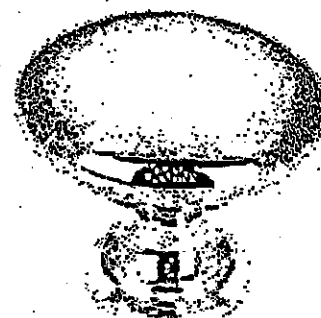

CSI-19



CSI-20




CSI-21




CSI-22

*POWDER
+
MASTER*


*END 2
+
TWIN*

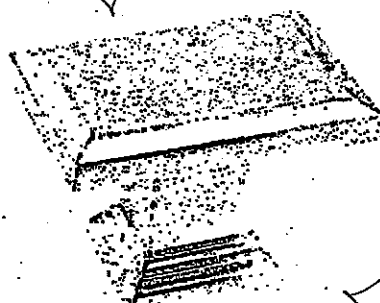

CSI-23

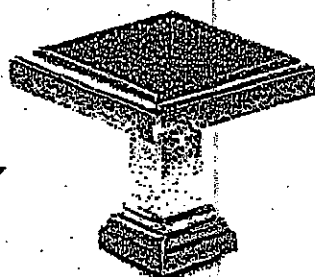

CSI-24


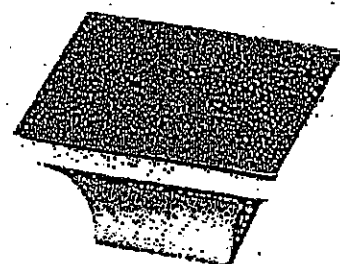


CSI-25

*NOTES:



- IMAGES ARE FOR QUICK REFERENCE PURPOSES ONLY
- ACTUAL SIZES AND FINISHES AS PER HARDWARE
- SAMPLE BOARD PROVIDED TO DECOR CENTRE

Blanco Quatrus U Super Single kitchen sink #401248 (stainless)


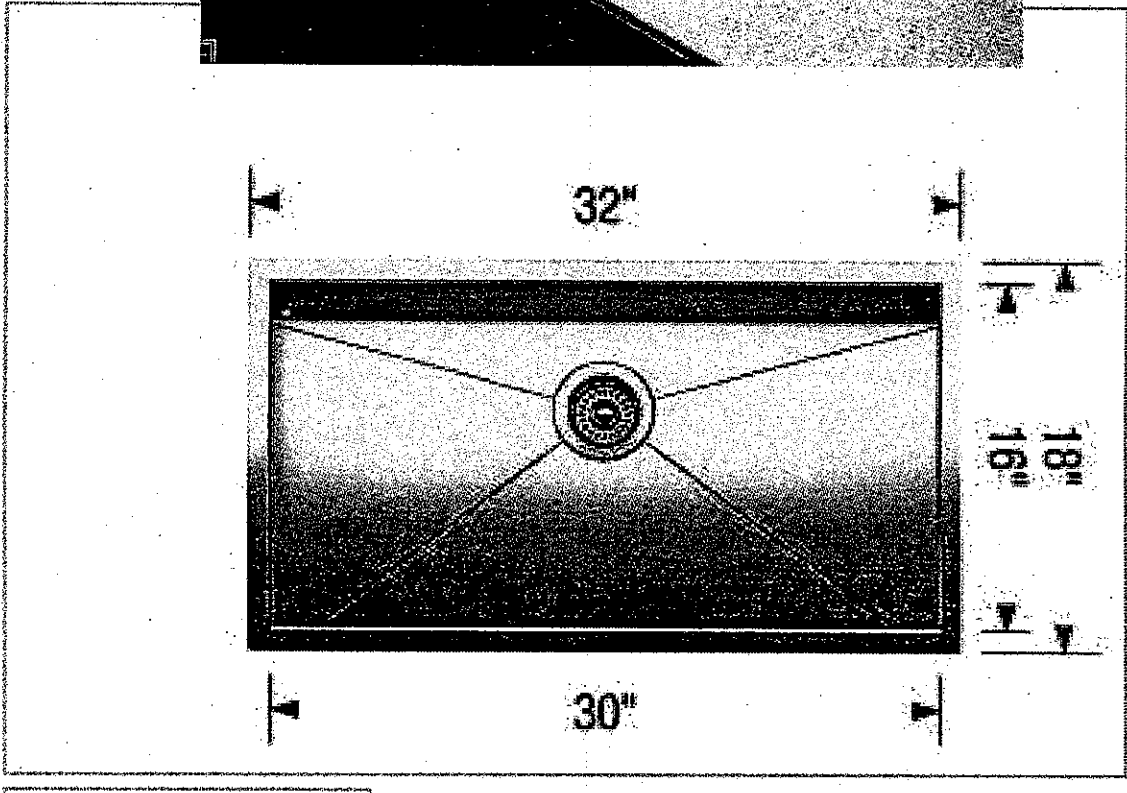
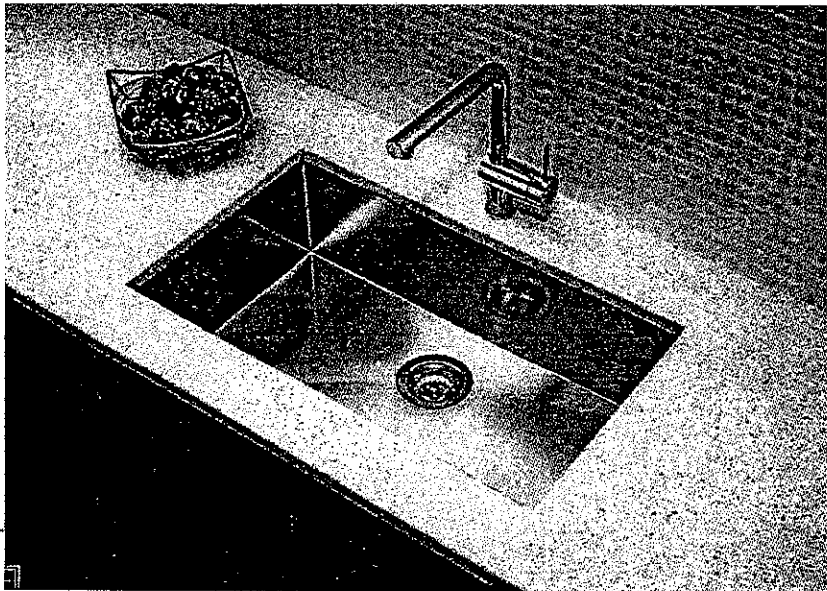


LOT # 28	
ROOM: Kitchen	SIGNATURE:
DATE: April 6 2018	SIGNATURE:

Contrac 'Collette' rectangular under mount sink (white) #4220CTV

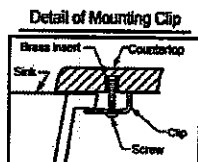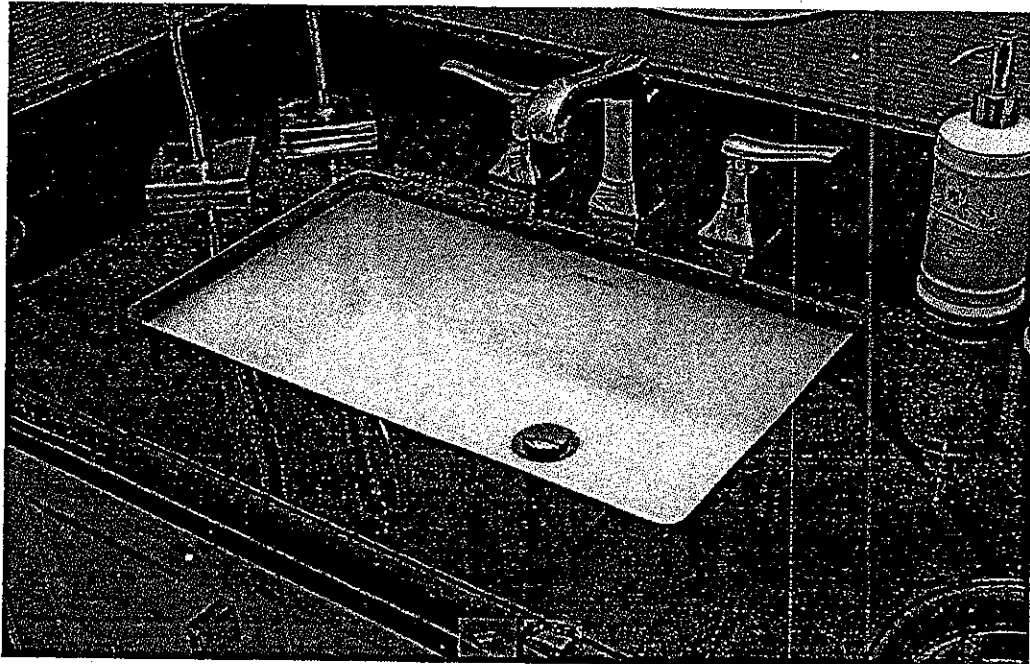

Note:
▲ Dimensions shown for
location of supplies
and 1" trap are
suggested.

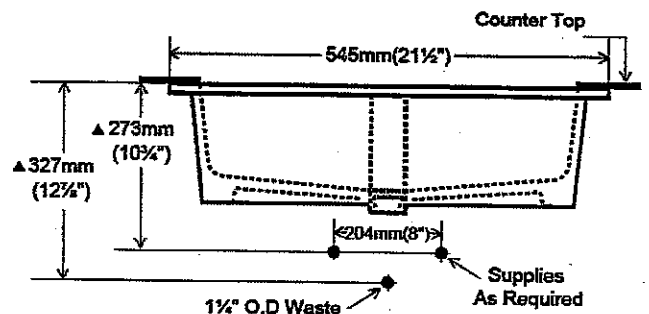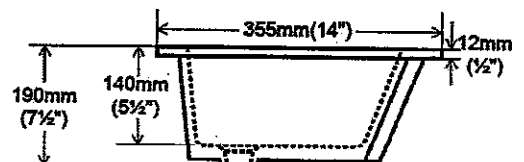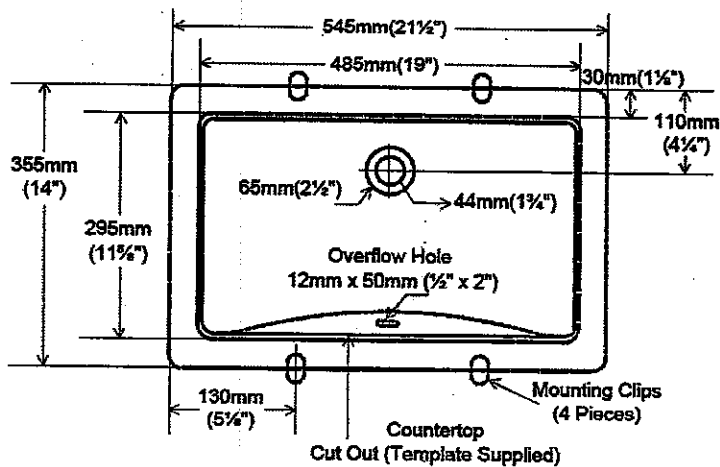

LOT #

28

ROOM:

MASTER ENSUITE

SIGNATURE:


DATE:

APRIL 16 2018

SIGNATURE:

Camden

4210CHY 16" Square Undermount Sink

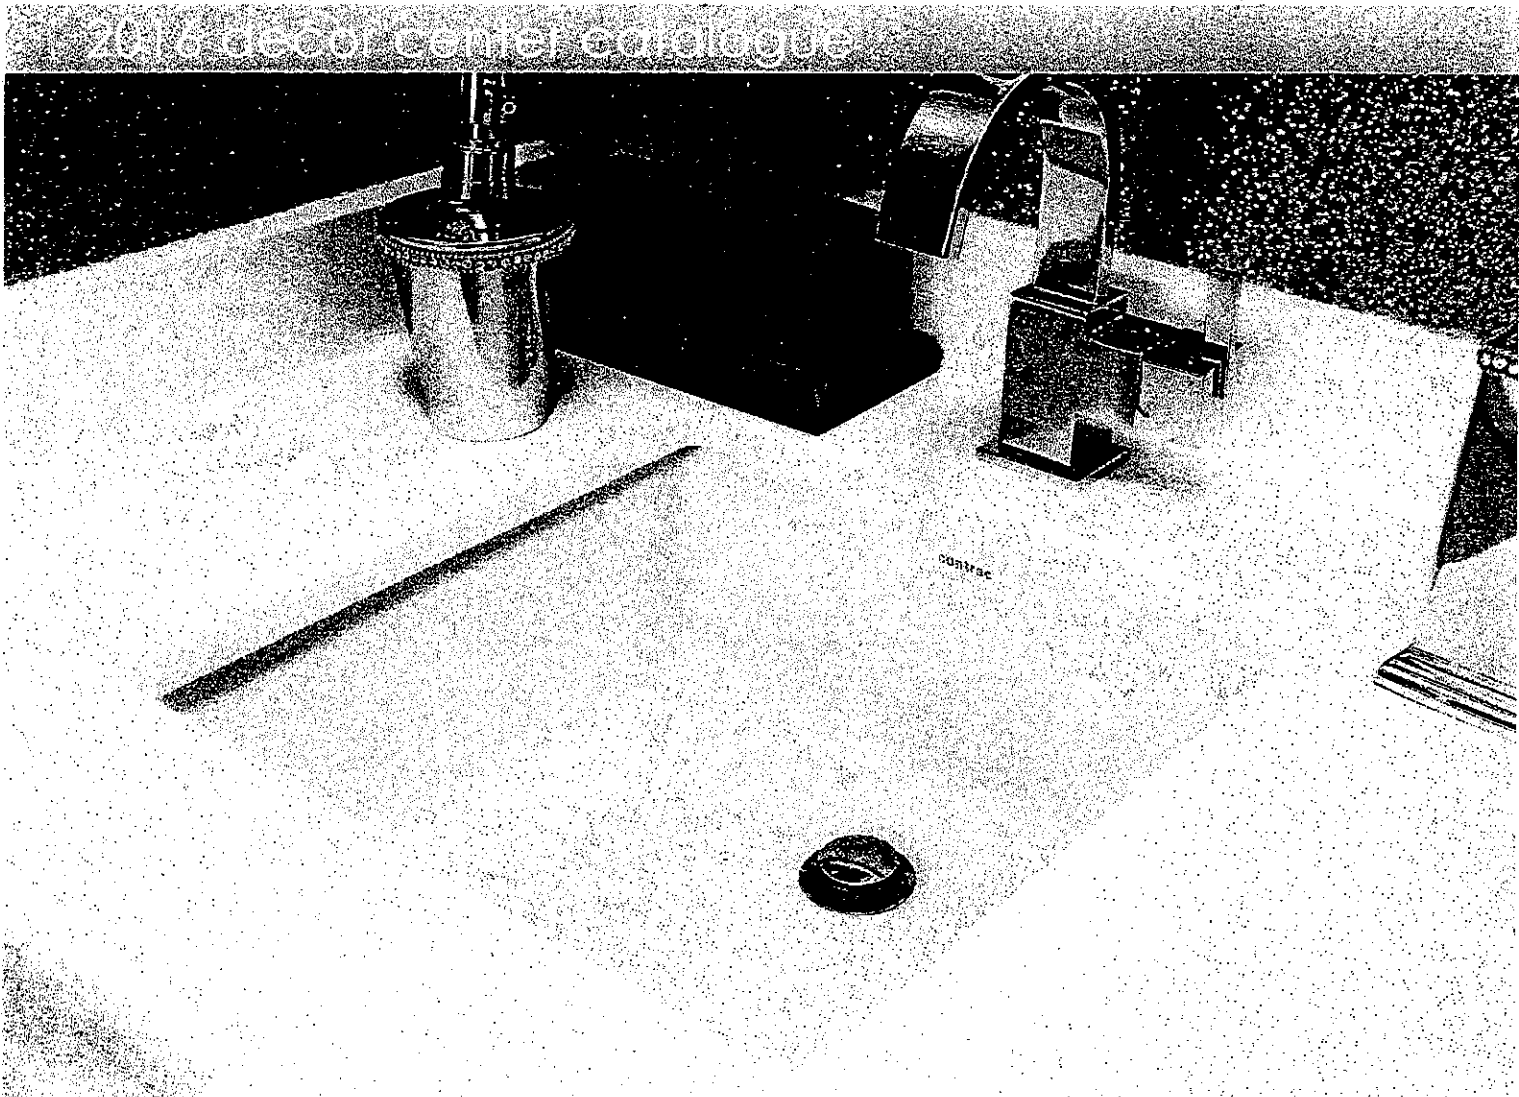

FEATURES
Vitreous china
Front overflow hole
Template and mounting hardware supplied
Overall dimensions (W x D x H):
(OD) 16" x 16" x 7½"
(ID) 13⅞" x 13⅞" x 5½"

CERTIFICATIONS
IAPMO cUPC
ASME A112.19.2 / CSA B45.1-2008

COLOUR
Soft white

LOT #
28

ROOM: Powder/Ens. 2/Twin	SIGNATURE:
DATE: April 16 2018	SIGNATURE: