

Kleinburg Glen - 87 - 1 - 42-5 Elev.B MADISON

CENTRAL VAC AND WIRING

Inv.1,144	1 - GREAT ROOM: CONDUIT PIPE - FOR TELEVISION - Locate approx. 66" A.F.F. above fireplace, terminating beside cable outlet, see plan for location.
Line18277	Note:
30Jan17 / 17Mar17	
Inv.1,144	2 - GREAT ROOM & MASTER ENSUITE: CAT 6 WIRING - UPGRADE AN OUTLET TO CAT 6 - See plan for location.
Line18276	Note:
30Jan17 / 17Mar17	

CERAMIC

Inv.1,797	1 - MASTER ENSUITE SHOWER WALL TILE: UPGRADE 2
Line26414	Note: LAID IN HORIZONTAL STACKED PATTERN
18Mar18 / 4May18	
Inv.1,797	1 - MASTER ENSUITE FLOOR TILE: UPGRADE 4 - 12X24" POLISHED
Line26413	Note: LAID IN STRAIGHT, STACKED PATTERN. SEE PLAN FOR TILE DIRECTION
18Mar18 / 4May18	
Inv.1,797	1 - FOYER / POWDER ROOM / LOWER LANDING: UPGRADE 5 FLOOR TILE - 24X24" POLISHED
Line26387	Note:
18Mar18 / 4May18	
Inv.1,797	1 - KITCHEN: BACKSPLASH UPGRADE 4 MARBLE MOSAIC
Line26389	Note:
18Mar18 / 4May18	

CROWN MOULDING

Inv.1,797	1 - GREAT ROOM: 7 BOX BEAM DETAIL CTR-B07
Line26390	Note:
18Mar18 / 4May18	

DRYWALL

Inv.1,144	1 - 2ND FLOOR: SMOOTH CEILINGS - (2 - Story Design) 2ND FLOOR
Line16911	Note:
30Jan17 / 17Mar17	

ELECTRICAL

Inv.1,144	1 - KITCHEN: RELOCATE STANDARD FIXTURE - Locate above island, see plan for location.
Line18279	Note:
30Jan17 / 17Mar17	
Inv.1,144	1 - GREAT ROOM: 110V WALL RECEPTACLE ON NORMAL CIRCUIT - Install approx. 66" A.F.F. above fireplace for future tv.
Line18278	Note:
30Jan17 / 17Mar17	
Inv.1,144	1 - KITCHEN: Add a ROUGH - IN CEILING OUTLET ON SAME SWITCH - DOES NOT INCLUDE FIXTURE - above island, use same switch as standard ceiling light. See plan for location.
Line18280	Note:
30Jan17 / 17Mar17	

Kleinburg Glen - 87 - 1 - 42-5 Elev.B MADISON

Inv.1,144	8 - KITCHEN: POT LIGHT: 4 INCH HALOGEN POT LIGHT - 440 WH - PRICED PER LIGHT - 10 OR MORE
Line18281	Note:
30Jan17 / 17Mar17	
Inv.1,144	1 - KITCHEN: Single pole switch for potlights
Line18288	Note:
30Jan17 / 17Mar17	
Inv.1,144	8 - LIVING & DINING ROOM: POT LIGHT: 4 INCH HALOGEN POT LIGHT - 440 WH - PRICED PER LIGHT - 10 OR MORE
Line18289	Note:
30Jan17 / 17Mar17	
Inv.1,144	2 - LIVING & DINING ROOM: Single pole switch for potlights.
Line18290	Note:
30Jan17 / 17Mar17	
Inv.1,144	1 - KITCHEN: 110V WALL RECEPTACLE ON DEDICATED CIRCUIT - FOR MICROWAVE - MICROWAVE NOT INCLUDED
Line18291	Note:
30Jan17 / 17Mar17	
Inv.1,144	1 - KITCHEN: 220V WALL RECEPTICAL ON DEDICATED CIRCUIT - FOR 4 WIRE BUILT - IN WALL OVEN - See plan for location.
Line18292	Note:
30Jan17 / 17Mar17	
Inv.1,144	1 - KITCHEN: 110V WALL RECEPTACLE ON DEDICATED CIRCUIT for future 600+ cfm hood fan.- See plan for location.
Line18293	Note:
30Jan17 / 17Mar17	
Inv.1,144	1 - KITCHEN: 110V WALL RECEPTACLE ON DEDICATED CIRCUIT - GAS FIRED APPLIANCE - FOR AUX. EQUIPMENT - NOT A STOVE PLUG
Line18295	Note:
30Jan17 / 17Mar17	
Inv.1,144	6 - GREAT ROOM: POT LIGHT: 4 INCH HALOGEN POT LIGHT - 440 WH - PRICED PER LIGHT - 10 OR MORE
Line18303	Note:
30Jan17 / 17Mar17	
Inv.1,144	1 - GREAT ROOM: Single pole switch for potlights
Line18304	Note:
30Jan17 / 17Mar17	

EXTERIOR COLOURS

Inv.1,144	1 - EXTERIOR COLOUR PACKAGE 10
Line16922	Note:
30Jan17 / 17Mar17	

FRAMING

Inv.1,144	1 - MAIN FLOOR CEILING 10FT- 8' INTERIOR DOORS AND ARCHES, TALLER FRONT AND REAR ELEVATION DOORS AND WINDOWS WITH TRANSOM, KITCHEN FURRING PANEL WITH CROWN AND 12" BULKHEAD
Line18297	Note:
30Jan17 / 17Mar17	

Kleinburg Glen - 87 - 1 - 42-5 Elev.B MADISON

Inv.1,144	3 - 2nd floor: Frame for taller archways - 96"
Line18299	Note:
30Jan17 / 17Mar17	

Inv.1,144	1 - 2ND FLOOR: STANDARD DOOR EXTENDED HEIGHT 96 INCH (PRICE PER DOOR) MAIN FLOOR 2 STOREY MODELS - 96"
Line19191	Note:
30Jan17 / 17Mar17	

GLASS AND MIRROR

Inv.1,144	1 - MASTER ENSUITE: CONVERT FRAMED SHOWER TO 10MM FRAMLESS SHOWER ENCLOSURE WITH DOOR AND 10MM SIDE PANEL
Line18300	Note:
30Jan17 / 17Mar17	

GRANITE MARBLE QUARTZ

Inv.1,797	1 - KITCHEN: COOKTOP CUT OUT
Line26408	Note:
18Mar18 / 4May18	

Inv.1,797	1 - POWDER ROOM: UPGRADE 3 STONE
Line26410	Note:
18Mar18 / 4May18	

Inv.1,797	1 - KITCHEN: UPGRADE EDGE PROFILE 4CM
Line26407	Note:
18Mar18 / 4May18	

Inv.1,797	1 - KITCHEN: UPGRADE 5 QUARTZ
Line26392	Note:
18Mar18 / 4May18	

HARDWOOD

Inv.1,797	1 - MAIN FLOOR - GREAT ROOM / DINING ROOM / LIVING ROOM / MAIN HALL / DEN: UPGRADE 4 - 'VINTAGE' 5" WHITE OAK HAND SCRAPED
Line26416	Note:
18Mar18 / 4May18	

Inv.1,797	1 - UPPER HALL: UPGRADE 4 - 'VINTAGE' 5" WHITE OAK HAND SCRAPED
Line26417	Note:
18Mar18 / 4May18	

Inv.1,797	1 - KITCHEN: UPGRADE 4 - 'VINTAGE' 5" WHITE OAK HAND SCRAPED
Line26418	Note:
18Mar18 / 4May18	

HVAC

Inv.1,144	1 - KITCHEN: GAS LINE ROUGH - GROUND FLOOR FOR future gas cooktop
Line18294	Note:
30Jan17 / 17Mar17	

Inv.1,144	1 - KITCHEN: UPGRADE VENTING FOR STOVE TO 8 INCH PIPE EXTERIOR WALL
Line18296	Note:
30Jan17 / 17Mar17	

INTERIOR TRIM AND DOORS

Kleinburg Glen - 87 - 1 - 42-5 Elev.B MADISON

Inv.1,144	3 - 2ND FLOOR: EXTENDED HEIGHT ARCHWAY (PRICE PER DOORWAY) - INCLUDE FRAMING NOTE
Line16918	Note:
30Jan17 / 17Mar17	
Inv.1,144	19 - 2ND FLOOR: STANDARD DOOR EXTENDED HEIGHT 96 INCH (PRICE PER DOOR) MAIN FLOOR 2 STOREY MODELS - 96"
Line16919	Note:
30Jan17 / 17Mar17	
Inv.1,144	3 - 2ND FLOOR: EXTENDED HEIGHT ARCHWAY (PRICE PER DOORWAY) - 96"
Line18301	Note:
30Jan17 / 17Mar17	
Inv.1,144	1 - MAIN FLOOR CEILING 10FT- 8' INTERIOR DOORS AND ARCHES, TALLER FRONT AND REAR ELEVATION DOORS AND WINDOWS WITH TRANSOM, KITCHEN FURRING PANEL WITH CROWN AND 12" BULKHEAD
Line19192	Note:
30Jan17 / 17Mar17	

KITCHEN AND BATH CABINETRY

Inv.1,144	1 - MAIN FLOOR CEILING 10FT- 8' INTERIOR DOORS AND ARCHES, TALLER FRONT AND REAR ELEVATION DOORS AND WINDOWS WITH TRANSOM, KITCHEN FURRING PANEL WITH CROWN AND 12" BULKHEAD
Line19193	Note:
30Jan17 / 17Mar17	
Inv.1,797	1 - KITCHEN: UPGRADE HARDWARE
Line26528	Note:
18Mar18 / 4May18	
Inv.1,797	1 - MASTER ENSUITE: UPGRADE 2 STONE COUNTER
Line26411	Note:
18Mar18 / 4May18	
Inv.1,797	1 - KITCHEN: ADJUST CABINETS FOR 36" COOKTOP AND HOOD FAN
Line26377	Note:
18Mar18 / 4May18	
Inv.1,797	1 - KITCHEN: UPGRADE 4 CABINET PROFILE
Line26378	Note:
18Mar18 / 4May18	
Inv.1,797	1 - KITCHEN: BUILT-IN OVEN AND MICROWAVE CABINET AND COOKTOP
Line26379	Note:
18Mar18 / 4May18	
Inv.1,797	1 - KITCHEN: L-SHAPED CANOPY, COMPLETE WITH 600 CFM FAN
Line26380	Note:
18Mar18 / 4May18	
Inv.1,797	3 - KITCHEN: POTS AND PANS DRAWERS - 1 SHALLOW TOP DRAWER + 2 DEEP DRAWERS
Line26381	Note:
18Mar18 / 4May18	
Inv.1,797	4 - KITCHEN: TOP DRAWER
Line26382	Note:
18Mar18 / 4May18	

Kleinburg Glen - 87 - 1 - 42-5 Elev.B MADISON

Inv.1,797	2 - KITCHEN: PULL OUT SPICE DOOR, 2 LEVEL (SINGLE DOOR WITH 2 LEVEL WITH MULTI-TECH TRACKS ATTACHED TO DOOR)
Line26385	Note:
18Mar18 / 4May18	
Inv.1,797	1 - KITCHEN *ISLAND*: TWO COLUMN WITH RECESSED POSTS AND FRONT AND BACK AND WAINSCOTT PANEL SIDE, 1 AT EITHER END OF ISLAND + FURNITURE KICK AT SIDES AND BACK OF ISLAND
Line26386	Note:
18Mar18 / 4May18	
Inv.1,797	1 - KITCHEN: RAISE CABINETS FOR HARDWOOD FLOOR
Line26711	Note:
18Mar18 / 4May18	

PAINT

Inv.1,797	1 - MAIN STAIRS: STAIN STAIRS TO MATCH HARDWOOD, AS CLOSE AS POSSIBLE
Line26419	Note:
18Mar18 / 4May18	

PLUMBING

Inv.1,797	1 - POWDER ROOM: UPGRADE SINK TO CONTRAC 'CAMDEN' SQUARE UNDERMOUNT
Line26527	Note:
18Mar18 / 4May18	

PLUMBING FIXTURES

Inv.1,797	2 - MASTER ENSUITE: RECTANGULAR UNDER MOUNT SINK - CONTRAC 'COLETTE'
Line26412	Note:
18Mar18 / 4May18	
Inv.1,797	1 - KITCHEN SINK: STAINLESS STEEL UNDERMOUNT SINK BLANCO QUATRUS R15U #401518
Line26409	Note:
18Mar18 / 4May18	

STAIRS AND RAILINGS

Inv.1,797	1 - MAIN STAIRS: EUROLINE 2 + V GROOVE
Line26420	Note:
18Mar18 / 4May18	

WINDOWS - BASEMENT

Inv.1,144	5 - BASEMENT WINDOWS - UPGRADE EXISTING BASEMENT WINDOW TO 30 INCH X 16 INCH
Line16910	Note:
30Jan17 / 17Mar17	

WINDOWS AND DOORS

Inv.1,144	1 - MAIN FLOOR CEILING 10FT- 8' INTERIOR DOORS AND ARCHES, TALLER FRONT AND REAR ELEVATION DOORS AND WINDOWS WITH TRANSOM, KITCHEN FURRING PANEL WITH CROWN AND 12" BULKHEAD
Line19194	Note:
30Jan17 / 17Mar17	

Purchaser: Gold Park Homes
 Telephone Res. / Bus: (905) 760-9595
 Decor Advisor: Yolande Somerville

Property: 87

Project: Kleinburg Glen - Phase 1

Model and Elevation: 42-5 Elev.B MADISON

Layout Changes: ☐ Yes ☒ No Sketch Attached: ☒ Yes ☐ No Exterior Colour Scheme:

1. Cabinetry

	Style and Colour	Counter	Hardware
Kitchen / Breakfast	*Florentine mdf 'fog grey'	*C.S. 'Frosty Carina'	*ch-47
Laundry Room	n/a	n/a	n/a
Powder Room	M-600 mel. 'mystic'	*C.S. Piatra Grey'	cs1-23
Mud Room	M-600 mel. 'mystic'	P-Lam #4971-52	cs1-23
Master Ensuite Bathroom	Venice pvc 'Mystic'	*C.S. 'Ice Snow'	cs1-23
Second Ensuite Bathroom (If Applicable)	Varese pvc 'Mystic'	P-Lam #P-344-LM	cs1-24
Twin Bathroom	Varese pvc 'Mystic'	P-Lam #P-344-LM	cs1-24
Dishwasher Cabinet			

Comment

2. Floor Tile

	Selection	Grout	Threshold
Entrance Vestibule	*24x24" Eterna pol. 'Dark Grey'		
Main Hall	n/a		
Kitchen / Breakfast	n/a		
Laundry Room	13x13" New Reeds 'Brown'		
Powder Room	*24x24" Eterna pol. 'Dark Grey' (& Landing)		
Mud Room	13x13" New Reeds 'Brown'		
Master Ensuite Bathroom	*12x24" Carrara X pol. 'White/Grey'		
Second Ensuite Bathroom (If Applicable)	13x13" New Byzantine 'Pentellic Grey'		
Lower Landing (If Applicable)	n/a		
Twin Bath	13x13" New Byzantine 'Pentellic Grey'		

Comment

3. Wall Tile

	Selection	Listello/Inserts	Describe
Master Ensuite Bathroom		☐ Yes ☒ No	
Tub Deck	n/a	☐ Yes ☒ No	
Shower Stall	*4x16" CDC Bright Petal 'Arct Wht'	☐ Yes ☒ No	
Bathroom Walls	n/a	☐ Yes ☒ No	
Second Ensuite Bathroom (If Applicable)	8x10" Weave 'Tender Grey'	☐ Yes ☒ No	
Twin Bathroom	8x10" Weave 'White'	☐ Yes ☒ No	

Kitchen Backsplash

☒ Yes ☐ No

Backsplash Behind Fridge

Comment

*GM.ORT.WHT.MOROCCAN

Purchaser: Gold Park Homes

Property: 87

Telephone Res. / Bus: (905) 760-9595

Project: Kleinburg Glen - Phase 1

Decor Advisor: Yolande Somerville

Model and Elevation: 42-5 Elev.B MADISON

4. Plumbing Fixtures

Master Ensuite Bathroom Second Ensuite Powder Room
Other Room - Specify Other Washroom

Comment

Standard thru out except sinks

5. Hardwood Flooring

	Type and Stain		Type and Stain
Main Hall	*5" Wht oak HScrape 'Gotham'	Upper Landing	n/a
Kitchen / Breakfast	*5" Wht oak HScrape 'Gotham'	Upper Hall	*5" Wht oak HScrape 'Gotham'
Living Room	*5" Wht oak HScrape 'Gotham'	Master Bedroom	n/a
Dining Room	*5" Wht oak HScrape 'Gotham'	Bedroom #2	n/a
Family Room	*5" Wht oak HScrape 'Gotham'	Bedroom #3	n/a
Den/Library	*5" Wht oak HScrape 'Gotham'	Bedroom #4	n/a
Entrance Vestibule	n/a	Bedroom #5	n/a
Lower Landing (If Applicable)	n/a	Other Room - Specify	

Comment

6. Carpeting

	Upgrade	Description
Main Hall	☐	n/a
Living Room	☐	n/a
Dining Room	☐	n/a
Family Room	☐	n/a
Den/Library	☐	n/a
Upper Hall	☐	n/a
Master Bedroom	☐	Standard 'Pearl White'
Bedroom #2	☐	Standard 'Pearl White'
Bedroom #3	☐	Standard 'Pearl White'
Bedroom #4	☐	Standard 'Pearl White'
Bedroom #5	☐	n/a
	☐	
Upper Landing (If Applicable)	☐	n/a
Lower Landing (If Applicable)	☐	n/a

	Type	Area
Upgrade Underpad		
Carpet on Stairs	Capped	Runner - *Upgrade

Comment

Standard underpad

Purchaser:	Gold Park Homes	Property:	87
Telephone Res. / Bus:	(905) 760-9595	Project:	Kleinburg Glen - Phase 1
Decor Advisor:	Yolande Somerville	Model and Elevation:	42-5 Elev.B MADISON

7. Fireplace

Living Room

Purchased

As Per Plan

N/A

Family Room

Purchased

As Per Plan

N/A

Other Room - Specify

Purchased

As Per Plan

N/A

Fireplace Type

Standard Gas

Mantle Type

Mediterranean

Colour / Stain

Standard

Surround

none

Hearth

standard

Comment

8. Trim Carpentry

Interior Doors

Standard

Front Door Glass Inserts

Standard

Door Handles

Standard

Interior Trim

Standard

Comment

9. Plaster Mouldings and Medallions

Entrance Vestibule

Kitchen/Breakfast

Main Hall

Den/Library

Living Room

Lower Landing

Dining Room

Other Room - Specify

Family Room

*CTR-B07

Comment

10. Railings and Spindles

Railing Package

*Euroline 2 + V Groove

Spindle Colour

*Black

Railing Colour

*Gotham

Treads

*Gotham

Stringer / Riser

*Gotham

Oak Stairs

Yes

No

Comment

11. Wall Paint

Main & Upper Hall

Master Bedroom

Living Room

Bedroom #2

Dining Room

Bedroom #3

Kitchen / Breakfast

Bedroom #4

Family Room

Bedroom #5

Powder Room

Master Ensuite

Laundry Room

Second Ensuite

Den/Library

Thru Out

Warm Grey

Trim Paint

Comment

Smooth Ceilings First Floor

Purchaser: Gold Park Homes
Telephone Res. / Bus: (905) 760-9595
Decor Advisor: Yolande Somerville

Property: 87
Project: Kleinburg Glen - Phase 1
Model and Elevation: 42-5 Elev.B MADISON

12. Electrical

Plugs and Switches ☒ White ☐ Ivory
Hood Fan ☐ White ☐ Ivory
Appliances Built in Cooktop Built in Oven Gas Stove Microwave
☒ Yes ☐ No ☒ Yes ☐ No ☐ Yes ☐ No ☒ Yes ☐ No
Above Kitchen Cabinet Light ☐ Yes ☒ No
Below Kitchen Cabinet Light ☐ Yes ☒ No

Comment

13. Heating and Air Conditioning

Air Conditioning
Gas Provisions Dryer
Gas Provisions Stove
Gas Provisions Barbecue
Comment

14. Additional Comments

15. Disclaimers and Notes

- Colours of all materials are as close as possible to builder's selection, but not necessarily identical due to variances in manufacturing.
- Any extras listed above are null and void unless accompanied by a separate invoice/amendment. Said invoice must be paid in full.
- The Purchaser acknowledges that after Interior Colour Selection form is signed and dated, no further changes will be permitted other than re-selection due to unavailability. _____ Purchaser's Initials
- The Purchaser acknowledges reading and accepting the "Gold Park Homes Decor Centre Disclaimers" form. This document contains other miscellaneous disclaimers.

This Interior Colour Selection is final and approved by:

Signature: _____ Date: _____

No PHONE in
KITCHEN.

HARDWOOD !!
in KITCHEN!!

KG-87

FEB 14 2017

GAS LINE
+
ELECT.

OVEN &
MICRO

66" AFF

7 Box
WATER

10' CEILINGS!

LEGEND

○ STD LIGHT

⊕ COFFED CEILING

⊕ ELECT. RECEPTACLE

* CONDUIT


● POTLIGHT

\$ SINGLE POLE SWITCH


△ ⊕ PHONE

△ ⊕ CABLE

△ ⊕ CAT 6

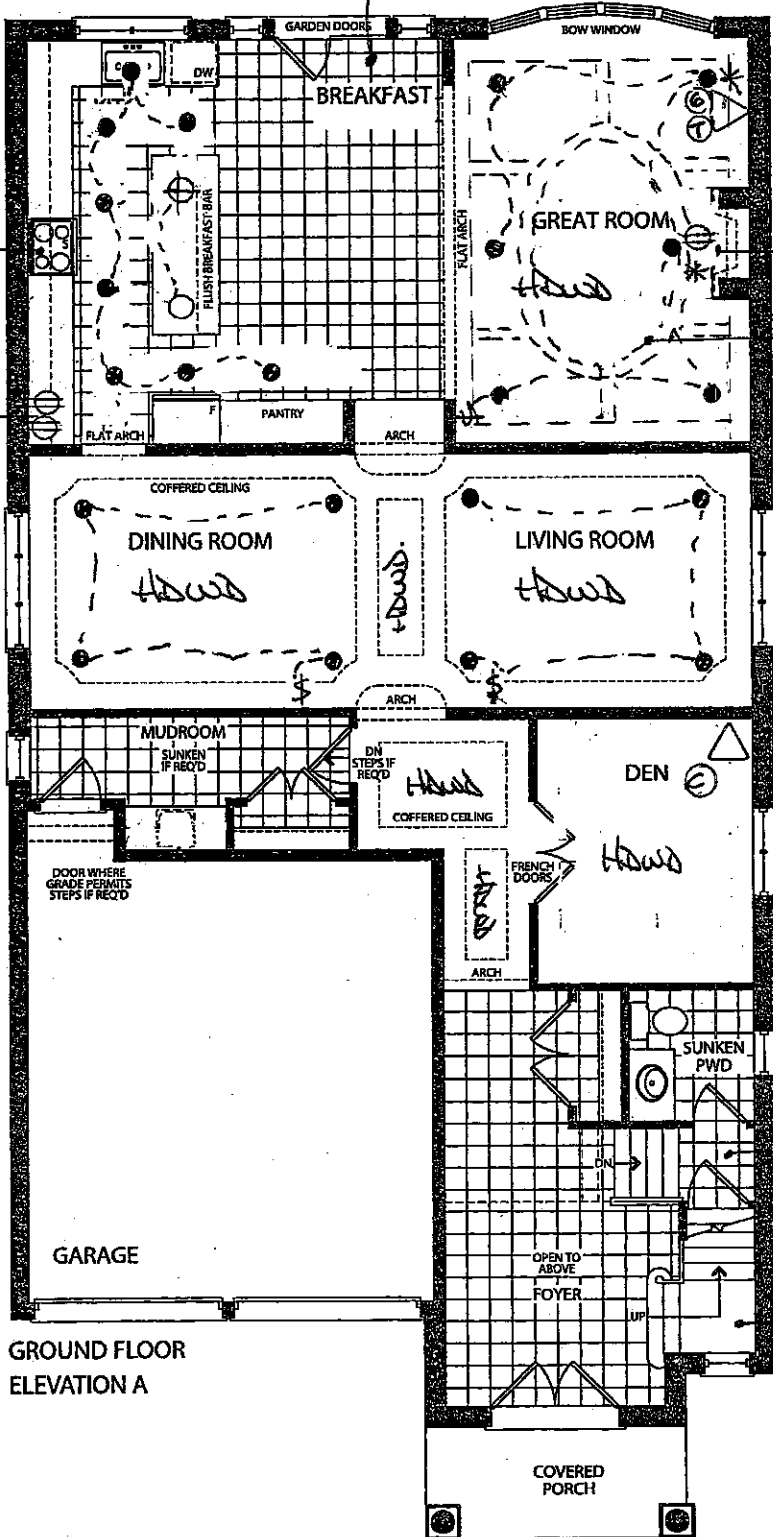

GROUND FLOOR
ELEVATION A

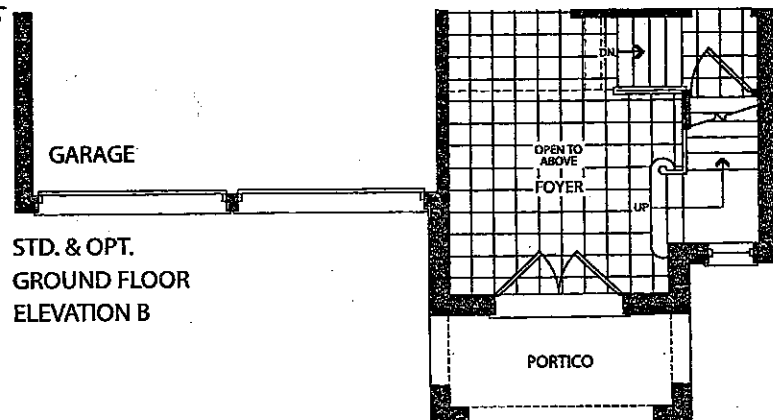

STD. & OPT.
GROUND FLOOR
ELEVATION B

KG-87

- FEB. 28 2017
- APRIL 3 2018

the Madison



Elevation A • 3,622 sq.ft.

Elevation B • 3,623 sq.ft.

TILE DIRECTION



8' DOORS
+
8' ARCHES

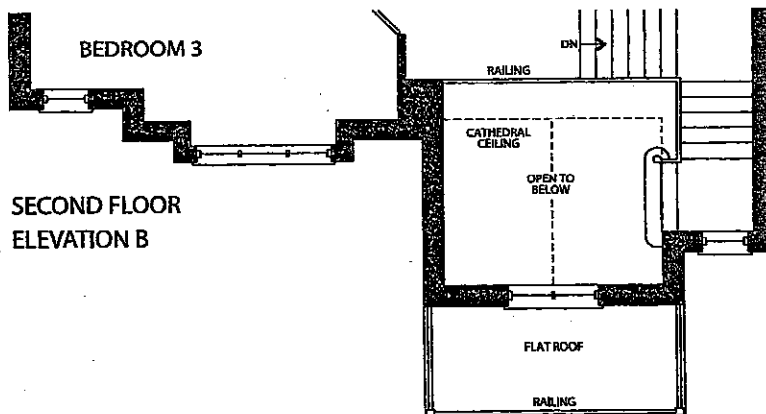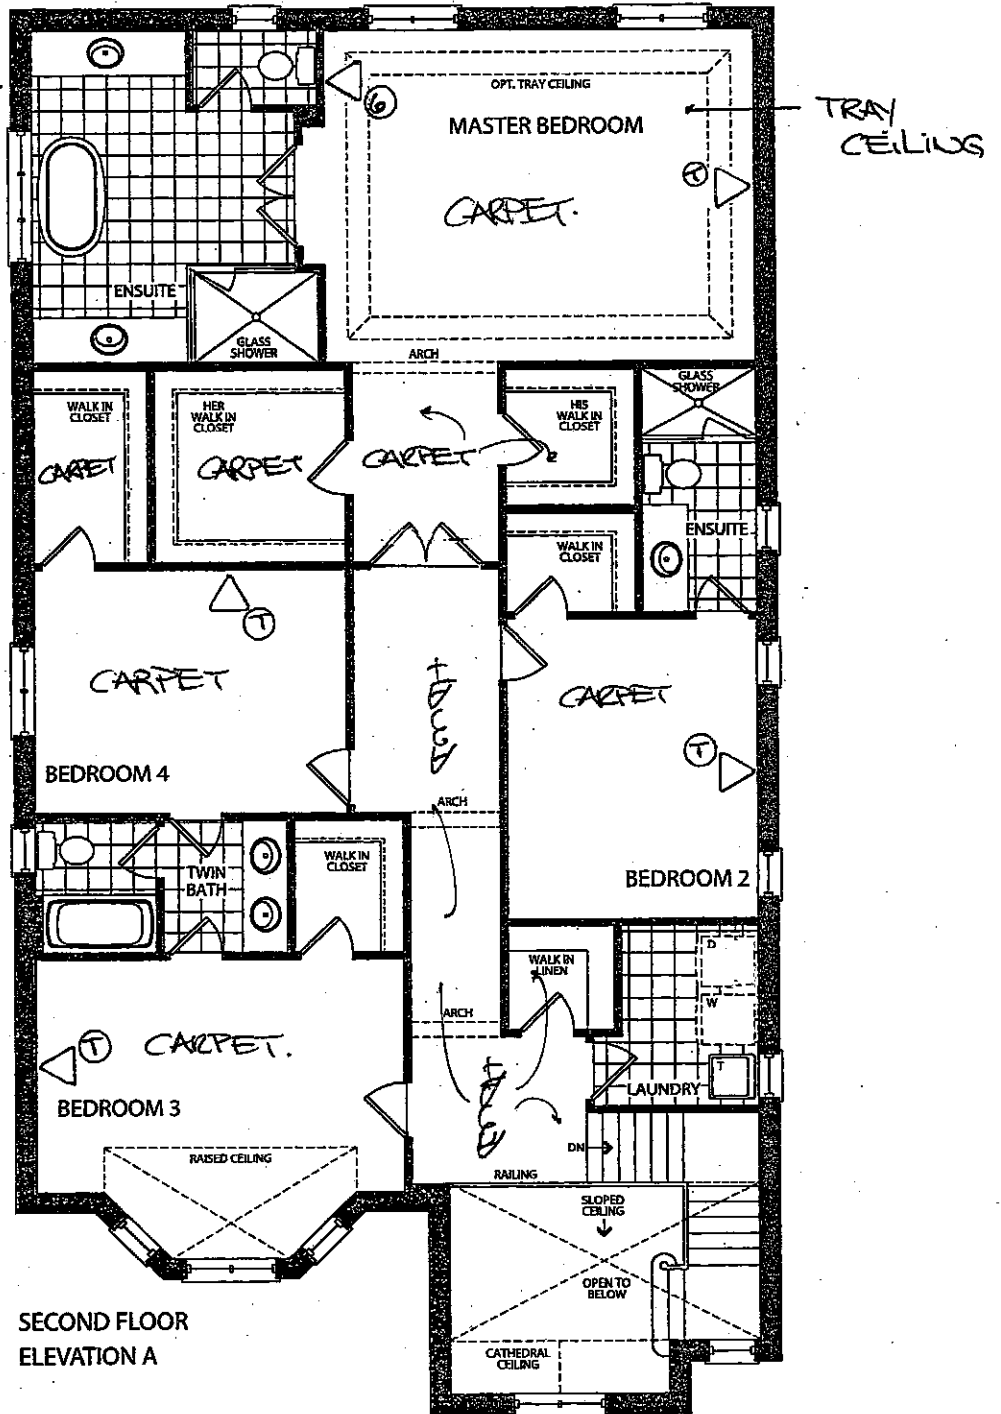


KG-87
• FEB 28 2017
• April 3 2018

the Madison

Elevation A • 3,622 sq.ft.

Elevation B • 3,623 sq.ft.

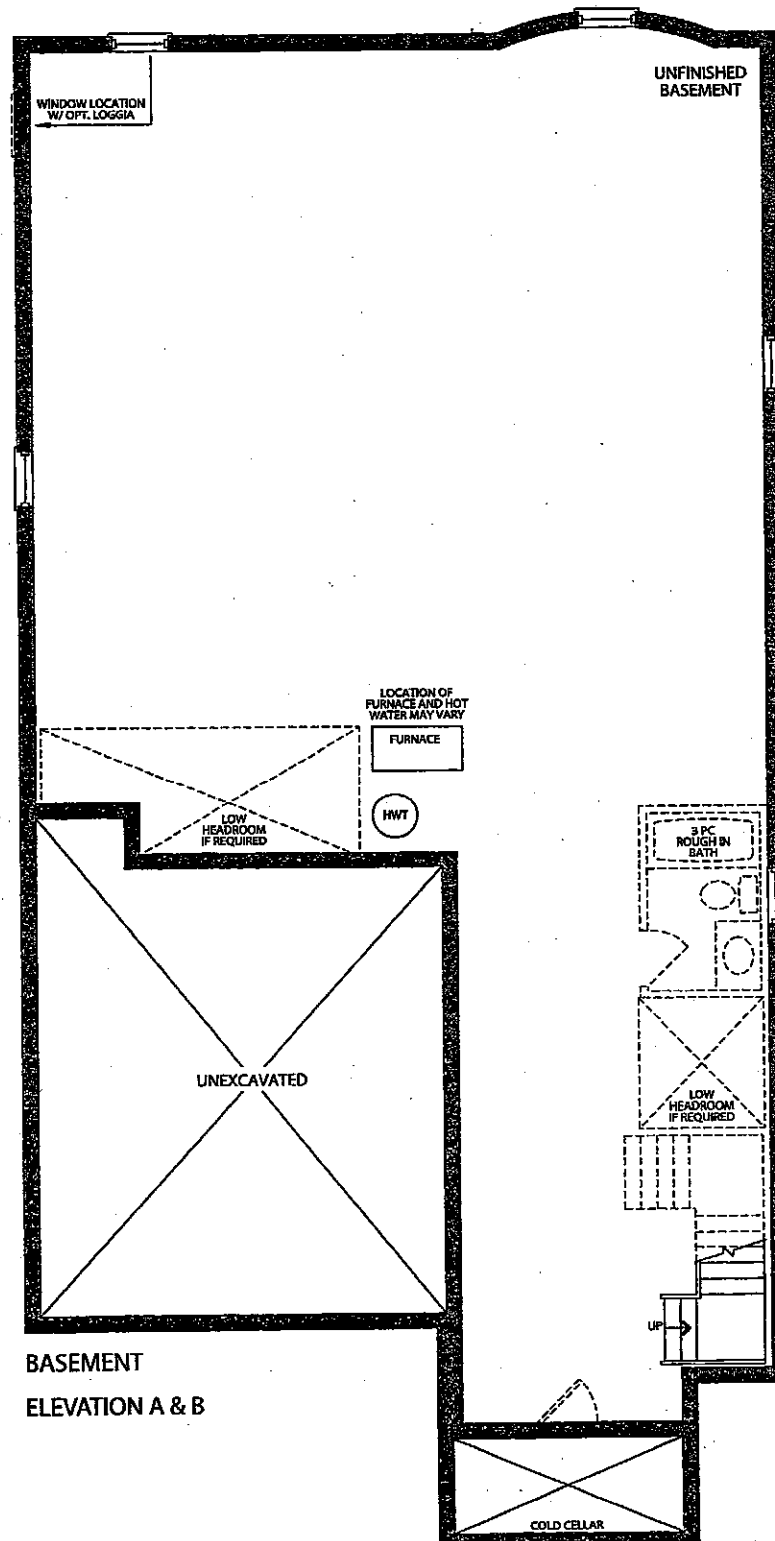

CORTINA

KITCHENS INC.
70 Rogers Road, Woodbridge, Ontario L4L 8L8
Tel: 905-854-4491 Fax: 905-854-0255
www.CortinaKitchens.com

KG2-87
April 3 2018

QUOTATION

Date: 14/10/16

Trade Name: Gold Park Homes

Site location: Kleinburg


Model: 42-5

Address:

Project: Kleinburg Glen

Phase:

This layout has been explained to the purchaser by Cortina Kitchens Inc. and is understood by the purchaser.

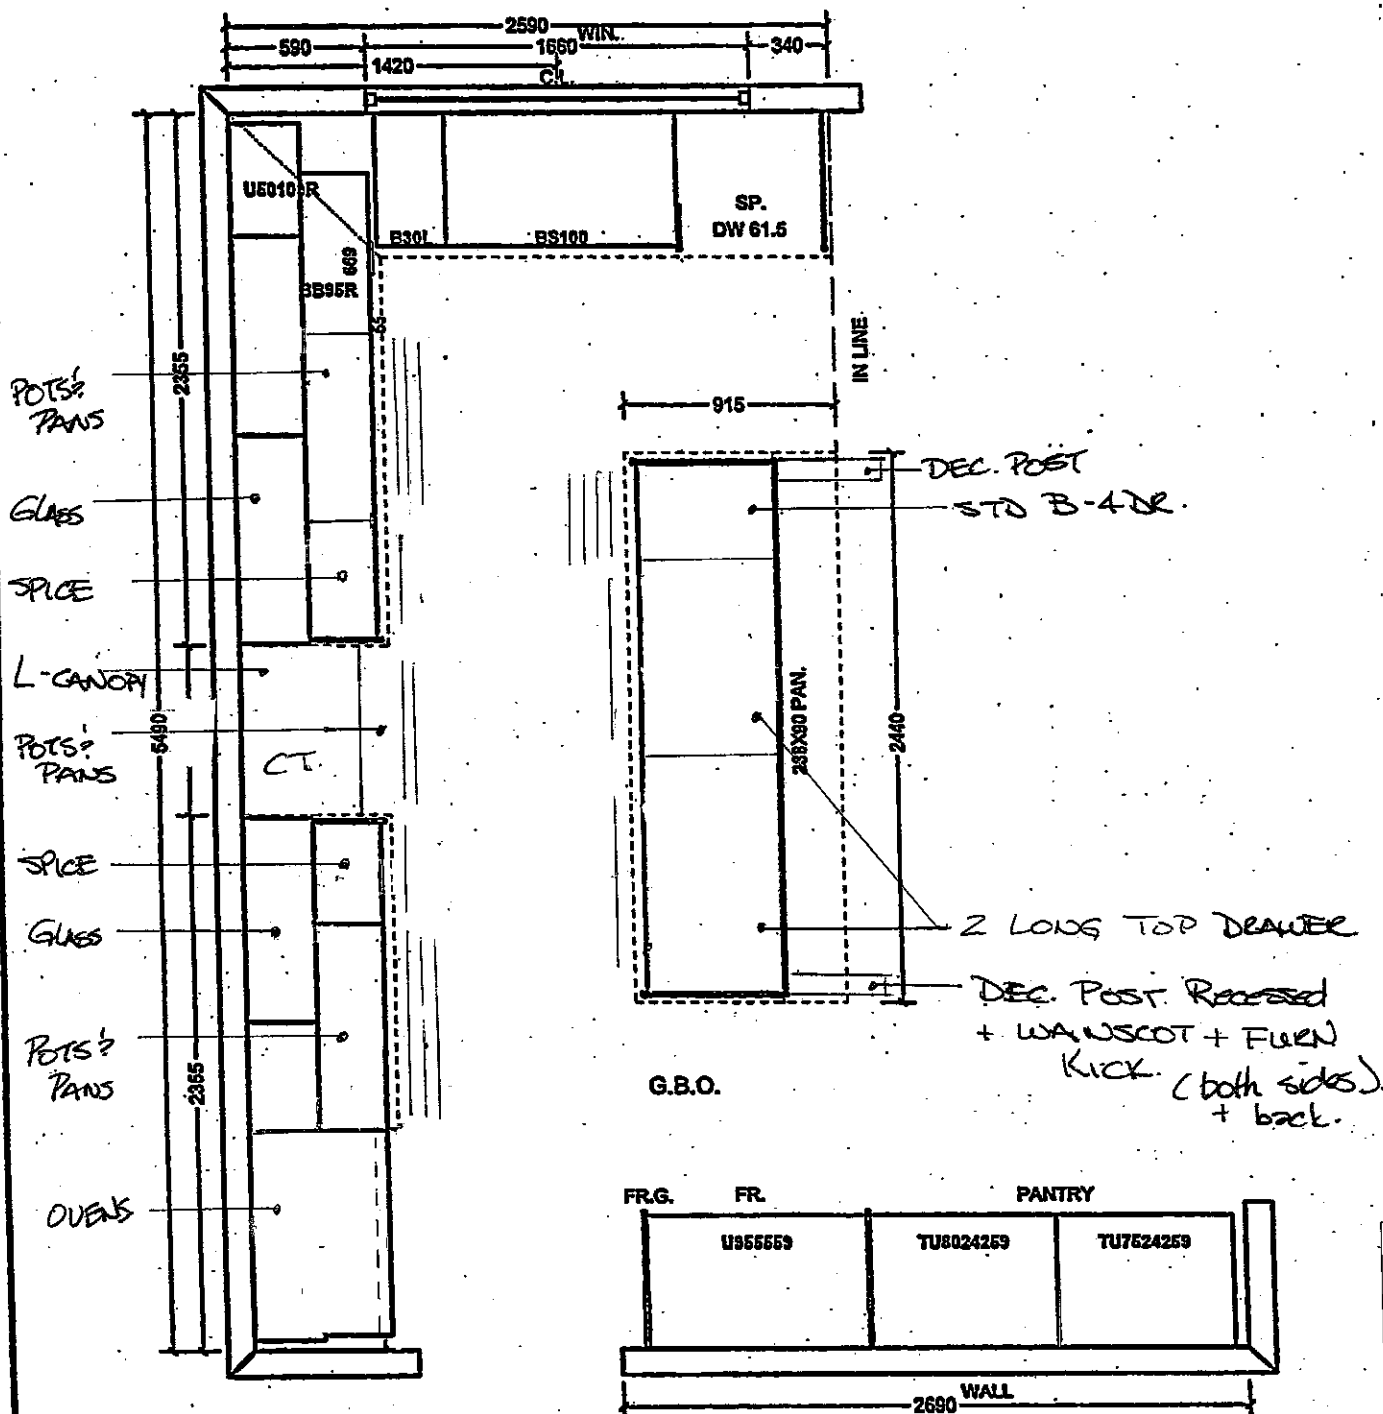

All prices subject to confirmation from head office.
This quotation is subject to the terms & conditions set out

ACCEPTED DATE: _____

All agreements are contingent upon strikes, accidents, and delays beyond our control.
Please provide our installer with template for sinkholes or \$150.00 will be charged for callback.

Item A: Wood grain and colour are characteristics of the product. We cannot guarantee that such grain and colour will always match.
Item B: Cortina Kitchens Inc. reserves the right to alter dimensions and make technical changes without notice.

CORTINA

KITCHENS INC.
70 Regatta Road, Waukegan, Ontario L4L 6L8
Tel: 855-294-9484 Fax: 855-294-0984
www.CortinaKitchens.com

KG2-87

APRIL 3 2018

QUOTATION

Date: 14/10/16

Trade Name: Gold Park Homes

Site location: Kleinburg



Model: 42-5

Address:


Project: Kleinburg Glen

Phase:

This layout has been explained to the purchaser by Cortina Kitchens Inc. and is understood by the purchaser.

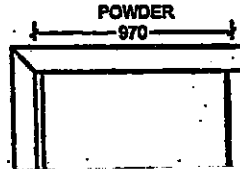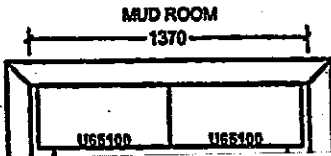

KG2-87
ISLAND

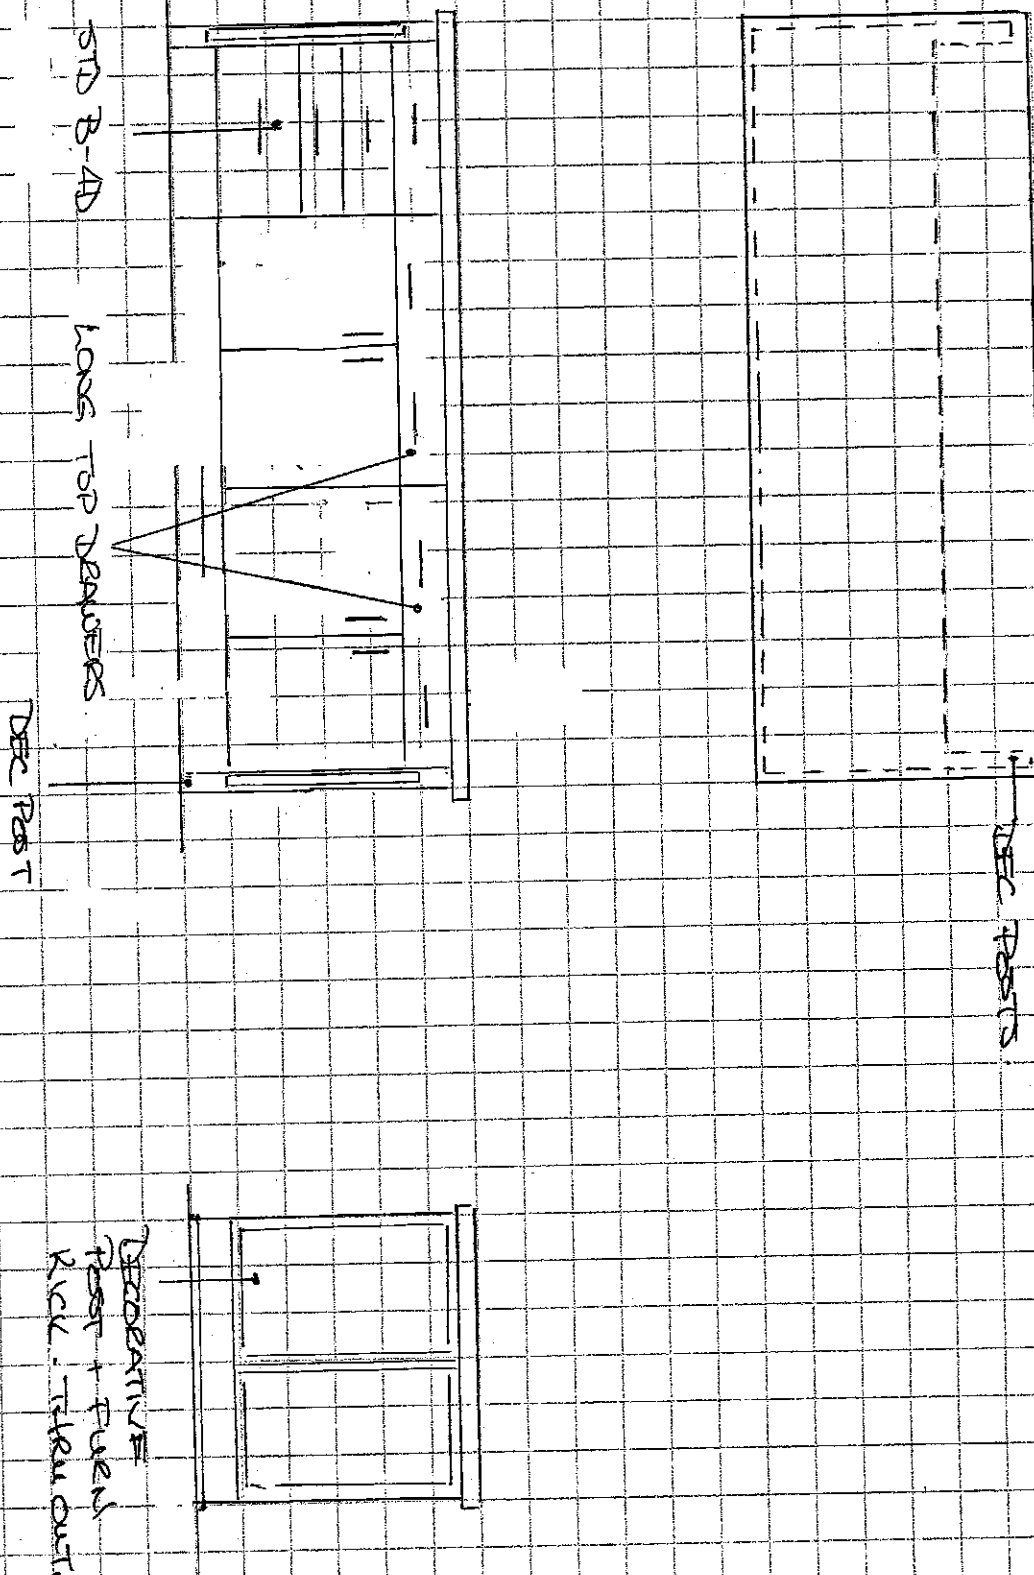


UPGRADE HARDWARE

KG2-87
APRIL 3 2018


UPGRADE HARDWARE




CH-32

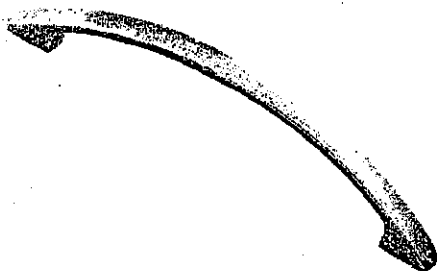


CH-38

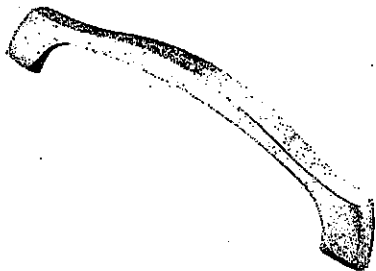


CH-44

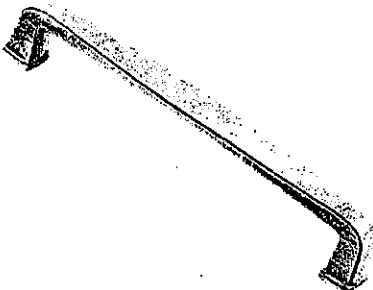


CH-45

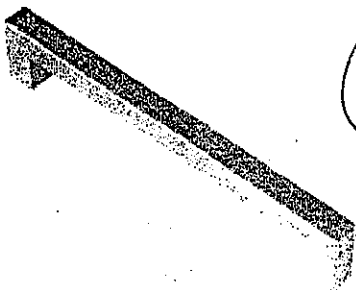


CH-46

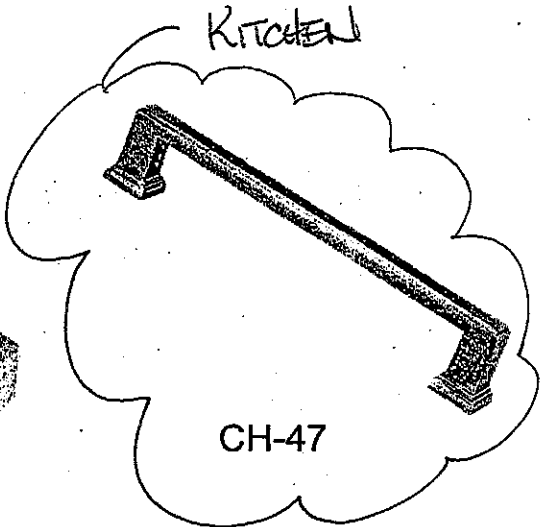


CH-47

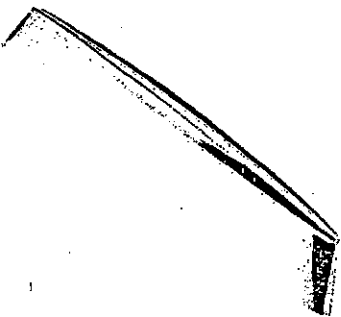


CH-48

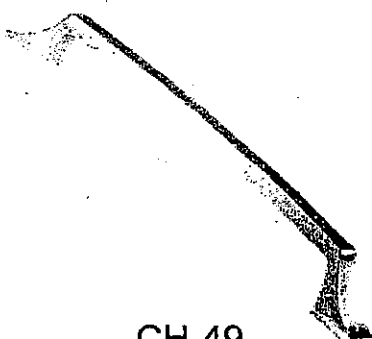


CH-49

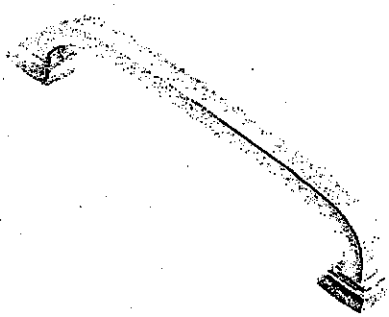

CH-50

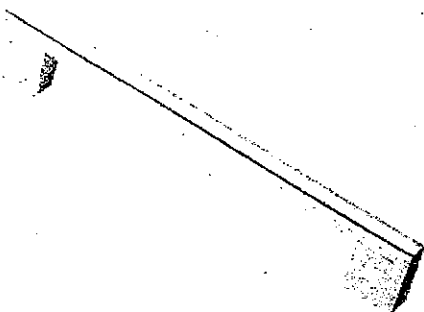

CH-51

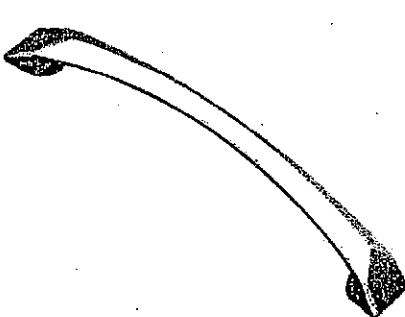

CH-52



CH-53

*NOTES:

- IMAGES ARE FOR QUICK REFERENCE PURPOSES ONLY
- ACTUAL SIZES AND FINISHES AS PER HARDWARE SAMPLE BOARD PROVIDED TO DECOR CENTRE

CORTINA

MODIFIED: 19/05/16 to


STANDARD HARDWARE

KGZ-87
APRIL 3 2048

STANDARD HARDWARE



CSI-6

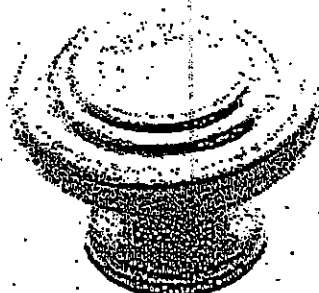

CSI-10




CSI-14



CSI-16



CSI-18

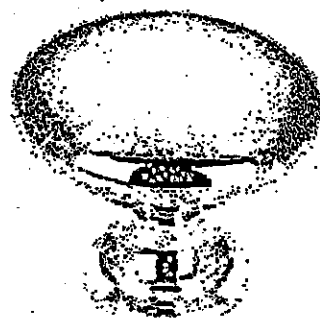


CSI-19

**CSI- 20**


CSI-21




CSI-22

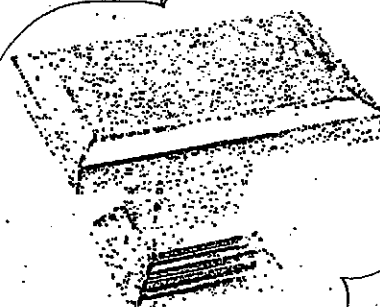

CSI- 23

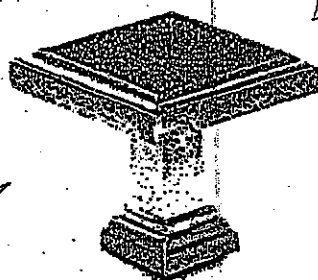

CSI- 24

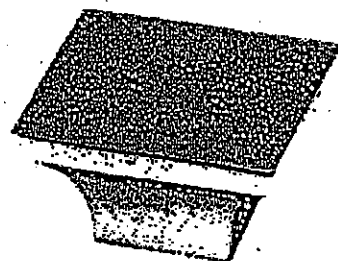**CSI-25**

***NOTES:**

- IMAGES ARE FOR QUICK REFERENCE PURPOSES ONLY**
- ACTUAL SIZES AND FINISHES AS PER HARDWARE
SAMPLE BOARD PROVIDED TO DECOR CENTRE

GOLDPARK




WORTH MORE



Granite, Marble,
Engineered Surfaces

- Standard 2CM & 3CM
- ⊖ Upgrade 1 2CM & 3CM
- ⊗ Upgrade 1 & 4 CM
- ⊙ Upgrade 2



KG2-87
April 5 2018

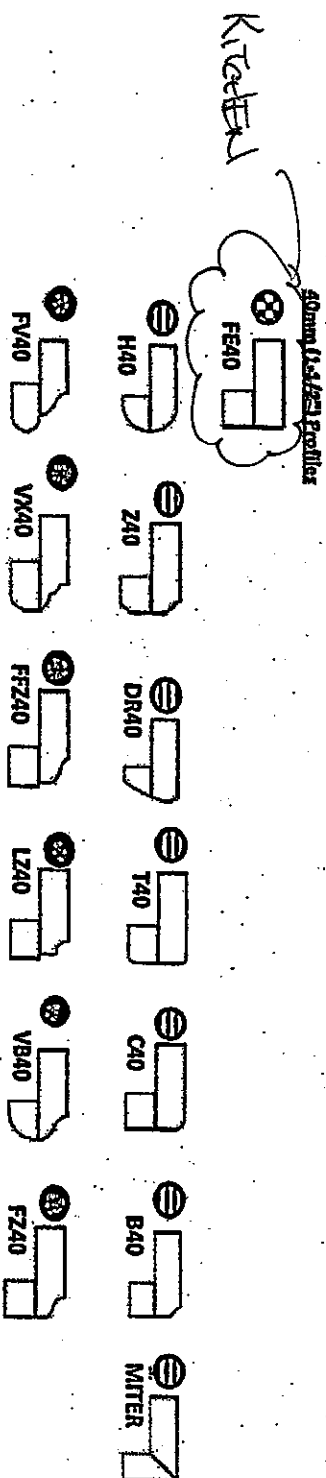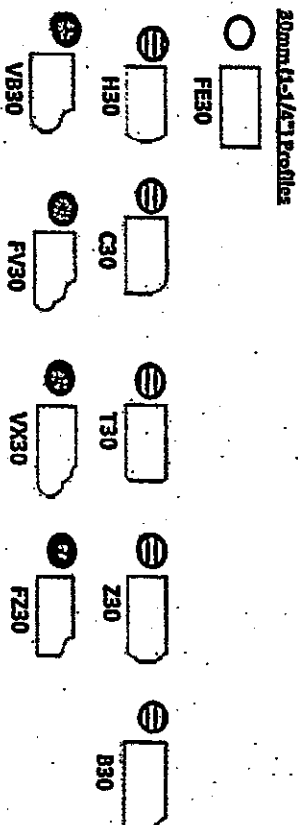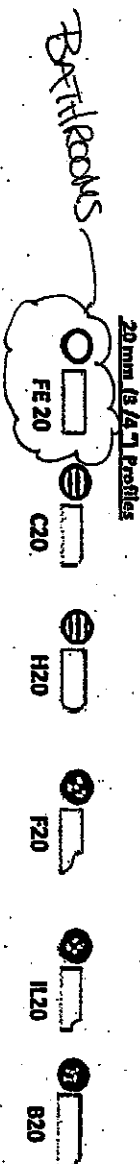

Note: All colours may not be available in 30mm at time ordered. Vendor reserves the right to use 40 mm edges (by lamination process).



*Mitre edge is available in Upgrade 1 for an overall thickness of 2". All other Mitre edge options will be an Upgrade 2 Edge.

Blanco Quatrus R15U Super Single kitchen sink #401518 (stainless)


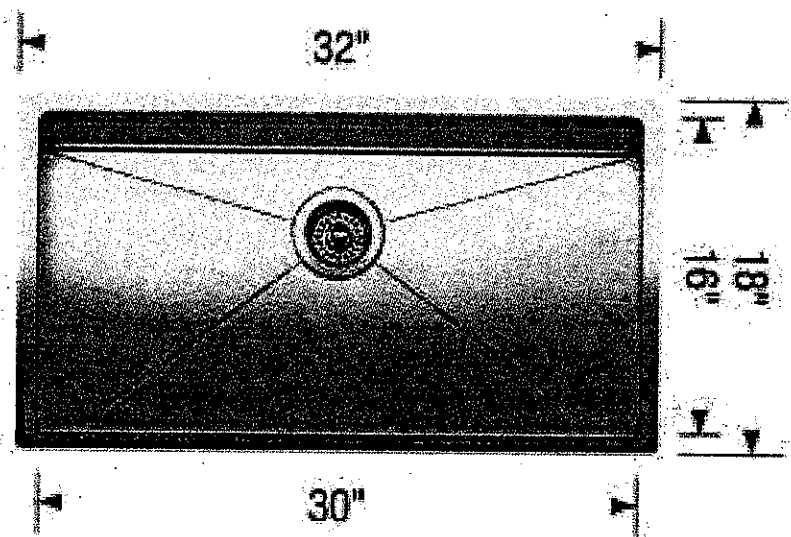
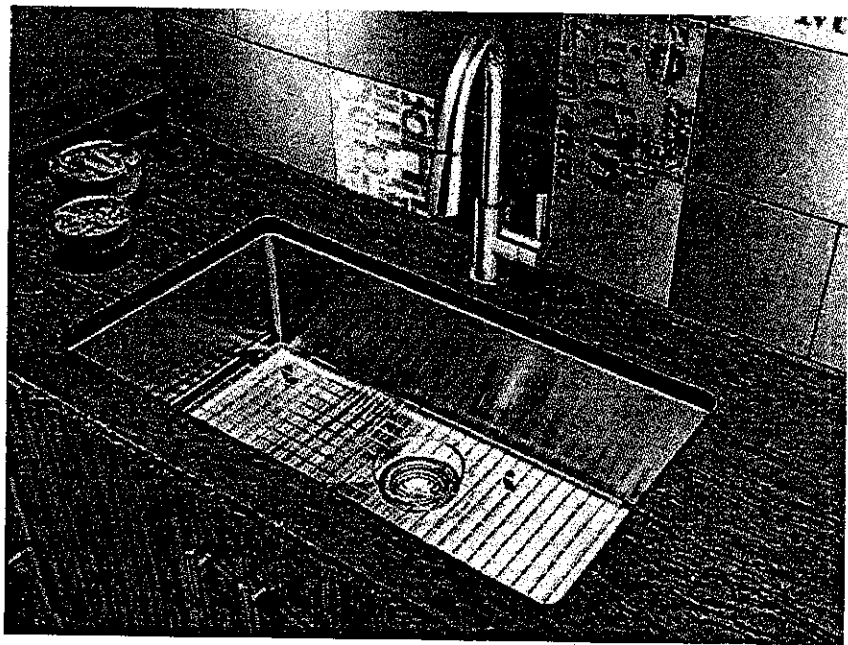


LOT # 87	
ROOM: Kitchen	SIGNATURE:
DATE: March 29 2018	SIGNATURE:

Contrac 'Collette' rectangular under mount sink (white) #4220CTV

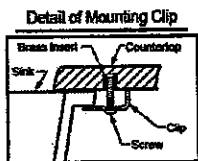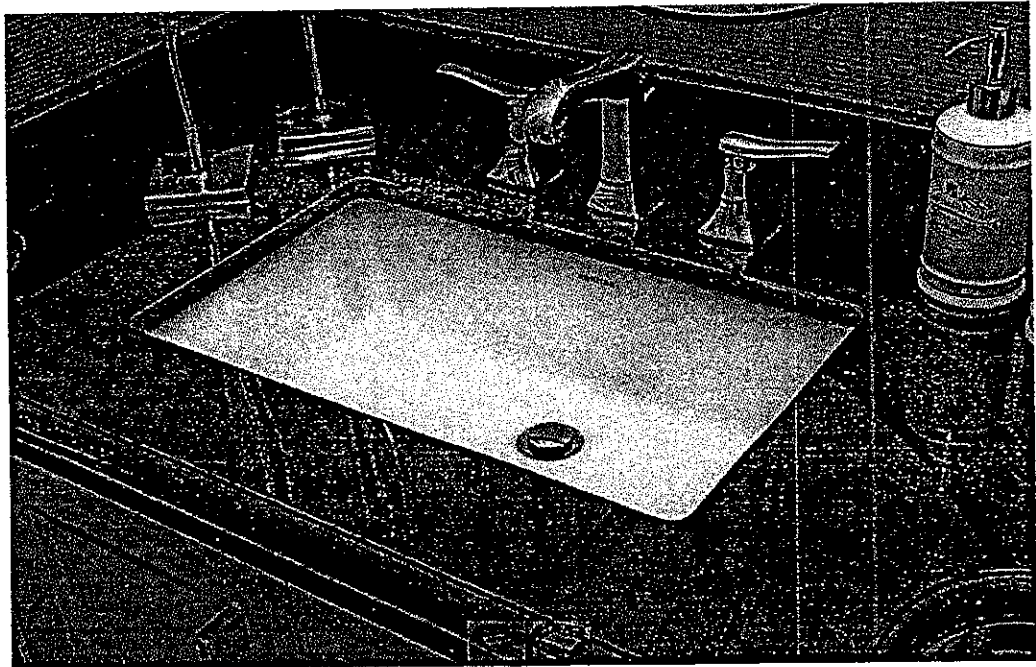


Note:
▲ Dimensions shown for
location of supplies
and "P" trap are
suggested.

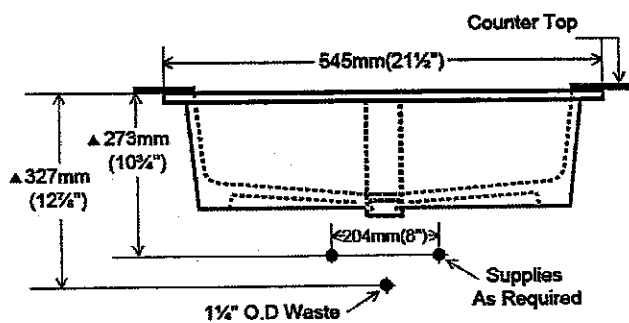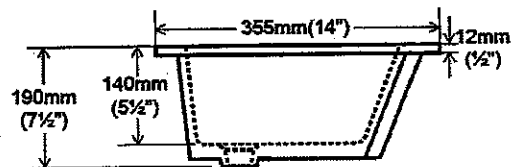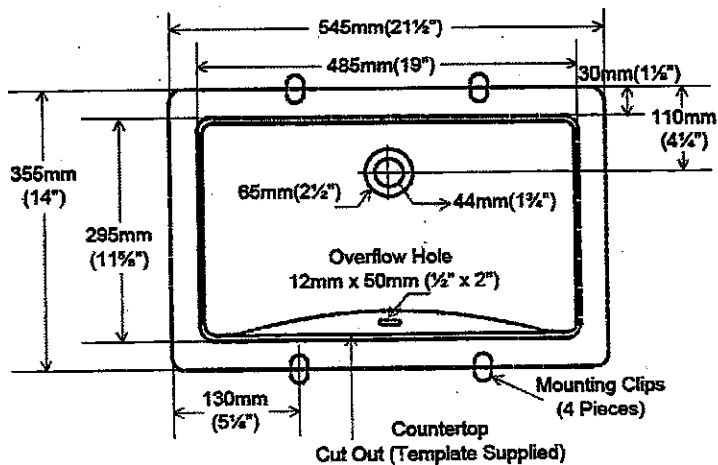

LOT # 87		
ROOM: MASTER ENSUITE	SIGNATURE:	
DATE: APRIL 3 2018	SIGNATURE:	

Camden

4210CHY 16" Square Undermount Sink

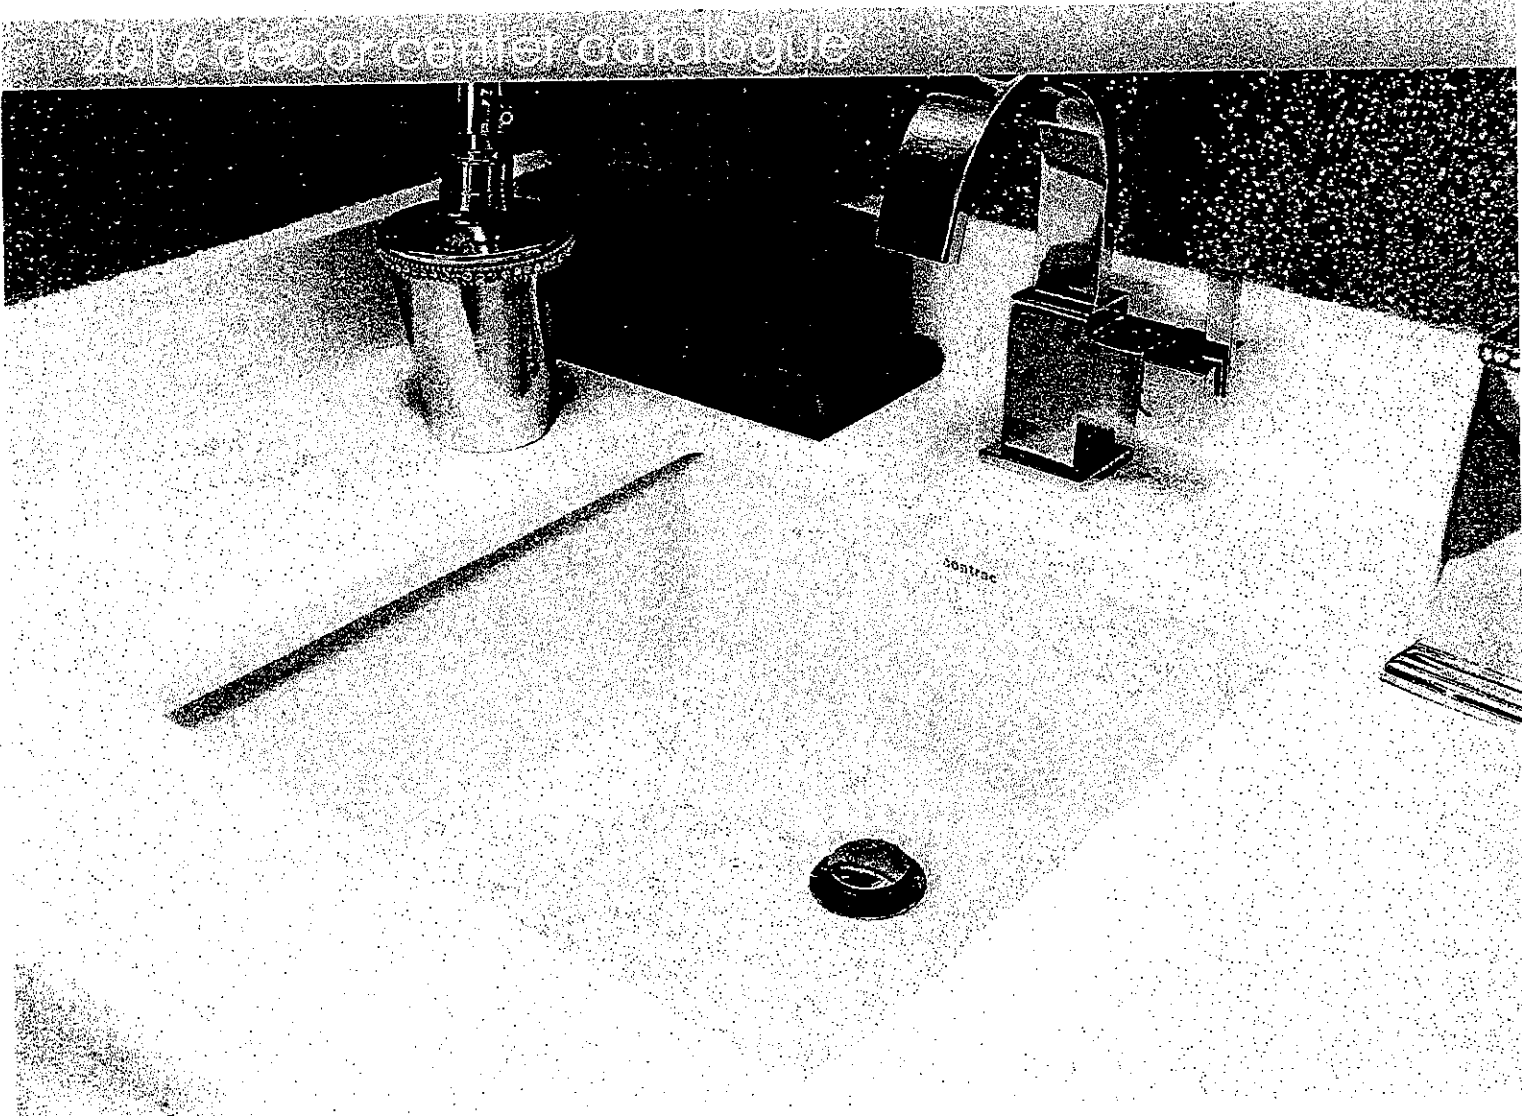

FEATURES	CERTIFICATIONS	COLOUR
Vitreous china Front overflow hole Template and mounting hardware supplied Overall dimensions (W x D x H): (OD) 16" x 16" x 7½" (ID) 13¾" x 13¾" x 5½"	IAPMO cUPC ASME A112.19.2 / CSA B45.1-2008	Soft white

LOT # 87	
ROOM: Powder	SIGNATURE:
DATE: April 3 2018	SIGNATURE: