

Kleinburg Glen - 87 - 1 - 42-5 Elev.B MADISON
CENTRAL VAC AND WIRING

Inv.1,144	1 - GREAT ROOM: CONDUIT PIPE - FOR TELEVISION - Locate approx. 66" A.F.F. above fireplace, terminating beside cable outlet, see plan for location.
Line18277	Note:
30Jan17 / 17Mar17	
Inv.1,144	2 - GREAT ROOM & MASTER ENSUITE: CAT 6 WIRING - UPGRADE AN OUTLET TO CAT 6 - See plan for location.
Line18276	Note:
30Jan17 / 17Mar17	

CERAMIC

Inv.1,797	1 - MASTER ENSUITE SHOWER WALL TILE: UPGRADE 2
Line26414	Note: LAID IN HORIZONTAL STACKED PATTERN
18Mar18 / 4May18	
Inv.1,797	1 - MASTER ENSUITE FLOOR TILE: UPGRADE 4 - 12X24" POLISHED
Line26413	Note: LAID IN STRAIGHT, STACKED PATTERN. SEE PLAN FOR TILE DIRECTION
18Mar18 / 4May18	
Inv.1,797	1 - FOYER / POWDER ROOM / LOWER LANDING: UPGRADE 5 FLOOR TILE - 24X24" POLISHED
Line26387	Note:
18Mar18 / 4May18	
Inv.1,797	1 - KITCHEN: BACKSPLASH UPGRADE 4 MARBLE MOSAIC
Line26389	Note:
18Mar18 / 4May18	

CROWN MOULDING

Inv.1,797	1 - GREAT ROOM: 7 BOX BEAM DETAIL CTR-B07
Line26390	Note:
18Mar18 / 4May18	

DRYWALL

Inv.1,144	1 - 2ND FLOOR: SMOOTH CEILINGS - (2 - Story Design) 2ND FLOOR
Line16911	Note:
30Jan17 / 17Mar17	

ELECTRICAL

Inv.1,144	1 - KITCHEN: RELOCATE STANDARD FIXTURE - Locate above island, see plan for location.
Line18279	Note:
30Jan17 / 17Mar17	
Inv.1,144	1 - GREAT ROOM: 110V WALL RECEPTACLE ON NORMAL CIRCUIT - Install approx. 66" A.F.F. above fireplace for future tv.
Line18278	Note:
30Jan17 / 17Mar17	
Inv.1,144	1 - KITCHEN: Add a ROUGH - IN CEILING OUTLET ON SAME SWITCH - DOES NOT INCLUDE FIXTURE - above island, use same switch as standard ceiling light. See plan for location.
Line18280	Note:
30Jan17 / 17Mar17	

Kleinburg Glen - 87 - 1 - 42-5 Elev.B MADISON

Inv.1,144	8 - KITCHEN: POT LIGHT: 4 INCH HALOGEN POT LIGHT - 440 WH - PRICED PER LIGHT - 10 OR MORE
Line18281	Note:
30Jan17 / 17Mar17	
Inv.1,144	1 - KITCHEN: Single pole switch for potlights
Line18288	Note:
30Jan17 / 17Mar17	
Inv.1,144	8 - LIVING & DINING ROOM: POT LIGHT: 4 INCH HALOGEN POT LIGHT - 440 WH - PRICED PER LIGHT - 10 OR MORE
Line18289	Note:
30Jan17 / 17Mar17	
Inv.1,144	2 - LIVING & DINING ROOM: Single pole switch for potlights.
Line18290	Note:
30Jan17 / 17Mar17	
Inv.1,144	1 - KITCHEN: 110V WALL RECEPTACLE ON DEDICATED CIRCUIT - FOR MICROWAVE - MICROWAVE NOT INCLUDED
Line18291	Note:
30Jan17 / 17Mar17	
Inv.1,144	1 - KITCHEN: 220V WALL RECEPTICAL ON DEDICATED CIRCUIT - FOR 4 WIRE BUILT - IN WALL OVEN - See plan for location.
Line18292	Note:
30Jan17 / 17Mar17	
Inv.1,144	1 - KITCHEN: 110V WALL RECEPTACLE ON DEDICATED CIRCUIT for future 600+ cfm hood fan.- See plan for location.
Line18293	Note:
30Jan17 / 17Mar17	
Inv.1,144	1 - KITCHEN: 110V WALL RECEPTACLE ON DEDICATED CIRCUIT - GAS FIRED APPLIANCE - FOR AUX. EQUIPMENT - NOT A STOVE PLUG
Line18295	Note:
30Jan17 / 17Mar17	
Inv.1,144	6 - GREAT ROOM: POT LIGHT: 4 INCH HALOGEN POT LIGHT - 440 WH - PRICED PER LIGHT - 10 OR MORE
Line18303	Note:
30Jan17 / 17Mar17	
Inv.1,144	1 - GREAT ROOM: Single pole switch for potlights
Line18304	Note:
30Jan17 / 17Mar17	

EXTERIOR COLOURS

Inv.1,144	1 - EXTERIOR COLOUR PACKAGE 10
Line16922	Note:
30Jan17 / 17Mar17	

FRAMING

Inv.1,144	1 - MAIN FLOOR CEILING 10FT- 8' INTERIOR DOORS AND ARCHES, TALLER FRONT AND REAR ELEVATION DOORS AND WINDOWS WITH TRANSOM, KITCHEN FURRING PANEL WITH CROWN AND 12" BULKHEAD
Line18297	Note:
30Jan17 / 17Mar17	

Kleinburg Glen - 87 - 1 - 42-5 Elev.B MADISON

Inv.1,144	3 - 2nd floor: Frame for taller archways - 96"
Line18299	Note:
30Jan17 / 17Mar17	
Inv.1,144	1 - 2ND FLOOR: STANDARD DOOR EXTENDED HEIGHT 96 INCH (PRICE PER DOOR) MAIN FLOOR 2 STOREY MODELS - 96"
Line19191	Note:
30Jan17 / 17Mar17	

GLASS AND MIRROR

Inv.1,144	1 - MASTER ENSUITE: CONVERT FRAMED SHOWER TO 10MM FRAMLESS SHOWER ENCLOSURE WITH DOOR AND 10MM SIDE PANEL
Line18300	Note:
30Jan17 / 17Mar17	

GRANITE MARBLE QUARTZ

Inv.1,797	1 - KITCHEN: COOKTOP CUT OUT
Line26408	Note:
18Mar18 / 4May18	
Inv.1,797	1 - POWDER ROOM: UPGRADE 3 STONE
Line26410	Note:
18Mar18 / 4May18	
Inv.1,797	1 - KITCHEN: UPGRADE EDGE PROFILE 4CM
Line26407	Note:
18Mar18 / 4May18	
Inv.1,797	1 - KITCHEN: UPGRADE 5 QUARTZ
Line26392	Note:
18Mar18 / 4May18	

HARDWOOD

Inv.1,797	1 - MAIN FLOOR - GREAT ROOM / DINING ROOM / LIVING ROOM / MAIN HALL / DEN: UPGRADE 4 - 'VINTAGE' 5" WHITE OAK HAND SCRAPED
Line26416	Note:
18Mar18 / 4May18	
Inv.1,797	1 - UPPER HALL: UPGRADE 4 - 'VINTAGE' 5" WHITE OAK HAND SCRAPED
Line26417	Note:
18Mar18 / 4May18	
Inv.1,797	1 - KITCHEN: UPGRADE 4 - 'VINTAGE' 5" WHITE OAK HAND SCRAPED
Line26418	Note:
18Mar18 / 4May18	

HVAC

Inv.1,144	1 - KITCHEN: GAS LINE ROUGH - GROUND FLOOR FOR future gas cooktop
Line18294	Note:
30Jan17 / 17Mar17	
Inv.1,144	1 - KITCHEN: UPGRADE VENTING FOR STOVE TO 8 INCH PIPE EXTERIOR WALL
Line18296	Note:
30Jan17 / 17Mar17	

INTERIOR TRIM AND DOORS

Kleinburg Glen - 87 - 1 - 42-5 Elev.B MADISON

Inv.1,144	3 - 2ND FLOOR: EXTENDED HEIGHT ARCHWAY (PRICE PER DOORWAY) - INCLUDE FRAMING NOTE
Line16918	Note:
30Jan17 / 17Mar17	
Inv.1,144	19 - 2ND FLOOR: STANDARD DOOR EXTENDED HEIGHT 96 INCH (PRICE PER DOOR) MAIN FLOOR 2 STOREY MODELS - 96"
Line16919	Note:
30Jan17 / 17Mar17	
Inv.1,144	3 - 2ND FLOOR: EXTENDED HEIGHT ARCHWAY (PRICE PER DOORWAY) - 96"
Line18301	Note:
30Jan17 / 17Mar17	
Inv.1,144	1 - MAIN FLOOR CEILING 10FT- 8' INTERIOR DOORS AND ARCHES, TALLER FRONT AND REAR ELEVATION DOORS AND WINDOWS WITH TRANSOM, KITCHEN FURRING PANEL WITH CROWN AND 12" BULKHEAD
Line19192	Note:
30Jan17 / 17Mar17	

KITCHEN AND BATH CABINETRY

Inv.1,144	1 - MAIN FLOOR CEILING 10FT- 8' INTERIOR DOORS AND ARCHES, TALLER FRONT AND REAR ELEVATION DOORS AND WINDOWS WITH TRANSOM, KITCHEN FURRING PANEL WITH CROWN AND 12" BULKHEAD
Line19193	Note:
30Jan17 / 17Mar17	
Inv.1,797	1 - KITCHEN: UPGRADE HARDWARE
Line26528	Note:
18Mar18 / 4May18	
Inv.1,797	1 - MASTER ENSUITE: UPGRADE 2 STONE COUNTER
Line26411	Note:
18Mar18 / 4May18	
Inv.1,797	1 - KITCHEN: ADJUST CABINETS FOR 36" COOKTOP AND HOOD FAN
Line26377	Note:
18Mar18 / 4May18	
Inv.1,797	1 - KITCHEN: UPGRADE 4 CABINET PROFILE
Line26378	Note:
18Mar18 / 4May18	
Inv.1,797	1 - KITCHEN: BUILT-IN OVEN AND MICROWAVE CABINET AND COOKTOP
Line26379	Note:
18Mar18 / 4May18	
Inv.1,797	1 - KITCHEN: L-SHAPED CANOPY, COMPLETE WITH 600 CFM FAN
Line26380	Note:
18Mar18 / 4May18	
Inv.1,797	3 - KITCHEN: POTS AND PANS DRAWERS - 1 SHALLOW TOP DRAWER + 2 DEEP DRAWERS
Line26381	Note:
18Mar18 / 4May18	
Inv.1,797	4 - KITCHEN: TOP DRAWER
Line26382	Note:
18Mar18 / 4May18	

Kleinburg Glen - 87 - 1 - 42-5 Elev.B MADISON

Inv.1,797	2 - KITCHEN: PULL OUT SPICE DOOR, 2 LEVEL (SINGLE DOOR WITH 2 LEVEL WITH MULTI-TECH TRACKS ATTACHED TO DOOR)
Line26385	Note:
18Mar18 / 4May18	
Inv.1,797	1 - KITCHEN *ISLAND*: TWO COLUMN WITH RECESSED POSTS AND FRONT AND BACK AND WAINSCOTT PANEL SIDE, 1 AT EITHER END OF ISLAND + FURNITURE KICK AT SIDES AND BACK OF ISLAND
Line26386	Note:
18Mar18 / 4May18	
Inv.1,797	1 - KITCHEN: RAISE CABINETS FOR HARDWOOD FLOOR
Line26711	Note:
18Mar18 / 4May18	
Inv.1,858	1 - KITCHEN: DEEP OVERLAY GABLE
Line27048	Note: LOCATE AT WALL OVENS
9Jun18 / 11Jun18	
Inv.1,858	1 - KITCHEN: PRICE CLARIFICATION - 2 LONG TOP DRAWERS ARE PRICED AS 4 AT ISLAND
Line27046	Note: REFERRING TO ITEM #6 ON ORDER # P.E. 1797
9Jun18 / 11Jun18	

PAINT

Inv.1,797	1 - MAIN STAIRS: STAIN STAIRS TO MATCH HARDWOOD, AS CLOSE AS POSSIBLE
Line26419	Note:
18Mar18 / 4May18	

PLUMBING

Inv.1,797	1 - POWDER ROOM: UPGRADE SINK TO CONTRAC 'CAMDEN' SQUARE UNDERMOUNT
Line26527	Note:
18Mar18 / 4May18	

PLUMBING FIXTURES

Inv.1,797	2 - MASTER ENSUITE: RECTANGULAR UNDER MOUNT SINK - CONTRAC 'COLETTE'
Line26412	Note:
18Mar18 / 4May18	
Inv.1,797	1 - KITCHEN SINK: STAINLESS STEEL UNDERMOUNT SINK BLANCO QUATRUS R15U #401518
Line26409	Note:
18Mar18 / 4May18	

STAIRS AND RAILINGS

Inv.1,797	1 - MAIN STAIRS: EUROLINE 2 + V GROOVE
Line26420	Note:
18Mar18 / 4May18	

WINDOWS - BASEMENT

Inv.1,144	5 - BASEMENT WINDOWS - UPGRADE EXISTING BASEMENT WINDOW TO 30 INCH X 16 INCH
Line16910	Note:
30Jan17 / 17Mar17	

WINDOWS AND DOORS

Kleinburg Glen - 87 - 1 - 42-5 Elev.B MADISON

Inv.1,144	1 - MAIN FLOOR CEILING 10FT- 8' INTERIOR DOORS AND ARCHES, TALLER FRONT AND REAR ELEVATION DOORS AND WINDOWS WITH TRANSOM, KITCHEN FURRING PANEL WITH CROWN AND 12" BULKHEAD
Line19194	Note:
30Jan17 / 17Mar17	

Item A. Wood grain and colour are characteristics of the product. We cannot guarantee that such grain and colour will always match.
Item B. Corina Kitchens Inc. reserves the right to alter dimensions and make technical changes without notice.

CORTINA

KITCHENS INC.
70 Regina Road, Woodbridge, Ontario L4L 6L6
Tel: 905-294-0004 Fax: 905-294-0004
www.CortinaKitchens.com

KG2-87

APRIL 3 2018

NOTE ~~ADDED~~:
JUNE 9 2018

QUOTATION

Date: 14/10/16

Trade Name: Gold Park Homes

Site location: Kleinburg



Model: 42-5

Address:


Project: Kleinburg Glen

Phase:

This layout has been explained to the purchaser by Cortina Kitchens Inc. and is understood by the purchaser.

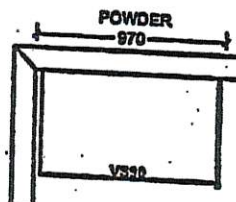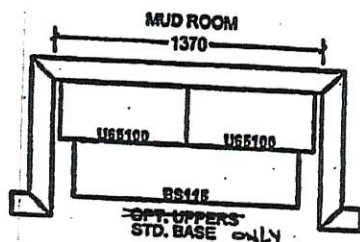

KG2-87
ISLAND

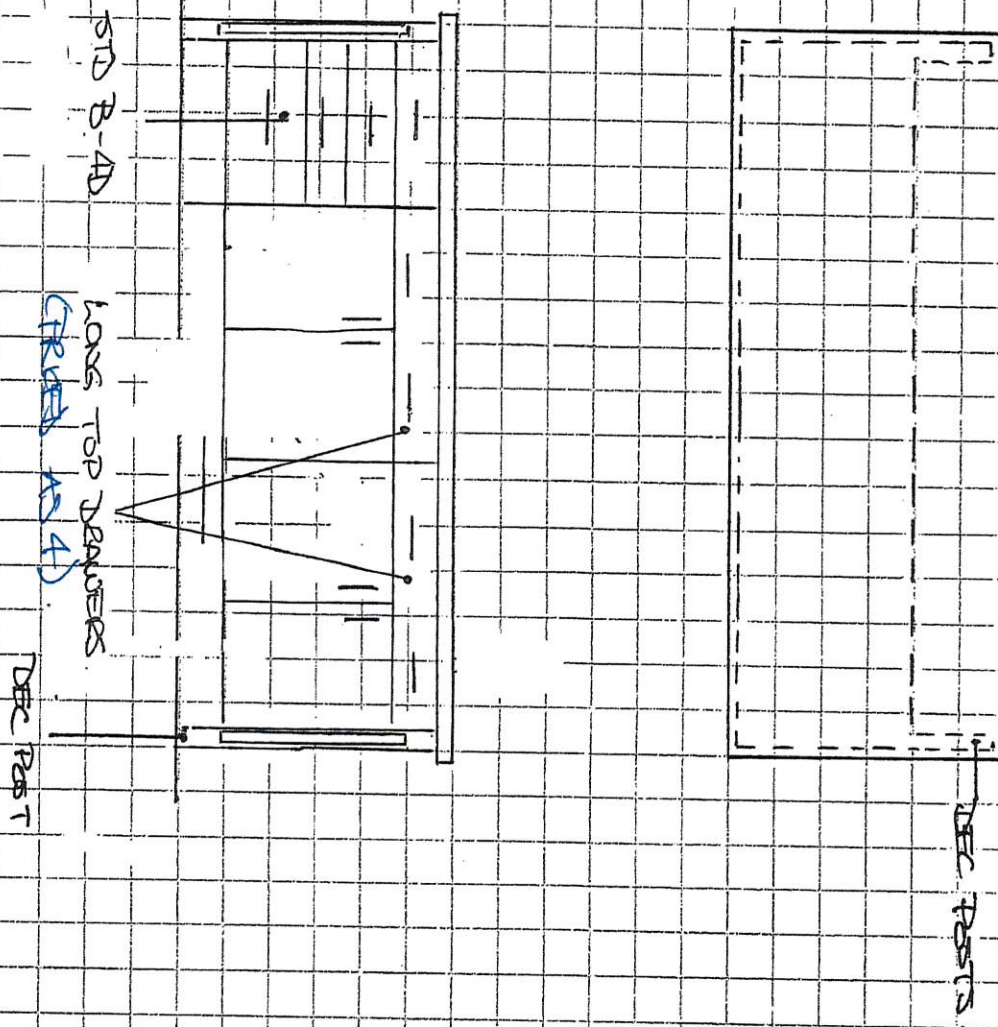

DECKATIVE
POST + FURN
KICK - TRUCK OUT.

