

**Kleinburg Glen - 86 - 1 - 38-4 Elev.A BRIDGEPORT
CARPET**

Inv.1,193	1 - BEDROOM 2 / BEDROOM 3 / BEDROOM 4 CARPET: UPGRADE 1 'CITYVIEW' CARPET
Line26374	Note:
14Feb17 / 4May18	

CENTRAL VAC AND WIRING

Inv.1,145	1 - GREAT ROOM: ROUGH - IN FIBER OPTIC CABLE - HOME RUN TO ELECTRICAL PANEL - See plan for location.
Line18306	Note:
30Jan17 / 17Mar17	
Inv.1,145	4 - DEN / MASTER BEDROOM / BEDROOM 2 / BEDROOM 3: CAT 6 WIRING - UPGRADE AN OUTLET TO CAT 6 - See plan for location.
Line18308	Note:
30Jan17 / 17Mar17	
Inv.1,145	1 - MUD ROOM: ROUGH - IN FOR EXTRA SECURITY KEY PAD
Line18305	Note:
30Jan17 / 17Mar17	
Inv.1,145	1 - GREAT ROOM: CONDUIT PIPE - FOR TELEVISION - Locate approx. 66" A.F.F. above fireplace, terminating beside fibre optic - see plan for location.
Line18307	Note:
30Jan17 / 17Mar17	

CERAMIC

Inv.1,193	1 - FOYER FLOOR TILE: UPGRADE 5 - 12X24" POLISHED
Line26355	Note: LAID IN STRAIGHT, STACKED PATTERN - SEE PLAN FOR TILE DIRECTION
14Feb17 / 4May18	
Inv.1,193	1 - POWDER ROOM FLOOR TILE: UPGRADE 5 - 12X24" POLISHED
Line26356	Note: LAID IN STRAIGHT, STACKED PATTERN - SEE PLAN FOR TILE DIRECTION
14Feb17 / 4May18	
Inv.1,193	1 - KITCHEN FLOOR TILE: UPGRADE 5 - 12X24" POLISHED
Line26357	Note: LAID IN STRAIGHT, STACKED PATTERN - SEE PLAN FOR TILE DIRECTION
14Feb17 / 4May18	
Inv.1,193	1 - MUD ROOM FLOOR TILE: UPGRADE 5- 12X24" POLISHED
Line26358	Note: LAID IN STRAIGHT, STACKED PATTERN - SEE PLAN FOR TILE DIRECTION
14Feb17 / 4May18	
Inv.1,193	1 - KITCHEN BACKSPLASH: UPGRADE 4 MARBLE MOSAIC
Line26359	Note: INCLUDES BEHIND HOOD FAN
14Feb17 / 4May18	
Inv.1,193	1 - MASTER ENSUITE: UPGRADE 4 FLOOR TILE
Line26362	Note: 12X24" LAID IN STRAIGHT, STACKED PATTERN. SEE PLAN FOR TILE DIRECTION
14Feb17 / 4May18	
Inv.1,193	1 - MASTER ENSUITE: SHOWER WALLS AND CEILING - UPGRADE 2
Line26363	Note: 8X24" LAID HORIZONTAL, STACKED
14Feb17 / 4May18	

CROWN MOULDING

Kleinburg Glen - 86 - 1 - 38-4 Elev.A BRIDGEPORT

Inv.1,193	1 - DINING ROOM: 4-BOX BEAM DETAIL -CTR-B07
Line26372	Note:
14Feb17 / 4May18	

DRYWALL

Inv.1,145	1 - SMOOTH CEILINGS - (2 - Story Design) 2ND FLOOR
Line16913	Note:
30Jan17 / 17Mar17	

ELECTRICAL

Inv.1,145	1 - GREAT ROOM: 110V WALL RECEPTACLE ON NORMAL CIRCUIT - Locate apprx.66" A.F.F. above fireplace for future tv
Line18309	Note:
30Jan17 / 17Mar17	

Inv.1,145	1 - KITCHEN: 110V WALL RECEPTACLE ON DEDICATED CIRCUIT - GAS FIRED APPLIANCE - FOR AUX. EQUIPMENT - NOT A STOVE PLUG
Line18310	Note:
30Jan17 / 17Mar17	

Inv.1,145	1 - KITCHEN: 110V WALL RECEPTACLE ON DEDICATED CIRCUIT - FOR MICROWAVE - MICROWAVE NOT INCLUDED
Line18312	Note:
30Jan17 / 17Mar17	

Inv.1,145	1 - KITCHEN: 220V WALL RECEPTICAL ON DEDICATED CIRCUIT - FOR 4 WIRE BUILT - IN WALL OVEN - MUST SPECIFY LOCATION
Line18313	Note:
30Jan17 / 17Mar17	

Inv.1,145	7 - KITCHEN: POT LIGHT: 4 INCH HALOGEN POT LIGHT - 440 WH - PRICED PER LIGHT - 10 OR MORE
Line18314	Note:
30Jan17 / 17Mar17	

Inv.1,145	6 - GREAT ROOM: POT LIGHT: 4 INCH HALOGEN POT LIGHT - 440 WH - PRICED PER LIGHT - 10 OR MORE
Line18315	Note:
30Jan17 / 17Mar17	

Inv.1,145	1 - KITCHEN: Single pole switch for potlights
Line18316	Note:
30Jan17 / 17Mar17	

Inv.1,145	1 - GREAT ROOM:Single pole switch for potlights
Line18317	Note:
30Jan17 / 17Mar17	

Inv.1,145	1 - KITCHEN: Single pole switch for potlights
Line18318	Note:
30Jan17 / 17Mar17	

Inv.1,145	4 - DINING ROOM: POT LIGHT: 4 INCH HALOGEN POT LIGHT - 440 WH - PRICED PER LIGHT - 10 OR MORE
Line18319	Note:
30Jan17 / 17Mar17	

Inv.1,145	1 - KITCHEN: RELOCATE STANDARD FIXTURE - Locate above island, see plan for location.
Line18320	Note:
30Jan17 / 17Mar17	

Kleinburg Glen - 86 - 1 - 38-4 Elev.A BRIDGEPORT

Inv.1,145	1 - KITCHEN: ROUGH - IN CEILING OUTLET ON SAME SWITCH - DOES NOT INCLUDE FIXTURE - Locate above island, see plan for location. Use same switch as standard ceiling light
Line18321	Note:
30Jan17 / 17Mar17	
Inv.1,145	1 - DINING ROOM: UPGRADE TO DIMMER SWITCH - ONE UNIT See plan for location.
Line18322	Note:
30Jan17 / 17Mar17	
Inv.1,193	1 - KITCHEN: CYCLONE 36" CHIMNEY-STYLE HOOD FAN - STAINLESS STEEL #scb71136
Line26526	Note:
14Feb17 / 4May18	

EXTERIOR COLOURS

Inv.1,145	1 - EXTERIOR COLOUR PACKAGE 7
Line16923	Note:
30Jan17 / 17Mar17	

FRAMING

Inv.1,145	1 - MASTER BEDROOM: EXTENDED HEIGHT ARCHWAY (PRICE PER DOORWAY) - 96"
Line16917	Note:
30Jan17 / 17Mar17	
Inv.1,145	1 - MAIN FLOOR CEILING 10FT- 8' INTERIOR DOORS AND ARCHES, TALLER FRONT AND REAR ELEVATION DOORS AND WINDOWS WITH TRANSOM, KITCHEN FURRING PANEL AND CROWN WITH 12" BULK HEAD,
Line18323	Note:
30Jan17 / 17Mar17	
Inv.1,145	1 - 2ND FLOOR: STANDARD DOOR EXTENDED HEIGHT 96 INCH (PRICE PER DOOR) MAIN FLOOR 3 STOREY MODELS -
Line19190	Note:
30Jan17 / 17Mar17	

GLASS AND MIRROR

Inv.1,145	1 - MASTER ENSUITE: CONVERT FRAMED SHOWER TO 10MM FRAMELESS SHOWER ENCLOSURE WITH DOOR AND 10MM SIDE PANEL
Line18325	Note:
30Jan17 / 17Mar17	

GRANITE MARBLE QUARTZ

Inv.1,193	1 - KITCHEN: UPGRADE 3 QUARTZ
Line26352	Note:
14Feb17 / 4May18	
Inv.1,193	1 - KITCHEN: UPGRADE 2 EDGE DETAIL -4CM
Line26353	Note:
14Feb17 / 4May18	
Inv.1,193	1 - MASTER ENSUITE: UPGRADE 3 COUNTER TOP
Line26361	Note:
14Feb17 / 4May18	

HARDWOOD

Kleinburg Glen - 86 - 1 - 38-4 Elev.A BRIDGEPORT

Inv.1,193	1 - UPPER HALL: UPGRADE 1 HARDWOOD
Line26366	Note:
14Feb17 / 4May18	
Inv.1,193	1 - MASTER BEDROOM: UPGRADE 1 HARDWOOD
Line26367	Note:
14Feb17 / 4May18	

HVAC

Inv.1,145	1 - KITCHEN GAS LINE ROUGH - GROUND FLOOR for future gas stove
Line18311	Note:
30Jan17 / 17Mar17	

INTERIOR TRIM AND DOORS

Inv.1,145	18 - 2ND FLOOR: STANDARD DOOR EXTENDED HEIGHT 96 INCH (PRICE PER DOOR) MAIN FLOOR 3 STOREY MODELS -
Line16916	Note:
30Jan17 / 17Mar17	
Inv.1,145	1 - MAIN FLOOR CEILING 10FT- 8' INTERIOR DOORS AND ARCHES, TALLER FRONT AND REAR ELEVATION DOORS AND WINDOWS WITH TRANSOM, KITCHEN FURRING PANEL AND CROWN WITH 12" BULK HEAD,
Line19133	Note:
30Jan17 / 17Mar17	
Inv.1,193	1 - MAIN FLOOR: UPGRADE PACKAGE 2 - 3" CASING + 7" BASBOARD
Line26368	Note:
14Feb17 / 4May18	
Inv.1,193	1 - 2ND FLOOR: UPGRADE TRIM PACKAGE 2 - 3" CASING + 7" BASEBOARD
Line26369	Note:
14Feb17 / 4May18	

KITCHEN AND BATH CABINETRY

Inv.1,145	1 - MAIN FLOOR CEILING 10FT- 8' INTERIOR DOORS AND ARCHES, TALLER FRONT AND REAR ELEVATION DOORS AND WINDOWS WITH TRANSOM, KITCHEN FURRING PANEL AND CROWN WITH 12" BULK HEAD,
Line19134	Note:
30Jan17 / 17Mar17	
Inv.1,193	1 - KITCHEN: BUILT-IN WALL OVEN, MICROWAVE AND SLIDE IN COOKTOP
Line26344	Note:
14Feb17 / 4May18	
Inv.1,193	1 - KITCHEN: DEEP GABLE AT WALL OVENS
Line26345	Note:
14Feb17 / 4May18	
Inv.1,193	1 - KITCHEN: POTS AND PANS DRAWERS (1 FALSE TOP DRAWER + 2 DEEP DRAWERS)
Line26346	Note:
14Feb17 / 4May18	
Inv.1,193	1 - KITCHEN: RECYCLE CABINET - 2 BINS WITH LIDS, PULL-OUT ATTACHED TO DOOR
Line26347	Note:
14Feb17 / 4May18	

Kleinburg Glen - 86 - 1 - 38-4 Elev.A BRIDGEPORT

Inv.1,193	1 - KITCHEN: UPGRADE HARDWARE
Line26348	Note:
14Feb17 / 4May18	
Inv.1,193	1 - KITCHEN: POTS AND PANS DRAWERS
Line26349	Note:
14Feb17 / 4May18	
Inv.1,193	1 - KITCHEN: UPGRADE 4 CABINETS
Line26350	Note:
14Feb17 / 4May18	
Inv.1,193	1 - KITCHEN: DECORATIVE POSTS AT ISLAND, WAINSCOTTING, DECORATIVE PANEL, FURNITURE KICK - SEE SKETCH
Line26351	Note:
14Feb17 / 4May18	
Inv.1,193	1 - MASTER ENSUITE: UPGRADE 4, MAPLE CABINET PROFILE
Line26360	Note:
14Feb17 / 4May18	
Inv.1,193	1 - KITCHEN: DELETE UPPERS, FINISH SIDES OF CABINETS - LEAVE APPROX. 36" FOR 30" CHIMNEY-STYLE HOOD FAN
Line26373	Note:
14Feb17 / 4May18	
Inv.1,193	4 - KITCHEN: BEVELLED GLASS, CLEAR DOOR
Line26375	Note:
14Feb17 / 4May18	
Inv.1,193	2 - KITCHEN: MATCHING INTERIOR DOUBLE DOOR CABINET
Line26376	Note:
14Feb17 / 4May18	
Inv.1,857	1 - KITCHEN: *DELETE* BUILT-IN WALL OVEN, MICROWAVE ANC SLIDE IN COOKTOP
Line27036	Note: NOT AVAILABLE DUE TO SITE CONDITION
9Jun18 / 11Jun18	
Inv.1,857	1 - KITCHEN: *DELETE* DEEP GABLE AT WALL OVENS
Line27037	Note: NOT REQUIRED
9Jun18 / 11Jun18	
Inv.1,857	1 - KITCHEN: SLIDE-IN STOVE PREP FOR **STANDARD 30" SLIDE IN RANGE** NO SPECS WILL BE PROVIDED
Line27038	Note:
9Jun18 / 11Jun18	
Inv.1,857	1 - KITCHEN: MOVE POTS AND PANS DRAWERS - SEE KITCHEN PLAN FOR LOCATION
Line27039	Note:
9Jun18 / 11Jun18	
Inv.1,857	1 - KITCHEN: MAGIC CORNER
Line27040	Note:
9Jun18 / 11Jun18	

PAINTING

Inv.1,193	1 - MAIN STAIRS: STAIN STAIRS TO MATCH HARWOOD AS CLOSE AS POSSIBLE
Line26371	Note:
14Feb17 / 4May18	

PLUMBING

Inv.1,145	1 - MASTER ENSUITE: UPGRADE TO FREE STANDING TUB - UPG1 ONLY
Line18327	Note:
30Jan17 / 17Mar17	

PLUMBING FIXTURES

Inv.1,193	2 - MASTER ENSUITE: CONTRAC 'COLETTE' RECTANGULAR UNDERMOUNT SINK
Line26364	Note:
14Feb17 / 4May18	
Inv.1,193	1 - KITCHEN SINK: BLANCO QUATRUS SUPER SINGLE
Line26365	Note:
14Feb17 / 4May18	

STAIRS AND RAILINGS

Inv.1,193	1 - MAIN STAIR: EUROLINE 2 + V GROOVE
Line26370	Note:
14Feb17 / 4May18	

WINDOWS - BASEMENT

Inv.1,145	4 - BASEMENT WINDOWS - UPGRADE EXISTING BASEMENT WINDOW TO 30 INCH X 16 INCH
Line16912	Note:
30Jan17 / 17Mar17	

WINDOWS AND DOORS

Inv.1,145	1 - MAIN FLOOR CEILING 10FT- 8' INTERIOR DOORS AND ARCHES, TALLER FRONT AND REAR ELEVATION DOORS AND WINDOWS WITH TRANSOM, KITCHEN FURRING PANEL AND CROWN WITH 12" BULK HEAD,
Line19135	Note:
30Jan17 / 17Mar17	

CORTINA

70 Regina Road, Woodbridge, Ontario L4L 8L9
Tel: 905-294-0494 Fax: 905-294-0584
www.CortinaKitchens.com

KG2-86
April 6 2018

QUOTATION

Date: 28/06/16

Trade Name: Gold Park Homes

Site location:

Model: 38-4


Address:

Project: Kleinburg Glen

Phase:

This layout has been explained to the purchaser by Cortina Kitchens Inc. and is understood by the purchaser.

REVISED
JUNE 9 2018

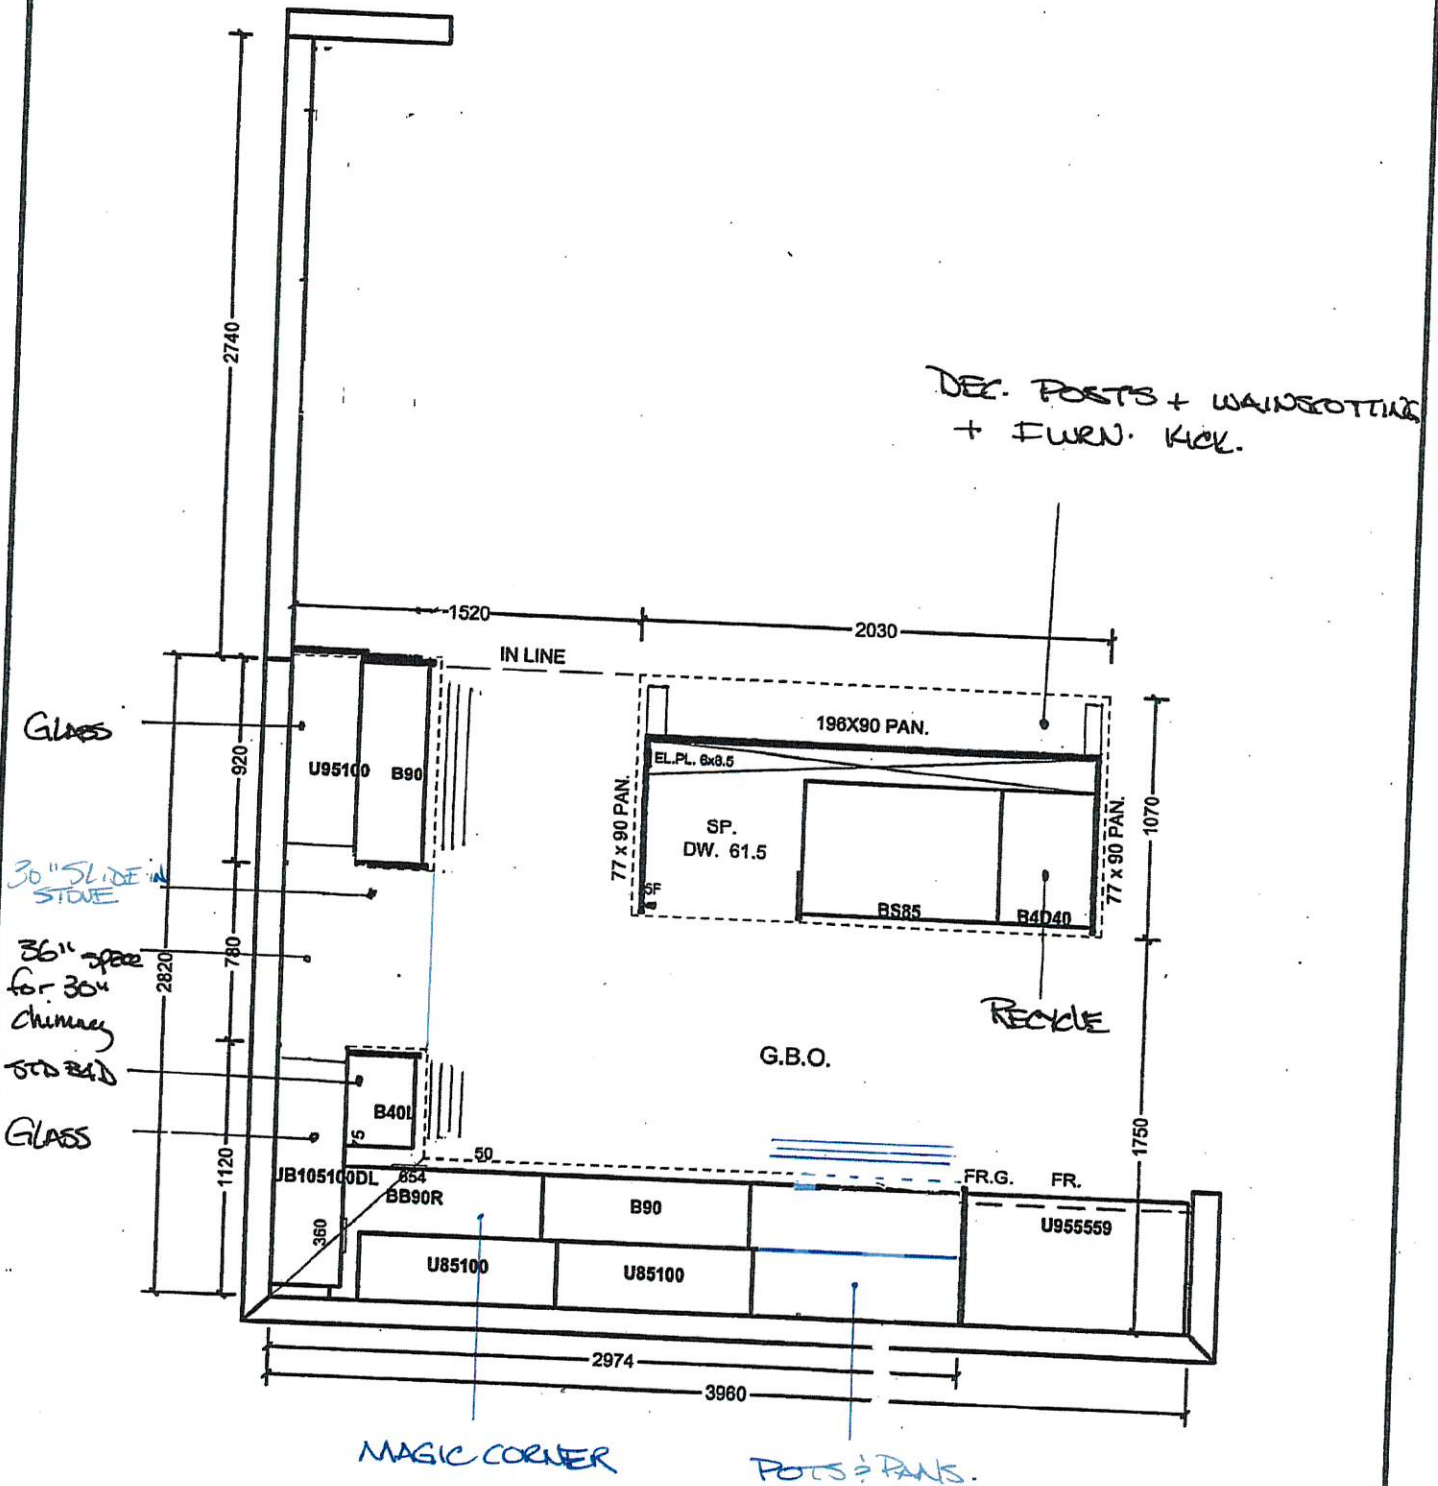

All prices subject to confirmation from head office.
This quotation is subject to the terms & conditions set out

ACCEPTED DATE: _____

All agreements are contingent upon strikes, accidents, and delays beyond our control.
Please provide our installer with template for sinkholes or \$150.00 will be charged for callback.

Item A. Wood grain and colour are characteristics of the product. We cannot guarantee that such grain and colour will always match.
Item B. Cortina Kitchens Inc. reserves the right to alter dimensions and make technical changes without notice.