

Brampton Encore - 2 - 1 - 38-4 Elev.B VIVALDI
CERAMIC

Inv.1,264	1 - FOYER/POWDER ROOM: UPGRADE 4 FLOOR TILE - 12X24" LAID IN STRAIGHT, STACKED PATTERN.
Line26654	Note:
22Mar17 / 25Apr18	
Inv.1,264	1 - MASTER ENSUITE FLOOR TILE: UPGRADE 4 - 12X24" LAID IN STRAIGHT STACKED PATTERN
Line26664	Note:
22Mar17 / 25Apr18	
Inv.1,264	1 - MASTER ENSUITE: UPGRADE 2 WALL TILE
Line26667	Note:
22Mar17 / 25Apr18	

GRANITE MARBLE QUARTZ

Inv.1,264	1 - KITCHEN: COOKTOP CUT OUT
Line26662	Note:
22Mar17 / 25Apr18	
Inv.1,264	1 - MASTER ENSUITE: GROUP 1 COUNTER TOP
Line26665	Note:
22Mar17 / 25Apr18	
Inv.1,264	1 - TWIN BATH: GROUP 1 COUNTER TOP
Line26668	Note:
22Mar17 / 25Apr18	
Inv.1,264	1 - ENSUITE 2: GROUP 1 COUNTER
Line26670	Note:
22Mar17 / 25Apr18	
Inv.1,861	1 - KITCHEN: *DELETE* COOK TOP CUT OUT
Line27066	Note: NOT REQUIRED
11Jun18 / 12Jun18	

HARDWOOD

Inv.1,264	1 - MAIN FLOOR HARDWOOD: FAMILY / DINING /MAIN HALL /LANDING: UPGRADE 1
Line26656	Note:
22Mar17 / 25Apr18	
Inv.1,264	1 - UPPER HALL: UPGRADE 1 HARDWOOD
Line26657	Note:
22Mar17 / 25Apr18	

KITCHEN AND BATH CABINETRY

Inv.1,264	1 - KITCHEN: UPGRADE 1 PROFILE - OAK
Line26645	Note:
22Mar17 / 25Apr18	
Inv.1,264	1 - KITCHEN: DOUBLE APPLIANCE CABINET AND COOKTOP CABINET
Line26646	Note:
22Mar17 / 25Apr18	

Brampton Encore - 2 - 1 - 38-4 Elev.B VIVALDI

Inv.1,264	1 - KITCHEN: PREMIUM STAIN
Line26647	Note:
22Mar17 / 25Apr18	
Inv.1,264	1 - KITCHEN: POTS AND PANS DRAWERS
Line26648	Note:
22Mar17 / 25Apr18	
Inv.1,264	2 - KITCHEN: 2 TIER SPICE PULL OUT
Line26649	Note:
22Mar17 / 25Apr18	
Inv.1,264	2 - KITCHEN: DEEP GABLE AT OVENS
Line26650	Note:
22Mar17 / 25Apr18	
Inv.1,264	1 - KITCHEN: 2 BIN RECYCLE CENTER
Line26651	Note:
22Mar17 / 25Apr18	
Inv.1,264	1 - KITCHEN: UPGRADE 2 + FLUSH BREAKFAST BAR
Line26652	Note:
22Mar17 / 25Apr18	
Inv.1,264	1 - KITCHEN BACKSPLASH: UPGRADE 2
Line26653	Note:
22Mar17 / 25Apr18	
Inv.1,264	1 - KITCHEN: UPGRADE 4 FLOOR TILE - 12X24" LAID STRAIGHT STACKED
Line26655	Note:
22Mar17 / 25Apr18	
Inv.1,264	4 - KITCHEN: PLAIN CLEAR GLASS DOOR
Line26660	Note:
22Mar17 / 25Apr18	
Inv.1,264	2 - KITCHEN: FINISHED INTERIOR FOR DOUBLE DOOR CABINET
Line26661	Note:
22Mar17 / 25Apr18	
Inv.1,264	1 - KITCHEN: UPGRADE HARDWARE
Line26663	Note:
22Mar17 / 25Apr18	
Inv.1,264	1 - KITCHEN: L-SHAPED CANOPY, INCLUDES FAN
Line26710	Note:
22Mar17 / 25Apr18	
Inv.1,861	1 - KITCHEN: *DELETE* DOUBLE APPLIANCE CABINET AND COOKTOP CABINET
Line27064	Note: NOT AVAILABLE DUE TO SITE CONDITION
11Jun18 / 12Jun18	
Inv.1,861	2 - KITCHEN: *DELETE* DEEP GABLE AT OVENS
Line27065	Note: NOT REQUIRED
11Jun18 / 12Jun18	

Brampton Encore - 2 - 1 - 38-4 Elev.B VIVALDI

Inv.1,861	1 - KITCHEN: PRICE CORRECTION - UPGRADE HARDWARE
Line27067	Note: PRICE CORRECTION - ITEM 19 FROM ORDER PE.1264
11Jun18 / 12Jun18	

Inv.1,861	1 - KITCHEN: SLIDE-IN STOVE PREP FOR 'STANDARD 30" SLIDE IN RANGE' - NO APPLIANCE SPECS WILL BE PROVIDED
Line27069	Note:
11Jun18 / 12Jun18	

PAINT

Inv.1,264	1 - MAIN STAIRS: STAIN STAIRS TO MATCH HARDWOOD
Line26659	Note:
22Mar17 / 25Apr18	

PLUMBING

Inv.1,264	1 - TWIN BATHROOM: CONTRAC 'CALVIN' OVAL UNDERMOUNT SINK
Line26669	Note:
22Mar17 / 25Apr18	

PLUMBING FIXTURES

Inv.1,264	1 - MASTER ENSUITE: CONTRAC 'CALVIN' OVAL UNDERMOUNT SINK
Line26666	Note:
22Mar17 / 25Apr18	

Inv.1,264	1 - ENSUITE 2: CONTRAC 'CALVIN' OVAL UNDERMOUNT SINK
Line26671	Note:
22Mar17 / 25Apr18	

Inv.1,264	1 - KITCHEN: BLANCO QUATRUS U SUPER SINGLE UNDERMOUNT SINK #401248
Line26672	Note:
22Mar17 / 25Apr18	

STAIRS AND RAILINGS

Inv.1,264	1 - MAIN STAIRS: EUROLINE 1 + V GROOVE
Line26658	Note:
22Mar17 / 25Apr18	

Inv.1,861	1 - MAIN STAIRS: PRICE CORRECTION FOR EUROLINE 1 + V GROOVE
Line27068	Note: PRICE CORRECTION ITEM 14 FROM ORDER PE.1264
11Jun18 / 12Jun18	

TRIM AND DOORS

Inv.1,264	1 - MAIN FLOOR: UPGRADE 2 TRIM PACKAGE
Line26709	Note: STANDARD ON 2ND FLOOR
22Mar17 / 25Apr18	

CORTINA
KITCHENS INC.

70 Regent Road, Woodbridge, Ontario L4L 8L6
Tel: 905-254-8494 Fax: 905-254-0094
www.CortinaKitchens.com

BE2-2

March 29 2018

QUOTATION

Date: 06/23/16

Trade Name: Gold Park Homes

Site location: Brampton

Model: 38-4

Address:






Project: Encore

Phase:

This layout has been explained to the purchaser by Cortina Kitchens Inc. and is understood by the purchaser.

REVISED

JUNE 11 2018

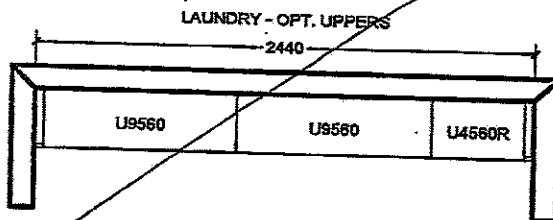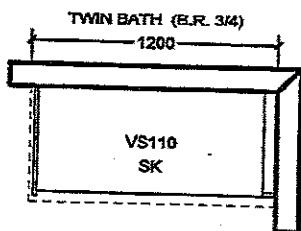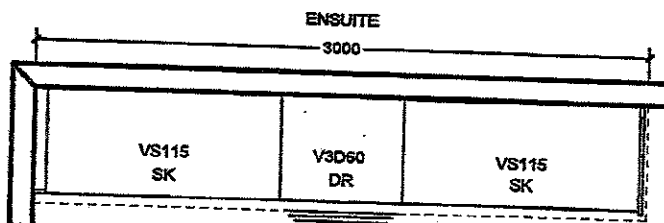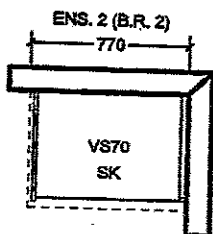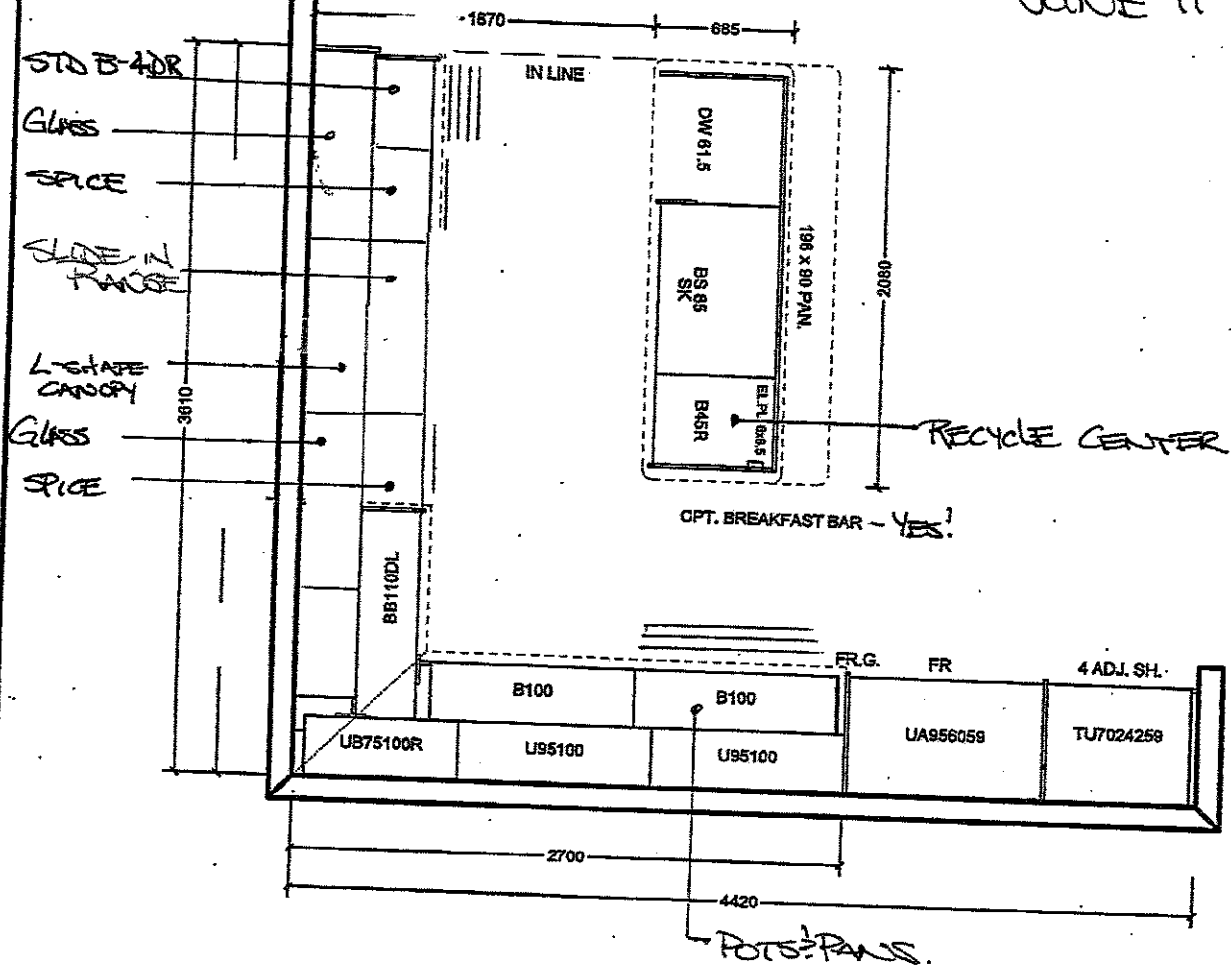

All prices subject to confirmation from head office.
This quotation is subject to the terms & conditions set out
in Cortina's Agreement of Purchase and Sale

All agreements are contingent upon strikes, accidents, and delay beyond our control.
Please provide our installer with template for sinkholes or \$150.00 will be charged for callback.

ACCEPTED DATE: _____

CUSTOMER SIGNATURE

SALESPERSON SIGNATURE

CORTINA HEAD OFFICE APPROVAL

ITEM A. Wood grain and colour are characteristics of the product, we cannot guarantee that such grain and colour will always match
ITEM B. Cortina Kitchens reserves the right to alter dimensions and make technical changes without notice.