

Brampton Encore - 84 - 1 - 41-5 Elev.B BRAHMS OPT - GFA1

CENTRAL VAC AND WIRING

Inv.1,316	1 - TELEPHONE AND CABLE ROUGH-IN LOCATION SKETCH
Line20739	Note:
10Apr17 / 3Aug17	
Inv.1,316	1 - SMART ETHERNET PACKAGE: INSTALL FOUR (X4) CAT 6 LOCATIONS IN LIEU OF THE FOUR (X4) STANDARD CAT 5 LOCATIONS. SEE SKETCH.
Line20741	Note: NOTE: STANDARD NANNY CAT 5 WAS MOVED TO REC ROOM
10Apr17 / 3Aug17	
Inv.1,316	1 - CONDUIT PIPE- FOR TELEVISION- MUST SPECIFY LOCATION AND TERMINATION POINT
Line23733	Note:
10Apr17 / 3Aug17	

CERAMIC

Inv.1,826	1 - KITCHEN BACKSPLASH: UPGRADE 4
Line26829	Note: PRICE INCLUDES BEHIND CHIMNEY HOOD FAN
12Apr18 / 3May18	
Inv.1,826	1 - FOYER / POWDER / KITCHEN-SERVERY-BREAKFAST / GARAGE ENTRANCE: UPGRADE 4 - 12X24" LAID IN STRAIGHT, STACKED PATTERN - SEE PLAN FOR TILE DIRECTION
Line26830	Note:
12Apr18 / 3May18	
Inv.1,826	1 - MASTER ENSUITE FLOOR TILE: UPGRADE 2 - 12X24" LAID IN STRAIGHT, STACKED PATTERN. SEE PLAN FOR TILE DIRECTION
Line26835	Note:
12Apr18 / 3May18	

CONCRETE AND DRAIN

Inv.1,316	1 - COLD CELLAR
Line23594	Note:
10Apr17 / 3Aug17	

ELECTRICAL

Inv.1,316	1 - KITCHEN: INSTALL 240V WALL RECEPTICAL ON DEDICATED CIRCUIT- FOR 4 WIRE BUILT-IN WALL OVEN -
NOTE: MICROWAVE AND WALL OVEN ARE ONE UNIT	
Line20743	Note:
10Apr17 / 3Aug17	
Inv.1,316	1 - KITCHEN: RELOCATE STANDARD FIXTURE IN KITCHEN TO ABOVE ISLAND. SEE SKETCH
Line20753	Note:
10Apr17 / 3Aug17	
Inv.1,316	1 - 110V WALL RECEPTACLE ON DEDICATED CIRCUIT - FOR FUTURE WINE FRIDGE
Line23734	Note:
10Apr17 / 3Aug17	
Inv.1,316	1 - KITCHEN: INSTALL GAS LINE ROUGH - MAIN FLOOR - (3 STOREY MODELS) AND 110V PLUG FOR STOVE
Line23736	Note:
10Apr17 / 3Aug17	

Brampton Encore - 84 - 1 - 41-5 Elev.B BRAHMS OPT - GFA1

Inv.1,316	1 - KITCHEN CABINET VALANCE LIGHTS (UNDER CABINETS) - WITH STRIP LIGHTS - DOES NOT INCLUDE (AND REQUIRES) KITCHEN UPGRADE PRICING
Line23737	Note:
10Apr17 / 3Aug17	
Inv.1,316	1 - KITCHEN: INSTALL ROUGH-N CEILING OUTLET & SWITCH (WITH COVER PLATE) DOES NOT INCLUDE FIXTURE- TO GO ABOVE ISLAND
Line23738	Note:
10Apr17 / 3Aug17	
Inv.1,316	2 - ADDITIONAL CAPPED FIXTURE ON SEPERATE SWITCH
Line23739	Note:
10Apr17 / 3Aug17	
Inv.1,826	1 - KITCHEN: CYCLONE CHIMNEY HOOD #SCB711
Line26823	Note:
12Apr18 / 3May18	

FRAMING

Inv.1,316	1 - MAIN FLOOR: INSTALL FIVE (X5) STANDARD DOOR EXTENDED HEIGHT 96" (PRICE PER DOOR) MAIN FLOOR 3 STOREY MODELS
Line23764	Note:
10Apr17 / 3Aug17	
Inv.1,316	1 - DEN: INSTALL TWO (X2) STANDARD FRENCH DOORS EXTENDED HEIGHT 96" (PRICE PER DOOR) MAIN FLOOR 3 STOREY MODELS
Line23765	Note:
10Apr17 / 3Aug17	

GRANITE MARBLE QUARTZ

Inv.1,316	1 - PLEASE INSTALL OPTIONAL SERVERY SINK
Line23732	Note:
10Apr17 / 3Aug17	
Inv.1,826	1 - KITCHEN: GROUP 2 COUNTER TOP
Line26826	Note:
12Apr18 / 3May18	
Inv.1,826	1 - KITCHEN: FLUSH BREAKFAST BAR
Line26827	Note:
12Apr18 / 3May18	
Inv.1,826	1 - KITCHEN: COOKTOP CUT OUT
Line26828	Note:
12Apr18 / 3May18	
Inv.1,860	1 - KITCHEN: *DELETE* COOKTOP CUT OUT
Line27060	Note: NOT REQUIRED
11Jun18 / 12Jun18	

HARDWOOD

Inv.1,826	1 - MAIN FLOOR HARDWOOD: FAMILY / LIVING / MAIN HALL / DEN / LANDINGS; UPGRADE 1
Line26831	Note:
12Apr18 / 3May18	

Brampton Encore - 84 - 1 - 41-5 Elev.B BRAHMS OPT - GFA1

Inv.1,826	1 - UPPER HALL: UPGRADE 1 HARDWOOD
Line26832	Note:
12Apr18 / 3May18	

HVAC

Inv.1,316	1 - KITCHEN: INSTALL GAS LINE ROUGH - MAIN FLOOR - (3 STOREY MODELS) AND 110V PLUG FOR STOVE
Line20748	Note:
10Apr17 / 3Aug17	
Inv.1,316	1 - UPGRADE VENTING FOR STOVE TO 8" PIPE INTERIOR WALL - ACCOMODATED TO FIT STANDARD RANGE HOOD
Line23735	Note:
10Apr17 / 3Aug17	

INTERIOR TRIM AND DOORS

Inv.1,316	5 - MAIN FLOOR: INSTALL FIVE (X5) STANDARD DOOR EXTENDED HEIGHT 96" (PRICE PER DOOR) MAIN FLOOR 3 STOREY MODELS
Line20755	Note:
10Apr17 / 3Aug17	
Inv.1,316	2 - DEN: INSTALL TWO (X2) STANDARD FRENCH DOORS EXTENDED HEIGHT 96" (PRICE PER DOOR) MAIN FLOOR 3 STOREY MODELS
Line20756	Note:
10Apr17 / 3Aug17	

KITCHEN AND BATH CABINETRY

Inv.1,826	1 - KITCHEN: PREMIUM STAIN
Line26817	Note:
12Apr18 / 3May18	
Inv.1,826	1 - KITCHEN: BUILT-IN WALL OVEN AND COOKTOP
Line26818	Note:
12Apr18 / 3May18	
Inv.1,826	1 - KITCHEN: GABLE AT OVENS
Line26819	Note:
12Apr18 / 3May18	
Inv.1,826	1 - KITCHEN: POTS AND PANS DRAWERS (BELOW COOKTOP) FALSE TOP DRAWER
Line26820	Note:
12Apr18 / 3May18	
Inv.1,826	4 - KITCHEN: TOP DRAWER - 1 LONG DRAWER (PRICED AS 2)
Line26821	Note:
12Apr18 / 3May18	
Inv.1,826	1 - KITCHEN: DELETE UPPERS ABOVE COOKTOP, FINISH SIDES OF CABINETS - LEAVE APPROX. 36" FOR 30" CHIMNEY-STYLE HOOD FAN
Line26822	Note:
12Apr18 / 3May18	
Inv.1,826	4 - KITCHEN: PLAIN, CLEAR GLASS CABINET
Line26824	Note:
12Apr18 / 3May18	

Brampton Encore - 84 - 1 - 41-5 Elev.B BRAHMS OPT - GFA1

Inv.1,826	2 - KITCHEN: FINISHED INTERIOR FOR DOUBLE CABINET
Line26825	Note:
12Apr18 / 3May18	
Inv.1,826	1 - KITCHEN: UNDER CABINET LIGHT VALANCE
Line26836	Note:
12Apr18 / 3May18	
Inv.1,860	1 - KITCHEN: *DELETE* BUILT-IN WALL OVEN AND COOKTOP
Line27057	Note: NOT AVAILABLE DUE TO SITE CONDITION
11Jun18 / 12Jun18	
Inv.1,860	1 - KITCHEN: *DELETE* GABLE AT OVENS
Line27058	Note: NOT REQUIRED
11Jun18 / 12Jun18	
Inv.1,860	1 - KITCHEN: *DELETE* POTS AND PANS DRAWERS (BELOW COOKTOP) FALSE TOP DRAWER
Line27059	Note: NOT REQUIRED
11Jun18 / 12Jun18	
Inv.1,860	1 - KITCHEN: SLIDE IN STOVE PREP FOR 'STANDARD 30" SLIDE IN RANGE' - NO APPLIANCE SPECS WILL BE PROVIDED
Line27061	Note:
11Jun18 / 12Jun18	
Inv.1,860	2 - KITCHEN: POTS AND PANS DRAWERS
Line27062	Note: LOCATE EITHER SIDE OF RANGE
11Jun18 / 12Jun18	
Inv.1,860	4 - KITCHEN: *DELETE* LONG TOP DRAWER
Line27063	Note: NOT REQUIRED
11Jun18 / 12Jun18	

MISC.

Inv.1,316	1 - Purchaser has attended a Structural appointment at the Decor Centre & has DECLINED any additional upgrades and accepts and acknowledges that there will be no further structural changes/additions/deletions to be made upon signing on April 10, 2017
Line20780	Note:
10Apr17 / 3Aug17	
Inv.1,316	1 - Purchasers are aware & accepts that ANY changes made to upgrades after signing this Purchasers Extra Form are subject to a minimum administration fee of \$500. PLUS a 10% holdback fee
Line20781	Note:
10Apr17 / 3Aug17	

PAINT

Inv.1,826	1 - MAIN STAIRS: STAIN STAIRS TO MATCH HARDWOOD, AS CLOSE AS POSSIBLE
Line26834	Note:
12Apr18 / 3May18	

PLUMBING

Inv.1,316	1 - BASEMENT: INSTALL ROUGH-IN - 3PC BASEMENT ROUGH-IN
Line20744	Note:
10Apr17 / 3Aug17	

Brampton Encore - 84 - 1 - 41-5 Elev.B BRAHMS OPT - GFA1

Inv.1,316	1 - KITCHEN: INSTALL ROUGH-IN - WATERLINE FOR FRIDGE
Line20751	Note:
10Apr17 / 3Aug17	

Inv.1,316	1 - PLEASE INSTALL OPTIONAL SERVERY SINK
Line23731	Note:
10Apr17 / 3Aug17	

STAIRS AND RAILINGS

Inv.1,826	1 - MAIN STAIRS: EUROLINE 1 + V GROOVE
Line26833	Note:
12Apr18 / 3May18	

WINDOWS - BASEMENT

Inv.1,316	3 - BASEMENT: INSTALL THREE (X3) BASEMENT WINDOWS - UPGRADE EXISTING BASEMENT WINDOW TO 30 INCH X 24 INCH - MAY REQUIRE INSTALLATION OF WINDOW WELL
Line20747	Note:
10Apr17 / 3Aug17	

BE - 84.
April 12 2008 *REVISED* June 11 2008

QUOTATION

Date: 23/06/16

Trade Name: Gold Park Homes

Site location: Brampton

Model: 41-5




Address:

Project: Encore

Phase:






This layout has been explained to the purchaser by Cortina Kitchens Inc. and is understood by the purchaser.

KITCHEN

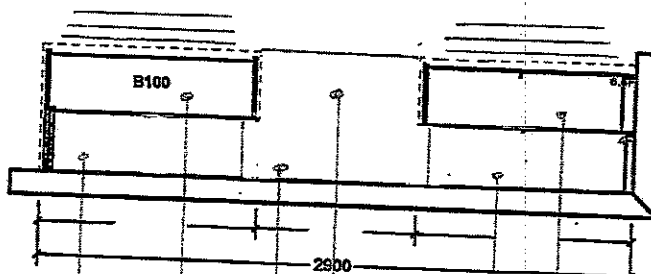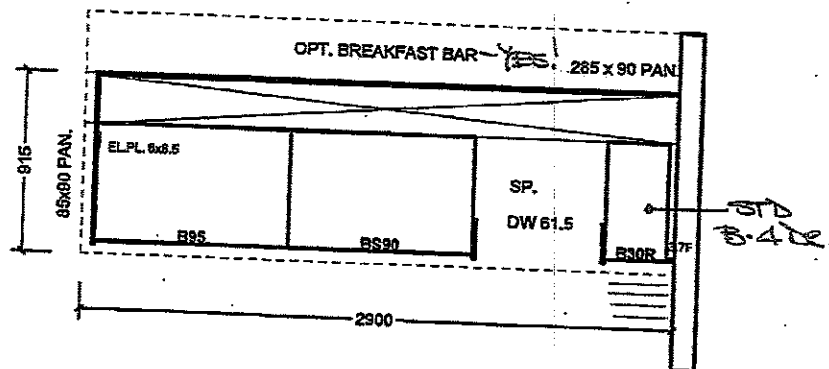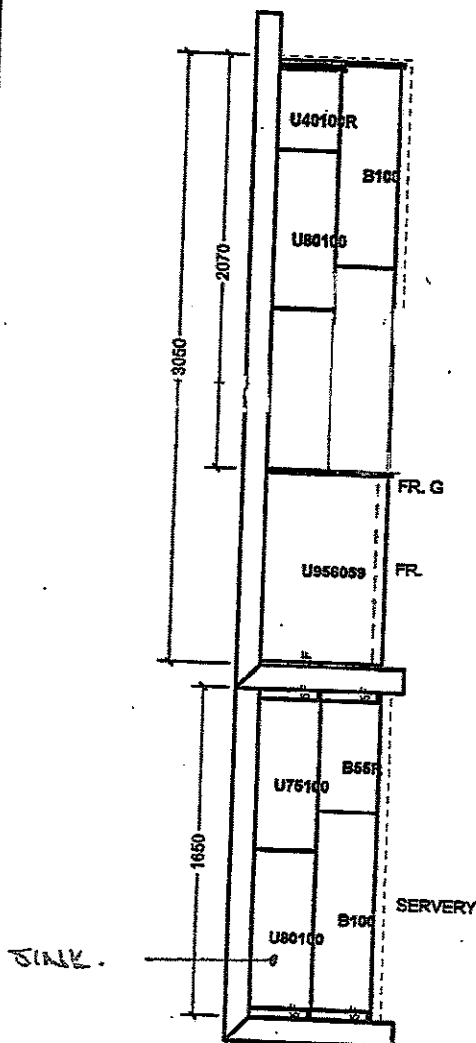

GLASS
ROCK
FRAB.
26" SPAC
for 30" chimney
30" SLIDE IN
FRABCE

GLASS
ROCK
FRAB.

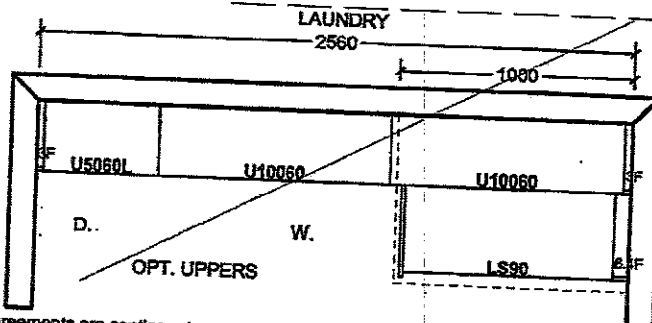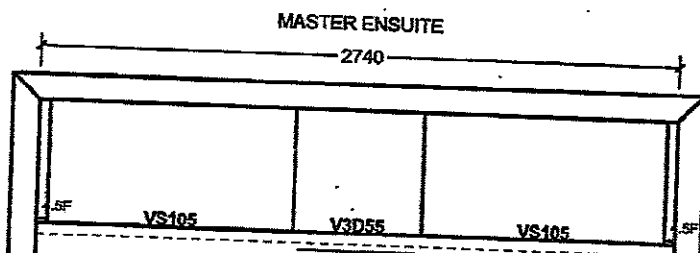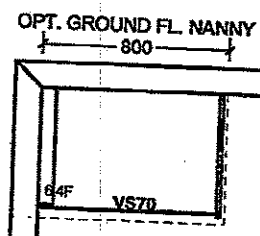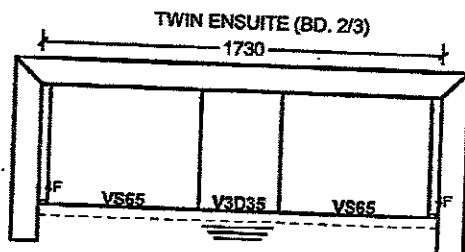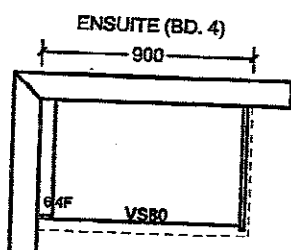

All prices subject to confirmation from head office.
This quotation is subject to the terms & conditions set out

ACCEPTED DATE: _____

All agreements are contingent upon strikes, accidents, and delays beyond our control.
Please provide our installer with template for sinkholes or \$150.00 will be charged for callback.