

Kleinburg Glen - BLOCK 51 - 2 - 42-3 Elev.B CARLTON
CENTRAL VAC AND WIRING

Inv.1,886	3 - BEDROOM 2 / BEDROOM 3 / BEDROOM 4: CAT 5 WIRING - ADD EXTRA CABLE OUTLET OUTLET
Line27118	Note: SEE FLOOR PLAN FOR LOCATION
2Aug18 / 8Aug18	
Inv.1,886	6 - GREAT ROOM / DEN / MASTER BEDROOM / BEDROOM 2 / BEDROOM 3 / BEDROOM 4: CAT 6 WIRING - UPGRADE AN OUTLET TO CAT 6 - SEE PLAN FOR LOCATION
Line27119	Note:
2Aug18 / 8Aug18	
Inv.1,886	1 - GREAT ROOM: CONDUIT PIPE - FOR TELEVISION - LOCATE APPROX 66" A.F.F. ABOVE FIREPLACE, TERMINATING BESIDE CABLE OUTLET, SEE PLAN FOR LOCATION
Line27120	Note:
2Aug18 / 8Aug18	
Inv.1,886	1 - UPPER HALL: ROUGH - IN FOR EXTRA SECURITY KEY PAD
Line27121	Note:
2Aug18 / 8Aug18	
Inv.1,886	1 - ROUGH IN- RG6 CABLE/SATTELITE FROM PANEL TO ATTIC FOR FUTURE SATELLITE INSTALLTION
Line27123	Note:
2Aug18 / 8Aug18	

CERAMIC

Inv.1,824	1 - KITCHEN: UPGRADE 4 BACKSPLASH
Line26785	Note:
11Apr18 / 4May18	
Inv.1,824	1 - FOYER / POWDER / KITCHEN FLOOR TILE: UPGRADE 5 - 24X24" POLISHED
Line26787	Note:
11Apr18 / 4May18	
Inv.1,824	1 - MUDROOM: UPGRADE 4 FLOOR TILE - 12X24" LAID IN STRAIGHT, STACKED PATTERN - SEE PLAN FOR TILE DIRECTION
Line26793	Note:
11Apr18 / 4May18	
Inv.1,824	1 - MASTER ENSUITE: UPGRADE 4 FLOOR TILE - 12X24" LAID IN STRAIGHT, STACKED PATTERN SEE PLAN FOR TILE DIRECTION
Line26798	Note:
11Apr18 / 4May18	
Inv.1,824	1 - MASTER ENSUITE: UPGRADE 1 WALL TILE - 4x12" HORIZONTAL STACKED PATTERN
Line26799	Note:
11Apr18 / 4May18	
Inv.1,824	1 - ENSUITE 2: UPGRADE 2 FLOOR TILE - LAID IN STRAIGHT, STACKED PATTERN SEE PLAN FOR TILE DIRECTION
Line26802	Note:
11Apr18 / 4May18	
Inv.1,824	1 - TWIN BATHROOM: UPGRADE 2 FLOOR TILE - LAID IN STRAIGHT, STACKED PATTERN SEE PLAN FOR TILE DIRECTION
Line26803	Note:
11Apr18 / 4May18	
Inv.1,824	1 - LAUNDRY ROOM: UPGRADE 2 FLOOR TILE - LAID IN STRAIGHT, STACKED PATTERN SEE PLAN FOR TILE DIRECTION
Line26806	Note:
11Apr18 / 4May18	

Kleinburg Glen - BLOCK 51 - 2 - 42-3 Elev.B CARLTON

CONCRETE AND DRAIN

Inv.1,623	1 - BACKFLOW PREVENTER VALVE	
Line24505	Note:	
25Oct17 / 25Oct17		

CROWN MOULDING

Inv.1,633	1 - GREAT ROOM: INSTALL WAFFLE CEILING DETAIL AS PER FLOOR PLAN TIC-164	
Line25765	Note:	
10Nov17 / 2Feb18		
Inv.1,633	1 - DEN: INSTALL WAFFLE CEILING DETAIL AS PER FLOOR PLAN TIC-164	
Line25766	Note:	
10Nov17 / 2Feb18		
Inv.1,633	1 - DINING ROOM: INSTALL WAFFLE CEILING DETAIL AS PER FLOOR PLAN TIC-164	
Line25767	Note:	
10Nov17 / 2Feb18		
Inv.1,824	1 - FAMILY ROOM: 7-BOX WAFFLE CEILING (UPGRADE TO CTB-702) DIFFERENCE IN PRICE FROM TIC-164 PREVIOUSLY ORDERED	
Line26809	Note: **NOT** TIC-164 AS ORDERED ON PE1633	
11Apr18 / 4May18		

DRYWALL

Inv.1,623	1 - MAIN FLOOR CEILING 10FT, 8FT TALLER INTERIOR DOORS, TALLER FLAT ARCHES, REAR AND FRONT WINDOWS WITH TRANSOM, TALLER KITCHEN CABINETS WITH CROWN AND FURRING PANEL, ADDED STAIRS AND PICKETS	
Line24496	Note:	
25Oct17 / 25Oct17		
Inv.1,623	1 - SMOOTH CEILINGS 2ND FLOOR	
Line24508	Note:	
25Oct17 / 25Oct17		

ELECTRICAL

Inv.1,623	1 - GAS LINE ROUGH - MAIN FLOOR - (2 STOREY MODELS) FOR GAS STOVE- INCLUDES 110V PLUG ON SEPARATE CIRCUIT	
Line24502	Note:	
25Oct17 / 25Oct17		
Inv.1,623	1 - KITCHEN- FUTURE WALL OVEN- 220V WALL RECEPTICLE ON DEDICATED CIRCUIT	
Line24503	Note:	
25Oct17 / 25Oct17		
Inv.1,623	1 - UNDER CABINET VALANCE LIGHTING- DOES NOT INCLUDE VALANCE	
Line24504	Note:	
25Oct17 / 25Oct17		
Inv.1,623	1 - KITCHEN- FOR FUTURE PENDANT LIGHT- Rough-in light on existing switch- Capped (doesn't include fixture)	
Line24509	Note:	
25Oct17 / 25Oct17		
Inv.1,623	1 - KITCHEN- FOR FUTURE PENDANT LIGHT- Rough-in light on a seperate switch- Capped (doesn't incude fixture)	
Line24510	Note:	
25Oct17 / 25Oct17		

Kleinburg Glen - BLOCK 51 - 2 - 42-3 Elev.B CARLTON

Inv.1,633	5 - GREAT ROOM: INSTALL 5 POTLIGHTS ON SAME SWITCH- SEPARATE SWITCH FROM STD FIXTURE STANDARD FIXTURE AND SWITCH TO REMAIN SEE FLOORPLAN FOR LOCATIONS
Line25747	Note:
10Nov17 / 2Feb18	
Inv.1,633	1 - GREAT ROOM: Additional Interior Switch FOR 5 POTLIGHTS
Line25748	Note:
10Nov17 / 2Feb18	
Inv.1,633	4 - DEN ROOM: INSTALL 4 POTLIGHTS ON STD SWITCH- DELETE STANDARD FIXTURE STD SWITCH TO REMAIN SEE FLOORPLAN FOR LOCATIONS
Line25749	Note:
10Nov17 / 2Feb18	
Inv.1,633	4 - LIVING ROOM: INSTALL 4 POTLIGHTS ON SAME SWITCH
Line25750	Note:
10Nov17 / 2Feb18	
Inv.1,633	1 - LIVING ROOM: Additional Interior Switch FOR 4 POTLIGHTS
Line25751	Note:
10Nov17 / 2Feb18	
Inv.1,633	4 - DINING ROOM: INSTALL 4 POTLIGHTS ON SAME SWITCH- SEPARATE SWITCH FROM STD FIXTURE STANDARD FIXTURE AND SWITCH TO REMAIN SEE FLOORPLAN FOR LOCATIONS
Line25752	Note:
10Nov17 / 2Feb18	
Inv.1,633	1 - DINING ROOM: Additional Interior Switch FOR 4 POTLIGHTS
Line25753	Note:
10Nov17 / 2Feb18	
Inv.1,633	4 - BREAKFAST ROOM: INSTALL 4 POTLIGHTS ON SAME SWITCH- SEPARATE SWITCH FROM STD FIXTURES STANDARD FIXTURES AND SWITCH TO REMAIN SEE FLOORPLAN FOR LOCATIONS
Line25754	Note:
10Nov17 / 2Feb18	
Inv.1,633	1 - BREAKFAST ROOM: Additional Interior Switch FOR 4 POTLIGHTS
Line25755	Note:
10Nov17 / 2Feb18	
Inv.1,633	5 - KITCHEN: DELETE STD FIXTURES INSTALL 5 POTLIGHTS ON SAME SWITCH
Line25756	Note:
10Nov17 / 2Feb18	
Inv.1,633	1 - KITCHEN: Additional Interior Switch FOR 5 POTLIGHTS
Line25757	Note:
10Nov17 / 2Feb18	
Inv.1,633	1 - SERVICE HALL: DELETE STD FIXTURES INSTALL 1 POTLIGHTS ON SAME SWITCH
Line25758	Note:
10Nov17 / 2Feb18	
Inv.1,633	2 - POWDER ROOM: DELETE STD WALL FIXTURE INSTALL 2 POTLIGHTS ON SAME STD SWITCH
Line25759	Note:
10Nov17 / 2Feb18	

Kleinburg Glen - BLOCK 51 - 2 - 42-3 Elev.B CARLTON

Inv.1,633	5 - FOYER: INSTALL 5 POTLIGHTS ON SAME SWITCH- SEPARATE SWITCH FROM STD FIXTURE STANDARD FIXTURE AND SWITCH TO REMAIN SEE FLOORPLAN FOR LOCATIONS
Line25760	Note:
10Nov17 / 2Feb18	
Inv.1,633	1 - FOYER: Additional Interior Switch FOR 5 POTLIGHTS
Line25761	Note:
10Nov17 / 2Feb18	
Inv.1,633	1 - EXTERIOR SOFFIT LIGHTS: CORNER UPGRADE- 4XPOTLIGHTS IN FRONT SOFFIT 5X POTLIGHTS IN SIDE UPGRADED ELEVATION SOFFIT- SEE ELEVATIONS FOR LOCATIONS
Line25769	Note:
10Nov17 / 2Feb18	
Inv.1,886	1 - GREAT ROOM: ADD ELECTRICAL OUTLET FOR FUTURE TV ABOVE FIREPLACE, APPROX. 66" A.F.F.
Line27122	Note:
2Aug18 / 8Aug18	

Exterior Colours

Inv.1,623	1 - EXTERIOR COLOUR PACKAGE #9
Line24494	Note:
25Oct17 / 25Oct17	

FRAMING

Inv.1,623	1 - MAIN FLOOR CEILING 10FT, 8FT TALLER INTERIOR DOORS, TALLER FLAT ARCHES, REAR AND FRONT WINDOWS WITH TRANSOM, TALLER KITCHEN CABINETS WITH CROWN AND FURRING PANEL, ADDED STAIRS AND PICKETS
Line24495	Note:
25Oct17 / 25Oct17	
Inv.1,633	1 - GREAT ROOM: COFFER CEILING IN GREAT ROOM FOR FUTURE WAFFLE DETAIL
Line25762	Note:
10Nov17 / 2Feb18	
Inv.1,633	1 - LIVING/DINING ROOM: COFFER CEILING AS PER FLOOR PLAN
Line25763	Note:
10Nov17 / 2Feb18	
Inv.1,633	1 - DEN: COFFER DEN FOR FUTURE WAFFLE
Line25764	Note:
10Nov17 / 2Feb18	

GRANITE MARBLE QUARTZ

Inv.1,824	1 - KITCHEN: GROUP 5 COUNTER TOP 3CM
Line26782	Note:
11Apr18 / 4May18	
Inv.1,824	2 - KITCHEN: WATER FALL LEG 3CM
Line26783	Note:
11Apr18 / 4May18	
Inv.1,824	1 - POWDER ROOM: GROUP 5 COUNTER TOP
Line26790	Note:
11Apr18 / 4May18	

Kleinburg Glen - BLOCK 51 - 2 - 42-3 Elev.B CARLTON

Inv.1,824	1 - MASTER ENSUITE: GROUP 3 COUNTER TOP	
Line26800	Note:	
11Apr18 / 4May18		
Inv.1,824	1 - ENSUITE 2: GROUP 2 COUNTER TOP	
Line26804	Note:	
11Apr18 / 4May18		
Inv.1,824	1 - TWIN BATH: GROUP 2 COUNTER TOP	
Line26805	Note:	
11Apr18 / 4May18		
Inv.1,824	1 - KITCHEN: COOKTOP CUT OUT	
Line26810	Note:	
11Apr18 / 4May18		

HARDWOOD

Inv.1,824	1 - UPPER HALL: UPGRADE 1 HARDWOOD	
Line26794	Note:	
11Apr18 / 4May18		

HVAC

Inv.1,623	1 - GAS LINE ROUGH - MAIN FLOOR - (2 STOREY MODELS) FOR GAS STOVE- INCLUDES 110V PLUG ON SEPARATE CIRCUIT	
Line24501	Note:	
25Oct17 / 25Oct17		

INTERIOR TRIM AND DOORS

Inv.1,623	1 - MAIN FLOOR CEILING 10FT, 8FT TALLER INTERIOR DOORS, TALLER FLAT ARCHES, REAR AND FRONT WINDOWS WITH TRANSOM, TALLER KITCHEN CABINETS WITH CROWN AND FURRING PANEL, ADDED STAIRS AND PICKETS	
Line24497	Note:	
25Oct17 / 25Oct17		

KITCHEN AND BATH CABINETRY

Inv.1,623	1 - MAIN FLOOR CEILING 10FT, 8FT TALLER INTERIOR DOORS, TALLER FLAT ARCHES, REAR AND FRONT WINDOWS WITH TRANSOM, TALLER KITCHEN CABINETS WITH CROWN AND FURRING PANEL, ADDED STAIRS AND PICKETS	
Line24498	Note:	
25Oct17 / 25Oct17		
Inv.1,824	1 - KITCHEN: UPGRADE 4 CABINETRY PROFILE MDF	
Line26773	Note:	
11Apr18 / 4May18		
Inv.1,824	1 - KITCHEN: UPGRADE HARDWARE	
Line26774	Note:	
11Apr18 / 4May18		
Inv.1,824	1 - KITCHEN: BUILT IN DOUBLE OVEN CABINET WITH DRAWER BELOW AND COOKTOP	
Line26775	Note:	
11Apr18 / 4May18		
Inv.1,824	1 - KITCHEN: DEEP GABLE AT OVENS	
Line26776	Note:	
11Apr18 / 4May18		



CONSTRUCTION SUMMARY

Kleinburg Glen - BLOCK 51 - 2 - 42-3 Elev.B CARLTON

Inv.1,824	1 - KITCHEN: ADJUST CABINETS FOR 36" COOKTOP	
Line26777	Note:	
11Apr18 / 4May18		
Inv.1,824	2 - KITCHEN: POTS AND PANS DRAWERS	
Line26778	Note:	
11Apr18 / 4May18		
Inv.1,824	4 - KITCHEN: TOP DRAWER - LONG TOP DRAWER PRICED AS 2	
Line26779	Note:	
11Apr18 / 4May18		
Inv.1,824	1 - KITCHEN: VETRINA -DOUBLE DOOR WITH PLAIN CLEAR BLASS AND MATCHING INTERIOR	
Line26780	Note:	
11Apr18 / 4May18		
Inv.1,824	1 - KITCHEN: VETRINA SINGLE DOOR WITH PLAIN CLEAR GLASS AND MATCHING INTERIOR	
Line26781	Note:	
11Apr18 / 4May18		
Inv.1,824	1 - KITCHEN: L-SHAPED CANOPY COMPLETE WITH FAN	
Line26784	Note:	
11Apr18 / 4May18		
Inv.1,824	1 - KITCHEN: RECYCLE CENTER	
Line26786	Note:	
11Apr18 / 4May18		
Inv.1,824	1 - POWDER ROOM: UPGRADE 2 PROFILE - MAPLE	
Line26788	Note: PRICE INCLUDES PREMIUM STAIN	
11Apr18 / 4May18		
Inv.1,824	1 - POWDER ROOM: UPGRADE HARDWARE	
Line26789	Note:	
11Apr18 / 4May18		
Inv.1,824	1 - MASTER ENSUITE: UPGRADE 2 CABINET PROFILE MAPLE	
Line26797	Note: PRICE INCLUDES PREMIUM STAIN	
11Apr18 / 4May18		
Inv.1,824	1 - LAUNDRY ROOM: UPPER CABINETS - STANDARD LEVEL	
Line26807	Note:	
11Apr18 / 4May18		
Inv.1,859	1 - KITCHEN: *DELETE* BUILT-IN DOUBLE WALL OVEN CABINET WITH DRAWER BELOW AND COOKTOP	
Line27049	Note: NOT AVAILABLE DUE TO SITE CONDITION	
9Jun18 / 11Jun18		
Inv.1,859	1 - KITCHEN: *DELETE* DEEP GABLE AT OVENS	
Line27050	Note: NOT REQUIRED	
9Jun18 / 11Jun18		
Inv.1,859	1 - KITCHEN: SLIDE-IN STOVE PREP FOR *36" SLIDE IN RANGE* NO SPECS WILL BE PROVIDED	
Line27051	Note:	
9Jun18 / 11Jun18		

Kleinburg Glen - BLOCK 51 - 2 - 42-3 Elev.B CARLTON

Inv.1,859	1 - KITCHEN: *DELETE* SINGLE DOOR VETRINA	
Line27052	Note:	
9Jun18 / 11Jun18		
Inv.1,859	1 - KITCHEN: 1 LONG TOP DRAWER IN LIEU OF STANDARD BANK OF DRAWERS (ORIGINALLY PRICED AS 2 TOP DRAWERS)	
Line27053	Note:	
9Jun18 / 11Jun18		
Inv.1,859	2 - KITCHEN: DELETE 2 TOP DRAWERS FROM INVOICE (USED AS 1 LONG TOP DRAWER IN LIEU OF STANDARD BANK OF DRAWERS)	
Line27054	Note:	
9Jun18 / 11Jun18		
Inv.1,859	2 - KITCHEN: CLEAR BEVELLED GLASS DOOR	
Line27055	Note: LOCATE BESIDE PANTRY	
9Jun18 / 11Jun18		
Inv.1,859	1 - KITCHEN: MATCHING INTERIOR - DOUBLE DOOR CABINET	
Line27056	Note: LOCATE BESIDE PANTRY	
9Jun18 / 11Jun18		
Inv.1,863	2 - KITCHEN: BEVELLED CLEAR GLASS AT VETRINA	
Line27075	Note:	
12Jun18 / 13Jun18		

PAINT

Inv.1,824	1 - MAIN STAIRS: STAIN STAIRS TO MATCH HARDWOOD, AS CLOSE AS POSSIBLE	
Line26796	Note:	
11Apr18 / 4May18		

PLUMBING FIXTURES

Inv.1,824	1 - POWDER ROOM: CONTRAC CAMDEN SQUARE UNDERMOUNT SINK #4210CHY	
Line26791	Note:	
11Apr18 / 4May18		
Inv.1,824	1 - KITCHEN: BLANCO SUPER SINGLE UNDERMOUNT SINK #401248	
Line26792	Note:	
11Apr18 / 4May18		
Inv.1,824	2 - MASTER ENSUITE: CONTRAC LEXINGTON OVERMOUNT SINK #13-0073	
Line26801	Note:	
11Apr18 / 4May18		
Inv.1,824	1 - ENSUITE 2: CONTRAC CALVIN OVAL UNDERMOUNT SINK #4220CFY	
Line26815	Note:	
11Apr18 / 4May18		
Inv.1,824	2 - TWIN BATH: CONTRAC CALVIN OVAL UNDERMOUNT SINK #4220CFY	
Line26816	Note:	
11Apr18 / 4May18		

STAIRS AND RAILINGS

Kleinburg Glen - BLOCK 51 - 2 - 42-3 Elev.B CARLTON

Inv.1,623	1 - MAIN FLOOR CEILING 10FT, 8FT TALLER INTERIOR DOORS, TALLER FLAT ARCHES, REAR AND FRONT WINDOWS WITH TRANSOM, TALLER KITCHEN CABINETS WITH CROWN AND FURRING PANEL, ADDED STAIRS AND PICKETS
Line24499	Note:
25Oct17 / 25Oct17	
Inv.1,824	1 - MAIN STAIRS: EUROLINE 2 + V GROOVE
Line26795	Note:
11Apr18 / 4May18	

TRIM AND DOORS

Inv.1,824	1 - MAIN FLOOR: UPGRADE 2 TRIM + 2ND FLOOR: UPGRADE 1 TRIM
Line26808	Note:
11Apr18 / 4May18	

WINDOWS - BASEMENT

Inv.1,623	4 - BASEMENT WINDOWS - UPGRADE EXISTING BASEMENT WINDOW TO 30 INCH X 16 INCH
Line24506	Note:
25Oct17 / 25Oct17	
Inv.1,631	1 - BASEMENT WINDOWS - UPGRADE EXISTING BASEMENT WINDOW TO 30 INCH X 16 INCH
Line24594	Note:
1Nov17 / 1Nov17	
Inv.1,633	1 - BASEMENT WINDOWS - EXTRA BASEMENT WINDOW 30 INCH X 16 INCH
Line24605	Note:
10Nov17 / 2Feb18	

WINDOWS AND DOORS

Inv.1,623	1 - MAIN FLOOR CEILING 10FT, 8FT TALLER INTERIOR DOORS, TALLER FLAT ARCHES, REAR AND FRONT WINDOWS WITH TRANSOM, TALLER KITCHEN CABINETS WITH CROWN AND FURRING PANEL, ADDED STAIRS AND PICKETS
Line24500	Note:
25Oct17 / 25Oct17	
Inv.1,623	1 - INSTALL MANDOOR-GARAGE TO HOUSE- GRADE PERMITS
Line24507	Note:
25Oct17 / 25Oct17	



162-51
And 1-20

the Carlton

Elevation A • 3,354 sq.ft.
Elevation B • 3,361 sq.ft.

* Cable
* Cat 6
* TV. Conduit


LEGEND.

⊙ FIBRE
⊙ CABLE

* Cable
* Cat 6
* Conduit Termination

* Cat 6

* Cable
* Cat 6

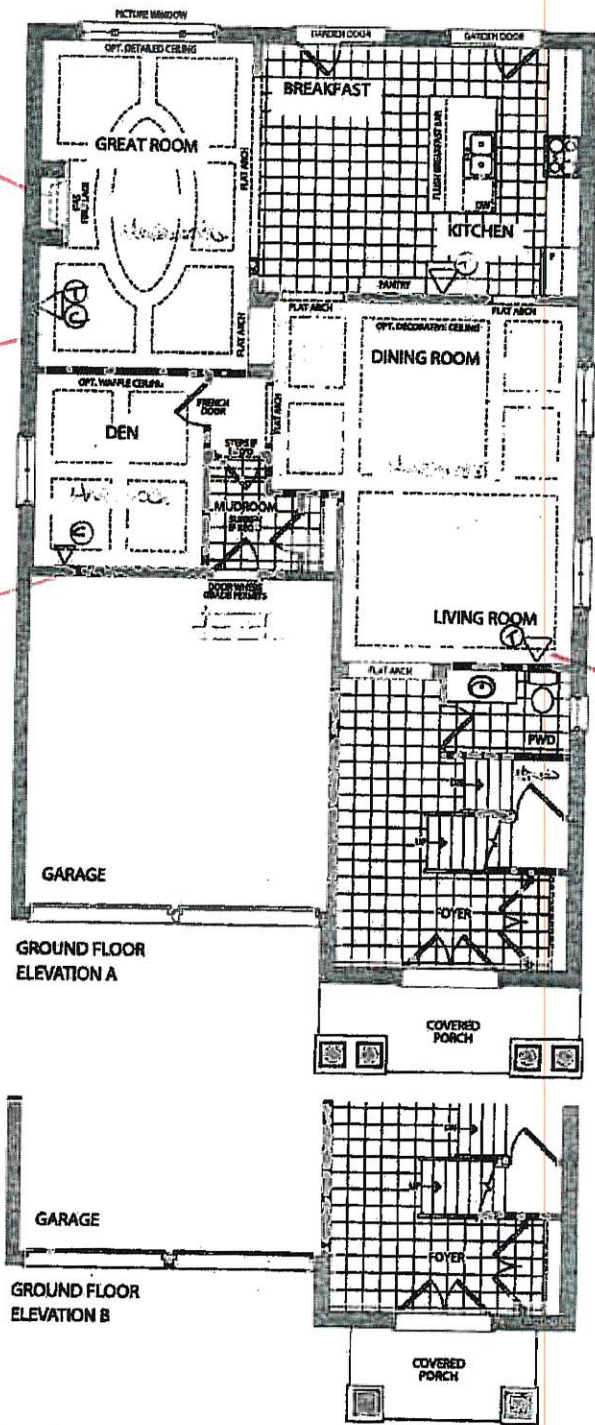


Prices, figures, illustrations, sizes, features and finishes are subject to change without notice. E.&O.E. Areas and dimensions are approximate and actual usable floor space may vary from the stated area. Layout may be reverse of the unit purchased. E. & O.E.

GOLDPARK
HOMES



the Carlton

Elevation A • 3,354 sq.ft.
Elevation B • 3,361 sq.ft.

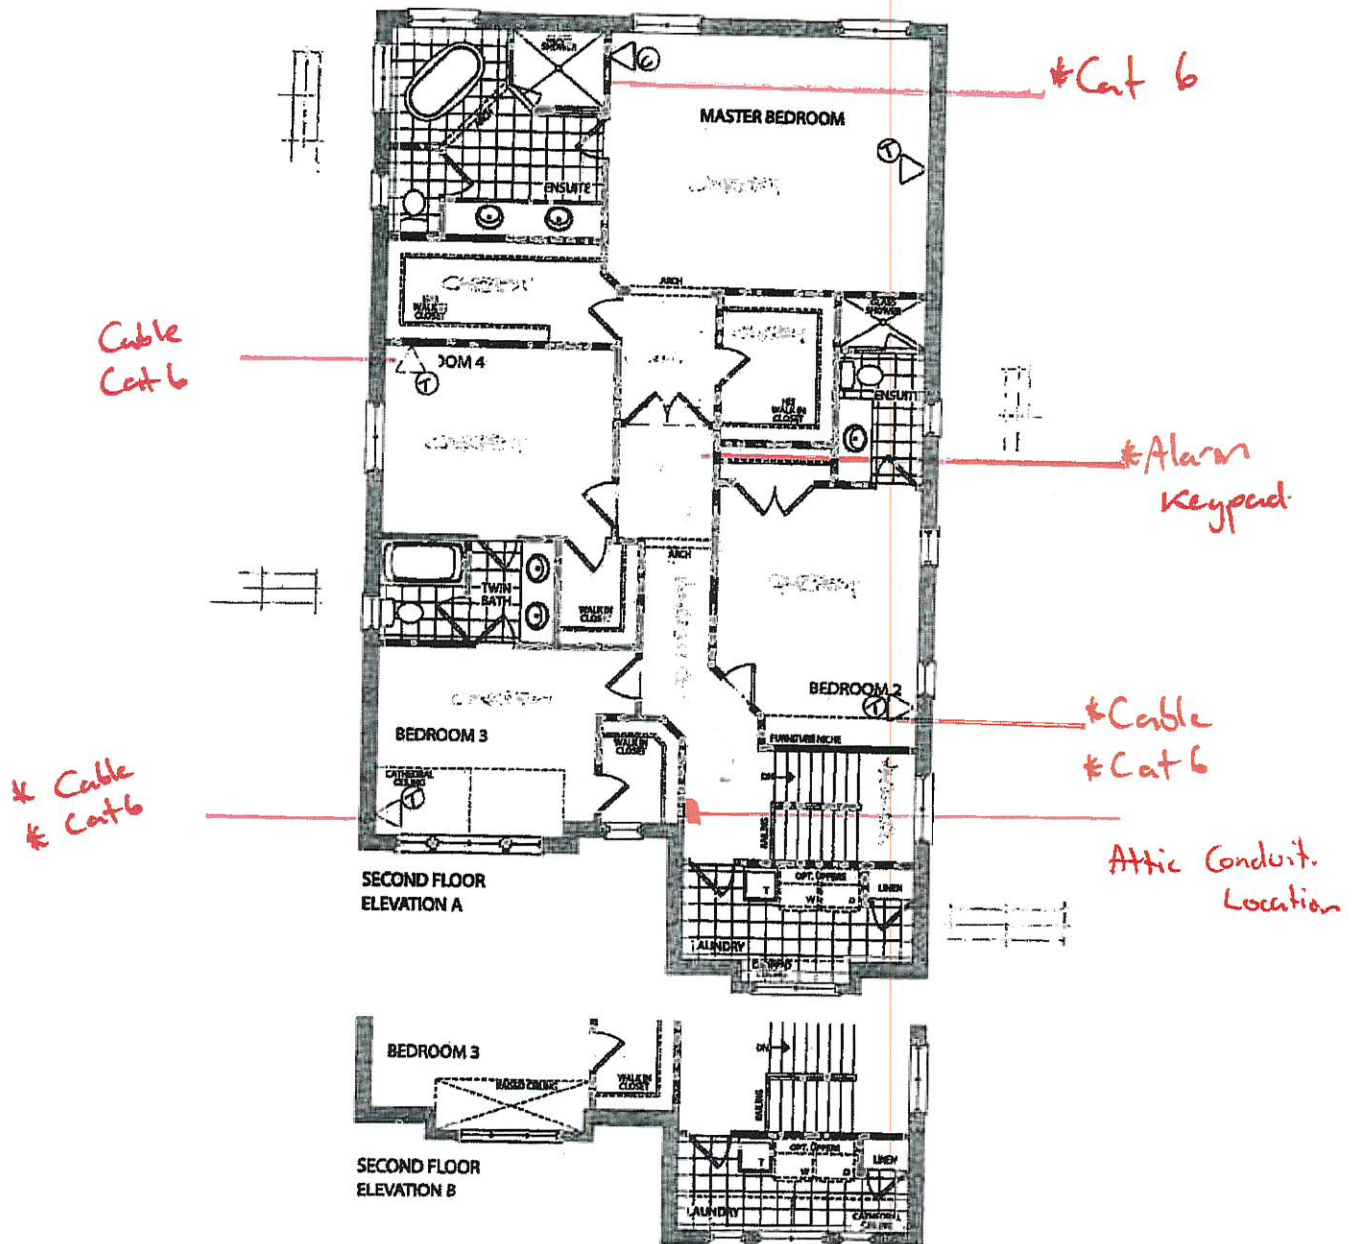

Prices, figures, illustrations, sizes, features and finishes are subject to change without notice. EAOE. Areas and dimensions are approximate and actual usable floor space may vary from the stated area. Layout may be reverse of the unit purchased. E. & O.E.



GOLDPARK
HOMES



132-31
Appl. to 100

the Carlton

Elevation A • 3,354 sq.ft.
Elevation B • 3,361 sq.ft.

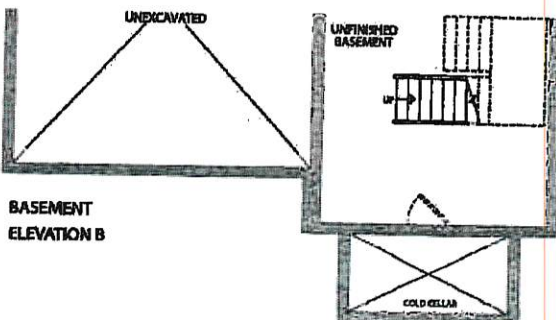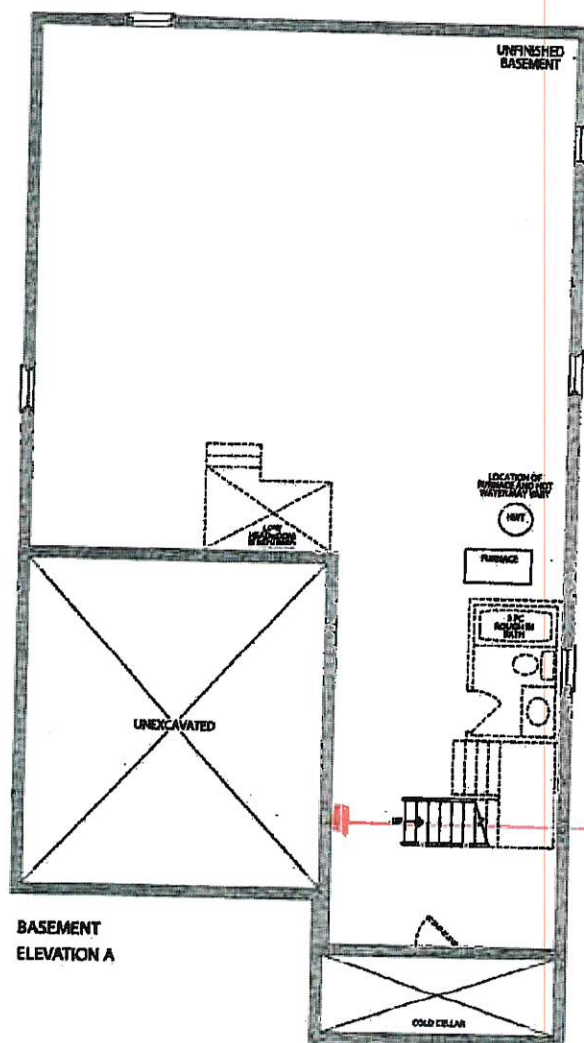

Pricing, figures, illustrations, sizes, features and finishes are subject to change without notice. E&OE. Areas and dimensions are approximate and actual usable floor space may vary from the stated area. Layout may be reverse of the unit purchased. E & OE.

GOLDPARK
HOMES