

Brampton Encore - 98 - 2 - 38-8 Elev.B CORELLI OPT - GFA1

CENTRAL VAC AND WIRING

Inv.1,966	1 - FAMILY ROOM: CONDUIT PIPE- FOR TELEVISION- LOCATE APPROX. 66" A.F.F. ABOVE FIREPLACE, TERMINATING BESIDE CABLE. SEE PLAN FOR LOCATION
Line27582	Note:
14Feb19 / 21Mar19	
Inv.1,966	1 - LIBRARY//DEN: CAT 6 WIRING - UPGRADE AN OUTLET TO CAT 6- SEE PLAN FOR LOCATION
Line27584	Note:
14Feb19 / 21Mar19	

CERAMIC

Inv.1,966	1 - KITCHEN FLOOR TILE: UPGRADE 4 - 12X24" LAID IN STRAIGHT, STACKED PATTERN. SEE PLAN FOR TILE DIRECTION
Line27617	Note: GROUT LINES AS SMALL AS POSSIBLE, PLEASE!
14Feb19 / 21Mar19	
Inv.1,966	1 - POWDER ROOM FLOOR TILE: UPGRADE 4 - 12X24" LAID IN STRAIGHT, STACKED PATTERN. SEE PLAN FOR TILE DIRECTION
Line27620	Note: GROUT LINES AS SMALL AS POSSIBLE PLEASE!
14Feb19 / 21Mar19	
Inv.1,966	1 - FOYER FLOOR TILE: UPGRADE 4 - 12X24" LAID IN STRAIGHT, STACKED PATTERN. SEE PLAN FOR TILE DIRECTION
Line27621	Note: GROUT LINES AS SMALL AS POSSIBLE, PLEASE!
14Feb19 / 21Mar19	
Inv.1,966	1 - MASTER ENSUITE FLOOR TILE: UPGRADE 4 - 12X24" LAID IN STRAIGHT, STACKED PATTERN. SEE PLAN FOR TILE DIRECTION
Line27628	Note:
14Feb19 / 21Mar19	
Inv.1,966	1 - MASTER ENSUITE: ADD STANDARD LEVEL TILE TO SHOWER CEILING
Line27631	Note:
14Feb19 / 21Mar19	

ELECTRICAL

Inv.1,966	1 - FAMIY ROOM: 110V WALL RECEPTACLE ON NORMAL CIRCUIT- LOCATE APPROX. 66' A.F.F. ABOVE FIREPLACE FOR FUTURE TV
Line27583	Note:
14Feb19 / 21Mar19	
Inv.1,966	1 - 200 AMP ELECTRICAL SERVICE
Line27585	Note:
14Feb19 / 21Mar19	
Inv.1,966	1 - KITCHEN: RELOCATE STANDARD CEILING LIGHT TO ABOVE ISLAND.
Line27586	Note: SEE PLAN FOR LOCATION
14Feb19 / 21Mar19	
Inv.1,966	2 - KITCHEN: ADD CAPPED CEILING OUTLETS ABOVE ISLAND, USE SAME SWITCH AS STANDARD CEILING LIGHT
Line27587	Note: SEE PLAN FOR LOCATION
14Feb19 / 21Mar19	
Inv.1,966	5 - KITCHEN: 4" HALOGEN POT LIGHT (10+)
Line27588	Note: SEE PLAN FOR LOCATION
14Feb19 / 21Mar19	

Brampton Encore - 98 - 2 - 38-8 Elev.B CORELLI OPT - GFA1

Inv.1,966	1 - KITCHEN: SINGLE POLE SWITCH FOR POTLIGHTS
Line27589	Note:
14Feb19 / 21Mar19	
Inv.1,966	6 - FAMILY ROOM: 4" HALOGEN POTLIGHT
Line27590	Note: SEE PLAN FOR LOCATION
14Feb19 / 21Mar19	
Inv.1,966	1 - FAMILY ROOM: SINGLE POLE SWITCH FOR POTLIGHTS
Line27591	Note:
14Feb19 / 21Mar19	
Inv.1,966	1 - KITCHEN: 110V WALL RECEPTACLE ON DEDICATED CIRCUIT - FOR (BUILT-IN) MICROWAVE - MICROWAVE NOT INCLUDED
Line27592	Note:
14Feb19 / 21Mar19	
Inv.1,966	1 - KITCHEN: 220V WALL RECEPTICAL ON DEDICATED CIRCUIT- FOR 4 WIRE BUILT-IN WALL OVEN - SEE PLAN FOR LOCATION
Line27593	Note:
14Feb19 / 21Mar19	
Inv.1,966	1 - KITCHEN: CHIMNEY-STYLE HOOD FAN #SC (B) 50030
Line27603	Note:
14Feb19 / 21Mar19	

FRAMING

Inv.1,966	1 - DEN/LIBRARY: DELETE 2 ARCHWAYS (DRYWALL OVER) - SEE PLAN FOR DETAIL.
Line27577	Note:
14Feb19 / 21Mar19	
Inv.1,966	1 - *note* MAIN FLOOR TO HAVE 96" ARCHES
Line27581	Note:
14Feb19 / 21Mar19	

GRANITE MARBLE QUARTZ

Inv.1,966	1 - KITCHEN: COOKTOP CUT OUT
Line27614	Note:
14Feb19 / 21Mar19	
Inv.1,966	1 - KITCHEN: UPGRADE 1 QUARTZ
Line27615	Note:
14Feb19 / 21Mar19	
Inv.1,966	1 - KITCHEN: FLUSH BREAKFAST BAR AT ISLAND
Line27616	Note:
14Feb19 / 21Mar19	
Inv.1,966	1 - MASTER ENSUITE: GROUP 1 QUARTZ
Line27629	Note:
14Feb19 / 21Mar19	
Inv.1,966	1 - ENSUITE 4: GROUP 1 COUNTER TOP
Line27646	Note:
14Feb19 / 21Mar19	

Brampton Encore - 98 - 2 - 38-8 Elev.B CORELLI OPT - GFA1

Inv.1,966	1 - GROUND FLOOR BATH: GROUP 1 QUARTZ
Line27635	Note:
14Feb19 / 21Mar19	
Inv.1,966	1 - SEMI ENSUITE 3/4: GROUP 1 QUARTZ
Line27640	Note:
14Feb19 / 21Mar19	

HARDWOOD

Inv.1,966	1 - MAIN FLOOR - FAMILY/LIVING/DINING/MAIN HALL/LIBRARY/LANDINGS: UPGRADE 4 - VINTAGE 5" HANDSCRAPED WHITE OAK
Line27624	Note:
14Feb19 / 21Mar19	
Inv.1,966	1 - UPPER HALL: UPGRADE 4 -VINTAGE 5" HAND SCRAPED WHITE OAK
Line27625	Note:
14Feb19 / 21Mar19	

HVAC

Inv.1,966	1 - KITCHEN: GAS LINE ROUGH - 2ND FLOOR- (3-STOREY MODELS) (INCLUDES REQUIRED ELECTRICAL)
Line27594	Note: FOR FUTURE GAS COOKTOP
14Feb19 / 21Mar19	
Inv.1,966	1 - HUMIDIFIER: WB3 - 17 (UP TO 3,000 SQ.FT.)
Line27595	Note:
14Feb19 / 21Mar19	

KITCHEN AND BATH CABINETRY

Inv.1,966	1 - KITCHEN: RELOCATE STANDARD BANK OF 4 DRAWERS TO ISLAND, SEE PLAN FOR LOCATION
Line27647	Note:
14Feb19 / 21Mar19	
Inv.1,966	1 - KITCHEN AND SERVERY: UPGRADE 1 OAK CABINETS
Line27604	Note:
14Feb19 / 21Mar19	
Inv.1,966	1 - KITCHEN/SERVERY: UPGRADE TO PREMIUM STAIN
Line27605	Note:
14Feb19 / 21Mar19	
Inv.1,966	1 - KITCHEN: DELETE UPPERS ABOVE COOK TOP, FINISH SIDES. LEAVE APPROX. 36" FOR 30" CHIMNEY-STYLE HOOD FAN
Line27606	Note:
14Feb19 / 21Mar19	
Inv.1,966	1 - KITCHEN: BUILT-IN DOUBLE APPLIANCE CABINET WITH COOK TOP CABINET
Line27607	Note:
14Feb19 / 21Mar19	
Inv.1,966	1 - KITCHEN: FINISHED GABLE (AT OVENS)
Line27608	Note:
14Feb19 / 21Mar19	

Brampton Encore - 98 - 2 - 38-8 Elev.B CORELLI OPT - GFA1

Inv.1,966	1 - KITCHEN/SERVERY: UPGRADE HARDWARE
Line27618	Note:
14Feb19 / 21Mar19	
Inv.1,966	1 - MASTER ENSUITE: UPGRADE HARDWARE
Line27630	Note:
14Feb19 / 21Mar19	

MISC.

Inv.1,966	1 - Purchaser has attended an appointment at the Decor Centre & has DECLINED any additional upgrades and accepts and acknowledges that there will be no further changes/additions/deletions to be made upon signing on February 14, 2019.
Line27642	Note:
14Feb19 / 21Mar19	
Inv.1,966	1 - Purchaser has attended an appt at the Decor Centre & has DECLINED any additional upgrades and accepts and acknowledges that they have checked the order and accepts the attached selections as noted.
Line27643	Note:
14Feb19 / 21Mar19	
Inv.1,966	1 - Purchaser has reviewed all extras and colours. All aspects of this order have been explained and no questions are outstanding. Purchasers are aware that verbal contracts do not form any part of this contract.
Line27644	Note:
14Feb19 / 21Mar19	
Inv.1,966	1 - KITCHEN - Purchaser accepts & acknowledges that in order to either complete or install built-in appliances and accommodate for cook-top, all appliance specifications must be provided to the Décor Center within one (1) week of completion of colour chart.
Line27645	Note:
14Feb19 / 21Mar19	

PAINT

Inv.1,966	1 - STAIRS: STAIN STAIRS TO MATCH HARDWOOD FLOOR AS CLOSE AS POSSIBLE
Line27626	Note: HARDWOOD AND STAIRS WILL NOT MATCH IN COLOUR, TEXTURE OR SPECIES
14Feb19 / 21Mar19	

PLUMBING

Inv.1,966	1 - ROUGH-IN - 3PC BASEMENT ROUGH-IN
Line27596	Note:
14Feb19 / 21Mar19	
Inv.1,966	1 - KITCHEN: ROUGH-IN - WATERLINE FOR FRIDGE
Line27598	Note:
14Feb19 / 21Mar19	
Inv.1,966	1 - MASTER ENSUITE: UPGRADE TO FREE STANDING TUB - MIROLIN 'BROOK'
Line27601	Note:
14Feb19 / 21Mar19	

PLUMBING FIXTURES

Inv.1,966	1 - KITCHEN: UPGRADE KITCHEN SINK - BLANCO QUATRUS R15U SUPER SINGLE #401518
Line27619	Note: DOES NOT INCLUDE BOTTOM GRID
14Feb19 / 21Mar19	
Inv.1,966	2 - MASTER ENSUITE: CONTRAC 'CALVIN' OVAL UNDER MOUNT SINK
Line27633	Note: PRICE INCLUDES STONE CUT/POLISH
14Feb19 / 21Mar19	

Brampton Encore - 98 - 2 - 38-8 Elev.B CORELLI OPT - GFA1

Inv.1,966	1 - GROUND FLOOR BATH: CONTRAC 'CALVIN' OVAL UNDERMOUNT SINK
Line27636	Note:
14Feb19 / 21Mar19	
Inv.1,966	1 - ENSUITE 4: CONTRAC 'CALVIN' OVAL UNDERMOUNT SINK
Line27639	Note: INCLUDES STONE CUT/POLISH
14Feb19 / 21Mar19	
Inv.1,966	2 - SEMI ENSUITE 3/4: CONTRAC 'CALVIN' OVAL UNDERMOUNT SINK
Line27641	Note: INCLUDES STONE CUT/POLISH
14Feb19 / 21Mar19	

STAIRS AND RAILINGS

Inv.1,966	1 - MAIN STAIRS: EUROLINE 1 + V GROOVE
Line27627	Note:
14Feb19 / 21Mar19	

TRIM AND DOORS

Inv.1,966	1 - DEN/LIBRARY: INSTALL TRIMMED ARCHWAY - 60"WIDE
Line27578	Note: CENTER ON LONG WALL, SEE PLAN FOR LOCATION
14Feb19 / 21Mar19	
Inv.1,966	8 - MAIN FLOOR: INCREASE ARCHWAYS TO 96"
Line27580	Note:
14Feb19 / 21Mar19	

WINDOWS - BASEMENT

Inv.1,966	2 - BASEMENT WINDOWS - UPGRADE EXISTING BASEMENT WINDOW TO 30 INCH X 24 INCH - MAY REQUIRE INSTALLATION OF WINDOW WELL
Line27597	Note: STANDARD WHITE COLOUR SEE PLAN FOR LOCATION
14Feb19 / 21Mar19	

Scheduled Closing Date:

Purchaser: Megan Townsend and Sandrow TownsendProperty: 98

Telephone Res. / Bus: Project: Brampton Encore - Phase 2

Decor Advisor: Shawn HajianModel and Elevation: 38-8 Elev.B CORELLI OPT - GFA1

Layout Changes: ☐ Yes ☒ NoSketch Attached: ☒ Yes ☐ NoExterior Colour Scheme:

1. Cabinetry

	Style and Colour	Counter	Hardware
Kitchen / Breakfast	*S303 OAK ' *CHARCOAL'	*QUARTZ 'SILKY WHITE'	*CH-46
Laundry Room	N/A	N/A	N/A
Powder Room	N/A	N/A	N/A
GROUND FL BATHRM	M500 MELAMINE 'MYSTIC'	*QUARTZ 'SILVER SHADOW'	CS1-24
Master Ensuite Bathroom	M500 MELAMINE 'MYSTIC'	*QUARTZ 'SILKY WHITE'	*CH-47
Second Ensuite Bathroom (If Applicable)	M500 MELAMINE 'MYSTIC'	*QUARTZ 'SILKY WHITE'	CS1-24
SEMI ENSUITE 3/4	M500 MEL. 'CRYSTAL WHIT'	*QUARTZ 'SILVER SHADOW'	CS1-24

Comment

2. Floor Tile

	Selection
Entrance Vestibule	*12X24" ETERNA LONDON POLISHED 'IMPERIAL GREY'
Main Hall	N/A
Kitchen / Breakfast	*12X24" ETERNA LONDON POLISHED 'IMPERIAL GREY'
Laundry Room	13X13" SERPENTINE 'BEYAZ WHITE'
Powder Room	*12X24" ETERNA LONDON POLISHED 'IMPERIAL GREY'
GROUND FL. BATH	13X13" SERPENTINE 'GREY'
Master Ensuite Bathroom	*12X24" TIMELESS POLISHED 'LIGHT GREY'
Second Ensuite Bathroom (If Applicable)	13X13" SERPENTINE SYRAK 'CHARCOAL'
Lower Landing (If Applicable)	GROUND FLOOR FOYER: 13X13" SERPENTINE 'GREY'
SEMI ENSUITE 3/4	13X13" SERPENTING 'GREY'

Comment

**GROUT LINES AS SMALL AS POSSIBLE, PLEASE!

3. Wall Tile

	Selection	Listello/Inserts	Describe
GROUND FL BATH WAL	8X10" WEAVE 'WHITE'	☐ Yes ☒ No	
Master Ensuite Bathroom			
Tub Deck	N/A	☐ Yes ☒ No	
Shower Stall	8X10" WEAVE 'TENDER GREY'	☐ Yes ☒ No	
Bathroom Walls	N/A	☐ Yes ☒ No	
Second Ensuite Bathroom (If Applicable)	8X10" WEAVE 'WHITE'	☐ Yes ☒ No	
SEMI ENSUITE 3/4	8X10" WEAVE 'WHITE'	☐ Yes ☒ No	
Kitchen Backsplash	☐ Yes ☒ No	Backsplash Behind Fridge	

Comment

**GROUT LINES AS SMALL AS POSSIBLE, PLEASE!

Scheduled Closing Date:

Purchaser: Megan Townsend and Sandrow Townsend Property: 98
Telephone Res. / Bus: Project: Brampton Encore - Phase 2
Decor Advisor: Shawn Hajian Model and Elevation: 38-8 Elev.B CORELLI OPT - GFA1

4. Plumbing Fixtures

Master Ensuite Bathroom Second Ensuite Powder Room
Other Room - Specify Other Washroom

Comment
SINKS ARE UPGRADED THRU OUT, EXCEPT POWDER ROOM

5. Hardwood Flooring

Main Hall Kitchen / Breakfast Living Room Dining Room Family Room Den/Library Entrance Vestibule Lower Landing (If Applicable)
Type and Stain *5" VINTAGE HS 'BOROQUE' N/A *5" VINTAGE HS 'BOROQUE' *5" VINTAGE HS 'BOROQUE' *5" VINTAGE HS 'BOROQUE' *5" VINTAGE HS 'BOROQUE' *5" VINTAGE HS 'BOROQUE' N/A *5" VINTAGE HS 'BOROQUE'
Upper Landing Upper Hall Master Bedroom Bedroom #2 Bedroom #3 Bedroom #4 Bedroom #5 Other Room - Specify
Type and Stain *5" VINTAGE HS 'BOROQUE' *5" VINTAGE HS 'BOROQUE' N/A N/A N/A N/A N/A

Comment

6. Carpeting

Ground Floor Second Floor
Upgrade Description STANDARD 'PEARL WHITE' w STANDARD UNDERPAD

Upgrade Underpad Carpet on Stairs
Type Area Capped Runner - *Upgrade

Comment

7. Fireplace

Living Room Family Room Other Room - Specify
Purchased As Per Plan N/A
Fireplace Type Mantle Type Colour / Stain Surround Hearth

Comment

Scheduled Closing Date:

Purchaser:

Megan Townsend and Sandrow Townsend

Property:

98

Telephone Res. / Bus:

Project:

Brampton Encore - Phase 2

Decor Advisor:

Shawn Hajian

Model and Elevation:

38-8 Elev.B CORELLI OPT - GFA1

8. Trim Carpentry

Interior Doors

STD

Front Door Glass Inserts

STD

Door Handles

STD

Interior Trim

STANDARD THRU OUT **96" ARCHES ON MAIN FLOOR**

Comment

9. Plaster Mouldings and Medallions

Standard Throughout

☐ Yes

☐ No

☒ N/A

Entrance Vestibule

Kitchen/Breakfast

Main Hall

Den/Library

Living Room

Lower Landing

Dining Room

Other Room - Specify

Family Room

Comment

10. Railings and Spindles

Railing Package

*EUROLINE 1 + V GROOVE

Railing Colour

*BOROQUE'

Stringer / Riser

*BOROQUE'

Spindle Colour

*BLACK

Treads

*BOROQUE'

Oak Stairs

☒ Yes

☐ No

☐ N/A

Comment

STAIRS WILL NOT MATCH HARDWOOD IN COLOUR, TEXTURE OR SPECIES

11. Wall Paint / Ceilings

Throughout Finished Areas

COOL WHITE

Trim Paint

White

Smooth Ceilings

Ground Floor

☐

Second Floor

☐

Note

Comment

Scheduled Closing Date:

Purchaser: Megan Townsend and Sandrow Townsend

Property: 98

Telephone Res. / Bus:

Project: Brampton Encore - Phase 2

Decor Advisor: Shawn Hajian

Model and Elevation: 38-8 Elev.B CORELLI OPT - GFA1

12. Electrical

Hood Fan ☐ White ☒ Stainless ☐ N/A

Above Kitchen Cabinet Light ☐ Yes ☒ No

Below Kitchen Cabinet Light ☐ Yes ☒ No

Standard Appliances ☐

Over The Range Microwave ☐

Chimney Style Fan ☒

Comment

BUILT-IN APPLIANCES

13. Heating and Air Conditioning

Air Conditioning

Gas Provisions Stove

Gas Provisions Dryer

Gas Provisions Barbecue

Comment

14. Additional Comments

15. Disclaimers and Notes

- 1) Colours of all materials are as close as possible to builder's selection, but not necessarily identical due to variances in manufacturing.
- 2) Any extras listed above are null and void unless accompanied by a separate invoice/amendment. Said invoice must be paid in full.
- 3) The Purchaser acknowledges that after Interior Colour Selection form is signed and dated, no further changes will be permitted other than re-selection due to unavailability. _____ Purchaser's Initials
- 4) The Purchaser acknowledges reading and accepting the "Gold Park Homes Decor Centre Disclaimers" form. This document contains other miscellaneous disclaimers.

This Interior Colour Selection is final and approved by:

Signature: _____ Date: _____

encore

BRAMPTON


BE2-98

FEB 14 2019.

X
my

X S.T

TILE

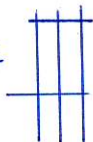

GAS 30" CT.

30" CHIMNEY HOOD

WALLOVEN
MICRO

LEGEND.

⊕ ELECTRICAL OUTLET

* CONDUIT

● POTLIGHT

○ STD LIGHT

⊕ CAPPED CEILING


⬡ 96" ARCH

△ PHONE

△ CABLE

△ CAT6.


\$ SWITCH.

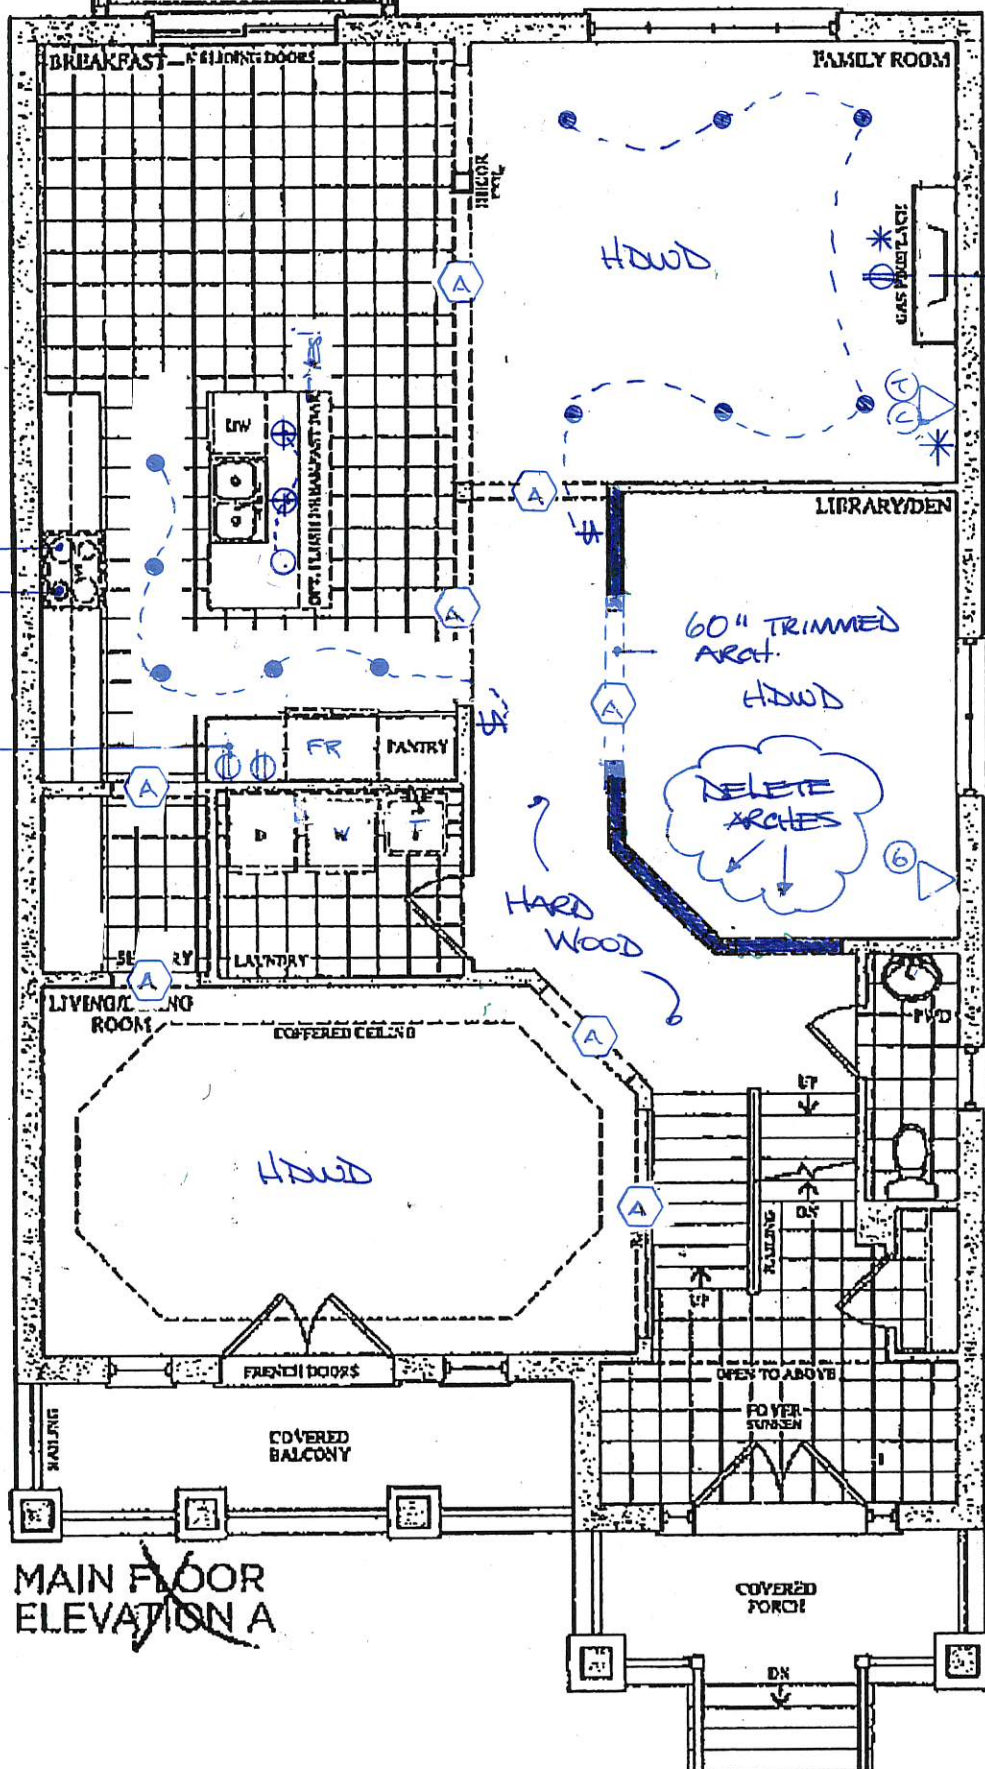

66" AFF

TILE

TILE

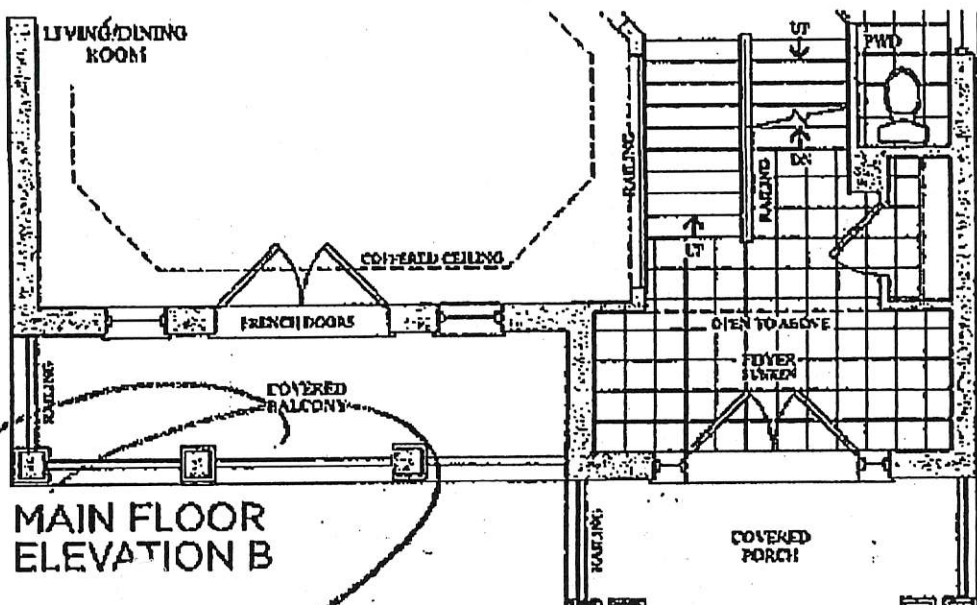

24x30"

24x30"

10'0" x 10'0"

10'0" x 10'0"



STD. WINDOW

3-PIECE
ROUGH IN.

10'0" x 10'0"

10'0" x 10'0"

10'0" x 10'0"

10'0" x 10'0"

BASEMENT ELEVATION A & B

BE2-98

FEB 4 2019

x 718

x 5.7

CORTINA
KITCHENS INC.
70 Regina Road, Woodbridge, Ontario L4L 6L6
Tel: 905-254-4644 Fax: 905-254-0554
www.CortinaKitchens.com

QUOTATION

Date: 06/23/16

Handwritten notes on the left margin:

- Handwritten "x" and "m" (possibly "m")
- Handwritten "x" and "S.T."


Trade Name: Gold Park Homes

Site location: Brampton

Phase:

Address:

This layout has been explained to the purchaser by Corina Kitchens Inc. and is understood by the purchaser.

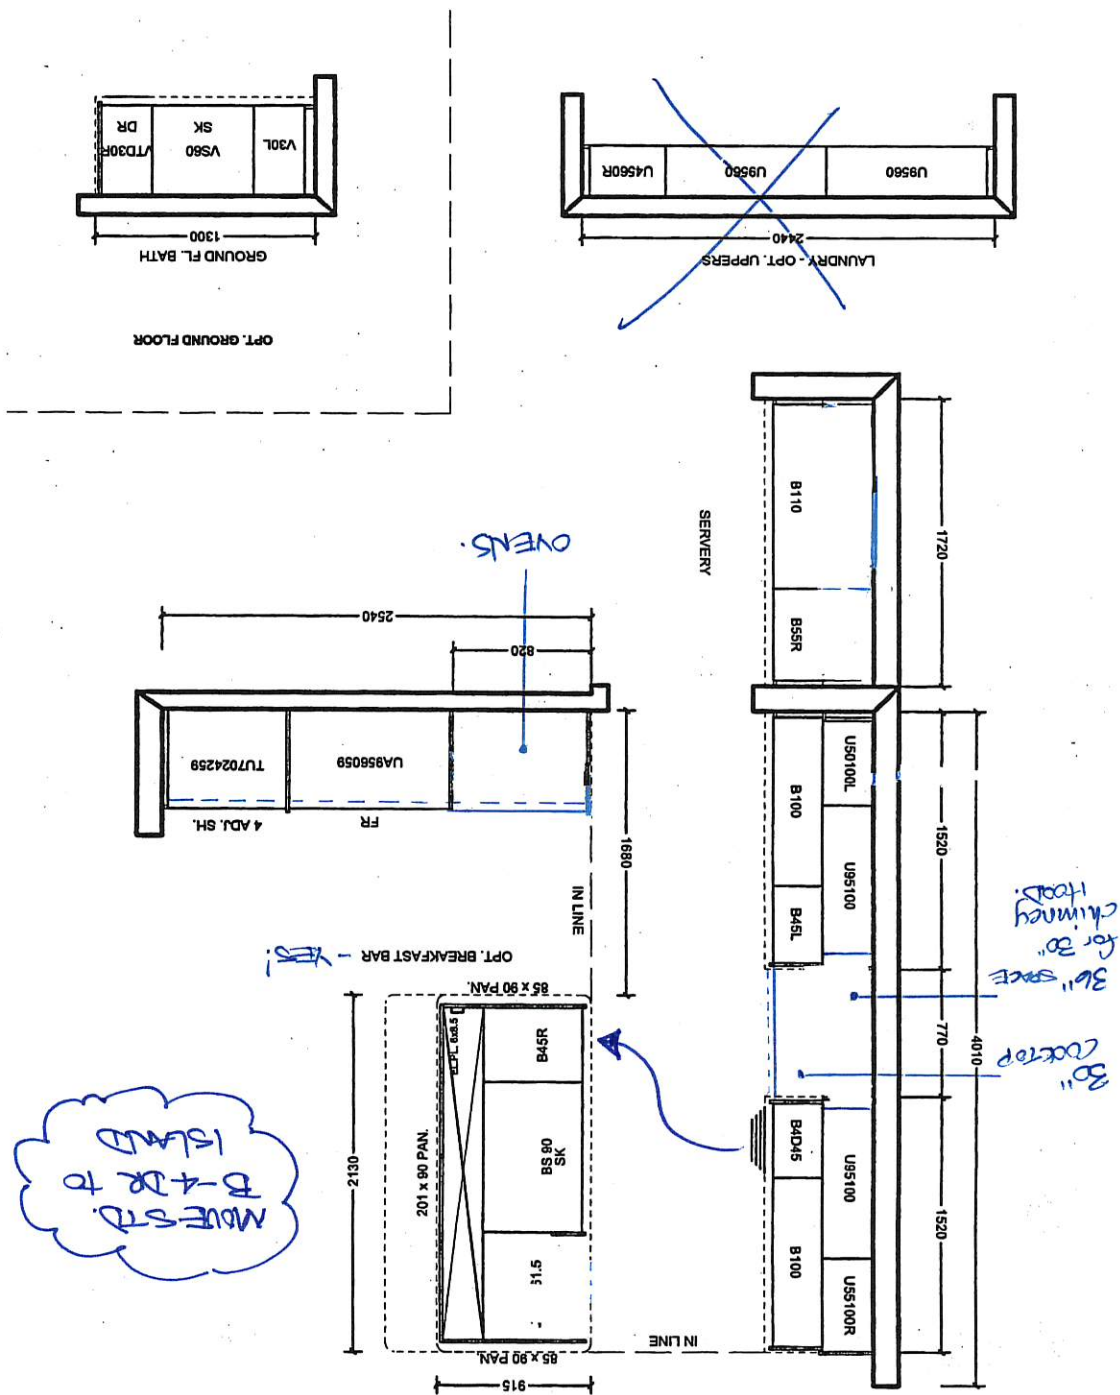

All prices subject to confirmation from head office. This quotation is subject to the terms & conditions set out in the Terms & Agreement of Purchase and Sale. Please provide our installer with template for sinkholes or \$150.00 will be charged for callback. All agreements are contingent upon strikes, accidents, and delay beyond our control.

ACCEPTED DATE:

CUSTOMER SIGNATURE

SALESPERSON SIGNATURE

CORTINA HEAD OFFICE APPROVAL

ITEM A. Wood grain and colour are characteristics of the product, we cannot guarantee that such grain and colour will always match
ITEM B. Cordina Kitchens reserves the right to alter dimensions and make technical changes without notice.

ITEM B. Cordina Kitchens reserves the right to alter dimensions and make technical changes without notice.


REF-98
FEB 4 2019. x my - x 5.7




CSI-6




CSI-10

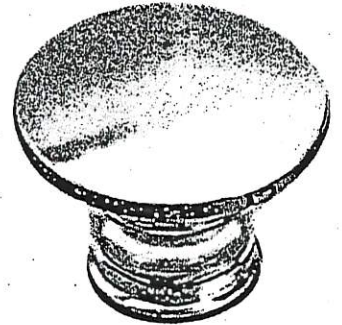


CSI-14

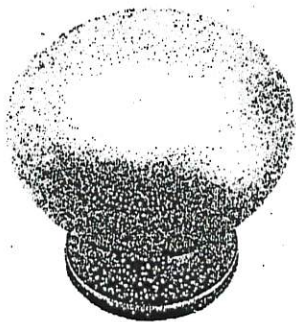


CSI-16

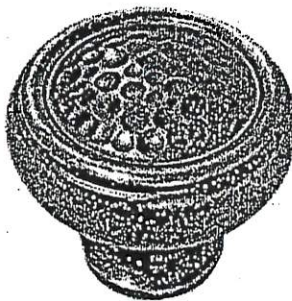


CSI-18

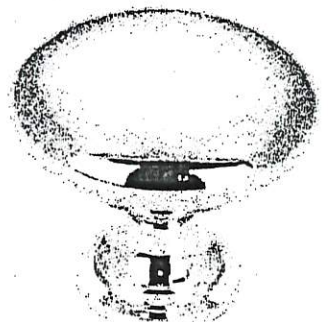

CSI-19

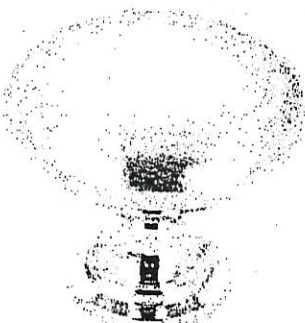


CSI-20

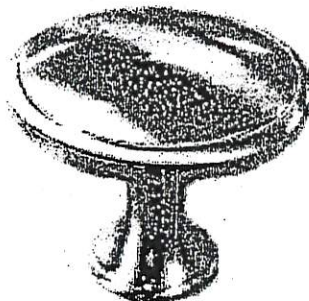


CSI-21



CSI-22

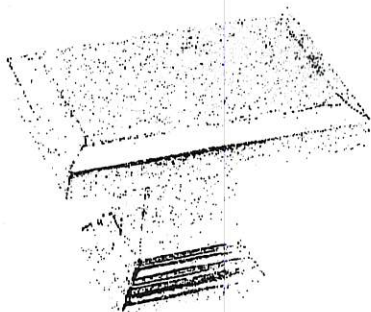


CSI-23

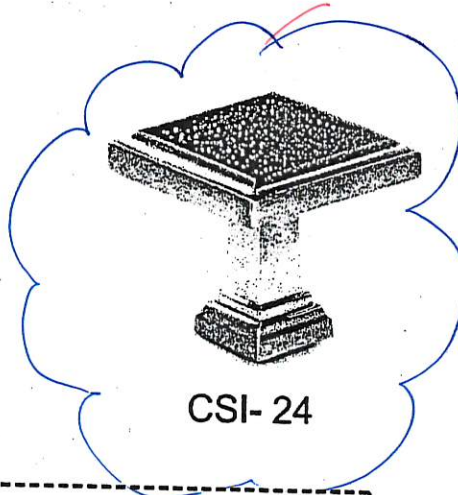

CSI-24


GROUND BATH
+
ENS 4
+
SEMI 3/4

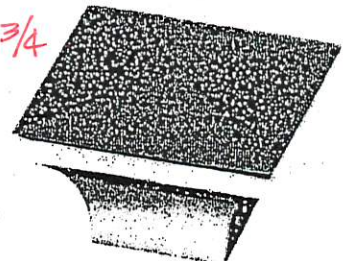


CSI-25

***NOTES:**


- IMAGES ARE FOR QUICK REFERENCE PURPOSES ONLY
- ACTUAL SIZES AND FINISHES AS PER HARDWARE SAMPLE BOARD PROVIDED TO DECOR CENTRE

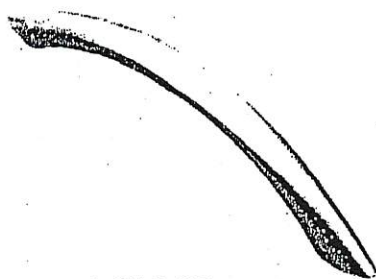


CH-32

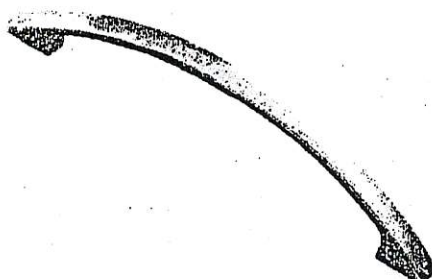


CH-38

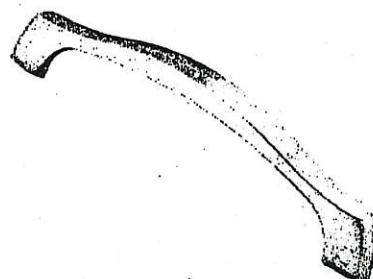


CH-44

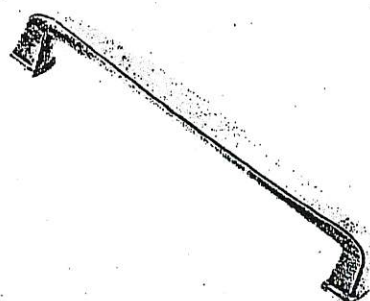


CH-45

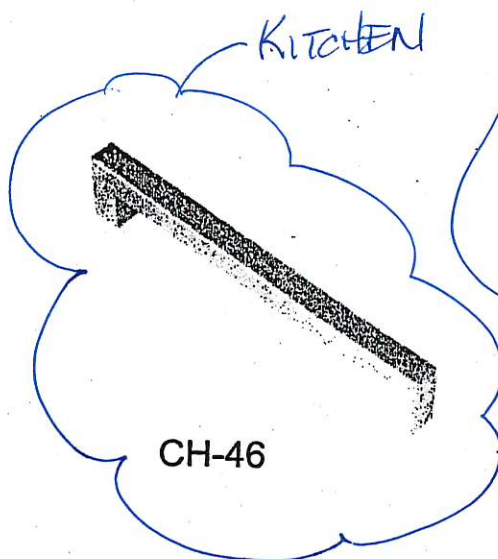


CH-46

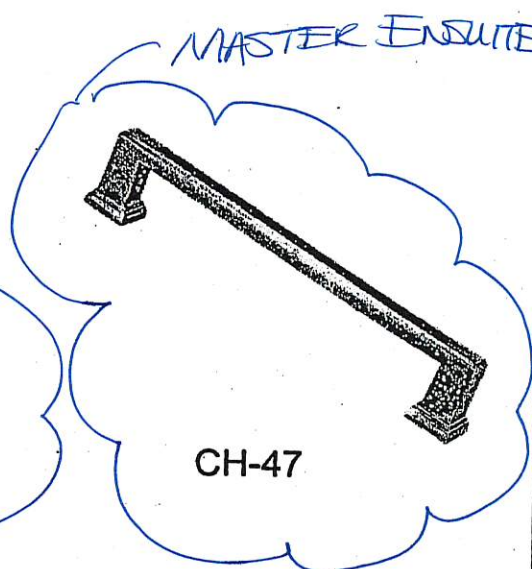


CH-47

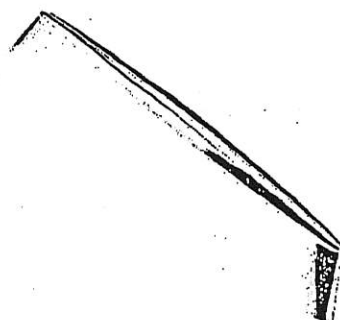


CH-48

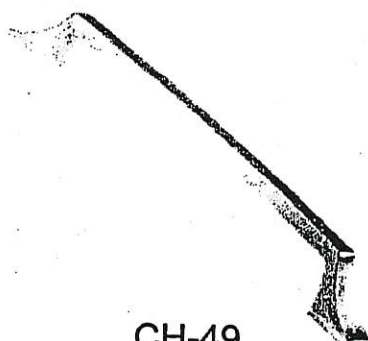


CH-49

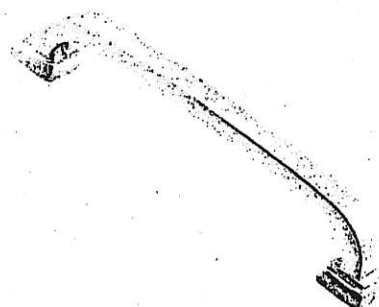


CH-50

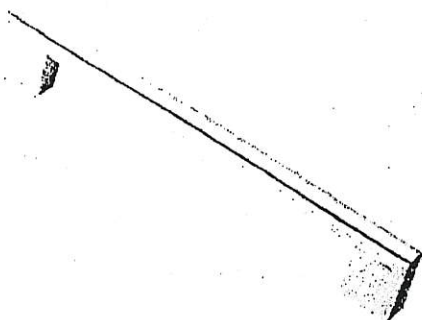

CH-51

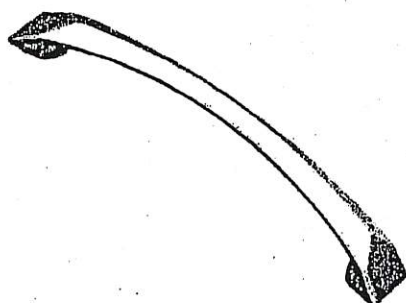

CH-52


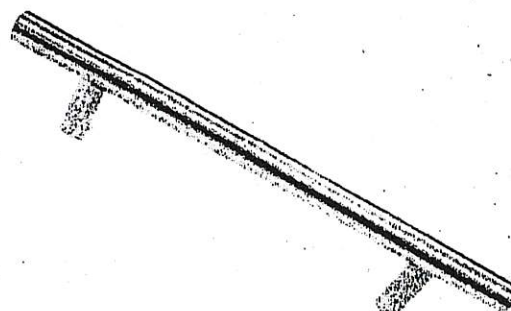


CH-53

***NOTES:**

- IMAGES ARE FOR QUICK REFERENCE PURPOSES ONLY
- ACTUAL SIZES AND FINISHES AS PER HARDWARE SAMPLE BOARD PROVIDED TO DECOR CENTRE


Blanco Quatrus R15U Super Single kitchen sink #401518 (stainless)

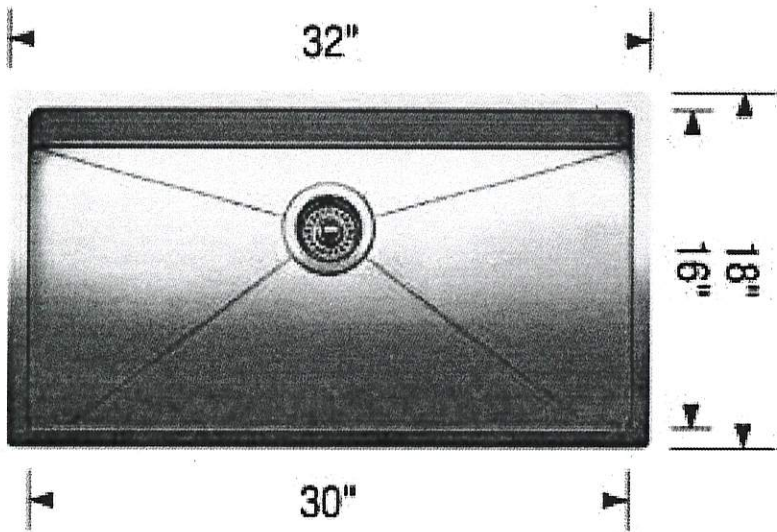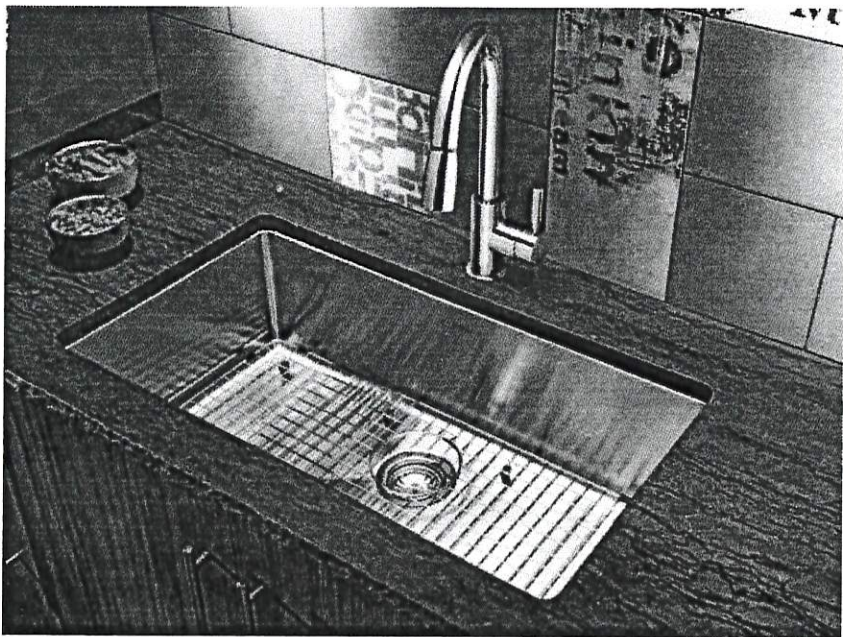

LOT # BE2-08	
ROOM: KITCHEN	SIGNATURE: X M. Townsend
DATE: FEB 14 2019	SIGNATURE: X S. Townsend

Calvin

19 1/4" Oval
4220CFY Undermount Sink

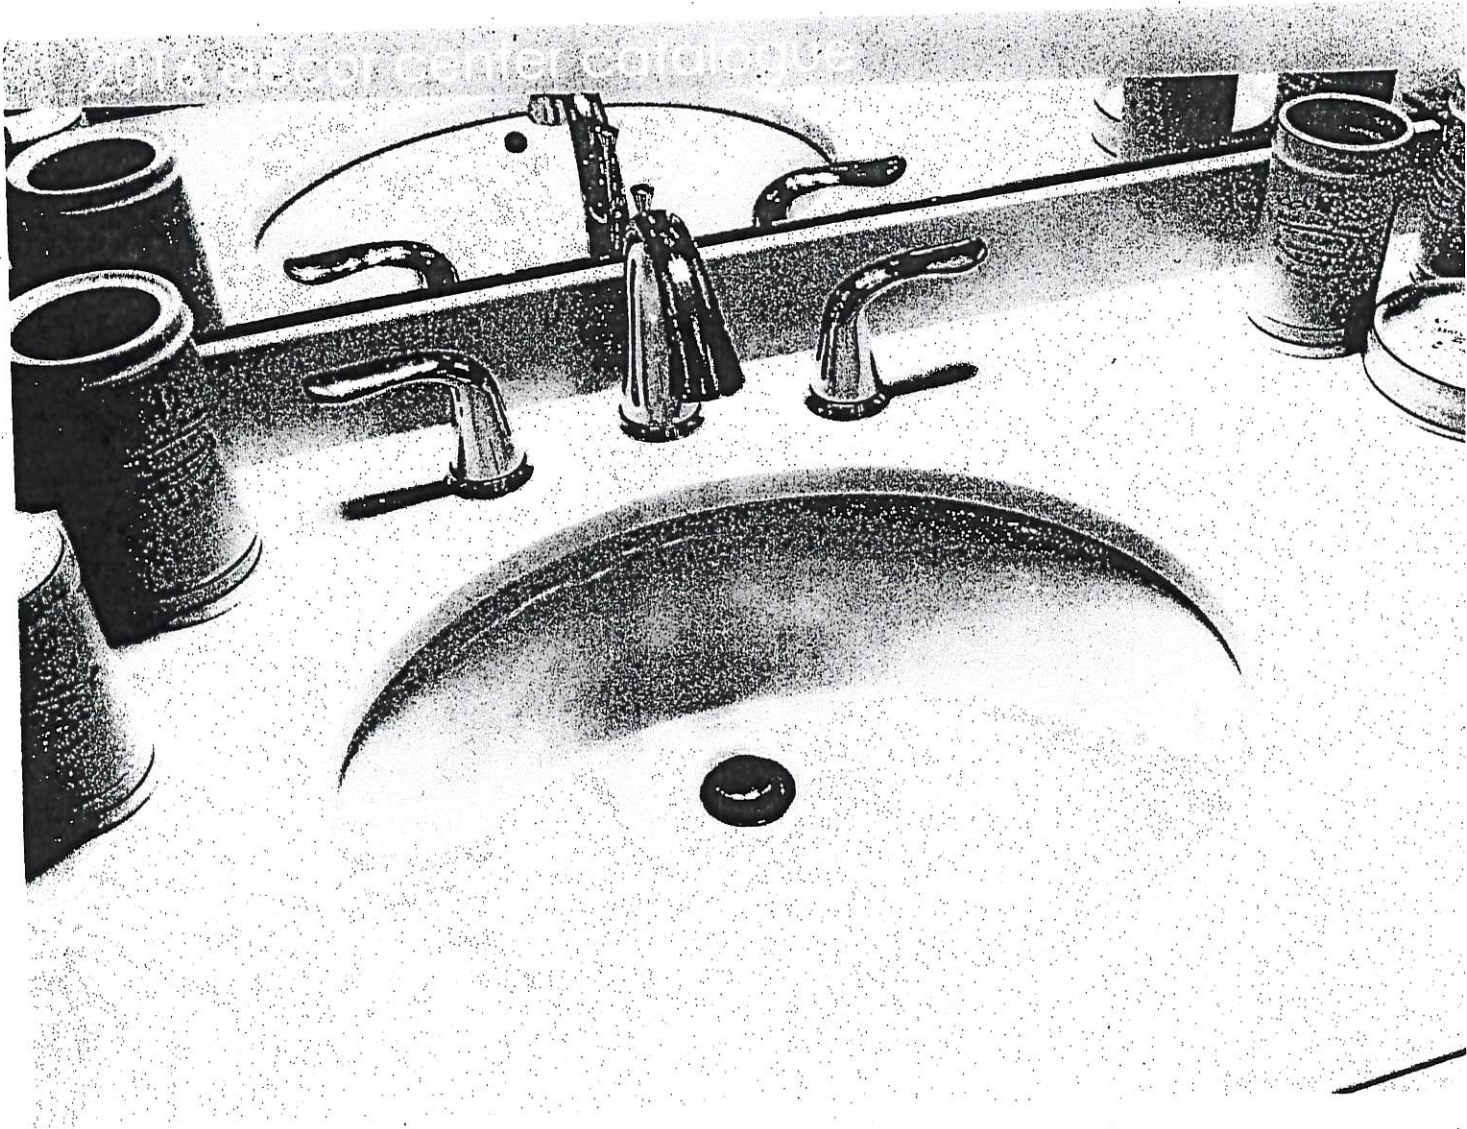

FEATURES

Vitreous china

Front overflow hole

Template and mounting hardware supplied

Overall dimensions (W x D x H):

(OD): 19 1/4" x 16 1/8" x 7 5/8"

(ID): 17" x 13 3/4" x 5 3/4"

CERTIFICATIONS

IAPMO cUPC

ASME A112.19.2 / CSA B45.1-2008


COLOUR

Soft white

LOT #
BE2-98

ROOM: (EXCEPT POWDER) ALL BATHROOMS	SIGNATURE: x M. Townsend
DATE: FEB 14 2019	SIGNATURE: x S. Townsend

PLUMBING UPGRADES

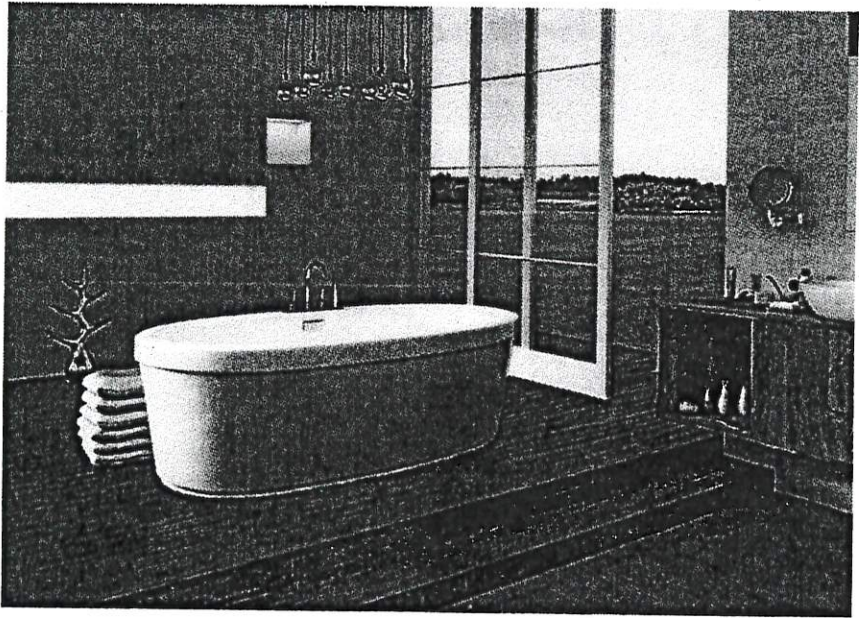

Mirolin Brooke Freestanding Tub
68" x 36"
#CF2002


LOT # BE2-98		
ROOM: MASTER ENSUITE	SIGNATURE: X M Townsend	
DATE: FEB 14 2019	SIGNATURE: X S. Townsend	

GOLDPARK
HOMES




Granite, Marble, Quartz
(Edge Profiles)

20mm (3/4") Profiles

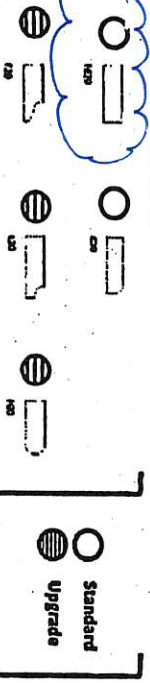


Standard & Upgrade Profiles
Offered with a 2 cm Surface

30mm (1 1/4") Profiles

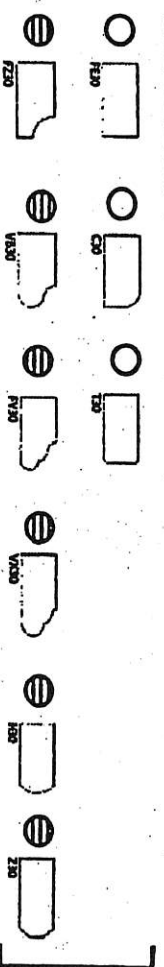

Standard & Upgrade Profiles
Offered with a 3 cm Surface

40mm (1 1/2") Profiles

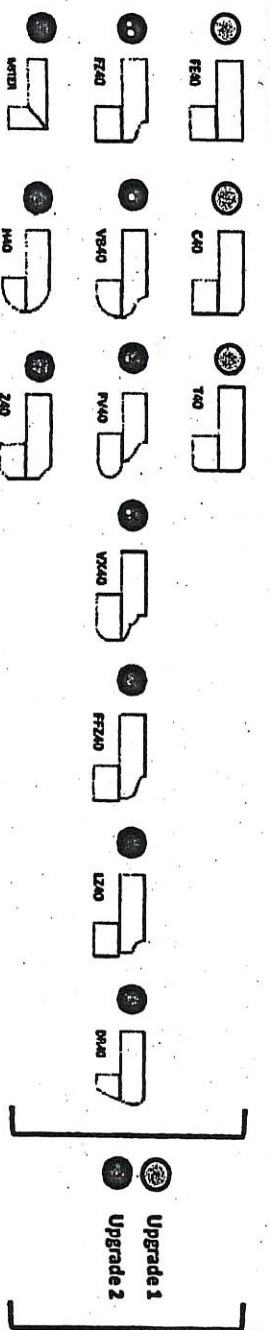

4 mm Upgrade 1 & 2 Profiles
Offered with a 2 cm Surface

Note: All colours may not be available in 30mm at time ordered.
Vendor reserves the right to use 40mm edges (by lamination process).

~~FEB-08~~
FEB 14 2013

XMF X.S.T

* ~~UPGRADED~~ SINKS
Taken Out.

SC(B)500


ALITO COLLECTION

BE2-08


FEB 14 2019

Cyclone®


Innovation by Design - Since 1991

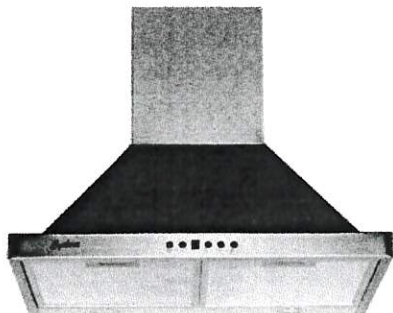

24" Width Model

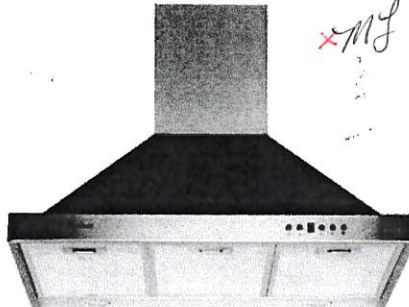

Mesh Filter

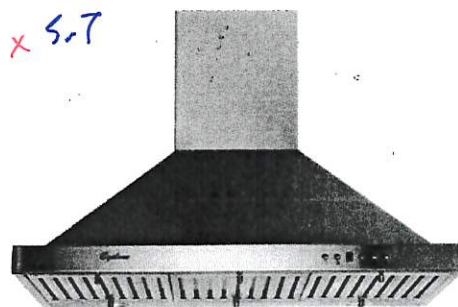

Baffle Filter

Wall Mount

Sometimes strength and beauty can co-exist. Strong and sturdy, yet attractive and unimposing, the SC500 combines the eye-pleasing design of European hoods with the power and efficiency of North American fans. A perfect match. Give your kitchen the look, feel, and capability that you have always wanted. Fitted with time-delay "OFF" options up to nine minutes, bright LED lights spaced for optimum light distribution, and a digital three-speed push button control panel.

Specifications

Air Flow Volume: 550 CFM

Electrical Connection: 120V/60Hz

Electrical Consumption: 200 Watts

Fan Speed: 1599 RPM

Finishes: Stainless Steel

Venting: 6" Round - Top Only

Dimensions: Width: 24"/30"/36"

Height: 46"



Depth: 18"

Sones: Min. 2

Max. 6



SC(B)50024

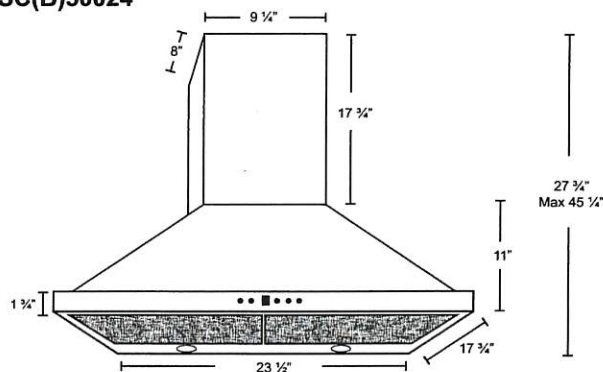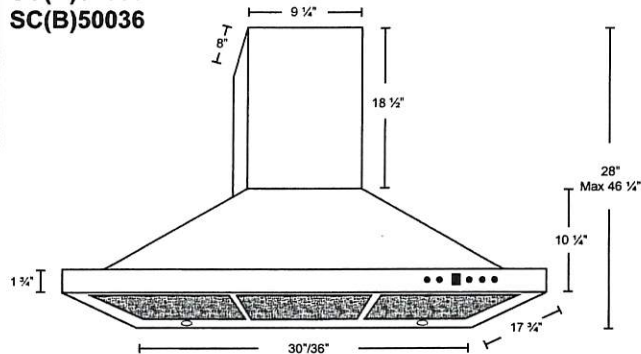SC(B)50030
SC(B)50036

* B in the model name denotes a model with baffle filters.

SC500 - Mesh Filters

SCB500 - Baffle Filters

Model	Colour	Venting	Size
SC(B)50024	Stainless Steel	6"	24"
→ SC(B)50030	Stainless Steel	6"	30" →
SC(B)50036	Stainless Steel	6"	36"