


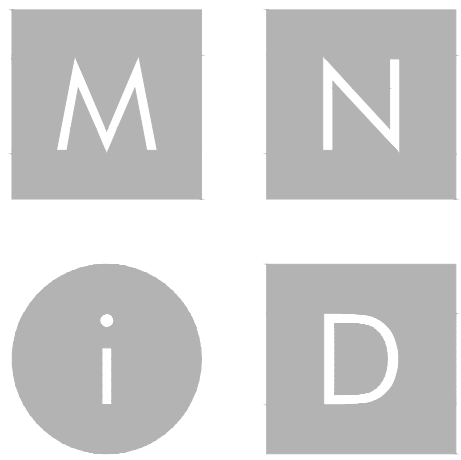

MIKE NIVEN INTERIOR DESIGN INC.
100 BROADVIEW AVE. 5.302 TORONTO, CANADA M4M 3B3
TEL: 416.783.7404 • FAX: 416.783.7404

ISSUED FOR
PLUMBING &
APPLIANCES

No.	Date	Revision	Dwn	Chg
1	18/04/2019	ADJUSTED AS SHOWN	RG	MN
2	15/05/2019	ADJUSTED AS SHOWN	RG	MN

1	15/05/2019	ISSUED FOR PLUMBING & APPLIANCES	RG	MN
1	18/04/2019	ISSUED FOR COORDINATION	RG	MN

No.	Date	Issue	Dwn	Chg
-----	------	-------	-----	-----

NOTE: DO NOT SCALE DRAWINGS
It is the contractor's responsibility to verify all specifications and dimensions and report any discrepancies to the designer prior to construction. Materials may not be substituted without designer's written approval.



PROJECT:
PINEVALLEY
OAK GROVE, LOT 91

GOLDPARK HOMES
CONCORD, ON



DRAWINGS:

PARTITION PLAN

DESIGNER'S:
MIKE NIVEN

DRAWN BY:
M-Tec Inc.

DATE:
FEB 2019


SCALE:
1:50

PROJECT NO:
2018-10

ID
0.0.0

INDEX


ID0.0.0	COVER SHEET AND INDEX	ID2.0.0	-	ID3.0.0	DETAILS
ID1.0.0	BASEMENT PARTITION PLAN				
ID1.0.1	BASEMENT REFLECTIVE CEILING PLAN				
ID1.1.0	FIRST AND SECOND FLOOR PARTITION PLAN				
ID1.1.1	FIRST AND SECOND FLOOR REFLECTIVE CEILING PLAN				

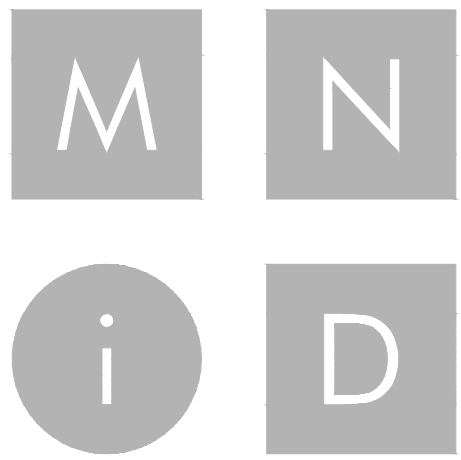

MIKE NIVEN INTERIOR DESIGN INC.
100 BROADVIEW AVE. S. 3RD FLOOR, TORONTO, CANADA M4M 3B3
TEL: 416.783.7404 • FAX: 416.783.7404

ISSUED FOR
PLUMBING &
APPLIANCES

No.	Date	Revision	Dwn	Chg
1	18/04/2019	ADJUSTED AS SHOWN	RG	MN
2	15/05/2019	ADJUSTED AS SHOWN	RG	MN

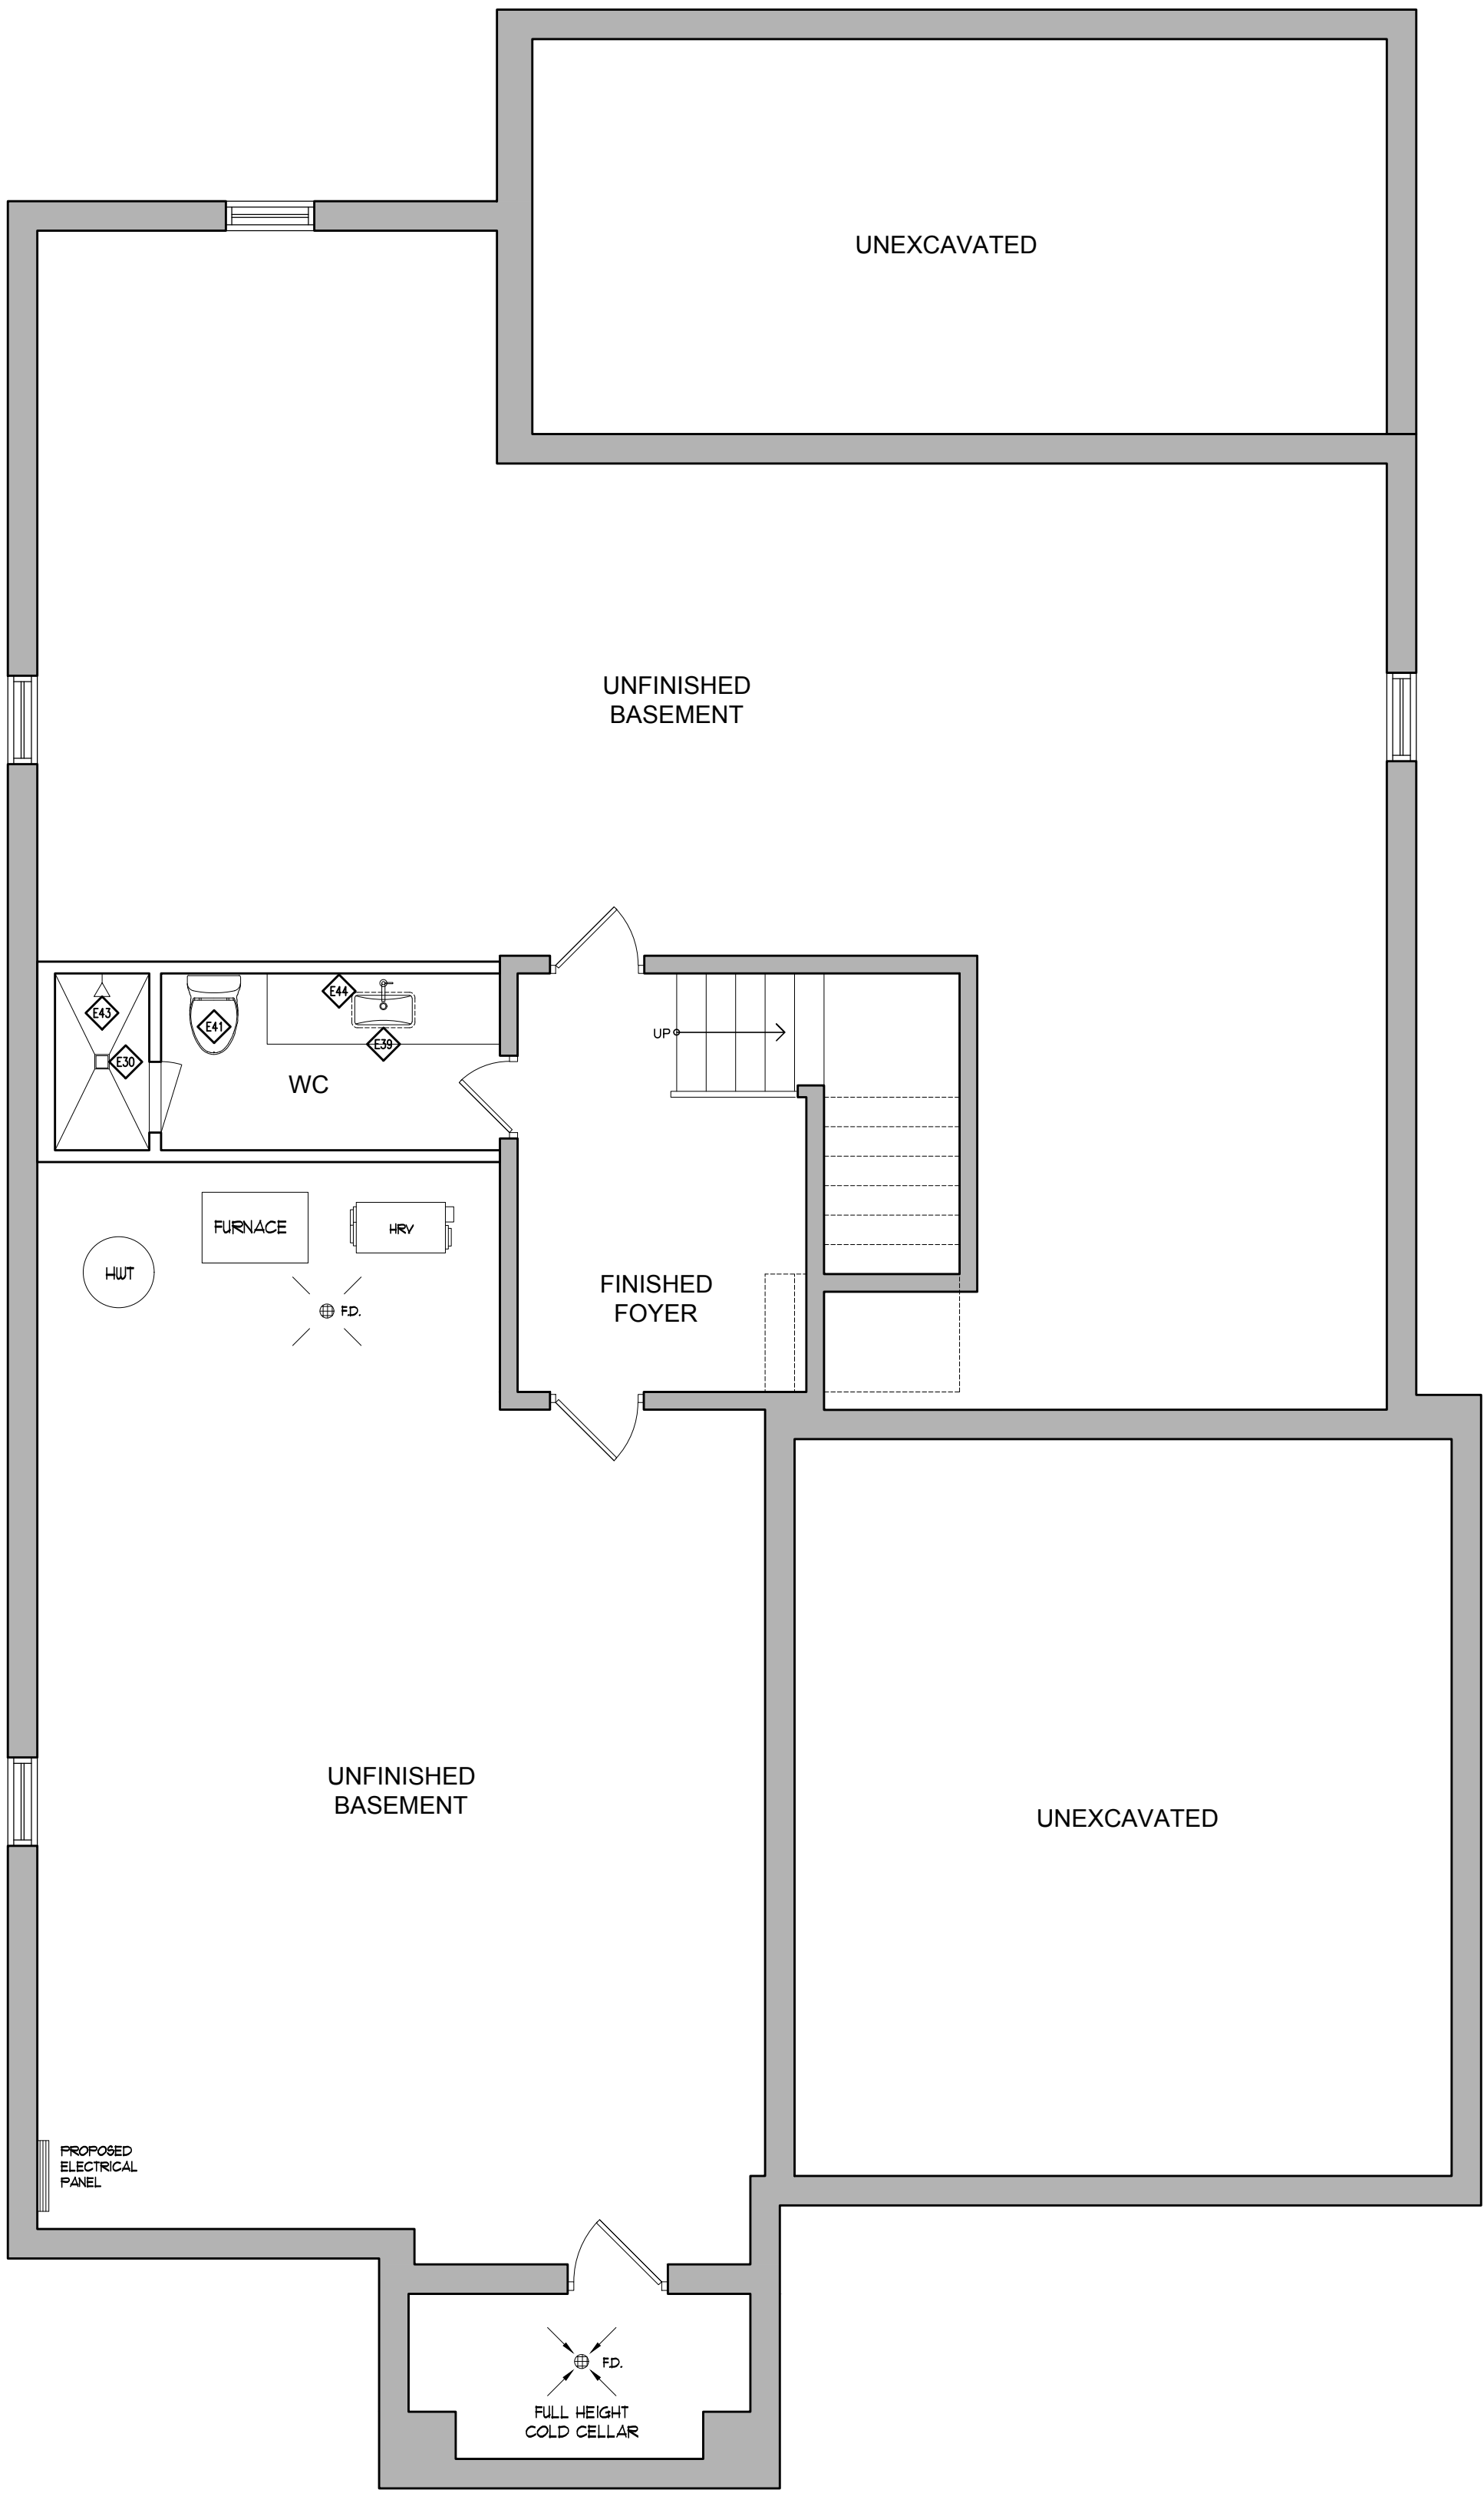

BASEMENT FLOOR
PARTITION PLAN
1
01.0.0 SCALE: 1:50

1	15/05/2019	ISSUED FOR PLUMBING & APPLIANCES	RG	MN
1	18/04/2019	ISSUED FOR COORDINATION	RG	MN

No.	Date	Issue	Dwn	Chg
-----	------	-------	-----	-----

NOTE: DO NOT SCALE DRAWINGS
It is the contractor's responsibility to verify all specifications and dimensions and report any discrepancies to the designer prior to construction. Materials may not be substituted without designer's written approval.



PROJECT:
PINEVALLEY
OAKGROVE, LOT 91

GOLDPARK HOMES
CONCORD, ON



DRAWING:

PARTITION PLAN

DESIGNER'S:

MIKE NIVEN

DRAWN BY:

M-Tec Inc.

DATE:

FEB 2019


SCALE:

1:50

PROJECT NO:

2018-10


ID
1.0.0

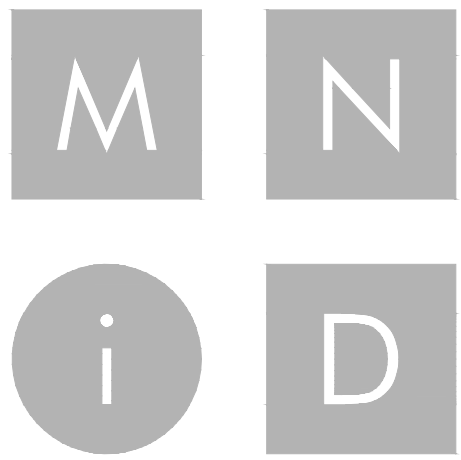

MIKE NIVEN INTERIOR DESIGN INC.
100 BROADVIEW AVE. 5.302 TORONTO, CANADA M4M 3B3
TEL: 416.783.7404 • FAX: 416.783.7404

ISSUED FOR
PLUMBING &
APPLIANCES

No.	Date	Revision	Dwn	Chg
1	18/04/2019	ADJUSTED AS SHOWN	RG	MN
2	15/05/2019	ADJUSTED AS SHOWN	RG	MN

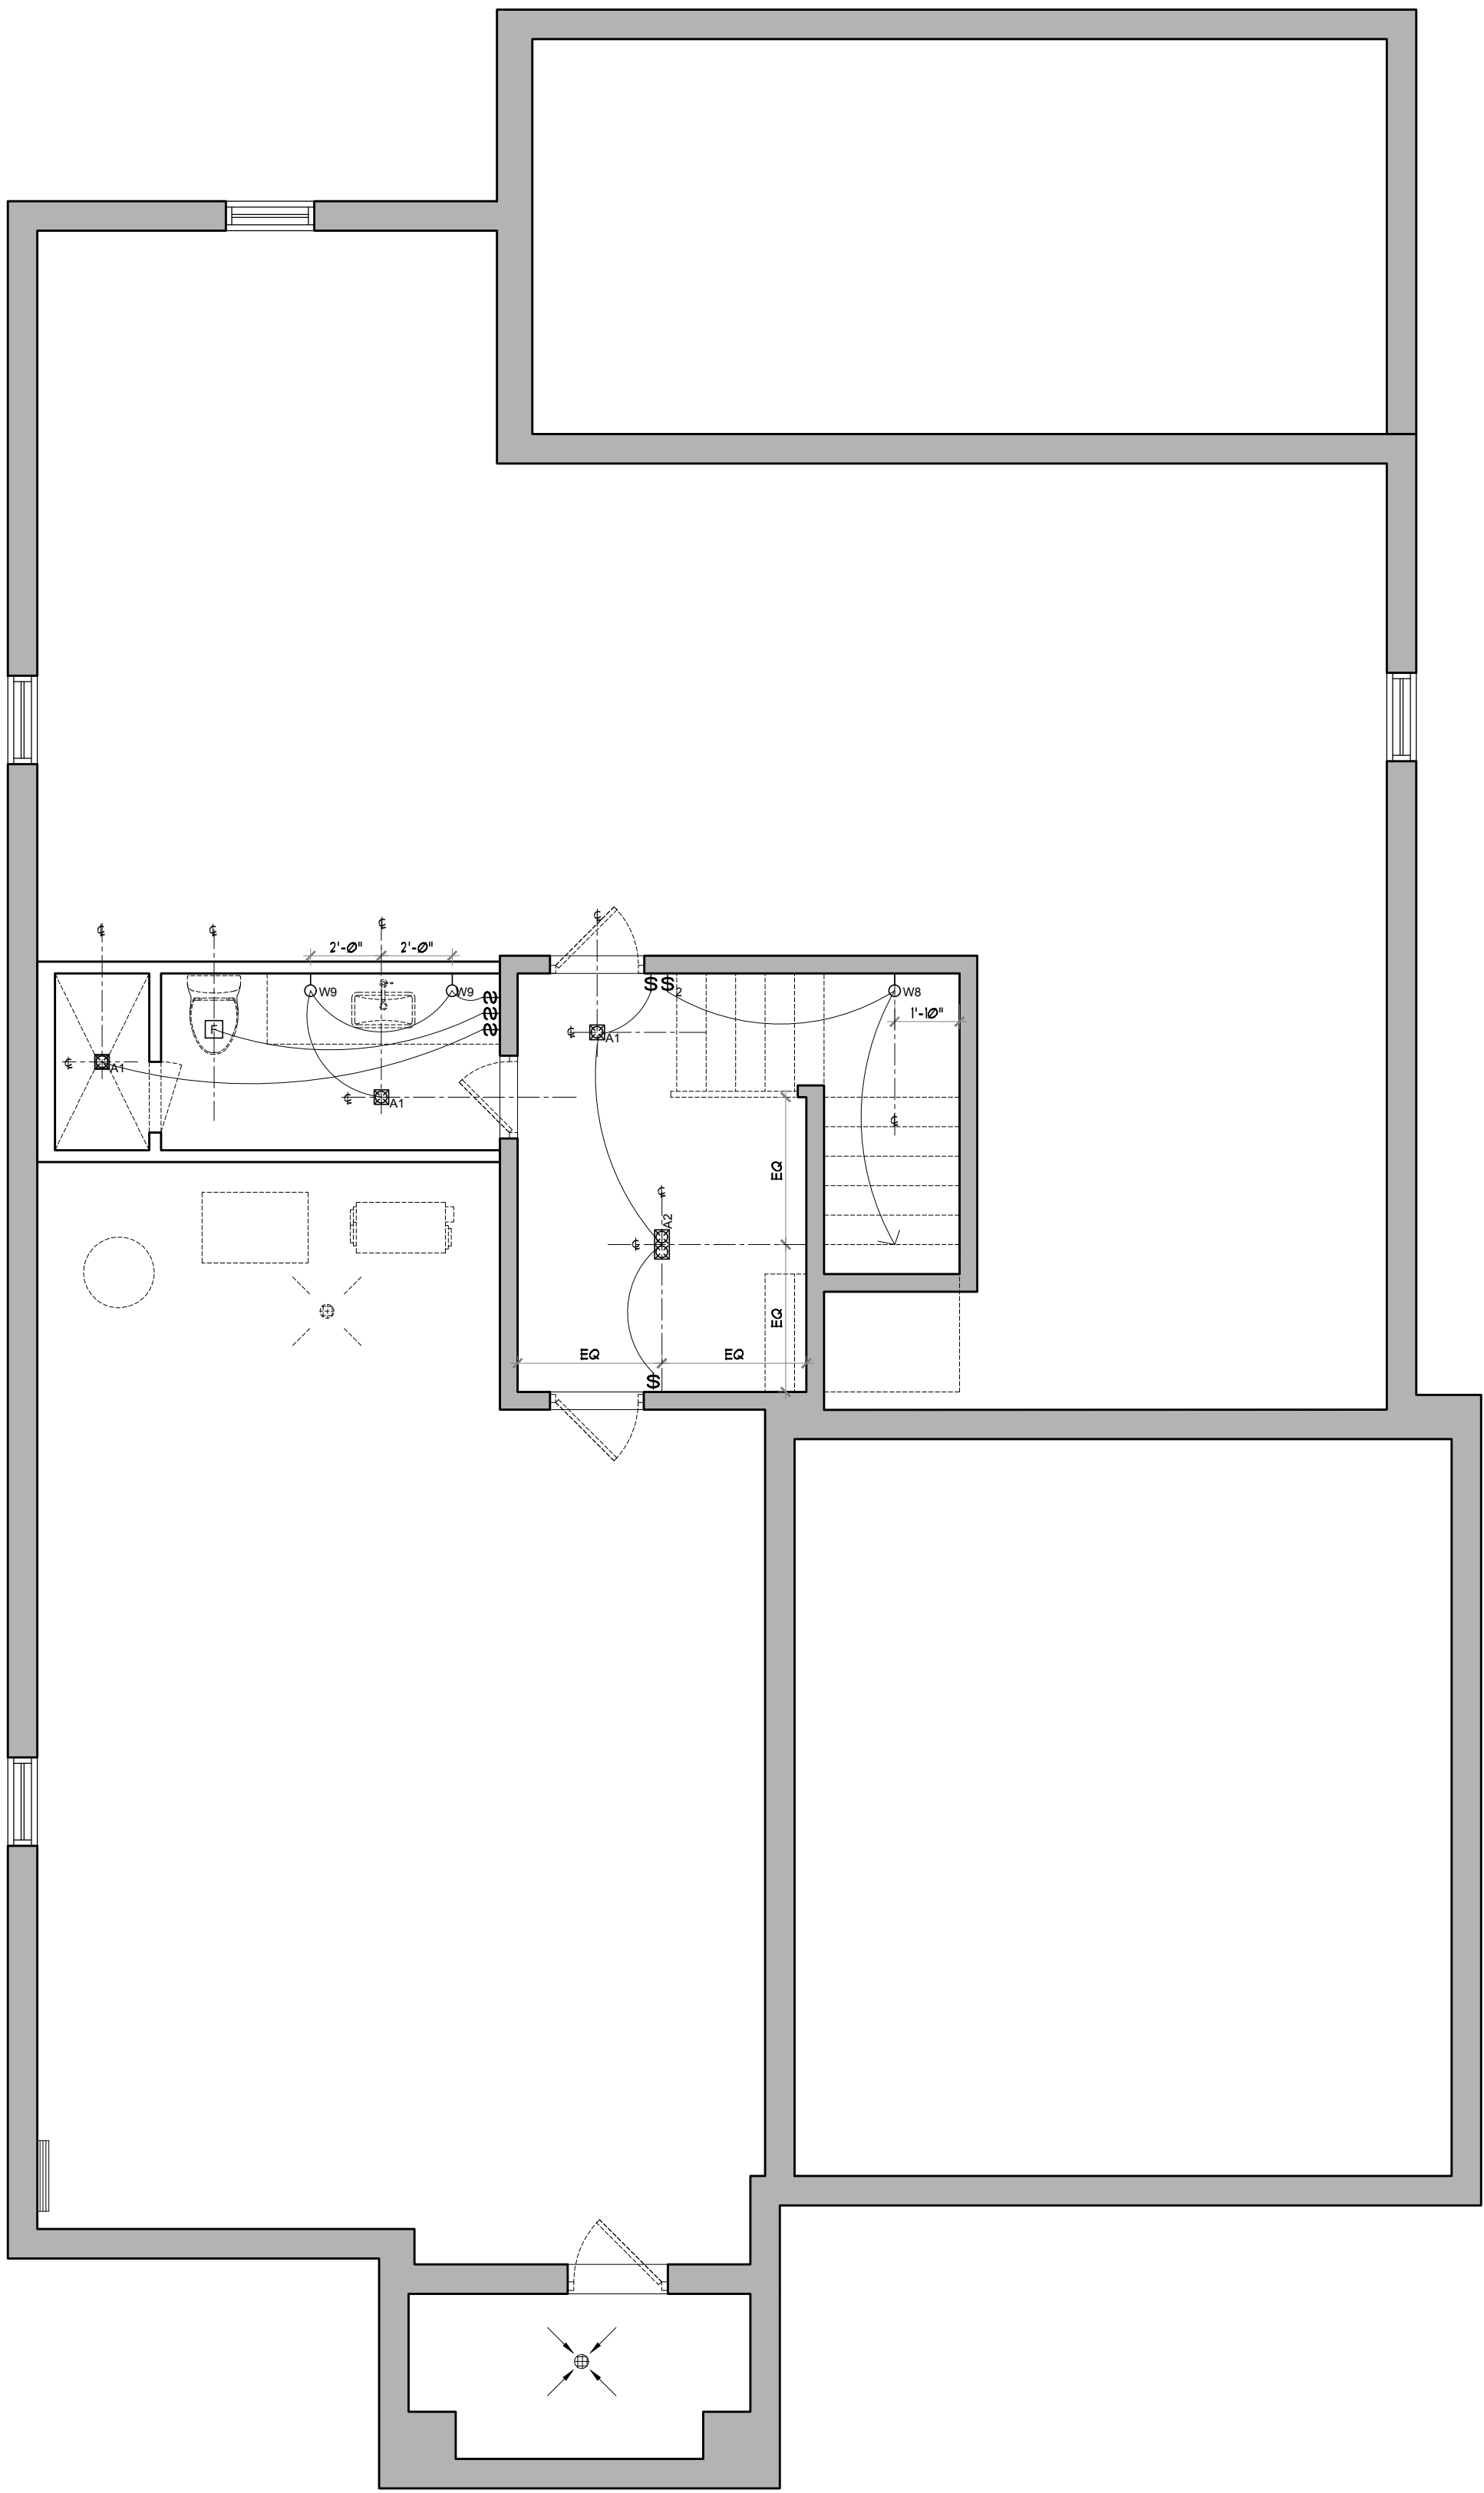

BASEMENT FLOOR
REFLECTIVE CEILING PLAN
1
Ø10' SCALE: 1/32

1	15/05/2019	ISSUED FOR PLUMBING & APPLIANCES	RG	MN
1	18/04/2019	ISSUED FOR COORDINATION	RG	MN

No.	Date	Issue	Dwn	Chg
-----	------	-------	-----	-----

NOTE: DO NOT SCALE DRAWINGS
It is the contractor's responsibility to verify all specifications and dimensions and report any discrepancies to the designer prior to construction. Materials may not be substituted without designer's written approval.



PROJECT:
PINEVALLEY
OAKGROVE, LOT 91
GOLDPARK HOMES
CONCORD, ON



DRAWING:

REFLECTIVE CEILING PLAN

DESIGNER'S:

MIKE NIVEN

DRAWN BY:

M-Tec Inc.

DATE:

FEB 2019


SCALE:

1:50

PROJECT NO:

2018-10


ID
1.0.1

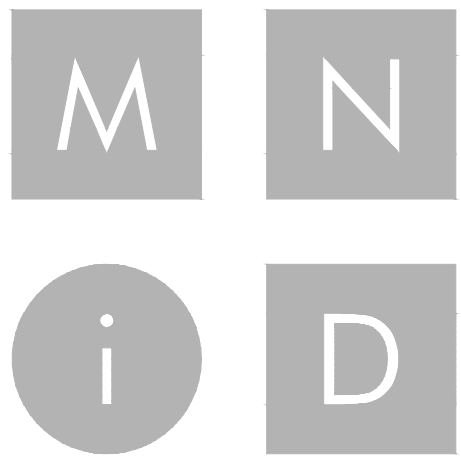

MIKE NIVEN INTERIOR DESIGN INC.
100 BROADVIEW AVE. 5.302 TORONTO, CANADA M4M 3B3
TEL: 416.783.7404 • FAX: 416.783.7404

ISSUED FOR
PLUMBING &
APPLIANCES

No.	Date	Revision	Dwn	Chg
1	18/04/2019	ADJUSTED AS SHOWN	RG	MN
2	15/05/2019	ADJUSTED AS SHOWN	RG	MN

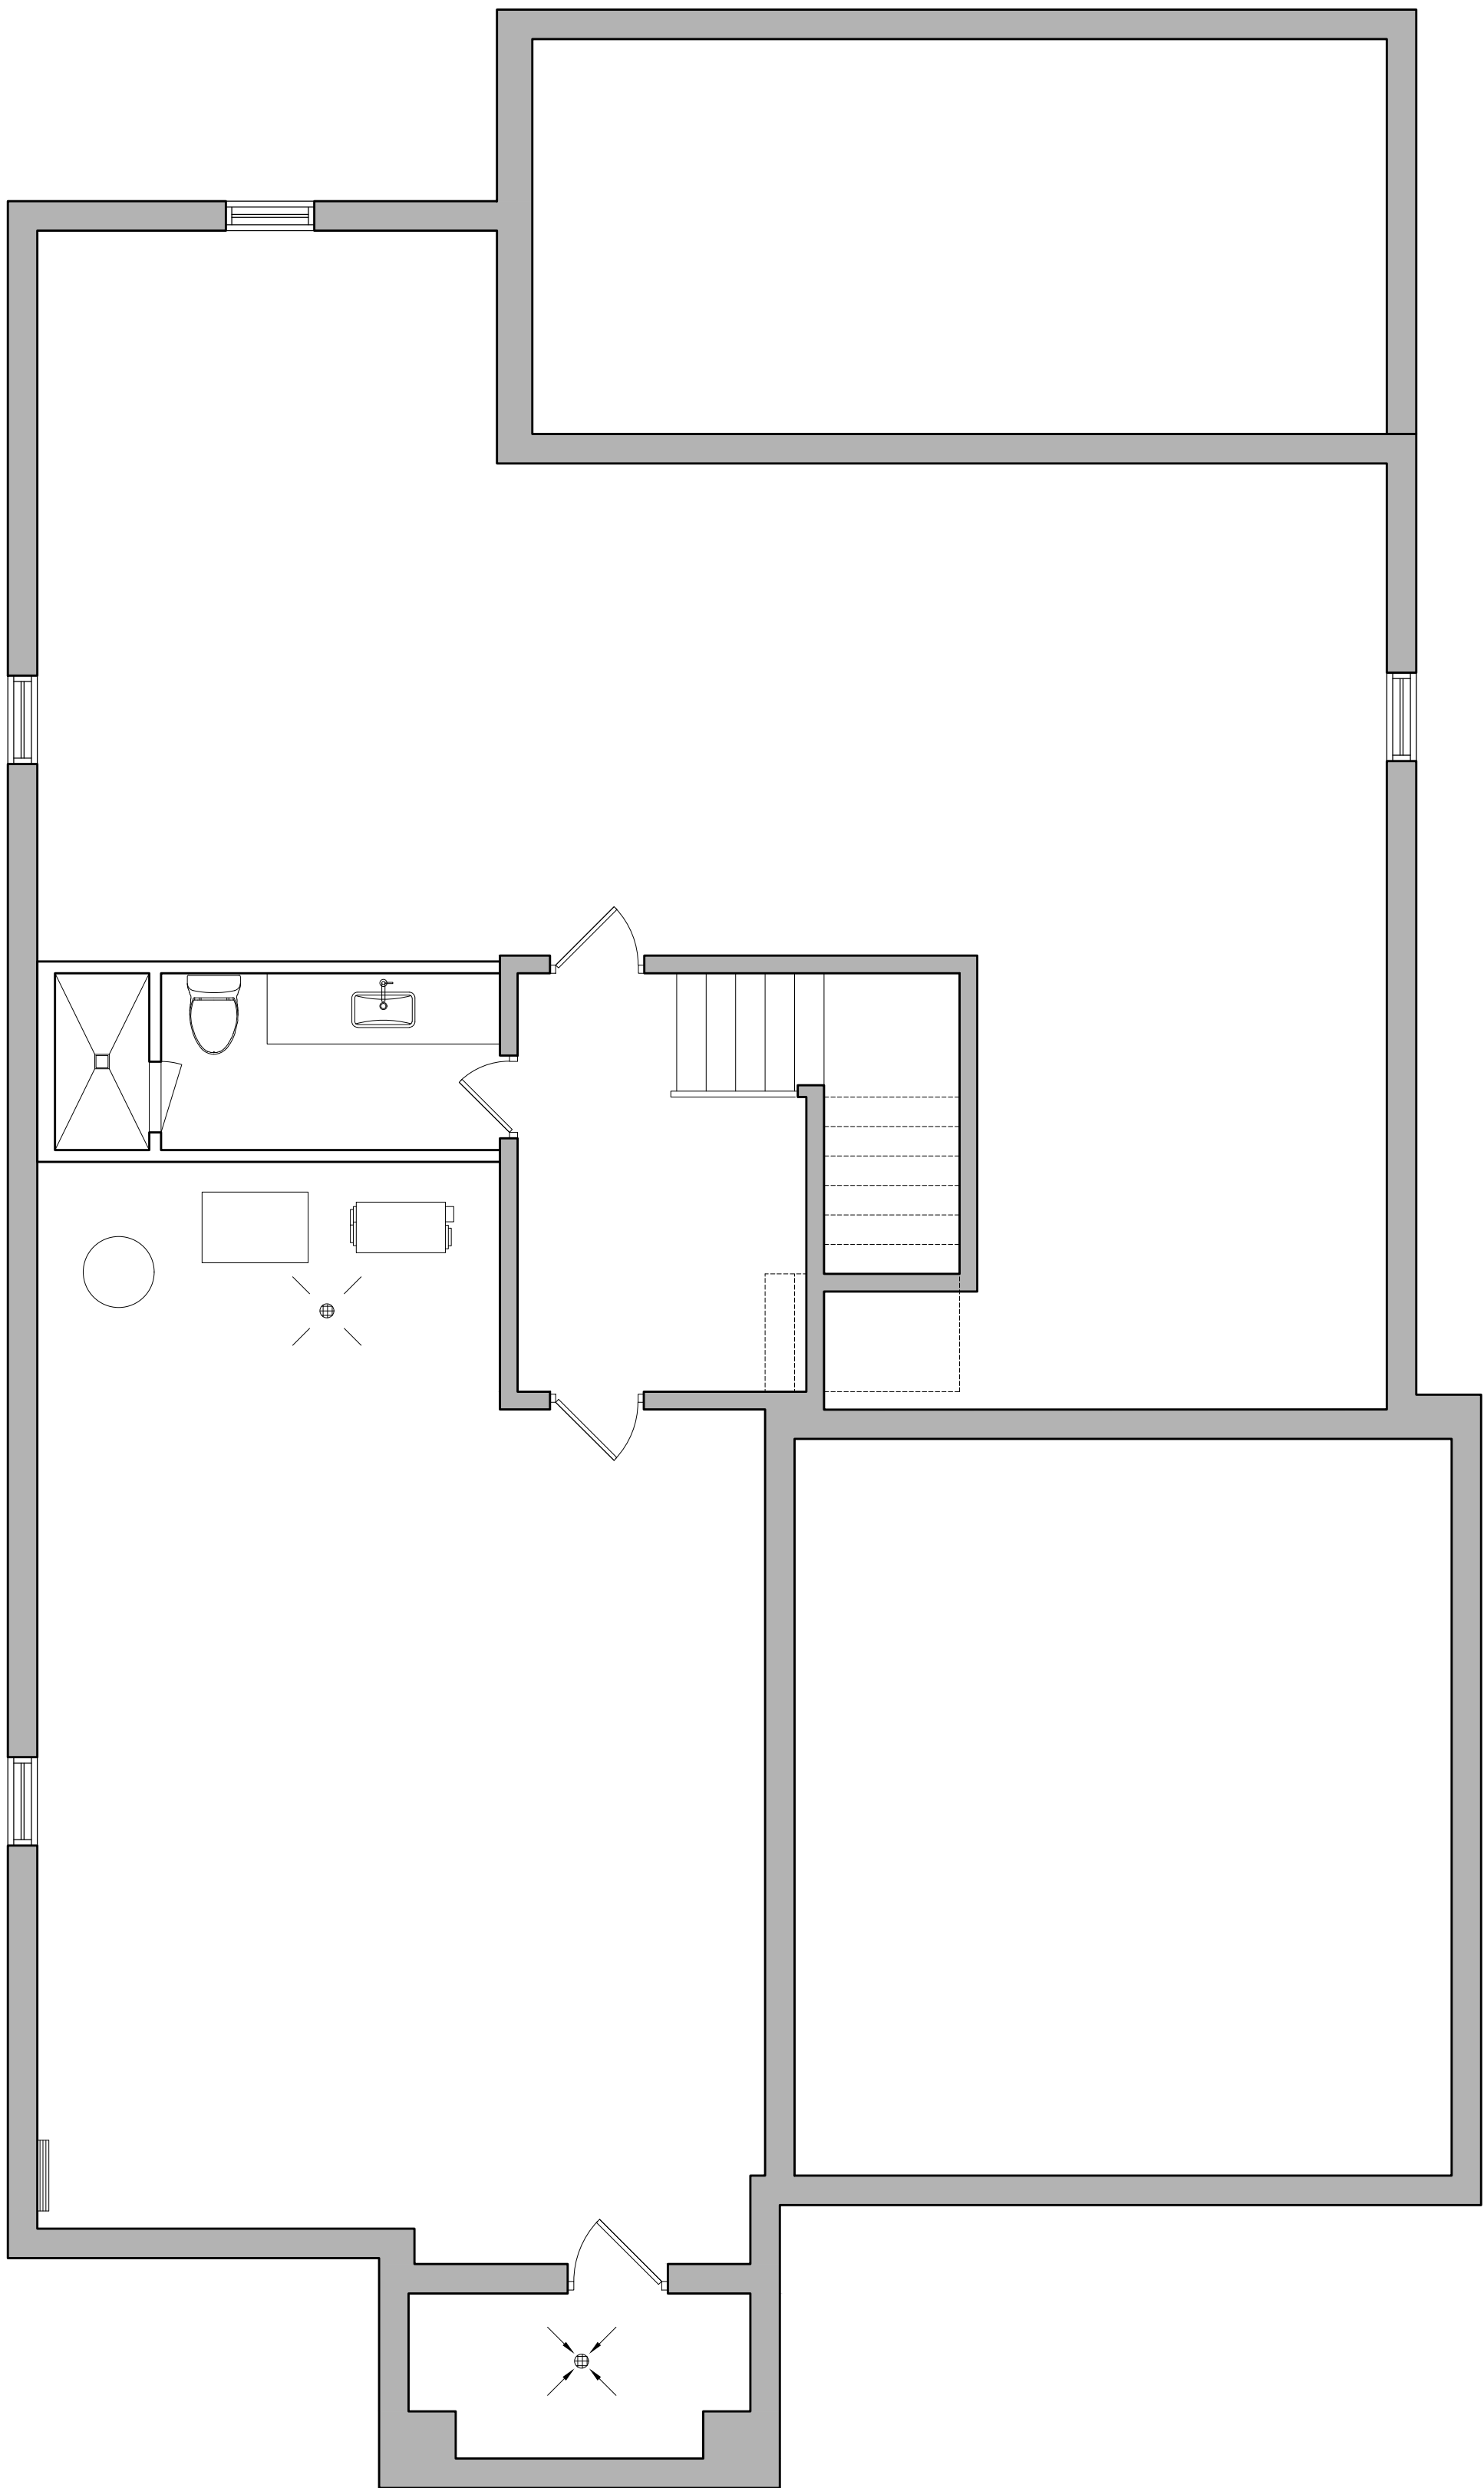

BASEMENT FLOOR
FINISHES PLAN
SCALE: 1:50

1	15/05/2019	ISSUED FOR PLUMBING & APPLIANCES	RG	MN
1	18/04/2019	ISSUED FOR COORDINATION	RG	MN

No.	Date	Issue	Dwn	Chg
-----	------	-------	-----	-----

NOTE: DO NOT SCALE DRAWINGS
It is the contractor's responsibility to verify all specifications and dimensions and report any discrepancies to the designer prior to construction. Materials may not be substituted without designer's written approval.



PROJECT:
PINEVALLEY
OAKGROVE, LOT 91
GOLDPARK HOMES
CONCORD, ON



DRAWING:

FINISHES PLAN

DESIGNER'S:

MIKE NIVEN

DRAWN BY:

M-Tec Inc.

DATE:

FEB 2019


SCALE:

1:50

PROJECT NO:

2018-10


ID
1.0.2

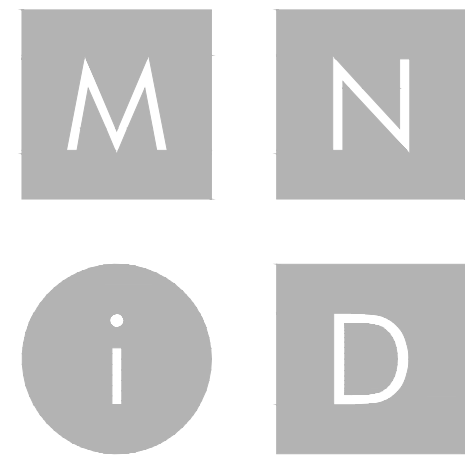


MIKE NIVEN INTERIOR DESIGN INC.
100 BROADVIEW AVE. S. 3RD FLOOR, TORONTO, ONT. M4M 3B3
TEL: 416.783.7404 • FAX: 416.783.7404

ISSUED FOR
PLUMBING &
APPLIANCES

No.	Date	Revision	Drawn	CHK
1	18/04/2019	ADJUSTED AS SHOWN	RG	MM
2	15/05/2019	ADJUSTED AS SHOWN	RG	MM

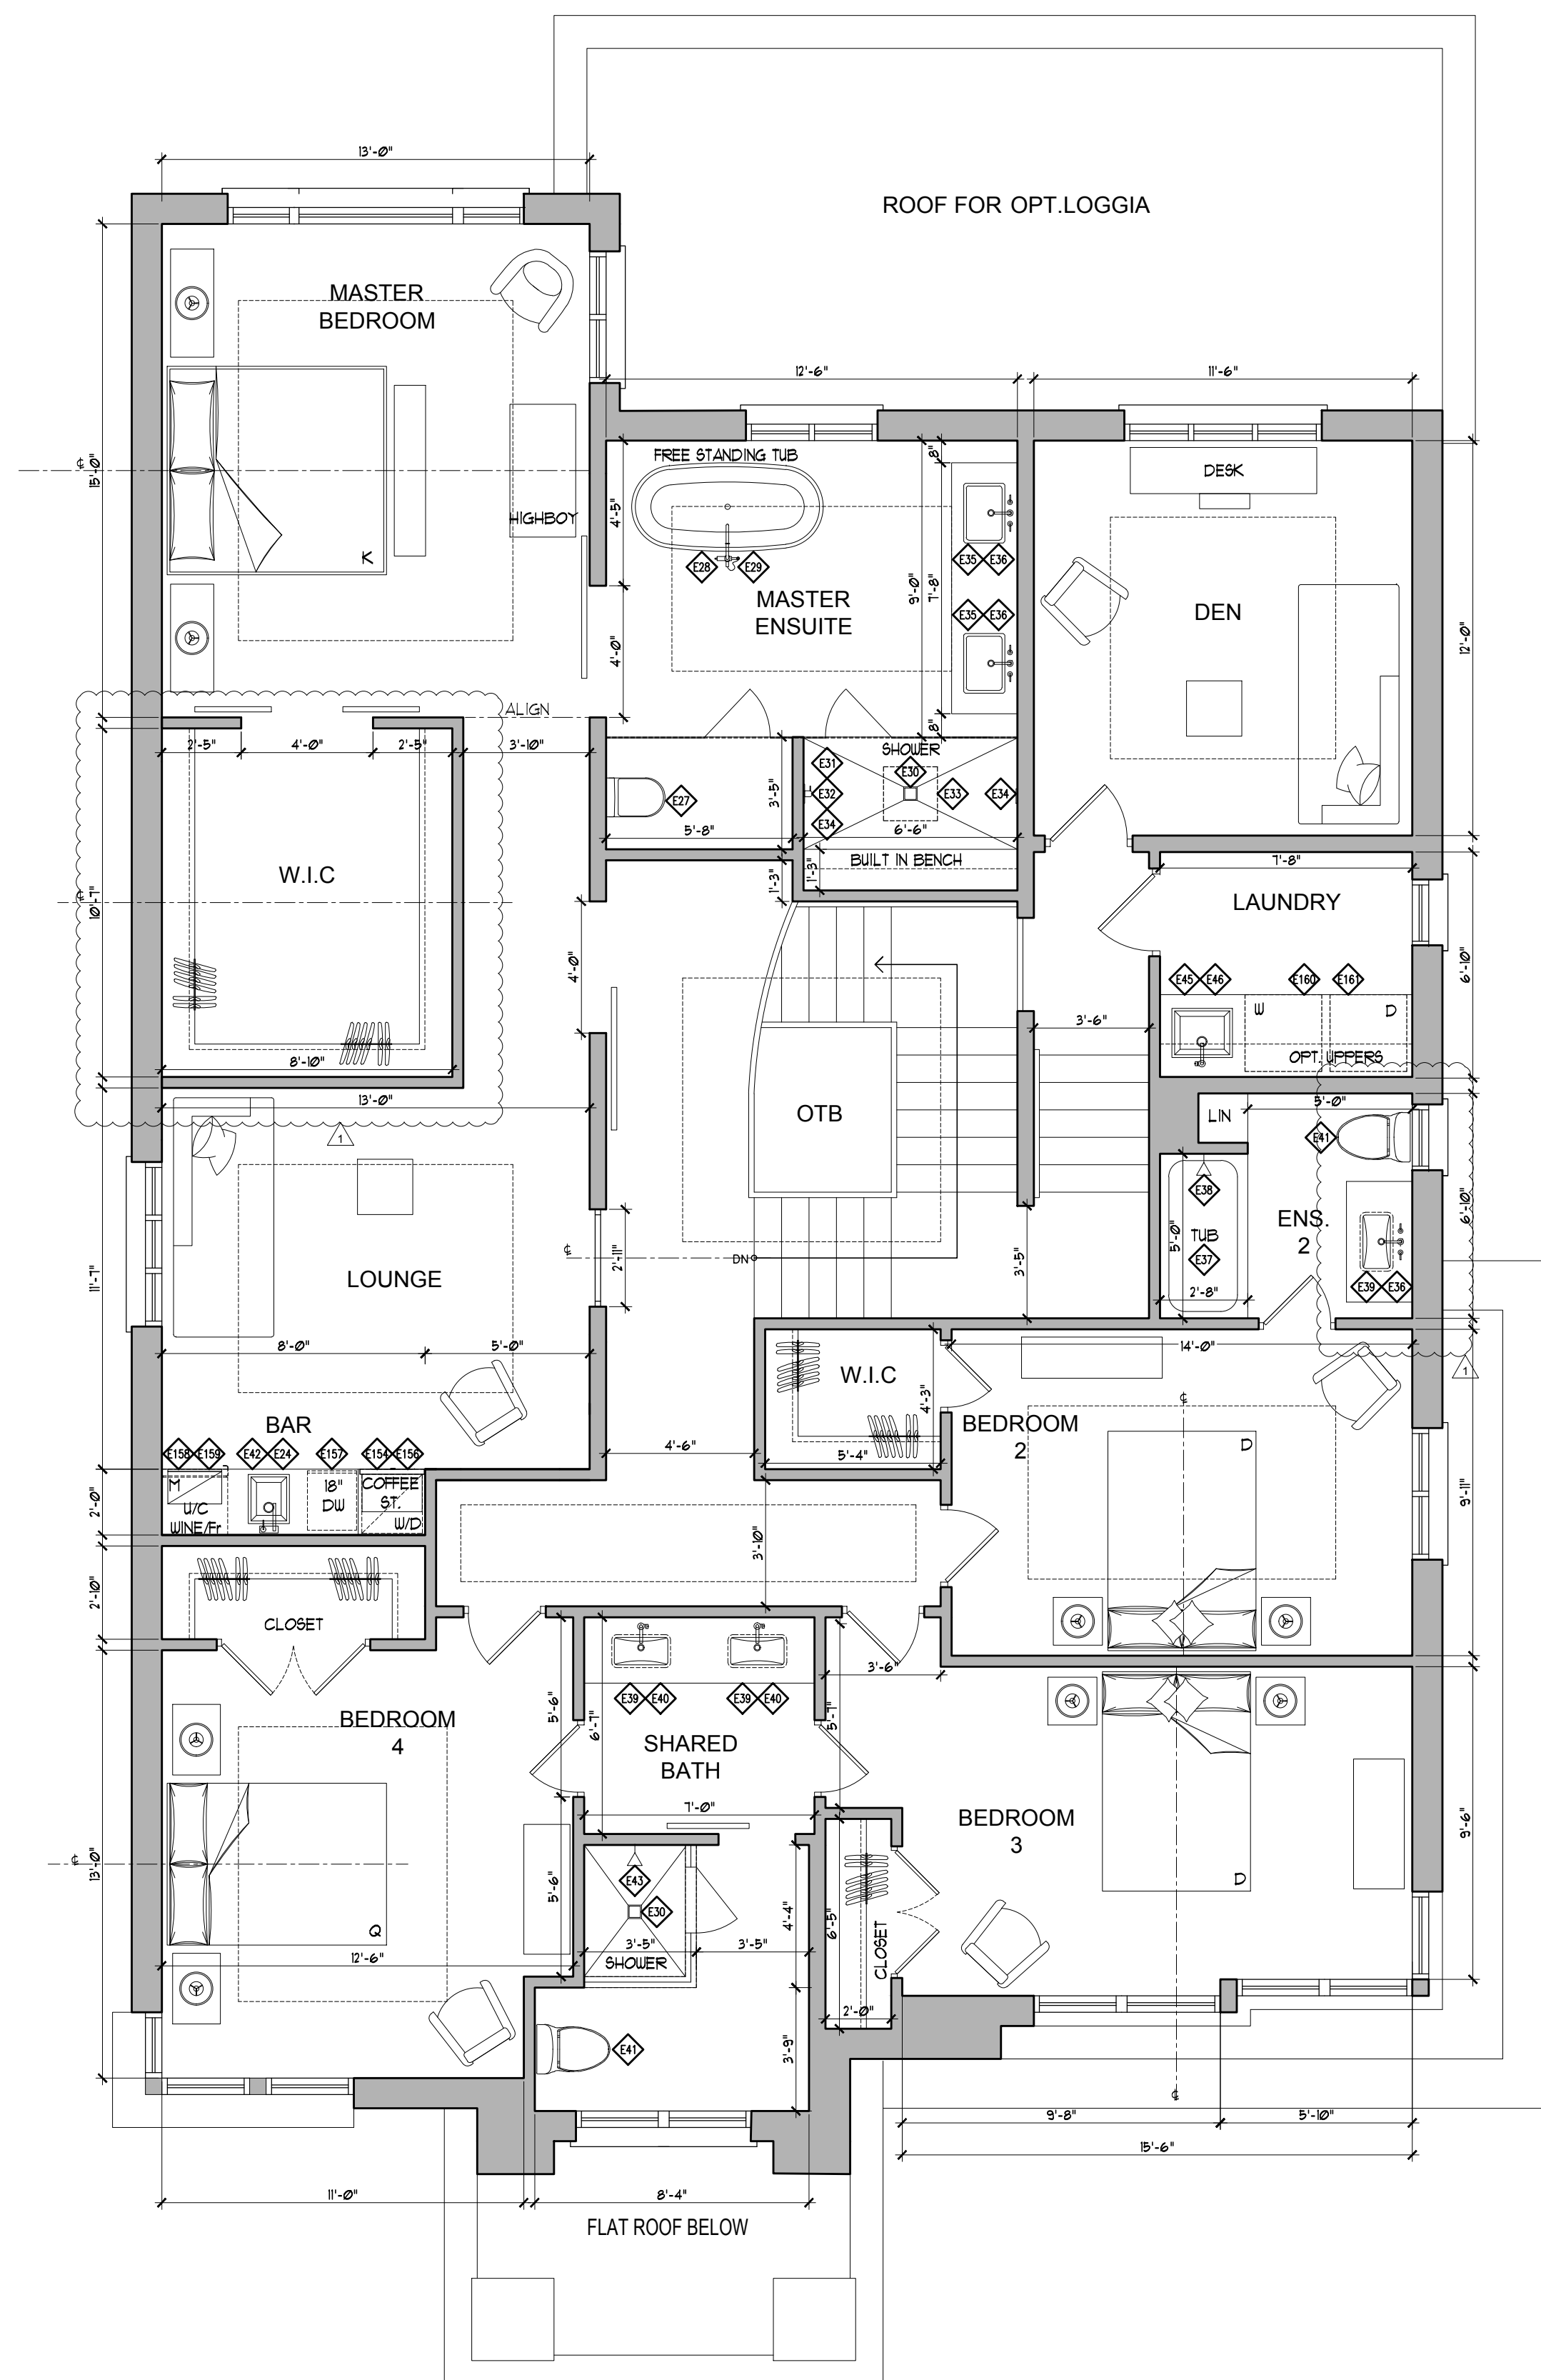

2 SECOND FLOOR
PARTITION PLAN
SCALE: 1:50

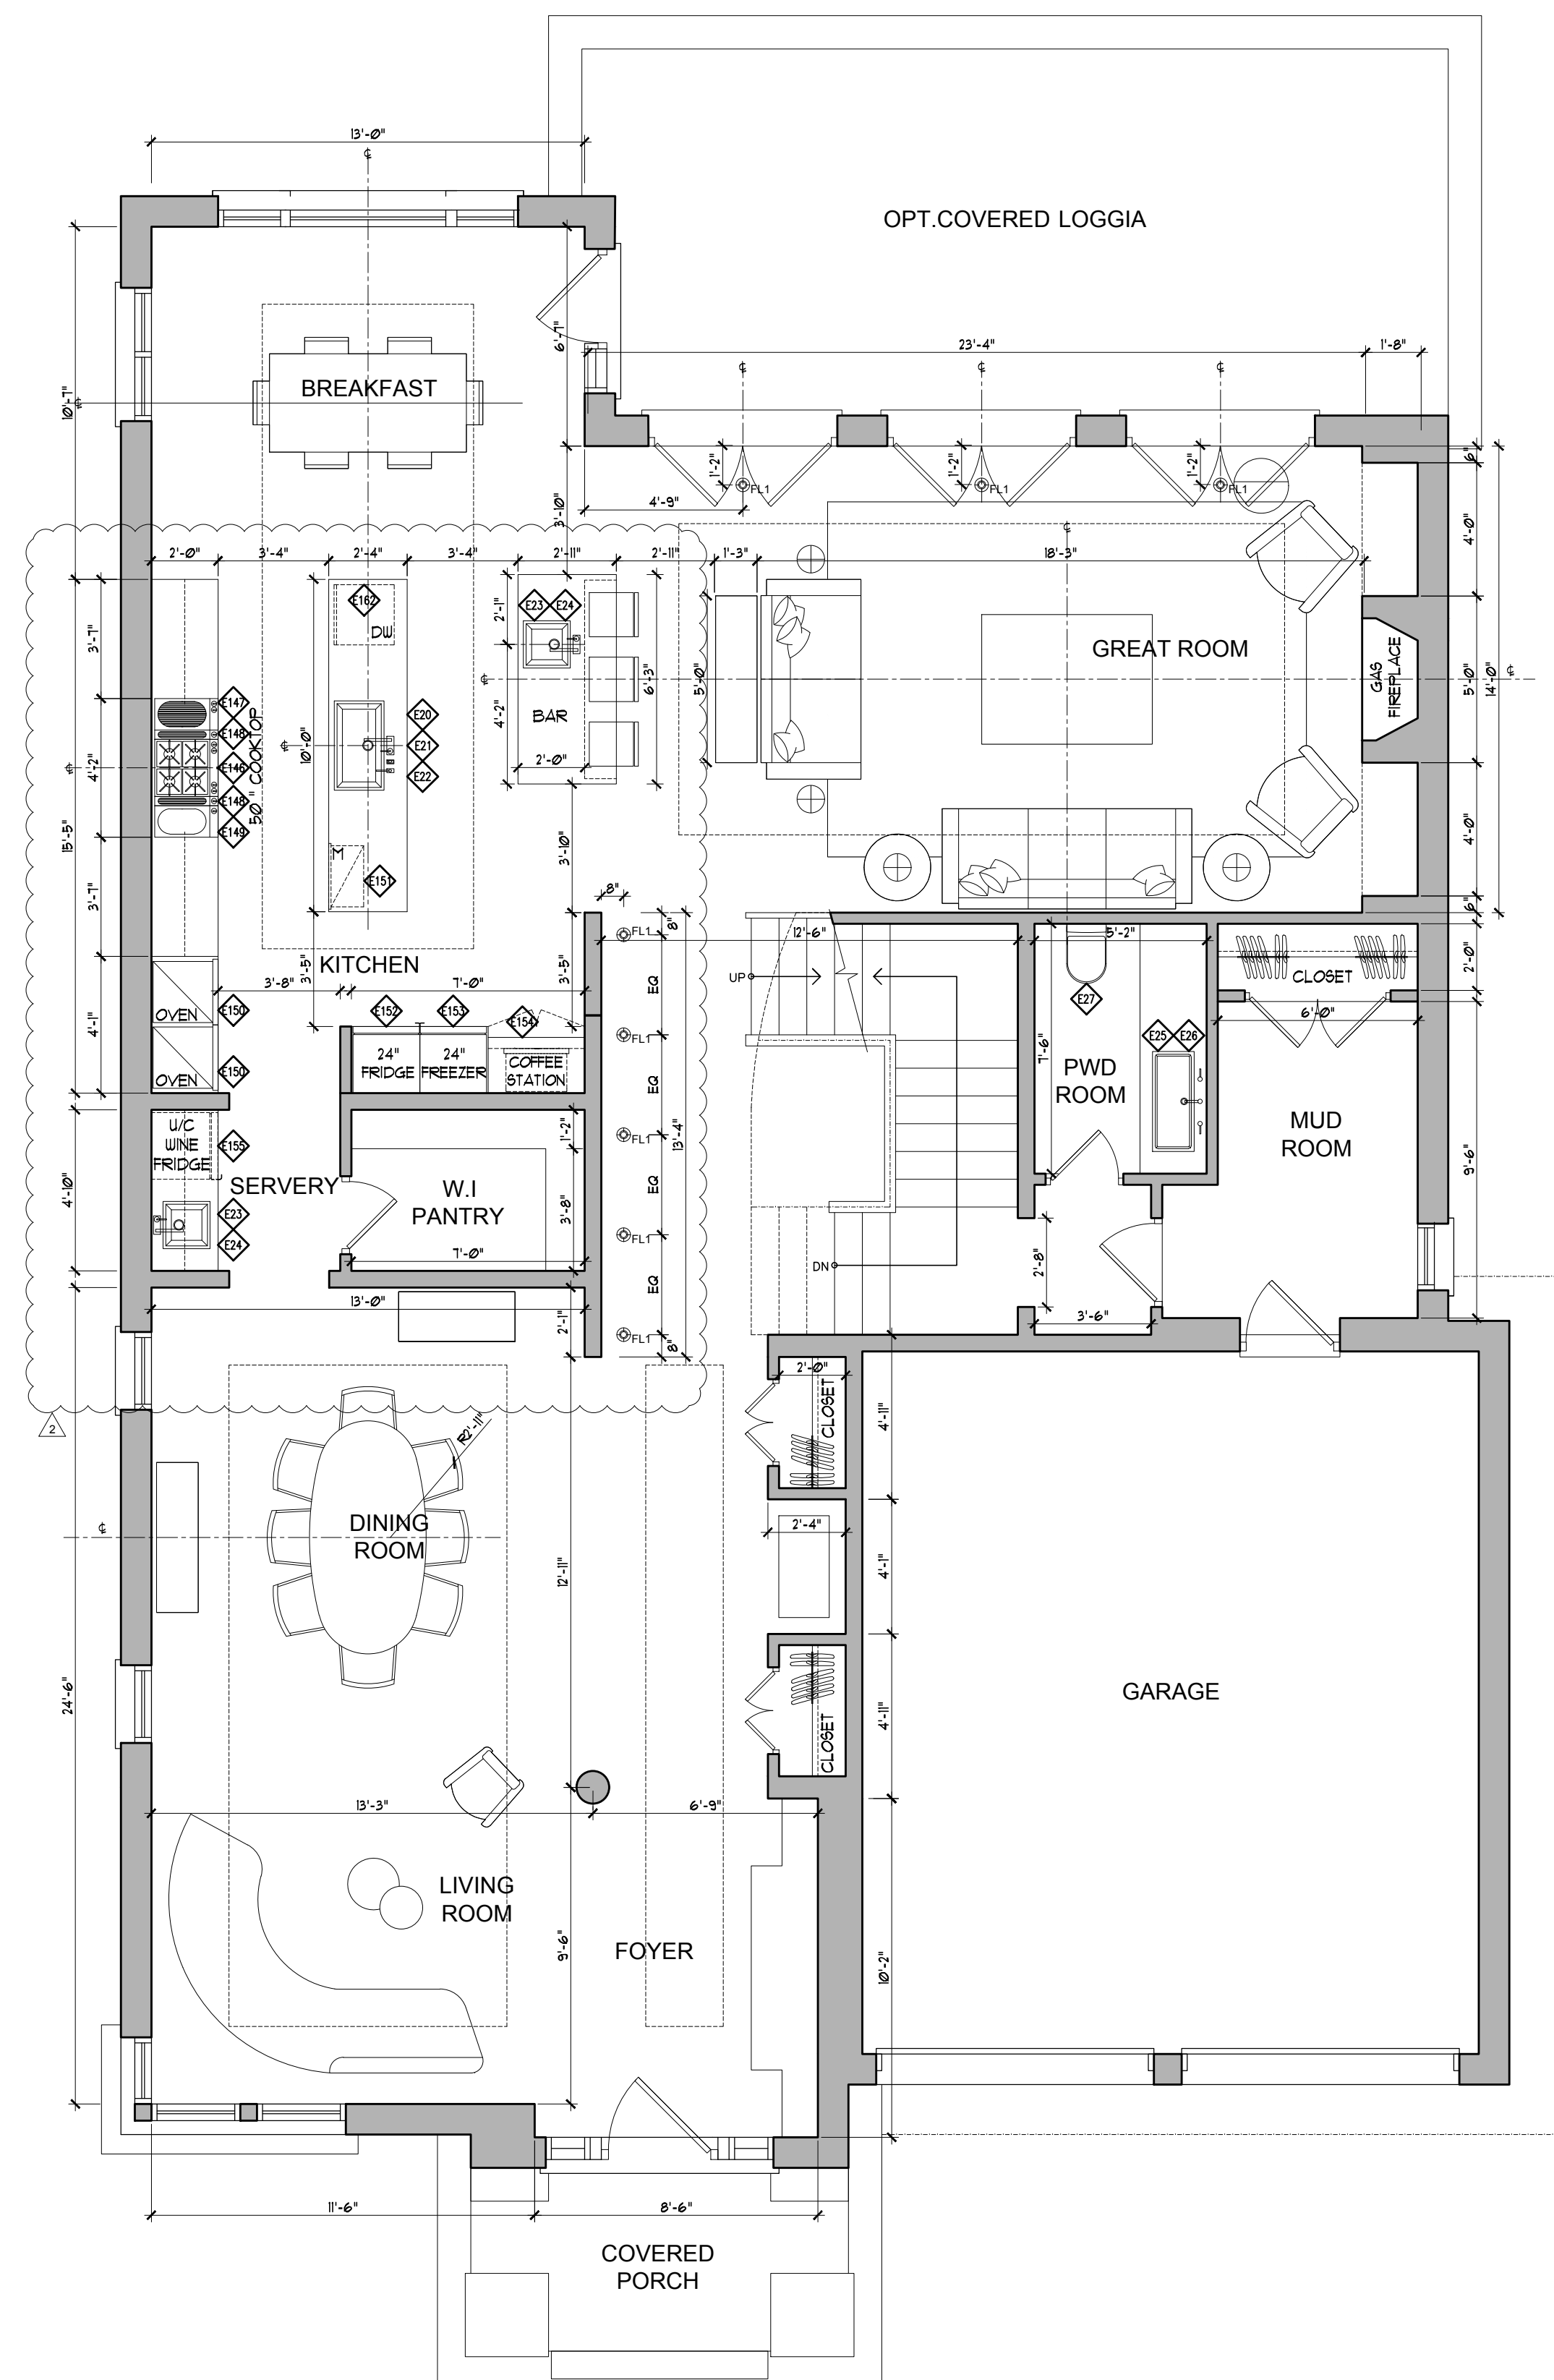

1 FIRST FLOOR
PARTITION PLAN
SCALE: 1:50

1	15/05/2019	ISSUED FOR PLUMBING & APPLIANCES	RG	MM
1	18/04/2019	ISSUED FOR COORDINATION	RG	MM

NOTE: **DON'T SCALE DRAWINGS**
It is the contractor's responsibility to verify all specifications and dimensions and report any discrepancies to the designer prior to construction. Materials may not be substituted without designer's written approval.




PROJECT:
PINEVALLEY
OAKGROVE, LOT 91
GOLDPARK HOMES
CONCORD, ON

DRAWING:
PARTITION PLAN

DESIGNER'S:
MICHELE NIVEN
DRAWN BY:
M-Tec Inc.
DATE:
FEB 2019
SCALE:
1:50
PROJECT NO:
2018-10


ID
1.1.0

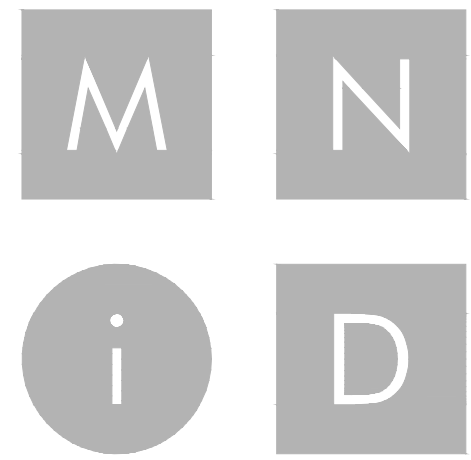


MIKE NIVEN INTERIOR DESIGN INC.
100 BROADVIEW AVE. S. 3RD FLOOR, TORONTO, ONTARIO M4M 3B3
TEL: 416.783.7404 • FAX: 416.783.7404

ISSUED FOR
PLUMBING &
APPLIANCES

No.	Date	Revision	Dwn	Chk
1	18/04/2019	ADJUSTED AS SHOWN	RG	MN
2	15/05/2019	ADJUSTED AS SHOWN	RG	MN

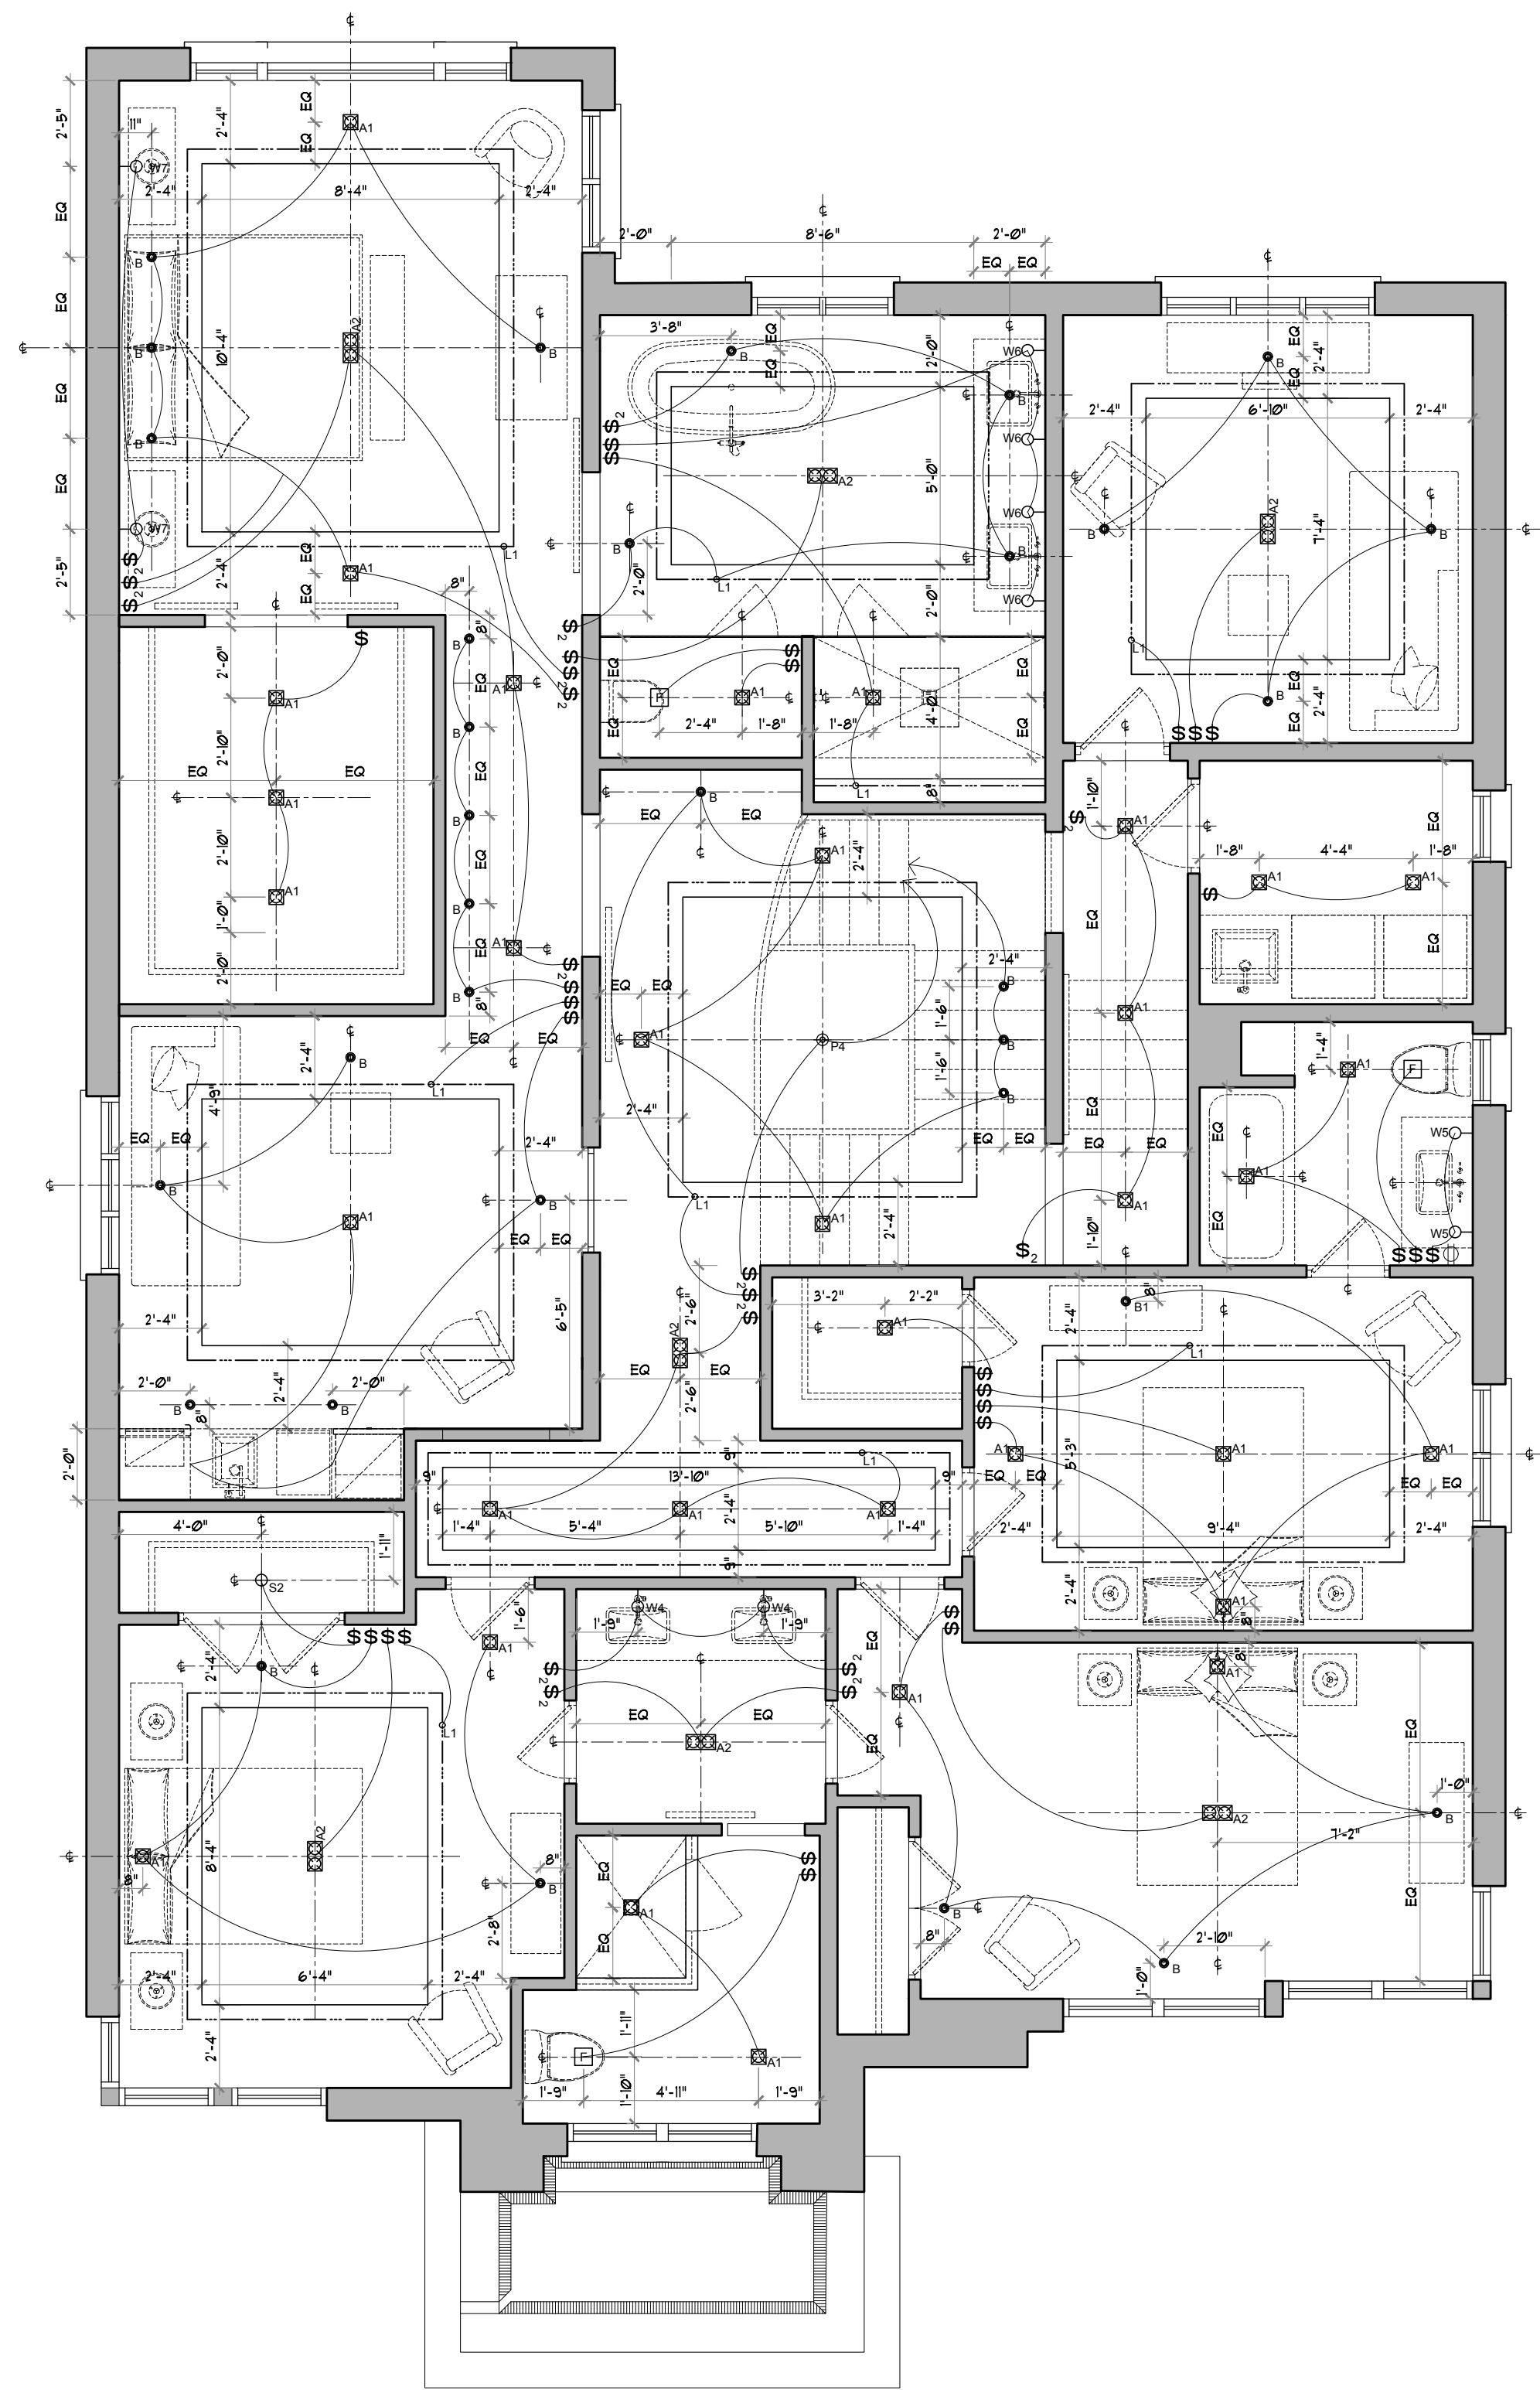

2 SECOND FLOOR
REFLECTIVE CEILING PLAN
1/011.1 SCALE: 1/50

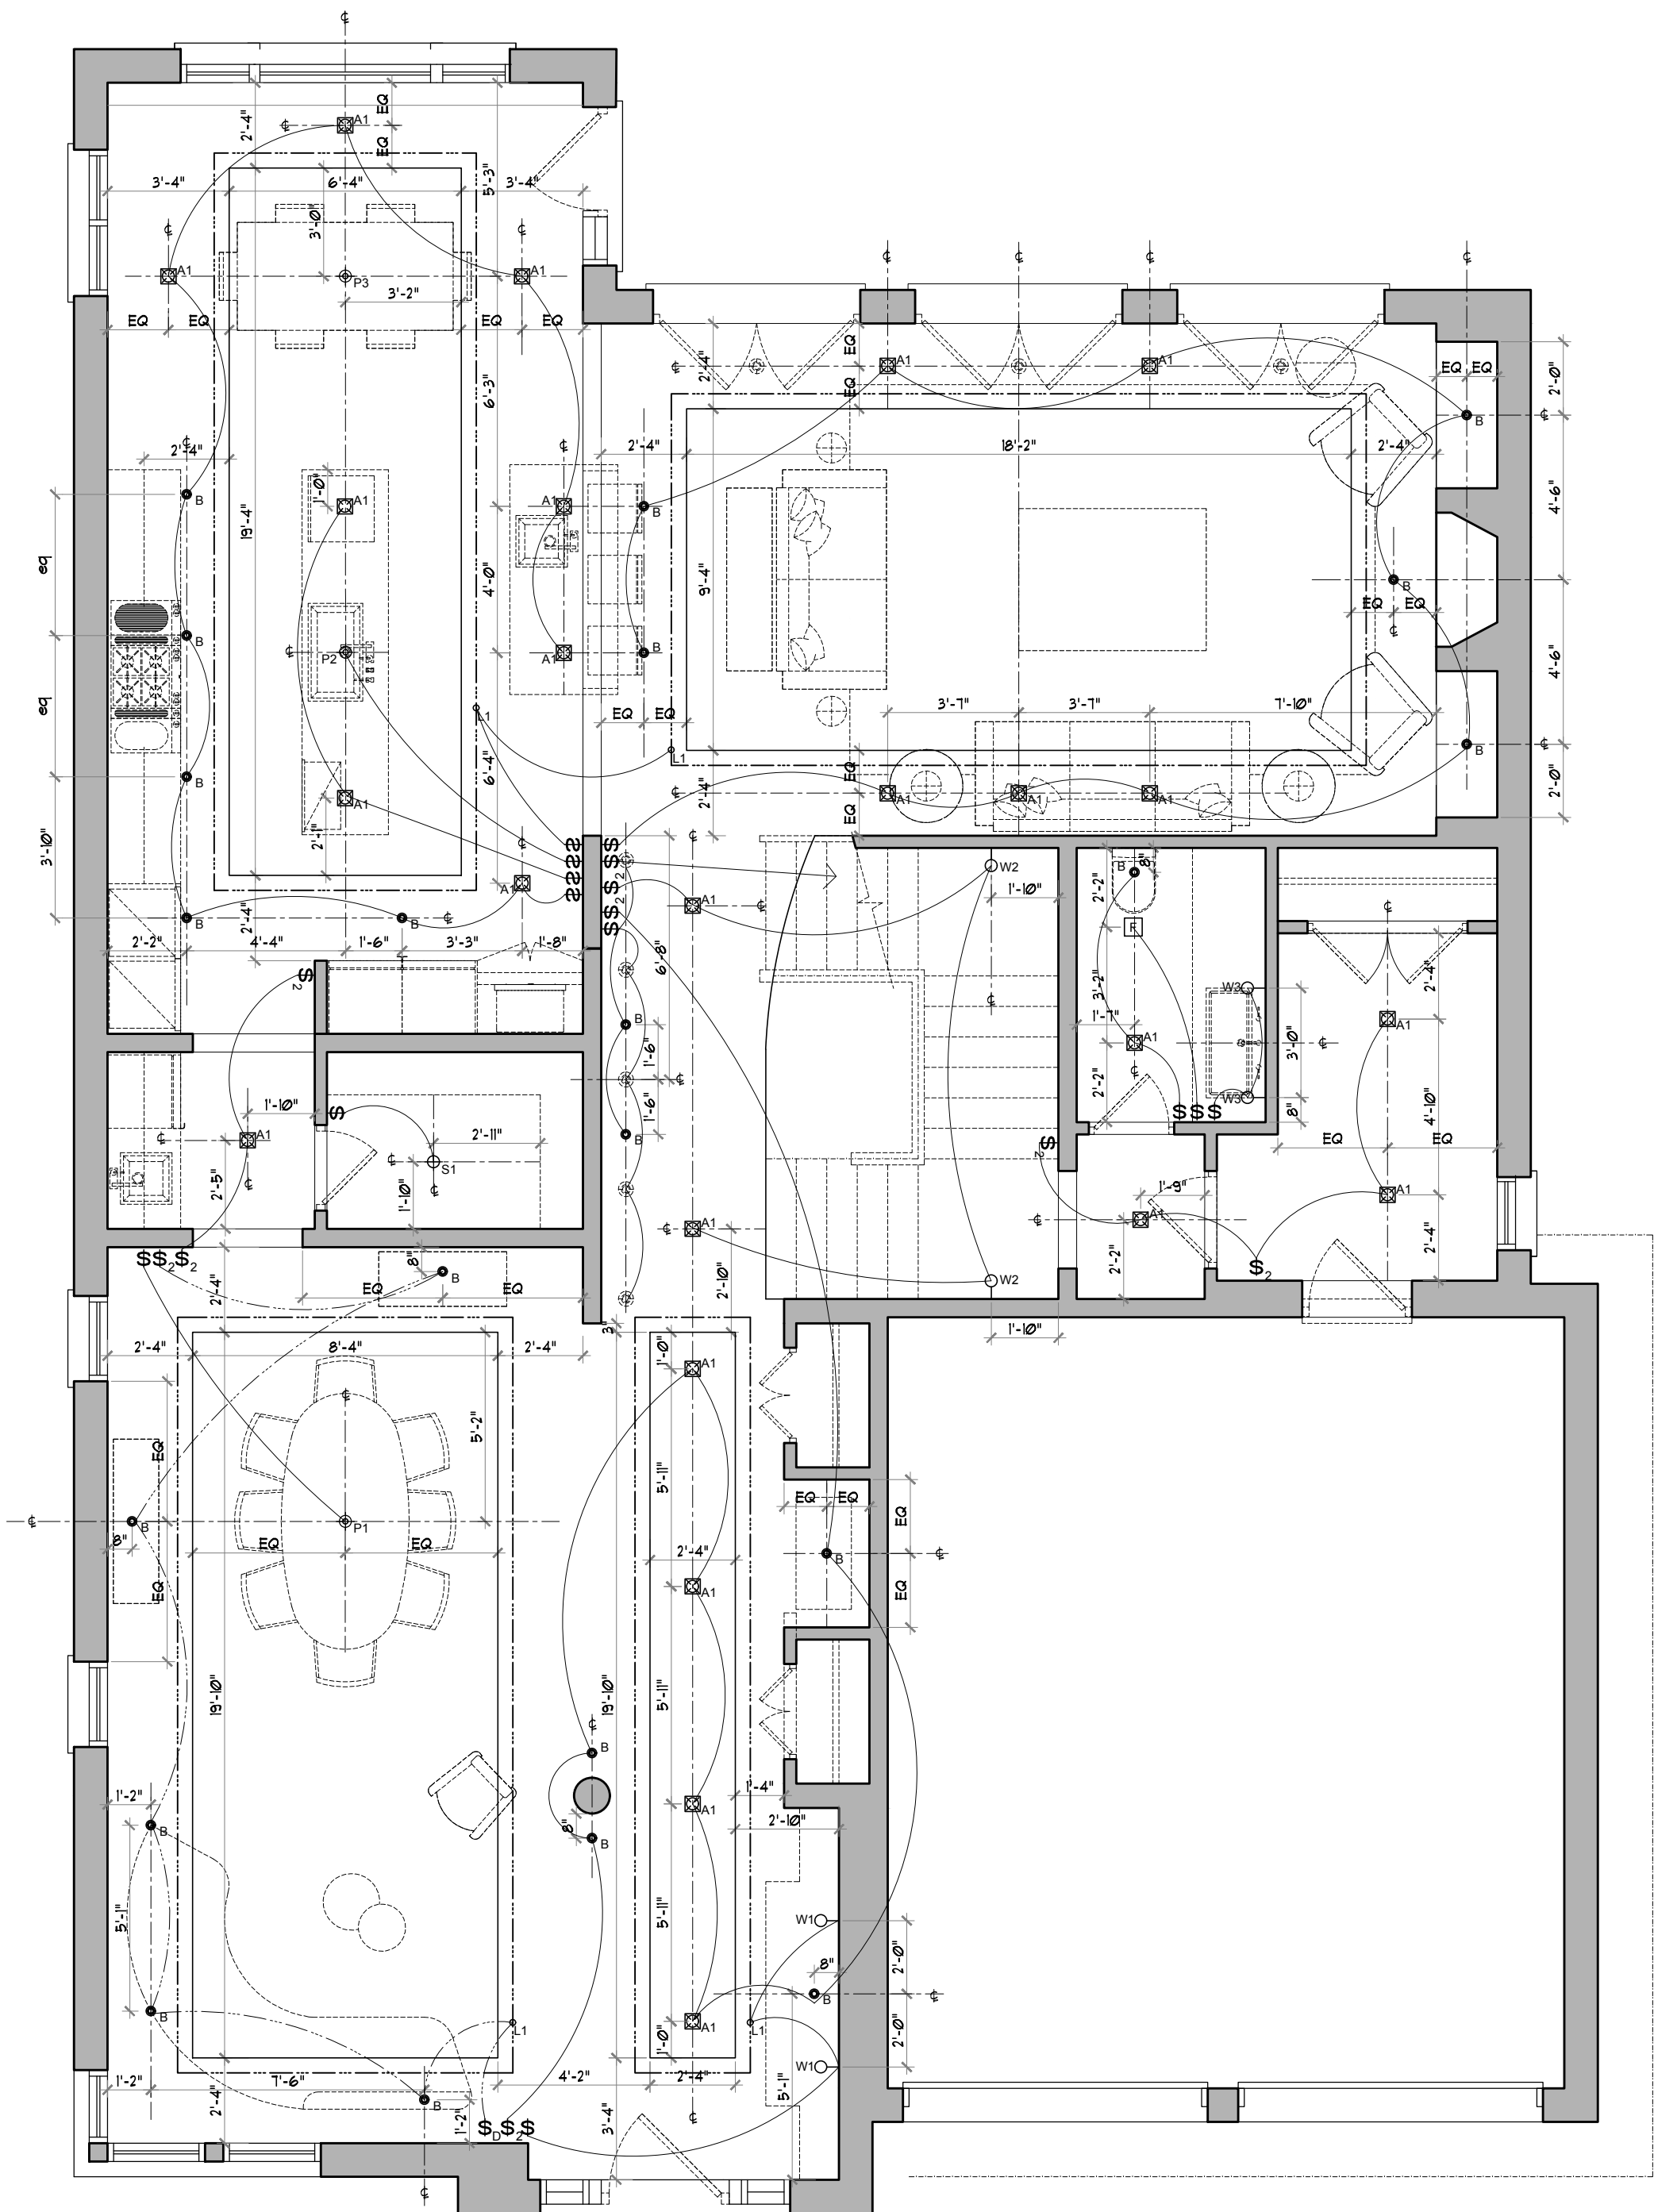

1 FIRST FLOOR
REFLECTIVE CEILING PLAN
1/011.1 SCALE: 1/50

1	15/05/2019	ISSUED FOR PLUMBING & APPLIANCES	RG	MN
1	18/04/2019	ISSUED FOR COORDINATION	RG	MN

No.	Date	Issue	Dwn	Chk
-----	------	-------	-----	-----

NOTE: DO NOT SCALE DRAWINGS
It is the contractor's responsibility to verify all specifications and dimensions and report any discrepancies to the designer prior to construction. Materials may not be substituted without designer's written approval.



PROJECT:

PINEVALLEY
OAKGROVE, LOT 91

GOLDPARK HOMES

CONCORD, ON



DRAWING:

REFLECTIVE CEILING PLAN

DESIGNER'S:

MIKE NIVEN

DRAWN BY:

M-Tec Inc.

DATE:

FEB 2019


SCALE:

1/50

PROJECT NO:

2018-10


ID
1.1.1

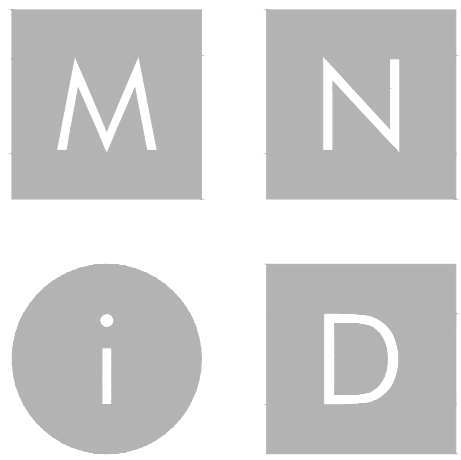


MIKE NIVEN INTERIOR DESIGN INC.
100 BROADVIEW AVE. 5.302 TORONTO, CANADA M4M 3B3
TEL: 416.783.7404 • FAX: 416.783.7404

ISSUED FOR
PLUMBING &
APPLIANCES

No.	Date	Revision	Dwn	Chg
1	18/04/2019	ADJUSTED AS SHOWN	RG	MN
2	15/05/2019	ADJUSTED AS SHOWN	RG	MN

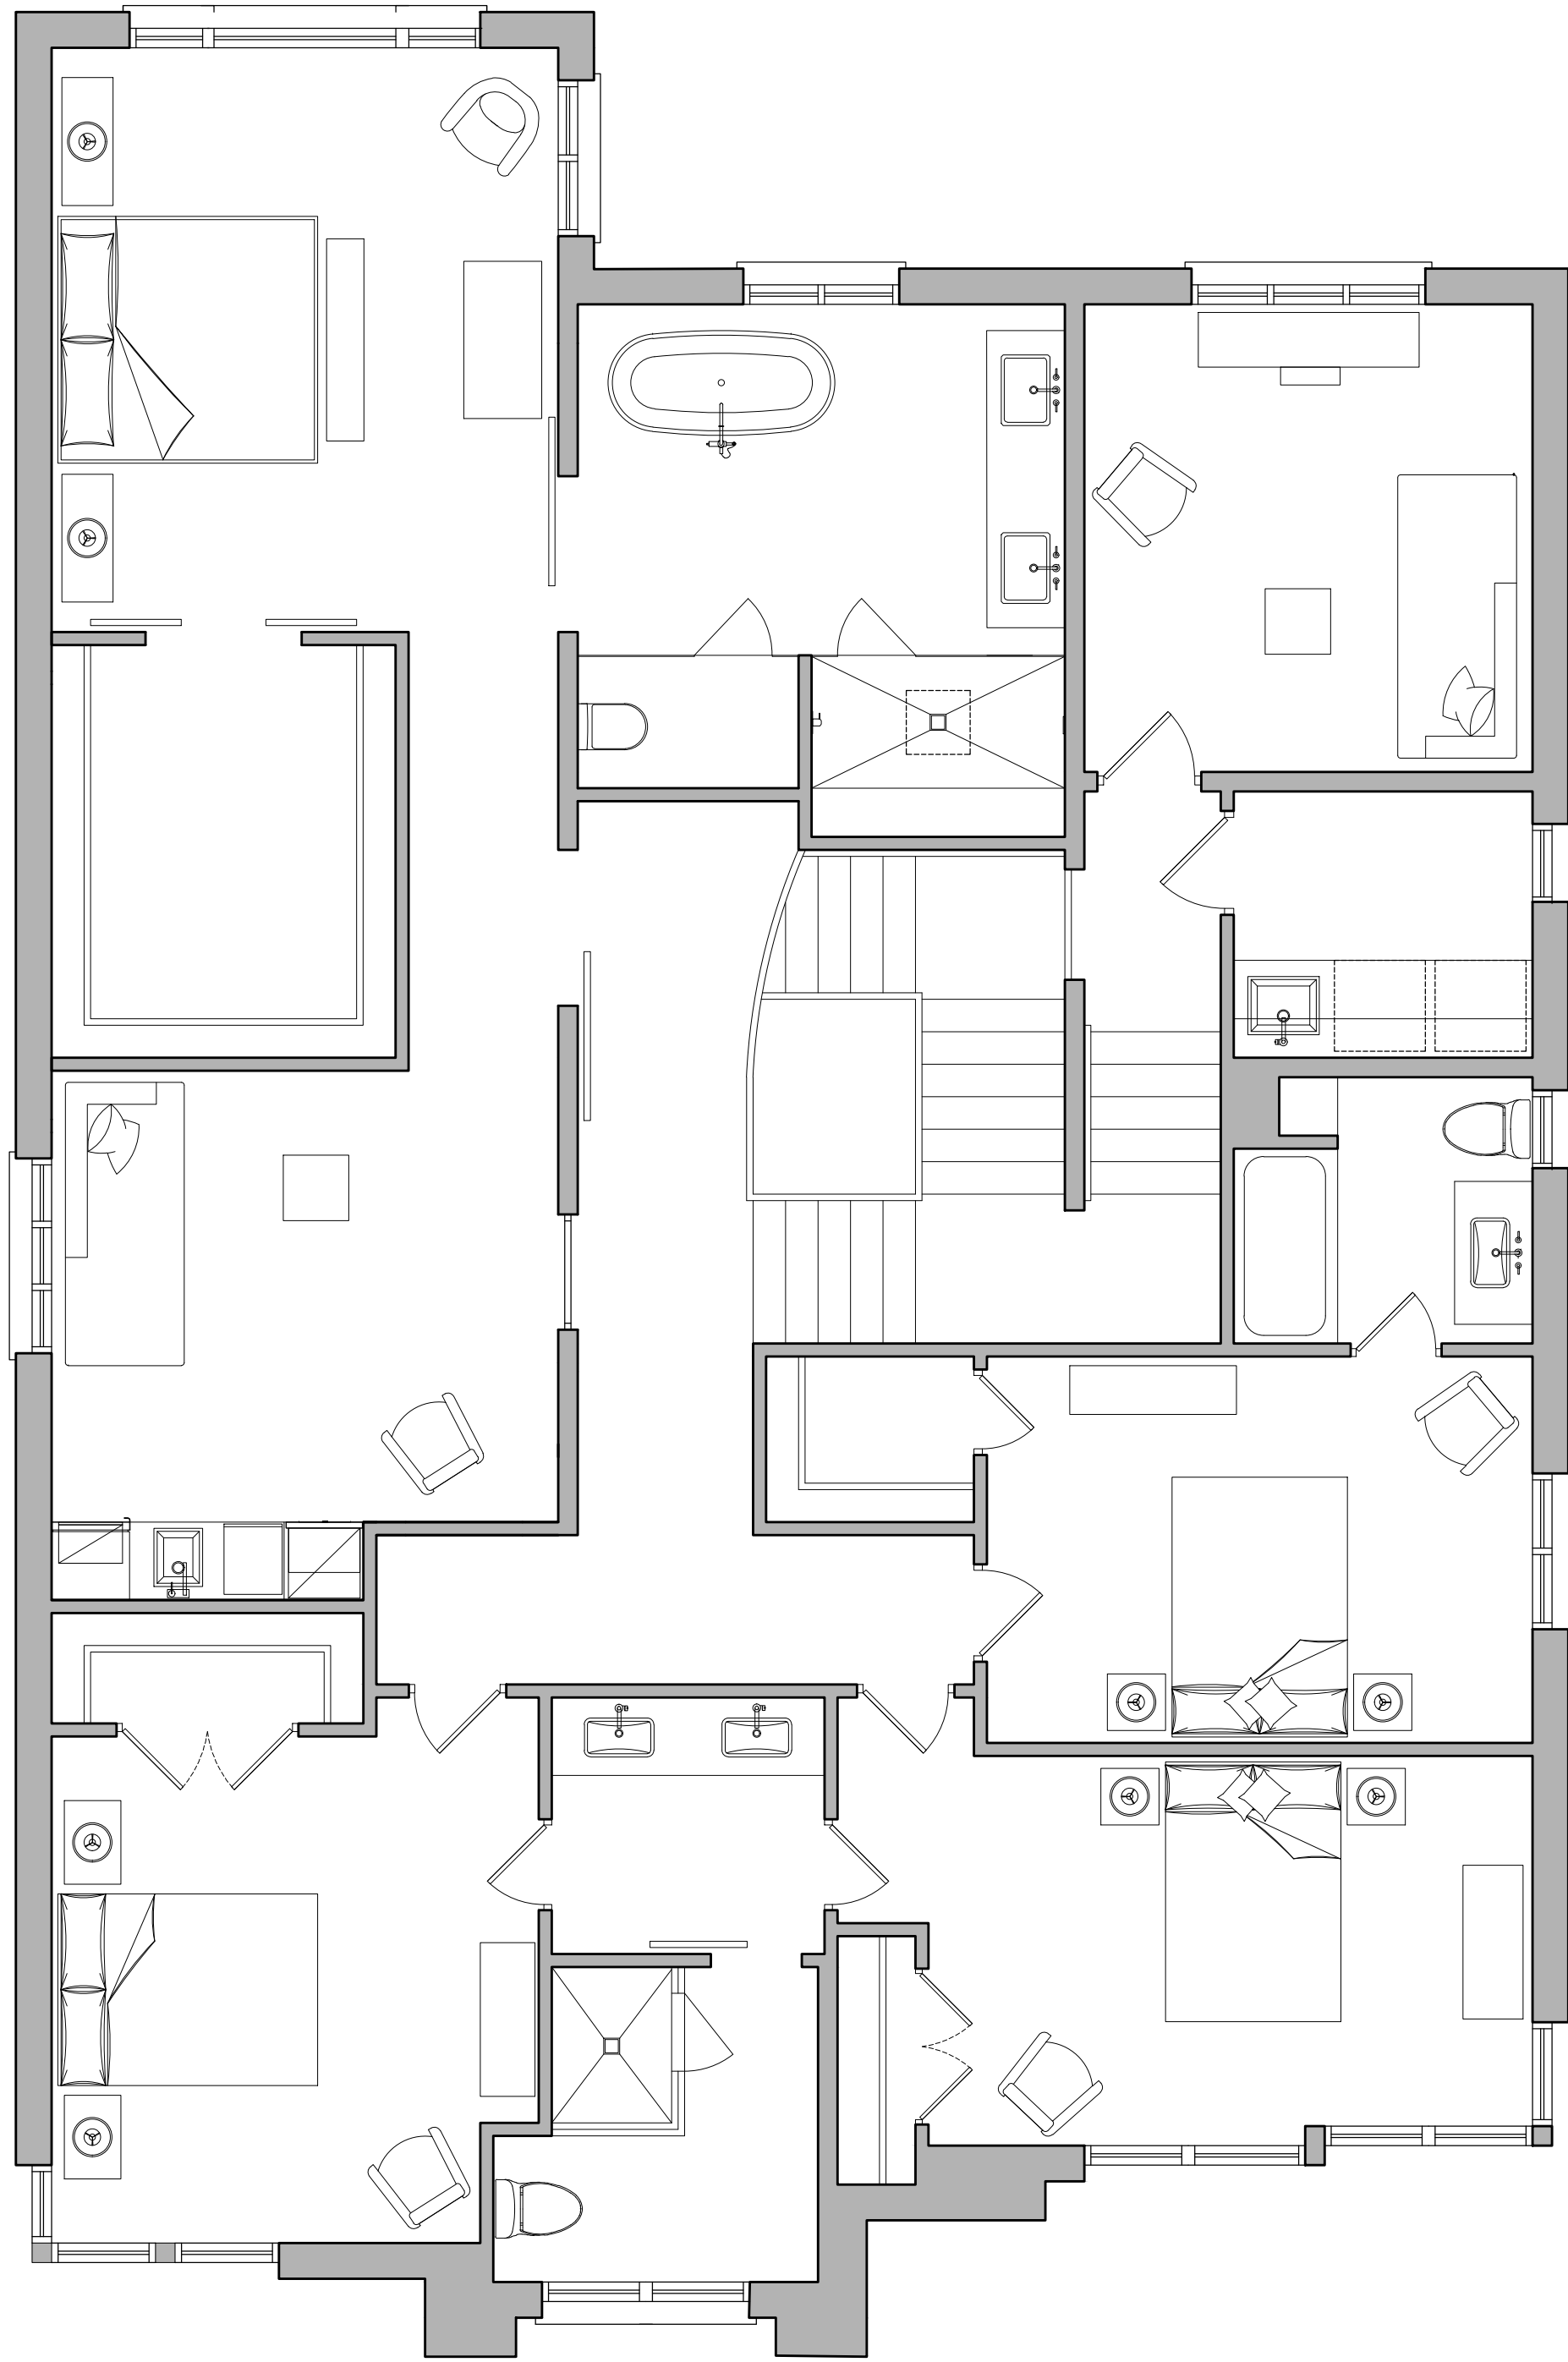

2 SECOND FLOOR
FINISHES PLAN
SCALE: 1:50

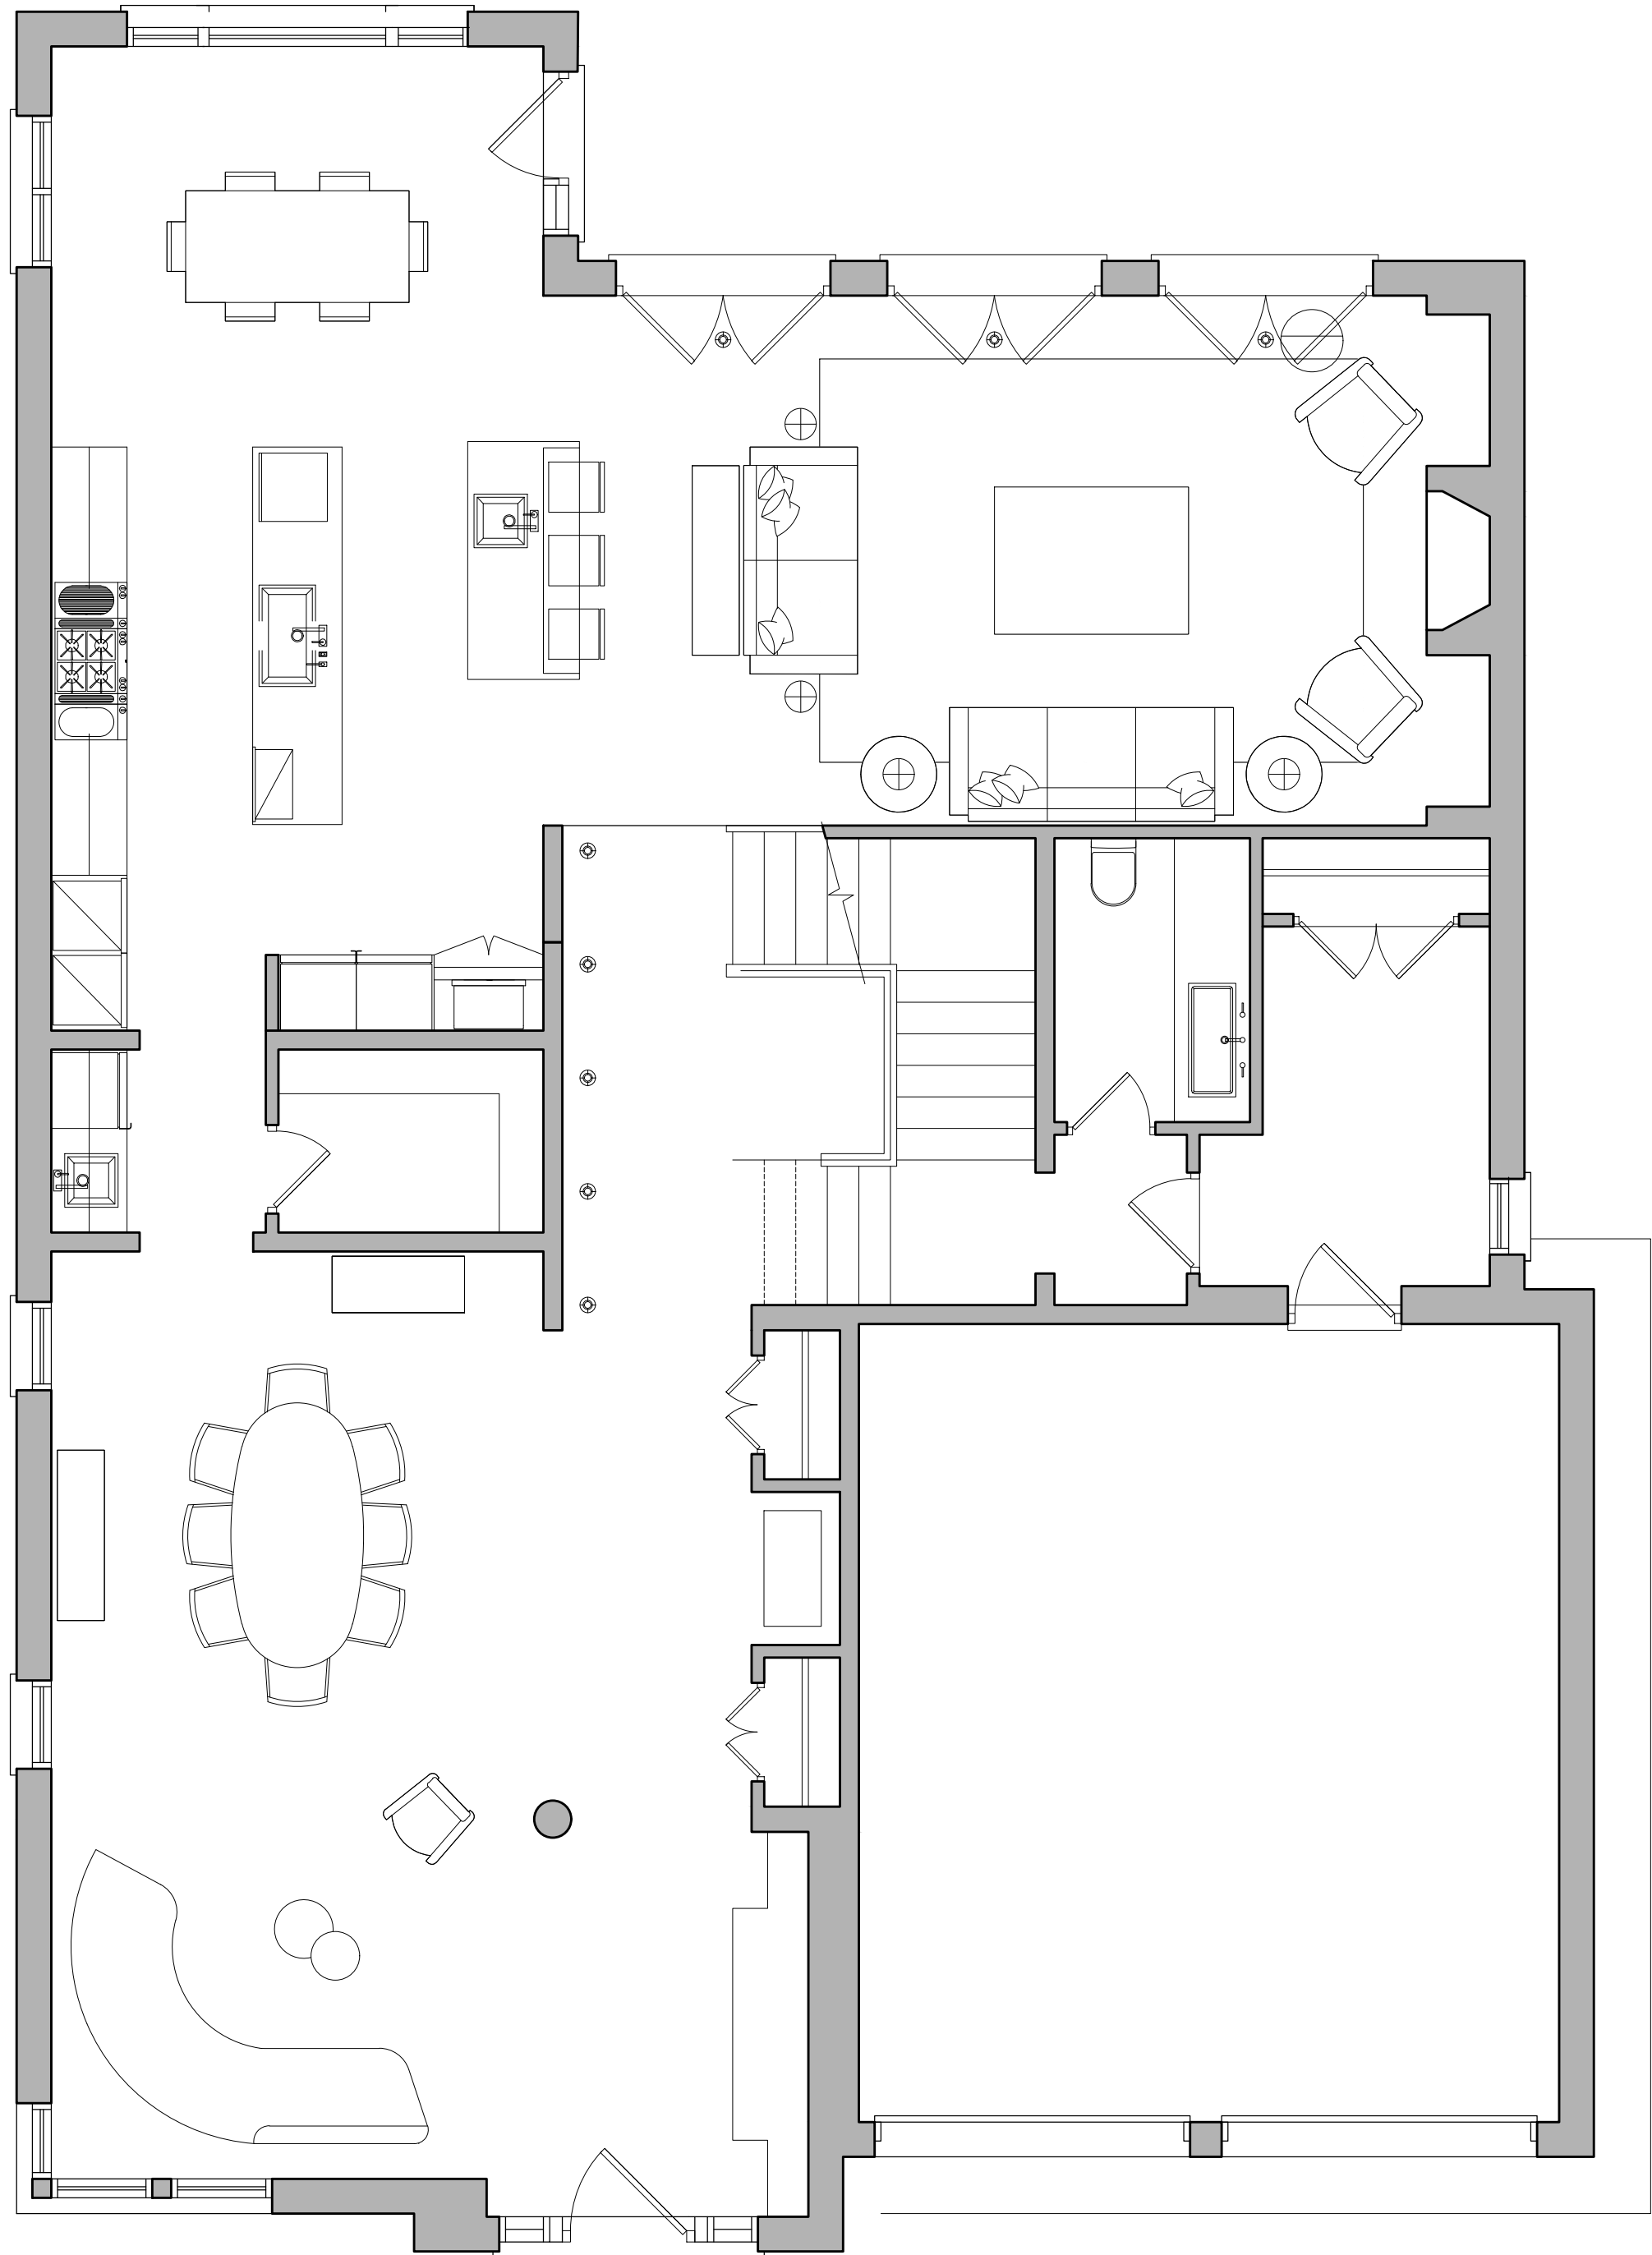

1 FIRST FLOOR
FINISHES PLAN
SCALE: 1:50

1	15/05/2019	ISSUED FOR PLUMBING & APPLIANCES	RG	MN
1	18/04/2019	ISSUED FOR COORDINATION	RG	MN

No.	Date	Issue	Dwn	Chg
-----	------	-------	-----	-----

NOTE: DO NOT SCALE DRAWINGS
It is the contractor's responsibility to verify all specifications and dimensions and report any discrepancies to the designer prior to construction. Materials may not be substituted without designer's written approval.



PROJECT:
PINEVALLEY
OAK GROVE, LOT 91
GOLDPARK HOMES
CONCORD, ON



DRAWING:

FINISHES PLAN

DESIGNER'S:

MIKE NIVEN

DRAWN BY:

M-Tec Inc.

DATE:

FEB 2019


SCALE:

1:50

PROJECT NO:

2018-10

ID
1.1.2

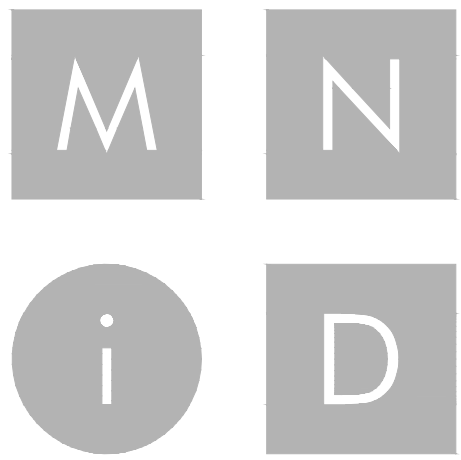

MIKE NIVEN INTERIOR DESIGN INC.
100 BROADVIEW AVE. S. 3RD FLOOR, TORONTO, CANADA M4M 3B3
TEL: 416.783.7404 • FAX: 416.783.7404

ISSUED FOR
PLUMBING &
APPLIANCES

No.	Date	Revision	Drawn	CHK
1	18/04/2019	ADJUSTED AS SHOWN	RG	MN
2	15/05/2019	ADJUSTED AS SHOWN	RG	MN

1	15/05/2019	ISSUED FOR PLUMBING & APPLIANCES	RG	MN
1	18/04/2019	ISSUED FOR COORDINATION	RG	MN

No.	Date	Issue	Drawn	CHK
-----	------	-------	-------	-----

NOTE: DO NOT SCALE DRAWINGS
It is the contractor's responsibility to verify all specifications and dimensions and report any discrepancies to the designer prior to construction. Materials may not be substituted without designer's written approval.




PROJECT:
PINEVALLEY
OAK GROVE, LOT 91
GOLDPARK HOMES
CONCORD, ON



DRAWING:

DETAILS

DESIGNER'S: MIKE NIVEN	ID 3.0.0
DRAWN BY: M-Tec Inc.	
DATE: FEB 2019	
SCALE: 1:50	
PROJECT NO: 2018-10	

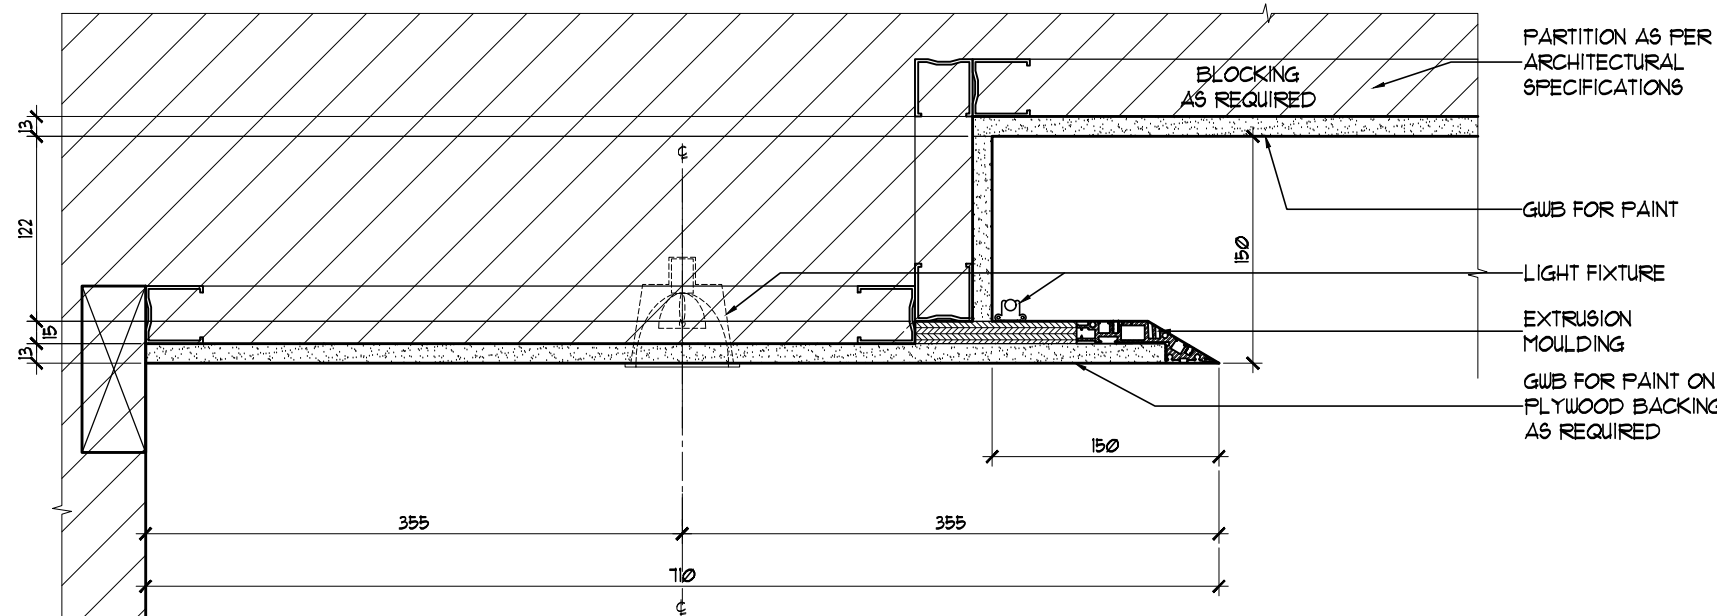

TYP. COVE DETAIL
VERTICAL SECTION
1
ID3.0 SCALE: 1:5