



CONSTRUCTION SUMMARY

Brampton Encore - 66R - 2 - 28-2 Elev.B Siren

FRAMING

Inv.2,036	1 - SIDE DOOR FROM GARAGE TO EXTERIOR- GRADE PERMITTING
Line28932	Note: Raise grade to accommodate
6Aug19 / 10Aug19	
Inv.2,036	1 - MANDOOR - GARAGE TO HOUSE- AS PER PLAN AND GRADE PERMITING
Line28789	Note:
6Aug19 / 10Aug19	

PLUMBING

Inv.2,036	1 - ROUGH-IN - 3PC BASEMENT ROUGH-IN
Line28807	Note:
6Aug19 / 10Aug19	


WINDOWS - BASEMENT

Inv.2,036	4 - BASEMENT WINDOWS - UPGRADE EXISTING BASEMENT WINDOW TO 30 INCH X 24 INCH - MAY REQUIRE INSTALLATION OF WINDOW WELL
Line28794	Note:
6Aug19 / 10Aug19	

BE2-66R
Aug. 6 2019

The
Siren
SEMI SERIES

Elevation A • 1,688 sq.ft.
→ Elevation B • 1,677 sq.ft.
Elevation C • 1,687 sq.ft.

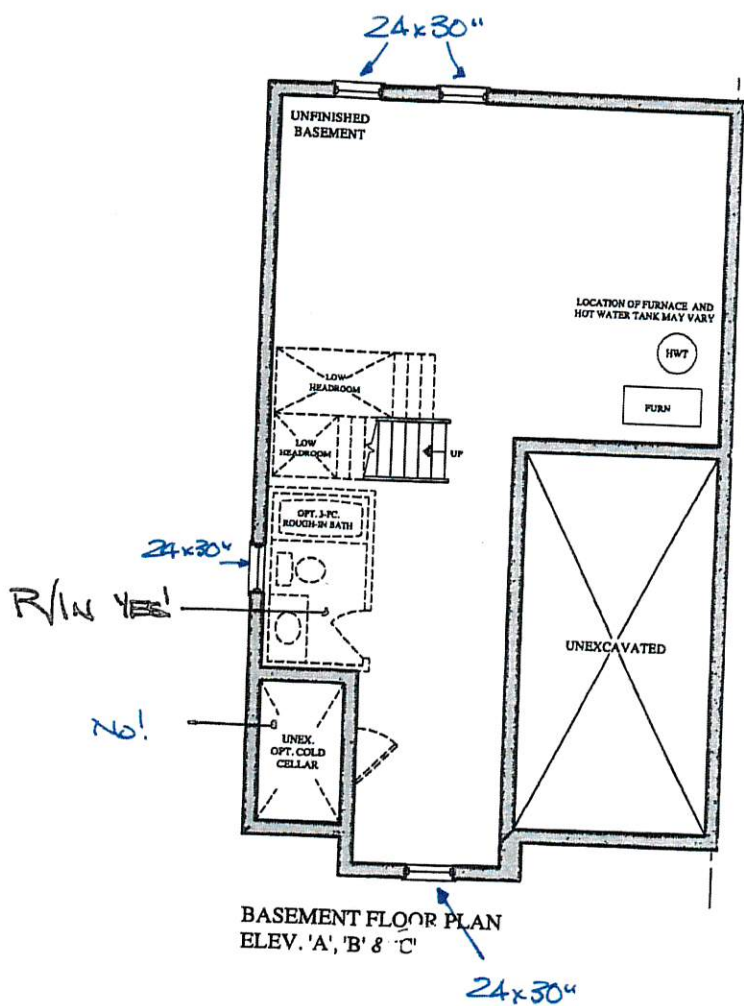

Prices, figures, illustrations, sizes, features and finishes are subject to change without notice. Areas and dimensions are approximate and actual usable floor space may vary from the stated area. Layout may be reverse of the unit purchased. E. & O.E.

BEZ-66R


AUG 6 2019

REVISED AUG 10 2019.


The Siren

SEMI SERIES

Elevation A • 1,688 sq.ft.
→ Elevation B • 1,677 sq.ft.
Elevation C • 1,687 sq.ft.

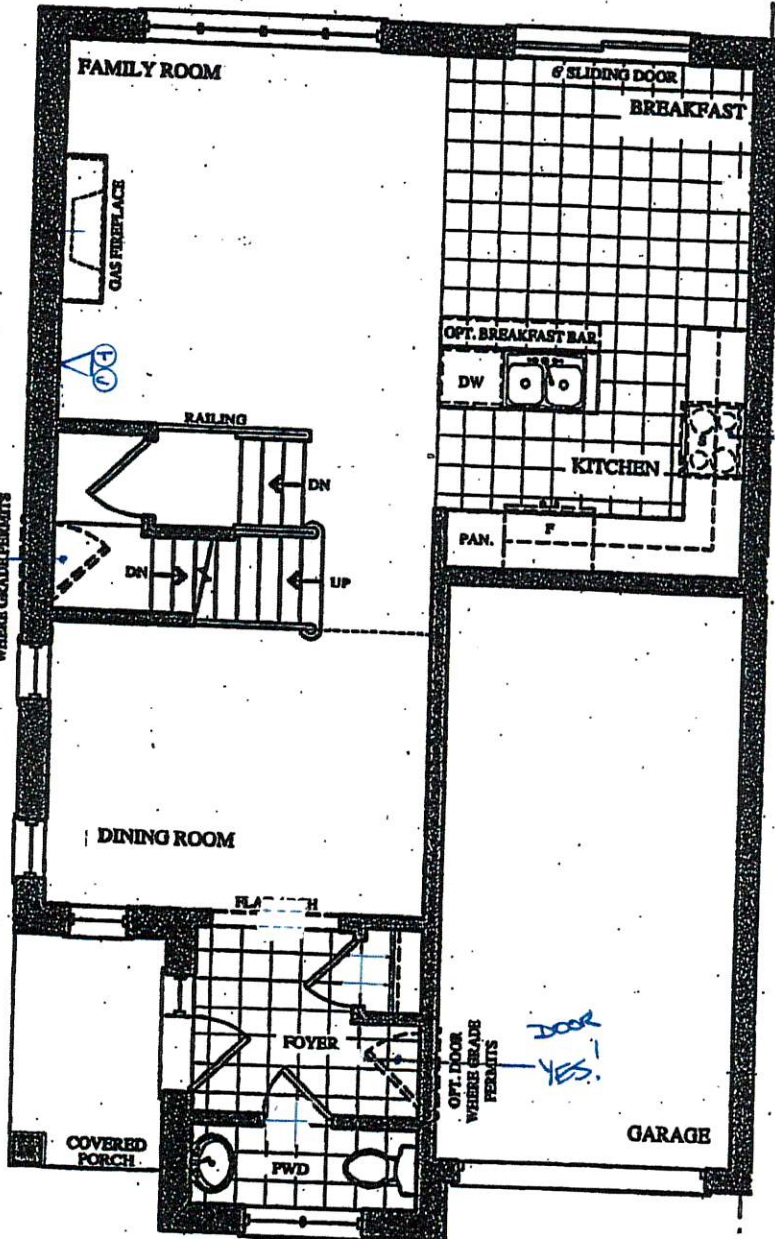

GROUND FLOOR PLAN
ELEV. 'A' & 'B'

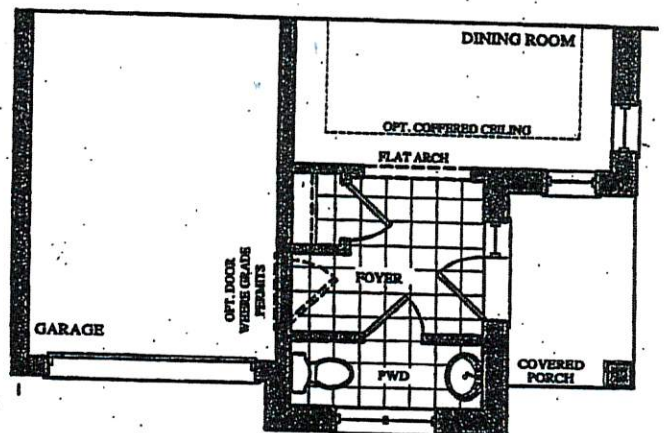


PART. GROUND FLOOR PLAN
ELEV. 'C'


BEZ-662
Aug. 6 2019

The Siren SEMI SERIES


Elevation A • 1,688 sq.ft.
Elevation B • 1,677 sq.ft.
Elevation C • 1,687 sq.ft.

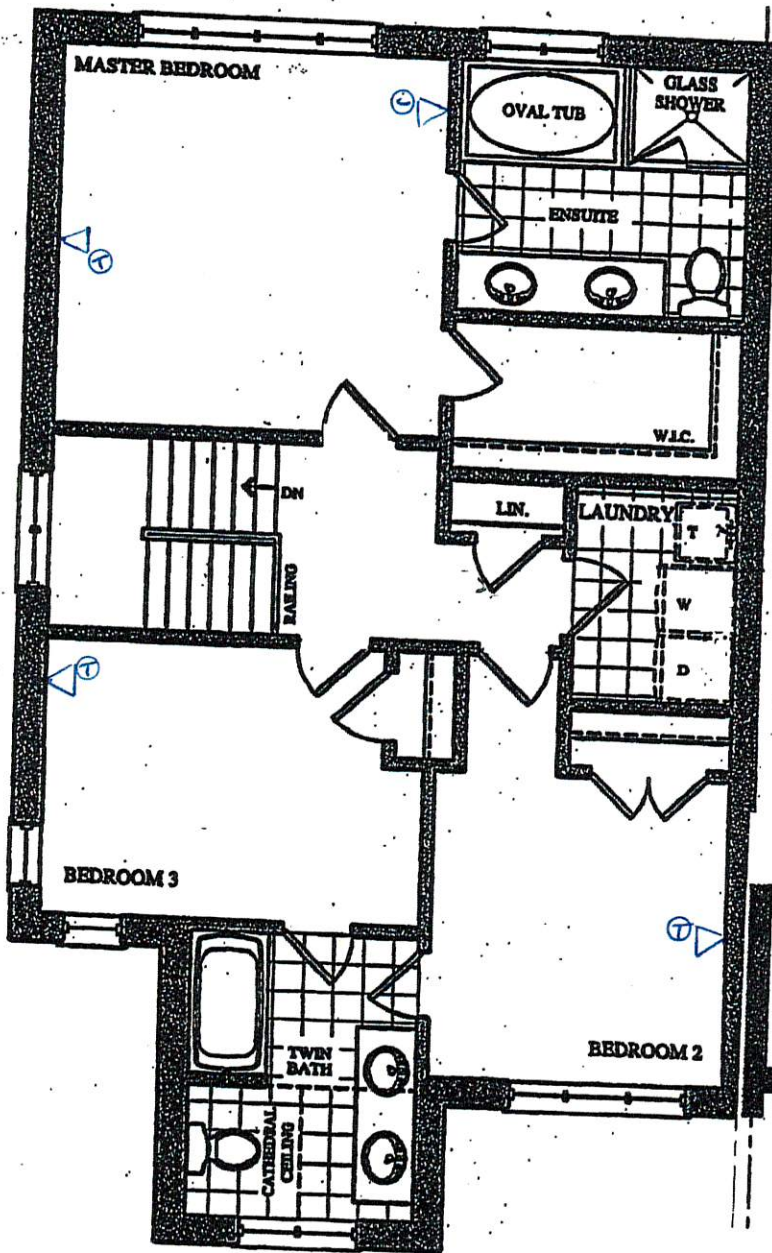

SECOND FLOOR PLAN
ELEV. 'A'

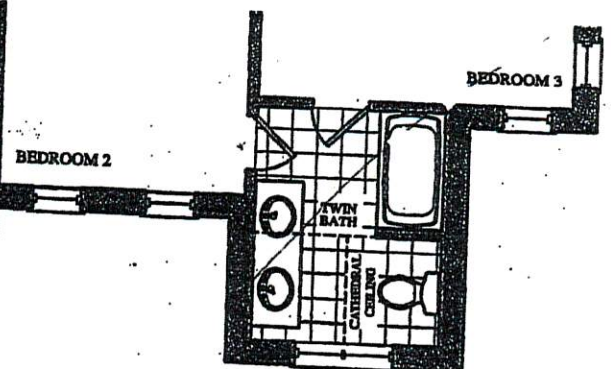

PART. SECOND FLOOR PLAN
ELEV. 'B'

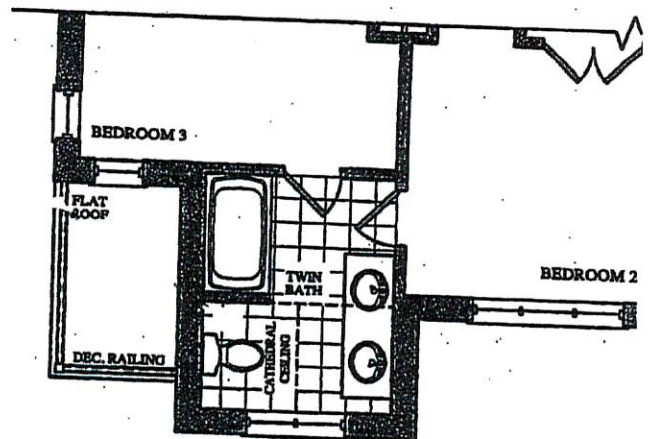

PART. SECOND FLOOR PLAN
ELEV. 'C'