

Brampton Encore - 151 - 2 - 38-3 Elev.B HAYDN

ELECTRICAL

Inv.2,015	1 - KITCHEN: 110V WALL RECEPTACLE ON DEDICATED CIRCUIT - GAS FIRED APPLIANCE - FOR AUX. EQUIPMENT - NOT A STOVE PLUG
Line28618	Note:
27Jun19 / 12Aug19	

FORMING

Inv.2,015	1 - SIDE DOOR- HOME TO EXTERIOR- AS PER PLAN AND GRADE PERMITTING
Line28620	Note:
27Jun19 / 12Aug19	

FRAMING

Inv.2,015	1 - **FRAMING NOTE: INSTALL SIDE ENTRANCE
Line28619	Note:
27Jun19 / 12Aug19	
Inv.2,015	4 - **FRAMING NOTE: MAIN FLOOR - DOORS TO BE 96"
Line28622	Note:
27Jun19 / 12Aug19	

HVAC

Inv.2,015	1 - KITCHEN: GAS LINE ROUGH - MAIN FLOOR- (2-STOREY MODELS)
Line28614	Note:
27Jun19 / 12Aug19	

INTERIOR TRIM AND DOORS

Inv.2,015	4 - MAIN FLOOR: STANDARD DOOR EXTENDED HEIGHT 96" (PRICE PER DOOR)- GROUND FLOOR 2 STOREY MODELS
Line28621	Note:
27Jun19 / 12Aug19	



PLUMBING

Inv.2,015	1 - BASEMENT: ROUGH-IN - 3PC BASEMENT ROUGH-IN
Line28617	Note:
27Jun19 / 12Aug19	


WINDOWS - BASEMENT

Inv.2,015	4 - BASEMENT WINDOWS - UPGRADE EXISTING BASEMENT WINDOW TO 30 INCH X 24 INCH - MAY REQUIRE INSTALLATION OF WINDOW WELL
Line28616	Note:
27Jun19 / 12Aug19	

AUGUST 12 2019

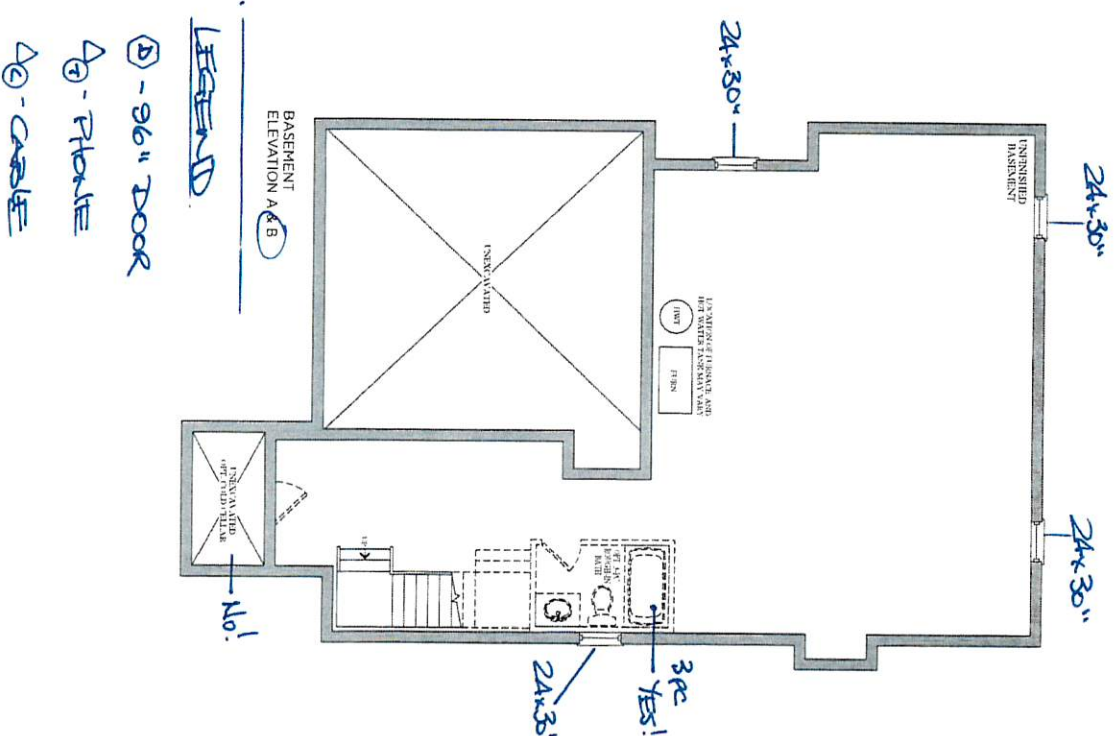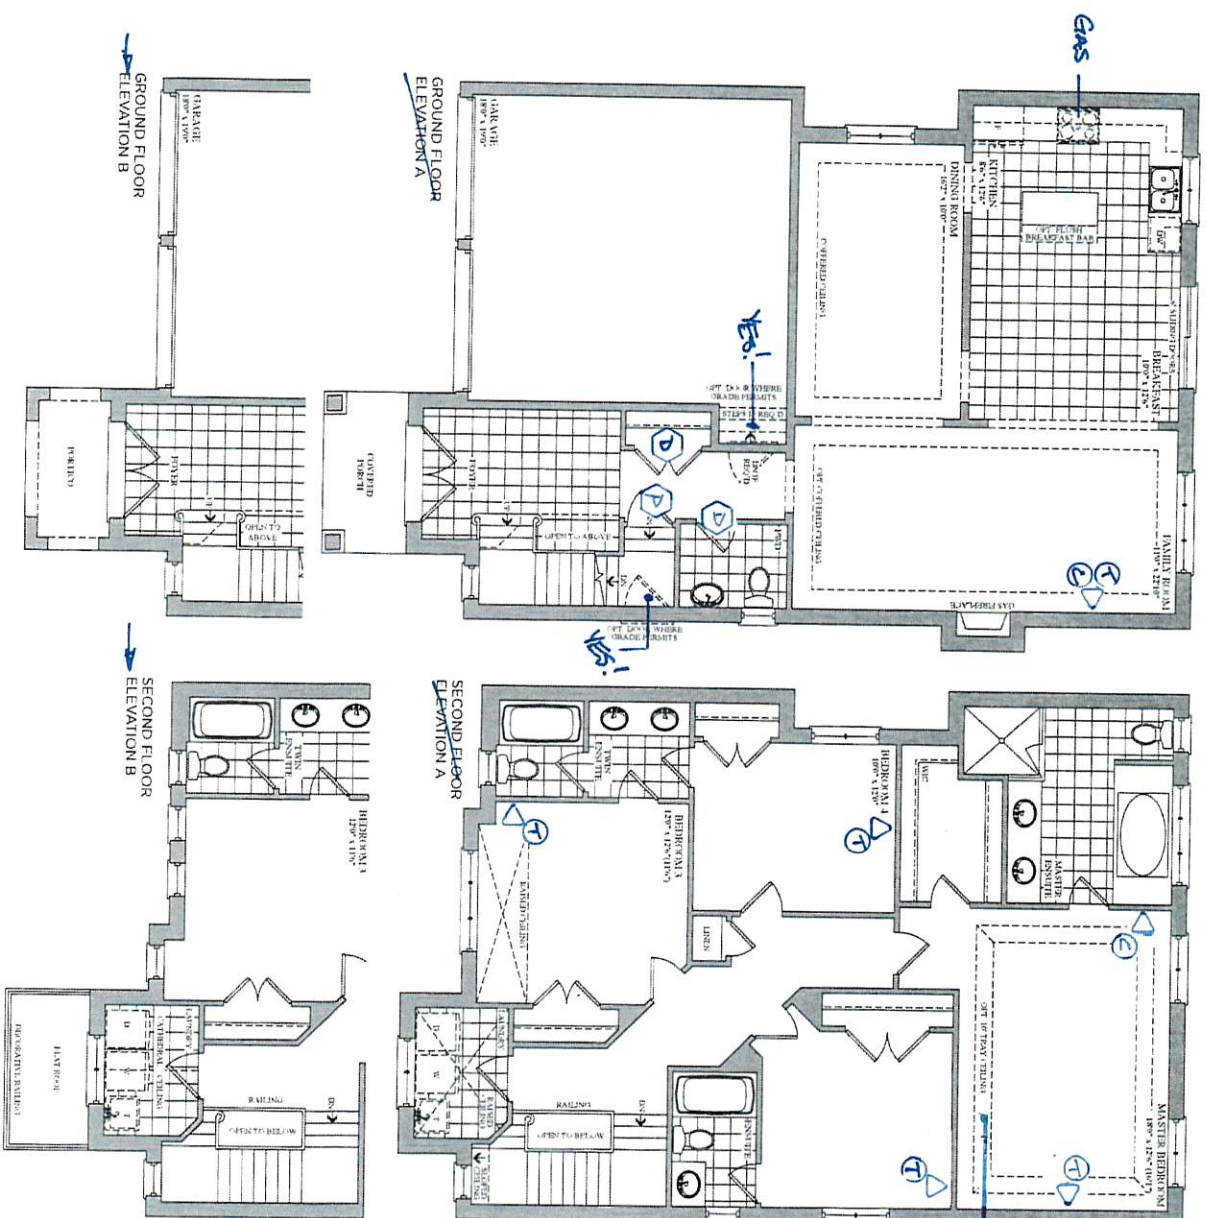

Elevation A • 2,454 sq.ft.

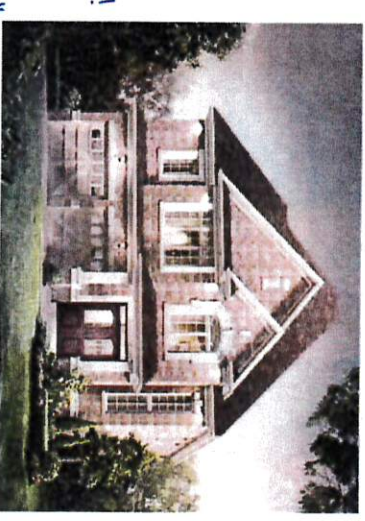

—Elevation B • 2,448 sq.ft.

[illegible]