

Brampton Encore - 101 - 2 - 38-4 Elev.A VIVALDI
ELECTRICAL

Inv.2,038	1 - KITCHEN: RELOCATE STANDARD FIXTURE - ABOVE ISLAND, SEE PLAN FOR LOCATION
Line28812	Note:
6Aug19 / 12Aug19	
Inv.2,038	1 - KITCHEN: ROUGH - IN CEILING OUTLET ON SAME SWITCH - DOES NOT INCLUDE FIXTURE - LOCATE ABOVE ISLAND, SAME SWITCH AS STANDARD CEILING LIGHT
Line28813	Note:
6Aug19 / 12Aug19	

FORMING

Inv.2,038	1 - SIDE DOOR- HOME TO EXTERIOR- AS PER PLAN AND GRADE PERMITTING
Line28814	Note:
6Aug19 / 12Aug19	

FRAMING

Inv.2,038	1 - MANDOOR - GARAGE TO HOUSE- AS PER PLAN AND GRADE PERMITING
Line28815	Note:
6Aug19 / 12Aug19	
Inv.2,038	4 - MAIN FLOOR: FRAME MAIN FLOOR DOORS AT 96" - ADDED WITH THE ADDITION OF TALLER INTERIOR DOORS
Line28816	Note:
6Aug19 / 12Aug19	
Inv.2,038	4 - MAIN FLOOR: FRAME MAIN FLOOR ARCHES AT 96" DOORS
Line28817	Note:
6Aug19 / 12Aug19	

INTERIOR TRIM AND DOORS




Inv.2,038	4 - MAIN FLOOR: EXTENDED HEIGHT ARCHWAY -96" (PRICE PER DOORWAY)
Line28819	Note:
6Aug19 / 12Aug19	
Inv.2,038	4 - MAIN FLOOR; STANDARD DOOR EXTENDED HEIGHT 96" (PRICE PER DOOR) MAIN FLOOR 3 STOREY MODELS
Line28820	Note:
6Aug19 / 12Aug19	

PLUMBING

Inv.2,038	1 - ROUGH-IN - 3PC BASEMENT ROUGH-IN
Line28821	Note:
6Aug19 / 12Aug19	

WINDOWS - BASEMENT

Inv.2,038	4 - BASEMENT WINDOWS - UPGRADE EXISTING BASEMENT WINDOW TO 30 INCH X 24 INCH - MAY REQUIRE INSTALLATION OF WINDOW WELL
Line28823	Note:
6Aug19 / 12Aug19	

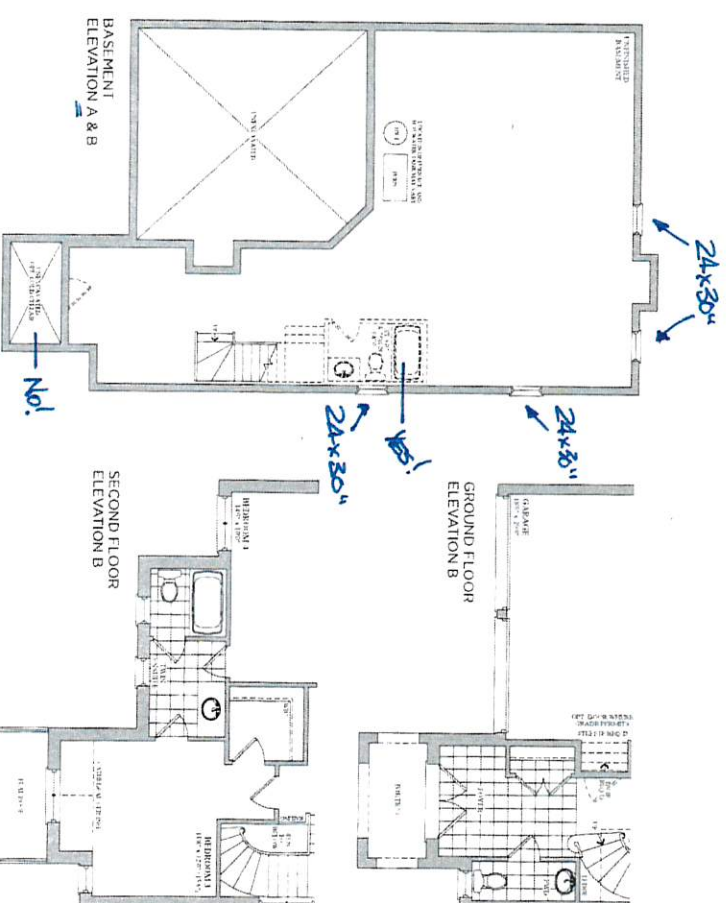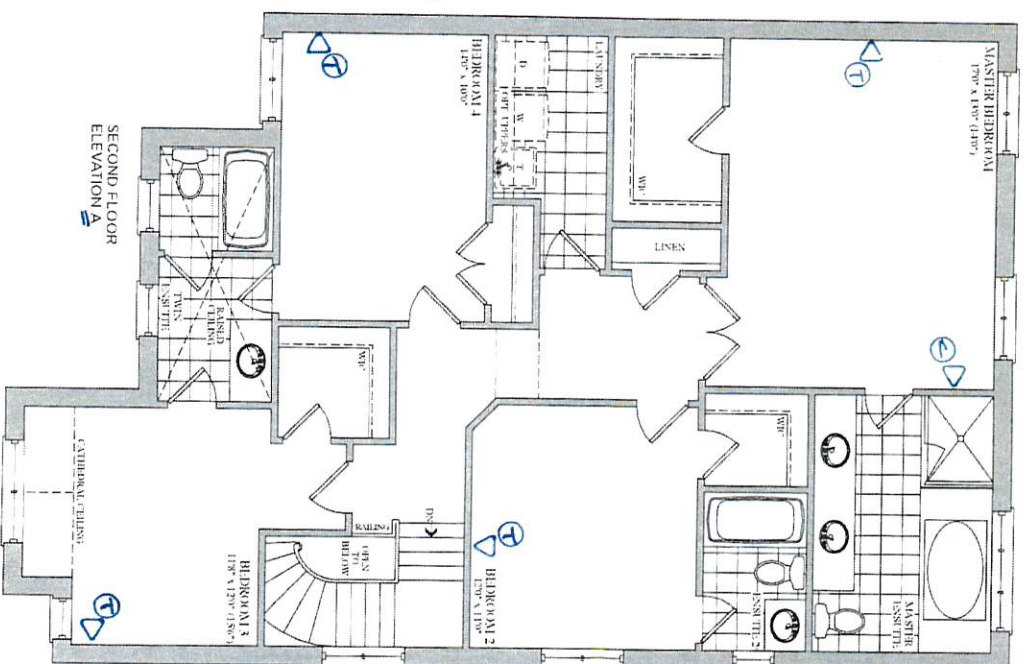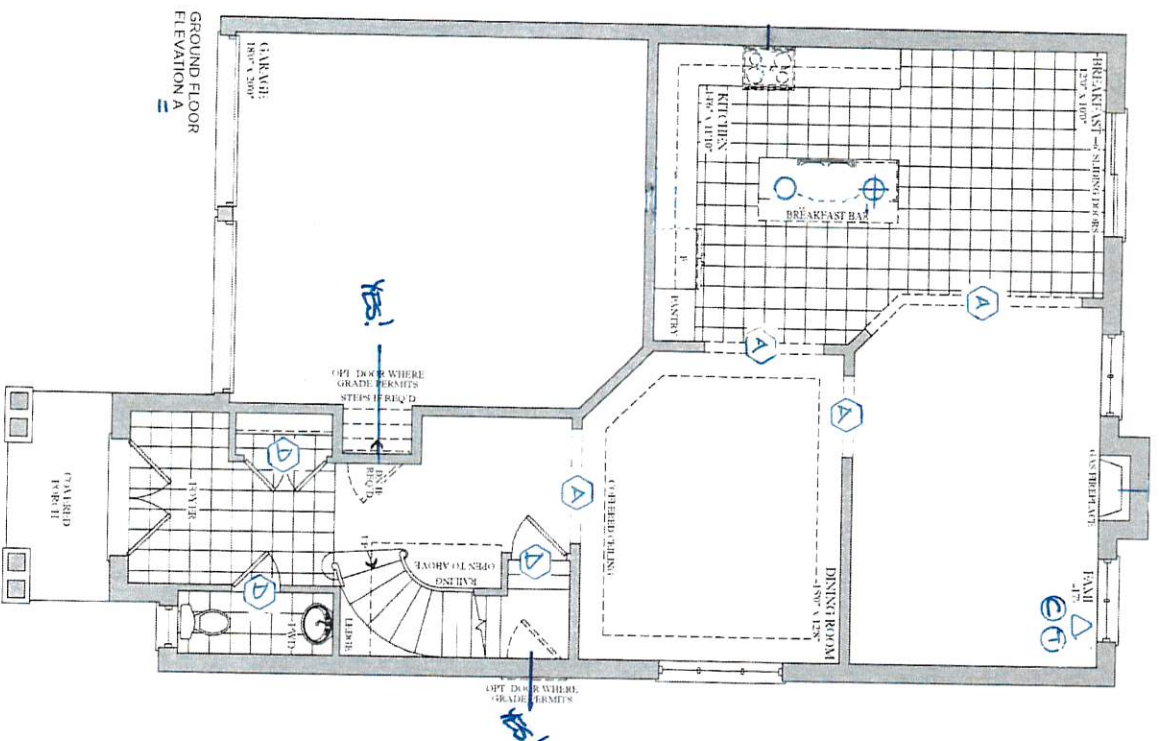

BE2-101
Aug. 6 2019
REVISED August 16 2019

Elevation A • 2,518 sq.ft. Elevation B • 2,518 sq.ft.

The Vivaldi

For more information, please contact the architect or the contractor. The architect is responsible for the design and the contractor is responsible for the construction. The architect is not responsible for the construction of the building.