

Brampton Encore - 93 - 2 - 38-6 Elev.B SCARLATTI OPT- GFA1

Inv.1,992	1 - KITCHEN BACKSPLASH: UPGRADE 4 MARBLE MOSAIC - PRICE INCLUDES BEHIND HOOD FAN TO CEILING
Line28278	Note:
21May19 / 24May19	

CROWN MOULDING

Inv.1,992	1 - BREAKFAST ROOM: 4-BOX WAFFLE CTR-B07
Line28178	Note:
21May19 / 24May19	
Inv.1,992	1 - FAMILY ROOM: 5 BOX WAFFLE - CTR-B07
Line28182	Note:
21May19 / 24May19	
Inv.1,992	1 - DINING ROOM: 5 BOX WAFFLE WITH OVAL -SEE PLAN FOR LAYOUT
Line28188	Note: CTR-BO7 PROFILE
21May19 / 24May19	
Inv.1,992	1 - LIVING ROOM: 6 BOX WAFFLE - SEE PLAN FOR LAYOUT
Line28190	Note: CTR-B07 PROFILE
21May19 / 24May19	

ELECTRICAL

Inv.1,992	1 - GREAT ROOM: 110V WALL RECEPTACLE ON DEDICATED CIRCUIT- LOCATE APPROX. 66" A.F.F. ABOVE FIREPLACE (FOR FUTURE TV)
Line28169	Note:
21May19 / 24May19	
Inv.1,992	1 - KITCHEN: RELOCATE STANDARD FIXTURE - LOCATE ABOVE ISLAND
Line28173	Note: SE PLAN FOR LOCATION
21May19 / 24May19	
Inv.1,992	2 - KITCHEN: ROUGH - IN CEILING OUTLET ON SAME SWITCH - DOES NOT INCLUDE FIXTURE - LOCATE ABOVE ISLAND, SEE PLAN FOR LOCATION - USE SAME SWITCH AS STANDARD CEILING LIGHT
Line28174	Note:
21May19 / 24May19	
Inv.1,992	6 - KITCHEN: POTLIGHT 4" LED (PRICED 10+)
Line28175	Note:
21May19 / 24May19	
Inv.1,992	1 - KITCHEN: SINGLE POLE SWITCH FOR POTLIGHTS
Line28176	Note:
21May19 / 24May19	
Inv.1,992	8 - FAMILY ROOM: 4" POTLIGHT LED (PRICED 10+)
Line28180	Note: SEE PLAN FOR LOCATION
21May19 / 24May19	
Inv.1,992	1 - FAMILY ROOM: SINGLE POLE SWITCH FOR POTLIGHTS
Line28181	Note:
21May19 / 24May19	
Inv.1,992	1 - KITCHEN CABINET VALANCE LIGHTS (UNDER CABINETS) - WITH STRIP LIGHTS - DOES NOT INCLUDE (AND REQUIRES) KITCHEN UPGRADE PRICING
Line28184	Note:
21May19 / 24May19	

Brampton Encore - 93 - 2 - 38-6 Elev.B SCARLATTI OPT- GFA1

Inv.1,992	1 - KITCHEN: 220V WALL RECEPTICAL ON DEDICATED CIRCUIT- FOR 4 WIRE BUILT-IN WALL OVEN - SEE PLAN FOR LOCATION
Line28185	Note:
21May19 / 24May19	
Inv.1,992	1 - KITCHEN: 110V WALL RECEPTACLE ON DEDICATED CIRCUIT - FOR MICROWAVE - MICROWAVE NOT INCLUDED LOCATE ABOVE WALL OVEN
Line28186	Note: SEE PLAN FOR LOCATION
21May19 / 24May19	
Inv.1,992	8 - LIVING ROOM: 4" POTLIGHT - LED (PRICED 10+)
Line28191	Note:
21May19 / 24May19	
Inv.1,992	1 - LIVING ROOM: SINGLE POLE SWITCH FOR POTLIGHTS
Line28192	Note:
21May19 / 24May19	
Inv.1,992	2 - FOYER: ROUGH - IN WALL OUTLET ON SAME SWITCH - DOES NOT INCLUDE FIXTURE - LOCATE APPROX. 80" A.F.F. SEE PLAN FOR LOCATION
Line28193	Note:
21May19 / 24May19	
Inv.1,992	1 - FOYER: SINGLE POLE SWITCH FOR WALL SCONCES
Line28194	Note:
21May19 / 24May19	
Inv.1,992	1 - KITCHEN: CYCLONE 36" CHIMNEY-STYLE HOOD FAN - STAINLESS STEEL #SCB50036
Line28195	Note:
21May19 / 24May19	
Inv.1,992	10 - EXTERIOR: 4" LED SOFFIT LIGHTS
Line28208	Note: 4 AT FRONT 2 AT LEFT SIDE 2 AT RIGHT SIDE 2 AT REAR
21May19 / 24May19	
Inv.1,992	1 - FOYER: SINGLE POLE SWITCH (FOR SOFFIT LIGHTS)
Line28255	Note:
21May19 / 24May19	
Inv.2,045	1 - EXTERIOR: 4" LED SOFFIT POT LIGHT
Line28982	Note:
13Aug19 / 14Aug19	

FORMING

Inv.1,992	1 - SIDE DOOR- HOME TO EXTERIOR- AS PER PLAN AND GRADE PERMITTING
Line28276	Note: INCLUDED IN APS
21May19 / 24May19	

FRAMING

Inv.1,992	1 - SMOOTH CEILINGS - (3-Story Design) GROUND FLOOR
Line28171	Note:
21May19 / 24May19	
Inv.1,992	1 - SMOOTH CEILINGS - (2-Story Design) 2ND FLOOR
Line28172	Note:
21May19 / 24May19	

BE2-93
Aug 13 2019


(C)



FRONT

TO BE USED FOR
* SOFFIT LIGHT LOCATION ONLY *

② FEB-03
Aug 13 2009

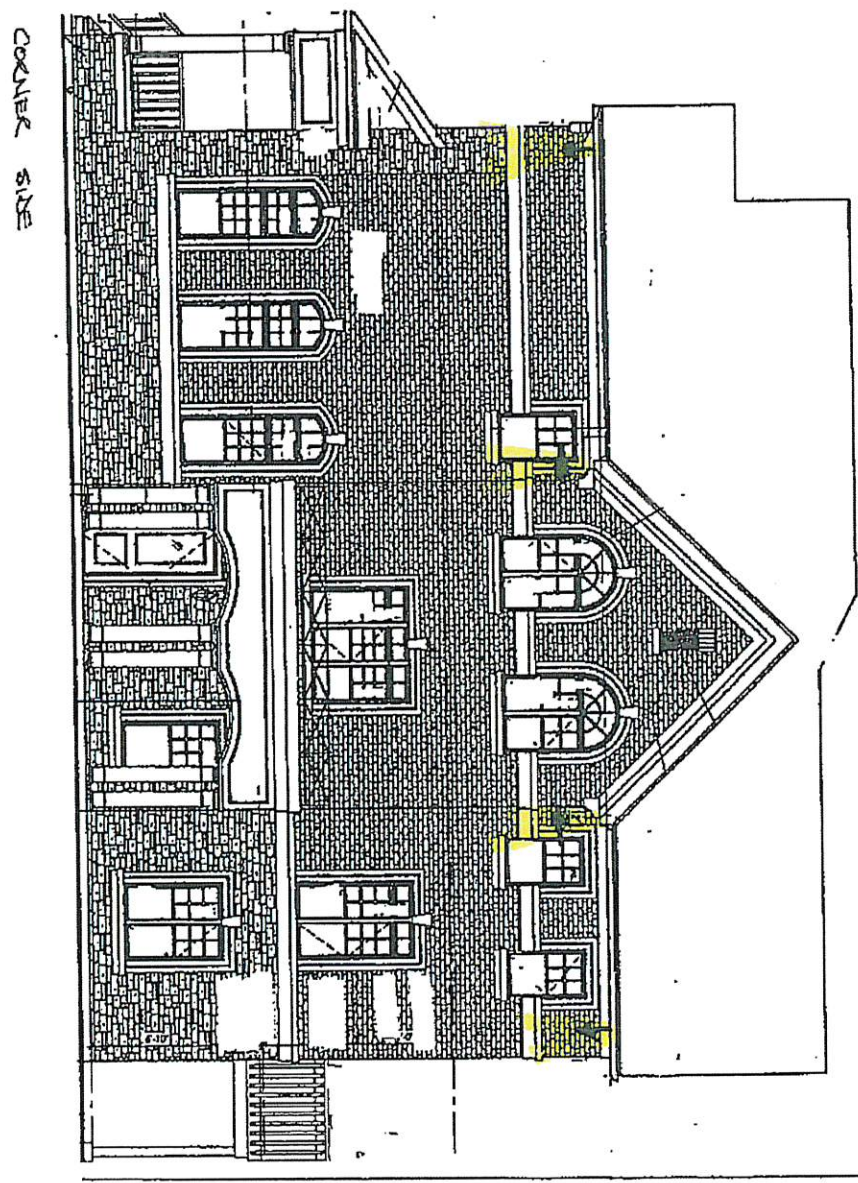

CORNER SIDE



① at side
between houses
Centered

REAR

BEZ-93 ⑩
Aug 13 2019