

Brampton Encore - 100 - 2 - 38-2 Elev.B RAVEL

CENTRAL VAC AND WIRING

Inv.2,041	1 - FAMILY ROOM: CONDUIT PIPE- FOR TELEVISION- LOCATE APPROX. 66" A.F.F. ABOVE FIREPLACE, TERMINATE AT CABLE
Line28884	Note:
9Aug19 / 14Aug19	

CERAMIC

Inv.2,041	1 - KITCHEN BACKSPLASH: UPGRADE 4 MARBLE MOSAIC SPLASH, INCLUDES BEHIND HOOD FAN TO CEILING
Line28917	Note:
9Aug19 / 14Aug19	
Inv.2,041	1 - FOYER / POWDER / KITCHEN/BREAKFAST: UPGRADE 4 FLOOR TILE - 12X24" LAID IN STRAIGHT, STACKED PATTERN - SEE PLAN FOR DIRECTION
Line28918	Note:
9Aug19 / 14Aug19	
Inv.2,041	1 - MASTER ENSUITE: UPGRADE 2 FLOOR TILE - 12X24" LAID IN STRAIGHT, STACKED PATTERN - SEE PLAN FOR DIRECTION
Line28919	Note:
9Aug19 / 14Aug19	
Inv.2,041	1 - MAIN BATHROOM: UPGRADE 2 FLOOR TILE - 12X24" LAID IN STRAIGHT, STACKED PATTERN - SEE PLAN FOR DIRECTION
Line28920	Note:
9Aug19 / 14Aug19	

ELECTRICAL

Inv.2,041	1 - FAMILY ROOM: 110V WALL RECEPTACLE ON DEDICATED CIRCUIT- LOCATE APPROX. 66" AF.F ABOVE FIREPLACE
Line28885	Note:
9Aug19 / 14Aug19	
Inv.2,041	1 - KITCHEN: RELOCATE STANDARD FIXTURE - LOCATE ABOVE ISLAND, SEE PLAN FOR LOCATION
Line28886	Note:
9Aug19 / 14Aug19	
Inv.2,041	1 - KITCHEN: ROUGH - IN CEILING OUTLET ON SAME SWITCH - DOES NOT INCLUDE FIXTURE - LOCATE ABOVE ISLAND, USE SAME SWITCH AS STANDARD CEILING LIGHT
Line28887	Note:
9Aug19 / 14Aug19	
Inv.2,041	1 - KITCHEN: 110V WALL RECEPTACLE ON DEDICATED CIRCUIT - GAS FIRED APPLIANCE - FOR AUX. EQUIPMENT - NOT A STOVE PLUG
Line28889	Note:
9Aug19 / 14Aug19	
Inv.2,041	1 - KITCHEN: CYCLE CHIMNEY STYLE HOOD FAN #SCB50030
Line28892	Note:
9Aug19 / 14Aug19	
Inv.2,041	1 - 200 AMP ELECTRICAL SERVICE
Line28893	Note:
9Aug19 / 14Aug19	
Inv.2,043	5 - KITCHEN: 4" LED POTLIGHT (10+)
Line28954	Note:
12Aug19 / 14Aug19	

Brampton Encore - 100 - 2 - 38-2 Elev.B RAVEL

Inv.2,043	1 - KITCHEN: SINGLE POLE SWITCH
Line28956	Note: FOR POTLIGHTS
12Aug19 / 14Aug19	
Inv.2,043	6 - FAMILY ROOM: 4" LED POTLIGHT (10+)
Line28957	Note:
12Aug19 / 14Aug19	
Inv.2,043	1 - FAMILY ROOM: SINGLE POLE SWITCH
Line28958	Note: FOR POTLIGHTS
12Aug19 / 14Aug19	
Inv.2,043	4 - DINING ROOM: 4" LED POTLIGHT (10+)
Line28959	Note:
12Aug19 / 14Aug19	
Inv.2,043	1 - DINING ROOMM: SINGLE POLE SWITCH FOR POTLIGHTS
Line29006	Note:
12Aug19 / 14Aug19	
Inv.2,043	1 - *DELETE* COFFERED CEILING IN FAMILY ROOM
Line29008	Note: DELETE ITEM 28,850 28896 FROM ODER #2041
12Aug19 / 14Aug19	

FRAMING

Inv.2,041	1 - FAMILY ROOM: OPTIONAL COFFERED CEILING - FAMILY ROOM (PER ROOM AS PER PLAN)
Line28896	Note:
9Aug19 / 14Aug19	
Inv.2,041	1 - MASTER ENSUITE: SHOWER STALL SHAMPOO SHELF -12X14"
Line28897	Note:
9Aug19 / 14Aug19	

GARAGE DOORS

Inv.2,041	2 - GARAGE DOOR OPENER - WITH 1 REMOTE- PRICE IS PER DOOR *BELT DRIVE*
Line28899	Note:
9Aug19 / 14Aug19	
Inv.2,041	1 - GARAGE: DIGITAL ENTRY KEYPAD
Line28900	Note:
9Aug19 / 14Aug19	

GLASS AND MIRROR

Inv.2,041	1 - MASTER ENSUITE: CONVERT FRAMED SHOWER TO 10MM FRAMLESS SHOWER ENCLOSURE WITH DOOR AND 10MM SIDE PANEL
Line28898	Note:
9Aug19 / 14Aug19	

GRANITE MARBLE QUARTZ

Inv.2,041	1 - KITCHEN: UPGRADE 1 QUARTZ COUNTER TOP
Line28915	Note:
9Aug19 / 14Aug19	

Brampton Encore - 100 - 2 - 38-2 Elev.B RAVEL

Inv.2,041	1 - KITCHEN ISLAND: FLUSH BREAKFAST BAR
Line28916	Note:
9Aug19 / 14Aug19	

HARDWOOD

Inv.2,041	1 - MAIN FLOOR: FAMILY/DINING/MAIN HALL/ LANDINGS: UPGRADE 4 HARDWOOD FLOOR: VINTAGE 3/4 X 5" WHITE OAK HAND SCRAPED
Line28922	Note:
9Aug19 / 14Aug19	
Inv.2,041	1 - UPPER HALL: UPGRADE 4 HARDWOOD FLOOR: VINTAGE 3/4 X 5" WHITE OAK HAND SCRAPED
Line28923	Note:
9Aug19 / 14Aug19	
Inv.2,041	1 - MASTER BEDROOM / BEDROOM 2 / BEDROOM 3 / BEDROOM 4: UPGRADE 4 HARDWOOD FLOOR: VINTAGE 3/4 X 5" WHITE OAK HAND SCRAPED
Line28924	Note:
9Aug19 / 14Aug19	

HVAC

Inv.2,041	1 - KITCHEN: GAS LINE ROUGH - GROUND FLOOR OF 2 STORY HOUSE
Line28888	Note:
9Aug19 / 14Aug19	
Inv.2,041	1 - HUMIDIFIER: WB3 - 17 (UP TO 3,000 SQ.FT.)
Line28901	Note:
9Aug19 / 14Aug19	
Inv.2,041	1 - A/C UNIT - 2.5 TONNE
Line28902	Note:
9Aug19 / 14Aug19	

KITCHEN AND BATH CABINETRY

Inv.2,041	1 - KITCHEN: SLIDE IN RANGE PREP - 30"
Line28890	Note: leave opening for 'typical' 30" slide in range. Purchaser will not provide specs and acknowledges that IF their stove doesn't fit they will be accountable for additional charges.
9Aug19 / 14Aug19	
Inv.2,041	1 - KITCHEN: DELETE UPPERS, FINISH SIDES OF CABINETS. LEAVE APPROX. 36" FOR 30" CHIMNEY-STYLE HOOD FAN
Line28891	Note:
9Aug19 / 14Aug19	
Inv.2,041	1 - KITCHEN: UPGRADE 3 PROFILE - OAK
Line28909	Note:
9Aug19 / 14Aug19	
Inv.2,041	1 - KITCHEN: PREMIUM COLOUR - SPRAY
Line28910	Note:
9Aug19 / 14Aug19	
Inv.2,041	2 - KITCHEN: POTS AND PANS DRAWERS - 1 SHALLOW TOP DRAWER + 2 DEEP DRAWERS BELOW
Line28911	Note:
9Aug19 / 14Aug19	

Brampton Encore - 100 - 2 - 38-2 Elev.B RAVEL

Inv.2,041	2 - KITCHEN: 2 TIER SPICE PULL OUT
Line28912	Note:
9Aug19 / 14Aug19	
Inv.2,041	1 - KITCHEN: UPGRADE HARDWARE
Line28913	Note:
9Aug19 / 14Aug19	
Inv.2,041	1 - KITCHEN: SINGLE DOOR, SHALLOW PANTRY (PRICE INCLUDES 2 FINISHED GABLES)
Line28914	Note:
9Aug19 / 14Aug19	
Inv.2,041	1 - LAUNDRY: OPTIONAL UPPER CABINETS (STANDARD LEVEL)
Line28921	Note:
9Aug19 / 14Aug19	

MISC.

Inv.2,041	1 - Purchaser has attended an appointment at the Decor Centre & has DECLINED any additional upgrades and accepts and acknowledges that there will be no further changes/additions/deletions to be made upon signing on AUGUST 9, 2019.
Line28928	Note:
9Aug19 / 14Aug19	
Inv.2,041	1 - Purchasers are aware & accepts that ANY changes made to upgrades after signing this Purchasers Extra Form are subject to a minimum administration fee of \$500. PLUS a 10% holdback fee.
Line28929	Note:
9Aug19 / 14Aug19	
Inv.2,041	1 - BONUS PACKAGE: \$10,000.00 (INCLUDING TAXES) WORTH OF UPGRADES FROM GOLD PARK HOMES DÉCOR CENTRE IS BEING APPLIED TOWARD THIS ORDER. PURCHASER HAS A REMAINING AMOUNT OF \$00 (INCLUDING TAXES).
Line28930	Note:
9Aug19 / 14Aug19	
Inv.2,043	1 - Purchasers are aware & accepts that ANY changes made to upgrades after signing this Purchasers Extra Form are subject to a minimum administration fee of \$500. PLUS a 10% holdback fee.
Line28960	Note:
12Aug19 / 14Aug19	
Inv.2,043	1 - ADMIN FEE FOR LATE CHANGES
Line29009	Note:
12Aug19 / 14Aug19	

PAINT

Inv.2,041	1 - MAIN STAIRS: STAIN STAIRS TO MATCH HARDWOOD FLOORS AS CLOSE AS POSSIBLE
Line28926	Note: STAIRS WILL NOT MATCH FLOORS IN COLOUR/ TEXTURE OR SPECIES
9Aug19 / 14Aug19	

PLUMBING

Inv.2,041	1 - ROUGH-IN - 3PC BASEMENT ROUGH-IN
Line28894	Note:
9Aug19 / 14Aug19	
Inv.2,041	1 - KITCHEN: ROUGH-IN - WATERLINE FOR FRIDGE
Line28908	Note:
9Aug19 / 14Aug19	

Brampton Encore - 100 - 2 - 38-2 Elev.B RAVEL

Inv.2,043	1 - MASTER ENSUITE: *DELETE* FRAMELESS SHOWER INSTALL STANDARD FRAMED SHOWER
Line29007	Note: DELETE ITEM 28,868 28898 FROM RODER #2041
12Aug19 / 14Aug19	

PLUMBING FIXTURES

Inv.2,041	1 - KITCHEN SINK: BLANCO QUATRUS R15 U 1-3/4 #401520
Line28927	Note:
9Aug19 / 14Aug19	

STAIRS AND RAILINGS

Inv.2,041	1 - MAIN STAIRS: EUROLINE 2 + V GROOVE
Line28925	Note:
9Aug19 / 14Aug19	

WINDOWS - BASEMENT

Inv.2,041	3 - BASEMENT WINDOWS - UPGRADE EXISTING BASEMENT WINDOW TO 30 INCH X 24 INCH - MAY REQUIRE INSTALLATION OF WINDOW WELL
Line28895	Note:
9Aug19 / 14Aug19	

BE2-100
Aug 9 2019


(M) (JLB)

BE2-100
August 12 2019


(JLB) (JLB)

REVISED
Aug 13 2019

(JLB) (JLB)

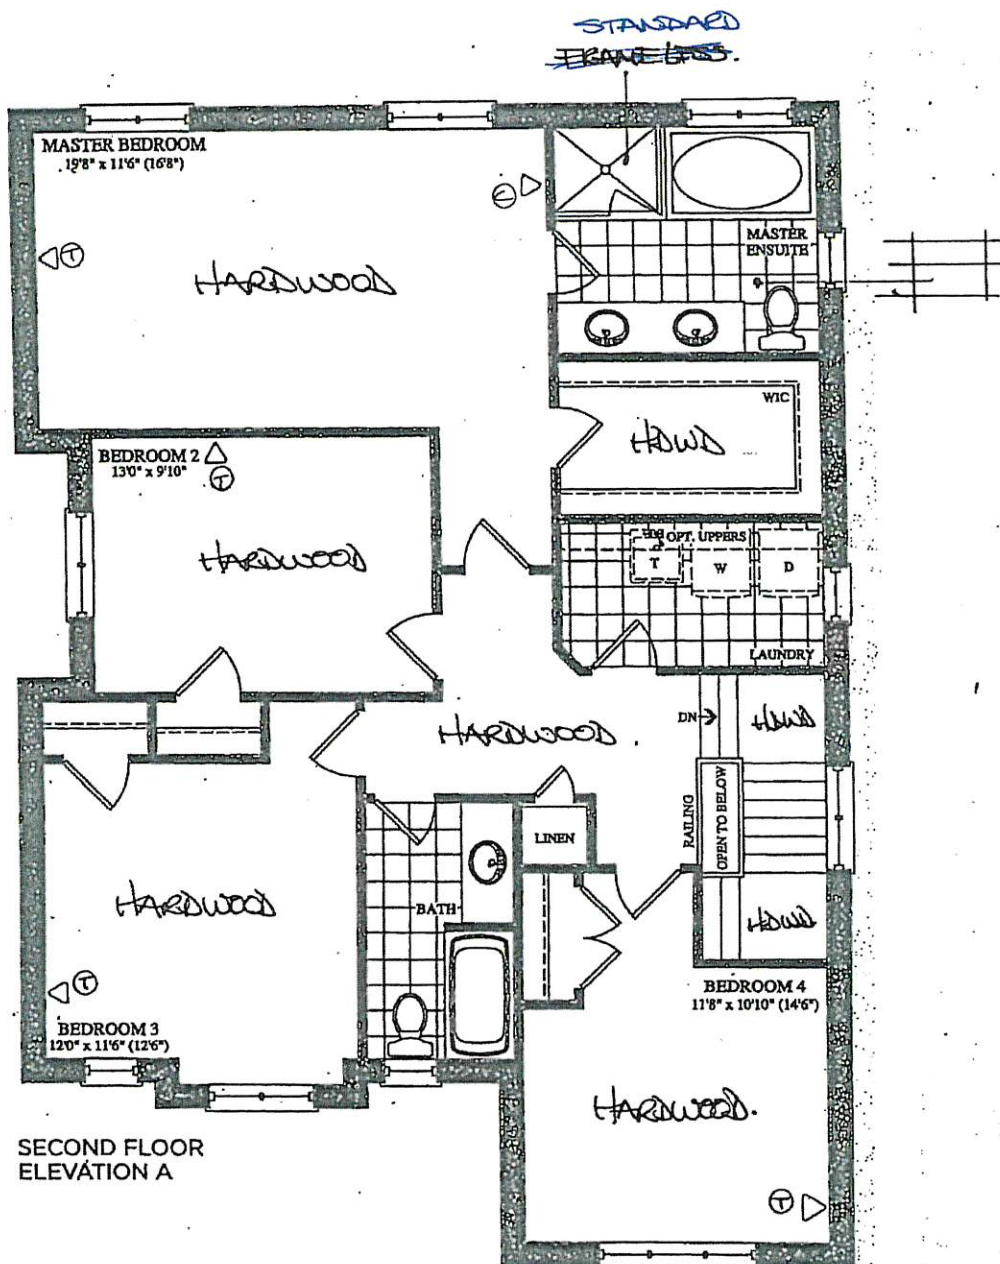

SECOND FLOOR
ELEVATION A

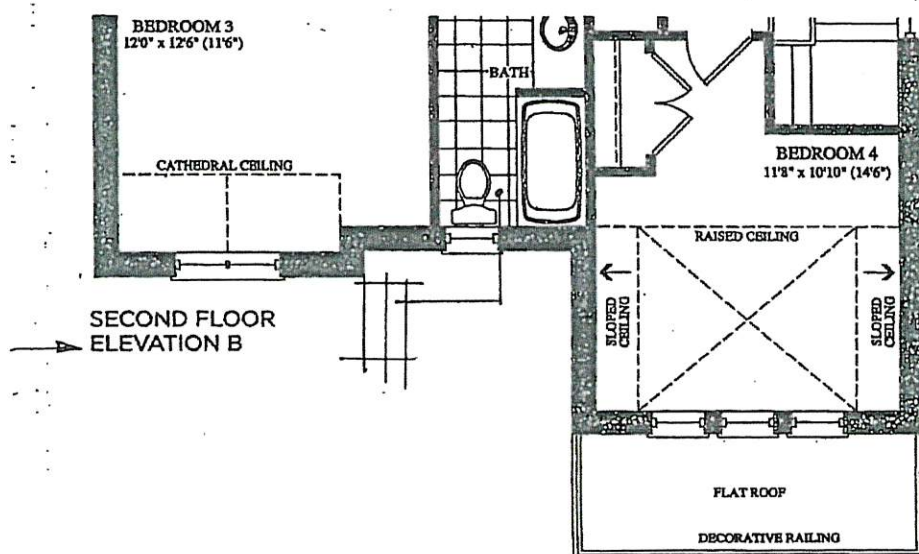


SECOND FLOOR
ELEVATION B

The Ravel

Elevation A • 2,322 sq.ft. | Elevation B • 2,322 sq.ft.

Prices, figures, illustrations, sizes, features and finishes are subject to change without notice. E.A.O.E. Areas and dimensions are approximate and actual usable floor space may vary from the stated area. Layout may be reverse of the unit purchased. E & O.E.

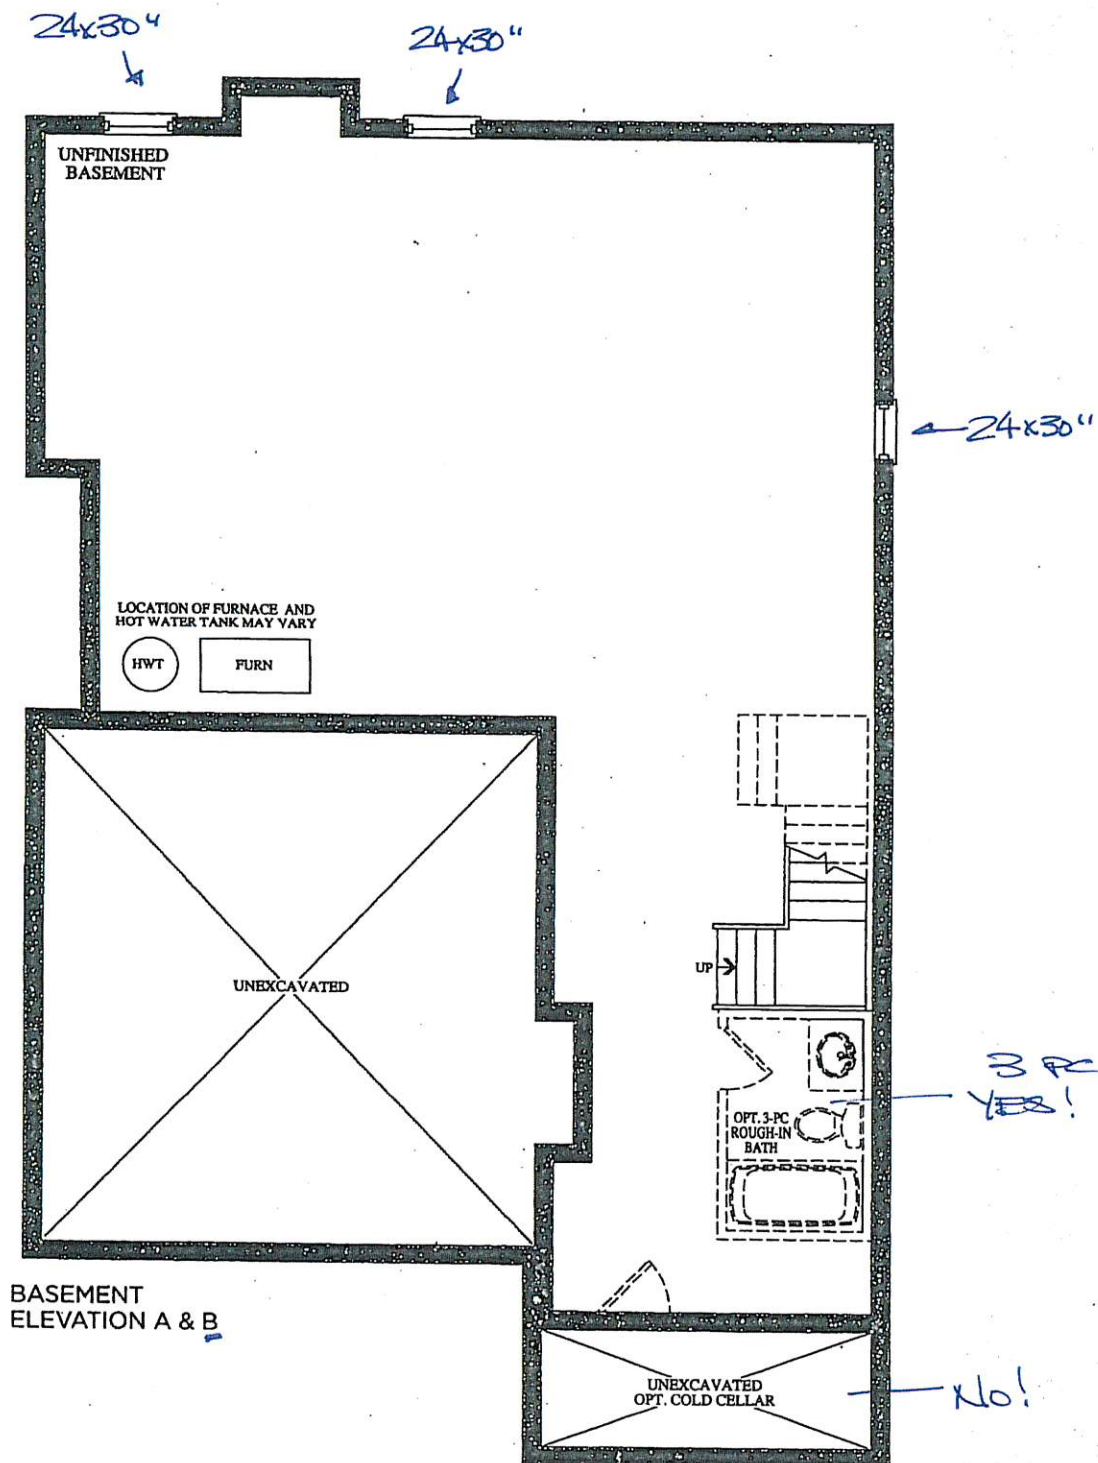

BASEMENT
ELEVATION A & B

BE2-100

AUG 9 2019

CP

CP

The Ravel

Elevation A • 2,322 sq.ft. | Elevation B • 2,322 sq.ft.

Prices, figures, illustrations, sizes, features and finishes are subject to change without notice. E.S.O.E. Areas and dimensions are approximate and actual usable floor space may vary from the stated area. Layout may be reverse of the unit purchased. E. & O.E.



The Ravel

Elevation A • 2,322 sq.ft. **Elevation B • 2,322 sq.ft.**

Prices, figures, illustrations, sizes, features and finishes are subject to change without notice. E.&O.E. Areas and dimensions are approximate and actual usable floor space may vary from the stated area. Layout may be reverse of the unit purchased. E. & O.E.

Purchaser: Clyde Carl Persad & Chintah Persad

Property: 100

Telephone Res. / Bus: /

Project: Brampton Encore - Phase 2

Decor Advisor: Yolande Somerville

Model and Elevation: 38-2 Elev.B RAVEL

Layout Changes: ☐ Yes ☒ No

Sketch Attached: ☒ Yes ☐ No

Exterior Colour Scheme:

1. Cabinetry

	Style and Colour	Counter	Hardware
Kitchen / Breakfast	*Windsor oak 'Graphite'	*Quartz 'Silky White'	*CH-48
Laundry Room	*Varese pvc 'Mystic'	n/a	cs1-23
Powder Room	n/a	n/a	n/a
Main Bathroom	*Varese pvc 'Mystic'	P-Lam #6696-46	cs1-23
Master Ensuite Bathroom	*Varese pvc 'Mystic'	P-Lam #6696-46	cs1-23
Second Ensuite Bathroom (If Applicable)	n/a	n/a	n/a

Comment

2. Floor Tile

	Selection
Entrance Vestibule	*12x24" Carrara X polished 'White'
Main Hall	n/a
Kitchen / Breakfast	*12x24" Carrara X polished 'White'
Laundry Room	13x13" New Albion 'Grey'
Powder Room	*12x24" Carrara X polished 'White'
Main Bathroom	*12x24" New Byzantine 'Azzuro Blue'
Master Ensuite Bathroom	*12x24" New Byzantine 'Azzuro Blue'
Second Ensuite Bathroom (If Applicable)	n/a
Lower Landing (If Applicable)	n/a

Comment

3. Wall Tile

	Selection	Listello/Inserts	Describe
M.Ens Tub skirt/splash	8x10" Weave 'White'	☐ Yes ☒ No	
Master Ensuite Bathroom			
Tub Deck	8x10" Weave 'White'	☐ Yes ☒ No	
Shower Stall	8x10" Weave 'White'	☐ Yes ☒ No	
Bathroom Walls	n/a	☐ Yes ☒ No	
Second Ensuite Bathroom (If Applicable)		☐ Yes ☒ No	
Main Bath	8x10" Weave 'White'	☐ Yes ☒ No	
Kitchen Backsplash	☒ Yes ☐ No	Backsplash Behind Fridge	
	*Oriental White 1x3" Chevron		

Comment

Scheduled Closing Date: Wednesday, March 21, 2018

Purchaser: Clyde Carl Persad & Chintah Persad

Property: 100

Telephone Res. / Bus: /

Project: Brampton Encore - Phase 2

Decor Advisor: Yolande Somerville

Model and Elevation: 38-2 Elev.B RAVEL

4. Plumbing Fixtures

☐	Second Ensuite	☐	Powder Room	☐
Master Ensuite Bathroom ☐	Other Room - Specify ☐	☐	Other Washroom	☐

Comment

Standard except kitchen sink

5. Hardwood Flooring

Main Hall	Type and Stain *5" H.S. Wht Oak 'Baroque'	Upper Landing	Type and Stain *5" H.S. Wht Oak 'Baroque'
Kitchen / Breakfast	n/a	Upper Hall	*5" H.S. Wht Oak 'Baroque'
Living Room	n/a	Master Bedroom	*5" H.S. Wht Oak 'Baroque'
Dining Room	*5" H.S. Wht Oak 'Baroque'	Bedroom #2	*5" H.S. Wht Oak 'Baroque'
Family Room	*5" H.S. Wht Oak 'Baroque'	Bedroom #3	*5" H.S. Wht Oak 'Baroque'
Den/Library	n/a	Bedroom #4	*5" H.S. Wht Oak 'Baroque'
Entrance Vestibule	n/a	Bedroom #5	n/a
Lower Landing (If Applicable)	*5" H.S. Wht Oak 'Baroque'	Other Room - Specify	

Comment

6. Carpeting

	Upgrade	Description
Ground Floor	☐	
Second Floor	☐	
	☐	

Upgrade Underpad	Type	Area
Carpet on Stairs	Capped	Runner - *Upgrade

Comment

7. Fireplace

	Living Room			Family Room			Other Room - Specify		
	Purchased	As Per Plan	N/A	Purchased	As Per Plan	N/A	Purchased	As Per Plan	N/A
Fireplace Type	☐	☐	☒	☐	☒	☐	☐	☐	☒
Mantle Type				Standard Gas					
Colour / Stain				NF-20					
Surround				White					
Hearth				Grigio Carnico					
Hearth				none					

Comment

CB

CB

Purchaser: Clyde Carl Persad & Chintah Persad

Property: 100

Telephone Res. / Bus: /

Project: Brampton Encore - Phase 2

Decor Advisor: Yolande Somerville

Model and Elevation: 38-2 Elev.B RAVEL

8. Trim Carpentry

Interior Doors Front Door Glass Inserts Door Handles

Interior Trim

Comment

9. Plaster Mouldings and Medallions

Standard Throughout ☐ Yes ☐ No ☐ N/A

Entrance Vestibule Kitchen/Breakfast

Main Hall Den/Library

Living Room Lower Landing

Dining Room Other Room - Specify

Family Room

Comment

10. Railings and Spindles

Railing Package

Railing Colour

Spindle Colour

Stringer / Riser

Treads

Comment

Oak Stairs ☒ Yes ☐ No ☐ N/A

11. Wall Paint / Ceilings

Throughout Finished Areas

Trim Paint

Smooth Ceilings

Ground Floor ☒

Second Floor ☐

Note

Comment

CP

[Signature]

Scheduled Closing Date: Wednesday, March 21, 2018

Purchaser: Clyde Carl Persad & Chintah Persad

Property: 100

Telephone Res. / Bus: /

Project: Brampton Encore - Phase 2

Decor Advisor: Yolande Somerville

Model and Elevation: 38-2 Elev.B RAVEL

12. Electrical

Hood Fan ☐ White ☒ Stainless ☐ N/A

Above Kitchen Cabinet Light ☐ Yes ☒ No

Below Kitchen Cabinet Light ☐ Yes ☒ No

Standard Appliances ☐

Over The Range Microwave ☐

Chimney Style Fan ☒

Comment

13. Heating and Air Conditioning

Air Conditioning Yes ☐

Gas Provisions Stove Yes ☐

Gas Provisions Dryer NO ☐

Gas Provisions Barbecue Std ☐

Comment

14. Additional Comments

15. Disclaimers and Notes

- 1) Colours of all materials are as close as possible to builder's selection, but not necessarily identical due to variances in manufacturing.
- 2) Any extras listed above are null and void unless accompanied by a separate invoice/amendment. Said invoice must be paid in full.
- 3) The Purchaser acknowledges that after Interior Colour Selection form is signed and dated, no further changes will be permitted other than re-selection due to unavailability. _____ Purchaser's Initials
- 4) The Purchaser acknowledges reading and accepting the "Gold Park Homes Decor Centre Disclaimers" form. This document contains other miscellaneous disclaimers.

This Interior Colour Selection is final and approved by:

Signature

Date: _____

BE2-100
Aug 9 2019.







QUOTATION

Date: 06/23/16

Trade Name: Gold Park Homes	Site location: Brampton	Model: 38-2
Address:	Project: Encore	Phase:

This layout has been explained to the purchaser by Cortina Kitchens Inc. and is understood by the purchaser.

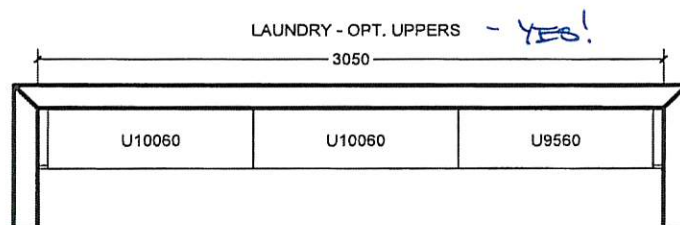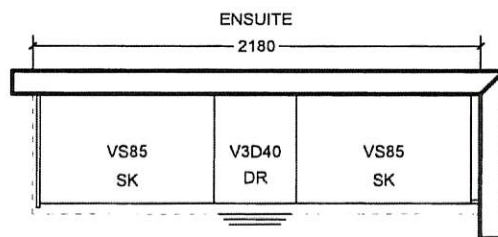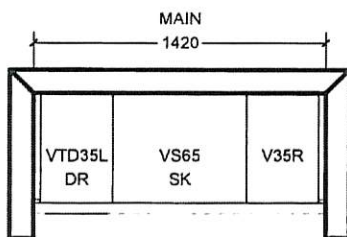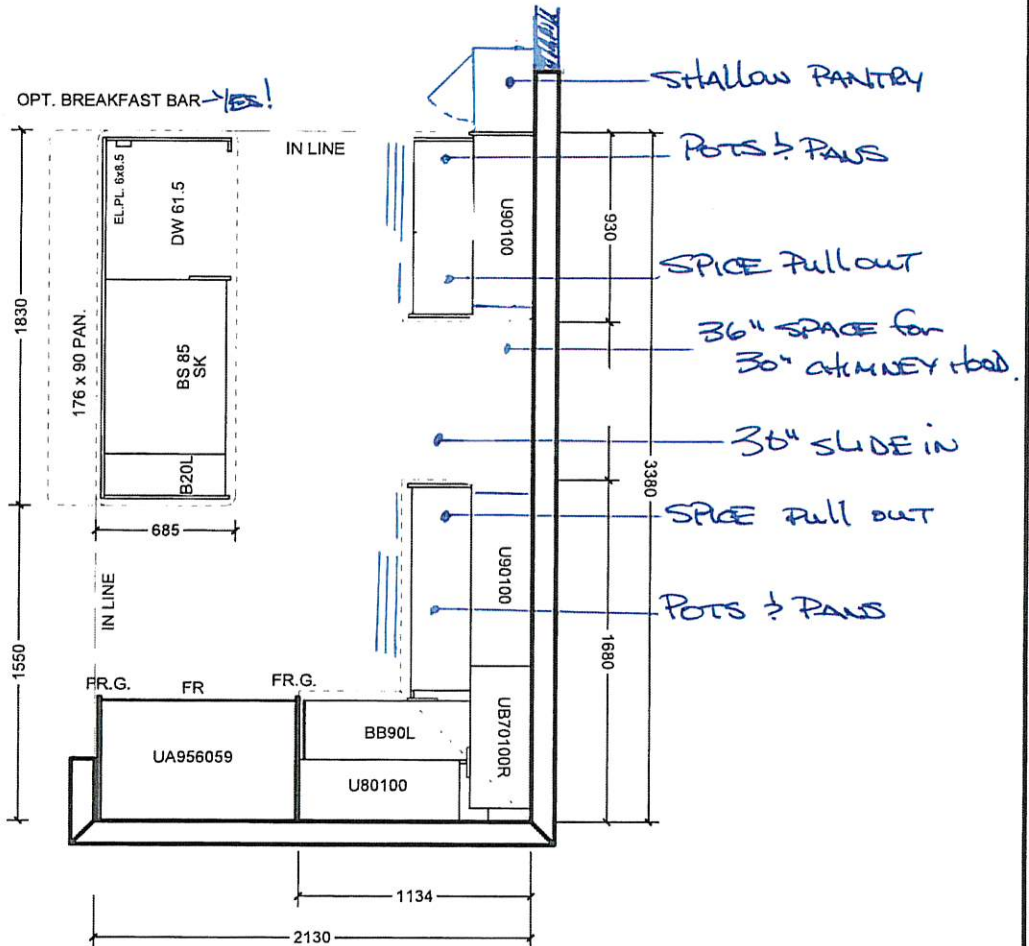

All prices subject to confirmation from head office.
This quotation is subject to the terms & conditions set out
in Cortina's Agreement of Purchase and Sale

All agreements are contingent upon strikes, accidents, and delay beyond our control.
Please provide our installer with template for sinkholes or \$150.00 will be charged for callback.

ACCEPTED DATE: _____



CUSTOMER SIGNATURE

SALESPERSON SIGNATURE

CORTINA HEAD OFFICE APPROVAL

ITEM A. Wood grain and colour are characteristics of the product, we cannot guarantee that such grain and colour will always match
ITEM B. Cortina Kitchens reserves the right to alter dimensions and make technical changes without notice.

Blanco Quatrus R-15 U 1-3/4" #401520

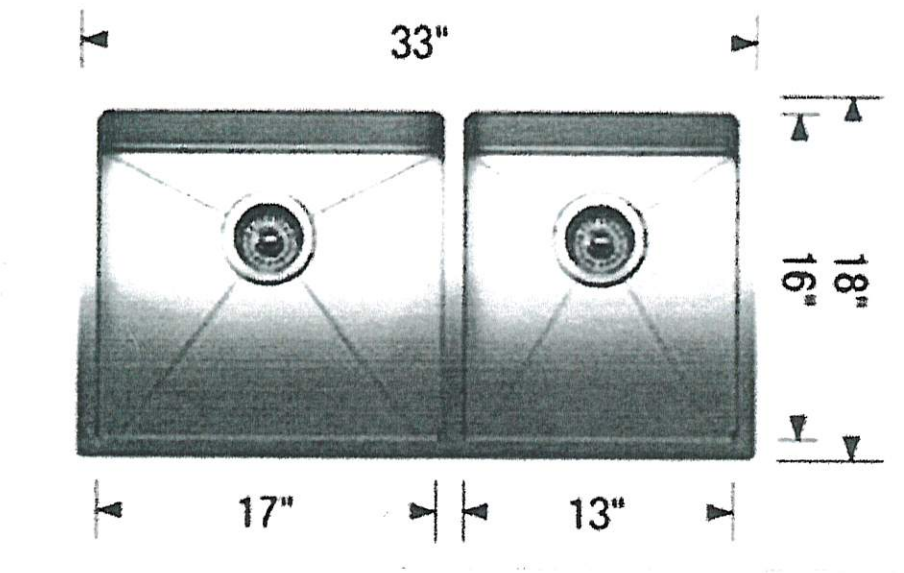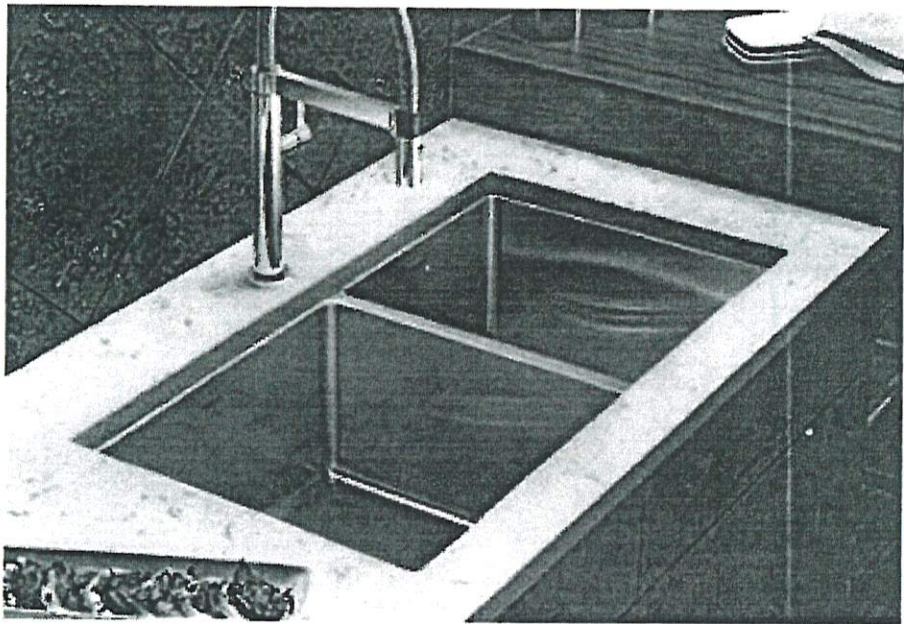


LOT #
100

ROOM:
KITCHEN


SIGNATURE:


DATE:
AUGUST 9 2019


SIGNATURE:

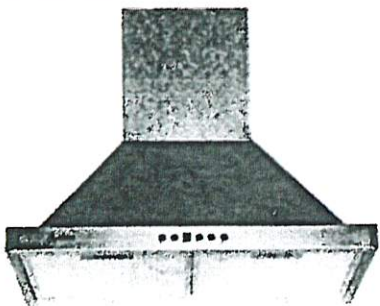24" Width Model

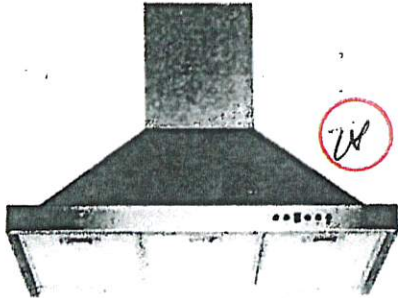

Mesh Filter

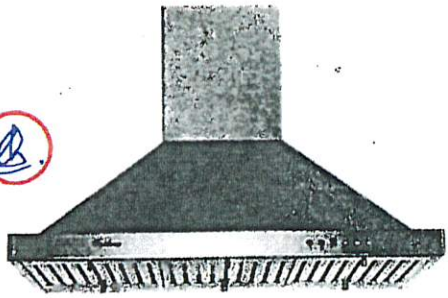



Baffle Filter

Wall Mount

Sometimes strength and beauty can co-exist. Strong and sturdy, yet attractive and unimposing, the SC500 combines the eye-pleasing design of European hoods with the power and efficiency of North American fans. A perfect match. Give your kitchen the look, feel, and capability that you have always wanted. Fitted with time-delay "OFF" options up to nine minutes, bright LED lights spaced for optimum light distribution, and a digital three-speed push button control panel.

Specifications


- Air Flow Volume: 550 CFM
- Electrical Connection: 120V/60Hz
- Electrical Consumption: 200 Watts
- Fan Speed: 1599 RPM
- Finishes: Stainless Steel
- Venting: 6" Round - Top Only
- Dimensions: Width: 24"/30"/36"
Height: 46"
Depth: 18"
- Sones: Min. 2
Max. 6

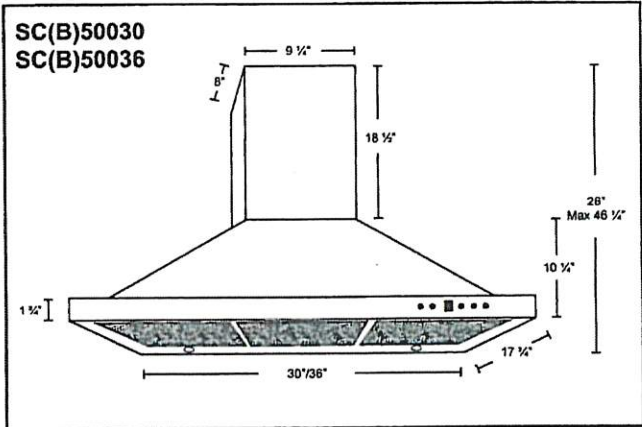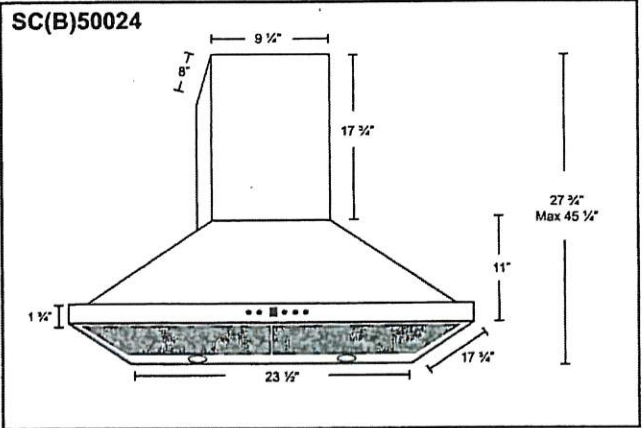

* B in the model name denotes a model with baffle filters.
SC500 - Mesh Filters SCB500 - Baffle Filters

Model	Colour	Venting	Size
SC(B)50024	Stainless Steel	6"	24"
SC(B)50030	Stainless Steel	6"	30"
SC(B)50036	Stainless Steel	6"	36"


BEZ 100
Aug 9 2019

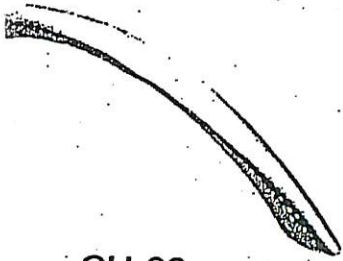


CH-32




CH-38

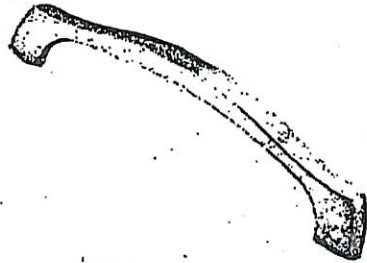


CH-44

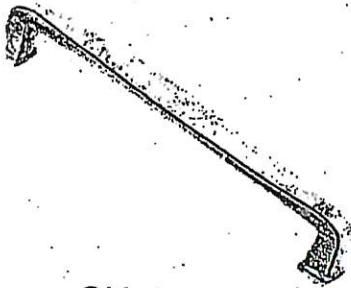


CH-45

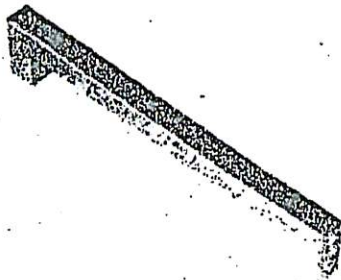


CH-46

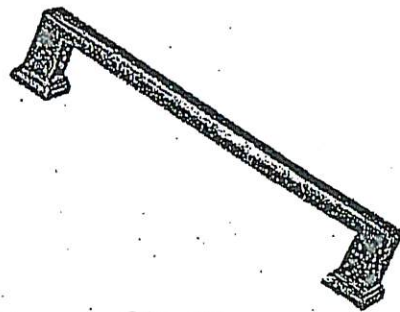

CH-47

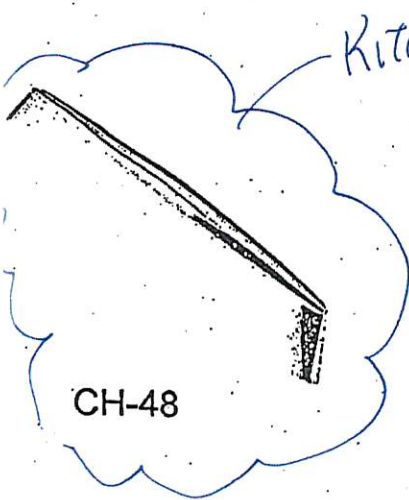


CH-48

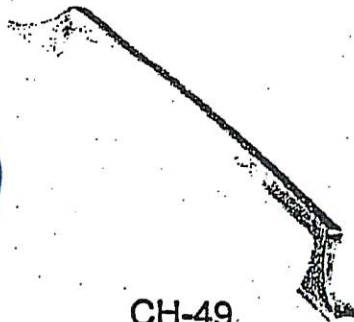


CH-49




CH-50

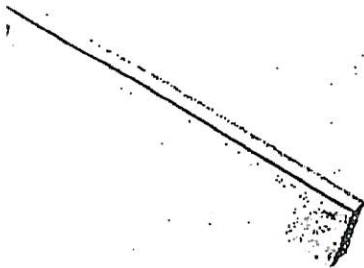

CH-51

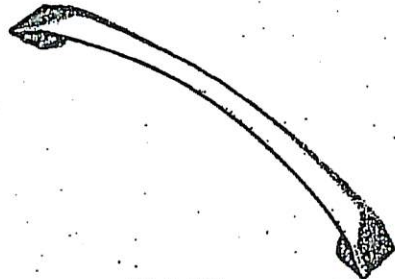


CH-52

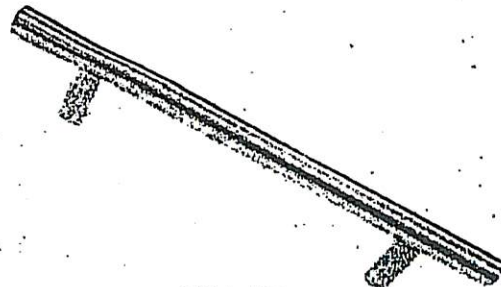

CH-53

NOTES:
IMAGES ARE FOR QUICK REFERENCE PURPOSES ONLY
ACTUAL SIZES AND FINISHES AS PER HARDWARE
SAMPLE BOARD PROVIDED TO DECOR CENTRE

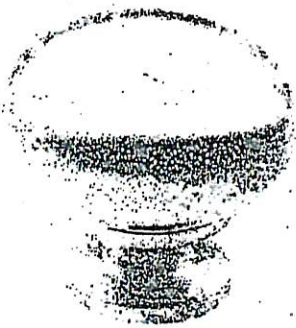

CSI-6




CSI-10




CSI-14




CSI-16

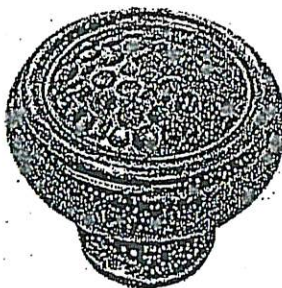


CSI-18

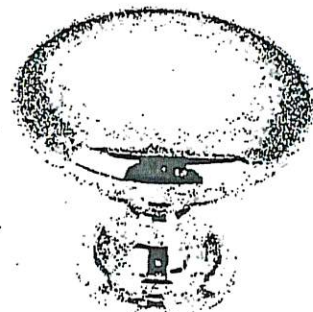

CSI-19

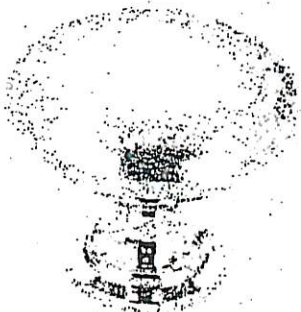

CSI-20

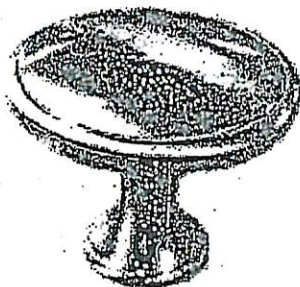


CSI-21




CSI-22


MASTER
+
MAIN
+
LAUNDRY

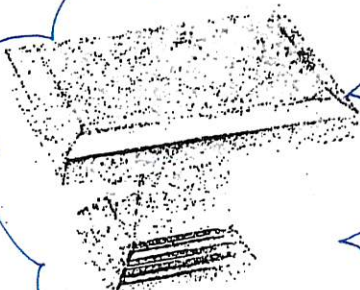

CSI-23

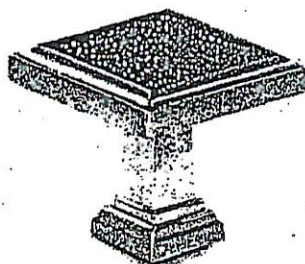

CSI-24

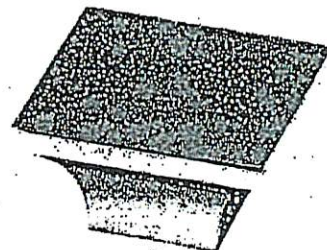

CSI-25

*NOTES:

- IMAGES ARE FOR QUICK REFERENCE PURPOSES ONLY
- ACTUAL SIZES AND FINISHES AS PER HARDWARE SAMPLE BOARD PROVIDED TO DECOR CENTRE

GOLDPARK

WORTH MORE



encore
BRANPTON

Granite, Marble,
Engineered Surfaces

- Standard 20mm & 8CM
- ⊖ Upgrade 12CM & 8CM
- ⊗ Upgrade 14CM
- ⊕ Upgrade 2


20mm (3/4") Profiles



Kitchen

- FE20
- ⊖ CZ0
- ⊗ H20
- ⊕ F20
- ⊖ N20
- ⊗ B20


30mm (1 1/4") Profiles

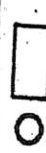

FE30

- ⊖ H30
- ⊗ C30
- ⊕ T30
- ⊖ Z30
- ⊗ B30
- ⊕ V30
- ⊗ F30

40mm (1 1/2") Profiles

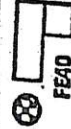

FE40

- ⊖ H40
- ⊗ Z40
- ⊕ DR40
- ⊖ T40
- ⊗ C40
- ⊕ B40
- ⊗ MITER
- ⊕ V40
- ⊗ FV40
- ⊕ FF40
- ⊗ LZ40
- ⊕ VB40
- ⊗ FZ40

Note: All colours may not be available in 30mm at time ordered. Vendor reserves the right to use 40mm edges (by lamination process).

*Mitre edge is available in Upgrade 1 for an overall thickness of 2". All other Mitre edge options will be an Upgrade 2 Edge.

DE-2-100
August 9 2019

18
CAB