

Brampton Encore - 90L - 2 - 28-7 Elev.A Wagner

CONCRETE AND DRAIN

|                   |                                                |
|-------------------|------------------------------------------------|
| Inv.2,061         | 1 - BASEMENT: ROUGH-IN - 3PC BASEMENT ROUGH-IN |
| Line29135         | Note:                                          |
| 10Sep19 / 12Sep19 |                                                |

FRAMING

|                   |                                                                |
|-------------------|----------------------------------------------------------------|
| Inv.2,061         | 1 - MANDOOR - GARAGE TO HOUSE- AS PER PLAN AND GRADE PERMITING |
| Line29134         | Note:                                                          |
| 10Sep19 / 12Sep19 |                                                                |

HVAC

|                   |                          |
|-------------------|--------------------------|
| Inv.2,062         | 1 - A/C UNIT - 2.5 TONNE |
| Line29137         | Note:                    |
| 10Sep19 / 12Sep19 |                          |

PLUMBING

|                   |                                      |
|-------------------|--------------------------------------|
| Inv.2,061         | 1 - ROUGH-IN - 3PC BASEMENT ROUGH-IN |
| Line29161         | Note:                                |
| 10Sep19 / 12Sep19 |                                      |


WINDOWS - BASEMENT

|                   |                                                                                                                        |
|-------------------|------------------------------------------------------------------------------------------------------------------------|
| Inv.2,061         | 4 - BASEMENT WINDOWS - UPGRADE EXISTING BASEMENT WINDOW TO 30 INCH X 24 INCH - MAY REQUIRE INSTALLATION OF WINDOW WELL |
| Line29136         | Note:                                                                                                                  |
| 10Sep19 / 12Sep19 |                                                                                                                        |


BE2-901  
SEPT 10 2019

# The Wagner SEMI SERIES

- Elevation A • 2,127 sq.ft.
- Elevation B • 2,117 sq.ft.
- Elevation C • 2,127 sq.ft.
- Elevation D • 2,127 sq.ft.

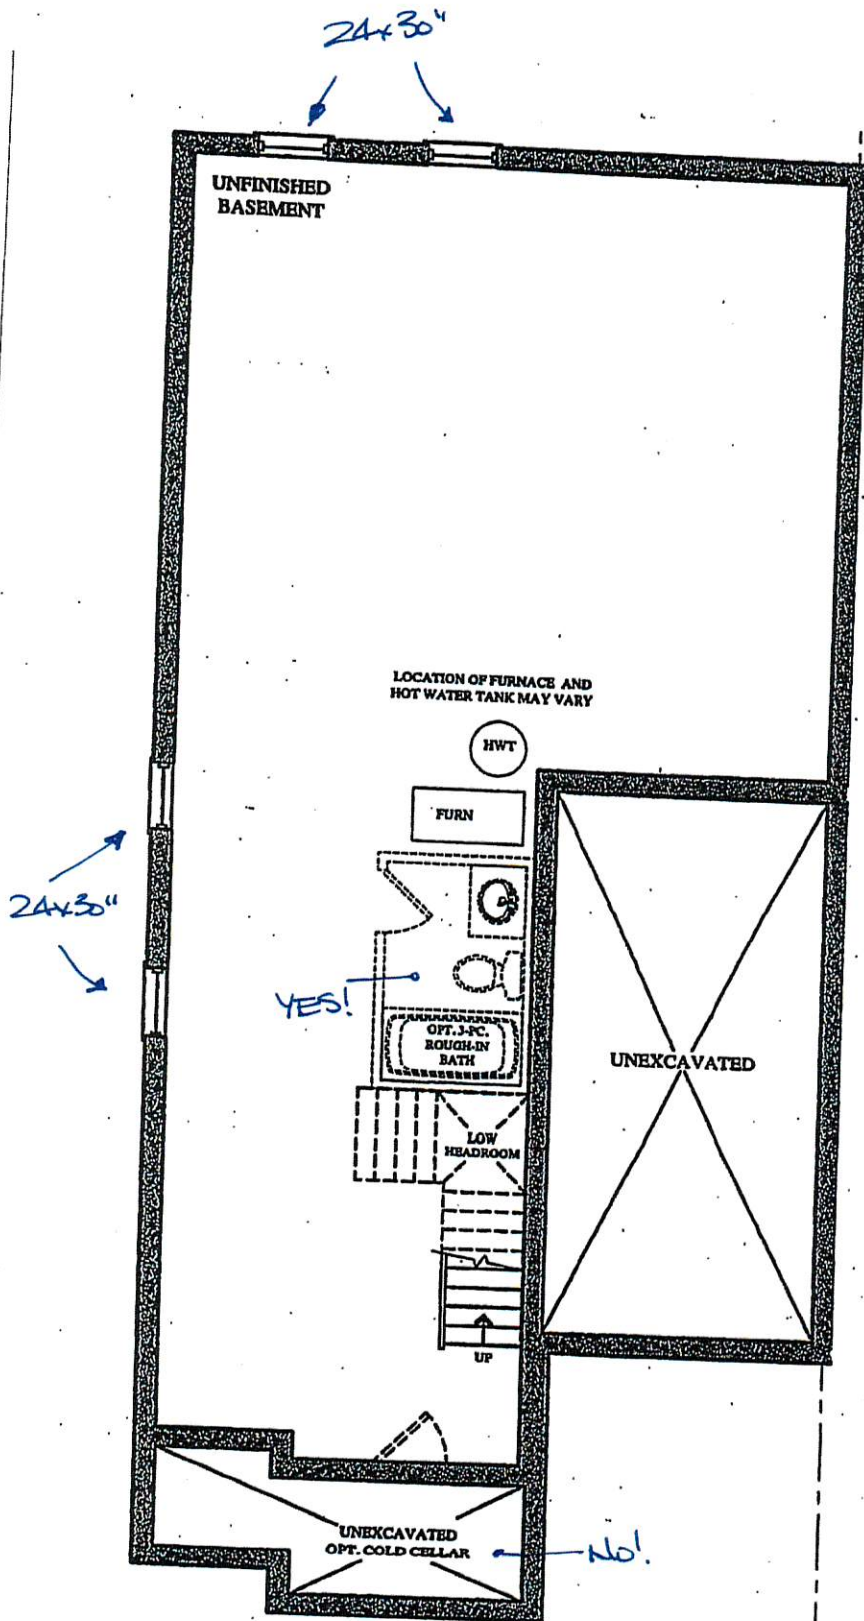

BASEMENT FLOOR PLAN  
ELEV. 'A' & 'B'

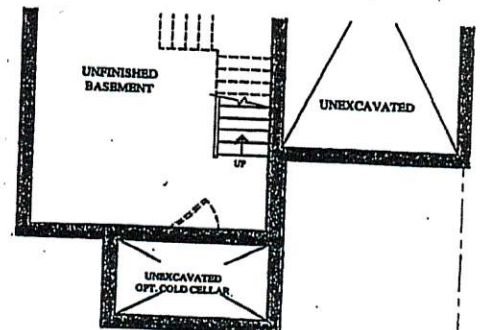


PART. BASEMENT FLOOR PLAN  
ELEV. 'C' & 'D'


BEZ-20L  
SEPT 16 2019

# The Wagner SEMI SERIES

→ Elevation A • 2,127 sq.ft.  
Elevation B • 2,117 sq.ft.  
Elevation C • 2,127 sq.ft.  
Elevation D • 2,127 sq.ft.

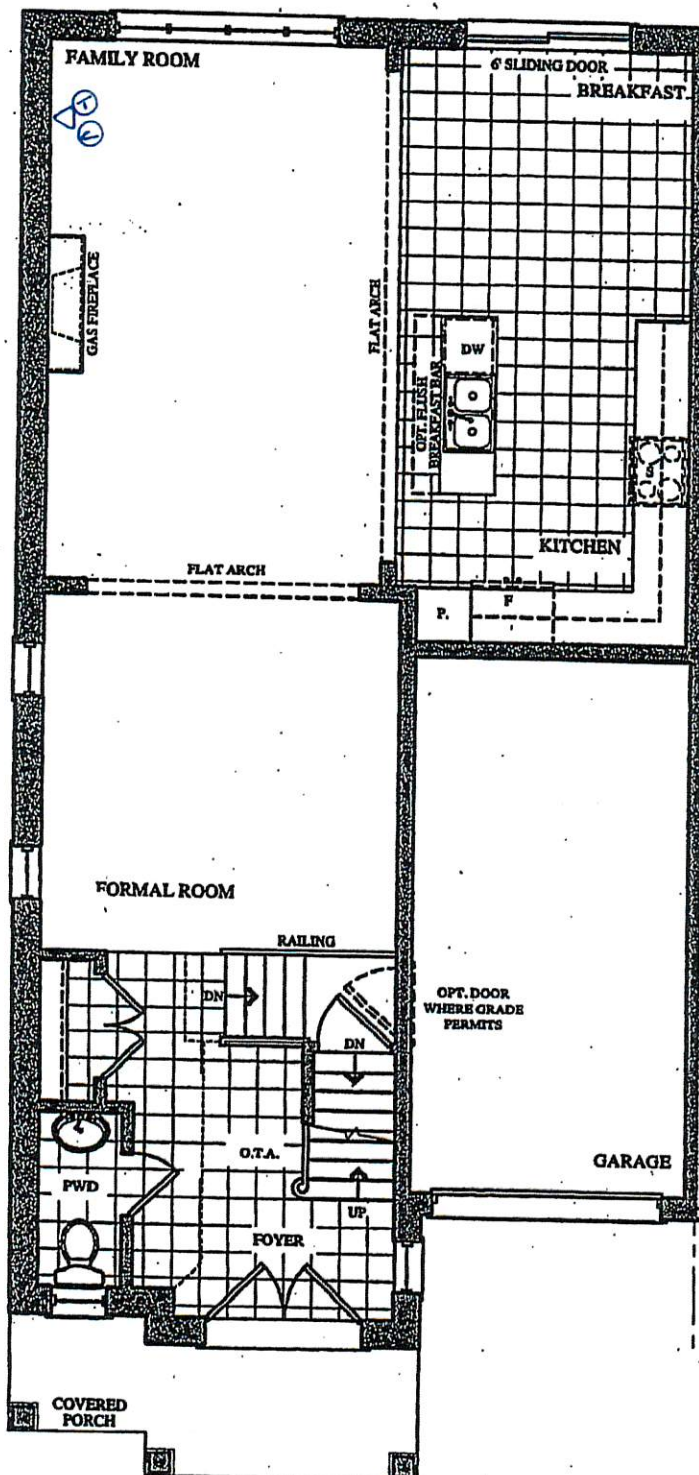

GROUND FLOOR PLAN  
ELEV. 'A' & 'B'

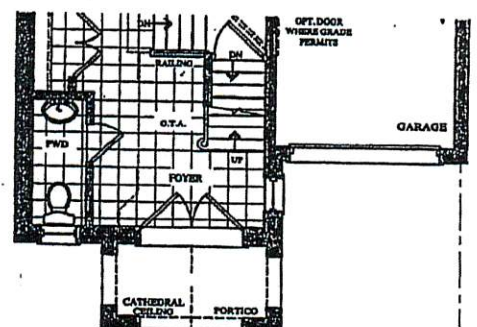


PART. GROUND FLOOR PLAN  
ELEV. 'C' & 'D'


BEZ-90L  
SEPT 10 2019

# The Wagner SEMI SERIES


→ Elevation A • 2,127 sq.ft.  
Elevation B • 2,117 sq.ft.  
Elevation C • 2,127 sq.ft.  
Elevation D • 2,127 sq.ft.

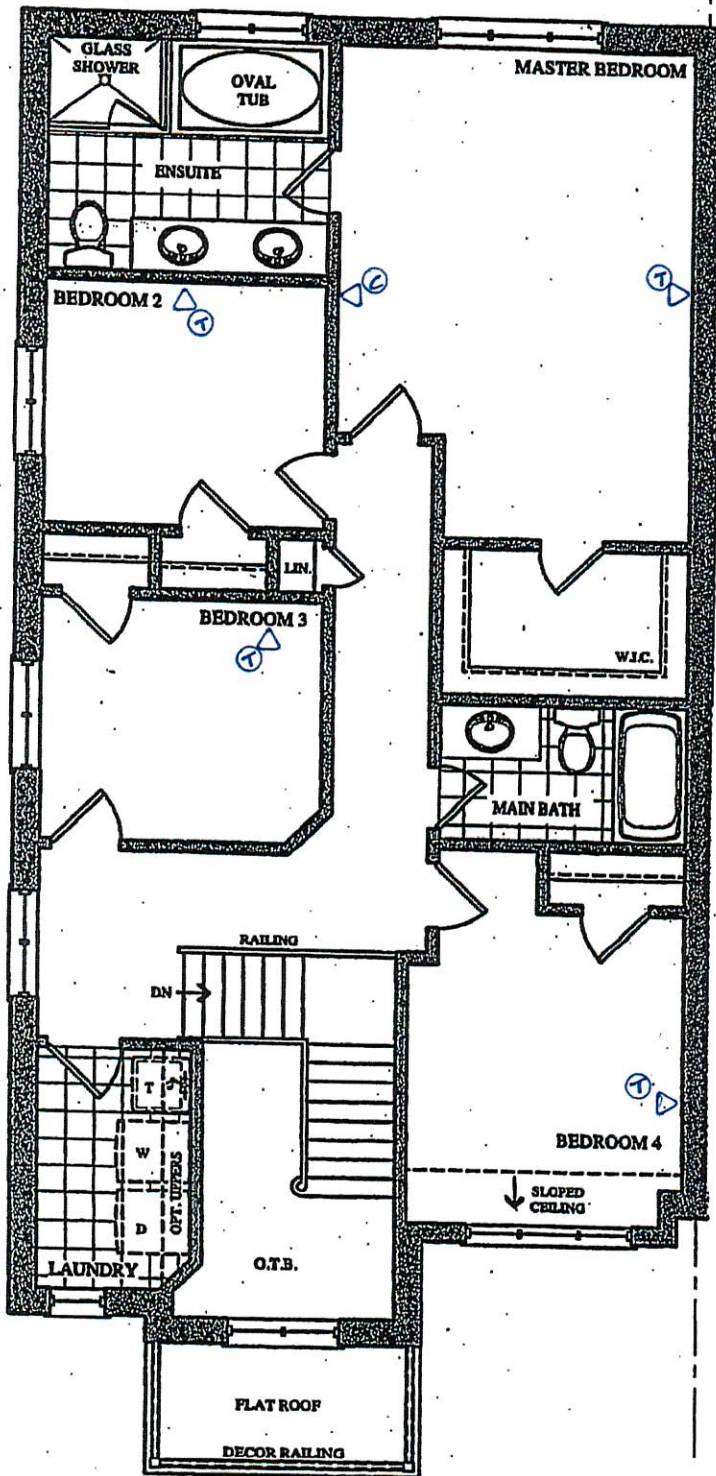


SECOND FLOOR PLAN  
ELEV. 'A'

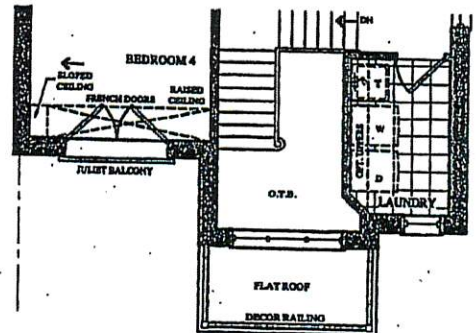

PART. SECOND FLOOR PLAN  
ELEV. 'B'

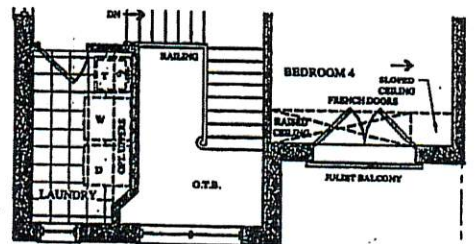

PART. SECOND FLOOR PLAN  
ELEV. 'C'

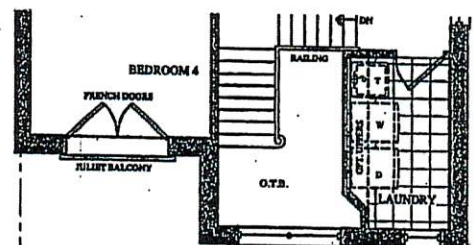

PART. SECOND FLOOR PLAN  
ELEV. 'D'