



CONSTRUCTION SUMMARY

Brampton Encore - 90R - 2 - 28-7 Elev.B Wagner

CONCRETE AND DRAIN

Inv.2,059	1 - BASEMENT: ROUGH-IN - 3 PC BASEMENT ROUGH-IN
Line29162	Note:
10Sep19 / 12Sep19	

FRAMING

Inv.2,059	1 - MANDOOR - GARAGE TO HOUSE- AS PER PLAN AND GRADE PERMITING
Line29129	Note:
10Sep19 / 12Sep19	

HVAC

Inv.2,060	1 - A/C UNIT - 2.5 TONNE
Line29133	Note:
10Sep19 / 12Sep19	

PLUMBING

Inv.2,059	1 - ROUGH-IN - 3PC BASEMENT ROUGH-IN
Line29159	Note:
10Sep19 / 12Sep19	


WINDOWS - BASEMENT

Inv.2,059	4 - BASEMENT WINDOWS - UPGRADE EXISTING BASEMENT WINDOW TO 30 INCH X 24 INCH - MAY REQUIRE INSTALLATION OF WINDOW WELL
Line29132	Note:
10Sep19 / 12Sep19	


BEZ-90R
SEPT 10 2019

The Wagner SEMI SERIES

Elevation A • 2,127 sq.ft.
Elevation B • 2,117 sq.ft.
Elevation C • 2,127 sq.ft.
Elevation D • 2,127 sq.ft.

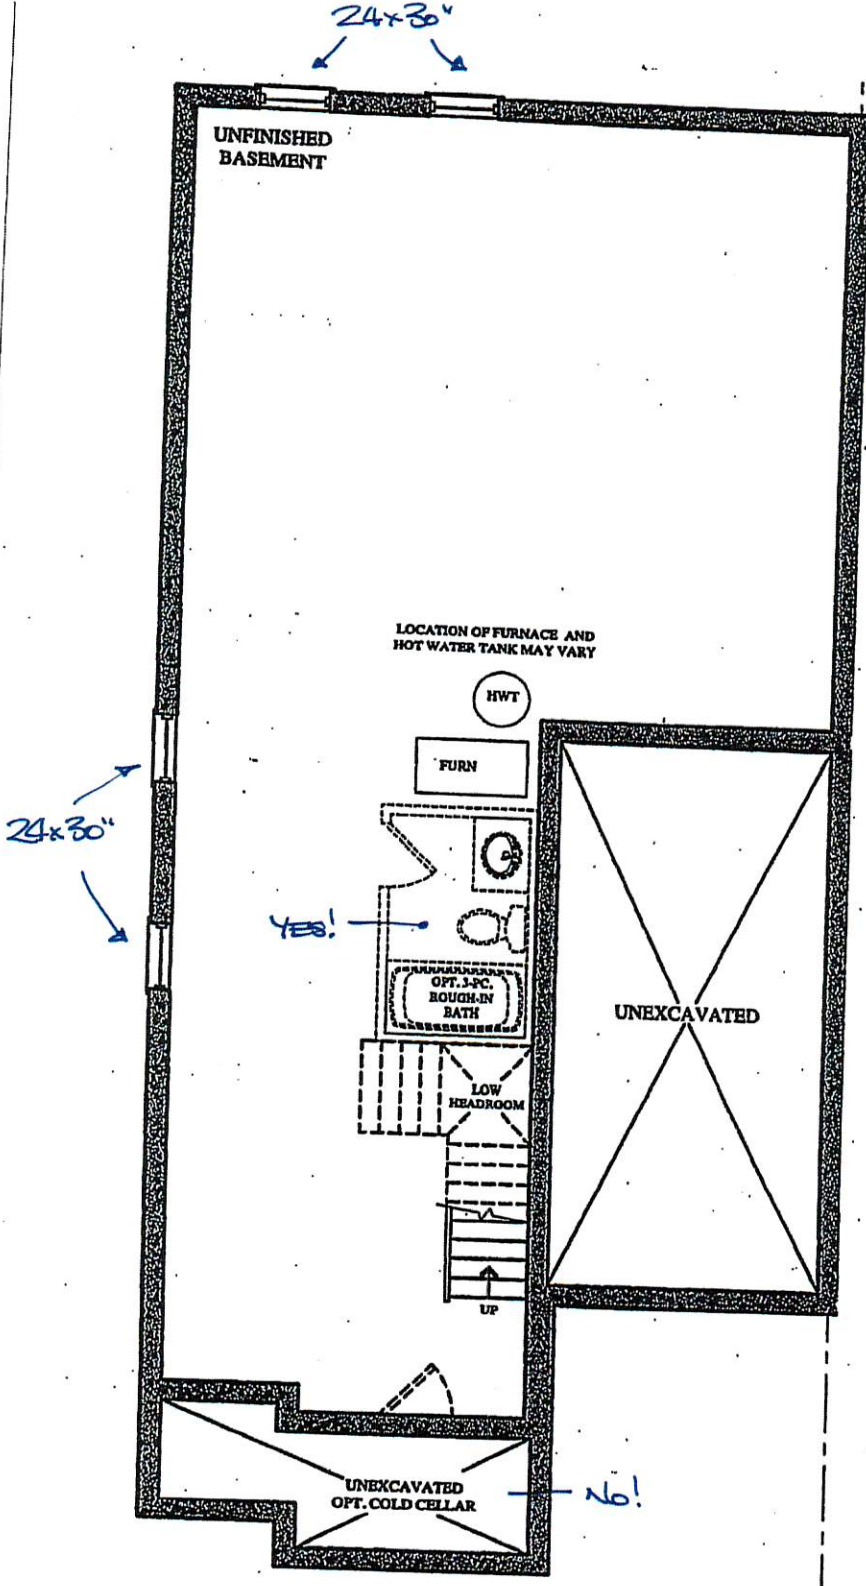

BASEMENT FLOOR PLAN
ELEV. 'A' & 'B'

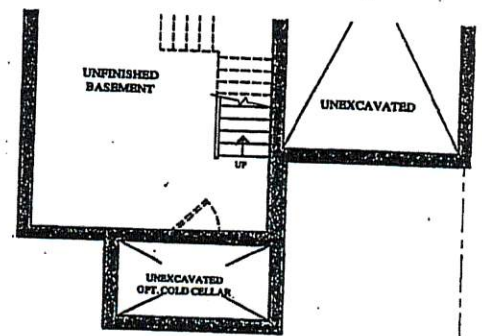


PART. BASEMENT FLOOR PLAN
ELEV. 'C' & 'D'


BEZ-90R
SEPT 10 2019

The Wagner SEMI SERIES

Elevation A • 2,127 sq.ft.
Elevation B • 2,117 sq.ft.
Elevation C • 2,127 sq.ft.
Elevation D • 2,127 sq.ft.

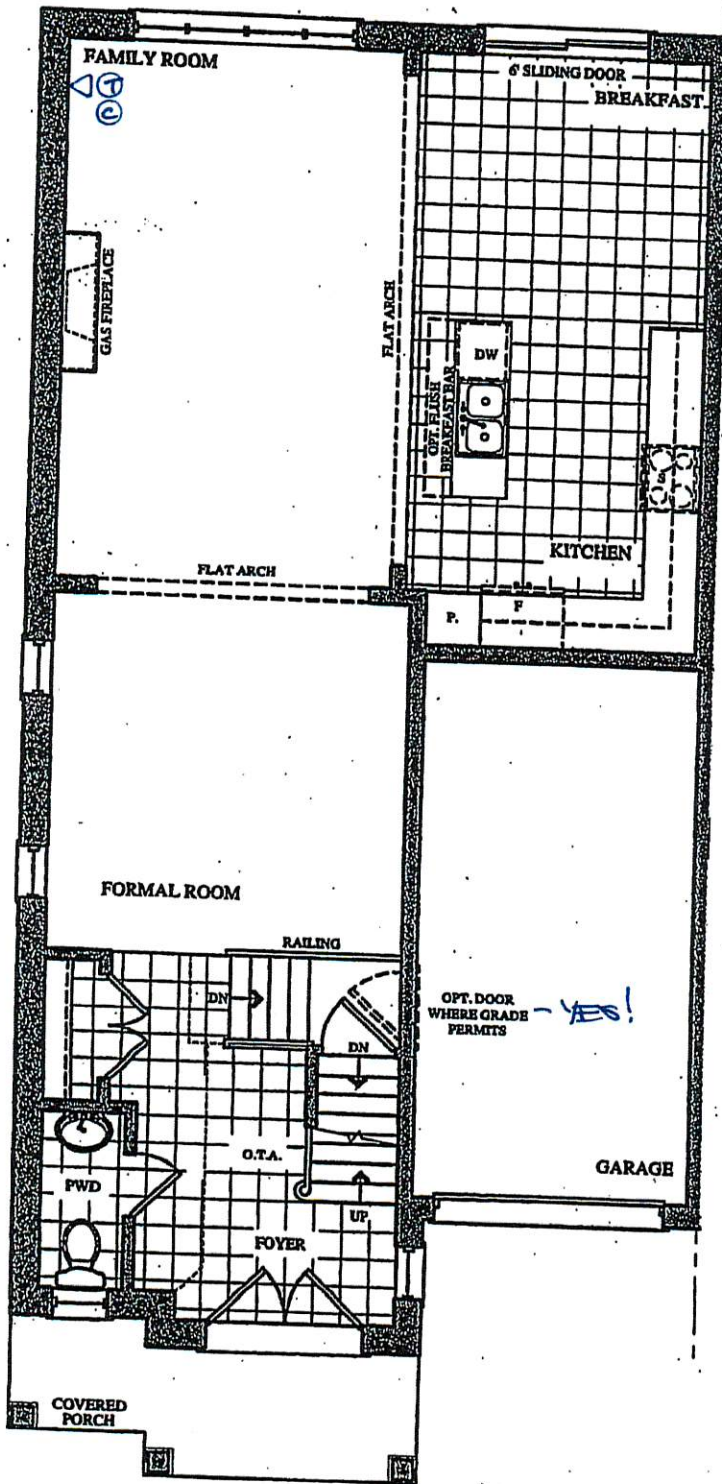

GROUND FLOOR PLAN
ELEV. 'A' & 'B'

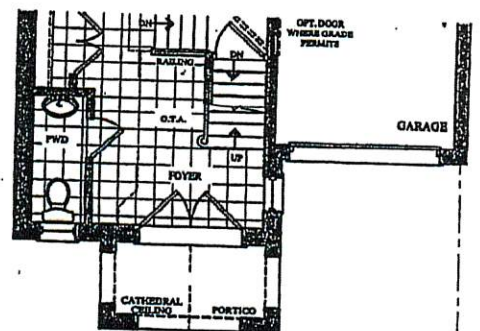


PART. GROUND FLOOR PLAN
ELEV. 'C' & 'D'


BE2-20R
 SEPT 16 2019

The Wagner SEMI SERIES


Elevation A • 2,127 sq.ft.
 Elevation B • 2,117 sq.ft.
 Elevation C • 2,127 sq.ft.
 Elevation D • 2,127 sq.ft.

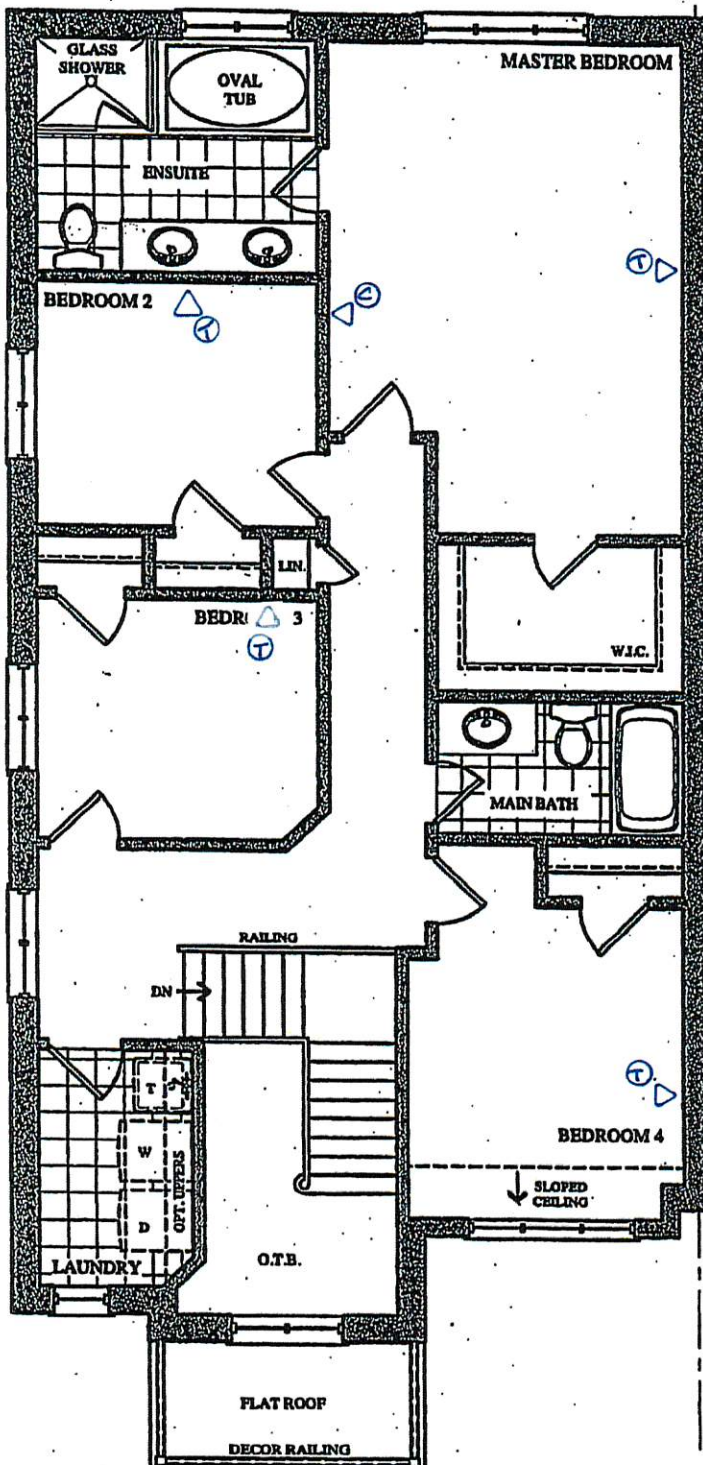


SECOND FLOOR PLAN
ELEV. 'A'

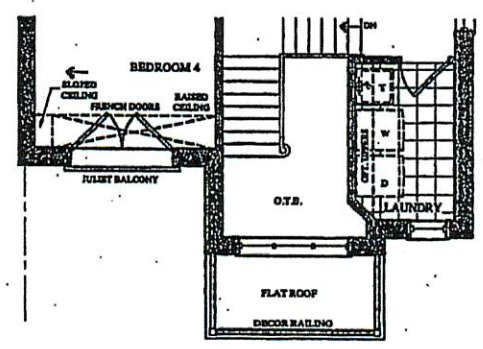

PART. SECOND FLOOR PLAN
ELEV. 'B'

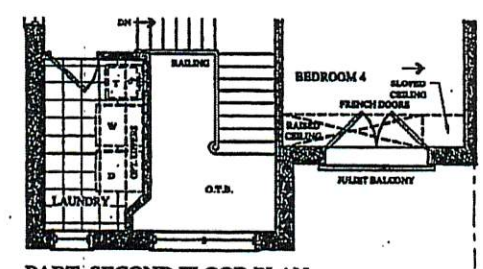

PART. SECOND FLOOR PLAN
ELEV. 'C'

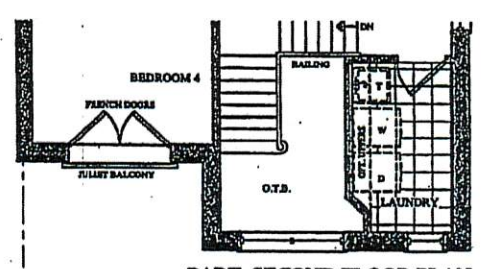

PART. SECOND FLOOR PLAN
ELEV. 'D'