

Brampton Encore - 91L - 2 - 28-6 Elev.A Berlio

CONCRETE AND DRAIN

Inv.2,063	1 - ROUGH-IN 3 PC BASEMENT ROUGH-IN
Line29163	Note:
10Sep19 / 12Sep19	

FORMING

Inv.2,063	1 - SIDE DOOR- HOME TO EXTERIOR- AS PER PLAN AND GRADE PERMITTING
Line29139	Note:
10Sep19 / 12Sep19	

FRAMING

Inv.2,063	1 - MANDOOR - GARAGE TO HOUSE- AS PER PLAN AND GRADE PERMITING
Line29138	Note:
10Sep19 / 12Sep19	

HVAC

Inv.2,064	1 - A/C UNIT - 2.0 TONNE
Line29142	Note:
10Sep19 / 12Sep19	

PLUMBING


Inv.2,063	1 - BASEMENT: ROUGH-IN - 3PC BASEMENT ROUGH-IN
Line29141	Note:
10Sep19 / 12Sep19	

WINDOWS - BASEMENT

Inv.2,063	4 - BASEMENT WINDOWS - UPGRADE EXISTING BASEMENT WINDOW TO 30 INCH X 24 INCH - MAY REQUIRE INSTALLATION OF WINDOW WELL
Line29140	Note:
10Sep19 / 12Sep19	

The
Berlio
SEMI SERIES

- Elevation A • 2,047 sq.ft.
- Elevation B • 2,037 sq.ft.
- Elevation C • 2,037 sq.ft.
- Elevation D • 2,047 sq.ft.

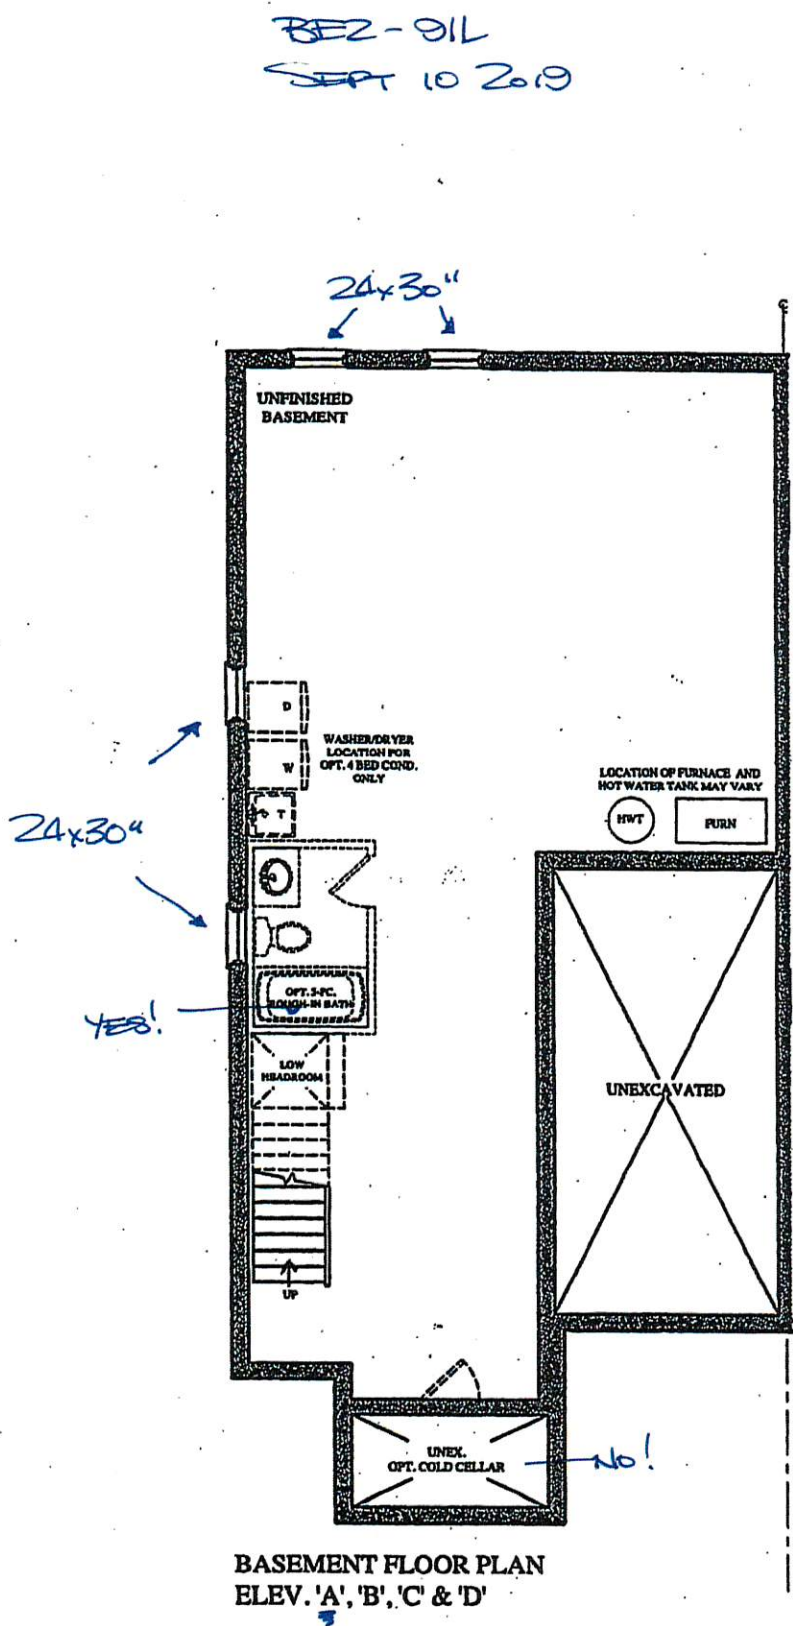


Prices, figures, illustrations, sizes, features and finishes are subject to change without notice. Areas and dimensions are approximate and actual usable floor space may vary from the stated area. Layout may be reverse of the unit purchased. E. & O.E.


GOLDPARK
WORTH MOR

**The
Berlio
SEMI SERIES**

Elevation A • 2,047 sq.ft.
Elevation B • 2,037 sq.ft.
Elevation C • 2,037 sq.ft.
Elevation D • 2,047 sq.ft.

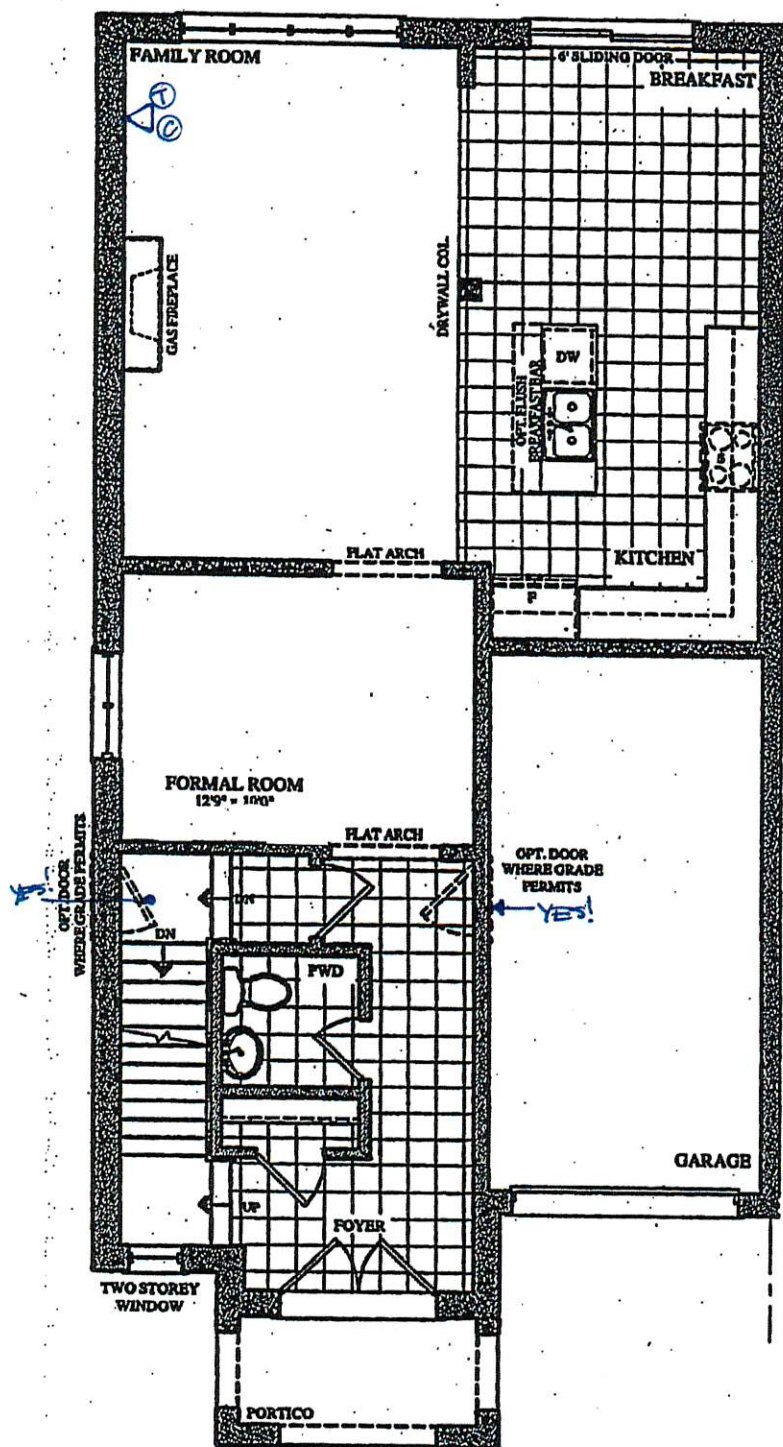

**GROUND FLOOR PLAN
ELEV. 'A' & 'B'**

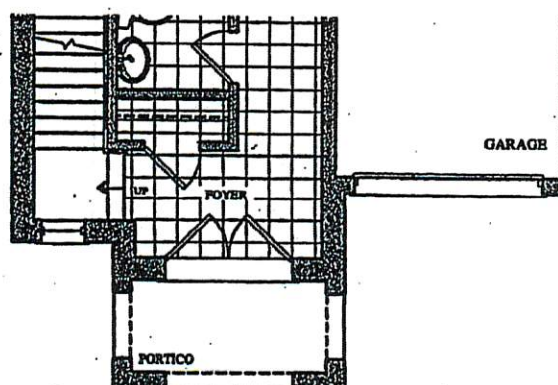


**PART. GROUND FLOOR PLAN
ELEV. 'C' & 'D'**

BE2-811
SEPT 10 2019


The Berlio

SEMI SERIES


→ Elevation A • 2,047 sq.ft.
Elevation B • 2,037 sq.ft.
Elevation C • 2,037 sq.ft.
Elevation D • 2,047 sq.ft.

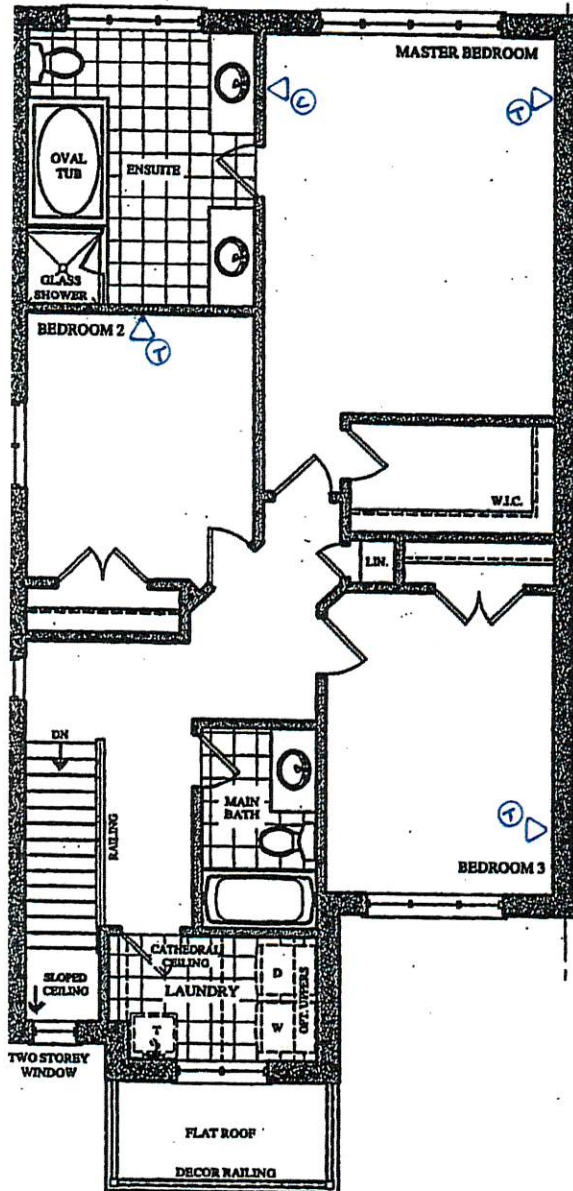


SECOND FLOOR PLAN
ELEV. 'A'

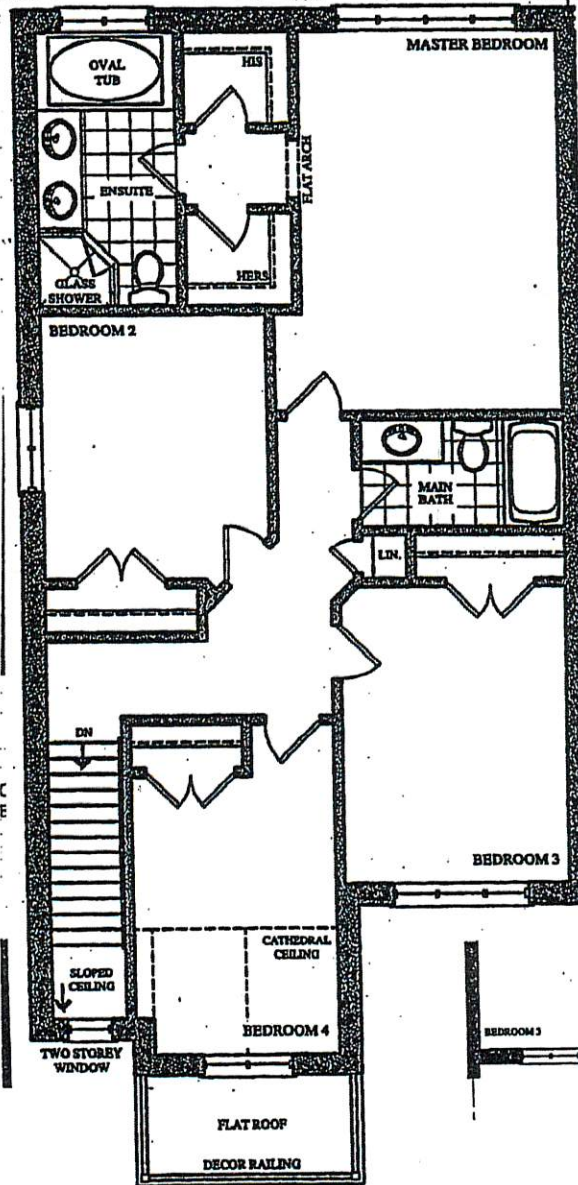


P.
K OPT. 4 BED SECOND FLOOR PLAN
ELEV. 'A'

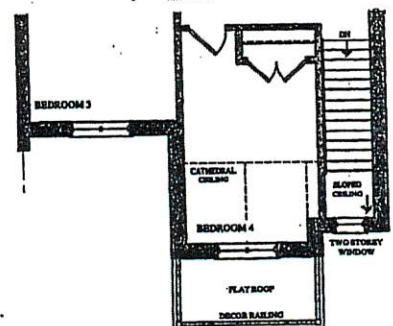


PART. OPT. 4 BED SECOND FLOOR PLAN
ELEV. 'B'

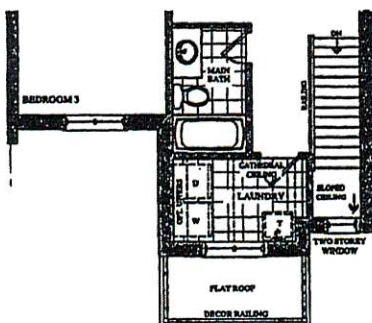


PART. SECOND FLOOR PLAN
ELEV. 'B'

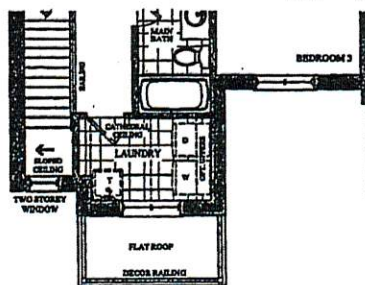


PART. SECOND FLOOR PLAN
ELEV. 'C'

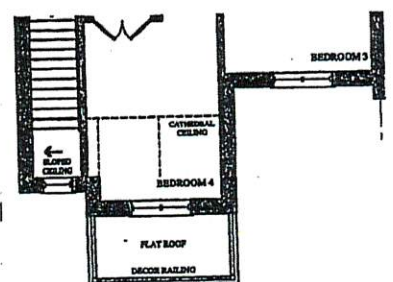

PART. OPT. 4 BED SECOND FLOOR PLAN
ELEV. 'C'

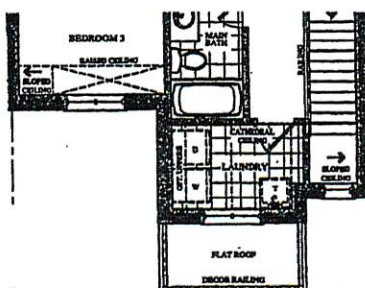

PART. SECOND FLOOR PLAN
ELEV. 'D'

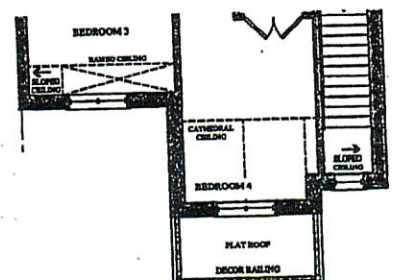

PART. OPT. 4 BED SECOND FLOOR PLAN