

Brampton Encore - 92L - 2 - 28-7 Elev.C Wagner

CONCRETE AND DRAIN

Inv.2,068	1 - 3 PC BASEMENT ROUGH-IN
Line29164	Note:
10Sep19 / 12Sep19	

FRAMING

Inv.2,068	1 - MANDOOR - GARAGE TO HOUSE- AS PER PLAN AND GRADE PERMITING
Line29148	Note:
10Sep19 / 12Sep19	

HVAC

Inv.2,067	1 - A/C UNIT - 2.5 TON
Line29153	Note:
10Sep19 / 12Sep19	

PLUMBING

Inv.2,068	1 - ROUGH-IN - 3PC BASEMENT ROUGH-IN
Line29151	Note:
10Sep19 / 12Sep19	


WINDOWS - BASEMENT

Inv.2,068	4 - BASEMENT WINDOWS - UPGRADE EXISTING BASEMENT WINDOW TO 30 INCH X 24 INCH - MAY REQUIRE INSTALLATION OF WINDOW WELL
Line29149	Note:
10Sep19 / 12Sep19	


BE2-92L
SEPT 10 2019.

The Wagner SEMI SERIES

Elevation A • 2,127 sq.ft.
Elevation B • 2,117 sq.ft.
Elevation C • 2,127 sq.ft.
Elevation D • 2,127 sq.ft.

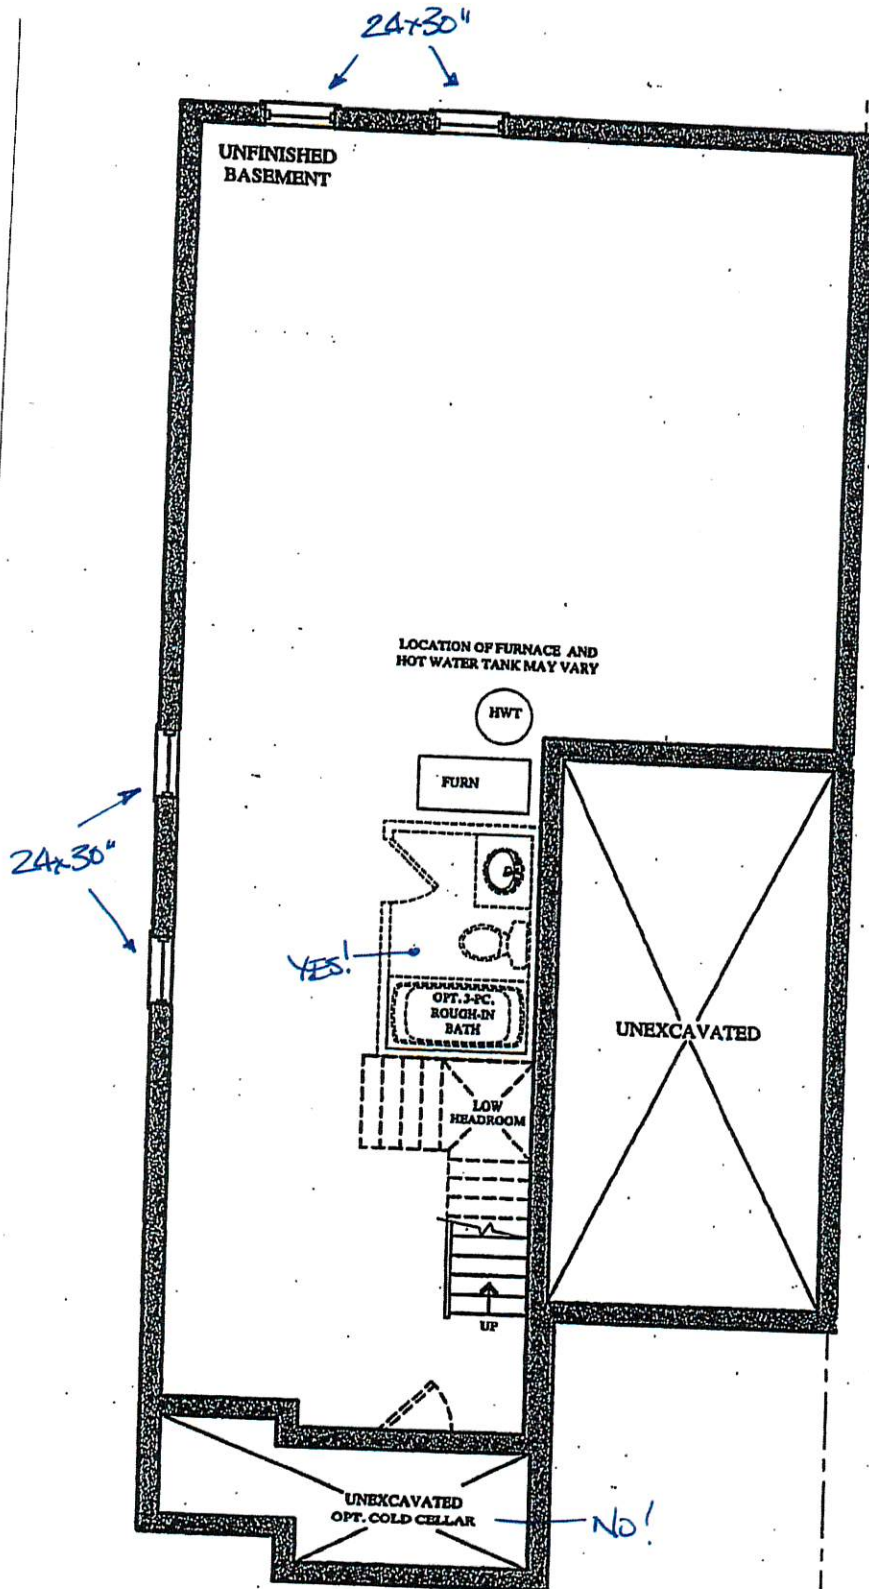

BASEMENT FLOOR PLAN
ELEV. 'A' & 'B'

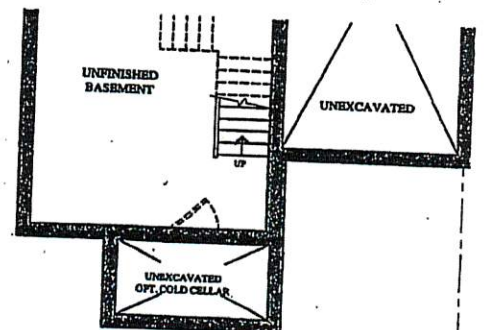


PART. BASEMENT FLOOR PLAN
ELEV. 'C' & 'D'


BEZ-92L
SEPT 10 2019

The Wagner SEMI SERIES

Elevation A • 2,127 sq.ft.
Elevation B • 2,117 sq.ft.
→ Elevation C • 2,127 sq.ft.
Elevation D • 2,127 sq.ft.

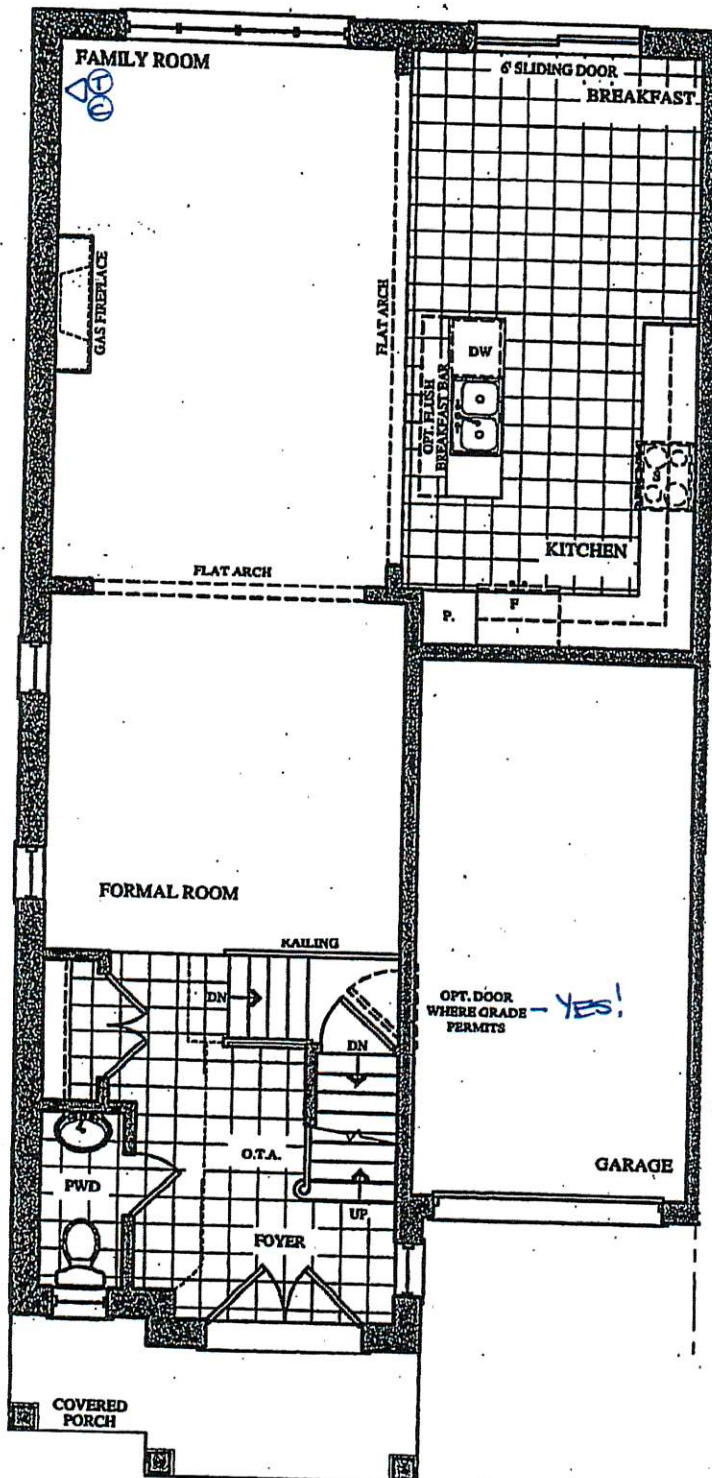

GROUND FLOOR PLAN
ELEV. 'A' & 'B'

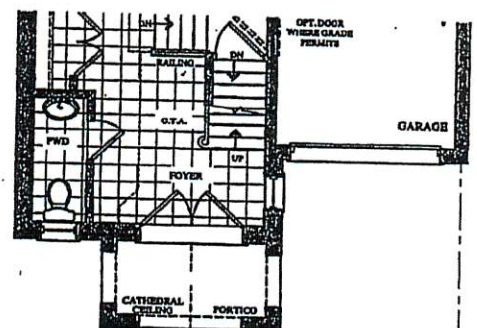


PART. GROUND FLOOR PLAN
ELEV. 'C' & 'D'


BE2-92L
SEPT 10 2019

The Wagner SEMI SERIES


Elevation A • 2,127 sq.ft.
Elevation B • 2,117 sq.ft.
→ Elevation C • 2,127 sq.ft.
Elevation D • 2,127 sq.ft.

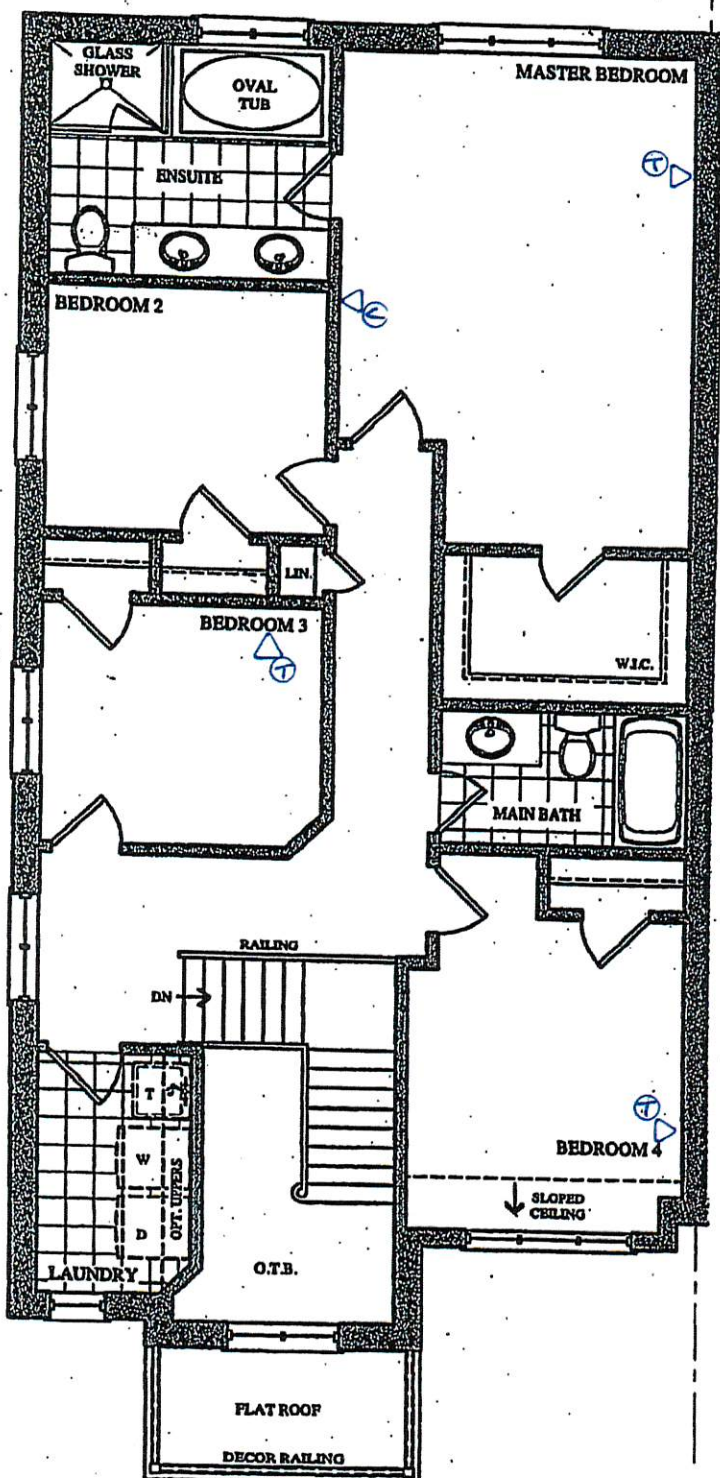


SECOND FLOOR PLAN
ELEV. 'A'

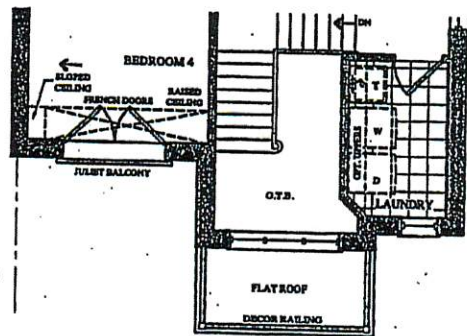

PART. SECOND FLOOR PLAN
ELEV. 'B'

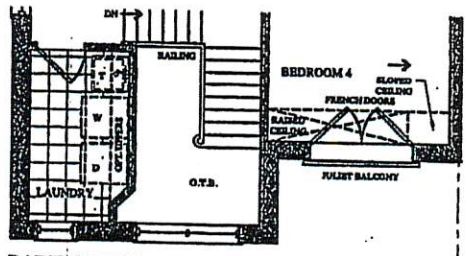

PART. SECOND FLOOR PLAN
ELEV. 'C'

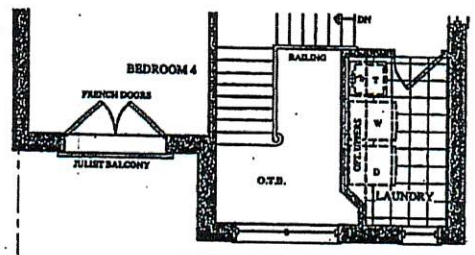

PART. SECOND FLOOR PLAN
ELEV. 'D'