



CONSTRUCTION SUMMARY

1091 - 1 - 50.03 C OAKGROVE

EXTERIOR COLOURS

Inv.1,958	1 - EXTERIOR COLOUR PACKAGE C.8
Line27497	Note:
9Jan19 / 10Jan19	

FRAMING

Inv.1,958	1 - ADD OPTIONAL TRAY CEILING IN MASTER BEDROOM
Line27496	Note:
9Jan19 / 10Jan19	

WINDOWS - BASEMENT


Inv.1,958	2 - UPGRADE EXISTING WINDOW TO 30X24 INCHES
Line27495	Note: Upgraded windows at sides of the home, may require window wells.
9Jan19 / 10Jan19	

* MODEL HOME



The Oakgrove
50.03 C

Phase 1 Lot 91
Sited as lookout bsmt

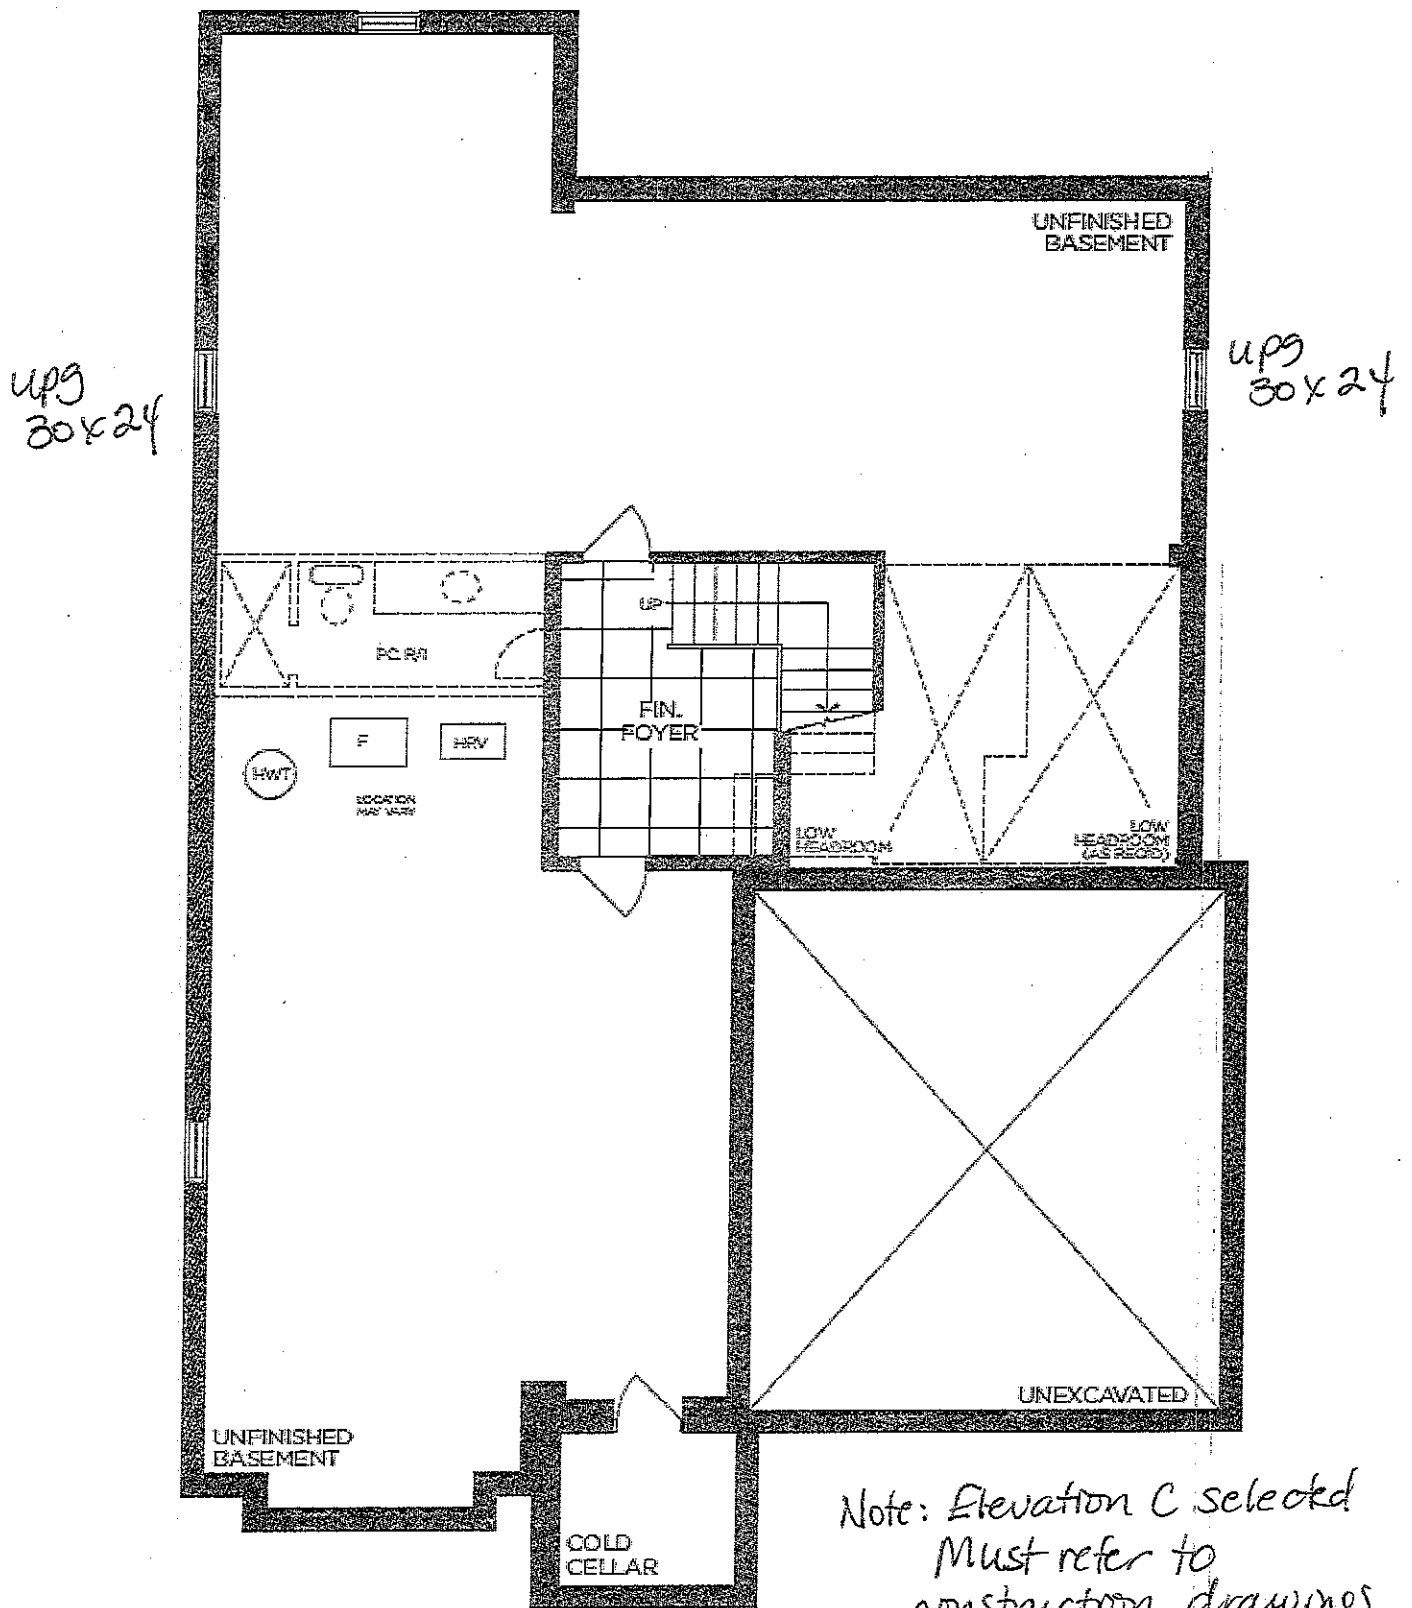

Note: Elevation C selected
Must refer to
construction drawings
for exact changes to front

Elevation A - 3,939 sq.ft.

Elevation B - 3,922 sq.ft.

Elevation C - 3,931 sq.ft.

Approval by: L. Preite