

CONSTRUCTION SUMMARY

Brampton Encore - 107 - 2 - 38-1 Elev. A BIZET CONCRETE AND DRAIN

	CONCRETE AND DRAIN
Inv. 2,092	1 - 3PC Basement Rough-In
Line 29680	Note:
10Oct19 / 8Nov19	
	ELECTRICAL
Inv. 2,092	1 - KITCHEN: 110V WALL RECEPTACLE ON DEDICATED CIRCUIT - GAS FIRED APPLIANCE -
,	FOR AUX. EQUIPMENT - NOT A STOVE PLUG
Line 29324	Note:
100ct19 / 8Nov19	
	Exterior Colours
Inv. 2,092	1 - Exterior Colour Package #9
Line 29681	Note:
10Oct19 / 8Nov19	
100011978110119	
r 2 002	FORMING
Inv. 2,092	1 - Side Door & Garage Mandoor
Line 29682	Note:
10Oct19 / 8Nov19	
	FRAMING
Inv. 2,092	1 - Side Door and Garage Mandoor
Line 29683	Note:
10Oct19 / 8Nov19	
	GRANITE MARBLE QUARTZ
Inv. 2,092	1 - KITCHEN: FLUSH BREAKFAST BAR
Line 29338	Note:
10Oct19 / 8Nov19	
	HARDWOOD
Inv. 2,092	1 - MAIN FLOOR: FAMILY / MAIN HALL / DINING ROOM / UPPER LANDING: UPGRADE 4 HARDWOOD - VINTAGE WHITE OAK HAND SCRAPED 3/4 X 5"
Line 29331	Note:
10Oct19 / 8Nov19	
Inv. 2,092	1 - UPPER HALL: UPGRADE 4 HARDWOOD - VINTAGE WHITE OAK HAND SCRAPED 3/4 X 5"
Line 29332	Note:
10Oct19 / 8Nov19	
	HVAC
Inv. 2,092	1 - KITCHEN: GAS LINE ROUGH - MAIN FLOOR
Line 29323	Note: REQUIRES ELECTRICAL
10Oct19 / 8Nov19	

KITCHEN AND BATH CABINETRY

1 - HUMIDIFIER: WB3 - 17 (UP TO 3,000 SQ.FT.)

Printed and Sent: 08-Nov-19

Inv.**2,092**

Line29325

10Oct19 / 8Nov19

Note:



CONSTRUCTION SUMMARY

Brampton Encore - 107 - 2 - 38-1 Elev.A BIZET

	Brampton Encore - 107 - 2 - 38-1 Elev.A BIZET
Inv. 2,092	1 - KITCHEN: PREMIUM SPRAY STAIN
Line 29328	Note:
100ct19 / 8Nov19	
Inv.2,092	1 - MASTER ENSUITE: PREMIUM SPRAY STAIN
Line 29329	Note:
10Oct19 / 8Nov19	
Inv. 2,092	1 - MAIN BATHROOM: PREMIUM SPRAY STAIN
Line 29330	Note:
10Oct19 / 8Nov19	
	MISC.
Inv. 2,092	1 - Purchaser has attended an appointment at the Decor Centre & has DECLINED any additional upgrades
	and accepts and acknowledges that there will be no further changes/additions/deletions to be made upon signing on OCTOBER 10, 2019.
Line 29335	Note:
100ct19 / 8Nov19	
Inv. 2,092	1 - Purchasers are aware & accepts that ANY changes made to upgrades after signing this Purchasers Extra Form are subject to a minimum administration fee of \$500. PLUS a 10% holdback fee.
Line 29336	Note:
100 110 (0) 10	
10Oct19 / 8Nov19 Inv. 2,092	1 - BONUS PACKAGE: \$10,000.00 (INCLUDING TAXES) WORTH OF UPGRADES FROM GOLD
	PARK HOMES DÉCOR CENTRE IS BEING APPLIED TOWARD THIS ORDER. PURCHASER HAS A REMAINING AMOUNT OF \$00 (INCLUDING TAXES).
Line 29337	Note:
10Oct19 / 8Nov19	
	PAINT
Inv. 2,092	1 - MAIN STAIRS: STAIN STAIRS TO MATCH HARDWOOD AS CLOSE AS POSSIBLE
Line 29333	Note:
10Oct19 / 8Nov19	
	PLUMBING
Inv. 2,092	1 - ROUGH-IN - 3PC BASEMENT ROUGH-IN
Line 29326	Note:
	Trote.
10Oct19 / 8Nov19	
	STAIRS AND RAILINGS
Inv. 2,092	1 - MAIN STAIRS: 1-3/4" LOTUS OAK + V GROOVE
Line 29334	Note:
10Oct19 / 8Nov19	
	WINDOWS - BASEMENT
Inv. 2,092	3 - BASEMENT WINDOWS - UPGRADE EXISTING BASEMENT WINDOW TO 30 INCH X 24 INCH - MAY REQUIRE INSTALLATION OF WINDOW WELL
Line 29327	Note:
10Oct19 / 8Nov19	
	WINDOWS AND DOORS
Inv. 2,092	1 - Side Door and Mandoor

Inv. 2,092	1 - Side Door and Mandoor		
Line 29684	Note:		
10Oct19 / 8Nov19			

Printed and Sent: 08-Nov-19




DEZ-107 (K)



The Bizet 38' SERIES

Elevation A • 2,234 sq.ft. | Elevation B • 2,222 sq.ft.

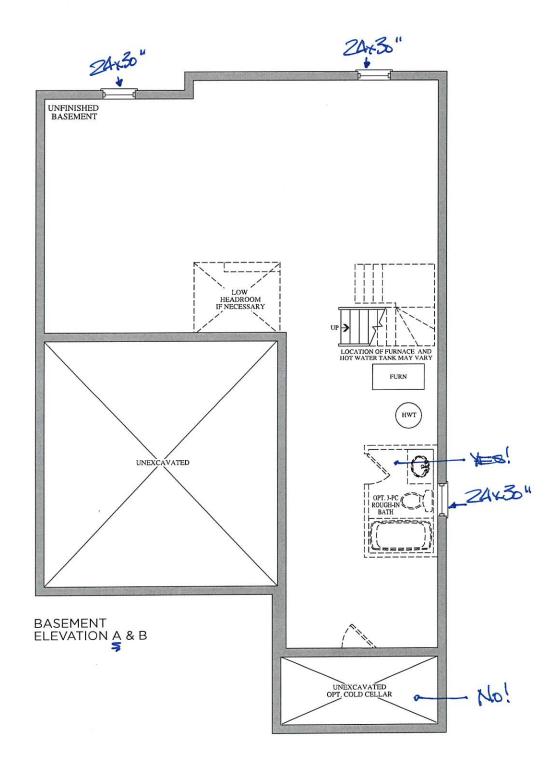





BEZ-107 Out 10 2019



The Bizet

38' SERIES

Elevation A • 2,234 sq.ft. | Elevation B • 2,222 sq.ft.

GAS+ ELECT. HARMOOD GROUND FLOOR ELEVATION A GROUND FLOOR ELEVATION B

Prices, figures, illustrations, vizes, features and finishes are subject to change without notice. E.A.O.E. Areas and dimensions a approximate and actual usable floor space may vary from the stated area. It is not much because the control of the change of the control of the c









The **Bizet**

38' SERIES

Elevation A • 2,234 sq.ft. | Elevation B • 2,222 sq.ft.

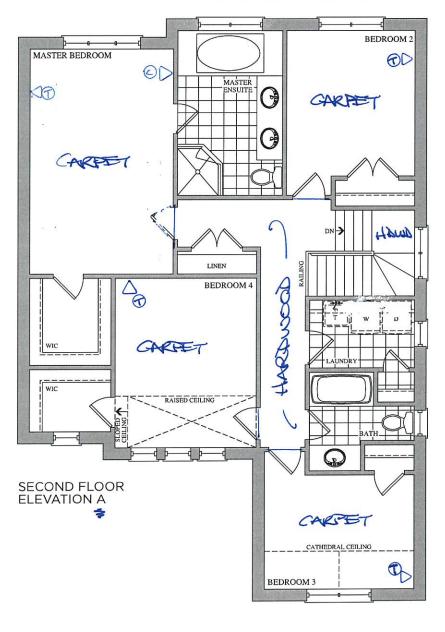

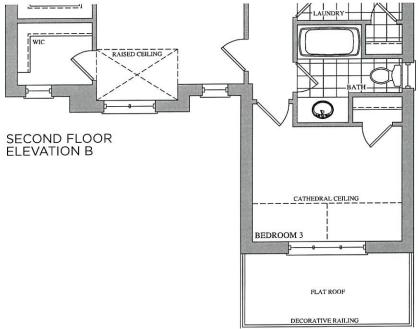



INTERIOR COLOUR SCHEME

GOLDPARK
worth More* *** NOTE: This is not an approved document. Document must be locked ***

Scheduled Closing Date:

	sulthan Mansoor & Khatoo	n Banu Moham Property: 107		
Telephone Res. / Bus: Decor Advisor: Yoland	le Somerville	Model and Elevation: 38-	ampton Encore - Phase 2	
Layout Changes: Yes			Colour Scheme:	
1. Cabinetry	Style and Colour	Counter	Hardware	
Kitchen / Breakfast	Siena oak *'Graphite'	Granite: Grigio Sardo	cs1-24	
Laundry Room	n/a	n/a	n/a	
Powder Room	n/a	n/a	n/a	
Main Bath	Siena oak *'Graphite'	P-Lam #4925k-07	cs1-24	
Master Ensuite	Oleria dak Grapriite	r -Lam #4925R-01	CS 1-24	
Bathroom	Siena oak *'Graphite'	P-Lam #4925k-07	cs1-24	
Second Ensuite Bathroom (If Applicable)	n/a	n/a	n/a	
Comment				
2. Floor Tile	Selection			
Entrance Vestibule	13x13" Serpentine 'Beyaz-	White'		
Main Hall	n/a			
Kitchen / Breakfast	13x13" Serpentine 'Beyaz-White'			
Laundry Room 13x13" Serpentine 'Beyaz-White'				
Powder Room	Powder Room 13x13" Serpentine 'Beyaz-White'			
Main Bath	13x13" Serpentine 'Beyaz-	White'		
Master Ensuite Bathroom	13x13" Serpentine 'Beyaz-	White'		
Second Ensuite Bathroom (If Applicable)	n/a			
Lower Landing (If Applicable) 13x13" Serpentine 'Beyaz-White' (side entrance)				
Mud Room	13x13" Serpentine 'Beyaz-	White'		
Comment				
		,		
3. Wall Tile	Selection	Listello/Inserts	Describe	
M.Ens Tub Skirt/Splash	8x10" Weave 'White'	Yes No		
Master Ensuite Bathroom	ck 8x10" Weave 'White'			
	all 8x10" Weave 'White'	○ Yes ● No		
Bathroom Wal		○ Yes ● No		
Second Ensuite Bathroom (If Applicable)	n/a	◯ Yes ● No		
Main Bath	8x10" Weave 'White'			
Kitchen Backsplash	Yes ■ No	Backsplash	Behind Fridge	
Comment				
			(K)	

INTERIOR COLOUR SCHEME *** NOTE: This is not an approved document. Document must be locked *** Scheduled Closing Date:			
	atoon Banu Moham Property: 10		
Telephone Res. / Bus:	5	rampton Encore - Phase 2	
Decor Advisor: Yolande Somerville	Model and Elevation: 38	3-1 Elev.A BIZET	
	Ensuite	Powder Room Other Washroom	
Comment			
Standard Thru Out		÷	
5. Hardwood Flooring Type and Stain		Type and Stain	
Main Hall 3/4x5" H. S. 'Baroque'	Upper Landing	3/4x5" H. S. 'Baroque'	
Kitchen / Breakfast n/a	Upper Hall	3/4x5" H. S. 'Baroque'	
Living Room n/a	Master Bedroom	n/a	
Dining Room 3/4x5" H. S. 'Baroque'	Bedroom #2	n/a	
Family Room 3/4x5" H. S. 'Baroque'	Bedroom #3	n/a	
Den/Library n/a	Bedroom #4	n/a	
Entrance Vestibule n/a	Bedroom #5	n/a	
Lower Landing (If Applicable)	Other Room - Specify		
Comment Vintage White Oak Hand Scraped 3/4 x 5" 6. Carpeting Upgrade Description	on.		
Ground Floor	JII		
Second Floor Standard	d 'Winter Grey' with std u/pad		
Type Upgrade Underpad	Area		
Capped	Runner - *Up	ograde	
Carpet on Stairs			
Comment			
7. Fireplace Living Room Purchased As Per Plan N/A	Family Room Purchased As Per Plan N/A Standard Gas	Other Room - Specify Purchased As Per Plan N/A	
Fireplace Type Mantle Type	NF-20		
Colour / Stain	White		
Surround	Nero Marquina		
Hearth	none		
Comment			
		(k)	

GOLDPAR		IOR COLOUR SCHEM	
SOLD AK	ORE "" NOTE: This is not an app	proved document. D	ocument must be locked ***
urchasers:	Ameersulthan Mansoor & Khatoon Banu	Moham Property: 107	
elephone Res. / Bus:			oton Encore - Phase 2
Decor Advisor:	Yolande Somerville Mod	el and Elevation: 38-1 E	Elev.A BIZET
8. Trim Carpentry Interior Doors Stan Interior Trim Stan Comment 9. Plaster Mouldi	ngs and Medallions out (Yes () No () N/A	rts Standard Do	por Handles Standard
Family Room Comment			
10. Railings and	Spirities		
Railing Package		Spindle Colour	*Baroque
-	Baroque	=	
Stringer / Riser	*Baroque	Treads	*Baroque Yes No N/A
Comment		Oak Stairs	Yes O No O N/A
11. Wall Paint / (Throughout Finish Trim Paint Smooth Ceilings Ground Fle	White)	
Note			
Comment			
			(K)


INTERIOR COLOUR SCHEME

INTERIOR COLOUR SCHEME *** NOTE: This is not an approved document. Document must be locked *** Scheduled Closing Date:

	eersulthan Mansoor & Khato	pon Banu Moham Property: 107	
Telephone Res. / Bus:		Project: Brampton En	
Decor Advisor: Yola	ande Somerville	Model and Elevation: 38-1 Elev.A E	BIZET
T12. Electrical Hood Fan White Standard Appliances Over The Range Microw	Stainless N/A		pinet Light Yes No pinet Light Yes No
Chimney Style Fan			
Comment			
Comment			
13. Heating and Air C	onditioning		
Air Conditioning	no	Gas Provisions Stove	yes
Gas Provisions Dryer	no	Gas Provisions Barbecue	std
Comment			
14. Additional Comm	ents		
Any extras listed above are not also also also also are not also also also also also also also also	s close as possible to builder's selected all and void unless accompanied by that after Interior Colour Selection railability Purchase reading and accepting the "Gold Piers.	ction, but not necessarily identical due to variances a separate invoice/amendment. Said invoice must form is signed and dated, no further changes will be er's Initials Park Homes Decor Centre Disclaimers" form. This d	be paid in full.

Signature




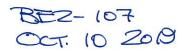





QUOTATION


Date: 06/23/16

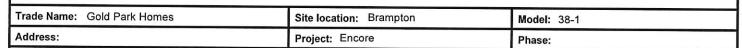


This layout has been explained to the purchaser by Cortina Kitchens Inc. and is understood by the purchaser.

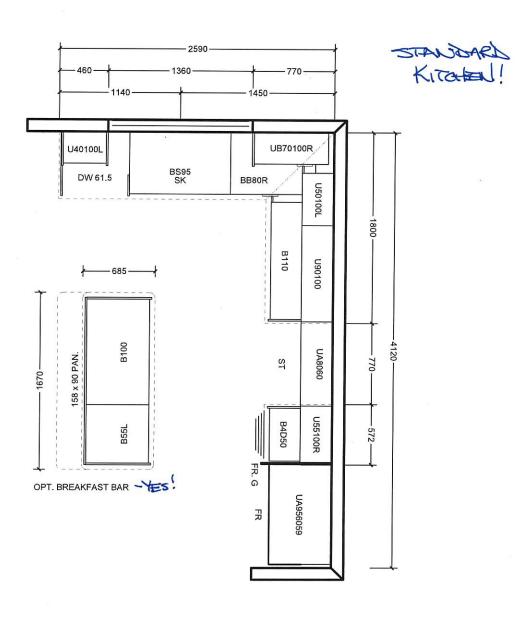

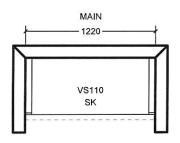

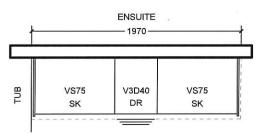

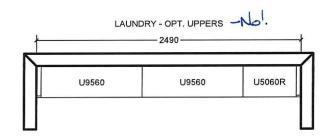

All prices subject to confirmation from head office. This quotation is subject to the terms & conditions set out in Cortina's Agreement of Purchase and Sale All agreements are contigent upon strikes, accidents, and delay beyond our control. Please provide our installer with template for sinkholes or \$150.00 will be charged for callback.

ACCEPTED DATE:	(Name - 1 - 1 - 1 - 1 - 1 - 1 - 1 - 1 - 1 -

CUSTOMER SIGNATURE


SALESPERSON SIGNATURE

CORTINA HEAD OFFICE APPROVAL

ITEM A. Wood grain and colour are characteristics of the product, we cannot guaruntee that such grian and colour will always match ITEM B. Cortina Kitchens reserves the right to alter dimensions and make technical changes without notice.



Granite, Marble, Engineered Surfaces

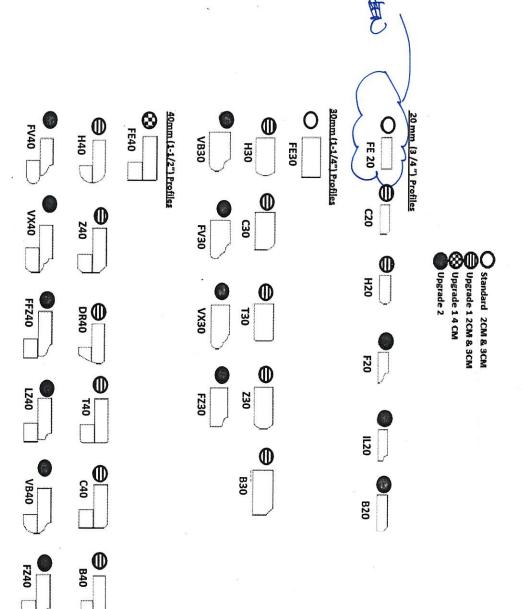

*Mitre edge is available in Upgrade 1 for an overall thickness of 2". All other Mitre edge options will be an Upgrade 2 Edge.

MITER

at time ordered. Vendor reserves the right to use

Note: All colours may not be available in 30mm

40 mm edges (by lamination process).

STANDARD HARDWARE

BE2-107 OCT 10 2019





CSI-6




CSI-10




CSI-14



CSI-16

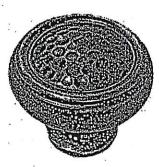

CSI-18

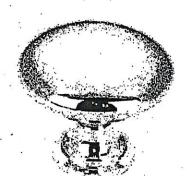

CSI-19




CSI- 20




CSI- 21




CSI-22

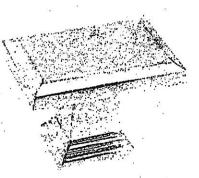

CSI-23

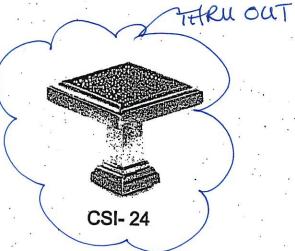

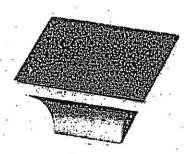

CSI-25

*NOTES:

- IMAGES ARE FOR QUICK REFERENCE PURPOSES ONLY
- ACTUAL SIZES AND FINISHES AS PER HARDWARE SAMPLE BOARD PROVIDED TO DECOR CENTRE

GOLDPARK WORTH MORE"

BATHROOM ACCESSORIES

PROJECT: ENCORE 2	
LOT: (07	
INSTALL STANDARD BATHROOM ACCESSORIES THRU OUT (TOWEL BAR, SOAP DISH, TISSUE HOLDER) **location as per vendor's discretion	9
DO *NOT* INSTALL STANDARD BATHROOM ACCESSORIES THRU OUT (TOWEL BAR, SOAP DISH, TISSUE HOLDER)	
SIGNATURE! Mantors!	
SIGNATURE: Kathon Bany	
DATE: OCTOBER 10 209	