



CONSTRUCTION SUMMARY

Brampton Encore - 110 - 2 - 38-9 Elev.B PUCCINI OPT - GFA1

CONCRETE AND DRAIN

Inv.2,116	1 - 3PC Basement Rough-In
Line29768	Note:
12Nov19 / 15Nov19	

FORMING

Inv.2,116	1 - SIDE DOOR- HOME TO EXTERIOR- AS PER PLAN AND GRADE PERMITTING
Line29704	Note: Included in aps
12Nov19 / 15Nov19	

Inv.2,116	1 - Mandoor - Garage To House - As Per Plan And Grade Permitting
Line29772	Note:
12Nov19 / 15Nov19	

FRAMING

Inv.2,116	1 - MANDOOR - GARAGE TO HOUSE- AS PER PLAN AND GRADE PERMITING
Line29705	Note: Included in aps
12Nov19 / 15Nov19	

Inv.2,116	1 - Side Door - Home To Exterior - As Per Plan And Grade Permitting
Line29769	Note:
12Nov19 / 15Nov19	

PLUMBING

Inv.2,116	1 - ROUGH-IN - 3PC BASEMENT ROUGH-IN
Line29706	Note:
12Nov19 / 15Nov19	

WINDOWS - BASEMENT

Inv.2,116	2 - BASEMENT WINDOWS - UPGRADE EXISTING BASEMENT WINDOW TO 30 INCH X 24 INCH - MAY REQUIRE INSTALLATION OF WINDOW WELL
Line29707	Note:
12Nov19 / 15Nov19	


WINDOWS AND DOORS


Inv.2,116	1 - Side Door & Garage Mandoor - As Per Plan and Grade Permitting
Line29767	Note:
12Nov19 / 15Nov19	

BE2-110
Nov 11 2019


The
Puccini
38' SERIES

Elevation A • 3,700 sq.ft. | Elevation B • 3,700 sq.ft.

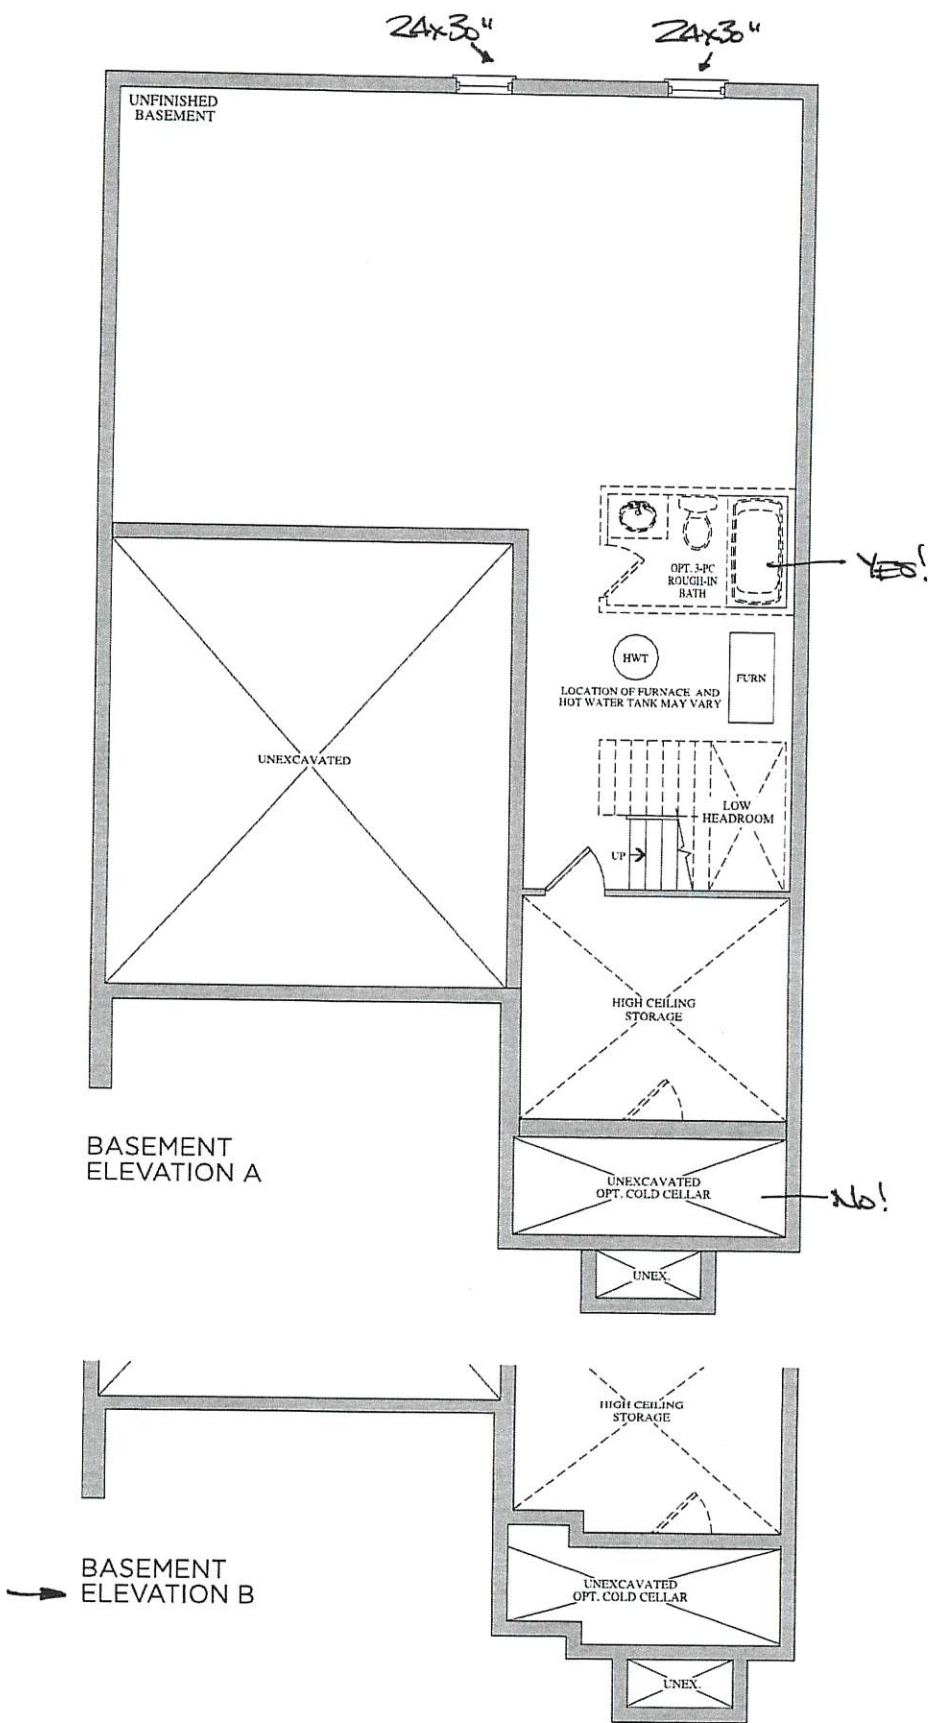


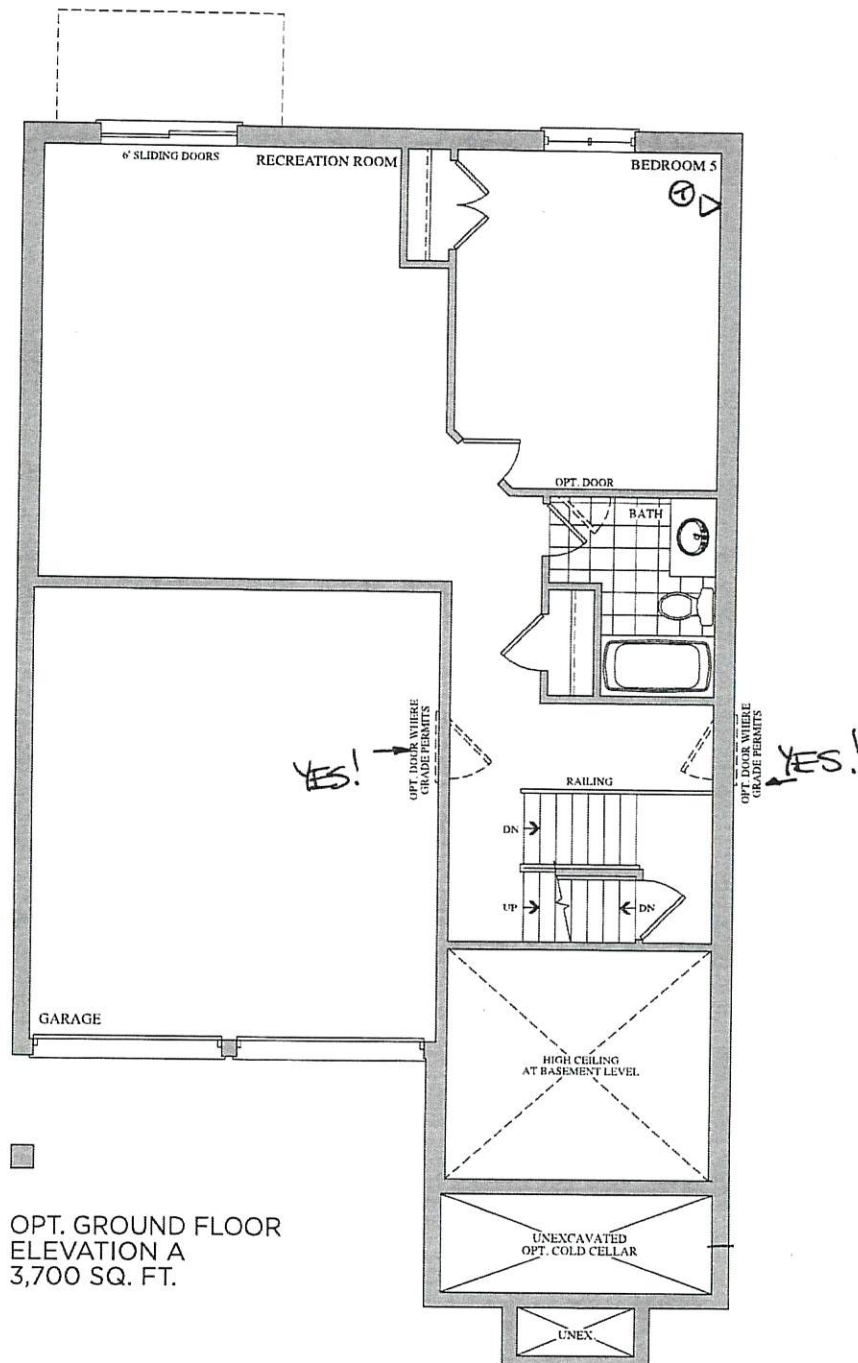


OPT. GROUND FLOOR
ELEVATION A
3,700 SQ. FT.

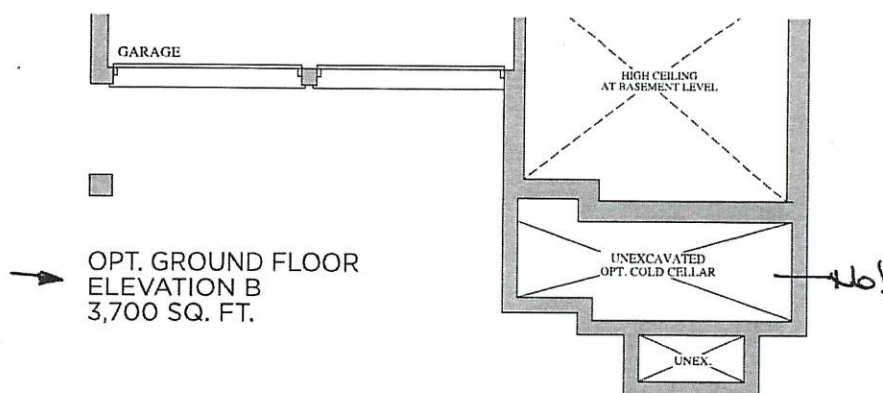

OPT. GROUND FLOOR
ELEVATION B
3,700 SQ. FT.

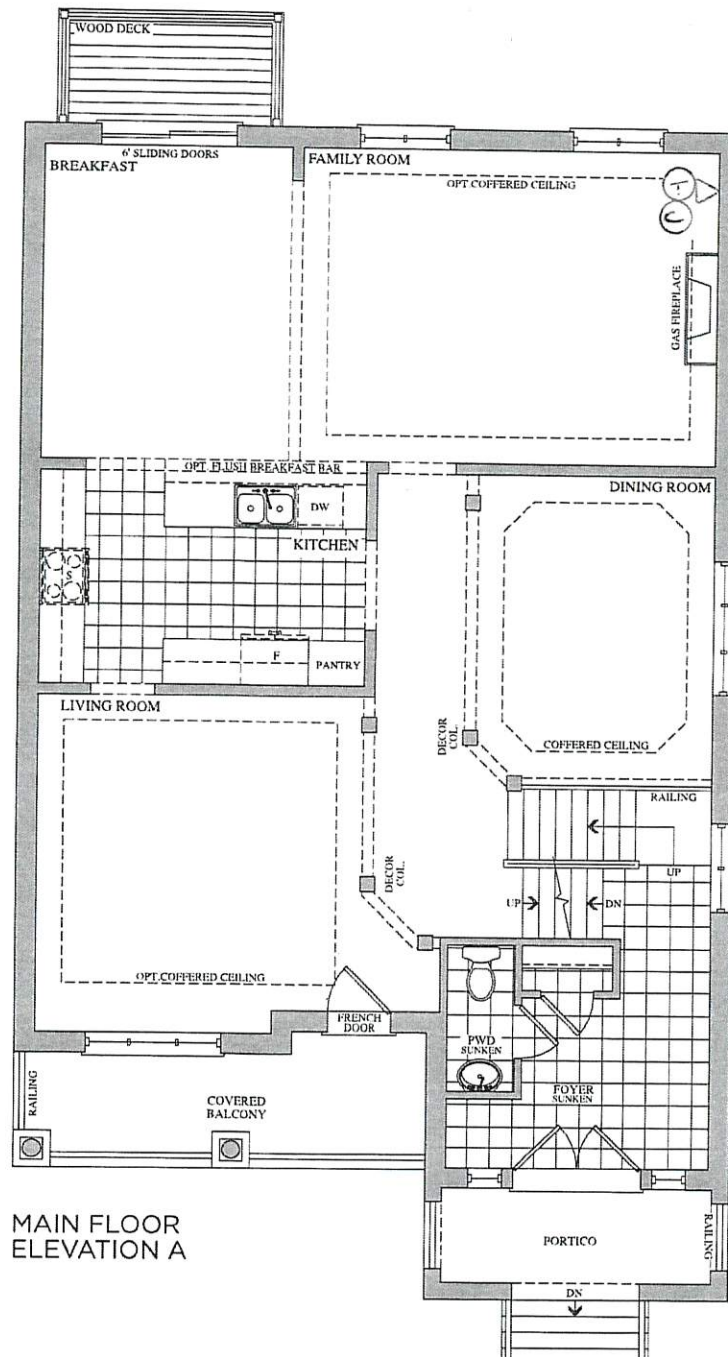

MAIN FLOOR
ELEVATION A

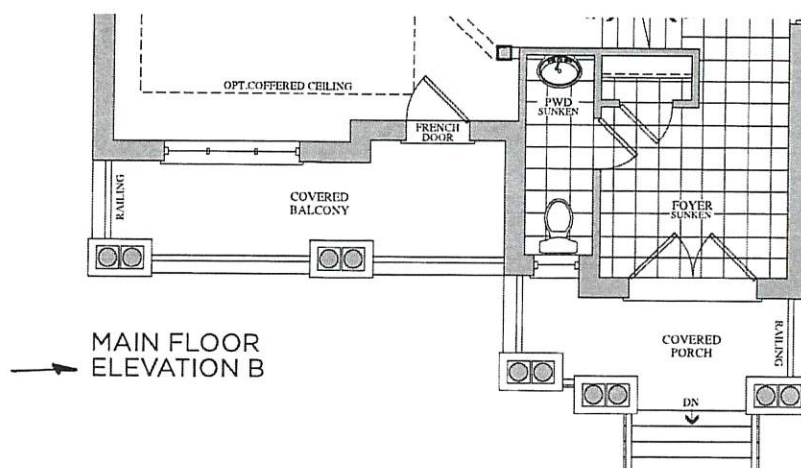

MAIN FLOOR
ELEVATION B

BE2-110
Nov 11 2019

The Puccini

38' SERIES

Elevation A • 3,700 sq.ft. | Elevation B • 3,700 sq.ft.

