

Brampton Encore - 87L - 2 - 28-6 Elev.A Berlio

CENTRAL VAC AND WIRING

Inv.2,091	1 - FAMILY ROOM: CONDUIT PIPE- FOR TELEVISION- LOCATE ABOVE FIREPLACE, APPROX. 66" A.F.F. TERMINATING BY CABLE LOCATION
Line29276	Note:
9Oct19 / 16Nov19	

CERAMIC

Inv.2,091	1 - KITCHEN: UPGRADE 2 BACKSPLASH - INCLUDES BEHIND HOOD FAN TO CEILING
Line29307	Note: HORIZONTAL STACKED PATTERN
9Oct19 / 16Nov19	

Inv.2,091	1 - FOYER / POWDER / KITCHEN-BREAKFAST / SIDE ENTRANCE LANDING: UPGRADE 5 FLOOR TILE - 24X24" LAID IN STRAIGHT STACKED PATTERN.
Line29308	Note:
9Oct19 / 16Nov19	

Inv.2,091	1 - MASTER ENSUITE FLOOR TILE: UPGRADE 2 12X24" LAID IN STRAIGHT, STACKED PATTERN. SEE PLAN FOR TILE DIRECTION
Line29312	Note:
9Oct19 / 16Nov19	

ELECTRICAL

Inv.2,091	5 - KITCHEN: 4" LED POTLIGHT (PRICE FOR 10 OR MORE)
Line29282	Note: SEE PLAN FOR LOCATION
9Oct19 / 16Nov19	

Inv.2,091	1 - FAMILY ROOM: 110V WALL RECEPTACLE ON DEDICATED CIRCUIT- LOCATE APPROX. 66" A.F.F. ABOVE FIREPLACE
Line29278	Note:
9Oct19 / 16Nov19	

Inv.2,091	1 - KITCHEN: RELOCATE STANDARD FIXTURE - TO ABOVE ISLAND, SEE PLAN FOR LOCATION
Line29279	Note:
9Oct19 / 16Nov19	

Inv.2,091	1 - KITCHEN: ROUGH - IN CEILING OUTLET ON SAME SWITCH - DOES NOT INCLUDE FIXTURE - LOCATE ABOVE ISLAND, USE SAME SWITCH AS STANDARD LIGHT
Line29280	Note: SEE PLAN FOR LOCATION
9Oct19 / 16Nov19	

Inv.2,091	1 - KITCHEN: SINGLE POLE SWITCH
Line29283	Note: FOR POTLIGHTS
9Oct19 / 16Nov19	

Inv.2,091	6 - FAMILY ROOM: 4" LED POTLIGHT (PRICE FOR 10 OR MORE)
Line29284	Note:
9Oct19 / 16Nov19	

Inv.2,091	1 - FAMILY ROOM: SINGLE POLE SWITCH
Line29285	Note: FOR POTLIGHTS
9Oct19 / 16Nov19	

Inv.2,091	1 - KITCHEN: CHIMNEY-STYLE HOOD FAN - CYCLONE #SCB50130
Line29286	Note:
9Oct19 / 16Nov19	

Brampton Encore - 87L - 2 - 28-6 Elev.A Berlio

Inv.2,091	1 - KITCHEN: 110V WALL RECEPTACLE ON DEDICATED CIRCUIT - GAS FIRED APPLIANCE - FOR AUX. EQUIPMENT - NOT A STOVE PLUG
Line29287	Note:
9Oct19 / 16Nov19	

Exterior Colours

Inv.2,091	1 - Exterioir Colour Package #9
Line29773	Note:
9Oct19 / 16Nov19	

FORMING

Inv.2,091	1 - SIDE DOOR- HOME TO EXTERIOR- AS PER PLAN AND GRADE PERMITTING
Line29320	Note:
9Oct19 / 16Nov19	
Inv.2,091	1 - Mandoor - Garage To House - As Per Plan And Grade Permitting
Line29778	Note:
9Oct19 / 16Nov19	

FRAMING

Inv.2,091	1 - MAIN FLOOR: *NOTE* 96" DOORS AND ARCHES
Line29299	Note:
9Oct19 / 16Nov19	
Inv.2,091	1 - MANDOOR - GARAGE TO HOUSE- AS PER PLAN AND GRADE PERMITING
Line29319	Note:
9Oct19 / 16Nov19	
Inv.2,091	1 - Side Door - Home To Exterior - As Per Plan And Grade Permitting
Line29777	Note:
9Oct19 / 16Nov19	

GARAGE DOORS

Inv.2,091	2 - GARAGE DOOR OPENER - WITH 1 REMOTE- PRICE IS PER DOOR *BELT DRIVE*
Line29293	Note:
9Oct19 / 16Nov19	
Inv.2,091	1 - GARAGE DOOR: DIGITAL ENTRY KEYPAD
Line29294	Note:
9Oct19 / 16Nov19	

GRANITE MARBLE QUARTZ

Inv.2,091	1 - KITCHEN: UPGRADE 5 QUARTZ COUNTER TOP
Line29305	Note:
9Oct19 / 16Nov19	
Inv.2,091	1 - KITCHEN: FLUSH BREAKFAST BAR
Line29306	Note:
9Oct19 / 16Nov19	
Inv.2,091	1 - MASTER ENSUITE: UPGRADE 1 QUARTZ COUNTER TOP
Line29313	Note:
9Oct19 / 16Nov19	

Brampton Encore - 87L - 2 - 28-6 Elev.A Berlio

HARDWOOD

Inv.2,091	1 - MAIN FLOOR: FAMILY / FORMAL / LANDING: UPGRADE 4 - VINTAGE 3/4 X 5" HAND SCRAPED WHITE OAK
Line29309	Note:
9Oct19 / 16Nov19	
Inv.2,091	1 - UPPER HALL: UPGRADE 4 - VINTAGE 3/4 X 5" HAND SCRAPED WHITE OAK
Line29310	Note:
9Oct19 / 16Nov19	

HVAC

Inv.2,091	1 - KITCHEN: GAS LINE ROUGH - MAIN FLOOR - (2 STOREY MODELS)
Line29288	Note:
9Oct19 / 16Nov19	
Inv.2,091	1 - KITCHEN: A/C - 2.5 TON
Line29296	Note:
9Oct19 / 16Nov19	
Inv.2,091	1 - HUMIDIFIER: WB3 - 17 (UP TO 3,000 SQ.FT.)
Line29295	Note:
9Oct19 / 16Nov19	
Inv.2,091	1 - *note* chimney style hood fan
Line29318	Note:
9Oct19 / 16Nov19	

INTERIOR TRIM AND DOORS

Inv.2,091	3 - MAIN FLOOR: EXTENDED HEIGHT ARCHWAY (PRICE PER DOORWAY) -96"
Line29297	Note:
9Oct19 / 16Nov19	
Inv.2,091	3 - MAIN FLOOR: STANDARD DOOR EXTENDED HEIGHT 96" (PRICE PER DOOR)- GROUND FLOOR 2 STOREY MODELS
Line29298	Note:
9Oct19 / 16Nov19	
Inv.2,091	1 - *note* man door + side door
Line29321	Note:
9Oct19 / 16Nov19	

KITCHEN AND BATH CABINETRY

Inv.2,091	1 - KITCHEN: DELETE UPPERS ABOVE STOVE, FINISH SIDES OF CABINETS. LEAVE APPROX. 36" SPACE FOR 30" CHIMNNEY-STYLE HOOD FAN
Line29289	Note:
9Oct19 / 16Nov19	
Inv.2,091	1 - KITCHEN: SLIDE IN STOVE PREP - 30" RANGE
Line29290	Note:
9Oct19 / 16Nov19	
Inv.2,091	1 - KITCHEN: UPGRADE 3 PROFILE - PVC LACQUER
Line29301	Note:
9Oct19 / 16Nov19	

Brampton Encore - 87L - 2 - 28-6 Elev.A Berlio

Inv.2,091	2 - KITCHEN: POTS AND PANS DRAWERS - SHALLOW TOP DRAWER + 2 DEEP DRAWERS BELOW
Line29302	Note: LOCATE EITHER SIDE OF RANGE
9Oct19 / 16Nov19	
Inv.2,091	1 - KITCHEN: RELOCATE STANDARD BANK OF 4 DRAWERS TO ISLAND
Line29303	Note:
9Oct19 / 16Nov19	
Inv.2,091	1 - KITCHEN: 2 DOOR DEEP PANTRY
Line29304	Note: SEE PLAN FOR LOCATION PRICE INCLUDES DEEP GABLE
9Oct19 / 16Nov19	

MISC.

Inv.2,091	1 - Purchaser has attended an appointment at the Decor Centre & has DECLINED any additional upgrades and accepts and acknowledges that there will be no further changes/additions/deletions to be made upon signing on OCTOBER 9, 2019.
Line29315	Note:
9Oct19 / 16Nov19	
Inv.2,091	1 - Purchasers are aware & accepts that ANY changes made to upgrades after signing this Purchasers Extra Form are subject to a minimum administration fee of \$500. PLUS a 10% holdback fee.
Line29316	Note:
9Oct19 / 16Nov19	
Inv.2,091	1 - BONUS PACKAGE: \$5,000.00 (INCLUDING TAXES) WORTH OF UPGRADES FROM GOLD PARK HOMES DÉCOR CENTRE IS BEING APPLIED TOWARD THIS ORDER. PURCHASER HAS A REMAINING AMOUNT OF \$00 (INCLUDING TAXES).
Line29317	Note:
9Oct19 / 16Nov19	

PAINT

Inv.2,091	1 - MAIN STAIRS: STAIN STAIRS TO MATCH HARDWOOD AS CLOSE AS POSSIBLE
Line29311	Note:
9Oct19 / 16Nov19	

PLUMBING

Inv.2,091	1 - KITCHEN: ROUGH-IN - WATERLINE FOR FRIDGE
Line29300	Note:
9Oct19 / 16Nov19	

PLUMBING FIXTURES

Inv.2,091	2 - MASTER ENSUITE: CONTRAC 'CALVIN' OVAL UNDERMOUNT SINK #4220CFY
Line29314	Note:
9Oct19 / 16Nov19	

WINDOWS - BASEMENT

Inv.2,091	4 - BASEMENT WINDOWS - UPGRADE EXISTING BASEMENT WINDOW TO 30 INCH X 24 INCH - MAY REQUIRE INSTALLATION OF WINDOW WELL
Line29291	Note:
9Oct19 / 16Nov19	

WINDOWS AND DOORS

Brampton Encore - 87L - 2 - 28-6 Elev.A Berlio

Inv.2,091	1 - Side Door and Garage Mandoor
Line29776	Note:
9Oct19 / 16Nov19	

*** NOTE: This is not an approved document. Document must be locked ***

Scheduled Closing Date:

Purchaser: Ravinder Singh Ghotra Property: 87L
Telephone Res. / Bus: Project: Brampton Encore - Phase 2
Decor Advisor: Yolande Somerville Model and Elevation: 28-6 Elev.A Berlio

Layout Changes: Yes No Sketch Attached: Yes No Exterior Colour Scheme:

1. Cabinetry

	Style and Colour	Counter	Hardware
Kitchen / Breakfast	*Aston PVC-Lacq. 'White mt'	*Quartz: 'Super White'	cs1-24
Laundry Room	n/a	n/a	n/a
Powder Room	n/a	n/a	n/a
Main Bath	M-500 mel. 'Mystic'	P-Lam #4925k-07	cs1-25
Master Ensuite Bathroom	M-500 mel. 'Mystic'	*Quartz: 'Silky White'	cs1-23
Second Ensuite Bathroom (If Applicable)	n/a	n/a	n/a

Comment

2. Floor Tile

	Selection
Entrance Vestibule	*24x24" Carrara X Polished 'White'
Main Hall	n/a
Kitchen / Breakfast	*24x24" Carrara X Polished 'White'
Laundry Room	13x13" New Reeds 'Brown'
Powder Room	*24x24" Carrara X Polished 'White'
Side Entrance Landin	*24x24" Carrara X Polished 'White'
Master Ensuite Bathroom	*12x24" New Byzantine 'Azzuro Blue)
Second Ensuite Bathroom (If Applicable)	n/a
Lower Landing (If Applicable)	n/a
Main Bath	13x13" New Reeds 'Brown'

Comment

3. Wall Tile

	Selection	Listello/Inserts	Describe
M. Ens. Tub skirt/splash	8x10" Weave 'White'	Yes No	
Master Ensuite Bathroom			
Tub Deck	8x10" Weave 'White'	Yes No	
Shower Stall	8x10" Weave 'White'	Yes No	
Bathroom Walls	n/a	Yes No	
Second Ensuite Bathroom (If Applicable)	n/a	Yes No	
Main Bath	8x10" Weave 'White'	Yes No	
Kitchen Backsplash	Yes No	Backsplash Behind Fridge	
Comment	2x6" Vitro Slim pol glass 'Dk Grey'		

B-splash - install horizontal stacked pattern



*** NOTE: This is not an approved document. Document must be locked ***

Scheduled Closing Date:

Purchaser: Ravinder Singh Ghotra Property: 87L
Telephone Res. / Bus: Project: Brampton Encore - Phase 2
Decor Advisor: Yolande Somerville Model and Elevation: 28-6 Elev.A Berlio

4. Plumbing Fixtures

Master Ensuite Bathroom Second Ensuite Powder Room
Other Room - Specify Other Washroom
Comment: Std thru out except M. Ensuite sinks

5. Hardwood Flooring

Main Hall Kitchen / Breakfast Living Room Dining Room Family Room Den/Library Entrance Vestibule Lower Landing (If Applicable)
Type and Stain: n/a, n/a, n/a, n/a, *5" Vintage H. S 'Baroque', n/a, n/a, n/a
Upper Landing Upper Hall Master Bedroom Bedroom #2 Bedroom #3 Bedroom #4 Bedroom #5 Other Room - Specify Formal Room
Type and Stain: *5" Vintage H. S 'Baroque', *5" Vintage H. S 'Baroque', n/a, n/a, n/a, n/a, n/a, *5" Vintage H. S 'Baroque'
Comment: Vintage White oak 3/4x5" hand scraped 'Baroque'

6. Carpeting

Ground Floor Second Floor
Upgrade Description
Type Area
Upgrade Underpad Capped Runner - *Upgrade
Carpet on Stairs
Comment

7. Fireplace

Living Room Family Room Other Room - Specify
Purchased As Per Plan N/A
Fireplace Type Mantle Type Colour / Stain Surround Hearth
Standard Gas NF-20 White Nero Marquina none
Comment: [Signature]

Scheduled Closing Date:

Purchaser: Ravinder Singh Ghotra

Property: 87L

Telephone Res. / Bus:

Project: Brampton Encore - Phase 2

Decor Advisor: Yolande Somerville

Model and Elevation: 28-6 Elev.A Berlio

8. Trim Carpentry

Interior Doors **standard Front Door Glass Inserts standard Door Handles standard

Interior Trim standard

Comment

** Standard profile, 96" on main floor

9. Plaster Mouldings and Medallions

Standard Throughout ☐ Yes ☐ No ☒ N/A

Entrance Vestibule			Kitchen/Breakfast		
Main Hall			Den/Library		
Living Room			Lower Landing		
Dining Room			Other Room - Specify		
Family Room					

Comment

10. Railings and Spindles

Railing Package	Standard Oak	
Railing Colour	*Baroque	Spindle Colour *Baroque
Stringer / Riser	*Baroque	Treads *Baroque
Comment		Oak Stairs ☒ Yes ☐ No ☐ N/A

11. Wall Paint / Ceilings

Throughout Finished Areas Cool White

Trim Paint White

Smooth Ceilings

Ground Floor	☒	STD .
Second Floor	☐	
Note		

Comment

29

*** NOTE: This is not an approved document. Document must be locked ***

Scheduled Closing Date:

Purchaser: Ravinder Singh Ghotra

Property: 87L

Telephone Res. / Bus:

Project: Brampton Encore - Phase 2

Decor Advisor: Yolande Somerville

Model and Elevation: 28-6 Elev.A Berlio

12. Electrical

Hood Fan ☐ White ☒ Stainless ☐ N/A

Above Kitchen Cabinet Light ☐ Yes ☒ No

Below Kitchen Cabinet Light ☐ Yes ☒ No

Standard Appliances ☐

Over The Range Microwave ☐

Chimney Style Fan ☒

Comment

13. Heating and Air Conditioning

Air Conditioning

Gas Provisions Stove

Gas Provisions Dryer

Gas Provisions Barbecue

Comment

14. Additional Comments

15. Disclaimers and Notes


- 1) Colours of all materials are as close as possible to builder's selection, but not necessarily identical due to variances in manufacturing.
- 2) Any extras listed above are null and void unless accompanied by a separate invoice/amendment. Said invoice must be paid in full.
- 3) The Purchaser acknowledges that after Interior Colour Selection form is signed and dated, no further changes will be permitted other than re-selection due to unavailability. _____ Purchaser's Initials
- 4) The Purchaser acknowledges reading and accepting the "Gold Park Homes Decor Centre Disclaimers" form. This document contains other miscellaneous disclaimers.

This Interior Colour Selection is final and approved by:


Signature: _____ Date: _____

The
Berlio
SEMI SERIES

- Elevation A • 2,047 sq.ft.
- Elevation B • 2,037 sq.ft.
- Elevation C • 2,037 sq.ft.
- Elevation D • 2,047 sq.ft.

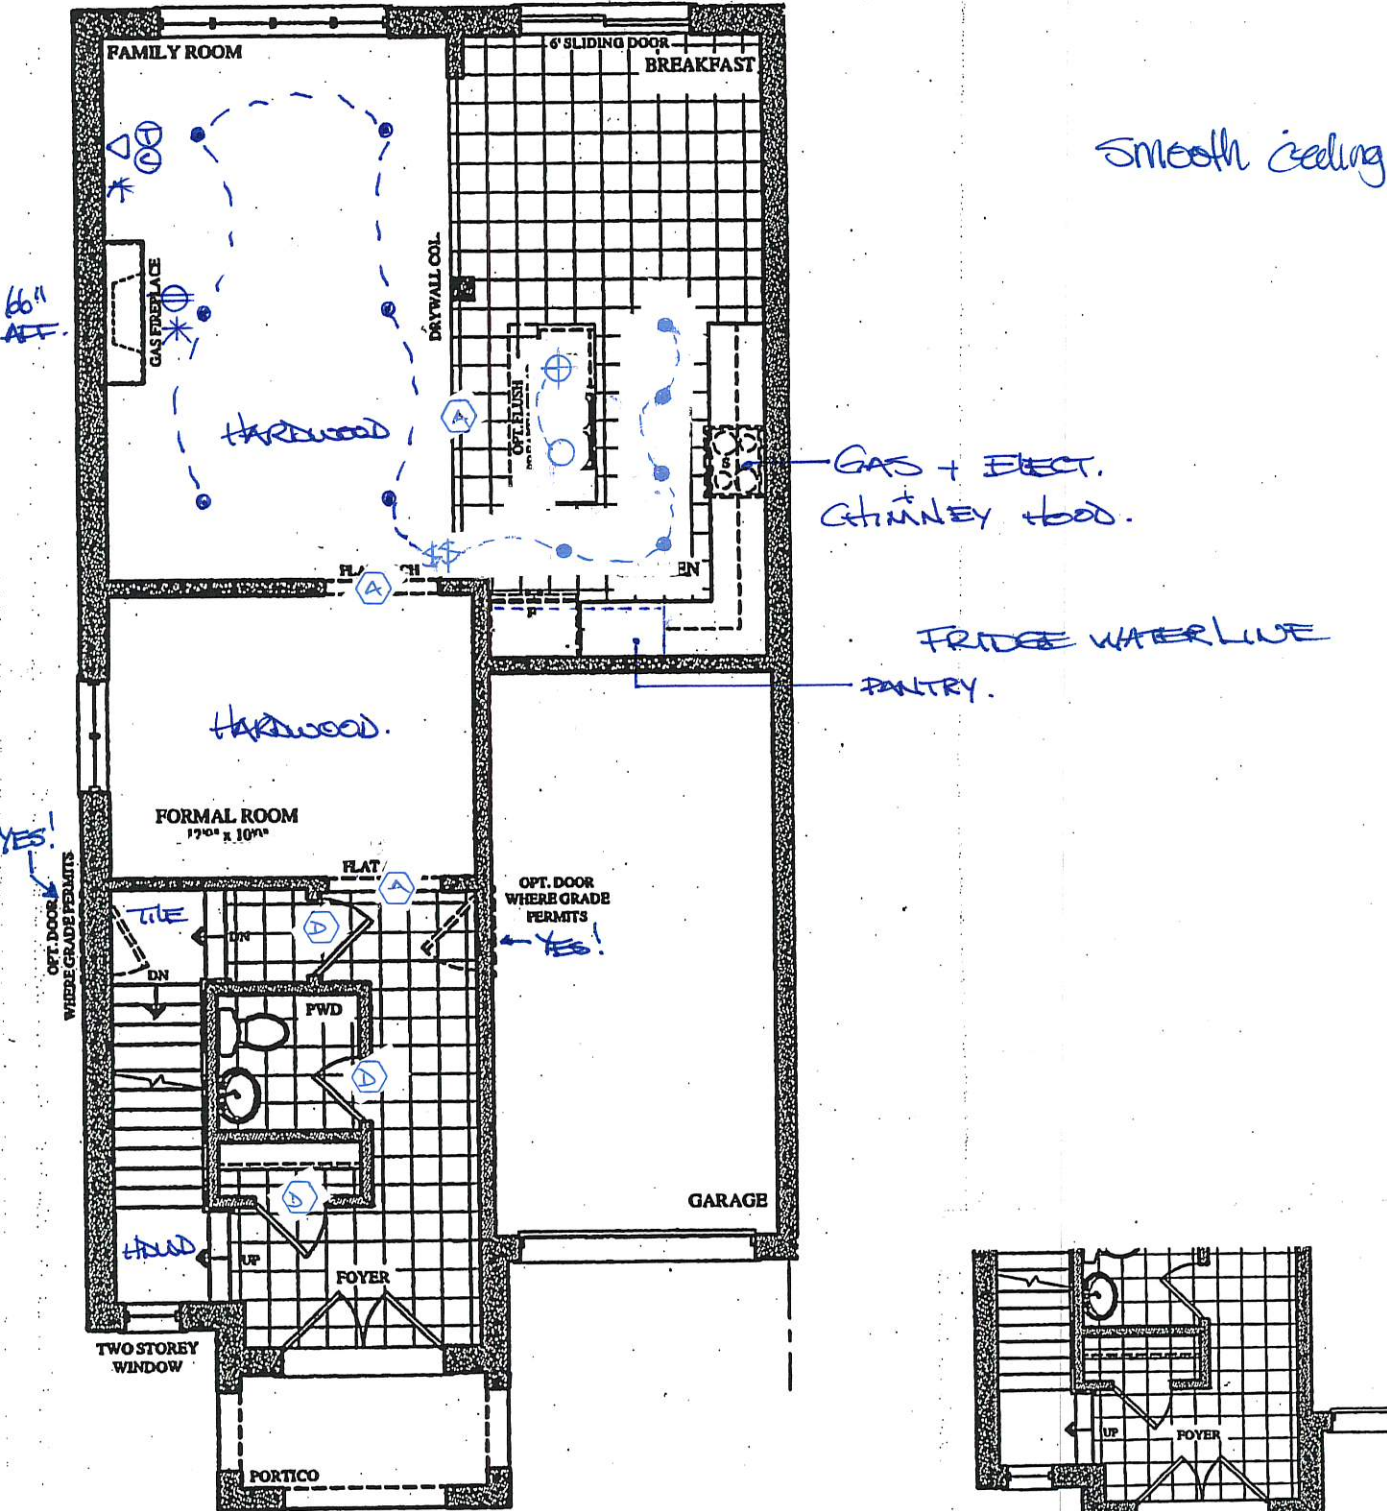


GROUND FLOOR PLAN
ELEV. 'A' & 'B'

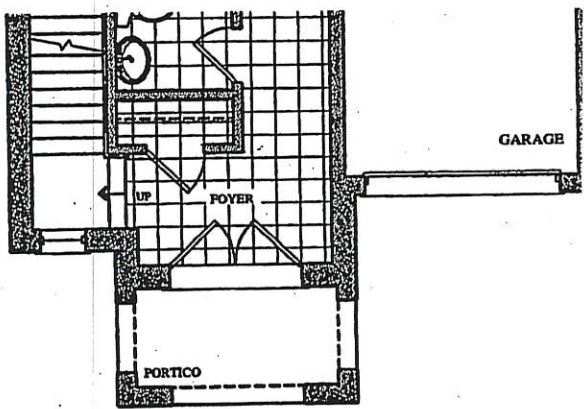


PART. GROUND FLOOR PLAN
ELEV. 'C' & 'D'

BEZ-87L
OCTOBER 9 2019


Elevation A • 2,047 sq.ft.
Elevation B • 2,037 sq.ft.
Elevation C • 2,037 sq.ft.
Elevation D • 2,047 sq.ft.

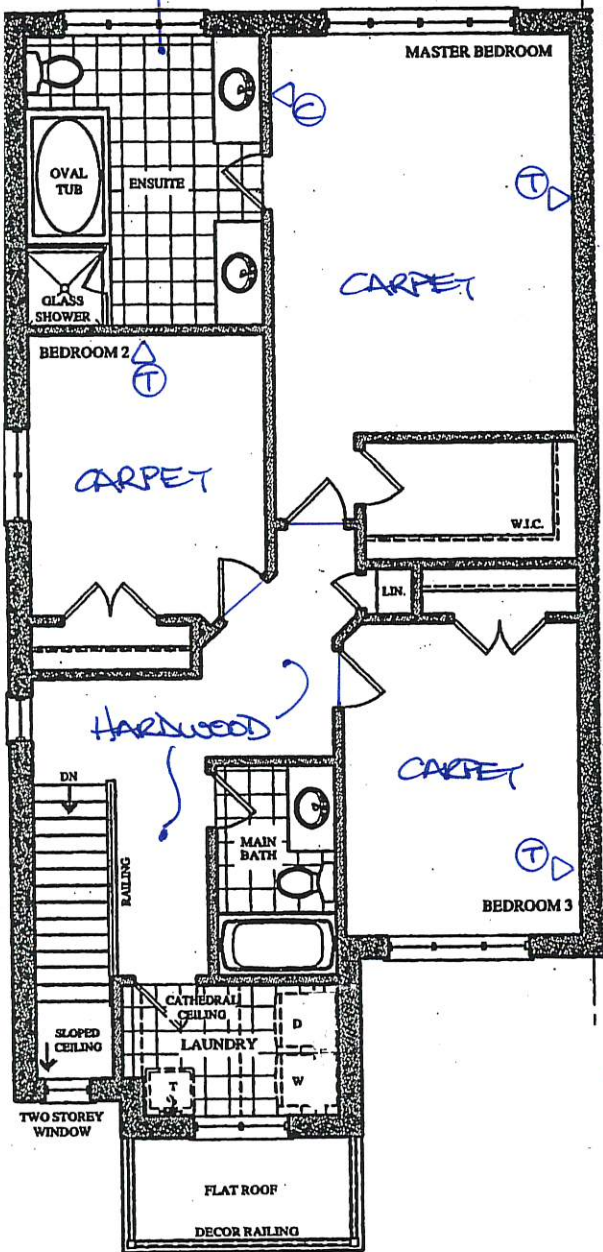


SECOND FLOOR PLAN
ELEV. 'A'

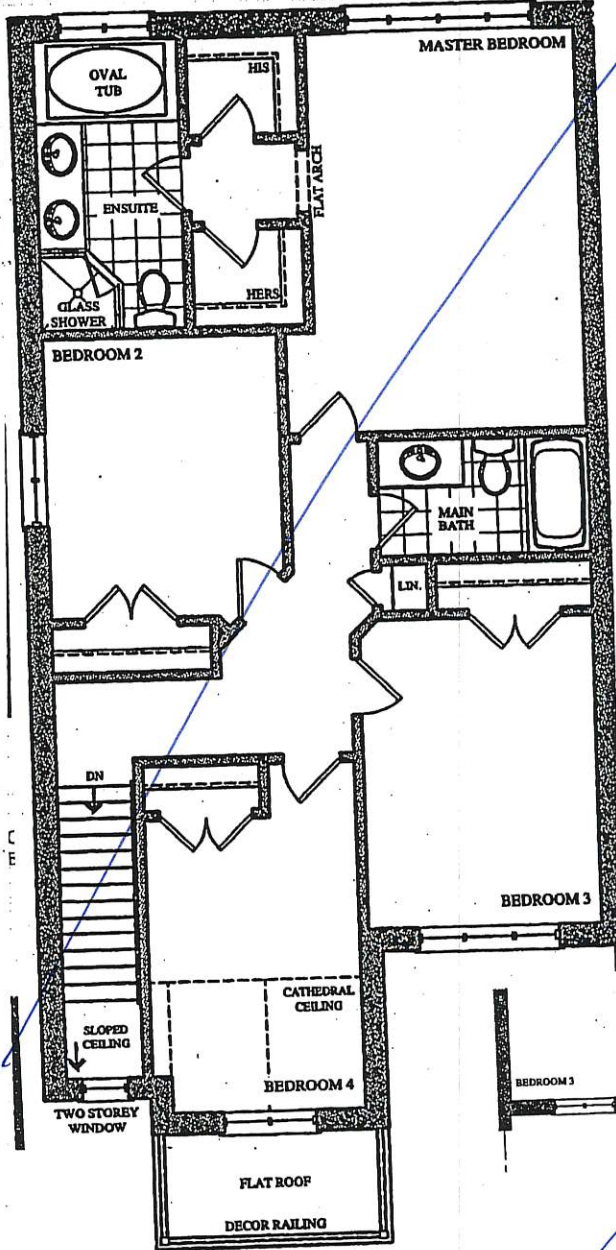


P. E
OPT. 4 BED SECOND FLOOR PLAN
ELEV. 'A'

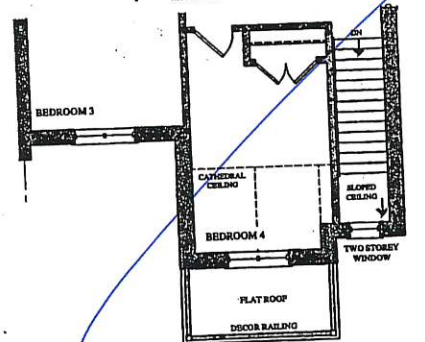


PART. OPT. 4 BED SECOND FLOOR PLAN
ELEV. 'B'

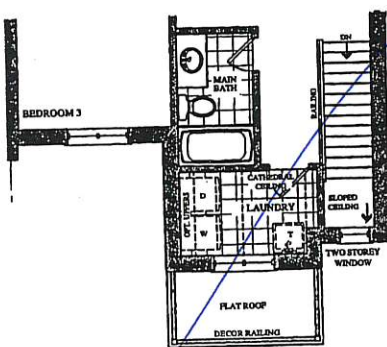


PART. SECOND FLOOR PLAN
ELEV. 'B'

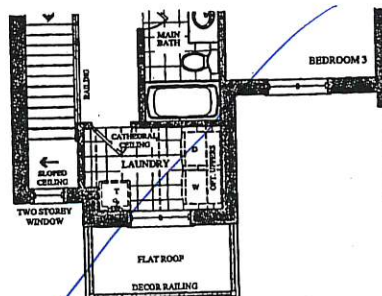


PART. SECOND FLOOR PLAN
ELEV. 'C'

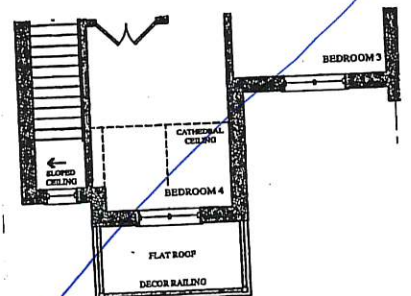

PART. OPT. 4 BED SECOND FLOOR PLAN
ELEV. 'C'

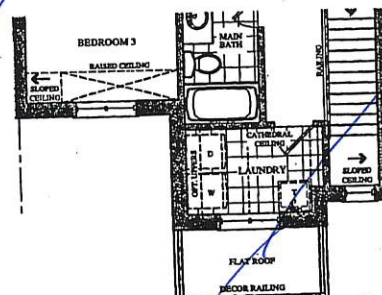

PART. SECOND FLOOR PLAN
ELEV. 'D'

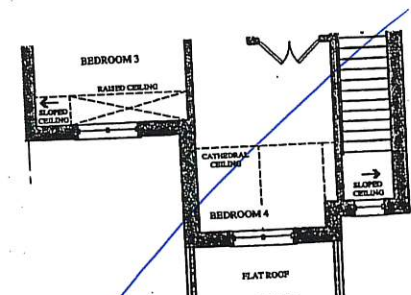


PART. OPT. 4 BED SECOND FLOOR PLAN

BEZ-87L
OCTOBER 9 2019



The
Berlio
SEMI SERIES

- Elevation A • 2,047 sq.ft.
Elevation B • 2,037 sq.ft.
Elevation C • 2,037 sq.ft.
Elevation D • 2,047 sq.ft.

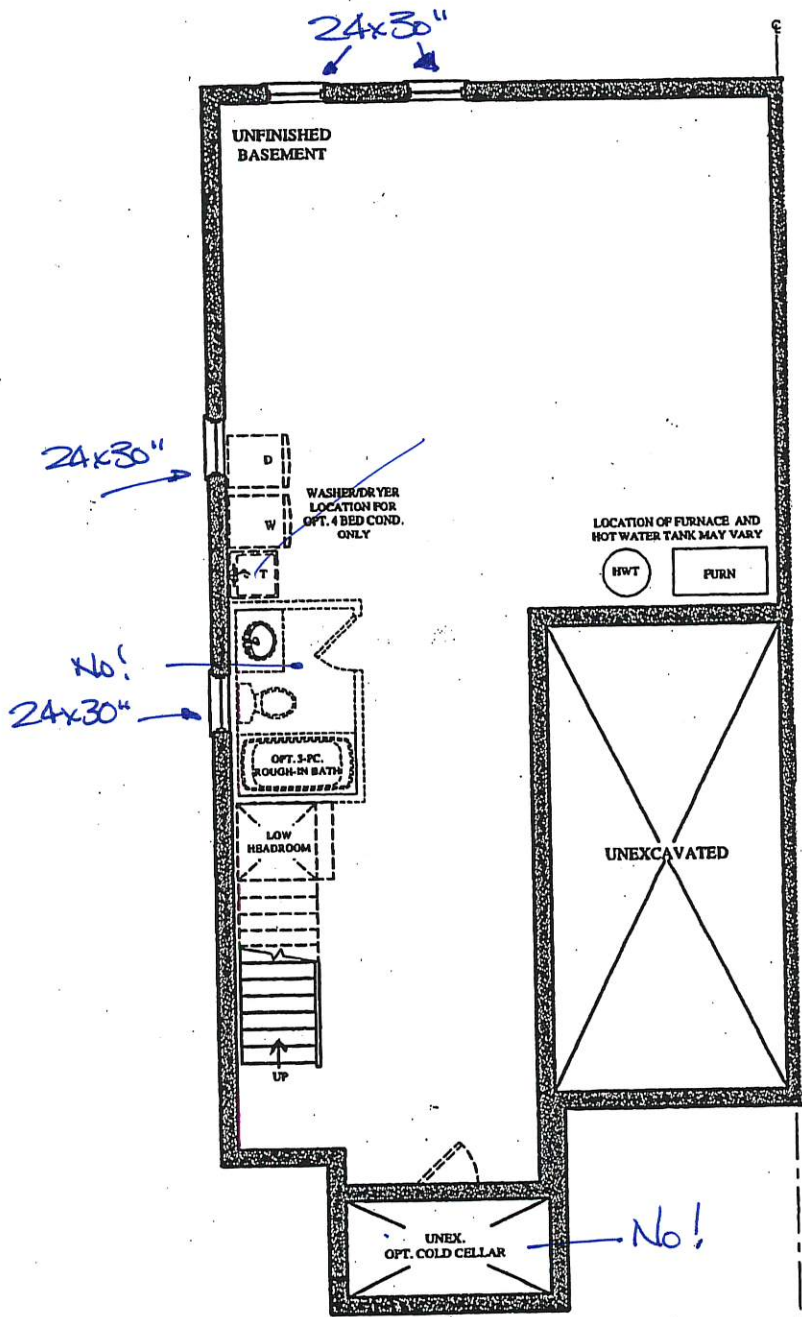

BASEMENT FLOOR PLAN
ELEV. 'A', 'B', 'C' & 'D'

Prices, figures, illustrations, sizes, features and finishes are subject to change without notice. Areas and dimensions are approximate and actual usable floor space may vary from the stated area. Layout may be reverse of the unit purchased. E. & O.E.

GOLDPARK
WORTH MOR



Trade Name: Gold Park Homes

Site location: Brampton





Model: SD-6

Address:



Project: Encore

Phase:

This layout has been explained to the purchaser by Cortina Kitchens Inc. and is understood by the purchaser.

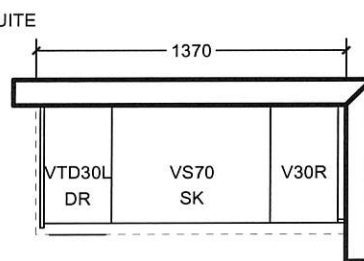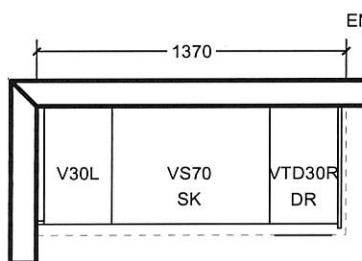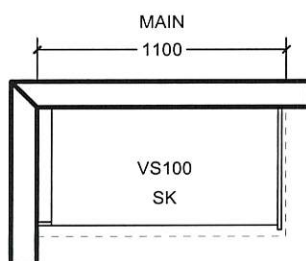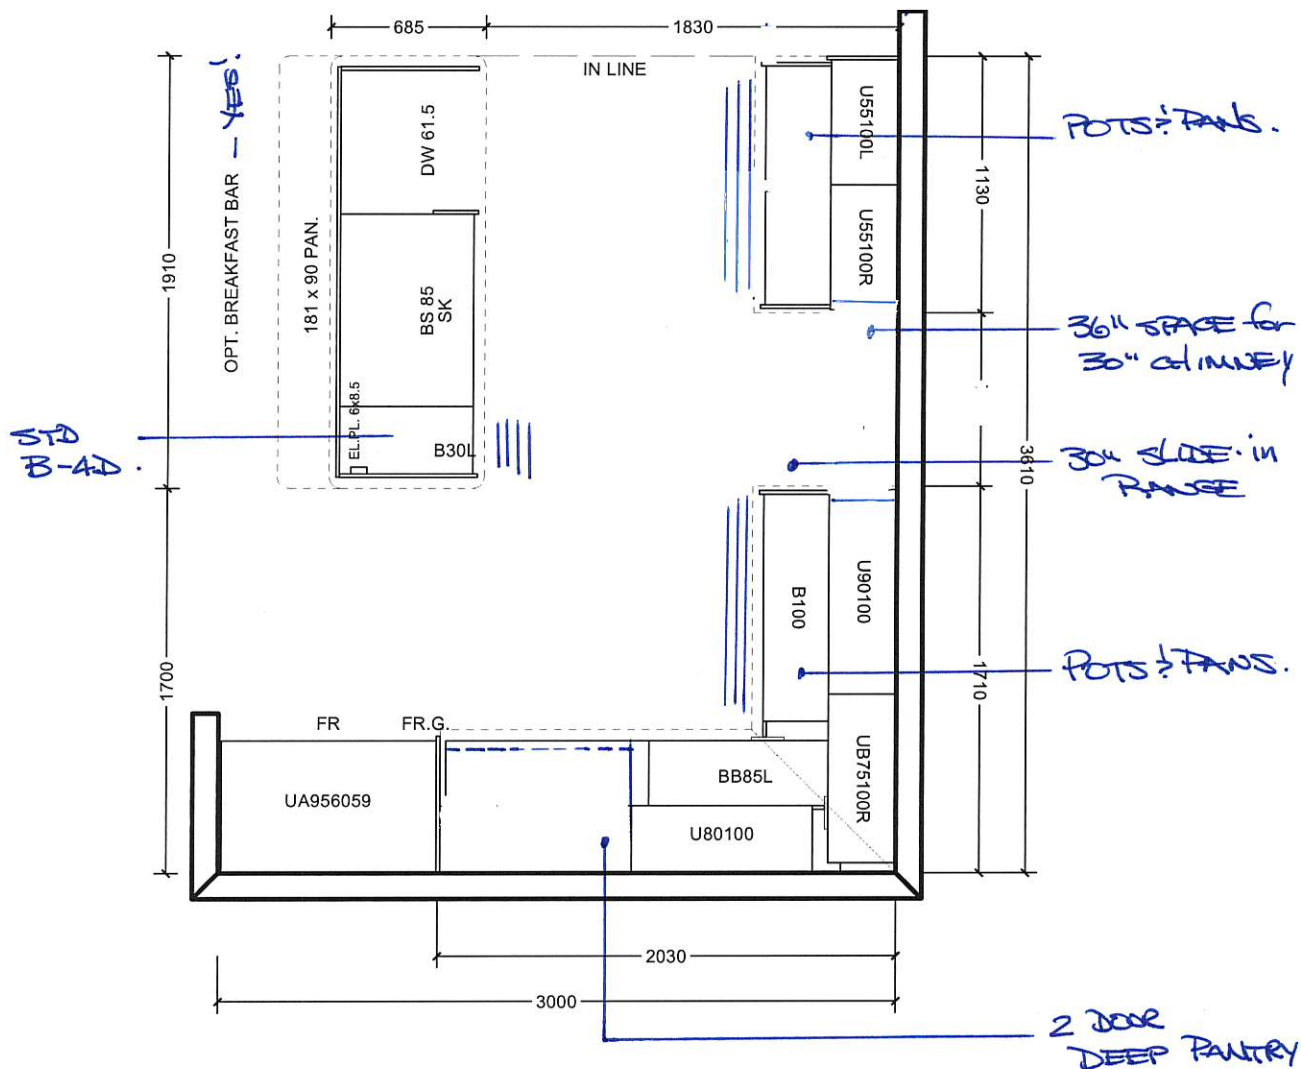

OPT. SECOND FLOOR 4 B.R.

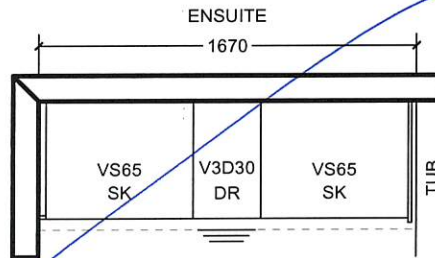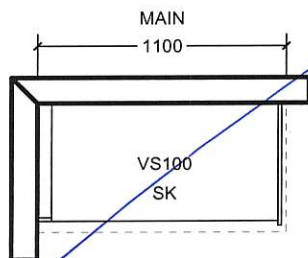

All prices subject to confirmation from head office.
This quotation is subject to the terms & conditions set out
in Cortina's Agreement of Purchase and Sale

ACCEPTED DATE: _____

CUSTOMER SIGNATURE

SALESPERSON SIGNATURE

CORTINA HEAD OFFICE APPROVAL

ITEM A. Wood grain and colour are characteristics of the product, we cannot guarantee that such grain and colour will always match
ITEM B. Cortina Kitchens reserves the right to alter dimensions and make technical changes without notice.

GOLDPARK

WORTH MORE




Granite, Marble,
Engineered Surfaces

- Standard 2CM & 3CM
- ⊖ Upgrade 1.2CM & 3CM
- ⊗ Upgrade 1.4CM
- ⊕ Upgrade 2

22mm / 3/4" Profile


Kitchen +

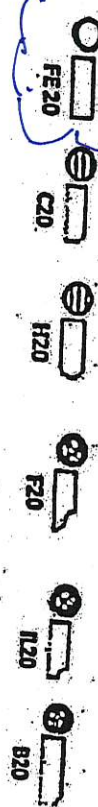


Master Ensuite



30mm / 1 1/4" Profile

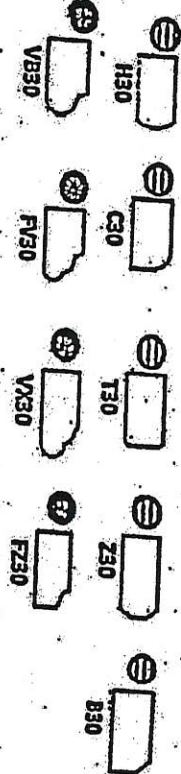

40mm / 1 1/2" Profile

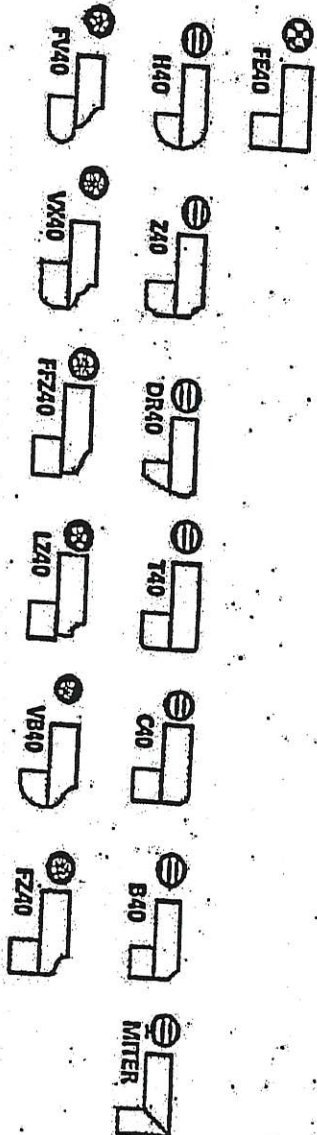

Note: All colours may not be available in 30mm at time ordered. Vendor reserves the right to use 40mm edges (by lamination process).


*Mitre edge is available in Upgrade 1 for an overall thickness of 2". All other Mitre edge options will be an Upgrade 2 Edge.

FE2-87L
Oct 9 2009



Calvin

19¼" Oval
4220CFY Undermount Sink

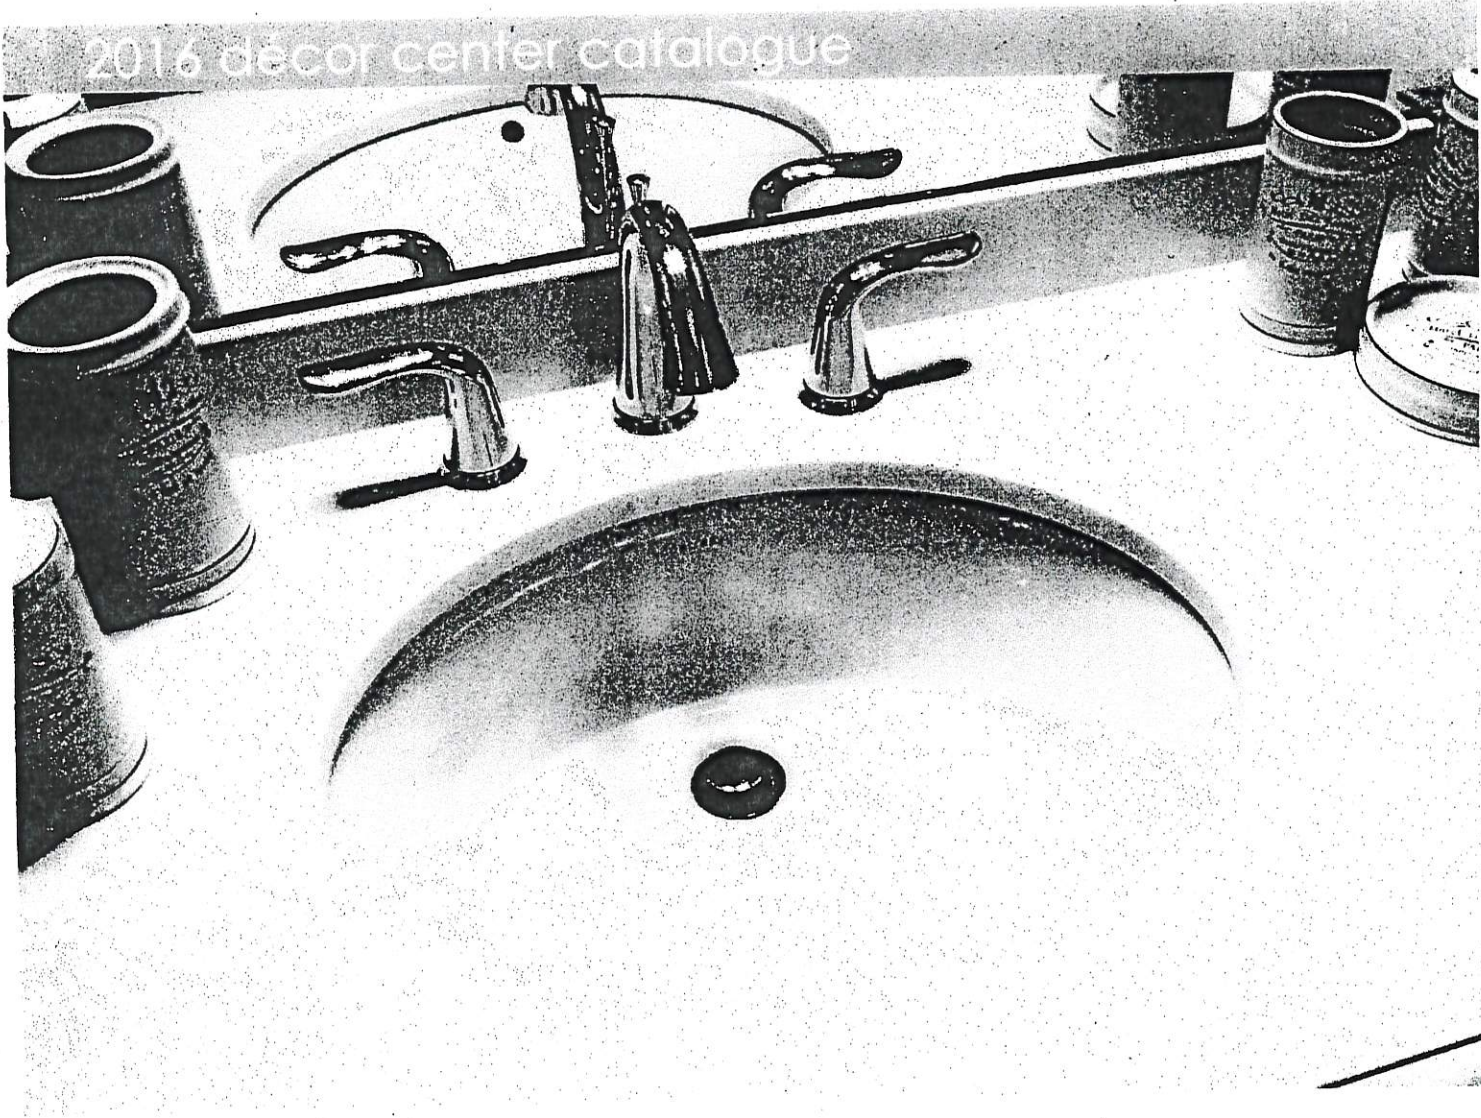

FEATURES


- Vitreous china
- Front overflow hole
- Template and mounting hardware supplied
- Overall dimensions (W x D x H):
(OD): 19¼" x 16½" x 7⅝"
(ID): 17" x 13¾" x 5¾"

CERTIFICATIONS


- IAPMO cUPC
- ASME A112.19.2 / CSA B45.1-2008

COLOUR

Soft white

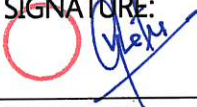LOT # 87L	
ROOM: MASTER EN-suite	SIGNATURE: 
DATE: Oct. 9 2019	SIGNATURE:


BEZ-87L
OCT 9 2009

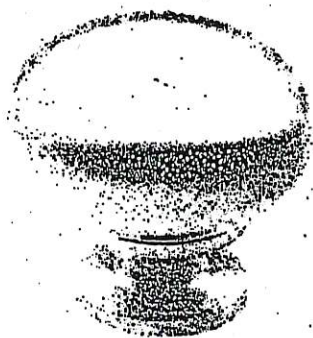


CSI-6




CSI-10

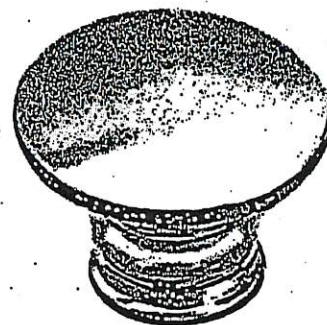


CSI-14

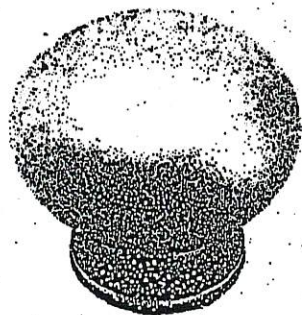

CSI-16

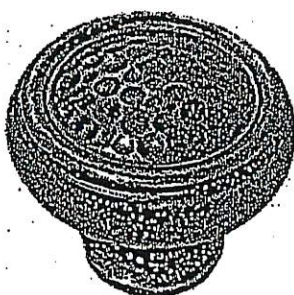

CSI-18

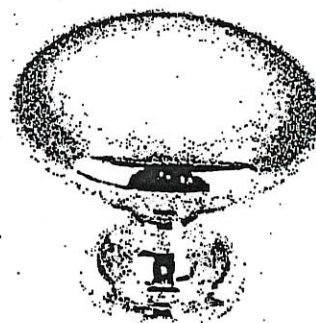

CSI-19




CSI-20




CSI-21




CSI-22

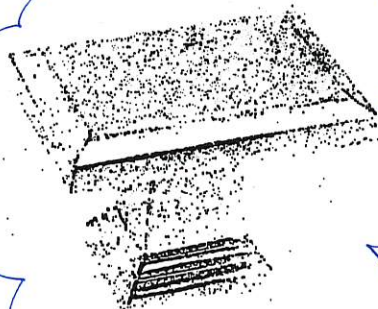

CSI-23

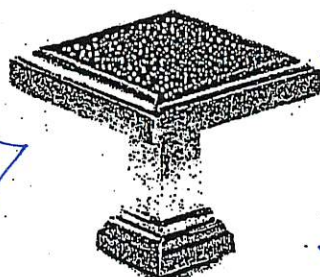


CSI-24

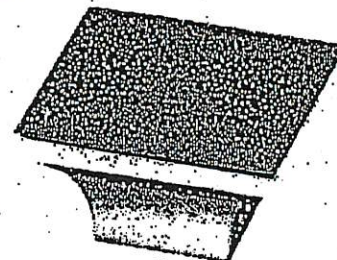


CSI-25

*NOTES:

- IMAGES ARE FOR QUICK REFERENCE PURPOSES ONLY
- ACTUAL SIZES AND FINISHES AS PER HARDWARE SAMPLE BOARD PROVIDED TO DECOR CENTRE

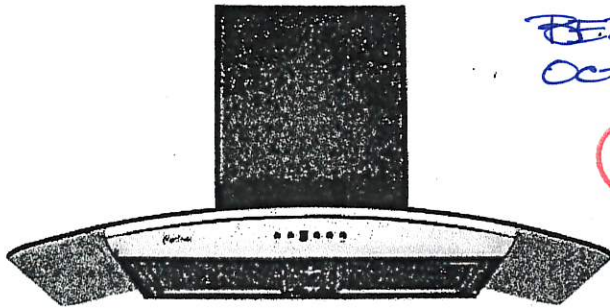

Mesh Filter

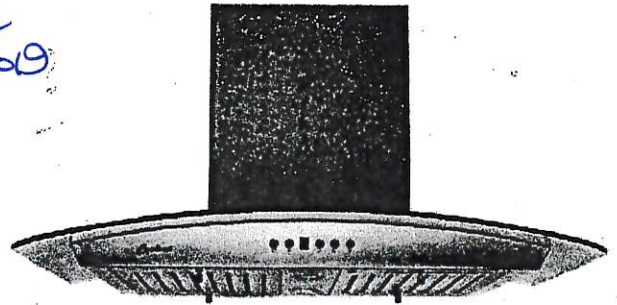

Baffle Filter

Wall Mount

A very stylish exhaust fan, it is the perfect balance of substance and style. The graceful contour of the arched glass canopy coupled with the brilliant shine of the stainless steel body give an impression that is at once both modern and classic. The hood features a digital three-speed control panel, button controlled LED lights, two mesh or baffle filter screens, and a quiet, efficient motor. Fitted with time-delay "OFF" options up to nine minutes.

Specifications

Air Flow Volume: 550 CFM

Electrical Connection: 120V/60Hz

Electrical Consumption: 200 Watts

Fan Speed: 1599 RPM

Finishes: Stainless Steel

Venting: 6" Round - Top Only


Dimensions: Width: 30"/36"

Height: 44 1/2"

Depth: 19 3/4"

Sones: Min. 2

Max. 6

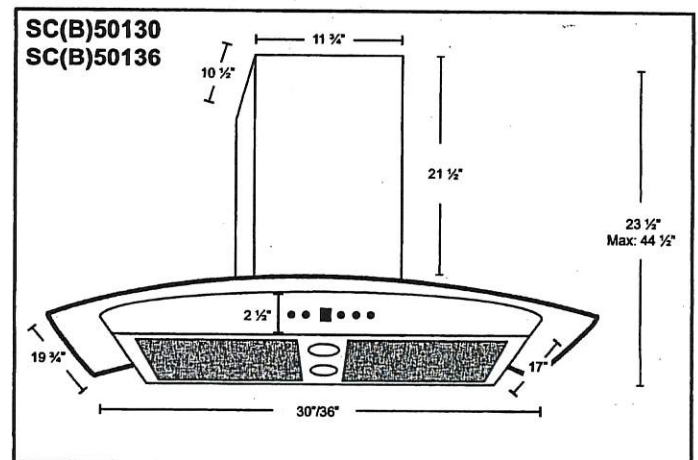

* B in the model name denotes a model with baffle filters.

SC501 - Mesh Filters

SCB501 - Baffle Filters

Model	Colour	Venting	Size
→ SC(B)50130	Stainless Steel	6"	30" →
→ SC(B)50136	Stainless Steel	6"	36"


NX58H9500WS

5.8 cu. ft. Slide-in Gas Range

INSTALLING YOUR RANGE



30" minimum clearance between the top of the cooking surface and the bottom of an unprotected wood or metal cabinet; or 24" minimum when the bottom of the wood or metal cabinet is protected by not less than 1/4" flame retardant millboard covered with not less than no.28 MSG sheet steel, 0.015" stainless steel, 0.024" aluminum or 0.020" copper.

18" minimum between the countertop and the adjacent cabinet bottom.

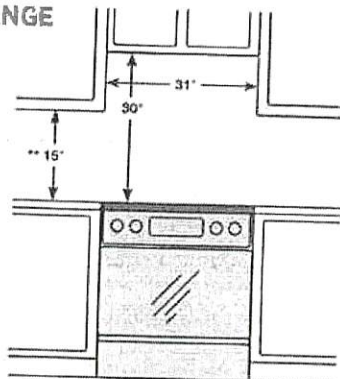


IMPORTANT: To eliminate the risk of burns or fire caused by reaching over heated surface units, cabinet storage space located above the surface units should be avoided. If cabinet storage is to be provided, the risk can be reduced by installing a range hood that projects horizontally a minimum of 5" beyond the bottom of the cabinets.

Dimensions

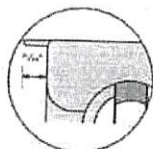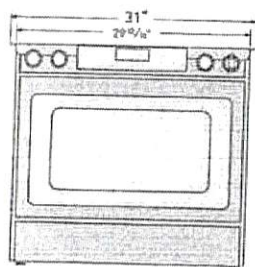

Glass cooktop overlaps and sits on top of your kitchen countertop to give a built-in look. Cut out space for the range is 29 1/2".

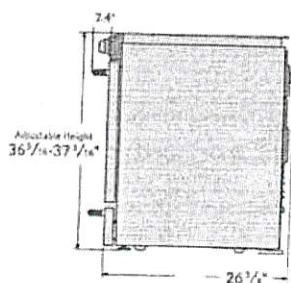

Total Power (BTU)

57,000 BTU

Power Source

120 V/60 Hz

Black Enamel 5 Burner Cooktop

- Right Front: 18000 BTU - Dual
- Left Front: 15000 BTU
- Right Rear: 5000 BTU
- Left Rear: 9500 BTU
- Center Rear: 9500 BTU - Oval

Oven

- Bake: 150°F - 550°F
- Convection Bake: 150°F - 550°F
- Bake Burner: 18000 BTU
- Broil Burner: 16000 BTU
- Variable Broil: Low/Hi (375°F - 480°F)
- Convection Roast: 150°F - 550°F
- Sabbath Mode

Warming Drawer

- Capacity: 0.7 cu. ft.
- Heating Performance: 600 W
- Temperature Settings: 3 Level

Warranty

- One (1) Year All Parts and Labor
- Five (5) Years Gas Cooktop

Product Dimensions & Weight (WxHxD)

Actual Oven Dimensions:

25" x 21 1/8" x 19"

Outside Dimensions:

29 1/2" x 36 1/4" - 37 1/4" (Adjustable) x 26 1/4"

Weight: 202 lbs.

Shipping Dimensions & Weight (WxHxD)

Dimensions:

33 1/4" x 41 3/4" x 30 1/4"

Weight: 225 lbs.

Color

Stainless Steel

Model

NX58H9500WS

UPC Code

887276032047

Black Stainless Steel

NX58K9500WG

887276142890

SAMSUNG

Actual color may vary. Design specifications and color availability are subject to change without notice. Non-metric weights and measurements are approximate.
©2016 Samsung Electronics America, Inc. 85 Challenger Road, Ridgefield Park, NJ 07660. Tel: 800-SAMSUNG samsung.com
Samsung is a registered trademark of Samsung Electronics Co., Ltd.

RF28R7551SR

SAMSUNG

28 cu. ft. 4-Door French Door Refrigerator with 21.5" Connected Touchscreen Family Hub™


BE2-87L
OCT 16 2019 (15)

Installation Specifications


1. Measure the height, width and depth of the opening, making sure to include baseboards, molding tile, countertop overhang, etc. Check to be sure there is enough room to open the door (consider walls, islands or other obstacles when measuring).
2. Refer to illustration below to determine dimensions.
3. Allow 2.5" of clearance on hinge side of refrigerator when installing next to a wall where handle may make contact.
4. Allow 1" minimum clearance at rear for proper air circulation and water/electrical connections. Allow a 3/8" minimum clearance at sides and top for ease of installation.
5. Ensure each door and entryway in the home is wide enough for the refrigerator to be moved through easily.

For optimal usage and to be able to open refrigerator doors completely, do not install next to a wall.

Please note: The following dimension and cutout information is for planning purposes only. For complete installation details, consult manual packed with product, or download manual online at samsung.com.

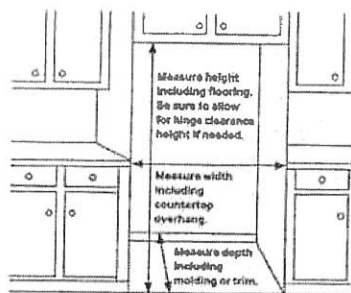

Dimensions

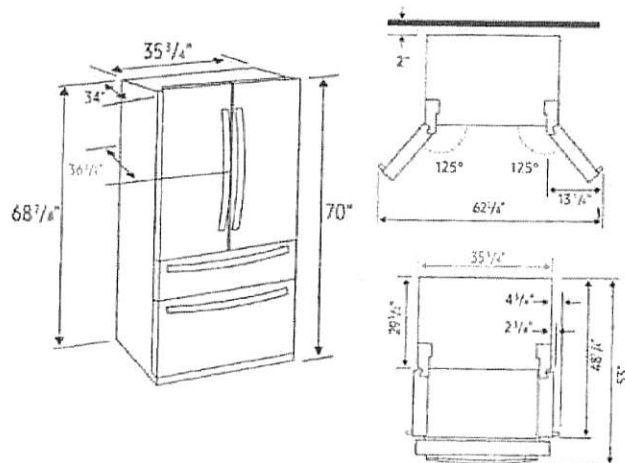

Total Capacity: 27.7 cu. ft.

Refrigerator: 15.6 cu. ft.

- 2 Humidity-Controlled Crispers
- 5 Tempered Glass Spill-Proof Shelves
 - 1 Slide-In
 - 1 Slide-Out
 - 1 Foldable Half
 - 2 Fixed
- 6 Door Bins
 - Right Door: 3 Door Bins
 - Left Door: 3 Regular Bins
- Metal Cooling
- High Efficiency LED Lighting

FlexZone™ Drawer: 3.8 cu. ft.

- EZ-Open Handle™
- 4 Temperature Zones with Smart Divider
 - Meat/Fish (29°F)
 - Cold Drinks (33°F)
 - Deli/Snacks (37°F)
 - Wine/Party Dishes (42°F)

Freezer: 8.3 cu. ft.

- EZ-Open Handle™
- Take Out Box
- 1 Drawer Divider
- High Efficiency LED Lighting

Warranty

One (1) Year Parts and Labor on Refrigerator

Five (5) Years Parts and Labor on Sealed Refrigeration System Only*

Ten (10) Years Parts and Five (5) Years

Labor on Digital Inverter Compressor

*Compressor, evaporator, condenser, drier and connecting tubing

Product Dimensions & Weight

Dimensions (WxHxD with hinges, handles and doors):

35 3/4" x 70" x 36 1/2"

Dimensions (WxHxD without hinges and door):

35 3/4" x 68 7/8" x 29 1/2"

Dimensions (WxHxD with hinge and door, no handle):

35 3/4" x 70" x 34"

Weight: 346 lbs

Shipping Dimensions & Weight (WxHxD)

Dimensions: 38 1/4" x 75 3/4" x 36 1/4"

Weight: 368 lbs

Color	Model #	UPC Code
Fingerprint Resistant Stainless Steel	RF28R7551SR	887276345321
Fingerprint Resistant Black Stainless Steel	RF28R7551SG	887276345314
Fingerprint Resistant Tuscan Stainless Steel	RF28R7551DT	887276345307


DW80R9950

Samsung Linear Wash 39 dBA Dishwasher

SAMSUNG

BB2-87L
OCT 16 2019

Installation Specifications

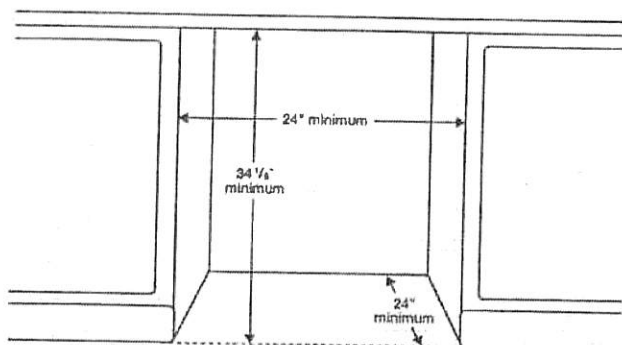

Features

- 7 Wash Cycles: Auto, Normal, Heavy, Delicate, Express 60, Rinse Only, Self Clean
- 8 Options: Half-Load Wash (Lower Rack), Zone Booster™ (Left), Speed Booster, Hi-Temp Wash, Sanitize (Anti-bacterial – NSF), Delay Start, Control Lock, Smart Control (Wi-Fi App)
- AutoRelease™ Door
- Hidden Heat Element
- Stainless Steel Interior Tub

Convenience

- Control Lock
- Digital Water Leakage Sensor
- Flexible Third Rack
- One-Touch Adjustable Racking System
- Silverware Basket
- Upper Rack: Foldable Cup Shelves, 2 Adjustable Tines
- Lower Rack: Fold-Down Tines

Warranty

One (1) Year All Parts and Labor
Five (5) Year Limited on Printed Circuit Board and Interior Nylon Racks

Product Dimensions & Weight (WxHxD)

Dimensions (height is adjustable):
23 7/8" x 33 7/8" – 35" x 25"

Weight: 95 lbs


Shipping Dimensions & Weight (WxHxD)

Dimensions:
26" x 34 3/4" x 29 1/4"


Weight: 101 lbs

Dimensions

Side View

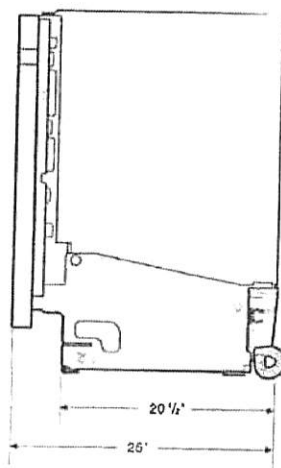

Rear View

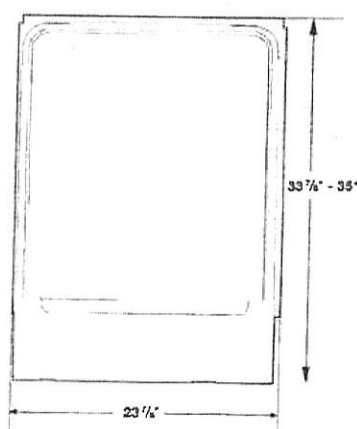


NX58H9500WS

5.8 cu. ft. Slide-in Gas Range

INSTALLING YOUR RANGE



30" minimum clearance between the top of the cooking surface and the bottom of an unprotected wood or metal cabinet; or 24" minimum when the bottom of the wood or metal cabinet is protected by not less than 1/4" flame retardant millboard covered with not less than no.28 MSG sheet steel, 0.015" stainless steel, 0.024" aluminum or 0.020" copper.

18" minimum between the countertop and the adjacent cabinet bottom.

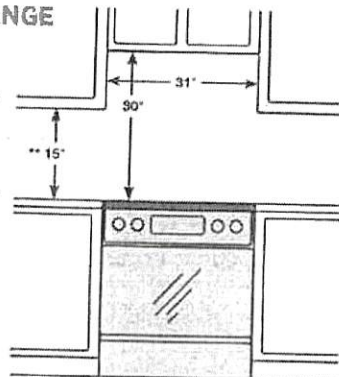


IMPORTANT: To eliminate the risk of burns or fire caused by reaching over heated surface units, cabinet storage space located above the surface units should be avoided. If cabinet storage is to be provided, the risk can be reduced by installing a range hood that projects horizontally a minimum of 5" beyond the bottom of the cabinets.

Dimensions

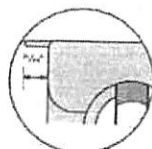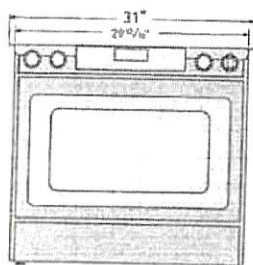

Glass cooktop overlaps and fits on top of your kitchen countertop to give a built-in look. Cut out space for the range is 29 1/2".

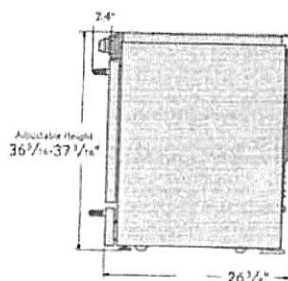

Total Power (BTU)

57,000 BTU

Power Source

120 V/60 Hz

Black Enamel 5 Burner Cooktop

• Right Front: 18000 BTU - Dual

• Left Front: 15000 BTU

• Right Rear: 5000 BTU

• Left Rear: 9500 BTU

• Center Rear: 9500 BTU - Oval

Oven

• Bake: 150°F - 550°F

• Convection Bake: 150°F - 550°F

• Bake Burner: 18000 BTU

• Broil Burner: 16000 BTU

• Variable Broil: Low/Hi (375°F - 480°F)

• Convection Roast: 150°F - 550°F

• Sabbath Mode

Warming Drawer

• Capacity: 0.7 cu. ft.

• Heating Performance: 600 W

• Temperature Settings: 3 Level

Warranty

One (1) Year All Parts and Labor

Five (5) Years Gas Cooktop

Product Dimensions & Weight (WxHxD)

Actual Oven Dimensions:

25" x 21 1/4" x 19"

Outside Dimensions:

29 1/2" x 36 1/2" - 37 1/2" (Adjustable) x 26 1/4"

Weight: 202 lbs.

Shipping Dimensions & Weight (WxHxD)

Dimensions:

33 1/2" x 41 3/4" x 30 5/16"

Weight: 225 lbs.

Color

Model #

UPC Code

Stainless Steel

NX58H9500WS

887276032047

Black Stainless Steel

NX58K9500WG

887276142890

SAMSUNG

Actual color may vary. Design specifications and color availability are subject to change without notice. Non-metric weights and measurements are approximate.

©2016 Samsung Electronics America, Inc. 85 Challenger Road, Ridgefield Park, NJ 07660. Toll: 800-SAMSUNG. samsung.com. Samsung is a registered trademark of Samsung Electronics Co., Ltd.

RF28R7551SR

SAMSUNG

28 cu. ft. 4-Door French Door Refrigerator with 21.5" Connected Touchscreen Family Hub™


RF28R7551SR
OCT 16 2019

Installation Specifications


1. Measure the height, width and depth of the opening, making sure to include baseboards, molding tile, countertop overhang, etc. Check to be sure there is enough room to open the door (consider walls, islands or other obstacles when measuring).
2. Refer to illustration below to determine dimensions.
3. Allow 2.5" of clearance on hinge side of refrigerator when installing next to a wall where handle may make contact.
4. Allow 1" minimum clearance at rear for proper air circulation and water/electrical connections. Allow a 3/8" minimum clearance at sides and top for ease of installation.
5. Ensure each door and entryway in the home is wide enough for the refrigerator to be moved through easily.

For optimal usage and to be able to open refrigerator doors completely, do not install next to a wall.

Please note: The following dimension and cutout information is for planning purposes only. For complete installation details, consult manual packed with product, or download manual online at samsung.com.

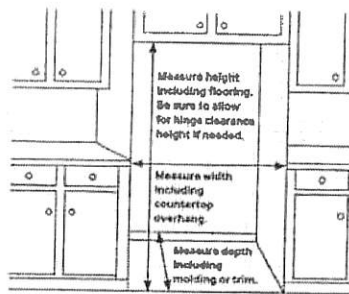

Dimensions

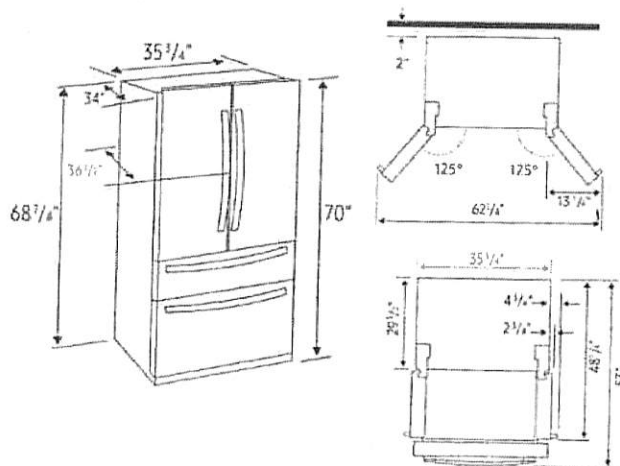

Total Capacity: 27.7 cu. ft.

Refrigerator: 15.6 cu. ft.

- 2 Humidity-Controlled Crispers
- 5 Tempered Glass Spill-Proof Shelves
 - 1 Slide-In
 - 1 Slide-Out
 - 1 Foldable Half
 - 2 Fixed
- 6 Door Bins
 - Right Door: 3 Door Bins
 - Left Door: 3 Regular Bins
- Metal Cooling
- High Efficiency LED Lighting

FlexZone™ Drawer: 3.8 cu. ft.

- EZ-Open Handle™
- 4 Temperature Zones with Smart Divider
 - Meat/Fish (29°F)
 - Cold Drinks (33°F)
 - Deli/Snacks (37°F)
 - Wine/Party Dishes (42°F)

Freezer: 8.3 cu. ft.

- EZ-Open Handle™
- Take Out Box
- 1 Drawer Divider
- High Efficiency LED Lighting

Warranty

One (1) Year Parts and Labor on Refrigerator

Five (5) Years Parts and Labor on Sealed Refrigeration System Only*

Ten (10) Years Parts and Five (5) Years

Labor on Digital Inverter Compressor

*Compressor, evaporator, condenser, drier and connecting tubing

Product Dimensions & Weight

Dimensions (WxHxD with hinges, handles and doors):

35 1/4" x 70" x 36 1/4"

Dimensions (WxHxD without hinges and door):

35 1/4" x 68 1/8" x 29 1/2"

Dimensions (WxHxD with hinge and door, no handle):

35 1/4" x 70" x 34"

Weight: 346 lbs

Shipping Dimensions & Weight (WxHxD)

Dimensions: 38 1/4" x 75 3/4" x 36 1/4"

Weight: 368 lbs

Color	Model #	UPC Code
Fingerprint Resistant Stainless Steel	RF28R7551SR	887276345321
Fingerprint Resistant Black Stainless Steel	RF28R7551SG	887276345314
Fingerprint Resistant Tuscan Stainless Steel	RF28R7551DT	887276345307


DW80R9950

Samsung Linear Wash 39 dBA Dishwasher

SAMSUNG

BEZ-87L
OCT 16 2019

Installation Specifications

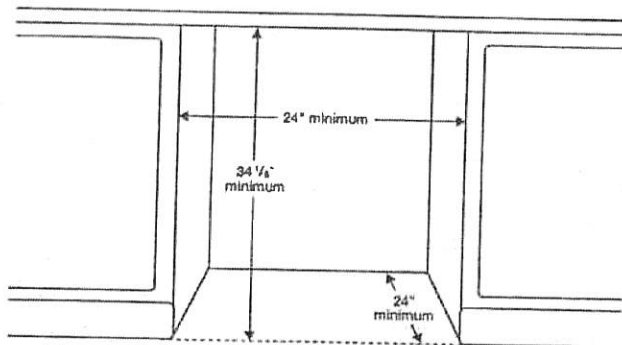

Features

- 7 Wash Cycles: Auto, Normal, Heavy, Delicate, Express 60, Rinse Only, Self Clean
- 8 Options: Half-Load Wash (Lower Rack), Zone Booster™ (Left), Speed Booster, Hi-Temp Wash, Sanitize (Anti-bacterial – NSF), Delay Start, Control Lock, Smart Control (Wi-Fi App)
- AutoRelease™ Door
- Hidden Heat Element
- Stainless Steel Interior Tub

Convenience

- Control Lock
- Digital Water Leakage Sensor
- Flexible Third Rack
- One-Touch Adjustable Racking System
- Silverware Basket
- Upper Rack: Foldable Cup Shelves, 2 Adjustable Tines
- Lower Rack: Fold-Down Tines

Warranty

One (1) Year All Parts and Labor
Five (5) Year Limited on Printed Circuit Board and Interior Nylon Racks

Product Dimensions & Weight (WxHxD)

Dimensions (height is adjustable):
23 7/8" x 33 7/8" – 35" x 25"

Weight: 95 lbs


Shipping Dimensions & Weight (WxHxD)

Dimensions:
26" x 34 3/4" x 29 1/4"


Weight: 101 lbs

Dimensions

Side View

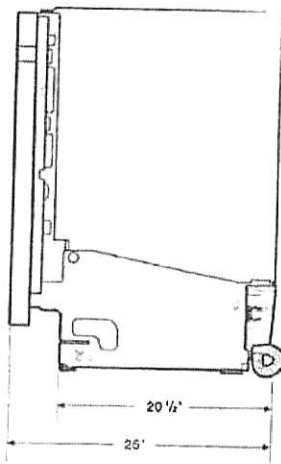

Rear View

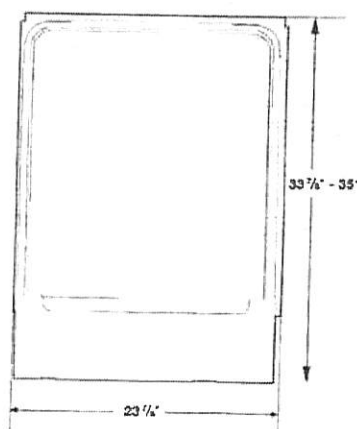

Color	Model #	UPC Code
Fingerprint Resistant Stainless Steel	DW80R9950US	887276296647
Fingerprint Resistant Black Stainless Steel	DW80R9950UG	887276296623
Fingerprint Resistant Tuscan Stainless Steel	DW80R9950UT	887276320137



BATHROOM ACCESSORIES

PROJECT: ENCORE 2

LOT: 87 L

INSTALL STANDARD BATHROOM ACCESSORIES
THRU OUT (TOWEL BAR, SOAP DISH, TISSUE
HOLDER) **location as per vendor's discretion

☐

DO *NOT* INSTALL STANDARD BATHROOM
ACCESSORIES THRU OUT (TOWEL BAR, SOAP
DISH, TISSUE HOLDER)

☒

SIGNATURE: _____

SIGNATURE:  

DATE: OCTOBER 9 2019