

Brampton Encore - 91R - 2 - 28-6 Elev.B Berlio OPT4

CONCRETE AND DRAIN

Inv.2,065	1 - 3 PC BASEMENT ROUGH-IN
Line29160	Note:
10Sep19 / 12Sep19	

Exterior Colours

Inv.2,066	1 - Exteriour Colour Package #8
Line29899	Note:
10Sep19 / 4Dec19	

FORMING

Inv.2,065	1 - SIDE DOOR- HOME TO EXTERIOR- AS PER PLAN AND GRADE PERMITTING
Line29143	Note:
10Sep19 / 12Sep19	

Inv.2,066	1 - Garage Mandoor
Line29901	Note:
10Sep19 / 4Dec19	

FRAMING

Inv.2,065	1 - MANDOOR - GARAGE TO HOUSE- AS PER PLAN AND GRADE PERMITING
Line29144	Note:
10Sep19 / 12Sep19	

Inv.2,066	1 - Side Door - As Per Plan and Grade Permitting
Line29900	Note:
10Sep19 / 4Dec19	

HVAC

Inv.2,066	1 - A/C UNIT - 2.0 TON
Line29147	Note:
10Sep19 / 4Dec19	

PLUMBING

Inv.2,065	1 - ROUGH-IN - 3PC BASEMENT ROUGH-IN
Line29152	Note:
10Sep19 / 12Sep19	

WINDOWS - BASEMENT

Inv.2,065	4 - BASEMENT WINDOWS - UPGRADE EXISTING BASEMENT WINDOW TO 30 INCH X 24 INCH - MAY REQUIRE INSTALLATION OF WINDOW WELL
Line29145	Note:
10Sep19 / 12Sep19	


WINDOWS AND DOORS

Inv.2,066	1 - Side Door & Garage Mandoor
Line29902	Note:
10Sep19 / 4Dec19	

The
Berlio
SEMI SERIES

Elevation A • 2,047 sq.ft.
Elevation B • 2,037 sq.ft.
Elevation C • 2,037 sq.ft.
Elevation D • 2,047 sq.ft.

BEZ-91R
SEPT 10 2019
REVISION DEC. 4 2019

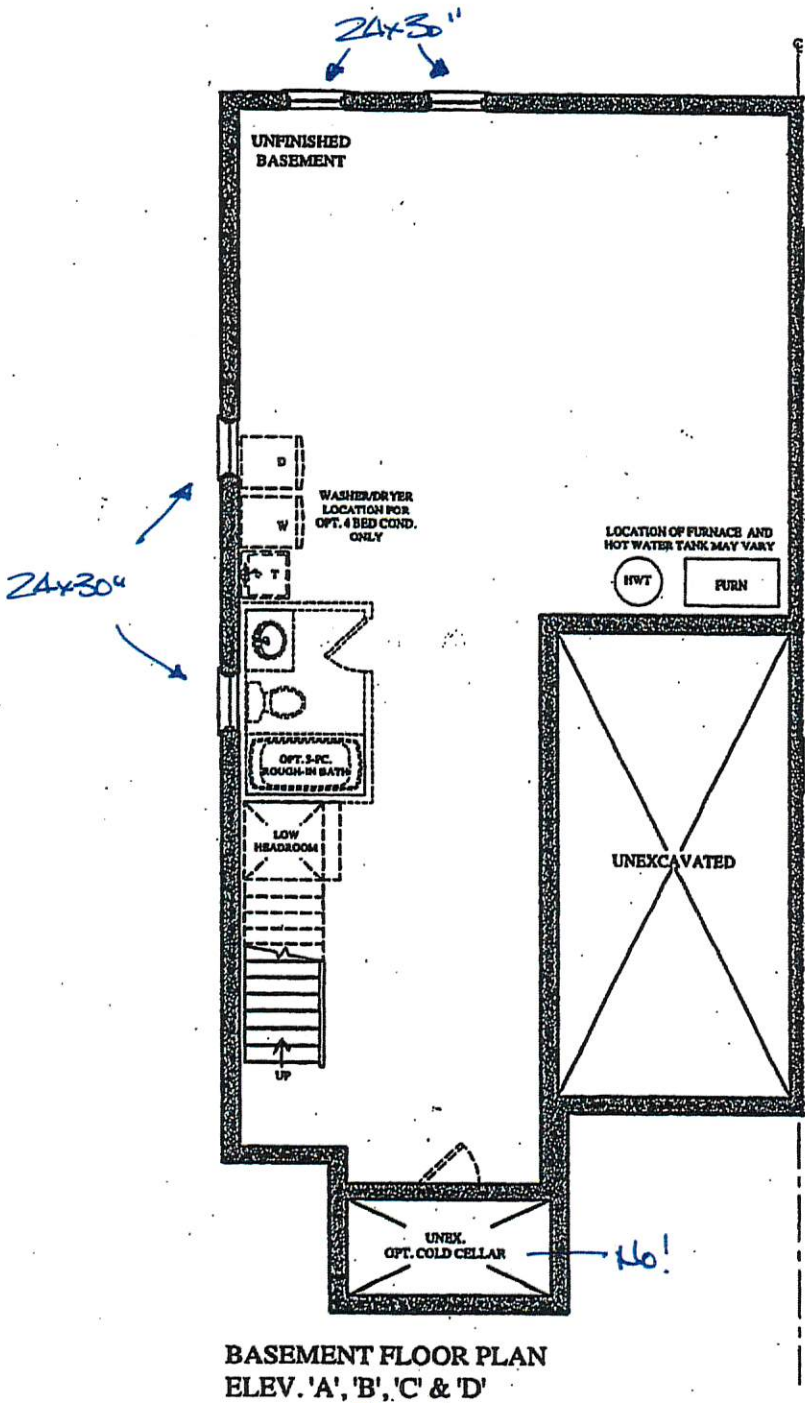


Prices, figures, illustrations, sizes, features and finishes are subject to change without notice. Areas and dimensions are approximate and actual usable floor space may vary from the stated area. Layout may be reverse of the unit purchased. E. & O.E.

BE2-91R
SEPT 10 2019


REVISED DEC 4 2019

The Berlio SEMI SERIES

Elevation A • 2,047 sq.ft.
Elevation B • 2,037 sq.ft.
Elevation C • 2,037 sq.ft.
Elevation D • 2,047 sq.ft.

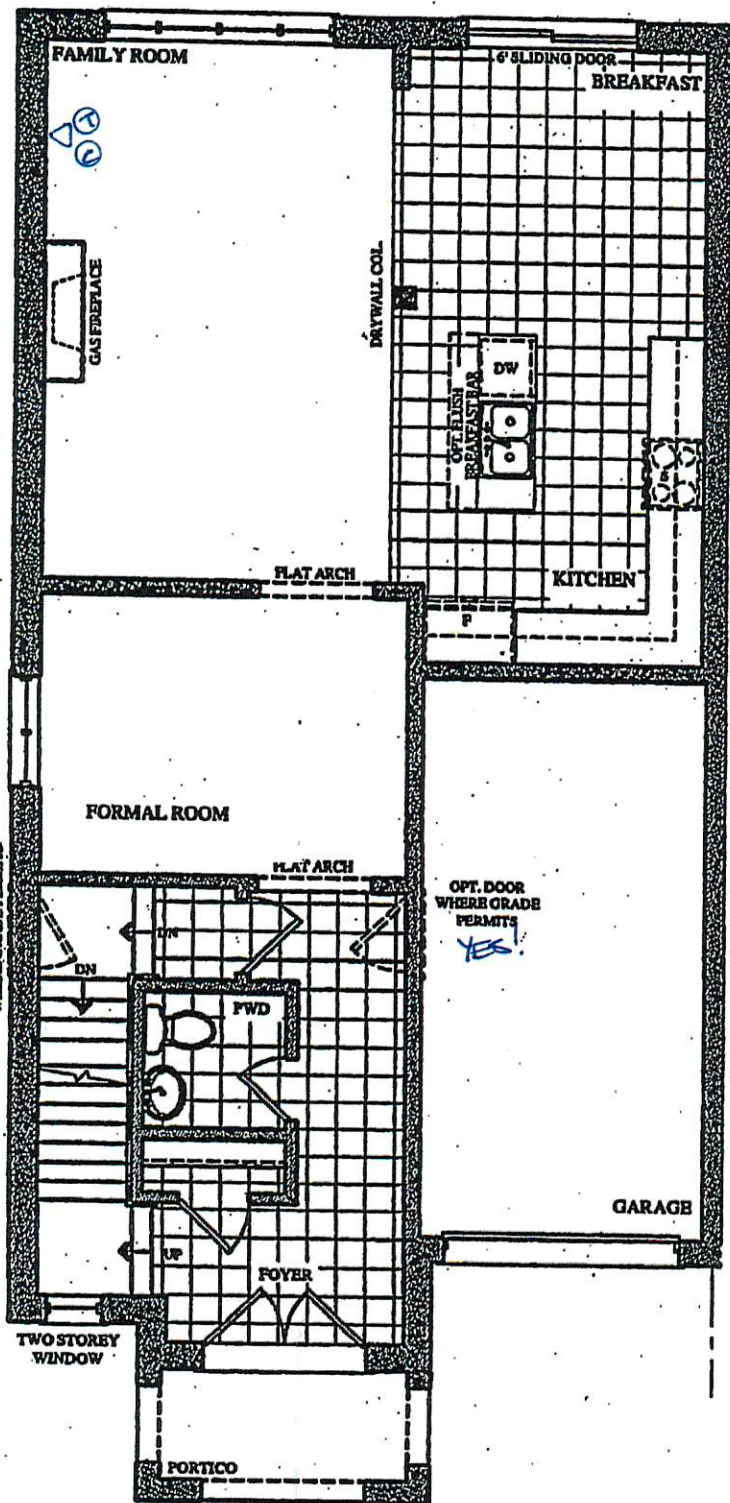

GROUND FLOOR PLAN
ELEV. 'A' & 'B'

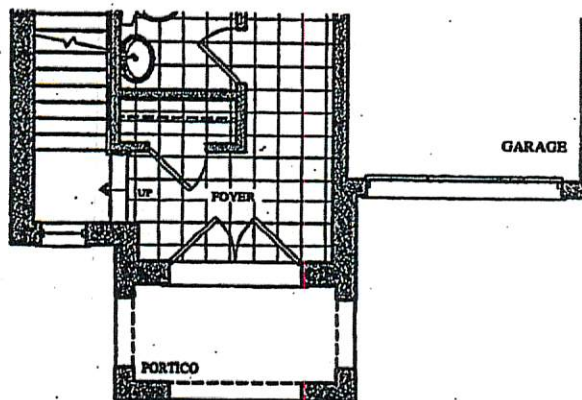


PART. GROUND FLOOR PLAN
ELEV. 'C' & 'D'

BEZ-91R
SEPT 10 2019


*REVISION DEC 4 2019 - 4 BEDRM

The
Berlio
SEMI SERIES


Elevation A • 2,047 sq.ft.
Elevation B • 2,037 sq.ft.
Elevation C • 2,037 sq.ft.
Elevation D • 2,047 sq.ft.

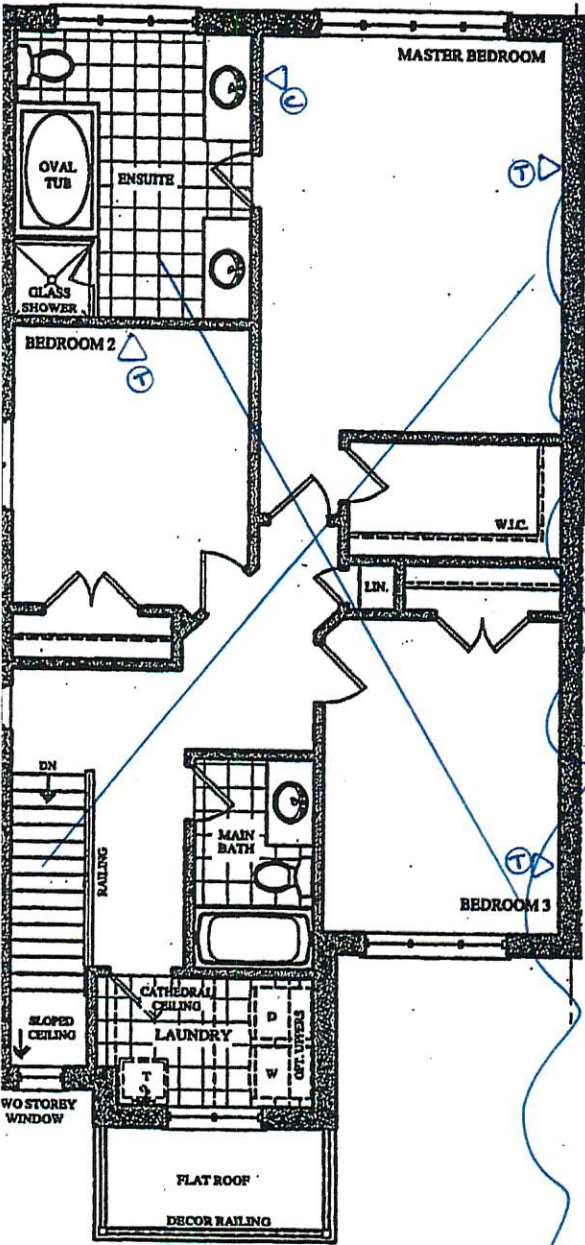


SECOND FLOOR PLAN
LEV. 'A'

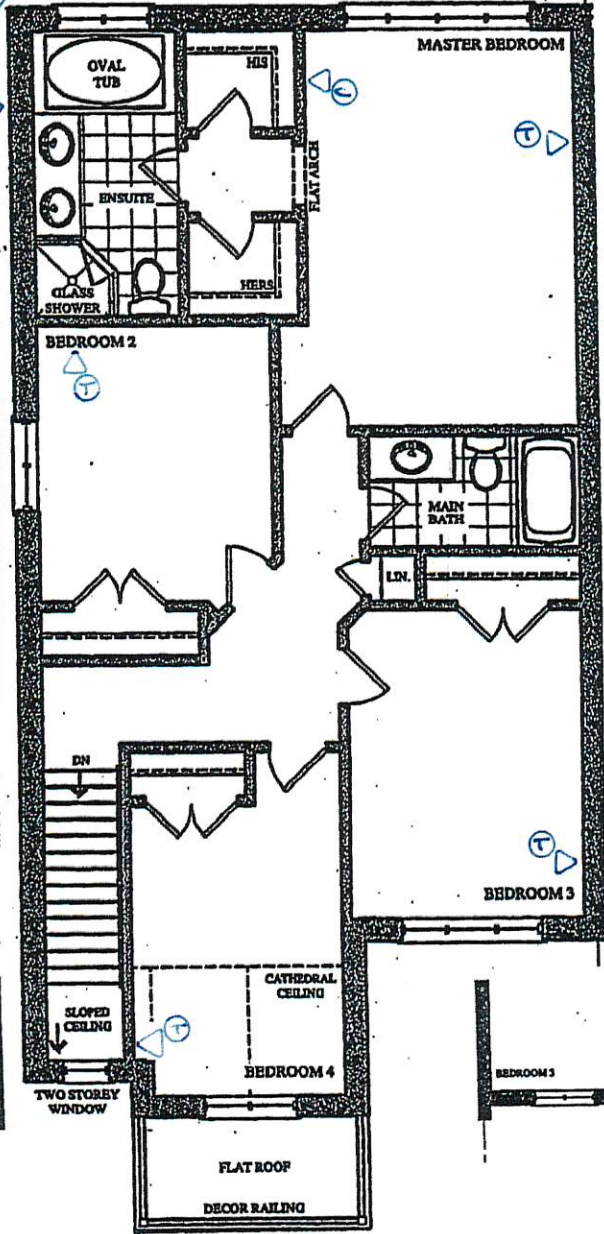


OPT. 4 BED SECOND FLOOR PLAN
ELEV. 'A'

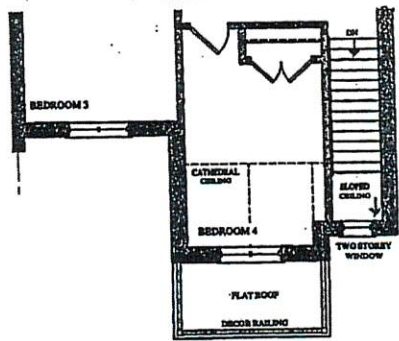


PART. OPT. 4 BED SECOND FLOOR PLAN
ELEV. 'B'

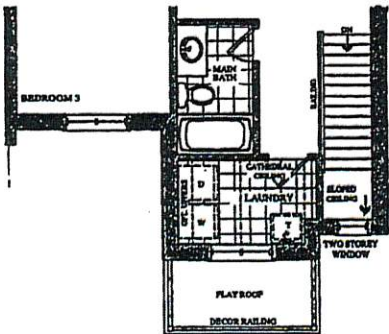


PART. SECOND FLOOR PLAN
ELEV. 'B'

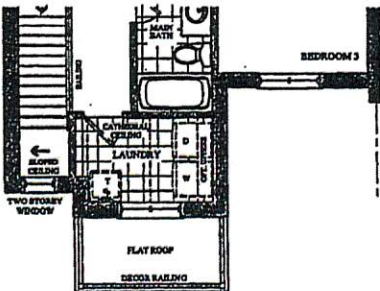


PART. SECOND FLOOR PLAN
ELEV. 'C'

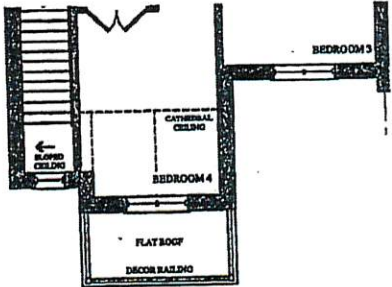

PART. OPT. 4 BED SECOND FLOOR PLAN
ELEV. 'C'

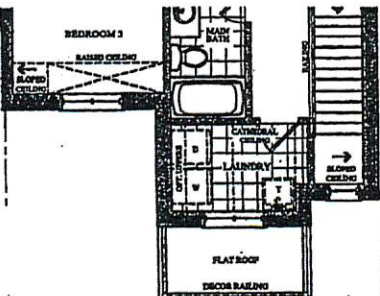

PART. SECOND FLOOR PLAN
ELEV. 'D'

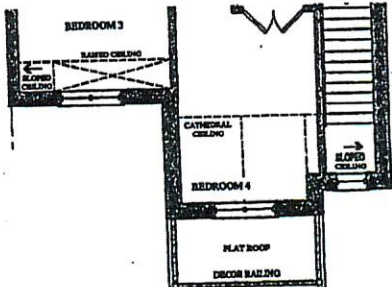

PART. OPT. 4 BED SECOND FLOOR PLAN
ELEV. 'D'