

Brampton Encore - 85R - 2 - 28-09 Elev B Gershwin

CENTRAL VAC AND WIRING

Inv.2,148	1 - GREAT ROOM: CAT 6 WIRING - ADD CAT 6- SEE PLAN FOR LOCATION
Line30184	Note:
20Dec19 / 8Jan20	
Inv.2,148	1 - BEDROOM 3: CAT 6 WIRING - ADD AT 6- SEE PLAN FOR LOCATION
Line30185	Note:
20Dec19 / 8Jan20	
Inv.2,148	1 - GREAT ROOM: CONDUIT PIPE- FOR TELEVISION- LOCATE APRPOX. 66" A.F.F. ABOVE FIREPLACE, TERMINATING AT CABLE. SEE PLAN
Line30188	Note:
20Dec19 / 8Jan20	

CONCRETE AND DRAIN

Inv.2,148	1 - 3PC Basement Rough-In
Line30312	Note:
20Dec19 / 8Jan20	

DRYWALL

Inv.2,148	1 - SMOOTH CEILINGS - (2-Story Design) 2ND FLOOR
Line30196	Note:
20Dec19 / 8Jan20	

ELECTRICAL

Inv.2,148	1 - GREAT ROOM: 110V WALL RECEPTACLE ON DEDICATED CIRCUIT- LOCATE APPROX. 66" A.F.F. ABOVE FIREPLACE
Line30186	Note:
20Dec19 / 8Jan20	
Inv.2,148	1 - KITCHEN: ADD CAPPED CEILING ROUGH IN ABOVE ISLAND, SAME SWITCH AS STANDARD LIGHT
Line30190	Note:
20Dec19 / 8Jan20	
Inv.2,148	1 - KITCHEN: RELOCATE STANDARD FIXTURE - SEE PLAN FOR LOCATION - ABOVE ISLAND
Line30189	Note:
20Dec19 / 8Jan20	
Inv.2,148	5 - KITCHEN: LED POT LIGHT (PRICE 10+)
Line30191	Note:
20Dec19 / 8Jan20	
Inv.2,148	1 - KITCHEN: SINGLE POLE SWITCH FOR POTLIGHTS
Line30192	Note:
20Dec19 / 8Jan20	
Inv.2,148	6 - GREAT ROOM: LED POTLIGHT (PRICE 10+)
Line30193	Note:
20Dec19 / 8Jan20	
Inv.2,148	1 - GREAT ROOM: SINGLE POLE SWITCH FOR POTLIGHTS
Line30194	Note:
20Dec19 / 8Jan20	

Brampton Encore - 85R - 2 - 28-09 Elev B Gershwin

Inv.2,148	1 - KITCHEN: 110V WALL RECEPTACLE ON DEDICATED CIRCUIT - GAS FIRED APPLIANCE - FOR AUX. EQUIPMENT - NOT A STOVE PLUG
Line30199	Note:
20Dec19 / 8Jan20	

Exterior Colours

Inv.2,148	1 - Exterior Color Package #6
Line30317	Note:
20Dec19 / 8Jan20	

FORMING

Inv.2,148	1 - SIDE DOOR- HOME TO EXTERIOR- AS PER PLAN AND GRADE PERMITTING
Line30181	Note:
20Dec19 / 8Jan20	
Inv.2,148	1 - Garage Mandoor - Garage To House - As Per Plan And Grade Permitting
Line30313	Note:
20Dec19 / 8Jan20	

FRAMING

Inv.2,148	1 - MANDOOR - GARAGE TO HOUSE- AS PER PLAN AND GRADE PERMITING
Line30183	Note:
20Dec19 / 8Jan20	
Inv.2,148	1 - Extended Archway on Main Floor 2 Storey Model
Line30315	Note:
20Dec19 / 8Jan20	
Inv.2,148	1 - Side Door - Home To Exterior - As Per Plan And Grade Permitting
Line30314	Note:
20Dec19 / 8Jan20	

HVAC

Inv.2,148	1 - KITCHEN: GAS LINE ROUGH - GROUND FLOOR FLOOR- (2-STOREY MODELS)
Line30197	Note:
20Dec19 / 8Jan20	

INTERIOR TRIM AND DOORS

Inv.2,148	1 - MAIN FLOOR: EXTENDED HEIGHT ARCHWAY (PRICE PER DOORWAY) -96"
Line30200	Note:
20Dec19 / 8Jan20	
Inv.2,148	1 - Side Door and Mandoor
Line30311	Note:
20Dec19 / 8Jan20	

MISC.

Inv.2,148	1 - Purchaser has attended an appointment at the Decor Centre & has DECLINED any additional upgrades and accepts and acknowledges that there will be no further changes/additions/deletions to be made upon signing on December 20, 2019.
Line30201	Note:
20Dec19 / 8Jan20	

Brampton Encore - 85R - 2 - 28-09 Elev B Gershwin

Inv.2,148	1 - BONUS PACKAGE: \$5,000.00 (INCLUDING TAXES) WORTH OF UPGRADES FROM GOLD PARK HOMES DÉCOR CENTRE IS BEING APPLIED TOWARD THIS ORDER. PURCHASER HAS A REMAINING AMOUNT OF \$00 (INCLUDING TAXES).
Line30202	Note:
20Dec19 / 8Jan20	

PLUMBING

Inv.2,148	1 - ROUGH-IN - 3PC BASEMENT ROUGH-IN
Line30195	Note:
20Dec19 / 8Jan20	

WINDOWS AND DOORS

Inv.2,148	1 - Side Door & Garage Mandoor
Line30316	Note:
20Dec19 / 8Jan20	



The Gershwin SEMI SERIES

Elevation A • 1,920 sq.ft.
Elevation B • 1,920 sq.ft.
Elevation C • 1,920 sq.ft.
Elevation D • 1,920 sq.ft.

BE2-88R
DEC 20 2019

MBD

KMD

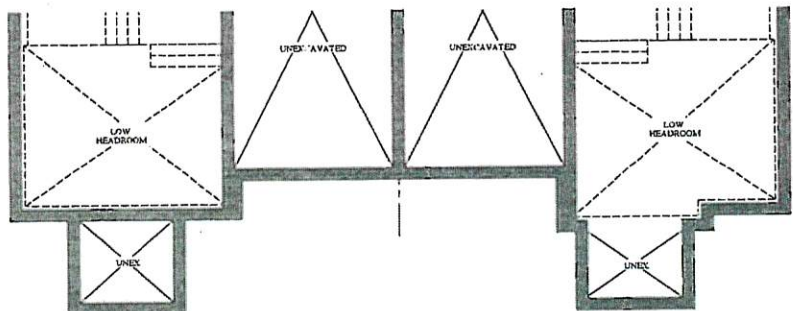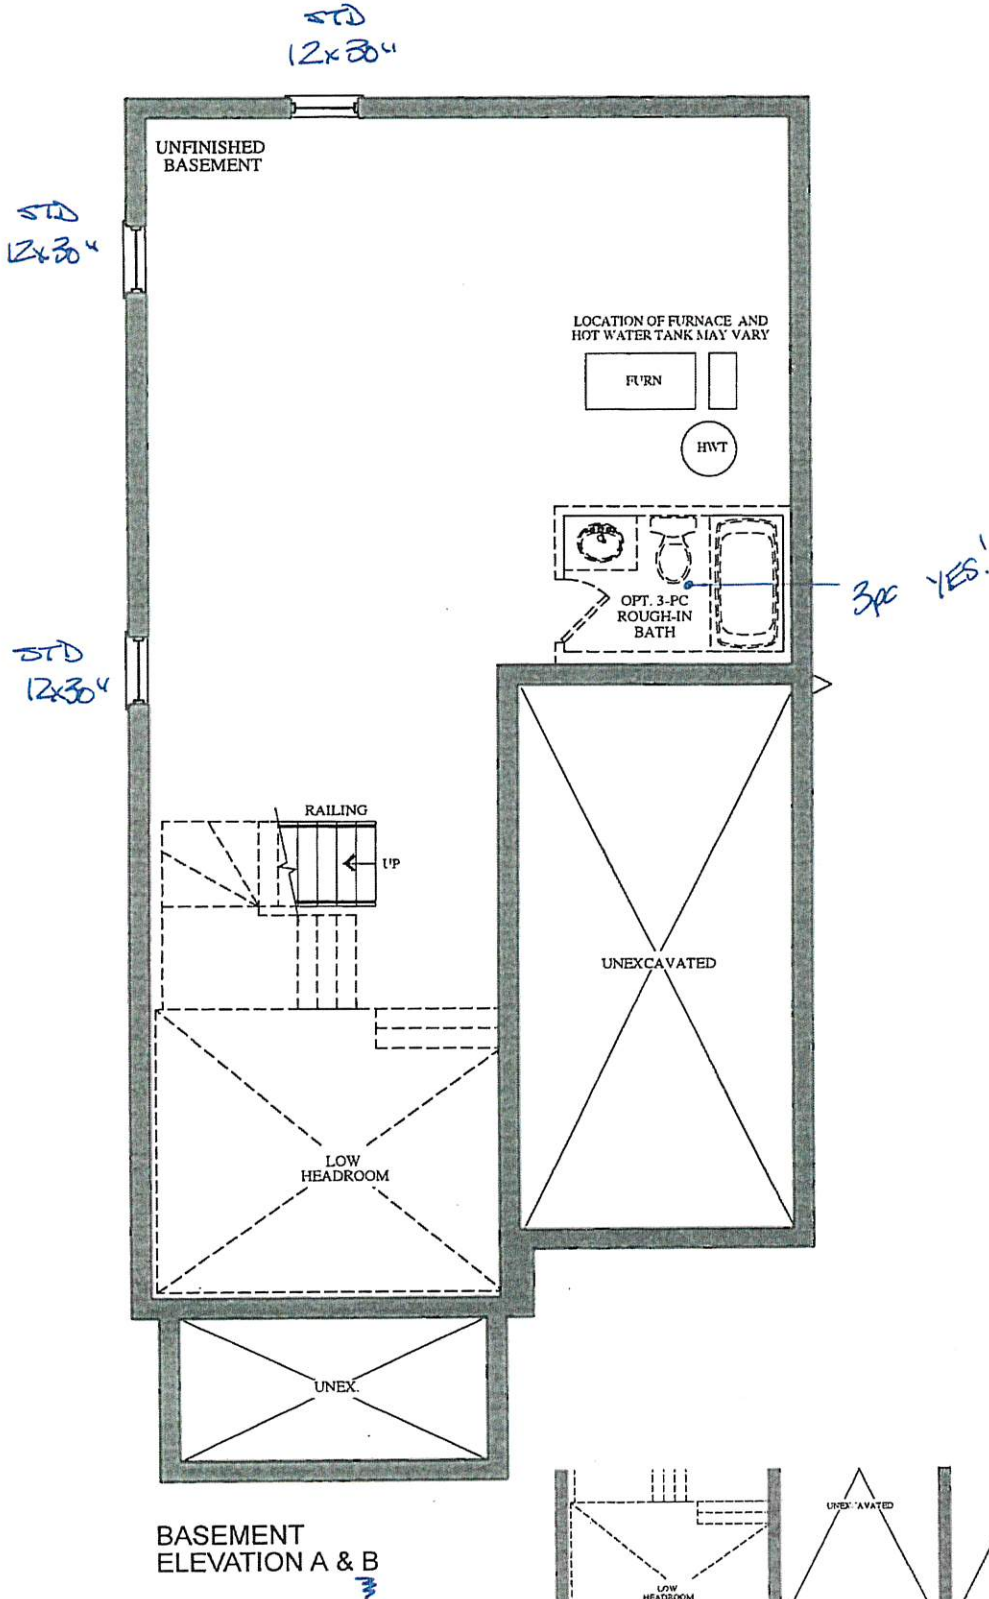

PART. BASEMENT FLOOR
ELEVATION C

PART. BASEMENT FLOOR
ELEVATION D

VENDOR
PURCHASER
PURCHASER

GOLDPARK
WORTH MORE™


Prices, figures, illustrations, sizes, features and finishes are subject to change without notice. Areas and dimensions are approximate and actual usable floor space may vary from the stated area. Layout may be reverse of the unit purchased. E. & O.E.

The Gershwin SEMI SERIES

Elevation A • 1,920 sq.ft.
Elevation B • 1,920 sq.ft.
Elevation C • 1,920 sq.ft.

BE2-85R
DEC 20 2019

MB
KMD

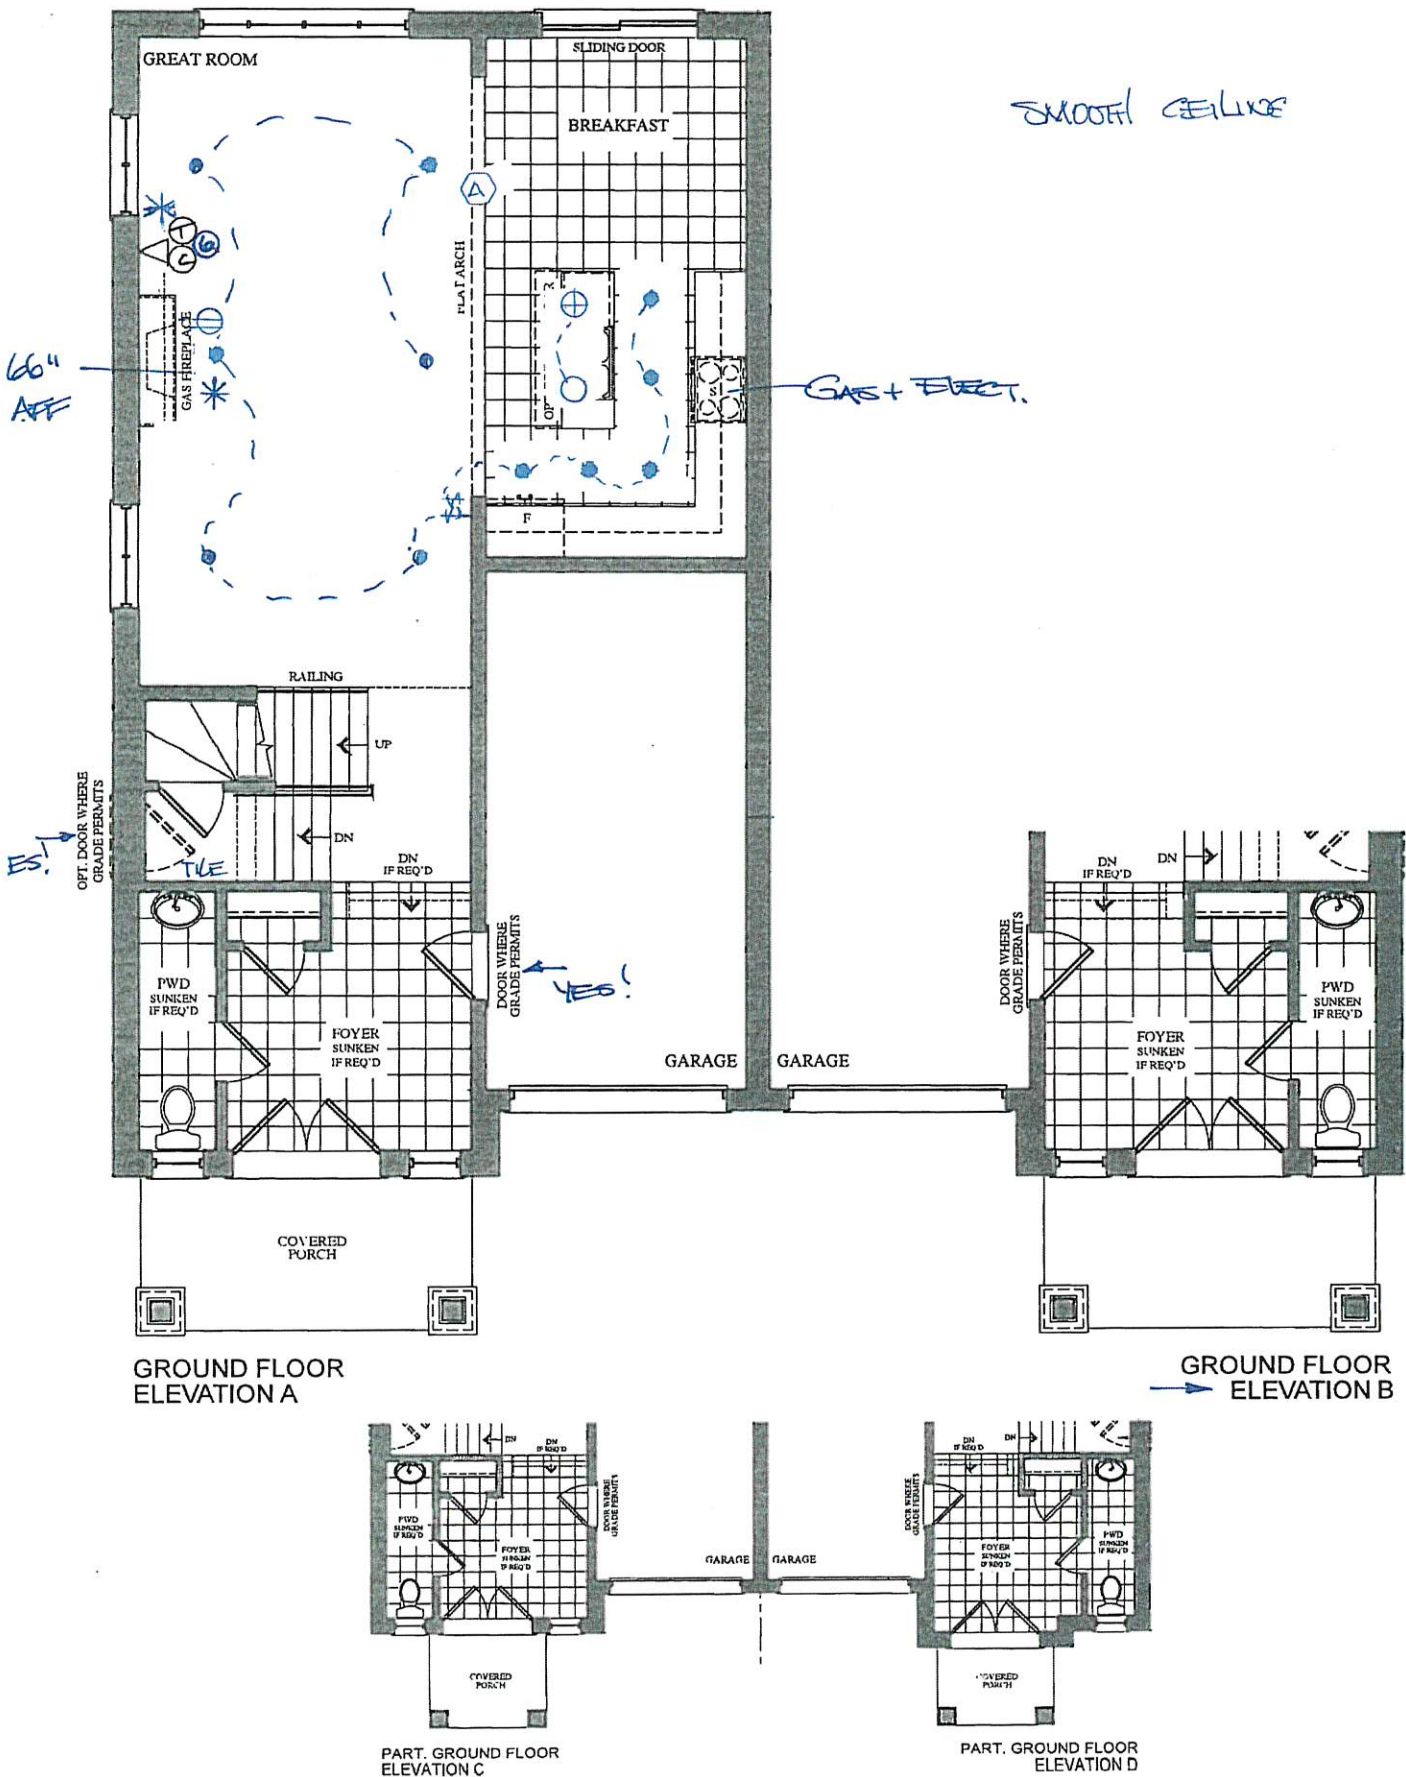

VENDOR	
PURCHASER	
PURCHASER	


GOLDPARK
WORTH MORE™

Prices, figures, illustrations, sizes, features and finishes are subject to change without notice. Areas and dimensions are approximate and actual usable floor space may vary from the stated area. Layout may be reverse of the unit purchased. E. & O.E.

The Gershwin SEMI SERIES

Elevation A • 1,920 sq.ft.
→ Elevation B • 1,920 sq.ft.
Elevation C • 1,920 sq.ft.
Elevation D • 1,920 sq.ft.

BE2-85R MB
DEC 20 2019 (KM)

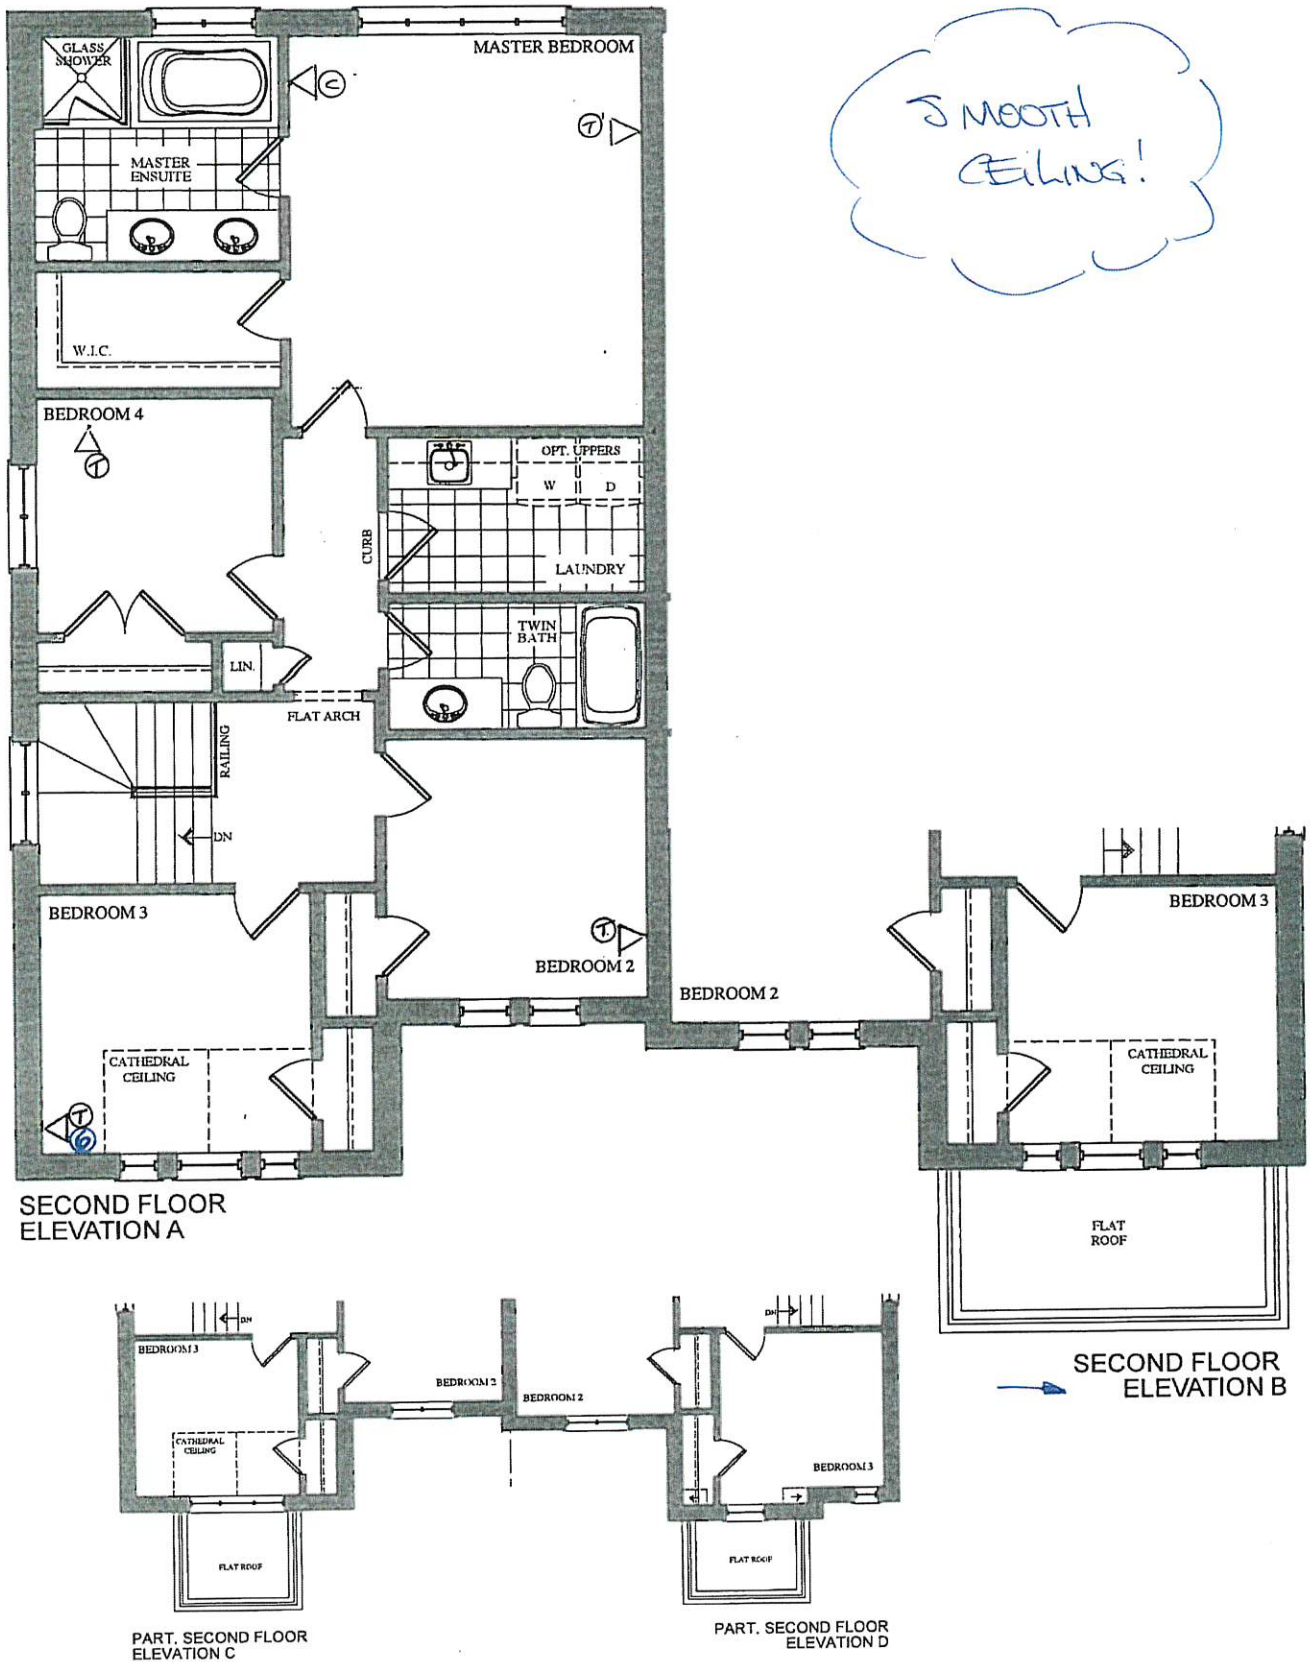

VENDOR
PURCHASER
PURCHASER

GOLDPARK
WORTH MORE™

Prices, figures, illustrations, sizes, features and finishes are subject to change without notice. Areas and dimensions are approximate and actual usable floor space may vary from the stated area. Layout may be reverse of the unit purchased. E. & O.E.