

Brampton Encore - 83R - 2 - 28-2 Elev.B Siren

CENTRAL VAC AND WIRING

Inv.2,134	1 - FAMILY ROOM: CONDUIT PIPE- FOR TELEVISION- LOCATE APPROX. 66" A.F.F. ABOVE FIREPLACE, TERMINATING AT CABLE. SEE PLAN FOR LOCATION
Line29959	Note:
12Dec19 / 9Jan20	

CONCRETE AND DRAIN

Inv.2,134	1 - 3PC Basement Rough-In
Line30334	Note:
12Dec19 / 9Jan20	

ELECTRICAL

Inv.2,134	1 - POWDER ROOM: ROUGH - IN CEILING OUTLET ON SAME SWITCH - DOES NOT INCLUDE FIXTURE - SEE PLAN FOR LOCATION.USE SAME SWITCH AS VANITY LIGHT
Line29939	Note:
12Dec19 / 9Jan20	

Inv.2,134	2 - KITCHEN: ROUGH - IN CEILING OUTLET - DOES NOT INCLUDE FIXTURE. LOCATE CENTERED ABOVE ISLAND, SEE PLAN FOR LOCATION
Line29940	Note: IN ADDITION TO STANDARD CEILING LIGHT
12Dec19 / 9Jan20	

Inv.2,134	1 - KITCHEN: SINGLE POLE SWITCH FOR ROUGH-IN LIGHTS ABOVE ISLAND
Line29941	Note:
12Dec19 / 9Jan20	

Inv.2,134	1 - 200 AMP ELECTRICAL SERVICE
Line29942	Note:
12Dec19 / 9Jan20	

Inv.2,134	1 - MASTER ENSUITE: ROUGH - IN CEILING OUTLET ON SAME SWITCH - DOES NOT INCLUDE FIXTURE - SEE PLAN FOR LOCATION.USE SAME SWITCH AS VANITY LIGHT
Line29955	Note:
12Dec19 / 9Jan20	

Inv.2,134	1 - TWIN BATHROOM: ROUGH - IN CEILING OUTLET ON SAME SWITCH - DOES NOT INCLUDE FIXTURE - SEE PLAN FOR LOCATION.USE SAME SWITCH AS VANITY LIGHT
Line29956	Note:
12Dec19 / 9Jan20	

Inv.2,134	1 - FAMILY ROOM: 110V WALL RECEPTACLE ON DEDICATED CIRCUIT- LOCATE APPROX. 66" A.F.F. ABOVE FIREPLACE
Line29958	Note:
12Dec19 / 9Jan20	

Exterior Colours

Inv.2,134	1 - Exterior Colour Package #7
Line30336	Note:
12Dec19 / 9Jan20	

FORMING

Inv.2,134	1 - SIDE DOOR- HOME TO EXTERIOR- AS PER PLAN AND GRADE PERMITTING
Line29934	Note: Included in aps
12Dec19 / 9Jan20	

Brampton Encore - 83R - 2 - 28-2 Elev.B Siren

Inv.2,134	1 - Garage Mandoor - Garage To House - As Per Plan And Grade Permitting
Line30330	Note:
12Dec19 / 9Jan20	

FRAMING

Inv.2,134	1 - MANDOOR - GARAGE TO HOUSE- AS PER PLAN AND GRADE PERMITTING
Line29935	Note: Included in aps
12Dec19 / 9Jan20	
Inv.2,134	1 - Side Door - Home To Exterior - As Per Plan And Grade Permitting
Line30331	Note:
12Dec19 / 9Jan20	
Inv.2,134	1 - Extended Height Door and Arches on Main floor (2 Storey Model)
Line30332	Note:
12Dec19 / 9Jan20	

INTERIOR TRIM AND DOORS

Inv.2,134	1 - MAIN FLOOR: EXTENDED HEIGHT ARCHWAY (PRICE PER DOORWAY) - 96"
Line29944	Note:
12Dec19 / 9Jan20	
Inv.2,134	3 - MAIN FLOOR: STANDARD DOOR EXTENDED HEIGHT 96" (PRICE PER DOOR)- GROUND FLOOR 2 STOREY MODELS
Line29957	Note:
12Dec19 / 9Jan20	
Inv.2,134	1 - Side Door & Mandoor
Line30333	Note:
12Dec19 / 9Jan20	

MISC.

Inv.2,134	1 - Purchaser has attended a phone appointment & has DECLINED any additional upgrades and accepts and acknowledges that they have checked the order and accepts the attached selections as noted.
Line29945	Note:
12Dec19 / 9Jan20	
Inv.2,134	1 - BONUS PACKAGE: \$5,000.00 (INCLUDING TAXES) WORTH OF UPGRADES FROM GOLD PARK HOMES DÉCOR CENTRE IS BEING APPLIED TOWARD THIS ORDER. PURCHASER HAS A REMAINING AMOUNT OF \$0.00.
Line29946	Note:
12Dec19 / 9Jan20	
Inv.2,134	1 - Purchaser acknowledges that there will be no further changes/additions/deletions to be made upon signing on December 13, 2019.
Line29947	Note:
12Dec19 / 9Jan20	

PLUMBING

Inv.2,134	1 - ROUGH-IN - 3PC BASEMENT ROUGH-IN
Line29937	Note: Included in aps
12Dec19 / 9Jan20	
Inv.2,134	1 - KITCHEN: ROUGH-IN - WATERLINE FOR FRIDGE
Line29943	Note:
12Dec19 / 9Jan20	



CONSTRUCTION SUMMARY

Brampton Encore - 83R - 2 - 28-2 Elev.B Siren

WINDOWS - BASEMENT

Inv.2,134	3 - BASEMENT WINDOWS - UPGRADE EXISTING BASEMENT WINDOW TO 30 INCH X 24 INCH - MAY REQUIRE INSTALLATION OF WINDOW WELL
Line29938	Note: DIFFERENCE IN PRICE FROM 16X30" WHICH WERE INCLUDED IN APS
12Dec19 / 9Jan20	


WINDOWS AND DOORS

Inv.2,134	1 - Side Door & Mandoor
Line30335	Note:
12Dec19 / 9Jan20	

BEZ-83R
DEC 13 2009 JB D

The Siren SEMI SERIES

Elevation A • 1,688 sq.ft.
→ Elevation B • 1,677 sq.ft.
Elevation C • 1,687 sq.ft.

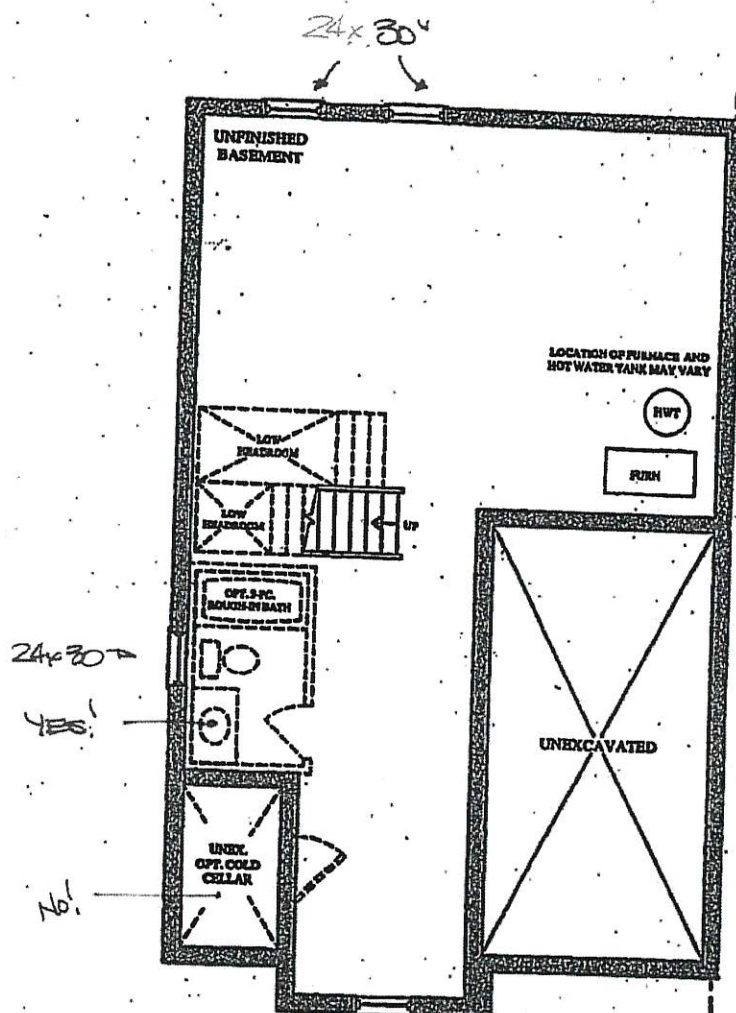

BASEMENT FLOOR PLAN
ELEV. 'A', 'B' & 'C'


BEZ-8SR
Dec 13 2019

19 D


The Siren

SEMI SERIES

Elevation A • 1,688 sq.ft.
Elevation B • 1,677 sq.ft.
Elevation C • 1,687 sq.ft.

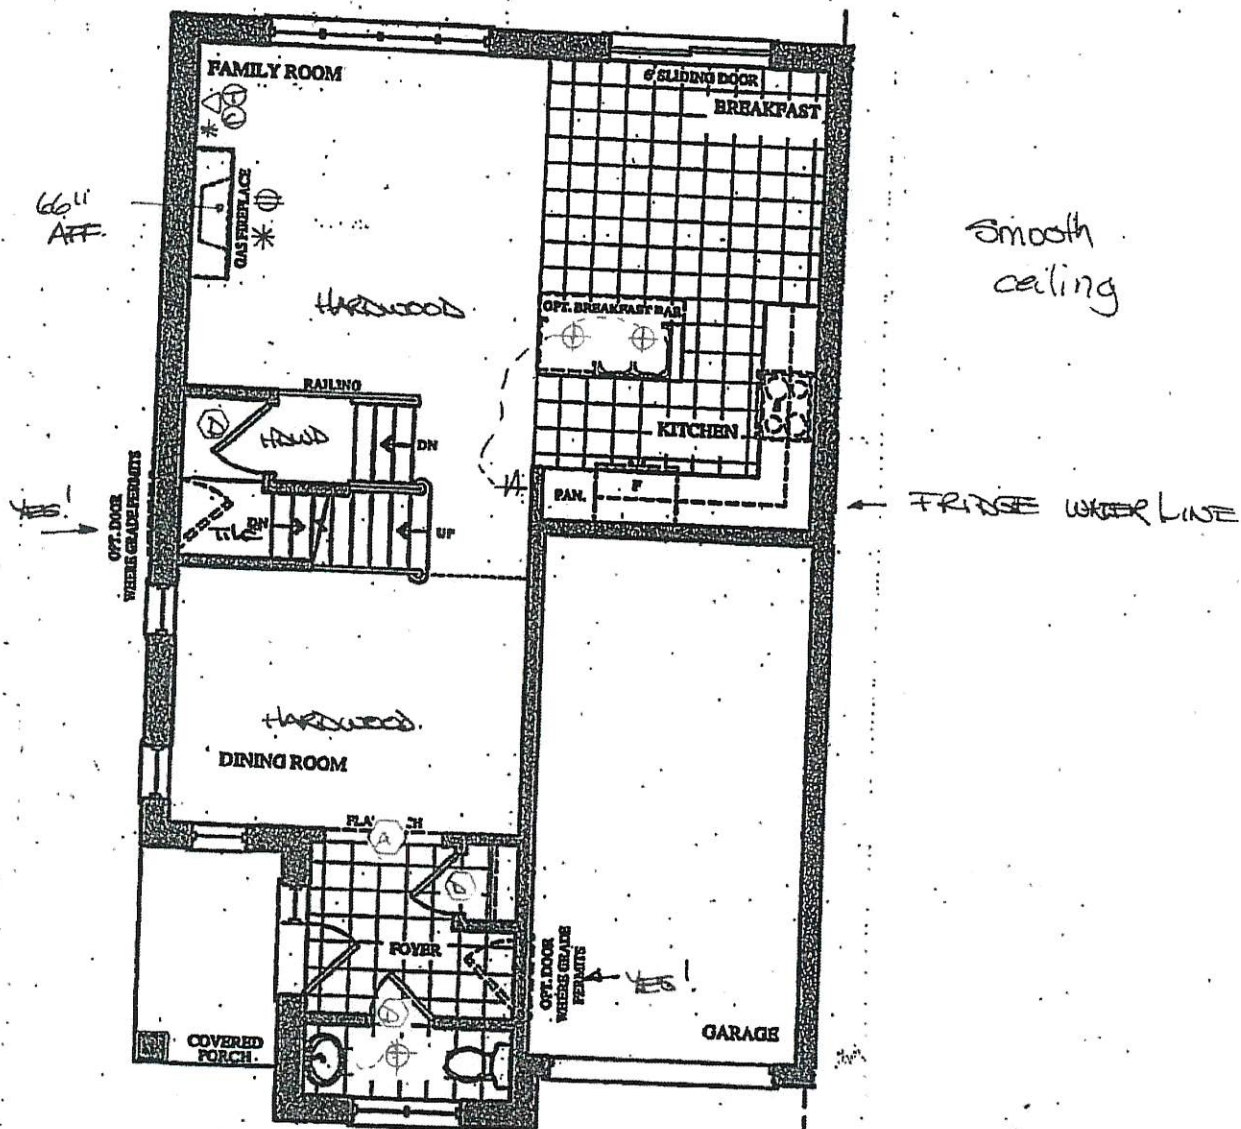


GROUND FLOOR PLAN
ELEV. 'A' & 'B'

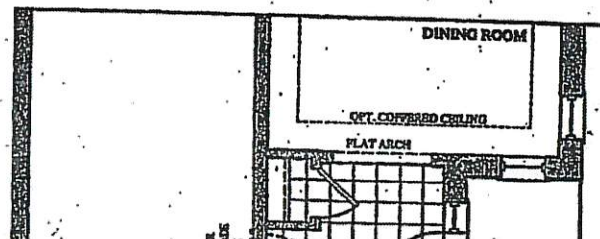

BE2-BDR
DEC 13 2019 13 5

The Siren SEMI SERIES

Elevation A • 1,688 sq.ft.
Elevation B • 1,677 sq.ft.
Elevation C • 1,687 sq.ft.

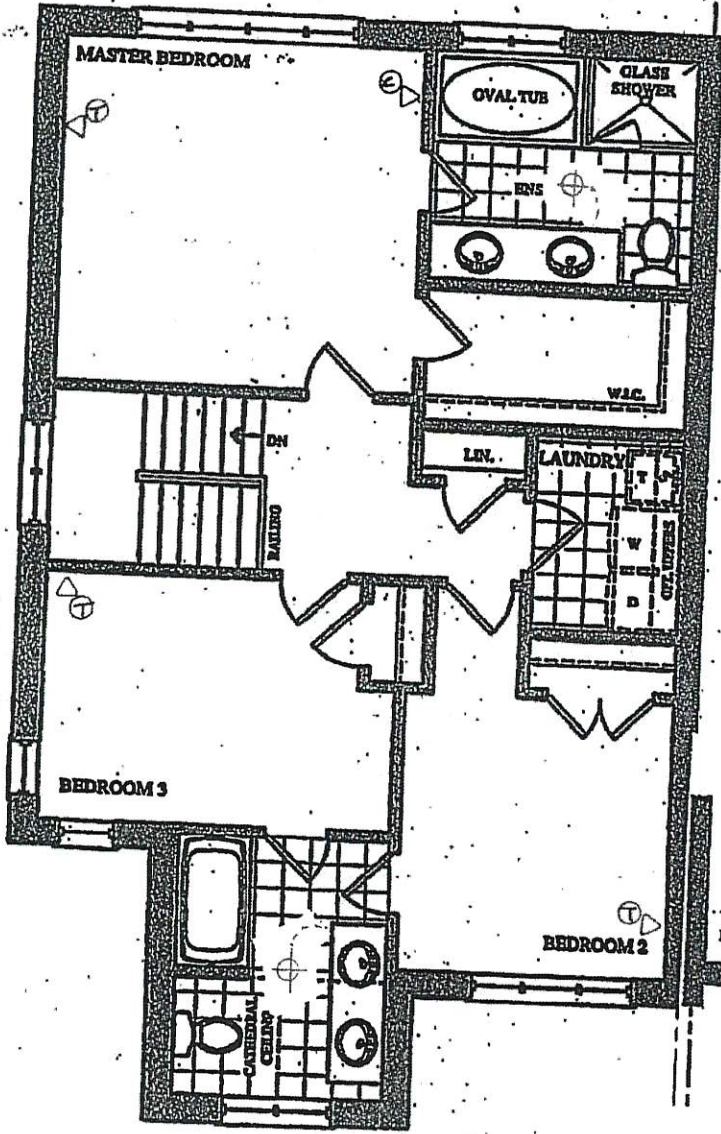

SECOND FLOOR PLAN
ELEV. 'A'

PART. SECOND FLOOR PLAN
ELEV. 'B'

