

Brampton Encore - 83L - 2 - 28-2 Elev.CL Siren

APPLIANCES

Inv.2,147	1 - 5 APPLIANCES: STAINLESS STEEL - FRIDGE/STOVE/DISHWASHER + WHITE - WASHER/DRYER
Line30180	Note:
19Dec19 / 9Jan20	

CONCRETE AND DRAIN

Inv.2,147	1 - 3PC Basement Rough-In
Line30339	Note:
19Dec19 / 9Jan20	

Exterior Colours

Inv.2,147	1 - Exterior Colour Package # 7
Line30340	Note:
19Dec19 / 9Jan20	

FORMING

Inv.2,147	1 - SIDE DOOR- HOME TO EXTERIOR- AS PER PLAN AND GRADE PERMITTING
Line30172	Note:
19Dec19 / 9Jan20	
Inv.2,147	1 - Garage Mandoor - Garage To House - As Per Plan And Grade Permitting
Line30337	Note:
19Dec19 / 9Jan20	

FRAMING

Inv.2,147	1 - MANDOOR - GARAGE TO HOUSE- AS PER PLAN AND GRADE PERMITING
Line30173	Note:
19Dec19 / 9Jan20	
Inv.2,147	1 - Side Door - Home To Exterior - As Per Plan And Grade Permitting
Line30338	Note:
19Dec19 / 9Jan20	

HVAC

Inv.2,147	1 - A/C - 2.0 TON
Line30179	Note:
19Dec19 / 9Jan20	

PLUMBING

Inv.2,147	1 - ROUGH-IN - 3PC BASEMENT ROUGH-IN
Line30177	Note:
19Dec19 / 9Jan20	

WINDOWS - BASEMENT

Inv.2,147	3 - BASEMENT WINDOWS - UPGRADE EXISTING BASEMENT WINDOW TO 30 INCH X 24 INCH - MAY REQUIRE INSTALLATION OF WINDOW WELL
Line30178	Note:
19Dec19 / 9Jan20	

WINDOWS AND DOORS


Brampton Encore - 83L - 2 - 28-2 Elev.CL Siren

Inv.2,147	1 - Side Door & Mandoor
Line30341	Note:
19Dec19 / 9Jan20	

BE2-83L
Dec 19 2009

The
Siren
SEMI SERIES

Elevation A • 1,688 sq.ft.
Elevation B • 1,677 sq.ft.
→ Elevation C • 1,687 sq.ft.

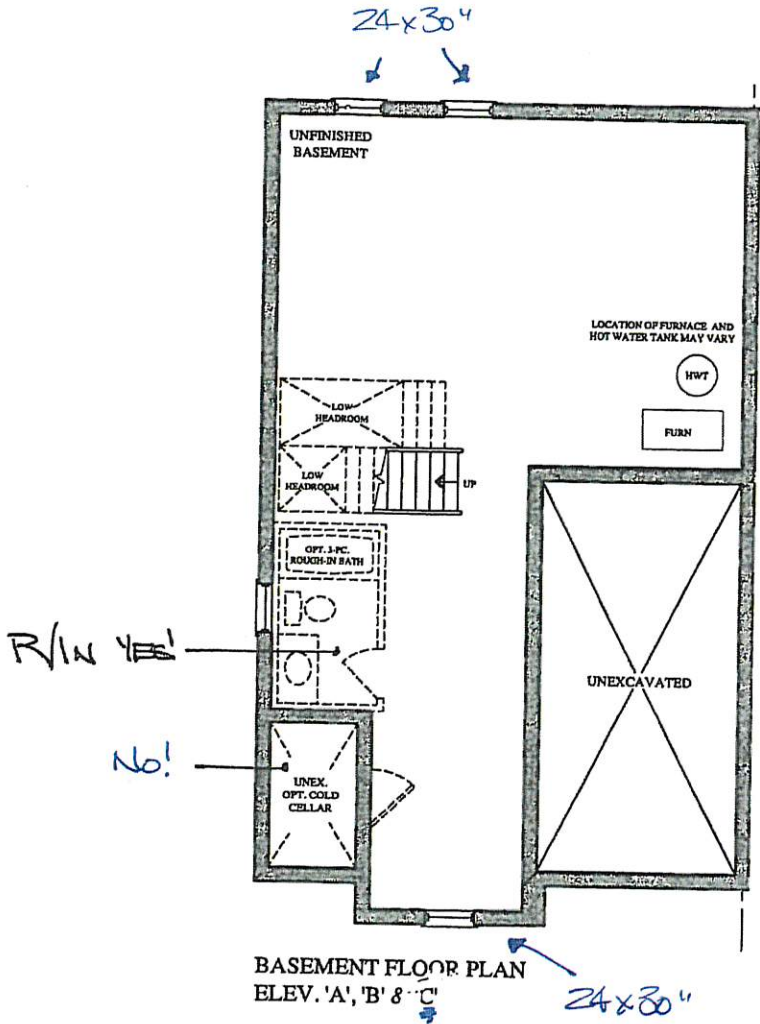

ices, figures, illustrations, sizes, features and finishes are subject to change without notice. Areas and dimensions are approximate and actual usable floor space may vary from the stated area. Layout may be reverse of the unit purchased. E. & O.E.


GOLDPARK
WORTH MORE™

BE2-88L
Dec 19 2019


The Siren

SEMI SERIES


Elevation A • 1,688 sq.ft.
Elevation B • 1,677 sq.ft.
Elevation C • 1,687 sq.ft.

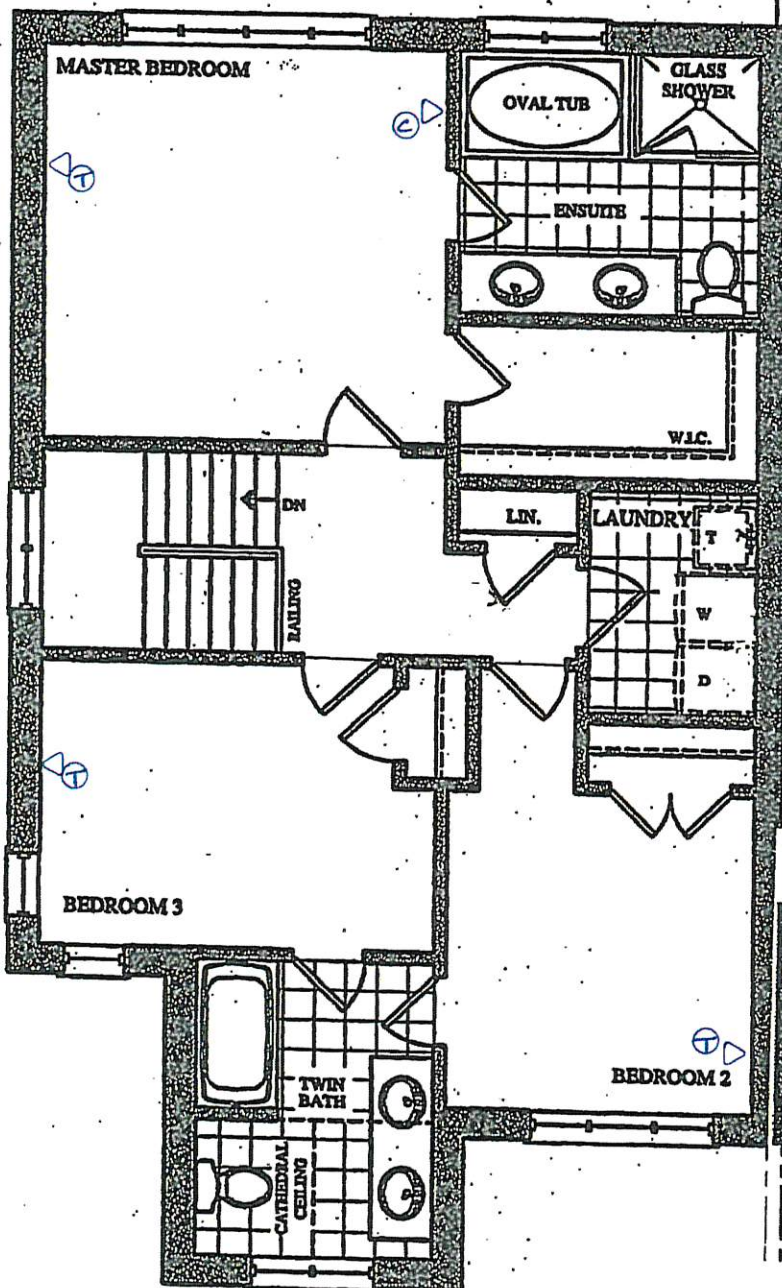

SECOND FLOOR PLAN
ELEV. 'A'

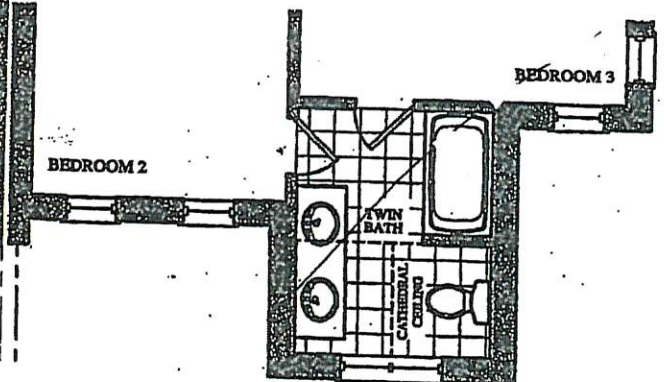

PART. SECOND FLOOR PLAN
ELEV. 'B'

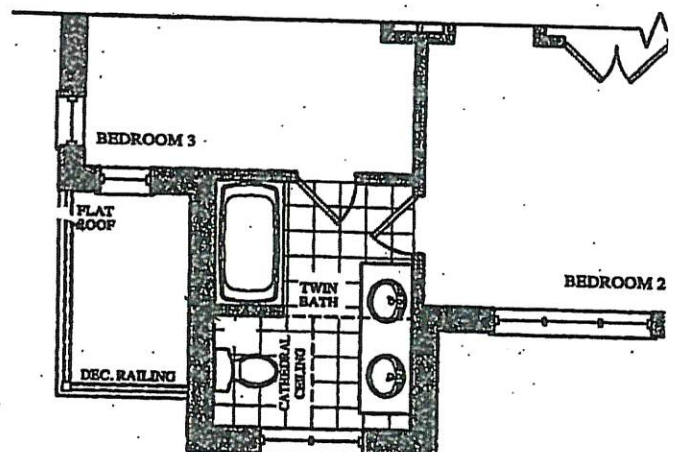

PART. SECOND FLOOR PLAN
ELEV. 'C'

The Siren


SEMI SERIES

Elevation A • 1,688 sq.ft.


Elevation B • 1,677 sq.ft.

→ Elevation C • 1,687 sq.ft.

BEZ-83L
Dec 19 2019

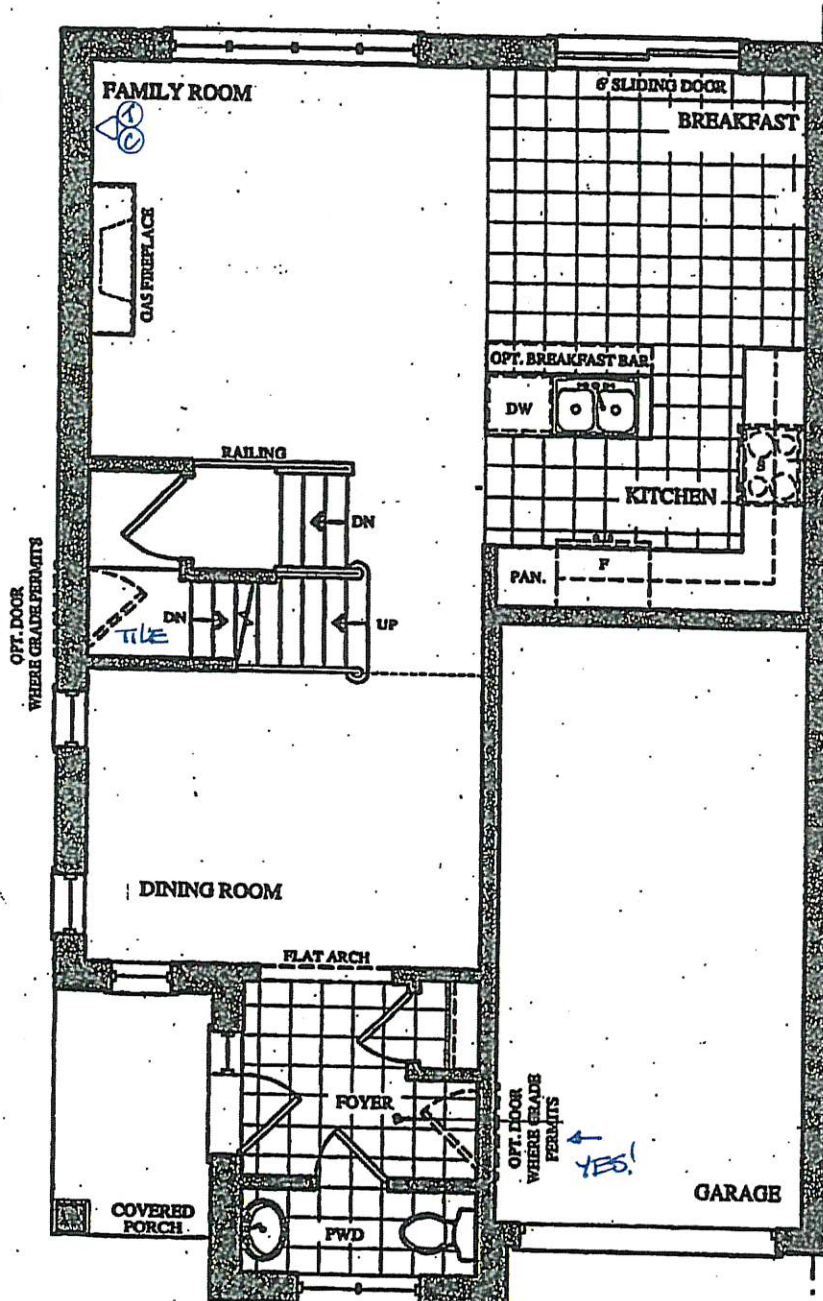

GROUND FLOOR PLAN
ELEV. 'A' & 'B'

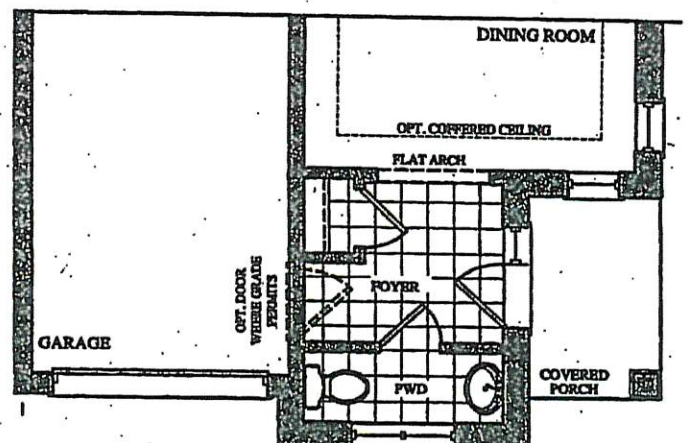

PART. GROUND FLOOR PLAN
ELEV. 'C'