

Brampton Encore - 67L - 2 - 28-09 Elev A Gershwin

CENTRAL VAC AND WIRING

Inv.2,131	1 - GREAT ROOM: CONDUIT PIPE- FOR TELEVISION- LOCATE APPROX. 66" A.F.F. ABOVE FIREPLACE, TERMINATING AT CABLE LOCATION
Line29910	Note: SEE PLAN FOR LOCATION
9Dec19 / 14Jan20	

CONCRETE AND DRAIN

Inv.2,131	1 - 3PC Basement Rough-In
Line30424	Note:
9Dec19 / 14Jan20	

ELECTRICAL

Inv.2,131	1 - 200 AMP ELECTRICAL SERVICE
Line29912	Note:
9Dec19 / 14Jan20	

Inv.2,131	1 - GREAT ROOM: 110V WALL RECEPTACLE ON DEDICATED CIRCUIT- LOCATE APPROX. 66" A.F.F. ABOVE FIREPLACE.
Line29911	Note:
9Dec19 / 14Jan20	

Exterior Colours

Inv.2,131	1 - Exterior Colour Package # 9
Line30427	Note:
9Dec19 / 14Jan20	

FORMING

Inv.2,131	1 - SIDE DOOR- HOME TO EXTERIOR- AS PER PLAN AND GRADE PERMITTING
Line29916	Note: INCLUDED IN APS
9Dec19 / 14Jan20	

Inv.2,131	1 - Garage Mandoor - Garage To House - As Per Plan And Grade Permitting
Line30423	Note:
9Dec19 / 14Jan20	

FRAMING

Inv.2,131	1 - MANDOOR - GARAGE TO HOUSE- AS PER PLAN AND GRADE PERMITING
Line29917	Note: INCLUDED IN APS
9Dec19 / 14Jan20	

Inv.2,131	1 - Side Door - Home To Exterior - As Per Plan And Grade Permitting
Line30422	Note:
9Dec19 / 14Jan20	

Inv.2,131	1 - Extended Height Archway on Main Floor
Line30491	Note:
9Dec19 / 14Jan20	

INTERIOR TRIM AND DOORS

Inv.2,131	1 - MAIN FLOOR; EXTENDED HEIGHT ARCHWAY (PRICE PER DOORWAY) - 96"
Line29915	Note:
9Dec19 / 14Jan20	

Brampton Encore - 67L - 2 - 28-09 Elev A Gershwin

Inv.2,131	1 - Side Door & Mandoor - As Per Plan And Grade Permitting
Line30425	Note:
9Dec19 / 14Jan20	

MISC.

Inv.2,131	1 - Purchaser has attended an appointment at the Decor Centre & has DECLINED any additional upgrades and accepts and acknowledges that there will be no further changes/additions/deletions to be made upon signing on December 9, 2019.
Line29918	Note:
9Dec19 / 14Jan20	
Inv.2,131	1 - BONUS PACKAGE: \$10,000.00 (INCLUDING TAXES) WORTH OF UPGRADES FROM GOLD PARK HOMES DÉCOR CENTRE IS BEING APPLIED TOWARD THIS ORDER. PURCHASER HAS A REMAINING AMOUNT OF \$4756.80 (INCLUDING TAXES).
Line29919	Note:
9Dec19 / 14Jan20	

PLUMBING

Inv.2,131	1 - ROUGH-IN - 3PC BASEMENT ROUGH-IN
Line29913	Note:
9Dec19 / 14Jan20	

WINDOWS - BASEMENT

Inv.2,131	3 - BASEMENT WINDOWS - UPGRADE EXISTING BASEMENT WINDOW TO 30 INCH X 24 INCH - MAY REQUIRE INSTALLATION OF WINDOW WELL
Line29914	Note:
9Dec19 / 14Jan20	

WINDOWS AND DOORS


Inv.2,131	1 - Side Door & Mandoor - As Per Plan And Grade Permitting
Line30426	Note:
9Dec19 / 14Jan20	

BE2-67L
DEC 9 2019

PL
SB

The
Gershwin
SEMI SERIES

- Elevation A • 1,920 sq.ft.
- Elevation B • 1,920 sq.ft.
- Elevation C • 1,920 sq.ft.
- Elevation D • 1,920 sq.ft.

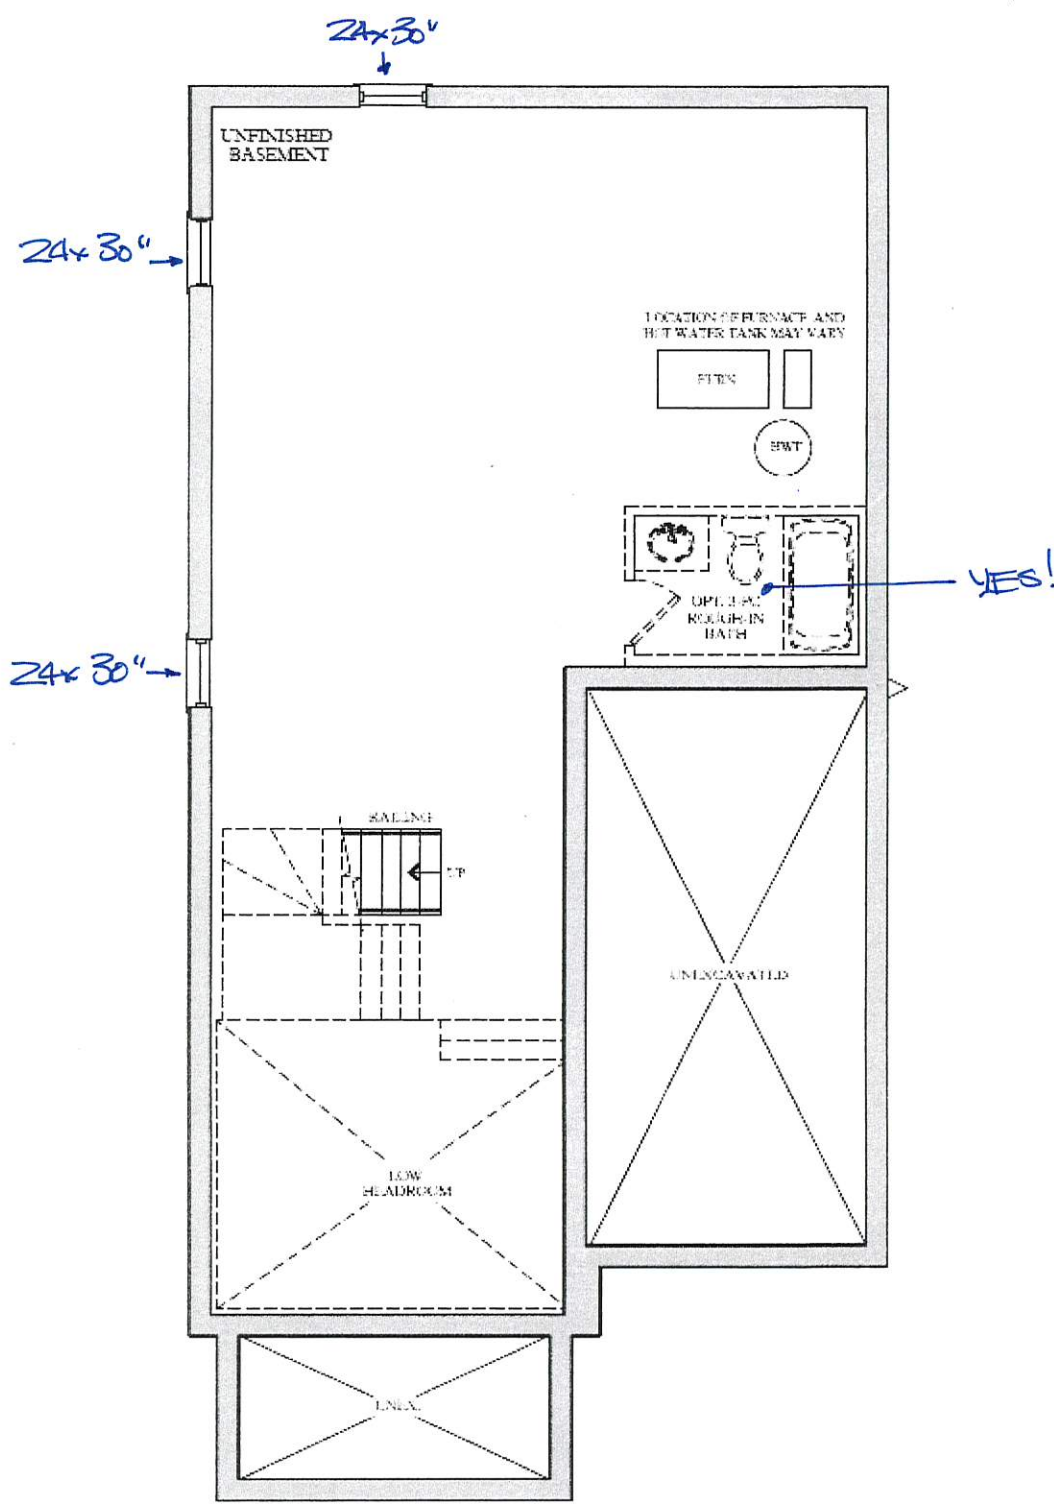

BASEMENT
ELEVATION A & B

VENDOR

PURCHASER

PURCHASER

GOLD PARK
WORTH MORE™

Prices, figures, illustrations, plans, features and finishes are subject to change without notice. Areas and dimensions are approximate and actual usable floor space may vary from the illustrated layout. May be revised at the time purchased. © 2019

encore
BRAMPTON


The Gershwin SEMI SERIES

- Elevation A • 1,920 sq.ft.
- Elevation B • 1,920 sq.ft.
- Elevation C • 1,920 sq.ft.
- Elevation D • 1,920 sq.ft.

BE2-67L

DEC 9 2019

PC SB

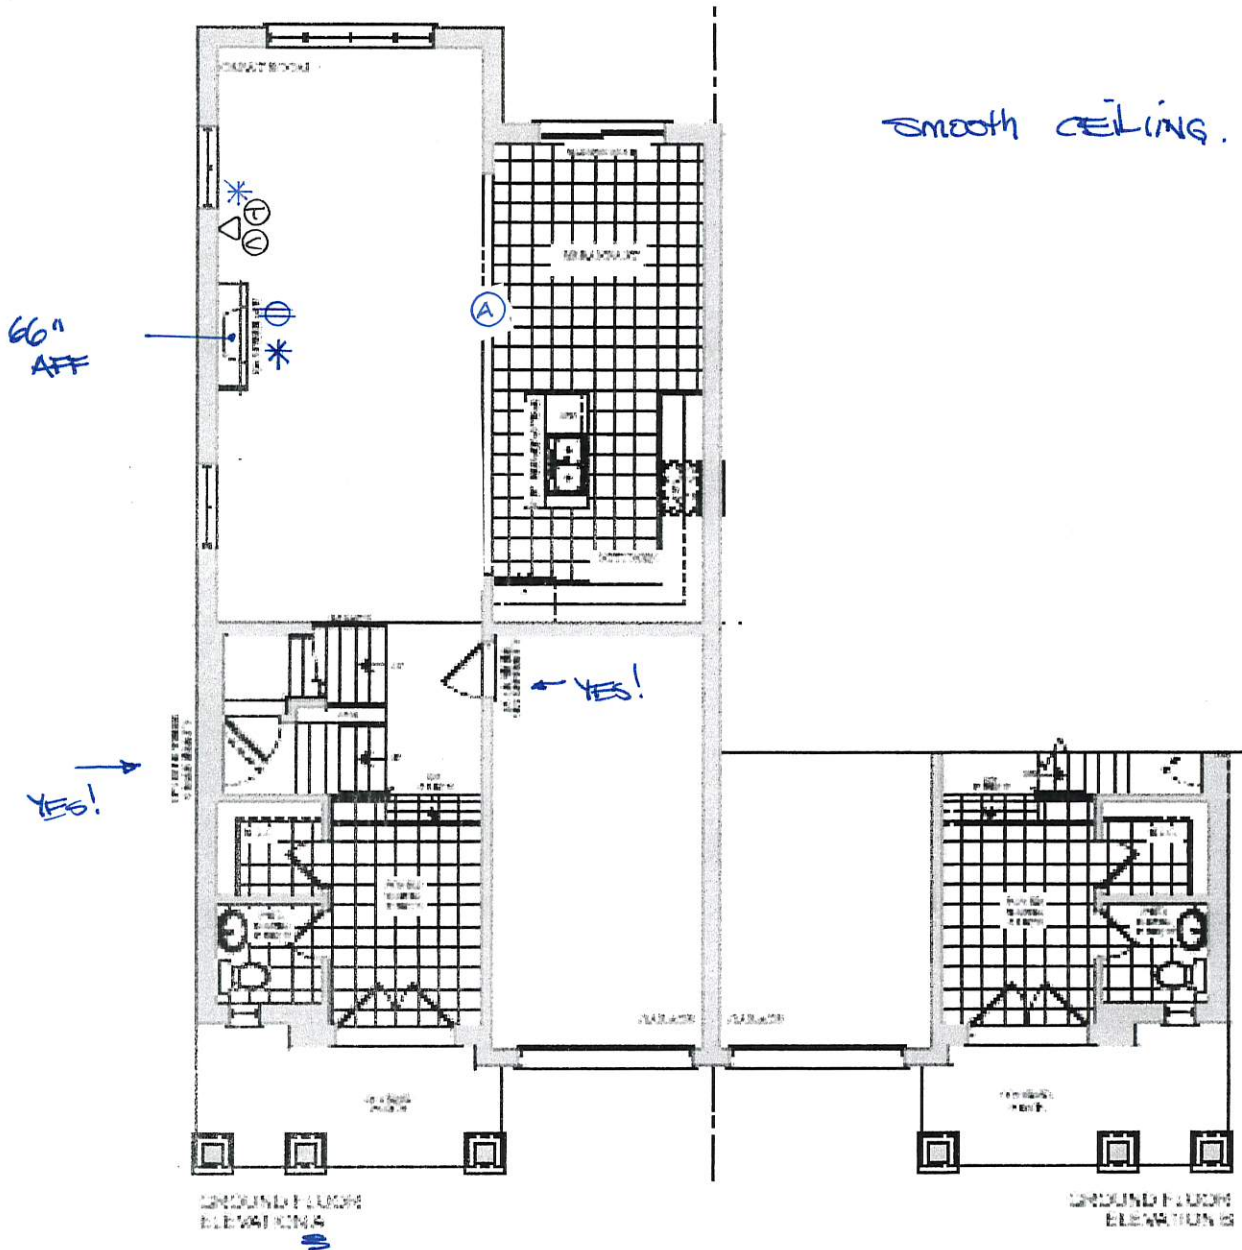

VENDOR	
PURCHASER	
PURCHASER	

GOLD PARK
WORTH MORE™

Prices, figures, electrical and other features and finishes are subject to change without notice. Areas and dimensions are approximate and actual usable floor space may vary from the stated area. Layout may be revised at any time purchased. E. & O.E.


encore
BRAMPTON

BE2-67L
Dec 9 2019

PC
EB

The Gershwin SEMI SERIES

- Elevation A • 1,920 sq.ft.
- Elevation B • 1,920 sq.ft.
- Elevation C • 1,920 sq.ft.
- Elevation D • 1,920 sq.ft.

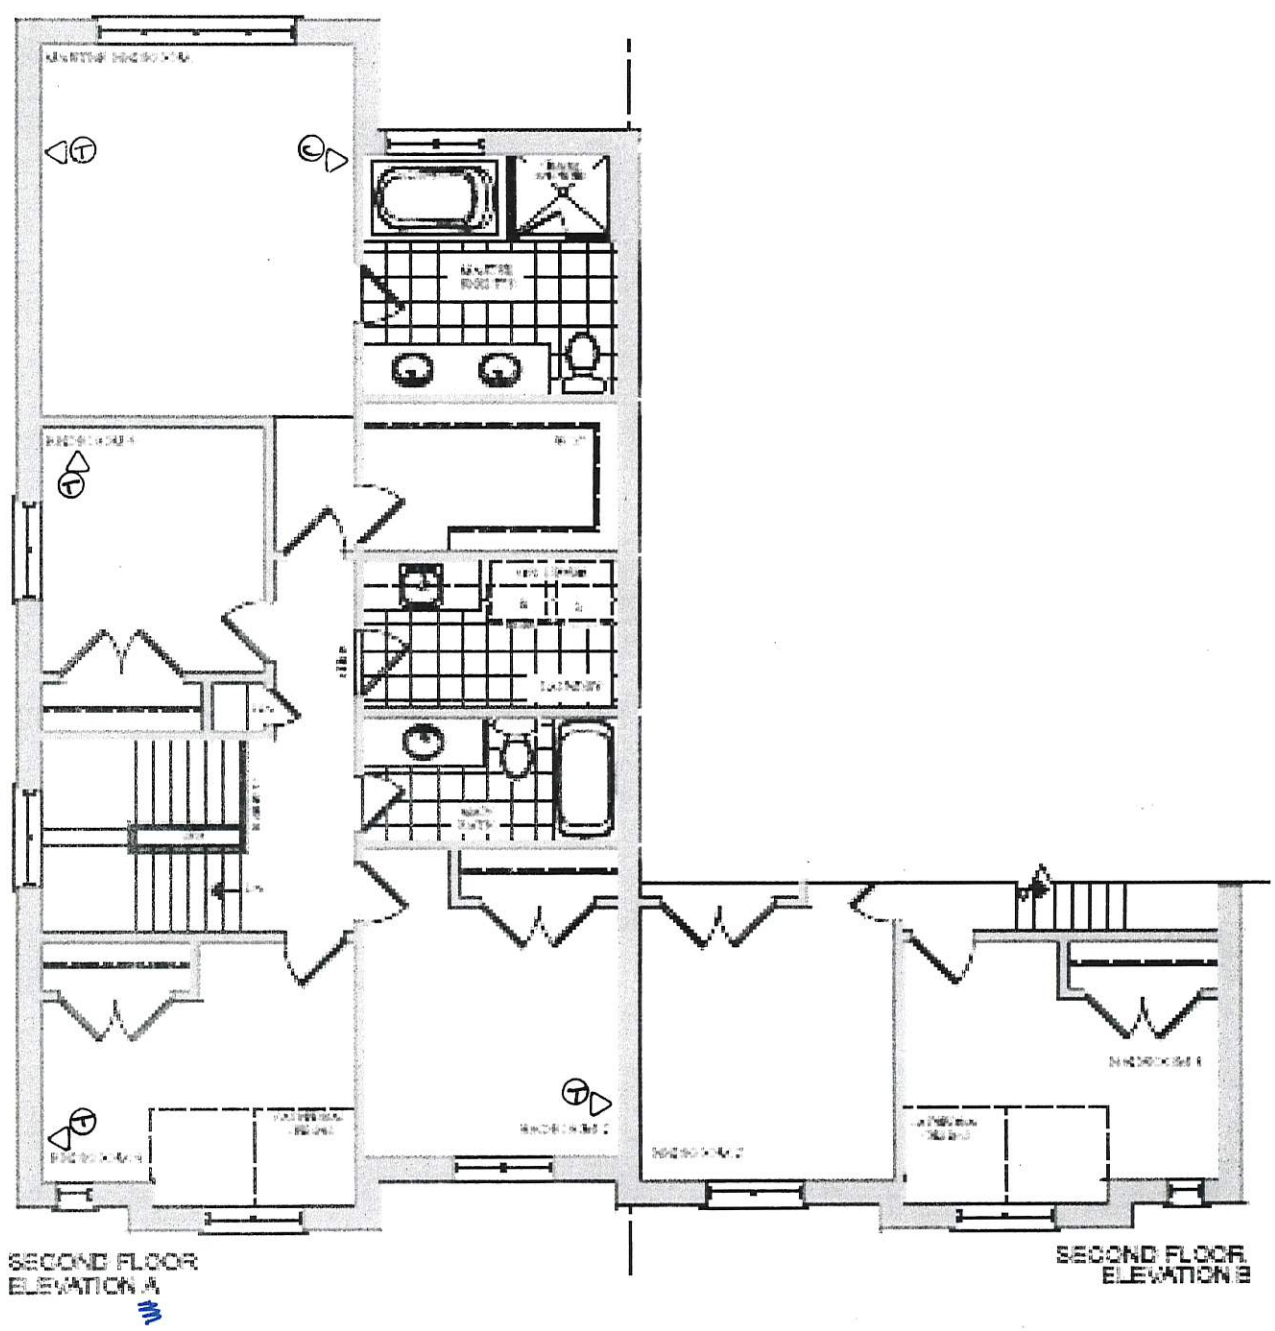

VENDOR

PURCHASER


PURCHASER

GOLD PARK
WORTH MORE™


Prices, figures, features and colors, fixtures and finishes are subject to change without notice. Areas and dimensions are approximate and actual usable floor space may vary from the stated area. Layout may be revised at the time purchased. L. & O.V.

The
Gershwin
SEMI SERIES

Elevation A • 1,920 sq.ft.
Elevation B • 1,920 sq.ft.
Elevation C • 1,920 sq.ft.
Elevation D • 1,920 sq.ft.

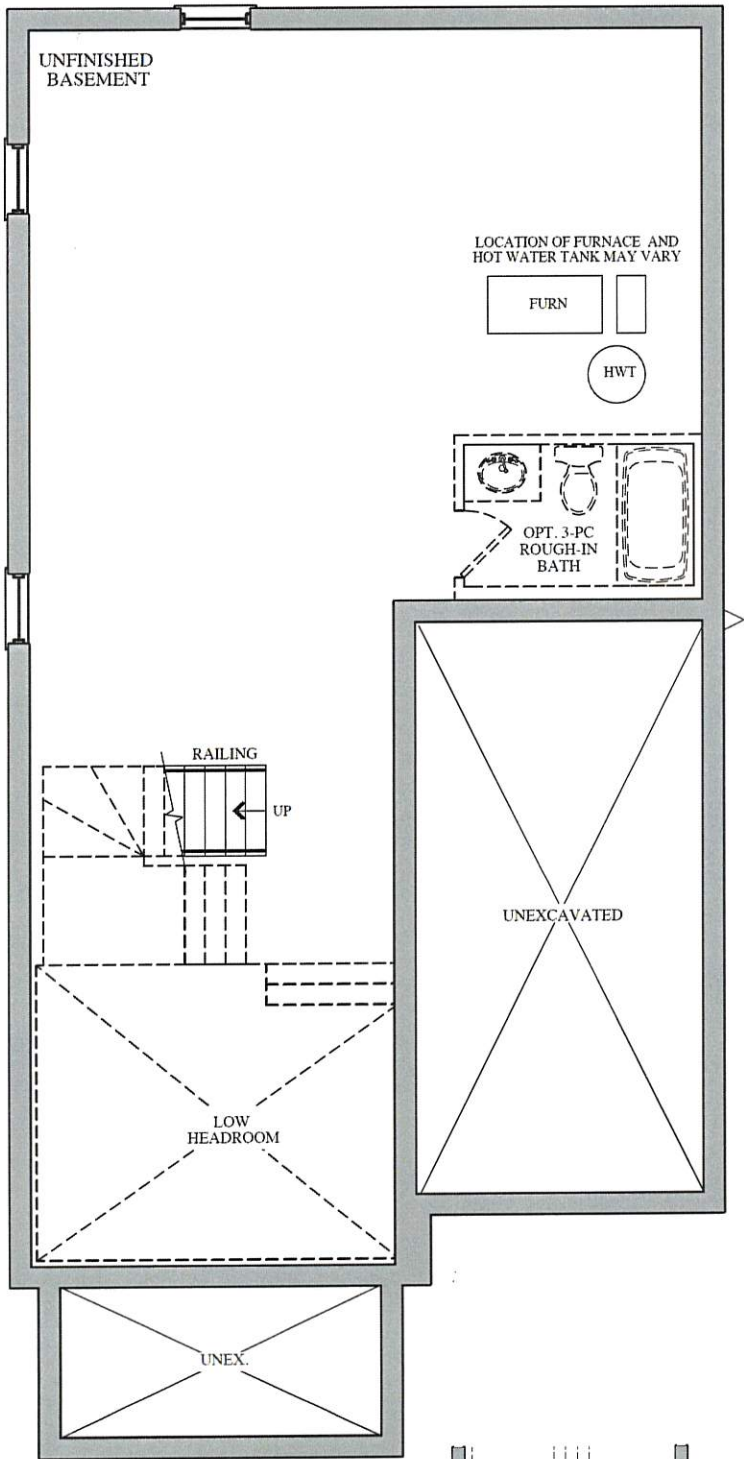

BASEMENT
ELEVATION A & B

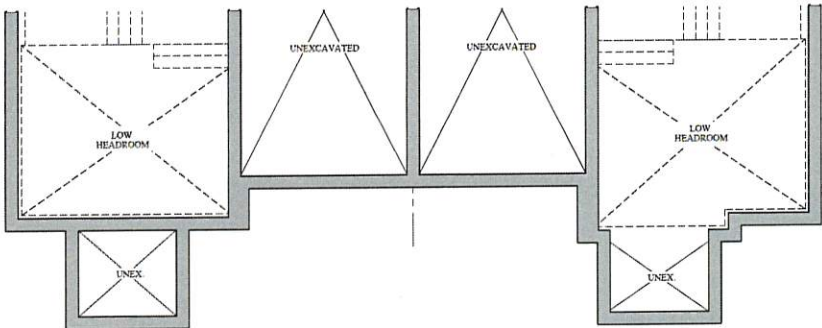

PART. BASEMENT FLOOR
ELEVATION C

PART. BASEMENT FLOOR
ELEVATION D

VENDOR

PURCHASER


PURCHASER

GOLDPARK
WORTH MORE™

Prices, figures, illustrations, sizes, features and finishes are subject to change without notice. Areas and dimensions are approximate and actual usable floor space may vary from the stated area. Layout may be reverse of the unit purchased. E. & O.E.


The
Gershwin
SEMI SERIES

Elevation A • 1,920 sq.ft.
Elevation B • 1,920 sq.ft.
Elevation C • 1,920 sq.ft.

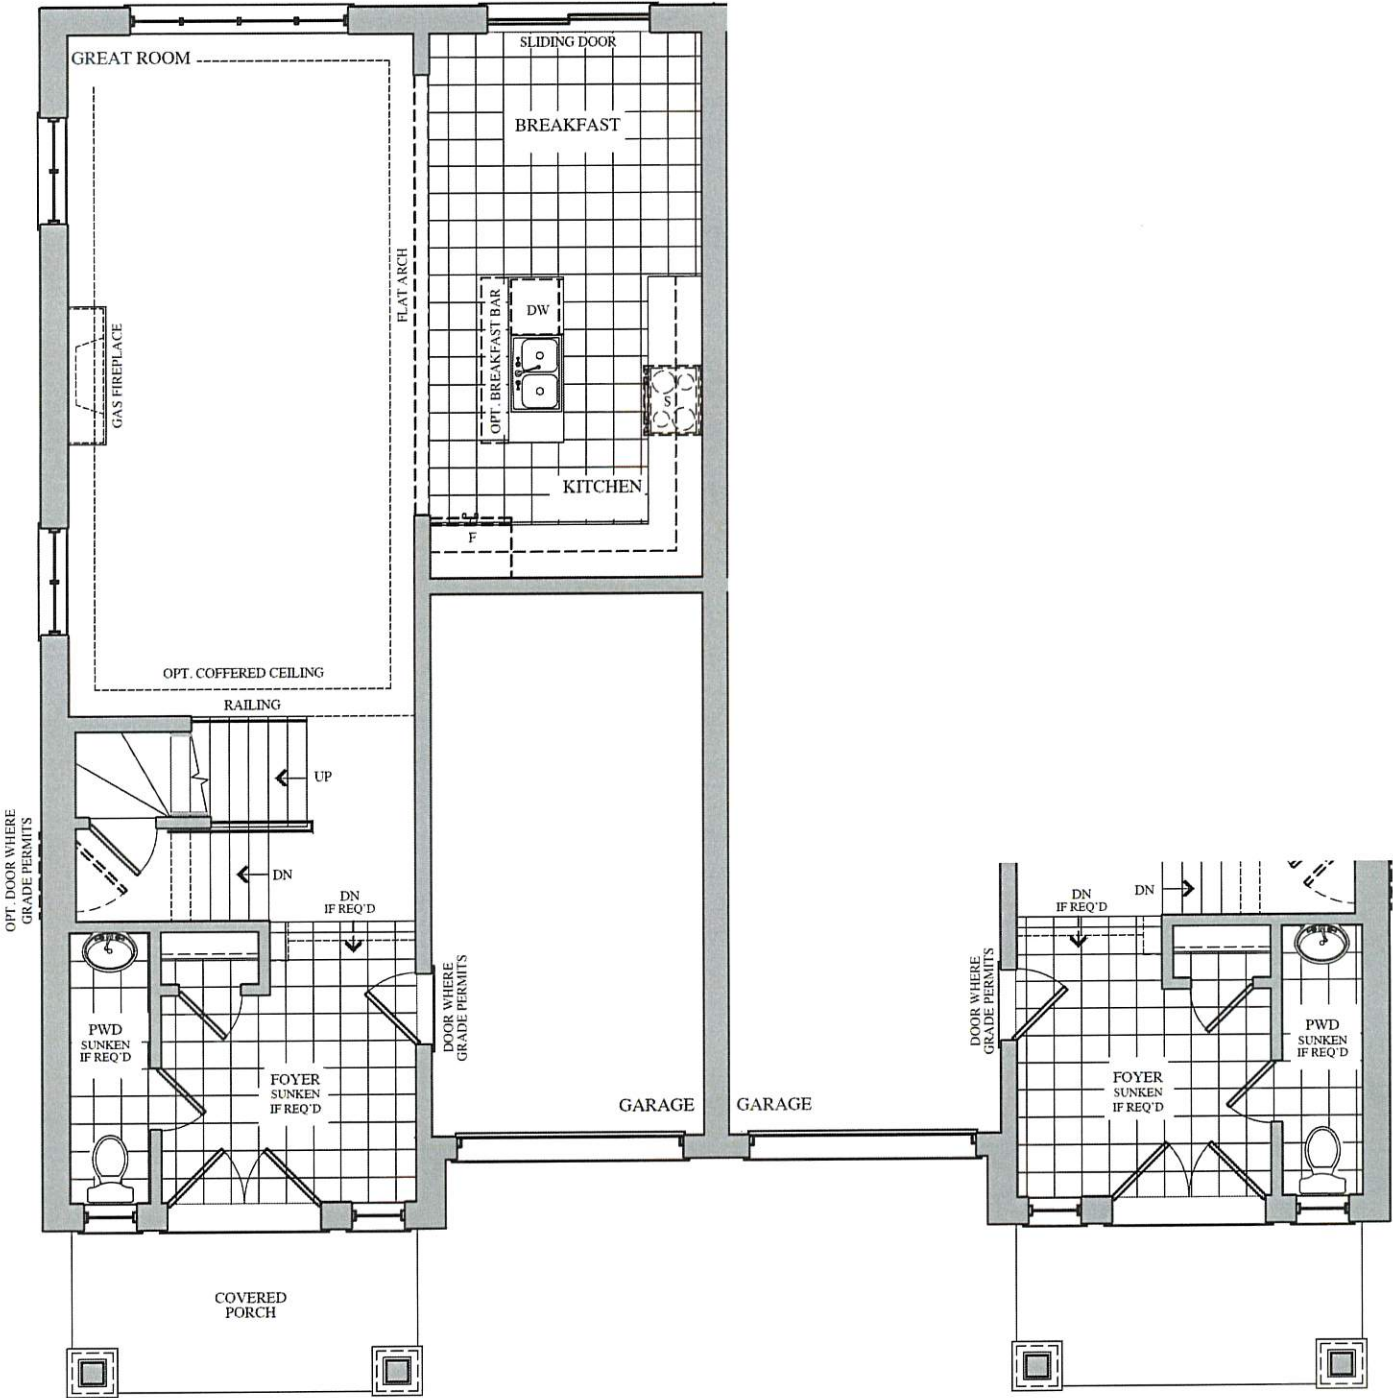

GROUND FLOOR
ELEVATION A

GROUND FLOOR
ELEVATION B

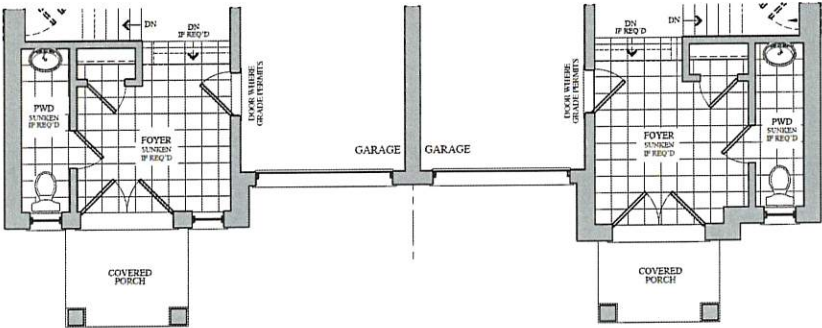

PART. GROUND FLOOR
ELEVATION C

PART. GROUND FLOOR
ELEVATION D

VENDOR

PURCHASER


PURCHASER

GOLDPARK
WORTH MORE™

Prices, figures, illustrations, sizes, features and finishes are subject to change without notice. Areas and dimensions are approximate and actual usable floor space may vary from the stated area. Layout may be reverse of the unit purchased. E. & O.E.

The
Gershwin
SEMI SERIES

Elevation A • 1,920 sq.ft.
Elevation B • 1,920 sq.ft.
Elevation C • 1,920 sq.ft.
Elevation D • 1,920 sq.ft.

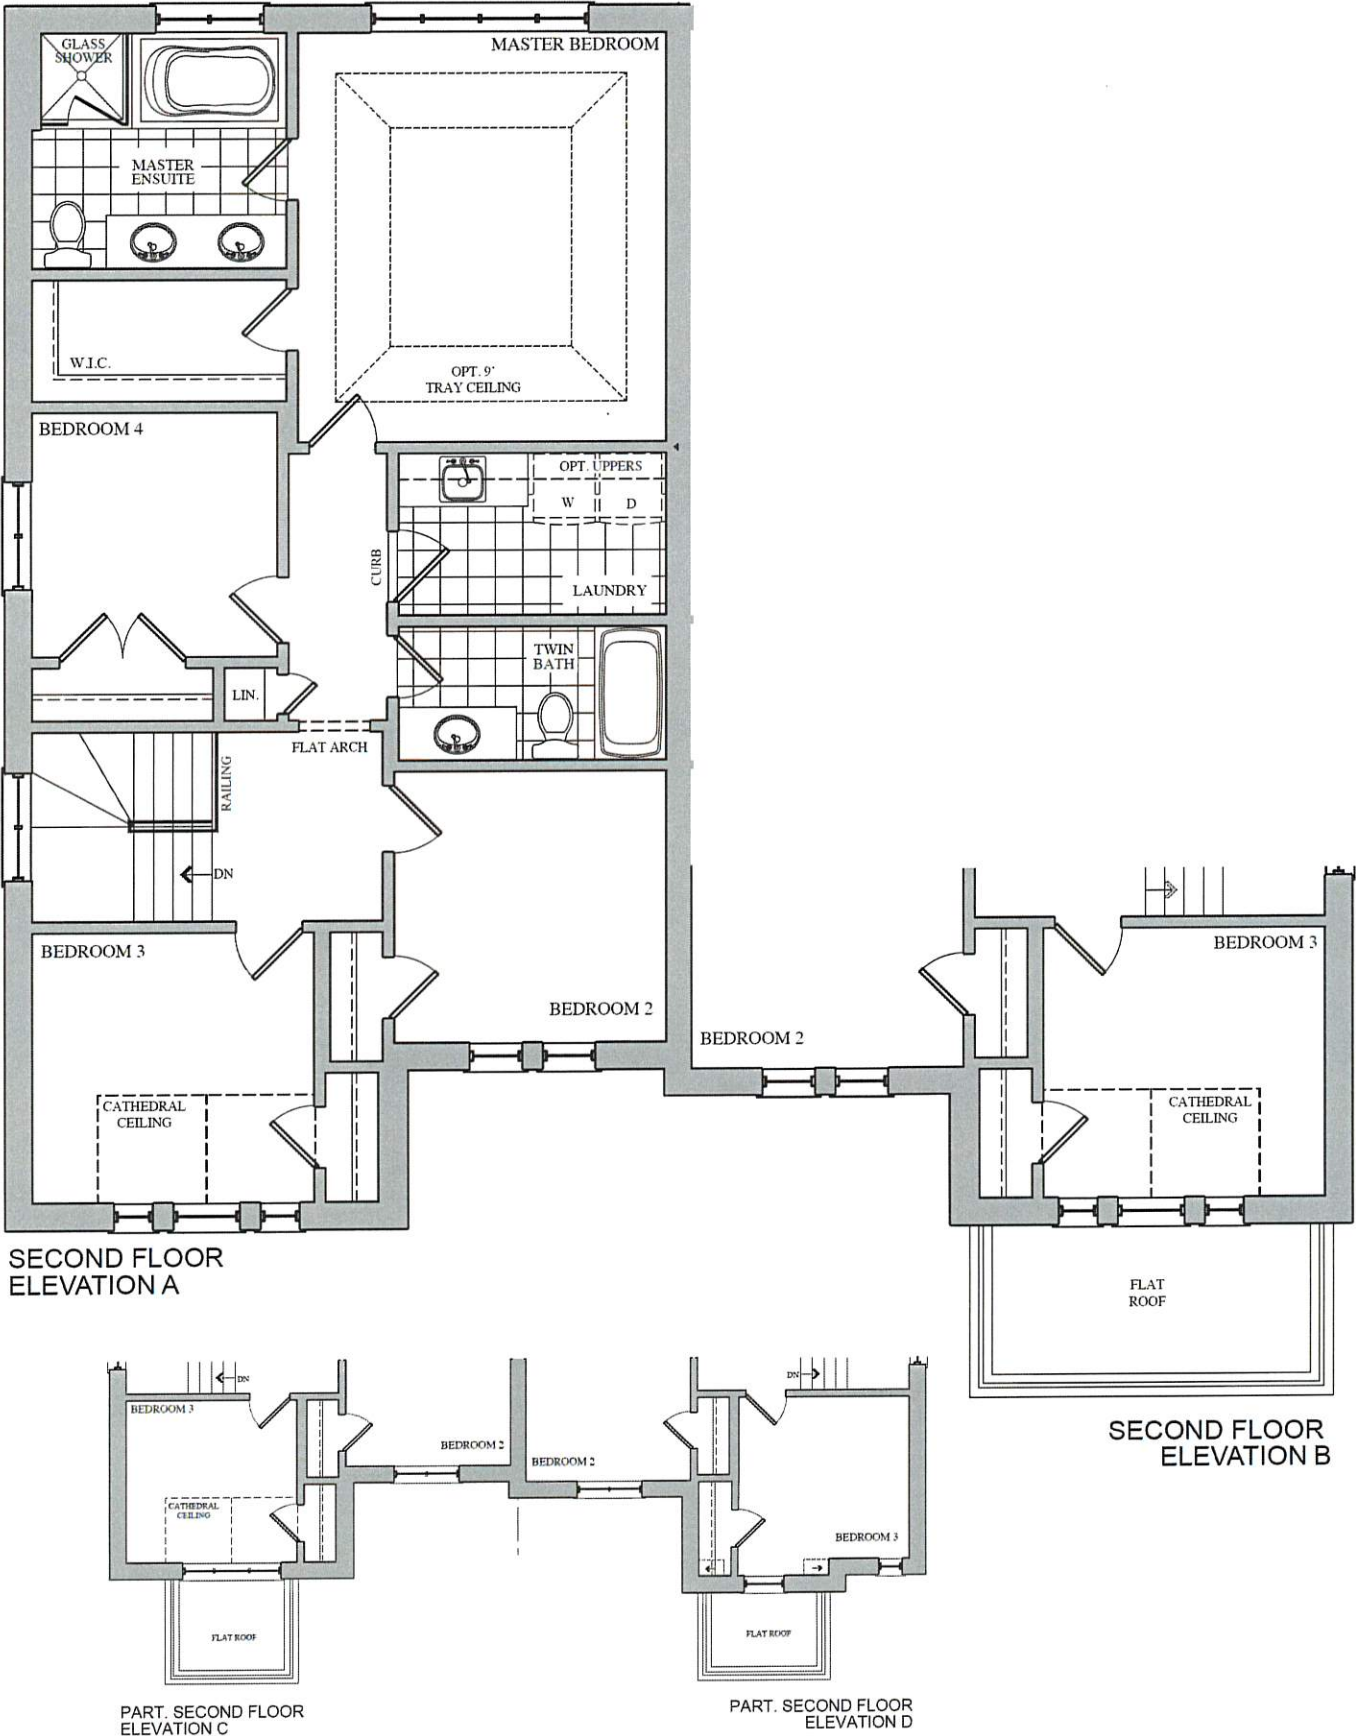

VENDOR

PURCHASER

PURCHASER

GOLDPARK
WORTH MORE™

Prices, figures, illustrations, sizes, features and finishes are subject to change without notice. Areas and dimensions are approximate and actual usable floor space may vary from the stated area. Layout may be reverse of the unit purchased. E. & O.E.