

Brampton Encore - 69L - 2 - 28-10 Elev A Stravinsky
CENTRAL VAC AND WIRING

Inv.2,136	1 - BEDROOM 3: CAT 6 WIRING - ADD CAT 6- SEE PLAN FOR LOCATION
Line29988	Note:
16Dec19 / 14Jan20	

CONCRETE AND DRAIN

Inv.2,136	1 - 3PC Basement Rough-In
Line30494	Note:
16Dec19 / 14Jan20	

ELECTRICAL

Inv.2,136	1 - GREAT ROOM: 110V WALL RECEPTACLE ON DEDICATED CIRCUIT- LOCATE APPROX. 66" A.F.F. ABOVE FIREPLACE *SIDE CLOSEST TO FRONT DOOR* OF 2-SIDED FIREPLACE.
Line29987	Note: SEE PLAN FOR LOCATION
16Dec19 / 14Jan20	
Inv.2,136	2 - KITCHEN: ROUGH - IN CEILING OUTLET DOES NOT INCLUDE FIXTURE - LOCATE APPROX. CENTER ABOVE ISLAND
Line29992	Note:
16Dec19 / 14Jan20	
Inv.2,136	1 - GREAT ROOM: RELOCATE STANDARD FIXTURE - SEE PLAN FOR LOCATION
Line29990	Note:
16Dec19 / 14Jan20	
Inv.2,136	1 - KITCHEN: SINGLE POLE SWITCH FOR ISLAND LIGHTS
Line29993	Note:
16Dec19 / 14Jan20	
Inv.2,136	1 - KITCHEN: 110V WALL RECEPTACLE ON DEDICATED CIRCUIT - FOR MICROWAVE ON SHELF- MICROWAVE & CABINETRY CUSTOMIZATION NOT INCLUDED -
Line29994	Note: LOCATE BESIDE FRIDGE
16Dec19 / 14Jan20	
Inv.2,136	1 - KITCHEN: 110V WALL RECEPTACLE ON DEDICATED CIRCUIT- LOCATE IN BACKSPLASH BESIDE FRIDGE, BELOW MICROWAVE SHELF
Line29995	Note: SEE PLAN FOR LOCATION
16Dec19 / 14Jan20	
Inv.2,136	1 - KITCHEN; 110V WALL RECEPTACLE ON DEDICATED CIRCUIT - GAS FIRED APPLIANCE - FOR AUX. EQUIPMENT - NOT A STOVE PLUG
Line29997	Note:
16Dec19 / 14Jan20	
Inv.2,136	1 - GREAT ROOM: ROUGH-IN CEILING LIGHT, SEE PLAN FOR LOCATION
Line30004	Note:
16Dec19 / 14Jan20	
Inv.2,136	1 - GREAT ROOM: SINGLE POLE SWITCH FOR CEILING ROUGH-IN
Line30005	Note:
16Dec19 / 14Jan20	

Exterior Colours

Inv.2,136	1 - Exterior Colour Package # 3
Line30493	Note:
16Dec19 / 14Jan20	

FORMING

Brampton Encore - 69L - 2 - 28-10 Elev A Stravinsky

Inv.2,136	1 - SIDE DOOR- HOME TO EXTERIOR- AS PER PLAN AND GRADE PERMITTING
Line29984	Note: INCLUDED IN APS
16Dec19 / 14Jan20	
Inv.2,136	1 - Garage Mandoor - Garage To House - As Per Plan And Grade Permitting
Line30492	Note:
16Dec19 / 14Jan20	

FRAMING

Inv.2,136	1 - MANDOOR - GARAGE TO HOUSE- AS PER PLAN AND GRADE PERMITING
Line29983	Note: INCLUDED IN APS
16Dec19 / 14Jan20	
Inv.2,136	1 - **CUSTOM** GREAT ROOM: DELETE STANDARD GAS FIREPLACE. CREATE PARTITION WALL TO HOUSE 2-SIDED GAS FIREPLACE model # PEARL36STIN SEE ATTACHED SKETCH FOR DETAIL
Line29986	Note:
16Dec19 / 14Jan20	
Inv.2,136	1 - Side Door - Home To Exterior - As Per Plan And Grade Permitting
Line30495	Note:
16Dec19 / 14Jan20	
Inv.2,136	1 - Revised Fire Place Location (see notes and plan)
Line30496	Note:
16Dec19 / 14Jan20	
Inv.2,136	1 - Extended Height Arches on Main floor (2 Storey Model)
Line30497	Note:
16Dec19 / 14Jan20	

HVAC

Inv.2,136	1 - KITCHEN: GAS LINE ROUGH - 2ND FLOOR- (2-STOREY MODELS)
Line29996	Note:
16Dec19 / 14Jan20	

INTERIOR TRIM AND DOORS

Inv.2,136	1 - MAIN FLOOR: EXTENDED HEIGHT ARCHWAY (PRICE PER DOORWAY) - 96"
Line30000	Note:
16Dec19 / 14Jan20	

MISC.

Inv.2,136	1 - Purchaser has attended an appointment at the Decor Centre & has DECLINED any additional upgrades and accepts and acknowledges that there will be no further changes/additions/deletions to be made upon signing on December 16, 2019.
Line30006	Note:
16Dec19 / 14Jan20	
Inv.2,136	1 - BONUS PACKAGE: \$5,000.00 (INCLUDING TAXES) WORTH OF UPGRADES FROM GOLD PARK HOMES DÉCOR CENTRE IS BEING APPLIED TOWARD THIS ORDER. PURCHASER HAS A REMAINING AMOUNT OF \$00 (INCLUDING TAXES).
Line30007	Note:
16Dec19 / 14Jan20	

PLUMBING

Brampton Encore - 69L - 2 - 28-10 Elev A Stravinsky

Inv.2,136	1 - KITCHEN: ROUGH-IN - WATERLINE FOR FRIDGE
Line30002	Note:
16Dec19 / 14Jan20	
Inv.2,136	1 - ROUGH-IN - 3PC BASEMENT ROUGH-IN
Line29999	Note:
16Dec19 / 14Jan20	
Inv.2,136	1 - BACK-FLOW PREVENTER VALVE
Line30003	Note:
16Dec19 / 14Jan20	

WINDOWS - BASEMENT

Inv.2,136	3 - BASEMENT WINDOWS - UPGRADE EXISTING BASEMENT WINDOW TO 30 INCH X 24 INCH - MAY REQUIRE INSTALLATION OF WINDOW WELL
Line29998	Note:
16Dec19 / 14Jan20	

WINDOWS AND DOORS

Inv.2,136	1 - Side Door and Mandoor
Line30498	Note:
16Dec19 / 14Jan20	


encore
BRAMPTON

SCHEDULE 'F'

The
Stravinsky
SEMI SERIES

Elevation A • 2,090 sq.ft.
Elevation B • 2,105 sq.ft.
Elevation C • 2,160 sq.ft.
Elevation D • 2,105 sq.ft.

102-601 (PB)
Dec 2, 2019
JAN 7 2020
PB
PB

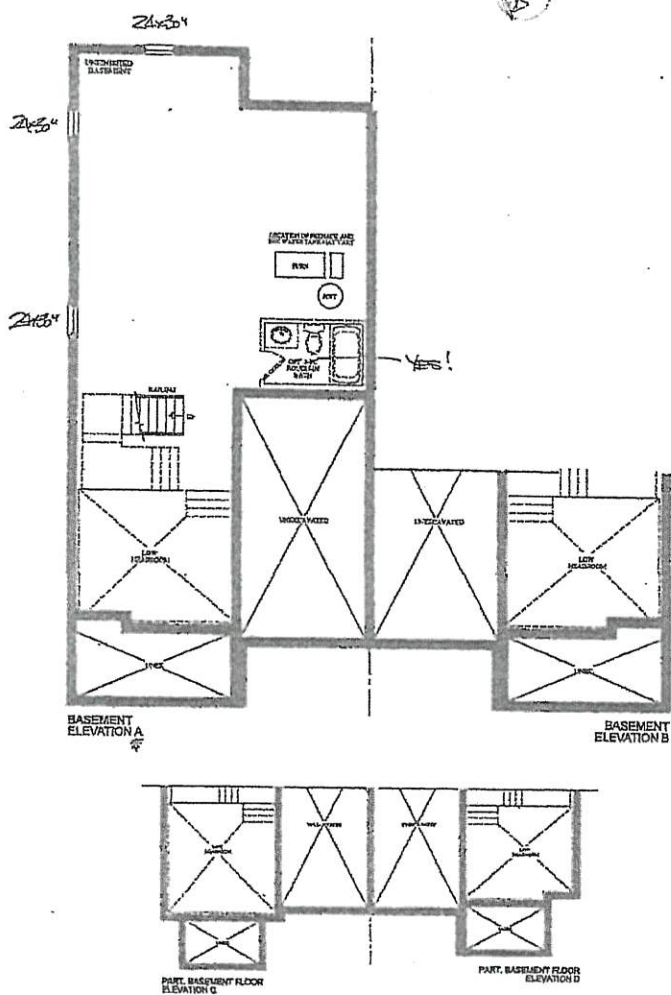

VENDOR
PURCHASER
PURCHASER

GOLDPARK
WORTH ALICE

Prices, figures, illustrations, sizes, features and finishes are subject to change without notice. Areas and dimensions are approximate and actual usable floor space may vary from the stated area. Layout may be reverse of the unit purchased. E & O.E.

encore
BRAMPTON

SCHEDULE 'F'



BEZ-69L
Dec 2 2009 AB:PS
REVISER JAN 7 2010

The
Stravinsky
SEMI SERIES

Elevation A - 2,090 sq.ft.
Elevation B - 2,105 sq.ft.
Elevation C - 2,160 sq.ft.
Elevation D - 2,105 sq.ft.

Revised
New wall
to be centered
on long
wall

SMOOTH CEILING

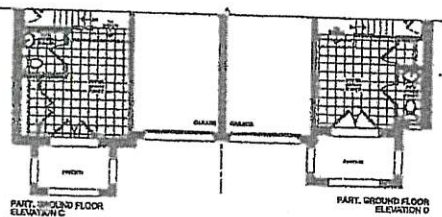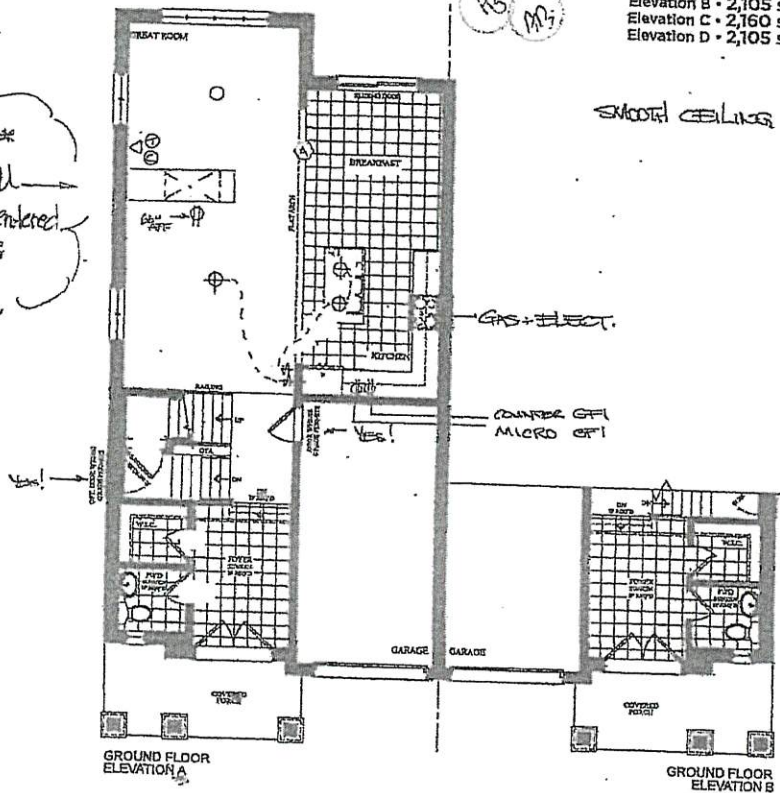

VENDOR
PURCHASER
PURCHASER

GOLDPARK
WORTH MORE

Prices, figures, illustrations, sizes, features and finishes are subject to change without notice. Areas and dimensions are approximate and actual usable floor space may vary from the stated area. Layout may be reverse of the unit purchased. E. & D.E.

encore
BRAMPTON



SCHEDULE 'F'

The
Stravinsky
SEMI SERIES

→ Elevation A • 2,090 sq.ft.
Elevation B • 2,105 sq.ft.
Elevation C • 2,160 sq.ft.
Elevation D • 2,105 sq.ft.

BE2-60L
DEC 20 2009

JAN 7 2010

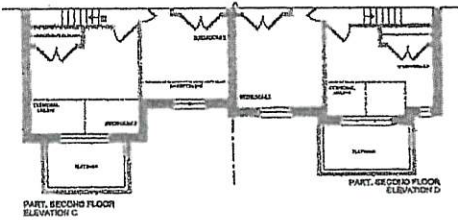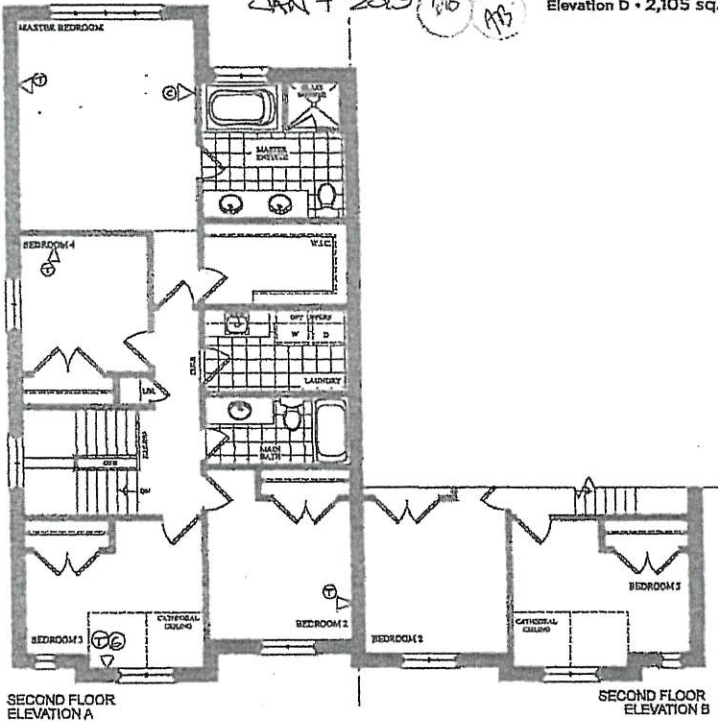

VENDOR _____
PURCHASER _____
PURCHASER _____

GOLDPARK
WORTH MORE™

Prices, figures, illustrations, sizes, features and finishes are subject to change without notice. Areas and dimensions are approximate and actual usable floor space may vary from the stated area. Layout may be reverse of the unit purchased. E.A.O.E.

1002-601 PB
 DEC. 20 2009 PB
 *REVISIONS
 JAN 7. 2010
 (A) (B)

