

CONSTRUCTION SUMMARY

Brampton Encore - 94 - 2 - 38-6 Elev.A SCARLATTI OPT- GFA1 CENTRAL VAC AND WIRING

Inv. 1,993	1 - GREAT ROOM: CONDUIT PIPE- FOR TELEVISION- LOCATE APPROX. 66" A.F.F. ABOVE FIREPLACE, TERMINATING BY CABLE OUTLET - SEE PLAN FOR LOCATION
Line 28270	Note:
22May19 / 10Sep19	

CERAMIC

Inv. 2,084	1 - KITCHEN BACKSPLASH: UPGRADE 1 - 4X16" LAID HORIZONTAL STACKED.	
Line30539	Note: PRICE INCLUDES BEHIND HOOD FAN TO CEILING	
1Oct19 / 3Feb20		

ELECTRICAL

	ELECTRICAL
Inv. 1,993	1 - GREAT ROOM: 110V WALL RECEPTACLE ON DEDICATED CIRCUIT- LOCATE ABOVE FIREPLACE APPROX. 66" A.F.F.
Line 28271	Note:
22May19 / 10Sep19	
Inv. 1,993	1 - KITCHEN: RELOCATE STANDARD FIXTURE - TO APPROX. CENTER ABOVE ISLAND
Line 28272	Note:
22May19 / 10Sep19	
Inv. 1,993	6 - KITCHEN: 4" LED POTLIGHT (PRICE 10-)
Line 28273	Note:
22May19 / 10Sep19	
Inv. 1,993	1 - KITCHEN: SINGLE POLE SWITCH
Line 28274	Note: FOR POTLIGHTS
22May19 / 10Sep19	
Inv. 1,993	1 - 220V WALL RECEPTICAL ON DEDICATED CIRCUIT- FOR 4 WIRE BUILT-IN WALL OVEN - MUST SPECIFY LOCATION
Line 28275	Note:
22May19 / 10Sep19	
Inv. 2,084	1 - KITCHEN: 36" CHIMNEY-STYLE HOOD FAN - CYCLONE #SCB50136
Line30537	Note:
1Oct19 / 3Feb20	

FORMING

Inv. 1,993	1 - SIDE DOOR- HOME TO EXTERIOR- AS PER PLAN AND GRADE PERMITTING
Line 28258	Note:
22May19 / 10Sep19	

FRAMING

Inv. 1,993	1 - MAIN FLOOR: *note* FRAME MAIN FLOOR DOORS AT 96" - ADDED WITH THE ADDITION OF TALLER INTERIOR DOORS
Line 28264	Note:
22May19 / 10Sep19	
Inv.1,993	1 - MAIN FLOOR: *note* FRAME MAIN FLOOR ARCHES AT 96" -
Line 28265	Note:
22May19 / 10Sep19	
Inv. 1,993	1 - MANDOOR - GARAGE TO HOUSE- AS PER PLAN AND GRADE PERMITING
Line 28266	Note:
22May19 / 10Sep19	

nSummary.rpt 05jul16 Printed and Sent: 03-Feb-20



CONSTRUCTION SUMMARY

Brampton Encore - 94 - 2 - 38-6 Elev.A SCARLATTI OPT- GFA1

Inv.1,993	1 - 2ND FLOOR: SMOOTH CEILINGS - (2-Story Design) 2ND FLOOR
Line 28267	Note:
22May19 / 10Sep19	

GRANITE MARBLE QUARTZ

Inv. 2,084	1 - KITCHEN: FLUSH BREAKFAST BAR
Line30538	Note:
1Oct19 / 3Feb20	

HARDWOOD

Inv. 2,084	1 - UPPER HALL: UPGRADE TO 'STANDARD LEVEL' HARDWOOD ON UPPER HALL	
Line30540	Note: VINTAGE RED OAK SMOOTH 3/4X4-3/8"	
1Oct19 / 3Feb20		

HVAC

Inv. 1,993	1 - KITCHEN: GAS LINE ROUGH - 2ND FLOOR- (3-STOREY MODELS) INCLUDES 110v FOR STOVE
Line 28261	Note:
22May19 / 10Sep19	
Inv. 1,993	1 - A/C UNIT - 4.0 TON
Line 28268	Note:
22May19 / 10Sep19	

INTERIOR TRIM AND DOORS

Inv. 1,993	3 - MAIN FLOOR: EXTENDED HEIGHT ARCHWAY (PRICE PER DOORWAY) -96"
Line 28262	Note:
22May19 / 10Sep19	¥
Inv. 1,993	4 - MAIN FLOOR: STANDARD DOOR EXTENDED HEIGHT 96" (PRICE PER DOOR) MAIN FLOOR 3 STOREY MODELS - INCLUDE FRAMING NOTE
Line 28263	Note:
22May19 / 10Sep19	

KITCHEN AND BATH CABINETRY

Inv. 2,084	1 - KITCHEN: ADJUST KITCHEN TO ACCOMMODATE 36" COOKTOP AND HOOD FAN.
Line30534	Note:
1Oct19 / 3Feb20	
Inv. 2,084	1 - KITCHEN: DOUBLE APPLIANCE CABINET FOR BUILT-IN OVENS AND COOKTOP (WITH DOORS BELOW)
Line30535	Note:
1Oct19 / 3Feb20	
Inv. 2,084	1 - KITCHEN: DELETE UPPERS, FINISH SIDES OF CABINETS. LEAVE APPROX. 42" SPACE FOR 36" CHIMNEY-STYLE HOOD FAN.
Line30536	Note:
1Oct19 / 3Feb20	

MISC.

Inv.2,084	1 - Purchaser has attended an appointment at the Decor Centre & has DECLINED any additional upgrades and accepts and acknowledges that there will be no further changes/additions/deletions to be made upon signing on January 14, 2020.
Line30541	Note: A minimum \$500 fee to re-open file will apply.
1Oct19 / 3Feb20	

nSummary.rpt 05jul16 Printed and Sent: 03-Feb-20



CONSTRUCTION SUMMARY

Brampton Encore - 94 - 2 - 38-6 Elev.A SCARLATTI OPT- GFA1

Inv. 2,084	1 - BONUS PACKAGE: \$10,000.00 (INCLUDING TAXES) WORTH OF UPGRADES FROM GOLD
	PARK HOMES DÉCOR CENTRE IS BEING APPLIED TOWARD THIS ORDER. PURCHASER HAS
	A REMAINING AMOUNT OF \$00 (INCLUDING TAXES).
Line30542	Note:
1Oct19 / 3Feb20	

PLUMBING

Inv. 1,993	1 - ROUGH-IN - 3PC BASEMENT ROUGH-IN
Line 28259	Note:
22May19 / 10Sep19	
Inv. 1,993	1 - MASTER ENSUITE: UPGRADE TO FREE STANDING TUB - MIROLIN 'BROOK'
Line 28269	Note:
22May19 / 10Sep19	

WINDOWS - BASEMENT

Inv.1,993	4 - BASEMENT WINDOWS - UPGRADE EXISTING BASEMENT WINDOW TO 30 INCH X 24
	INCH - MAY REQUIRE INSTALLATION OF WINDOW WELL
Line 28260	Note:
22May19 / 10Sep19	

Page 3 of 3

Printed and Sent: 03-Feb-20

encore

The Scarlatti 38' SERIES

BEZ-94

Elevation A • 3,591 sq.ft. | Elevation B • 3,578 sq.ft.

E105 51 HAM 24430" JAN 15 2020 UNFINISHED BASEMENT -3R R/W -125! 24×304 24×30" 161 BASEMENT ELEVATION A & B UNFINISHED BASEMENT

Prices, figures, illustrations, sizes, features and finishes are subject to change without notice E.B.O.E. Areas and dimensions are approximate and actual usable floor space may vary from the stated area. Layout may be reverse of the unit ourchased, E. & O.E.

OPT. BASEMENT ELEVATION A & B





The Scarlatti 38' SERIES


BEZ-94 810S EI YAM

_|

_

Elevation A • 3,591 sq.ft. | Elevation B • 3,578 sq.ft.

JAN 15 2020 AB

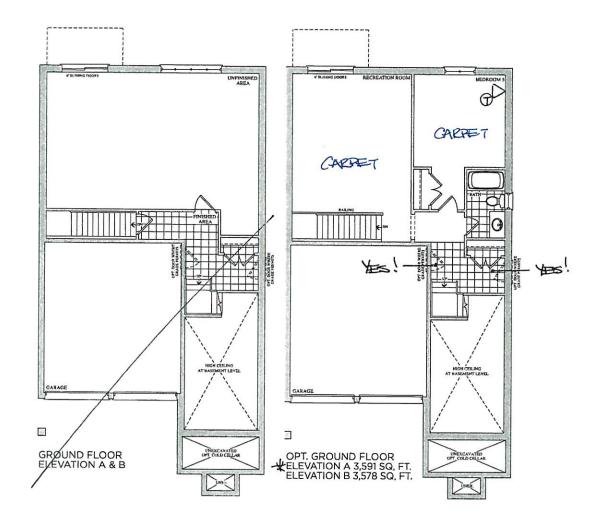



encore


BEZ-04. MAY 15 2019.

A PHONE

40 CARSLE

The Scarlatti
38' SERIES

Elevation A • 3,591 sq.ft.

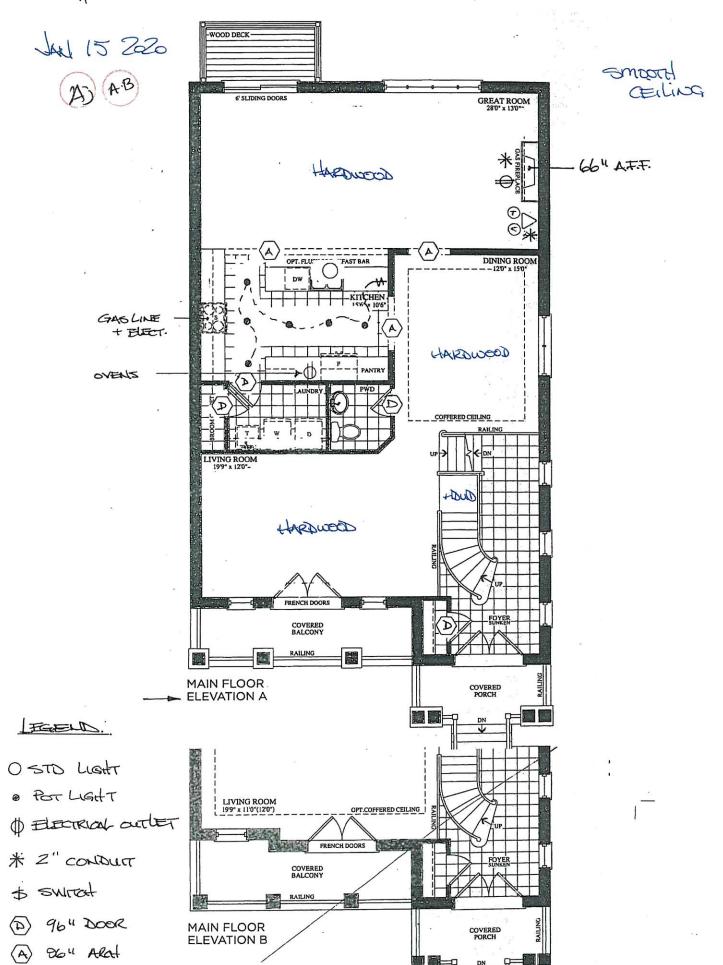





The Scarlatti 38' SERIES

15 209 May 15 209 Elevation A • 3,591 sq.ft. | Elevation B • 3,578 sq.ft.

 JAN 10 2020

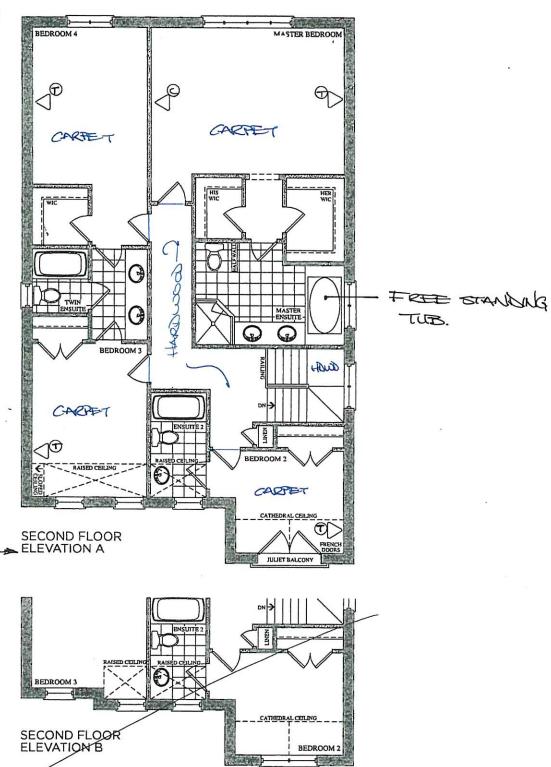






CORTINA

70 Regina Road, Woodbridge, Ontario L4L 8L6 Tel: 905-264-6464 Fax: 905-264-0664

JAN 15 2020 AJAS


QUOTATION

Date: 06/23/16

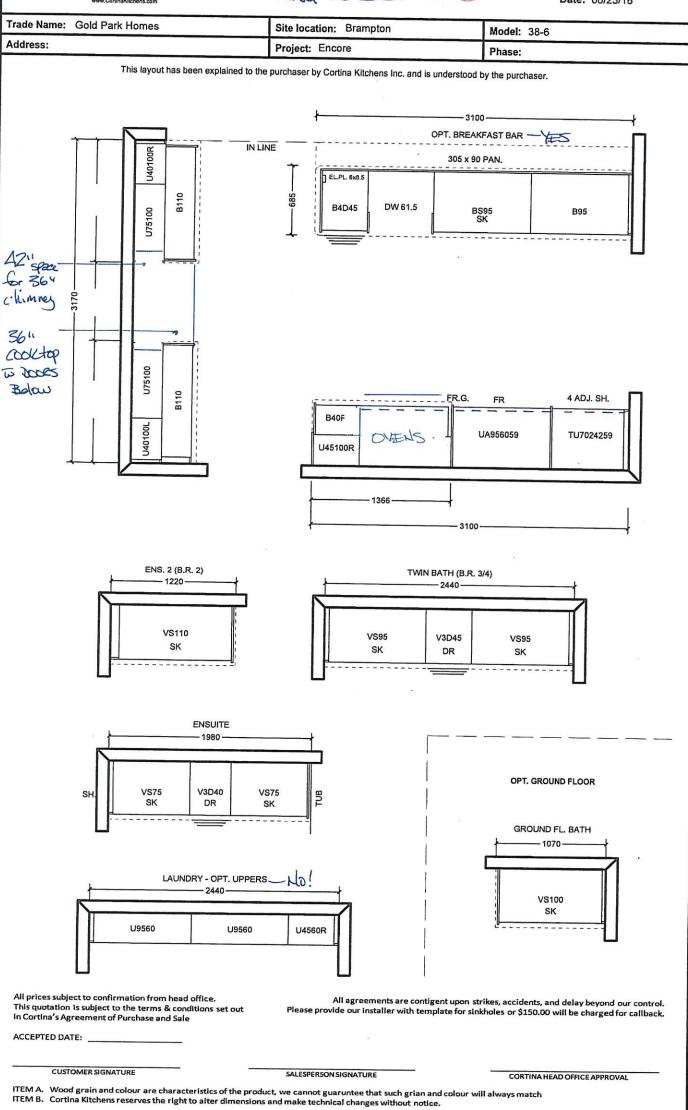

Product Dimensions

27" (68.6 cm) and 30" (76.2 cm) Ovens

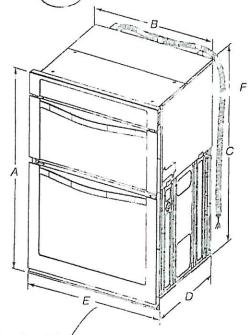

27" (68.6 cm) models

27" (68.6 cm) models

A. 42%" (108.0 cm) overall height
B. 25%" (64.6 cm) recessed width
C. 41" (104.1 cm) recessed height
D. 23%" (59.1 cm) max. recessed
depth
E. 27" (68.6 cm) overall width
F. 48" (121.9 cm) Flexible conduit
length measured from the
conduit clamp located at the
rear, of the oven. Do not remove
the conduit clamp.

30" (76.2 cm) models


A. 42% (108.0 cm) overall height

B. 28 1/3" (72.3 cm) recessed width

C. 41" (104.1 cm) recessed height D. 23 ¼" (59.1 cm) max. recessed depth

E. 30" (76.2 cm) overall width F. 48" (121.9 cm) Flexible conduit longth measured from the conduit clamp located at the rear of the oven. Do not remove the conduit clamp. Cabinet Dimensions

27" (68.6 cm) and 30" (76.2 cm) Ovens

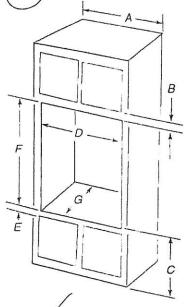

27" (68.6 cm) models

A. 27" (68.6 cm) min. cabinet width

width
B. 1" (2.5 cm) top of cutout to bottom of upper cabinet door
C. 19!4" (48.9 cm) bottom of cutout to floor is recommended.
4"-19'4" (10.2-48.9 cm) bottom of cutout to floor is acceptable.
D. 25'5" (64.8 cm) cutout width
E. 1'5" (3'.8 cm) min. bottom of

E. 1 !!" (3.8 cm) min. bottom of cutout to top of cabinet door

F. 41 /16" (105 cm)* recommended cutout height G.24" (60.7 cm) cutout depth

30" (76.2 cm) models

A. 30" (76.2 cm) min. cabinet width

B. 1" (2.5 cm) top of cutout to bottom of upper cabinet door

C. 19¼" (48.9 cm) bottom of cutout to floor is recommended. 4"-19 ¼" (10.2-48.9 cm) bottom of cutout to floor is acceptable.

D. 281/3" (72.4 cm) cutout width

E 112" (3.8 cm) min. bottom of cutout to top of cabinet door

F. 41 Yıs" (105 cm)* recommended cutout height

G. 24" (60.7 cm) cutout depth

*NOTE: The cutout height can be between 41" (104.1 cm) and 411/2" (105.6 cm) for microwave/oven combination.

BEZ-94 JAN 15 2019 (6) (4.8)

frally

30" (76.2 CM) AND 36" (91.4 CM) GAS BUILT-IN COOKTOP



PRODUCT MODEL NUMBERS

KCGS350F	KCGS950E	MGC9530D	WCG75US0D
		MGC9536D	WCG97US0D
KCGS356E	KCGS956E		
KCGS550E	MGC7430D	WCG51US0D	WCG97US6D
KEGS556E	MGC7536D	WCG51US6D	

GAS SUPPLY REQUIREMENTS

Type of Gas

Natural Gas:

• This cooking is factory set for use with Natural gas. If converting to LP gas, see the "LP Gas Conversion" instructions provided in the package containing literature. The model/serial rating plate located on the underside of the cooking base has information on the types of gas that can be used. If the types of gas listed do not include the type of gas available, check with the local gas supplier.

LP Gas Conversion:

Conversion most be done by a qualified service technician.

No attempt shall be made to convert the cooktop from the gas specified on the model/serial rating plate for use with a different gas without consulting the serving gas supplier. See the Gas Conversion instructions provided in the package containing literature.

Gas Supply Line

• Provide a gas supply line of %* (1.9 cm) rigid pipe to the cookiep location. A smaller size pipe on longer runs may result in insuff cient gas supply. Pipe-joint compounds that resist the action of LP gas must be used. Do not use TEFLON** tape. With LP gas, piping or tubing size should be ½* minimum. Usually, LP gas suppliers determine the size and materials used in the system.


Plenible metal appliance connector.

If local codes permit, use a ½" or ¾" LD, flexible stainless steel tubing gas connector, designed by CSA to connect the cooktop to the rigid gas supply line.



- A ½" male pipe thread is needed for connection to the female pipe threads of the inlet to the cooktop pressure regulator.
 Do not kink or damage the flexible metal tubing when moving the cooktop.

• Must include a shutoff valve:
The supply line must be equipped with a manual shutoff valve. This valve should be located in the same room but external to the cooktop opening, such as an adjacent cabinet. It must be accessible without removing the cooktop, and it should be in a location that allows ease of opening and closing. Do not block access to shutoff valve. The valve is for turning on or shutting off gas to the cooktop.

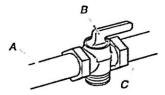

A. Gas supply line B. Shutoff valve "open" position

TEFLON is a registered trademark of E.I. Du Pont De Nemours and Company.


C. To cooktop

ELECTRICAL REQUIREMENTS

- A 120 volt, 60 Hz, AC only, 15-amp, fused electrical circuit is required. A time-delay fuse or circuit breaker is also recommended. It is recommended mat a separate circuit serving only this cocktop be provided.
 Electronic ignition systems operate within wide voltage limits, but proper grounding and polarity are necessary. Check that the outlet provides 120-volt power and is correctly grounded.


Page 1 of 4

Ref. W10597144B 8/10/15

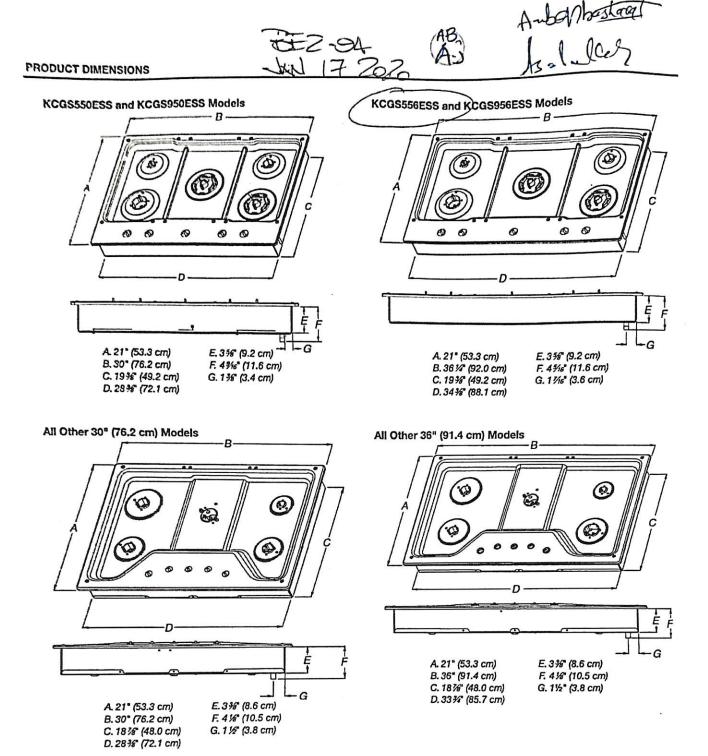



Back Wall

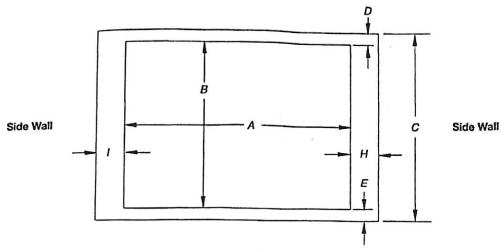

Countertop Front Edge

		Cutout (Product	Opening) Dimens	ions		
		30" (76.	2 cm) Models			
Models	A		В			
	Min	Recommended	Max	Min	Recommended	Max
KCGS550 and KCGS950 All Other 30" (76.2 cm) Models	28½" (72.4 cm) 28½" (72.4 cm)	28%" (73.4 cm) 28%" (73.4 cm)	29 1/16" (74.3 cm) 29 1/16" (74.3 cm)	19½" (49.5 cm) 19" (48.3 cm)	19 13/16" (50.2 cm) 19 1/2" (49.5 cm)	20" (50.8 cm) 20" (50.8 cm)
		36" (91)	4 cm)Models	L.		
KCGS556 and KCGS956 All Other 36" (91.4 cm) Models	34%* (88.4 cm) 33%* (86.0 cm)	35 1/16" (89.4 cm) 34 1/16" (87.0 cm)	35 58" (90.3 cm) 35 1/4" (89.5 cm)	19½" (49.5 cm) 19" (48.3 cm)	19 13/6" (50.2 cm) 19 1/3" (49.5 cm)	20" (50.8 cm) 20" (50.8 cm)

Side Walls (Combustible Surfaces)			
Models	H and I		
KCGS5 and KCGS9	H and I added together must be at least 48" (122.0 cm), with each side individually being at least 8" (20.3 cm).		
KCGS350, KCGS356, MGC9536, WCG97US0, WCG97US6	H and I added together must be at least 48* (122.0 cm), with each side individually being at least 12* (30.5 cm).		
All Other Models	Both have to be 8° (20.3 cm) or more.		

	Back Wall and Counter	top Front Dimensions	
Models	С	D	. E
KCGS550 and KCGS950			2¾* (6.9 cm)
All Other Models 25" (63.5 cm)		2 7/6" (7.3 cm)	31/6" (7.9 cm)


NOTES: After making the countertop cutout, some installations may require notching down the base cabinet side walls to clear the cooktop base. To avoid this modification, use a base cabinet with sidewalls wider than the cutout.

If cabinet has a drawer, a 4" (10.2 cm) depth clearance from the countertop to the top of the drawer (or other obstruction) in base cabinet is required. The drawer depth may need to be shortened to avoid interfering with the regulator.

IMPORTANT: If a built-in wall oven is to be installed below this cooktop, the grounded outlet and gas supply piping must be located in an adjacent cabinet.


This cooktop and its gas and electrical supply sources must be installed before the undercounter built-in wall oven is installed.

Page 4 of 4

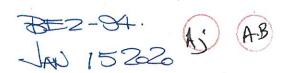





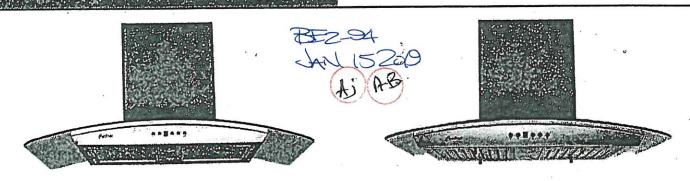

Mesh Filter

Baffle Filter

Wall Mount

A very stylish exhaustran, it is the perfect balance of substance and style. The graceful contour of the arched glass canopy coupled with the brilliant shine of the stainless steel body give an impression that is at once both modern and classic. The hood features a digital three-speed control panel, button controlled LED lights, two mesh or baffle filter screens, and a quiet, efficient motor. Fitted with time-delay "OFF" options up to nine minutes.

Specifications

Air Flow Volume: 550 CFM Electrical Connection: 120V/60Hz Electrical Consumption: 200 Watts Fan Speed: 1599 RPM Finishes: Stainless Steel

Venting: 6" Round - Top Only


Dimensions: Width: 30"/36" Height: 44 1/2"

Depth: 19 3/4"

Sones: Min. 2

Max. 6



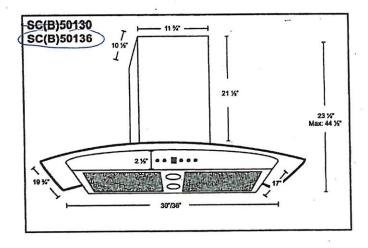

* B in the model name denotes a model with baffle filters. SCB501 - Baffle Filters SC501 - Mesh Filters

Model	Colour	Venting	Size
SC(B)50130	Stainless Steel	6 ^s	30"
SC(B)50136	Stainless Steel	6"	36"

STANDARD HARDWARE

AB JAN 15 2020 (A)














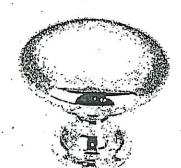

CSI-18

CSI-19









KITCHEN CSI- 20

CSI- 21

CSI-22

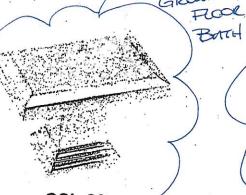



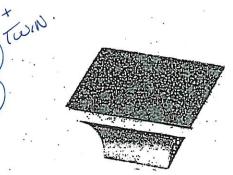

CSI-23

CSI-24

CSI-25

- IMAGES ARE FOR QUICK REFERENCE PURPOSES ONLY - ACTUAL SIZES AND FINISHES AS PER HARDWARE
- SAMPLE BOARD PROVIDED TO DECOR CENTRE



BATHROOM ACCESSORIES

PROJECT: ENCORE 2	
LOT: 94	
INSTALL STANDARD BATHROOM ACCESSORIES THRU OUT (TOWEL BAR, SOAP DISH, TISSUE HOLDER) **location as per vendor's discretion	
DO *NOT* INSTALL STANDARD BATHROOM ACCESSORIES THRU OUT (TOWEL BAR, SOAP DISH, TISSUE HOLDER)	
SIGNATURE: A Lade	
SIGNATURE: A ber bashquat	
DATE: JAN 15 2020	
DAIL. 0440 13 2020	

Rev.5ept.24 2019

GOLDPARK WORTH MORE

INTERIOR COLOUR SCHEME

*** NOTE: This is not an approved document. Document must be locked ***

elephone Res. / Bus:	lah Hanjrah & Amber Bashara Somerville M	t Property: 94 Project: Brampton Encore - Ph odel and Elevation: 38-6 Elev.A SCARLAT	
ayout Changes: O Yes N			
I. Cabinetry	tyle and Colour	Counter	Hardware
F	iena oak 'Slate'	Granite: Grigio Sardo	cs1-23
	/a	n/a	n/a
	/a	n/a	n/a
	iena oak 'Slate'	P-Lam #6698-46	
Master Ensuite	oleria dak Siale	P-Lam #0098-46	cs1-23
Bathroom	iena oak 'Greystone'	P-Lam #4925k-07	cs1-24
Second Ensuite Bathroom (If Applicable)	iena oak 'Greystone'	P-Lam #4925k-07	cs1-24
Twin Bath S	iena oak 'Greystone'	P-Lam #4925k-07	cs1-24
. Floor Tile	Selection		
Entrance Vestibule	13x13" Costa 'White'		
Main Hall			
Kitchen / Breakfast	13x13" Costa 'White'		
Laundry Room	13x13" Costa 'White'		
Powder Room 13x13" Costa 'White'			
Ground Bathroom	13x13" Costa 'White'		
Master Ensuite Bathroom	13x13" Serpentine 'Beyaz-white	e'	
Second Ensuite Bathroom (If Applicable)	13x13" Serpentine 'Beyaz-white	e'	
Lower Landing (If Applicable)	13x13" Costa 'White'		
Twin Bath	13x13" Serpentine 'Beyaz-white	e'	
Comment			
. Wall Tile			
	Selection	Listello/Inserts Describe	
Ground Floor	8x10" Weave 'Tender Grey'	O Yes No	
Master Ensuite Bathroom Tub Deck	n/a	○ Yes ● No	1
	8x10" Weave 'White'	Yes No	
		○ Yes ● No	
Bathroom Walls			
Second Ensuite	8x10" Weave 'White'	○ Yes ● No	
Second Ensuite Bathroom (If Applicable)	8x10" Weave 'White'	○ Yes ● No □	

INTERIOR COLOUR SCHEME GOLDPARK *** NOTE: This is not an approved document. Document must be locked *** **Scheduled Closing Date:** Purchasers: Asad Ullah Hanjrah & Amber Basharat Property: 94 Telephone Res. / Bus: Project: Brampton Encore - Phase 2 Decor Advisor: Yolande Somerville Model and Elevation: 38-6 Elev.A SCARLATTI OPT- GFA1 4. Plumbing Fixtures Second Ensuite **Powder Room** Other Room - Specify Master Ensuite Bathroom Other Washroom Comment Standard except M.Ens tub 5. Hardwood Flooring Type and Stain Type and Stain Main Hall STD red oak 'Natural' 3/4x4-3/8" **Upper Landing** STD red oak 'Natural' 3/4x4-3/8 Kitchen / Breakfast Upper Hall *red oak 'Natural' 3/4x4-3/8 Master Bedroom Living Room STD red oak 'Natural' 3/4x4-3/8 Bedroom #2 **Dining Room** STD red oak 'Natural' 3/4x4-3/8 STD red oak 'Natural' 3/4x4-3/8 Bedroom #3 Family Room Den/Library Bedroom #4 **Entrance Vestibule** Bedroom #5 Lower Landing Other Room - Specify STD red oak 'Natural' 3/4x4-3/8 (If Applicable) Comment 6. Carpeting Upgrade Description **Ground Floor** Std 'Winter Grey' with std u/pad Second Floor Std 'Winter Grey' with std u/pad Type Upgrade Underpad Capped Runner - *Upgrade Carpet on Stairs Comment 7. Fireplace Living Room Family Room Other Room - Specify Purchased Purchased As Per Plan As Per Plan N/A Purchased As Per Plan N/A 0 Standard Gas Fireplace Type NF-20 Mantle Type Colour / Stain White Surround Nero Marquina Hearth none

Comment

INTERIOR COLOUR SCHEME GOLDPARK *** NOTE: This is not an approved document. Document must be locked *** **Scheduled Closing Date:** Purchasers: Asad Ullah Hanjrah & Amber Basharat Property: 94 Telephone Res. / Bus: Project: Brampton Encore - Phase 2 Model and Elevation: 38-6 Elev.A SCARLATTI OPT- GFA1 Decor Advisor: Yolande Somerville 8. Trim Carpentry Interior Doors *Standard Front Door Glass Inserts Standard Door Handles Standard Interior Trim Standard Comment 9. Plaster Mouldings and Medallions Standard Throughout O Yes O No N/A Kitchen/Breakfast **Entrance Vestibule** Main Hall Den/Library **Lower Landing** Living Room Other Room - Specify **Dining Room** Family Room Comment 10. Railings and Spindles Railing Package Standard Oak Spindle Colour Natural Railing Colour Natural Stringer / Riser Natural Treads Natural Oak Stairs O N/A Yes O No Comment

1. Wall Paint / Ceilings	
Throughout Finished Areas	Warm Grey
Trim Paint White	
Smooth Ceilings	
Ground Floor	
Second Floor	
Note	Std on Main Floor
-	
Comment	



INTERIOR COLOUR SCHEME GOLDPARK *** NOTE: This is not an approved document. Document must be locked *** Scheduled Closing Date: Property: 94 Asad Ullah Hanjrah & Amber Basharat Purchasers: Project: Brampton Encore - Phase 2 Telephone Res. / Bus: Model and Elevation: 38-6 Elev.A SCARLATTI OPT- GFA1 Decor Advisor: Yolande Somerville 12. Electrical-Hood Fan White Stainless \(\cap \) N/A Above Kitchen Cabinet Light O Yes No Below Kitchen Cabinet Light () Yes () No **Standard Appliances** Over The Range Microwave Chimney Style Fan Comment Wall ovens + Cooktop 13. Heating and Air Conditioning Air Conditioning **Gas Provisions Stove** YES No **Gas Provisions Dryer** No Gas Provisions Barbecue STD Comment 14. Additional Comments -15. Disclaimers and Notes 1) Colours of all materials are as close as possible to builder's selection, but not necessarily identical due to variances in manufacturing. 2) Any extras listed above are null and void unless accompanied by a separate invoice/amendment. Said invoice must be paid in full.

3) The Purchaser acknowledges that after Interior Colour Selection form is signed and dated, no further changes will be permitted other

Purchaser's Initials 4) The Purchaser acknowledges reading and accepting the "Gold Park Homes Decor Centre Disclaimers" form. This document contains

Signature:

than re-selection due to unavailability.

This Interior Colour Selection is final and approved by:

other miscellaneous disclaimers.