

Brampton Encore - 81L - 2 - 28-09 Elev A Gershwin

APPLIANCES

Inv.2,135	1 - 5 PIECE APPLIANCES - FRIDGE/RANGE/DISHWASHER - STAINLESS STEEL + WASHER/DRYER - WHITE
Line29971	Note: INCLUDED IN APS
16Dec19 / 13Feb20	

CONCRETE AND DRAIN

Inv.2,135	1 - 3PC Basement Rough-In
Line30940	Note:
16Dec19 / 13Feb20	

ELECTRICAL

Inv.2,135	1 - KITCHEN: RELOCATE STANDARD FIXTURE - TO APPROX. CENTER ABOVE ISLAND
Line29973	Note:
16Dec19 / 13Feb20	
Inv.2,135	1 - GREAT ROOM: RELOCATE STANDARD FIXTURE - SEE PLAN FOR LOCATION
Line29974	Note:
16Dec19 / 13Feb20	
Inv.2,135	1 - RELOCATE STANDARD FIXTURE - MUST PROVIDE LOCATION
Line29975	Note:
16Dec19 / 13Feb20	
Inv.2,135	1 - GREAT ROOM: IN ADDITION TO STANDARD CEILING LIGHT, ADD A 2ND CEILING LIGHT, COMPLETE WITH OWN SWITCH
Line29976	Note: SEE PLAN FOR LOCATION
16Dec19 / 13Feb20	
Inv.2,135	1 - 200 AMP ELECTRICAL SERVICE
Line29977	Note:
16Dec19 / 13Feb20	

FORMING

Inv.2,135	1 - SIDE DOOR- HOME TO EXTERIOR- AS PER PLAN AND GRADE PERMITTING
Line29968	Note: included in aps
16Dec19 / 13Feb20	
Inv.2,135	1 - Garage Mandoor - As Per Plan And Grade Permitting
Line30937	Note:
16Dec19 / 13Feb20	

FRAMING

Inv.2,135	1 - MANDOOR - GARAGE TO HOUSE- AS PER PLAN AND GRADE PERMITTING
Line29969	Note: included in aps
16Dec19 / 13Feb20	
Inv.2,135	1 - Side Door - As Per Plan And Grade Permitting
Line30938	Note:
16Dec19 / 13Feb20	
Inv.2,135	1 - Extended Height Door and Arches on Main floor (2 Storey Model)
Line30939	Note:
16Dec19 / 13Feb20	

Brampton Encore - 81L - 2 - 28-09 Elev A Gershwin

INTERIOR TRIM AND DOORS

Inv.2,135	1 - MAIN FLOOR: EXTENDED HEIGHT ARCHWAY (PRICE PER DOORWAY) - 96"
Line29978	Note:
16Dec19 / 13Feb20	
Inv.2,135	3 - MAIN FLOOR: STANDARD DOOR EXTENDED HEIGHT 96" (PRICE PER DOOR)- GROUND FLOOR 2 STOREY MODELS - 96"
Line29979	Note:
16Dec19 / 13Feb20	
Inv.2,135	1 - Side Door and Garage Mandoor - As per plan and Grade permitting
Line30943	Note:
16Dec19 / 13Feb20	

MISC.

Inv.2,135	1 - Purchaser has attended an appointment at the Decor Centre & has DECLINED any additional upgrades and accepts and acknowledges that there will be no further changes/additions/deletions to be made upon signing on December 16, 2019.
Line29981	Note:
16Dec19 / 13Feb20	
Inv.2,135	1 - BONUS PACKAGE: \$5,000.00 (INCLUDING TAXES) WORTH OF UPGRADES FROM GOLD PARK HOMES DÉCOR CENTRE IS BEING APPLIED TOWARD THIS ORDER. PURCHASER HAS A REMAINING AMOUNT OF \$22.35 (INCLUDING TAXES) TO USE AT COLOUR APPOINTMENT.
Line29982	Note:
16Dec19 / 13Feb20	

PAINT

Inv.2,135	1 - Side Door and Garage Mandoor - As per plan and Grade permitting
Line30942	Note:
16Dec19 / 13Feb20	

PLUMBING

Inv.2,135	1 - ROUGH-IN - 3PC BASEMENT ROUGH-IN
Line29970	Note: included in aps
16Dec19 / 13Feb20	
Inv.2,135	1 - KITCHEN: ROUGH-IN - WATERLINE FOR FRIDGE
Line29980	Note:
16Dec19 / 13Feb20	

WINDOWS - BASEMENT

Inv.2,135	3 - BASEMENT WINDOWS - UPGRADE EXISTING BASEMENT WINDOW TO 30 INCH X 24 INCH - MAY REQUIRE INSTALLATION OF WINDOW WELL
Line29972	Note:
16Dec19 / 13Feb20	

WINDOWS AND DOORS

Inv.2,135	1 - Side Door and Garage Mandoor - As per plan and Grade permitting
Line30941	Note:
16Dec19 / 13Feb20	


SCHEDULE 'F'

encore  
BRAMPTON


The  
Gershwin  
SEMI SERIES

- Elevation A • 1,920 sq.ft.
- Elevation B • 1,920 sq.ft.
- Elevation C • 1,920 sq.ft.
- Elevation D • 1,920 sq.ft.

BE2-811  
Dec 16 2009

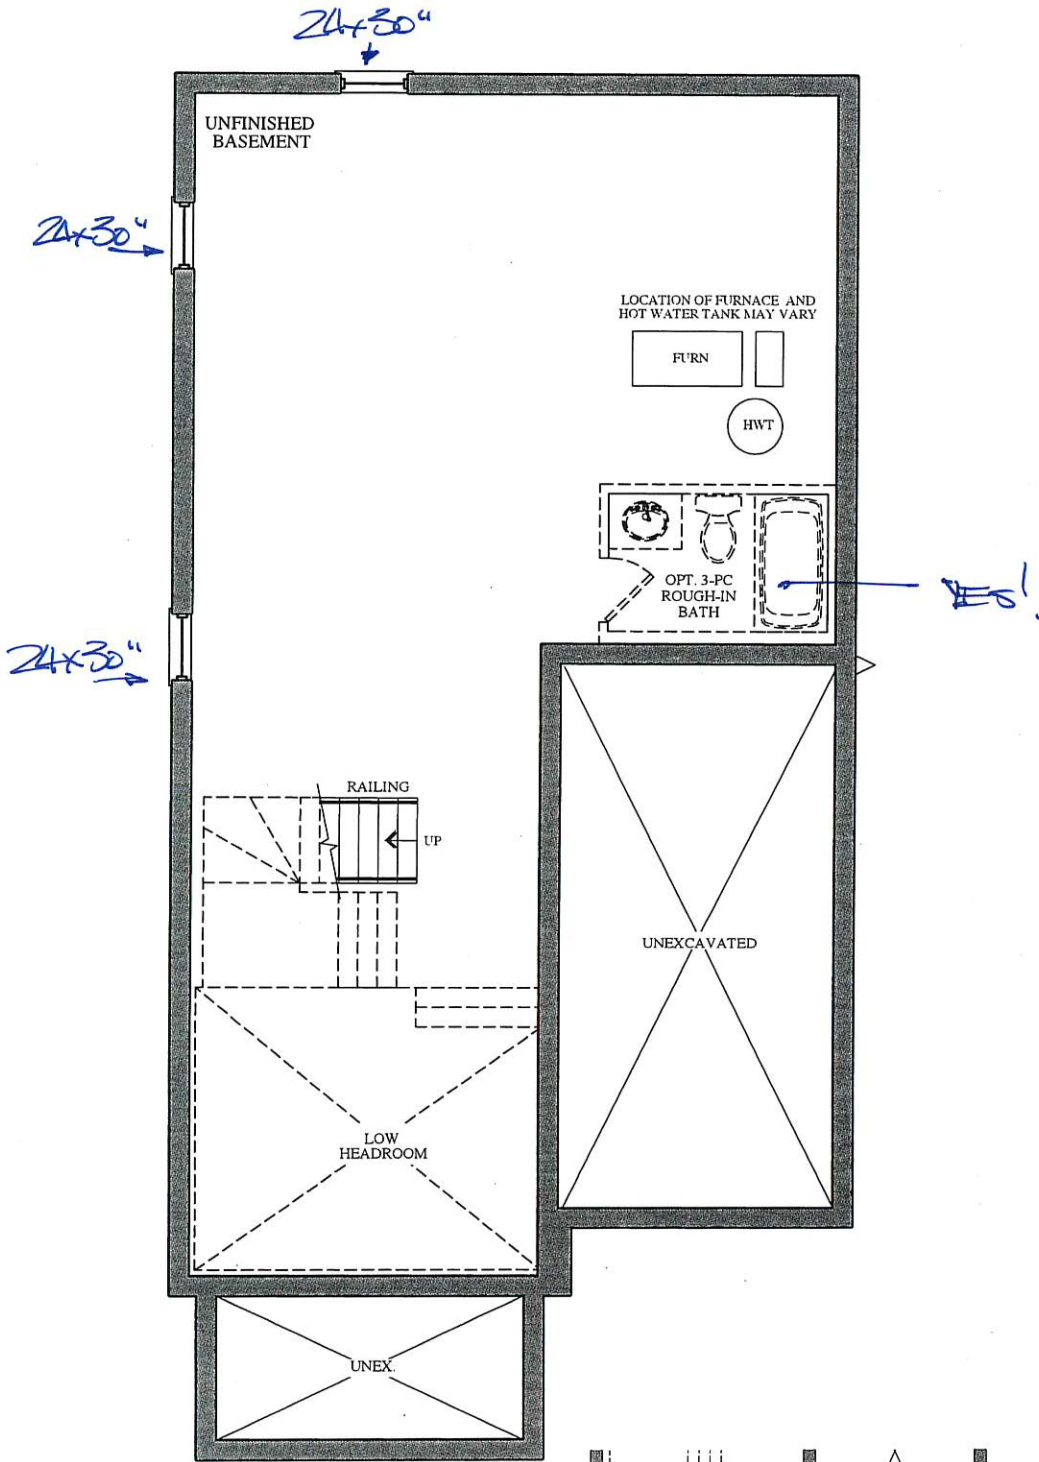

BASEMENT  
ELEVATION A & B

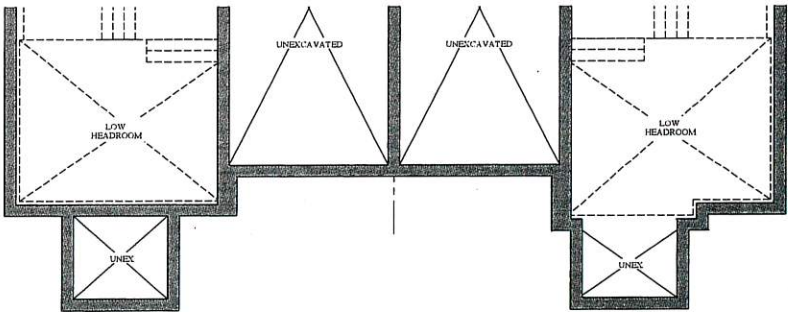

PART. BASEMENT FLOOR  
ELEVATION C

PART. BASEMENT FLOOR  
ELEVATION D

VENDOR	
PURCHASER	
PURCHASER	

GOLDPARK  
WORTH MORE™

Prices, figures, illustrations, sizes, features and finishes are subject to change without notice. Areas and dimensions are approximate and actual usable floor space may vary from the stated area. Layout may be reverse of the unit purchased. E. & O.E.




The  
Gershwin  
SEMI SERIES

Elevation A • 1,920 sq.ft.  
Elevation B • 1,920 sq.ft.  
Elevation C • 1,920 sq.ft.

BEZ-8(L)  
DEC 16 2019


APPLIANCES INCLUDED  
Smooth ceiling

FRIDGE WORKER LINE

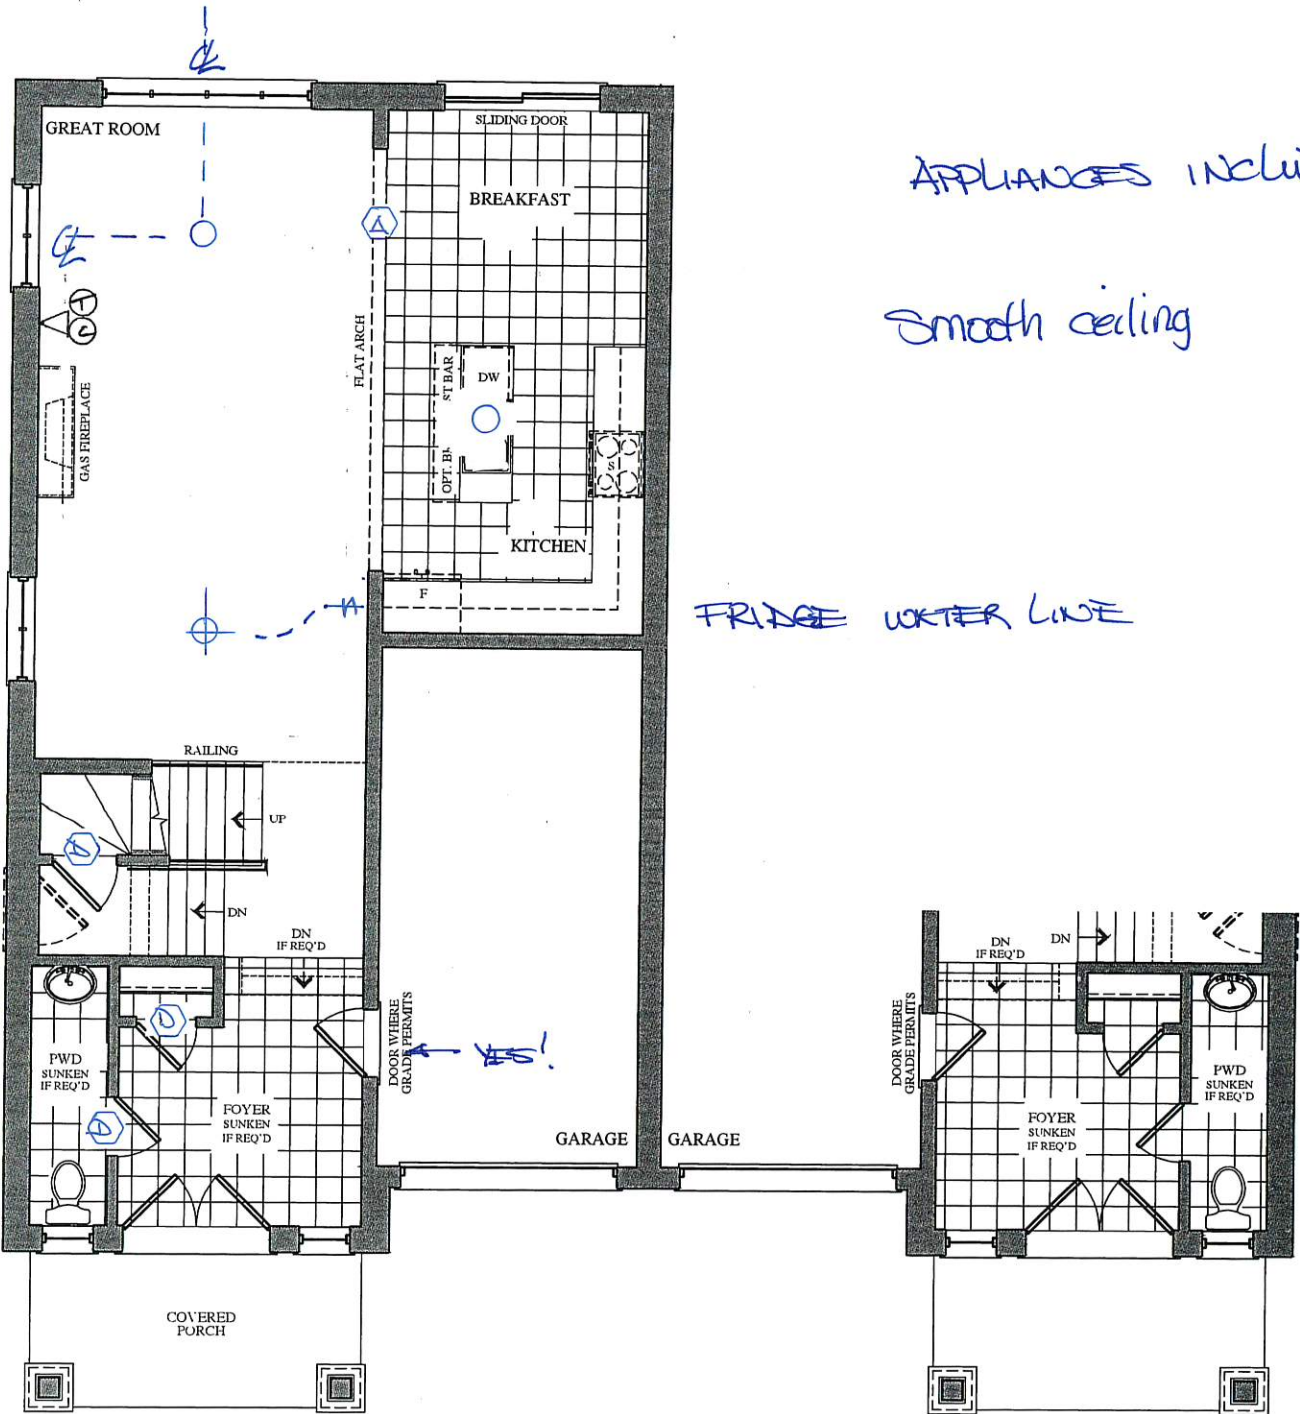

GROUND FLOOR  
ELEVATION A

GROUND FLOOR  
ELEVATION B

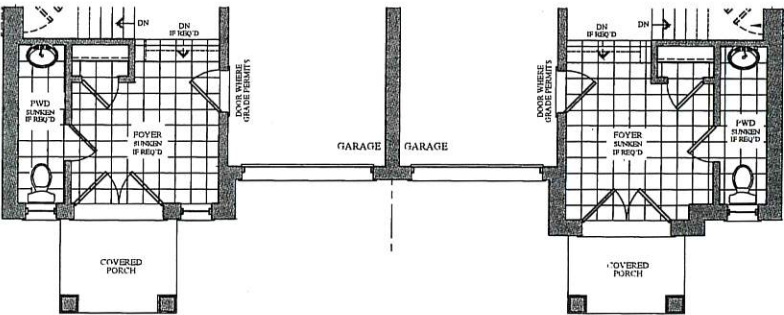

PART. GROUND FLOOR  
ELEVATION C

PART. GROUND FLOOR  
ELEVATION D

VENDOR

PURCHASER

PURCHASER

GOLDPARK  
WORTH MORE™

Prices, figures, illustrations, sizes, features and finishes are subject to change without notice. Areas and dimensions are approximate and actual usable floor space may vary from the stated area. Layout may be reverse of the unit purchased. E. & O.E.

SCHEDULE 'F'

encore  
BRAMPTON


# The Gershwin

## SEMI SERIES

BE2-8/L

Dec 16 2019.

→ Elevation A • 1,920 sq.ft.  
Elevation B • 1,920 sq.ft.  
Elevation C • 1,920 sq.ft.  
Elevation D • 1,920 sq.ft.

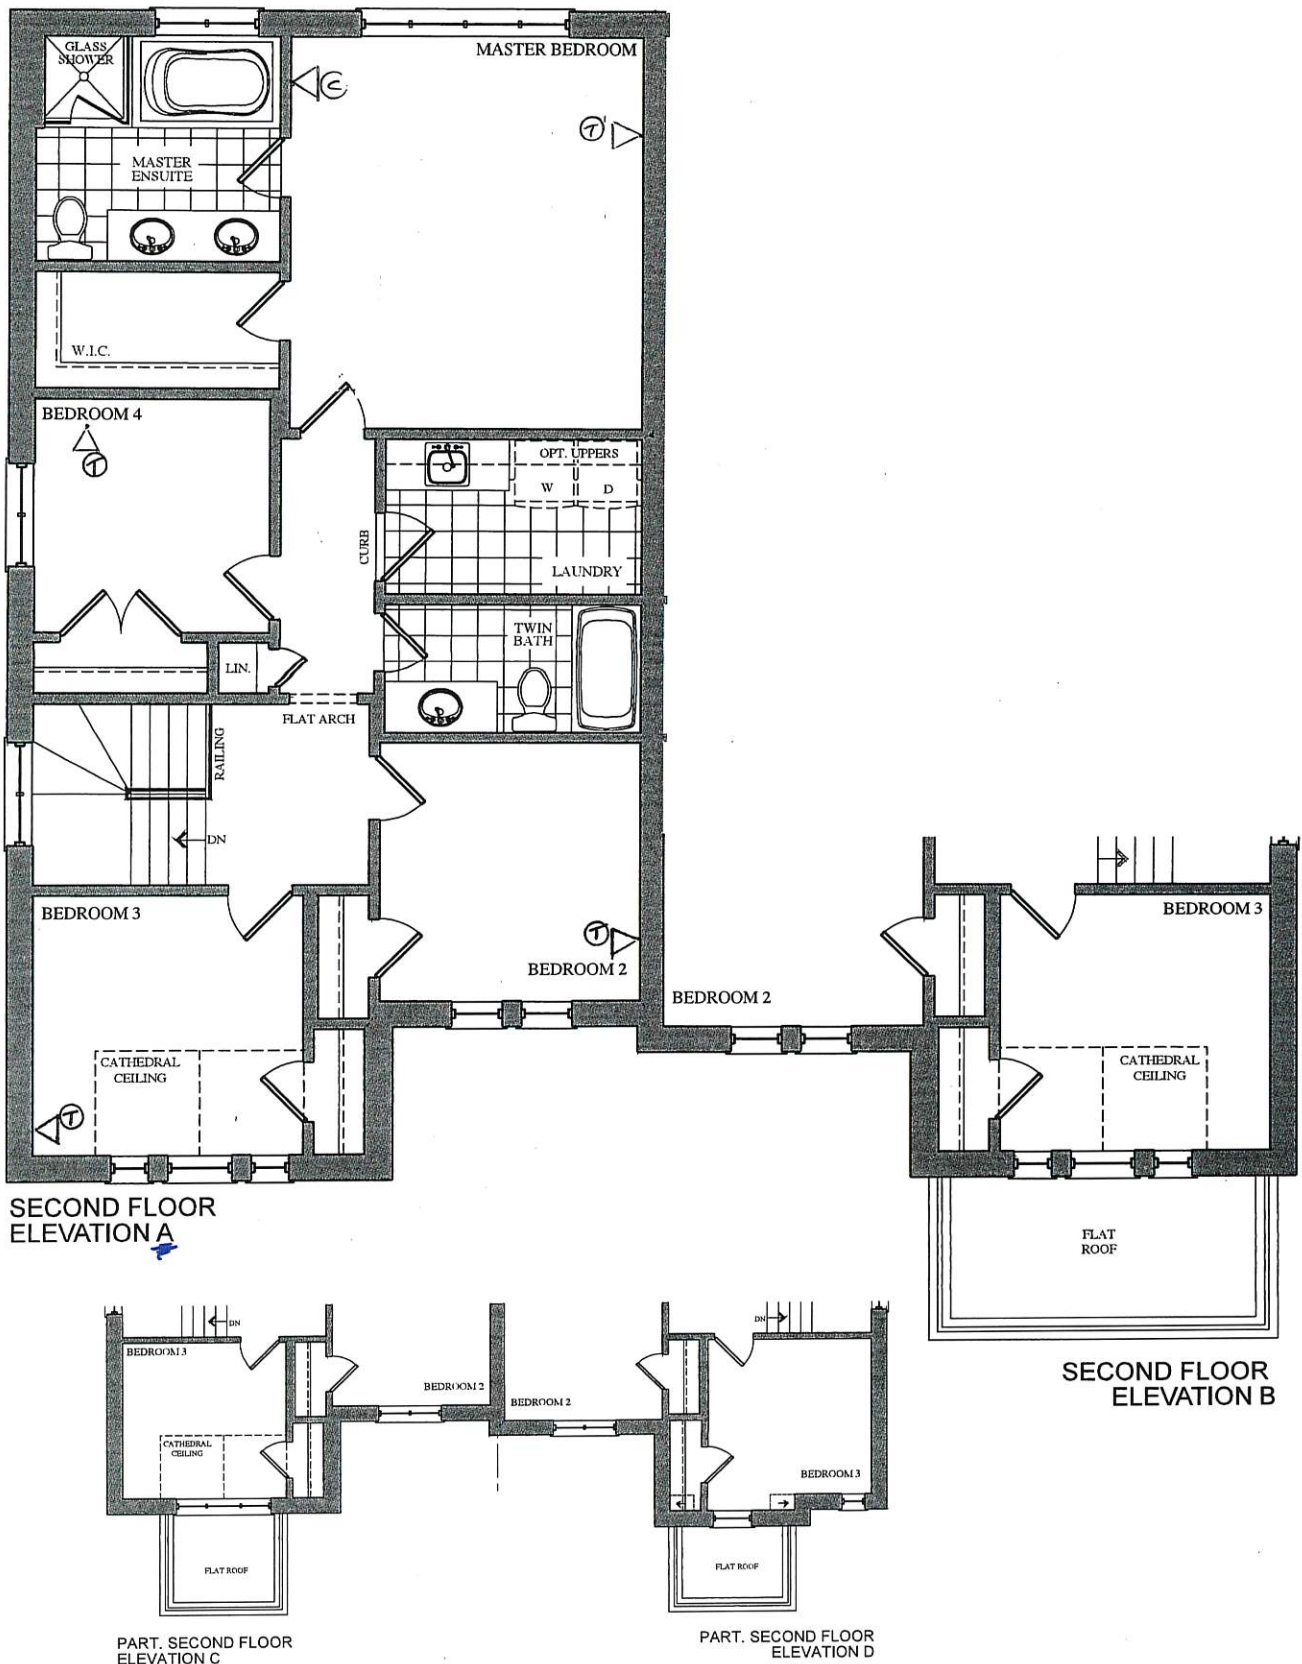

VENDOR

PURCHASER

PURCHASER

**GOLDPARK**  
WORTH MORE™

Prices, figures, illustrations, sizes, features and finishes are subject to change without notice. Areas and dimensions are approximate and actual usable floor space may vary from the stated area. Layout may be reverse of the unit purchased. E. & O.E.