


LOT NUMBER: 105
 UNIT NAME: THE BEAUMONT
 ELEVATION: A
 UNIT NUMBER: 5004

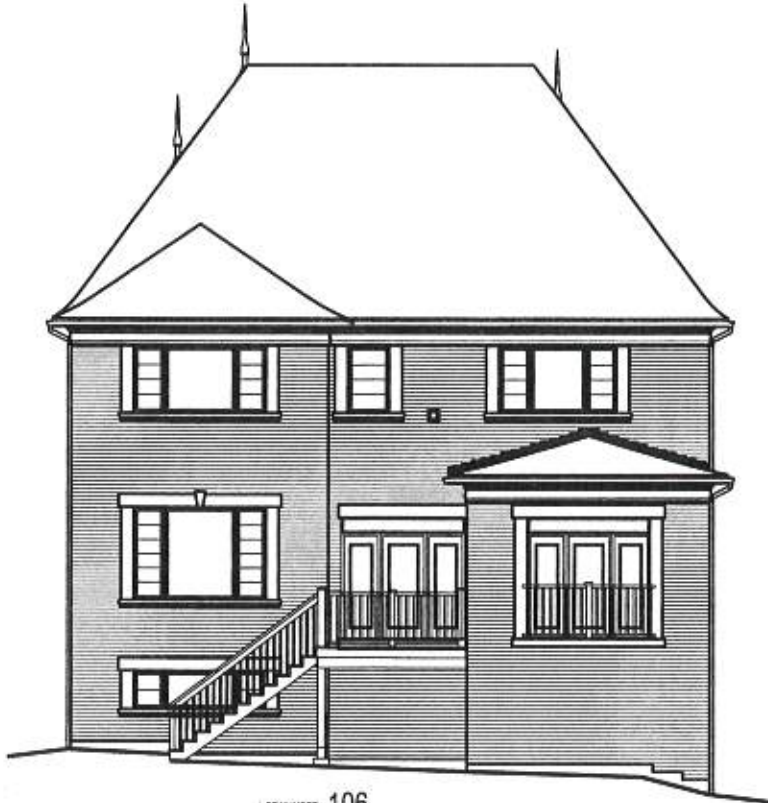

LOT NUMBER: 106
 UNIT NAME: THE KNIGHTSWOOD
 ELEVATION: B (REV)
 UNIT NUMBER: 5005

PURPLE CREEK ROAD



LOT NUMBER: 110
 UNIT NAME: THE KNIGHTSWOOD
 ELEVATION: B (REV)
 UNIT NUMBER: 5005

PURPLE CREEK ROAD

It is the builder's complete responsibility to ensure that all plans submitted for approval fully comply with the Architectural Guidelines and all applicable regulations and requirements including zoning provisions and any provisions in the subdivision agreement. The Control Architect is not responsible in any way for examining or approving site (lotting) plans or working drawings with respect to any zoning or building code or permit matter or that any house can be properly built or located on its lot.

This is to certify that these plans comply with the applicable Architectural Design Guidelines approved by the City of VAUGHAN.

WT 105 (REAR)

ARCHITECTURAL REVIEW & APPROVAL
 MAR 10 2020
 John G. Williams Limited, Architect

LEGEND:

- 1 BRICK/STONE VENEER ON SIDES OF STAIRS (POURED OR BRICK/EDGEM PRECAST)
- 2 DROP OR RAISE BANDING BY AMOUNT INDICATED
- 3 ADD BANDING AND/OR TRIM AS INDICATED
- 4 ADDED CAMBERED HEADERS
- 5 8'-0" X 8'-0" GARAGE DOORS
- 6 DROPPED OR RAISED 80PFT AS INDICATED
- 7 ADJUSTED ROOF OVERHANG AS INDICATED ON ROOF PLAN
- 8 PROVIDE GUARD PER CONSTRUCTION NOTE 11
- 9 FOYER SUNKEN AS INDICATED
- 10 LIGHT FIXTURE RELOCATED AS INDICATED

HUNT
 DESIGN ASSOCIATES INC.
 www.huntdesign.ca

GOLDPARK HOMES - 217020
 PINE VALLEY, VAUGHAN ONT.