




PURPLE CREEK ROAD

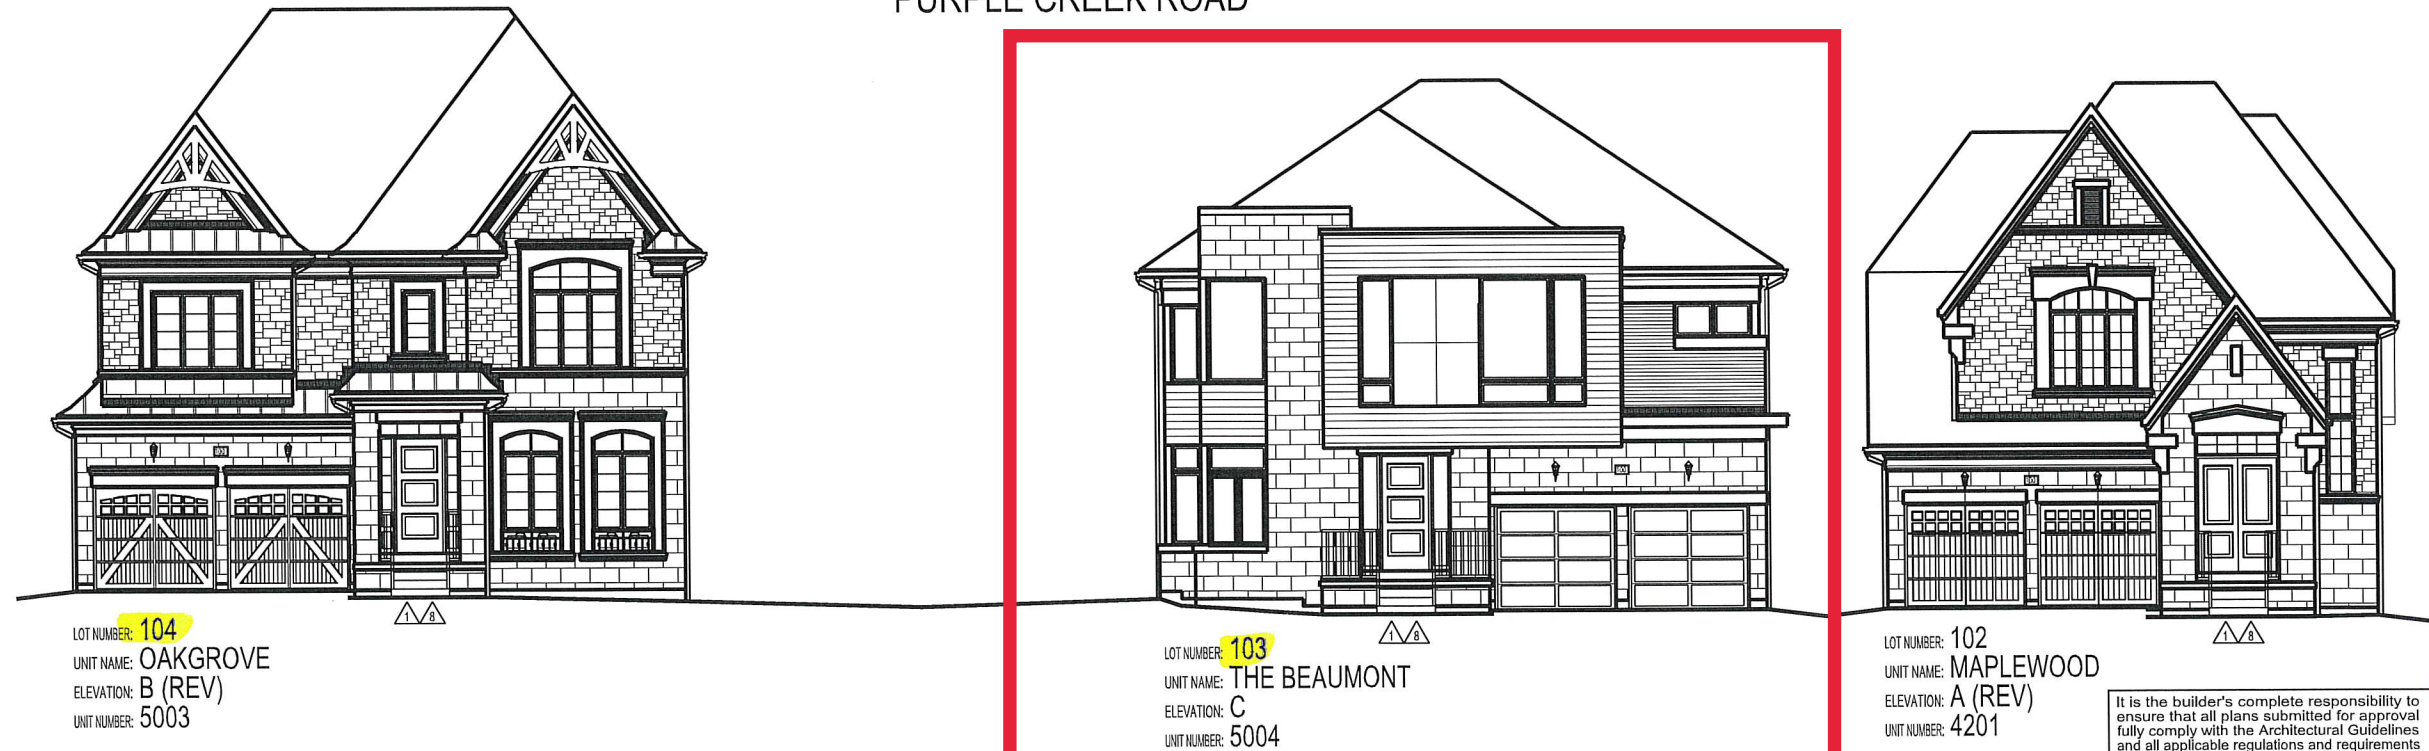

PURPLE CREEK ROAD

It is the builder's complete responsibility to ensure that all plans submitted for approval fully comply with the Architectural Guidelines and all applicable regulations and requirements including zoning provisions and any provisions in the subdivision agreement. The Control Architect is not responsible in any way for examining or approving site (lotting) plans or working drawings with respect to any zoning or building code or permit matter or that any house can be properly built or located on its lot. This is to certify that these plans comply with the applicable Architectural Design Guidelines approved by the City of VAUGHAN.

WTS 103 + 104
ARCHITECTURAL REVIEW & APPROVAL
FEB 19 2020
John G. Williams Limited, Architect

LEGEND:

- 1 BRICK/STONE VENEER ON SIDES OF STAIRS (POURED OR "BRICK LEDGE" PRECAST)
2 DROP OR RAISE BANDING BY AMOUNT INDICATED.
3 ADD BANDING AND/OR TRIM AS INDICATED.
4 ADDED CAMBERED HEADERS
5 8'-0" X 8'-0" GARAGE DOORS.
6 DROPPED OR RAISED SOFFIT AS INDICATED.
7 ADJUSTED ROOF OVERHANG AS INDICATED ON ROOF PLAN.
8 PROVIDE GUARD PER CONSTRUCTION NOTE 11.
9 FOYER SUNKEN AS INDICATED
10 LIGHT FIXTURE RELOCATED AS INDICATED.

HUNT
DESIGN ASSOCIATES INC.
www.huntdesign.ca

GOLDPARK HOMES - 217020
PINE VALLEY, VAUGHAN ONT.

8966 Woodbine Ave, Markham, ON L3R 0J7 ■ T 905.737.5133 ■ F 905.737.7326 ■ 2018/09/11 ■ OF ■

STREETSCAPES - (LOTS 98-104)

PAGE XX

217020WSS01

All drawings specifications, related documents and design are the copyright property of Hunt Design Associates (H.D.A.). Reproduction of this property in whole or in part is strictly prohibited without H.D.A.'s written permission.



LOT NUMBER: 98
UNIT NAME: THE KNIGHTSWOOD
ELEVATION: B (REV)
UNIT NUMBER: 5005

LOT NUMBER: 99
UNIT NAME: OAKGROVE
ELEVATION: B
UNIT NUMBER: 5003

LOT NUMBER: 100
UNIT NAME: FORESTCREST
ELEVATION: A (REV)
UNIT NUMBER: 4203

PURPLE CREEK ROAD



LOT NUMBER: 102
UNIT NAME: MAPLEWOOD
ELEVATION: A (REV)
UNIT NUMBER: 4201



LOT NUMBER: 103
UNIT NAME: THE BEAUMONT
ELEVATION: REAR EL. C
UNIT NUMBER: 5004

PURPLE CREEK ROAD



LOT NUMBER: 103
UNIT NAME: THE BEAUMONT
ELEVATION: SIDE EL. C
UNIT NUMBER: 5004

It is the builder's complete responsibility to ensure that all plans submitted for approval fully comply with the Architectural Guidelines and all applicable regulations and requirements including zoning provisions and any provisions in the subdivision agreement. The Control Architect is not responsible in any way for examining or approving site (lotting) plans or working drawings with respect to any zoning or building code or permit matter or that any house can be properly built or located on its lot. This is to certify that these plans comply with the applicable Architectural Design Guidelines approved by the City of VAUGHAN.

ARCHITECTURAL REVIEW & APPROVAL
FEB 19 2020
John G. Williams Limited, Architect

LEGEND:

- | | | | | |
|---|---|---|-----------------------------|--|
| 1 BRICK/STONE VENEER ON SIDES OF STAIRS (POURED OR "BRICK LEDGE" PRECAST) | 2 DROP OR RAISE BANDING BY AMOUNT INDICATED. | 3 ADD BANDING AND/OR TRIM AS INDICATED. | 4 ADDED CAMBERED HEADERS | 5 8'-0" X 8'-0" GARAGE DOORS. |
| 6 DROPPED OR RAISED SOFFIT AS INDICATED. | 7 ADJUSTED ROOF OVERHANG AS INDICATED ON ROOF PLAN. | 8 PROVIDE GUARD PER CONSTRUCTION NOTE 11. | 9 FOYER SUNKEN AS INDICATED | 10 LIGHT FIXTURE RELOCATED AS INDICATED. |

HUNT DESIGN ASSOCIATES INC.
www.hunt-design.ca

GOLDPARK HOMES - 217020
PINE VALLEY, VAUGHAN ONT.

8966 Woodbine Ave, Markham, ON L3R 0J7 ■ T 905.737.5133 ■ F 905.737.7326 ■ 2020/02/07 ■ NEA ■ 217020WSS01

STREETSCAPES - (LOTS 98-103)

PAGE XX

All drawings specifications, related documents and design are the copyright property of Hunt Design Associates (H.D.A.). Reproduction of this property in whole or in part is strictly prohibited without H.D.A.'s written permission.