

DATE: 11/01/2019 11:22 AM PROJECT: 217020 GOLDPARK HOMES 217020WSS01-SEP11 2019.DWG



LOT NUMBER: 101
UNIT NAME: THE BRIARWOOD
ELEVATION: A
UNIT NUMBER: 4000



LOT NUMBER: 100
UNIT NAME: FORESTCREST
ELEVATION: A (REV)
UNIT NUMBER: 4203



LOT NUMBER: 99
UNIT NAME: OAKGROVE
ELEVATION: B
UNIT NUMBER: 5003



LOT NUMBER: 98
UNIT NAME: THE KNIGHTSWOOD
ELEVATION: B (REV)
UNIT NUMBER: 5005



LOT NUMBER: 105
UNIT NAME: THE BEAUMONT
ELEVATION: A
UNIT NUMBER: 5004



LOT NUMBER: 104
UNIT NAME: OAKGROVE
ELEVATION: B (REV)
UNIT NUMBER: 5003



LOT NUMBER: 103
UNIT NAME: THE BEAUMONT
ELEVATION: C
UNIT NUMBER: 5004



LOT NUMBER: 102
UNIT NAME: MAPLEWOOD
ELEVATION: A (REV)
UNIT NUMBER: 4201

PURPLE CREEK ROAD

PURPLE CREEK ROAD

WTS 101, 105

It is the builder's complete responsibility to ensure that all plans submitted for approval fully comply with the Architectural Guidelines and all applicable regulations and requirements including zoning provisions and any provisions in the subdivision agreement. The Control Architect is not responsible in any way for examining or approving site (lotting) plans or working drawings with respect to any zoning or building code or permit matter or that any house can be properly built or located on its lot.

This is to certify that these plans comply with the applicable Architectural Design Guidelines approved by the City of VAUGHAN.

ARCHITECTURAL REVIEW & APPROVAL
MAR 10 2020
John G. Williams Limited, Architect

LEGEND:

- 1 BRICK/STONE VENEER ON SIDES OF STAIRS (POURED OR BRICK/LEGGED PRECAST)
- 2 DROP OR RAISE BANDING BY AMOUNT INDICATED
- 3 ADD BANDING AND/OR TRIM AS INDICATED
- 4 ADDED CAMBERED HEADERS
- 5 8'-0" X 8'-0" GARAGE DOORS
- 6 DROPPED OR RAISED SOFFIT AS INDICATED
- 7 ADJUSTED ROOF OVERHANG AS INDICATED ON ROOF PLAN
- 8 PROVIDE GUARD PER CONSTRUCTION NOTE 11
- 9 FOYER SUNKEN AS INDICATED
- 10 LIGHT FIXTURE RELOCATED AS INDICATED

HUNT
DESIGN ASSOCIATES INC.
www.hunt-design.ca

GOLDPARK HOMES - 217020

PINE VALLEY, VAUGHAN, ONT.

8966 Woodbine Ave, Markham, ON L3R 0J7 • T 905.737.5133 • F 905.737.7326

2018/09/11

OF

LOTS 98-104

PAGE XX


217020WSS01

All drawings, specifications, related documents and design are the copyright property of Hunt Design Associates (H.D.A.). Reproduction of this drawing in whole or in part is strictly prohibited without H.D.A.'s written permission.

PRINTING: MON MAR 08 12:24 PM | K:\PROJECTS\217020 GOLDPARK HOMES\STREETSCAPES\217020SS01.DWG



PURPLE CREEK ROAD

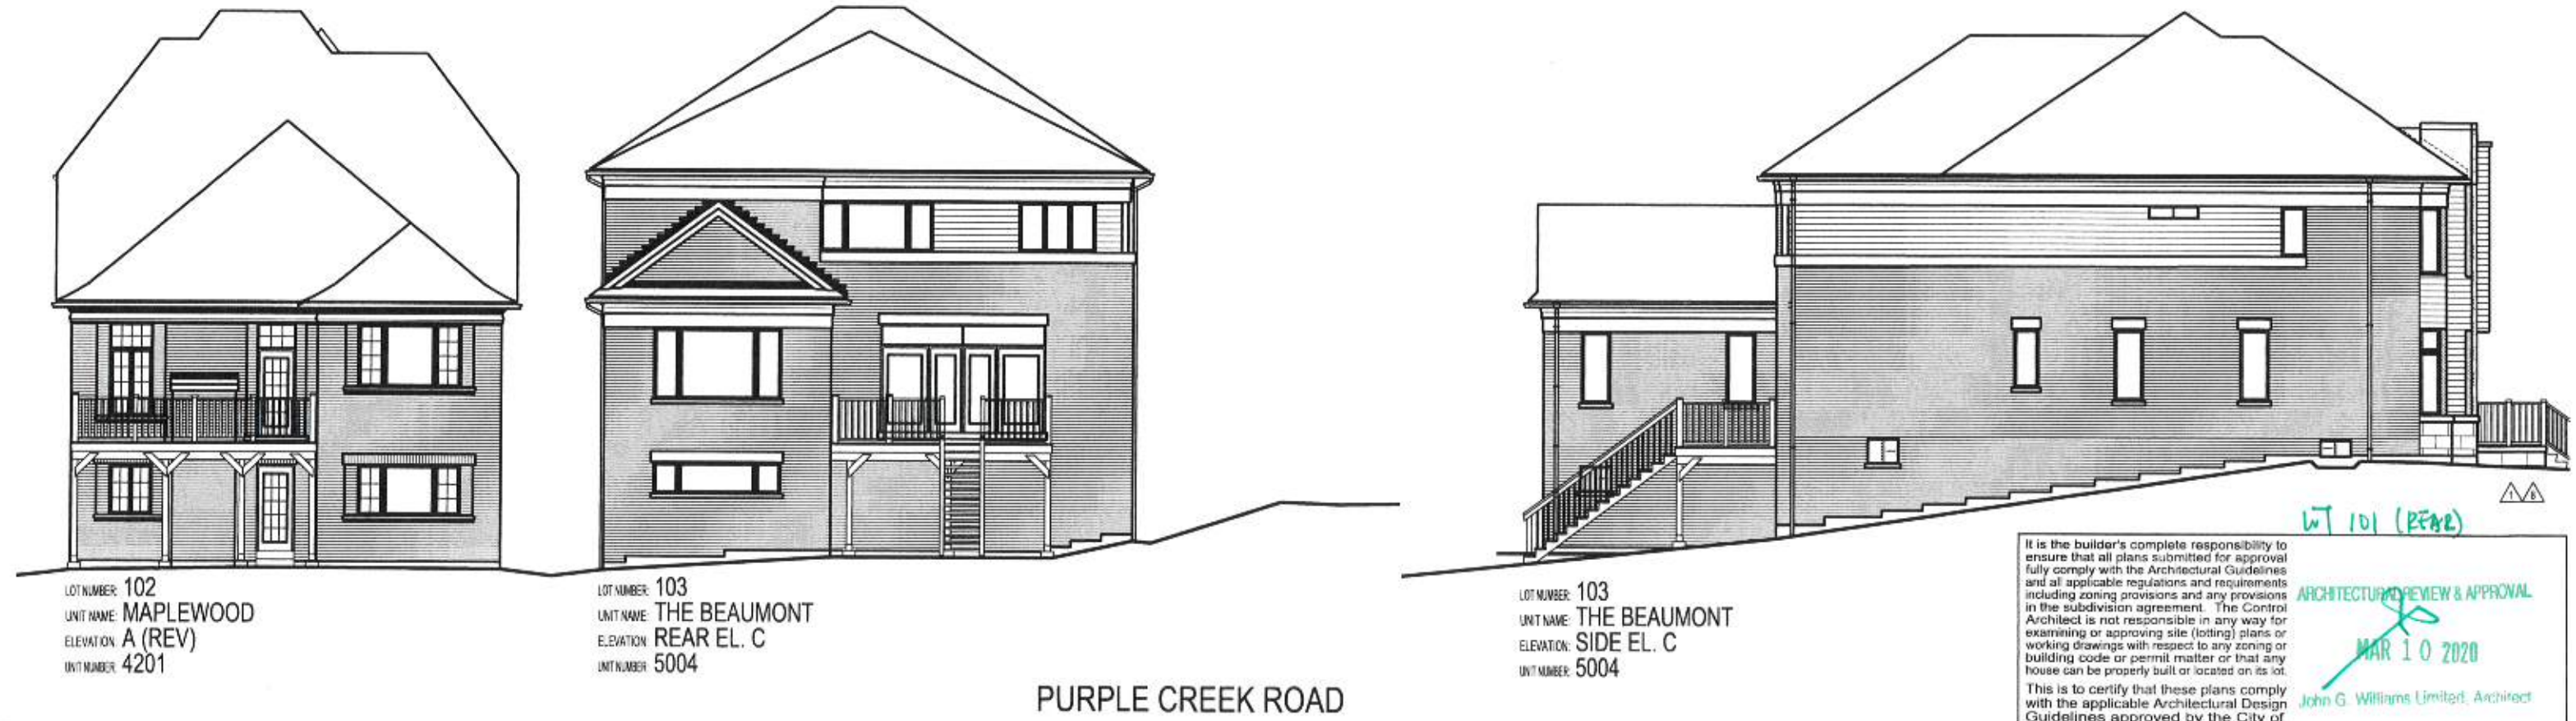

PURPLE CREEK ROAD

LEGEND:

- 1 BRICK/STONE VENEER ON SIDES OF STAIRS (POURED OR BRICK LEDGE/ PRECAST)
- 2 DROP OR RAISE BANDING BY AMOUNT INDICATED
- 3 ADD BANDING AND/OR TRIM AS INDICATED
- 4 ADDED CAMBERED HEADERS
- 5 8'-0" X 8'-0" GARAGE DOORS
- 6 CHOPPED OR RAISED SOFFIT AS INDICATED
- 7 ADJUSTED ROOF OVERHANG AS INDICATED ON ROOF PLAN
- 8 PROVIDE GUARD PER CONSTRUCTION NOTE 11
- 9 FOYER SUNKEN AS INDICATED
- 10 LIGHT FIXTURE RELOCATED AS INDICATED

HUNT
DESIGN ASSOCIATES INC.
www.hunt-design.ca

GOLDPARK HOMES - 217020
PINE VALLEY, VAUGHAN, ONT.
8966 Woodbine Ave, Markham, ON L3R 0J7 • T 905.737.5133 • F 905.737.7326 • 2020/02/07 • NEA •

It is the builder's complete responsibility to ensure that all plans submitted for approval fully comply with the Architectural Guidelines and all applicable regulations and requirements including zoning provisions and any provisions in the subdivision agreement. The Control Architect is not responsible in any way for examining or approving site (lotting) plans or working drawings with respect to any zoning or building code or permit matter or that any house can be properly built or located on its lot.

This is to certify that these plans comply with the applicable Architectural Design Guidelines approved by the City of VAUGHAN.

ARCHITECTURAL REVIEW & APPROVAL
MAR 10 2020
John G. Williams Limited, Architect

STREETSCAPES - (LOTS 98-103)