


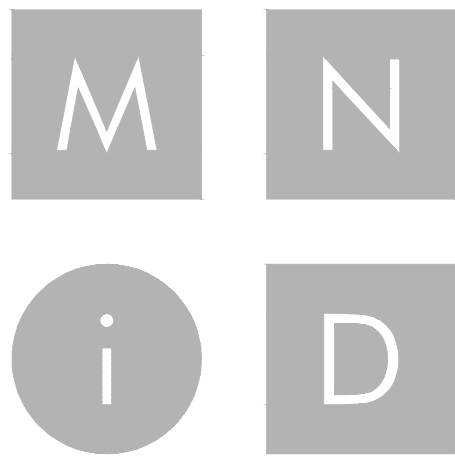

MIKE NIVEN INTERIOR DESIGN INC.
100 BROADVIEW AVE. S. 302 TORONTO, CANADA M4M 3B3
TEL: 416.783.7404 • FAX: 416.783.7404

ISSUED FOR
PLUMBING &
APPLIANCES

No.	Date	Revision	Dwn	Chg
1	18/04/2019	ADJUSTED AS SHOWN	RG	MN
2	15/05/2019	ADJUSTED AS SHOWN	RG	MN
3	24/05/2019	ADJUSTED AS SHOWN	RG	MN
4	11/06/2019	ADJUSTED AS SHOWN	RG	MN
5	02/2020	CHANGE NOTICE #10	NURS	MN

4	11/20/2018	ISSUED FOR PRICING FOR TRIM AND MILL WORK	RS	MN
3	10/22/2018	ISSUED FOR PRICING FOR GLASS AND TILES ONLY	HD	MN
2	15/05/2019	ISSUED FOR PLUMBING & APPLIANCES	RG	MN
1	18/04/2018	ISSUED FOR COORDINATION	RG	MN

No.	Date	Issue	Dwn	Chg
-----	------	-------	-----	-----

NOTE: DO NOT SCALE DRAWINGS
It is the contractor's responsibility to verify all specifications and dimensions and report any discrepancies to the designer prior to construction. Materials may not be substituted without designer's written approval.



PROJECT:
PINEVALLEY
KNIGHTSWOOD, LOT 93

GOLDPARK HOMES
CONCORD, ON



DRAWING:

COVER PAGE

DESIGNER'S:

MIKE NIVEN

DRAWN BY:

M-Tec Inc.

DATE:

FEB 2019

SCALE:

1:50

PROJECT NO:

2018-10

ID
0.0

PINEVALLEY
KNIGHTSWOOD

INDEX

ID0.0.0

COVER SHEET AND INDEX

ID1.0.0

BASEMENT PARTITION PLAN

ID1.0.1

BASEMENT REFLECTIVE CEILING PLAN

ID1.0.2

BASEMENT FINISHES PLAN

ID1.1.0

FIRST AND SECOND FLOOR PARTITION PLAN

ID1.1.1

FIRST AND SECOND FLOOR REFLECTIVE CEILING PLAN

ID1.1.2

FIRST AND SECOND FLOOR FINISHES PLAN

ID2.0.0

BATHROOM ELEVATIONS

ID2.0.1

BATHROOM ELEVATIONS

ID2.0.2

GROUND FLOOR ELEVATIONS

ID2.0.3

GROUND FLOOR ELEVATIONS

ID2.0.4

STAIRWELL ELEVATIONS

ID2.1.0

SECOND FLOOR ELEVATIONS

ID2.1.1

SECOND FLOOR ELEVATIONS

ID3.0.0


DETAILS

ID3.0.1

DETAILS

ID3.0.2


DETAILS

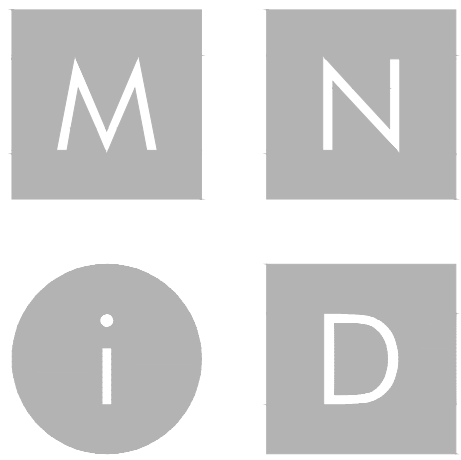

MIKE NIVEN INTERIOR DESIGN INC.
100 BROADVIEW AVE. S. 3RD FLOOR, TORONTO, CANADA M4M 3B3
TEL: 416.783.7404 • FAX: 416.783.7404

ISSUED FOR
PLUMBING &
APPLIANCES

No.	Date	Revision	Drawn	CHK
1	18/04/2019	ADJUSTED AS SHOWN	RG	MN
2	15/05/2019	ADJUSTED AS SHOWN	RG	MN
3	24/05/2019	ADJUSTED AS SHOWN	RG	MN
4	11/06/2019	ADJUSTED AS SHOWN	RG	MN
5	07/10/2019	CHANGE NOTICE #6	WV	MN
6	11/20/2019	CHANGE NOTICE #9	RS	MN

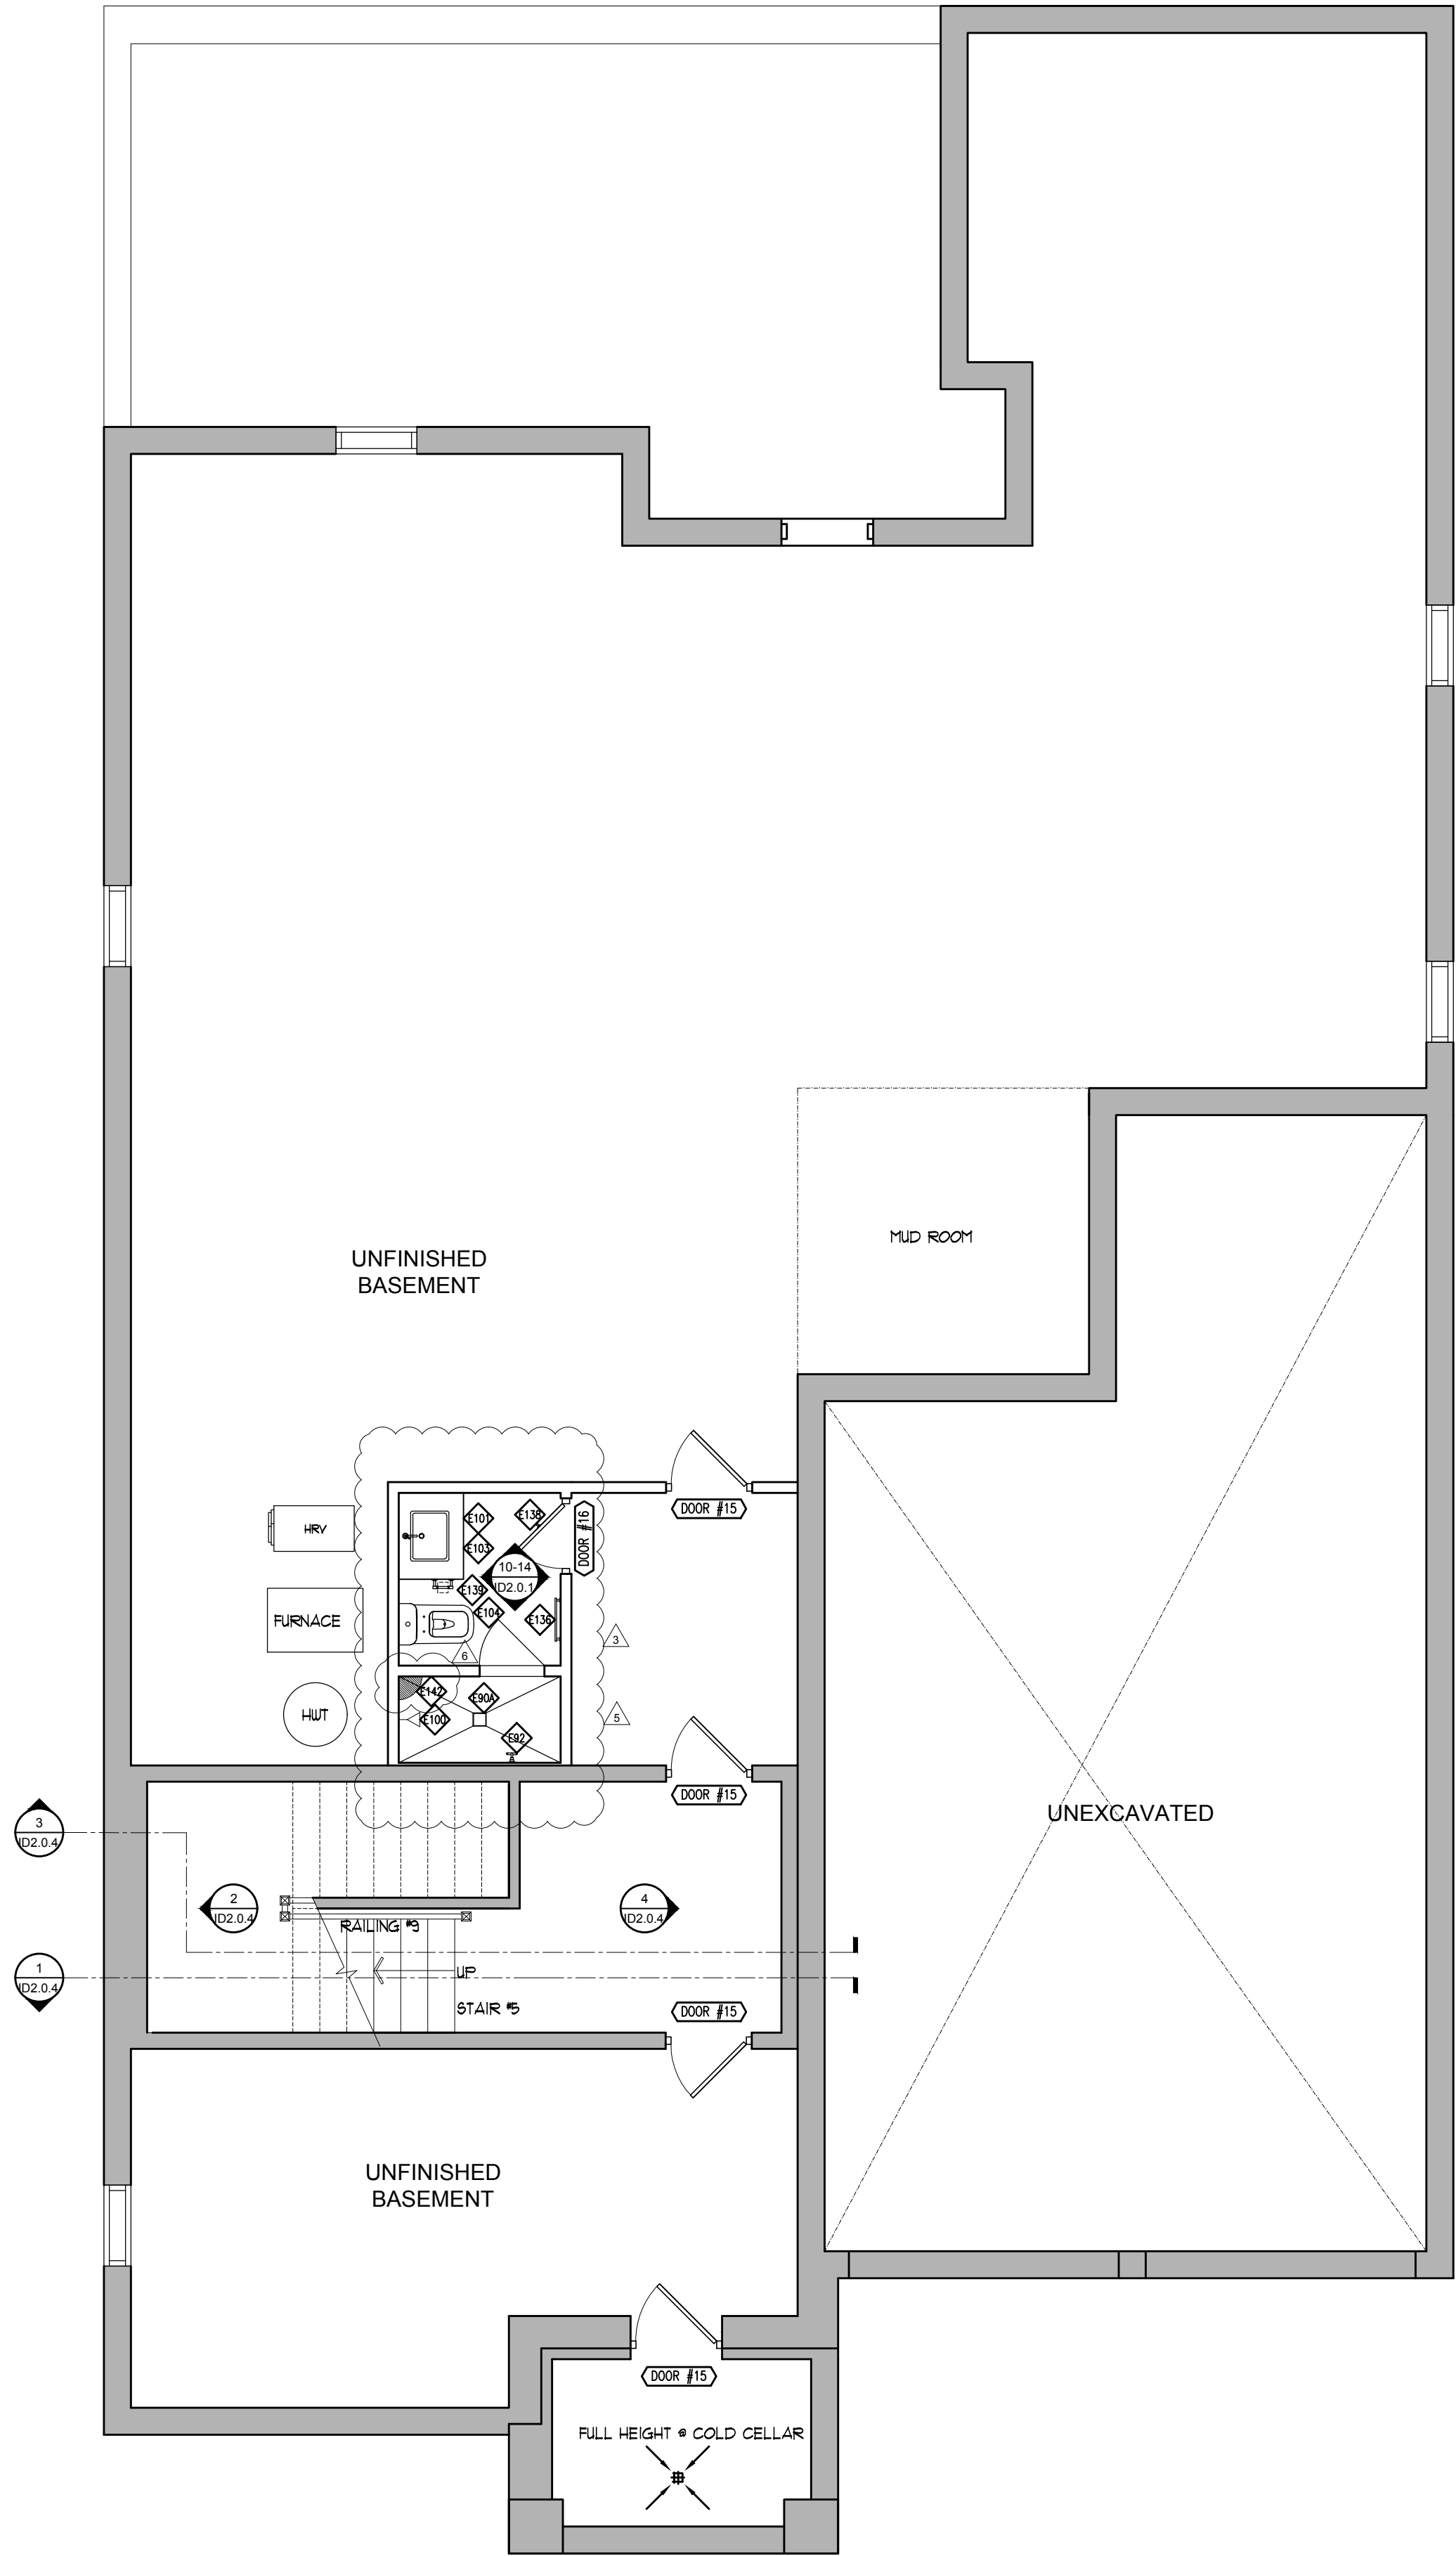

BASEMENT FLOOR
PARTITION PLAN
SCALE: 1:50

4	11/20/2019	ISSUED FOR PRICING FOR TRIM AND MILLWORK	RS	MN
3	10/22/2019	ISSUED FOR PRICING FOR GLASS AND TILES ONLY	HD	MN
2	15/05/2019	ISSUED FOR PLUMBING & APPLIANCES	RG	MN
1	18/04/2019	ISSUED FOR COORDINATION	RG	MN

No.	Date	Issue	Drawn	CHK
-----	------	-------	-------	-----

NOTE: **DONOT SCALE DRAWINGS**
It is the contractor's responsibility to verify all specifications and dimensions and report any discrepancies to the designer prior to construction. Materials may not be substituted without designer's written approval.



PROJECT:
PINEVALLEY
KNIGHTSWOOD, LOT 93

GOLDPARK HOMES
CONCORD, ON



DRAWING:

PARTITION PLAN

DESIGNER'S:


DRAWN BY:

DATE:

SCALE:

PROJECT NO:

ID
1.0.0

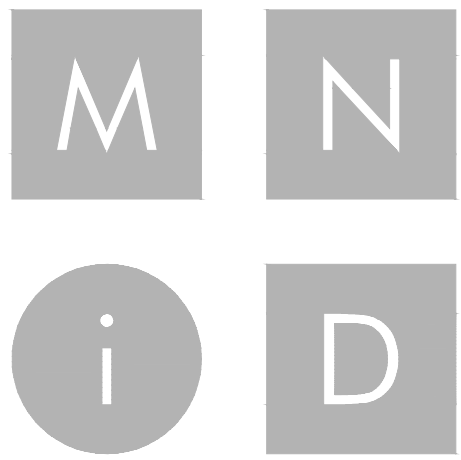

MIKE NIVEN INTERIOR DESIGN INC.
100 BROADVIEW AVE. S. 3RD FLOOR, TORONTO, CANADA M4M 3B3
TEL: 416.783.7404 • FAX: 416.783.7404

ISSUED FOR
PLUMBING &
APPLIANCES

No.	Date	Revision	Drawn	CHK
1	18/04/2019	ADJUSTED AS SHOWN	RG	MN
2	15/05/2019	ADJUSTED AS SHOWN	RG	MN
3	24/05/2019	ADJUSTED AS SHOWN	RG	MN
4	11/06/2019	ADJUSTED AS SHOWN	RG	MN
5	07/10/2019	CHANGE NOTICE #6	WV	MN
6	11/20/2019	CHANGE NOTICE #9	RS	MN
7	02/20/20	CHANGE NOTICE #10	NVRS	MN

4	11/20/2019	ISSUED FOR PRICING FOR TRIM AND MILLWORK	RS	MN
3	10/22/2019	ISSUED FOR PRICING FOR GLASS AND TILES ONLY	HD	MN
2	15/05/2019	ISSUED FOR PLUMBING & APPLIANCES	RG	MN
1	18/04/2019	ISSUED FOR COORDINATION	RG	MN

No.	Date	Issue	Drawn	CHK
-----	------	-------	-------	-----

NOTE: DO NOT SCALE DRAWINGS
It is the contractor's responsibility to verify all specifications and dimensions and report any discrepancies to the designer prior to construction. Materials may not be substituted without designer's written approval.



PROJECT:
PINEVALLEY
KNIGHTSWOOD, LOT 93

GOLDPARK HOMES
CONCORD, ON



DRAWING:

REFLECTIVE CEILING PLAN

DESIGNER'S:

MIKE NIVEN

DRAWN BY:

M-Tec Inc.

DATE:

FEB 2019


SCALE:

1:50


PROJECT NO:

2018-10

ID
1.0.1

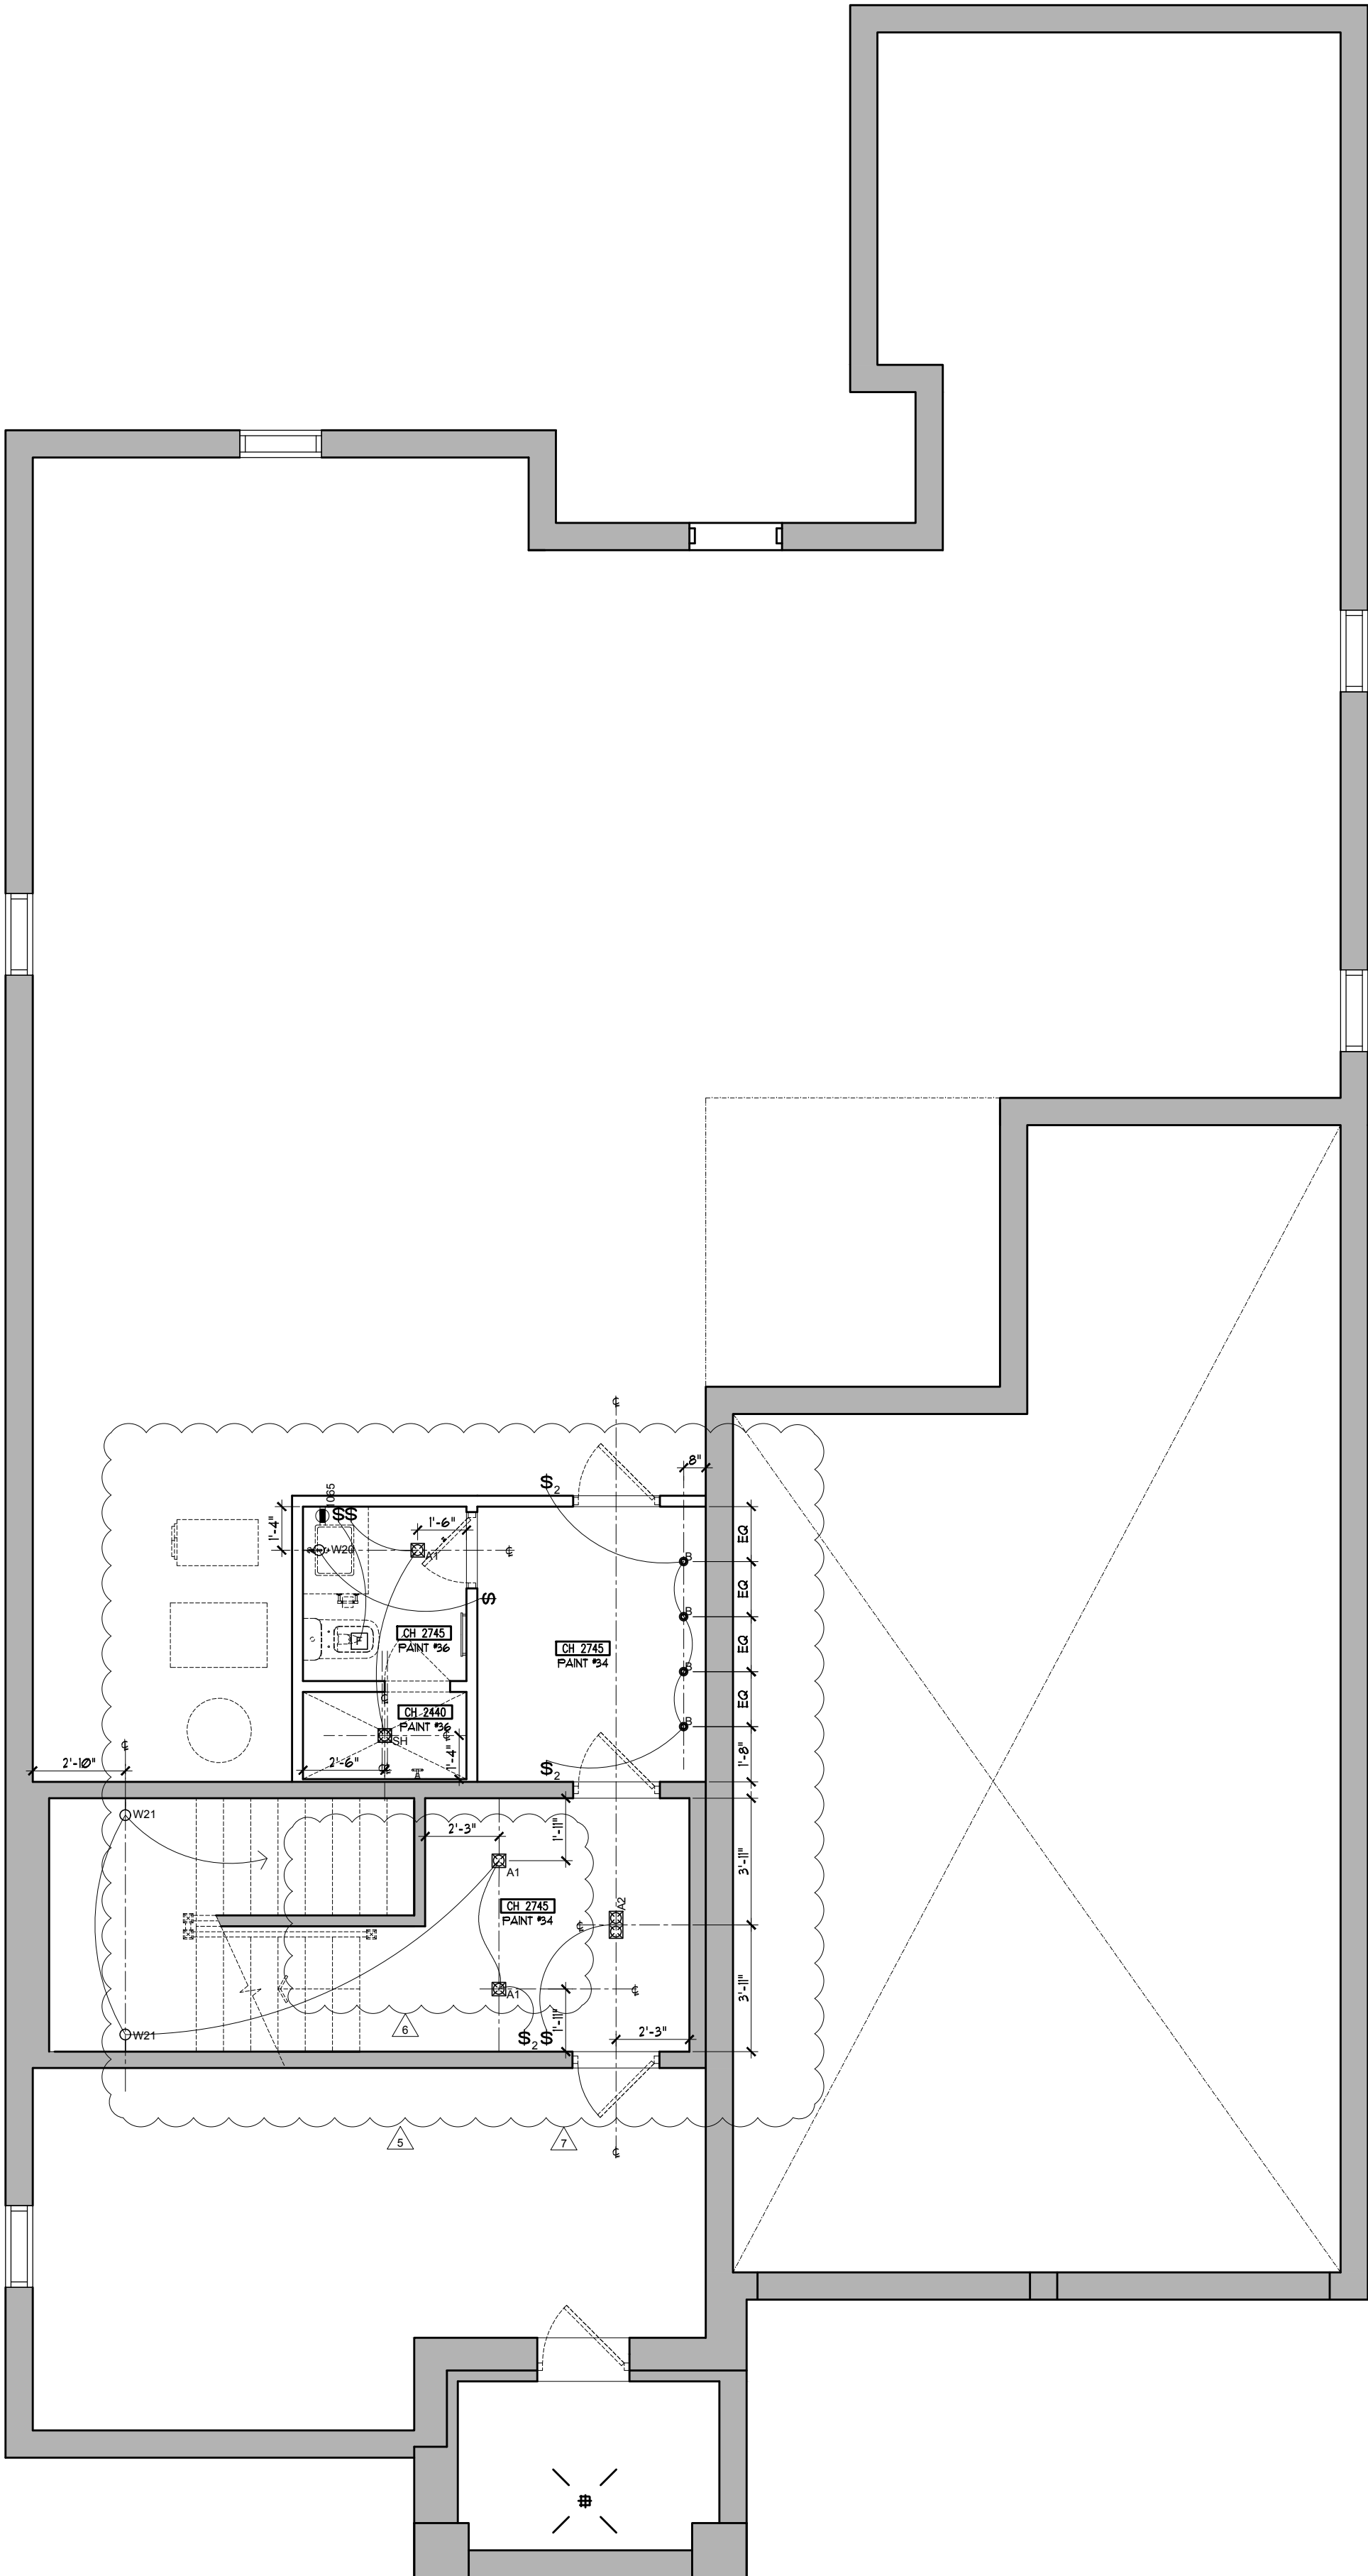


BASEMENT FLOOR
REFLECTIVE CEILING PLAN
SCALE: 1:50

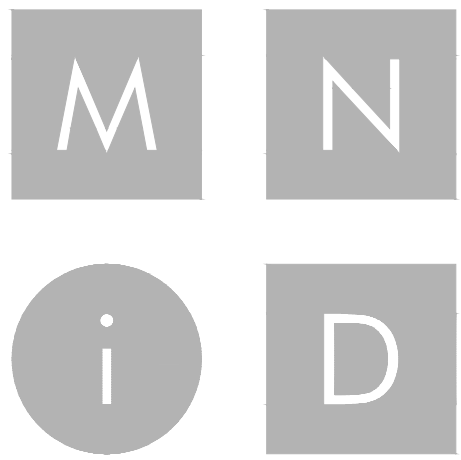

MIKE NIVEN INTERIOR DESIGN INC.
100 BROADVIEW AVE. S. 3RD FLOOR, TORONTO, CANADA M4M 3B3
TEL: 416.783.7404 • FAX: 416.783.7404

ISSUED FOR
PLUMBING &
APPLIANCES

No.	Date	Revision	Drawn	CHK
1	18/04/2019	ADJUSTED AS SHOWN	RG	MN
2	15/05/2019	ADJUSTED AS SHOWN	RG	MN
3	24/05/2019	ADJUSTED AS SHOWN	RG	MN
4	11/06/2019	ADJUSTED AS SHOWN	RG	MN
5	02/2020	CHANGE NOTICE #10	NURS	MN

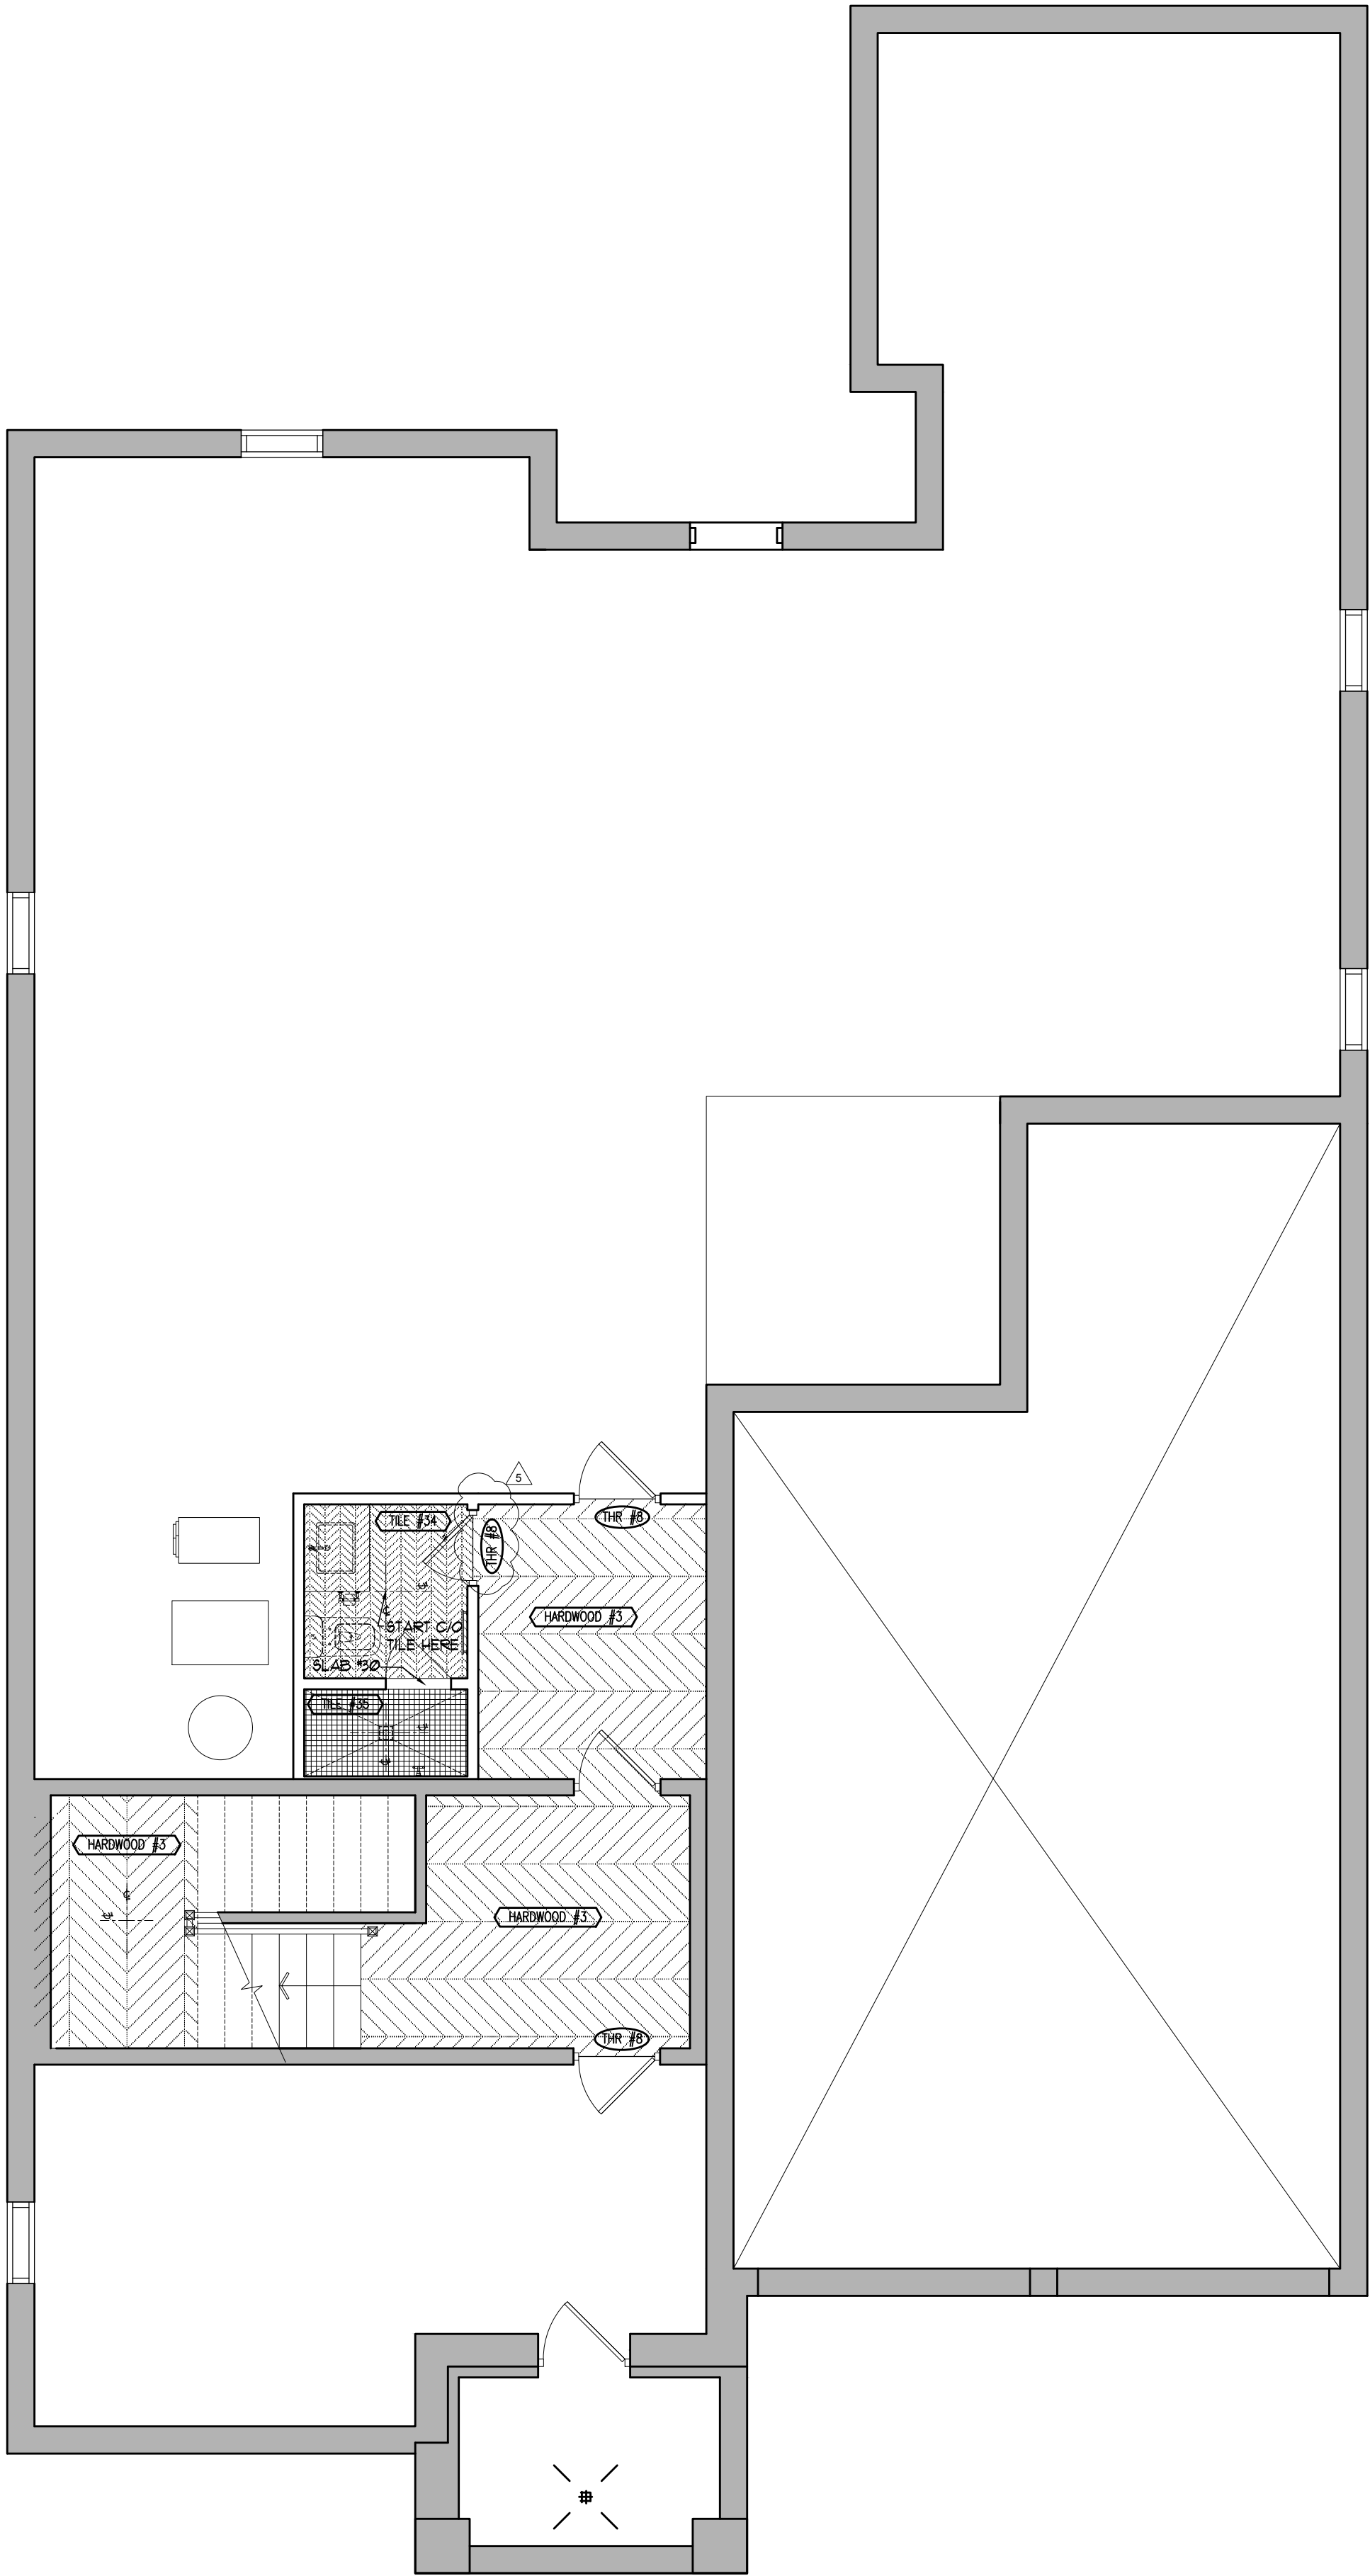

4	11/20/2019	ISSUED FOR PRICING FOR TRIM AND MILLWORK	RS	MN
3	10/22/2019	ISSUED FOR PRICING FOR GLASS AND TILES ONLY	HD	MN
2	15/05/2019	ISSUED FOR PLUMBING & APPLIANCES	RG	MN
1	18/04/2019	ISSUED FOR COORDINATION	RG	MN

No.	Date	Issue	Drawn	CHK
-----	------	-------	-------	-----

NOTE: DO NOT SCALE DRAWINGS
It is the contractor's responsibility to verify all specifications and dimensions and report any discrepancies to the designer prior to construction. Materials may not be substituted without designer's written approval.




PROJECT:
PINEVALLEY
KNIGHTSWOOD, LOT 93
GOLDPARK HOMES
CONCORD, ON



DRAWING:

FINISHES PLAN


DESIGNER'S: MIKE NIVEN	ID 1.0.2
DRAWN BY: M-Tec Inc.	
DATE: FEB 2019	
SCALE: 1:50	
PROJECT NO: 2018-10	

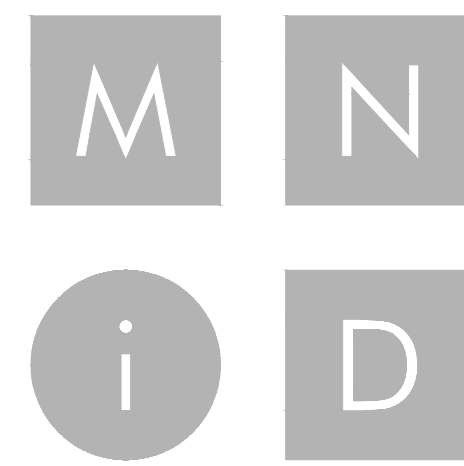


MIKE NIVEN INTERIOR DESIGN INC.
100 BROADVIEW AVE. S. 3RD FLOOR, TORONTO, CANADA M4M 3B3
TEL: 416.783.7404 • FAX: 416.783.7404

ISSUED FOR
PLUMBING &
APPLIANCES

No.	Date	Revision	Drawn	CHK
1	18/04/2019	ADJUSTED AS SHOWN	RG	MM
2	15/05/2019	ADJUSTED AS SHOWN	RG	MM
3	24/05/2019	ADJUSTED AS SHOWN	RG	MM
4	11/06/2019	ADJUSTED AS SHOWN	RG	MM
5	07/10/2019	CHANGE NOTICE #6	WV	MM
6	10/03/2019	CHANGE NOTICE #8	HD	MM
7	11/02/2019	CHANGE NOTICE #9	RS	MM
8	02/20/20	CHANGE NOTICE #10	NVRS	MM

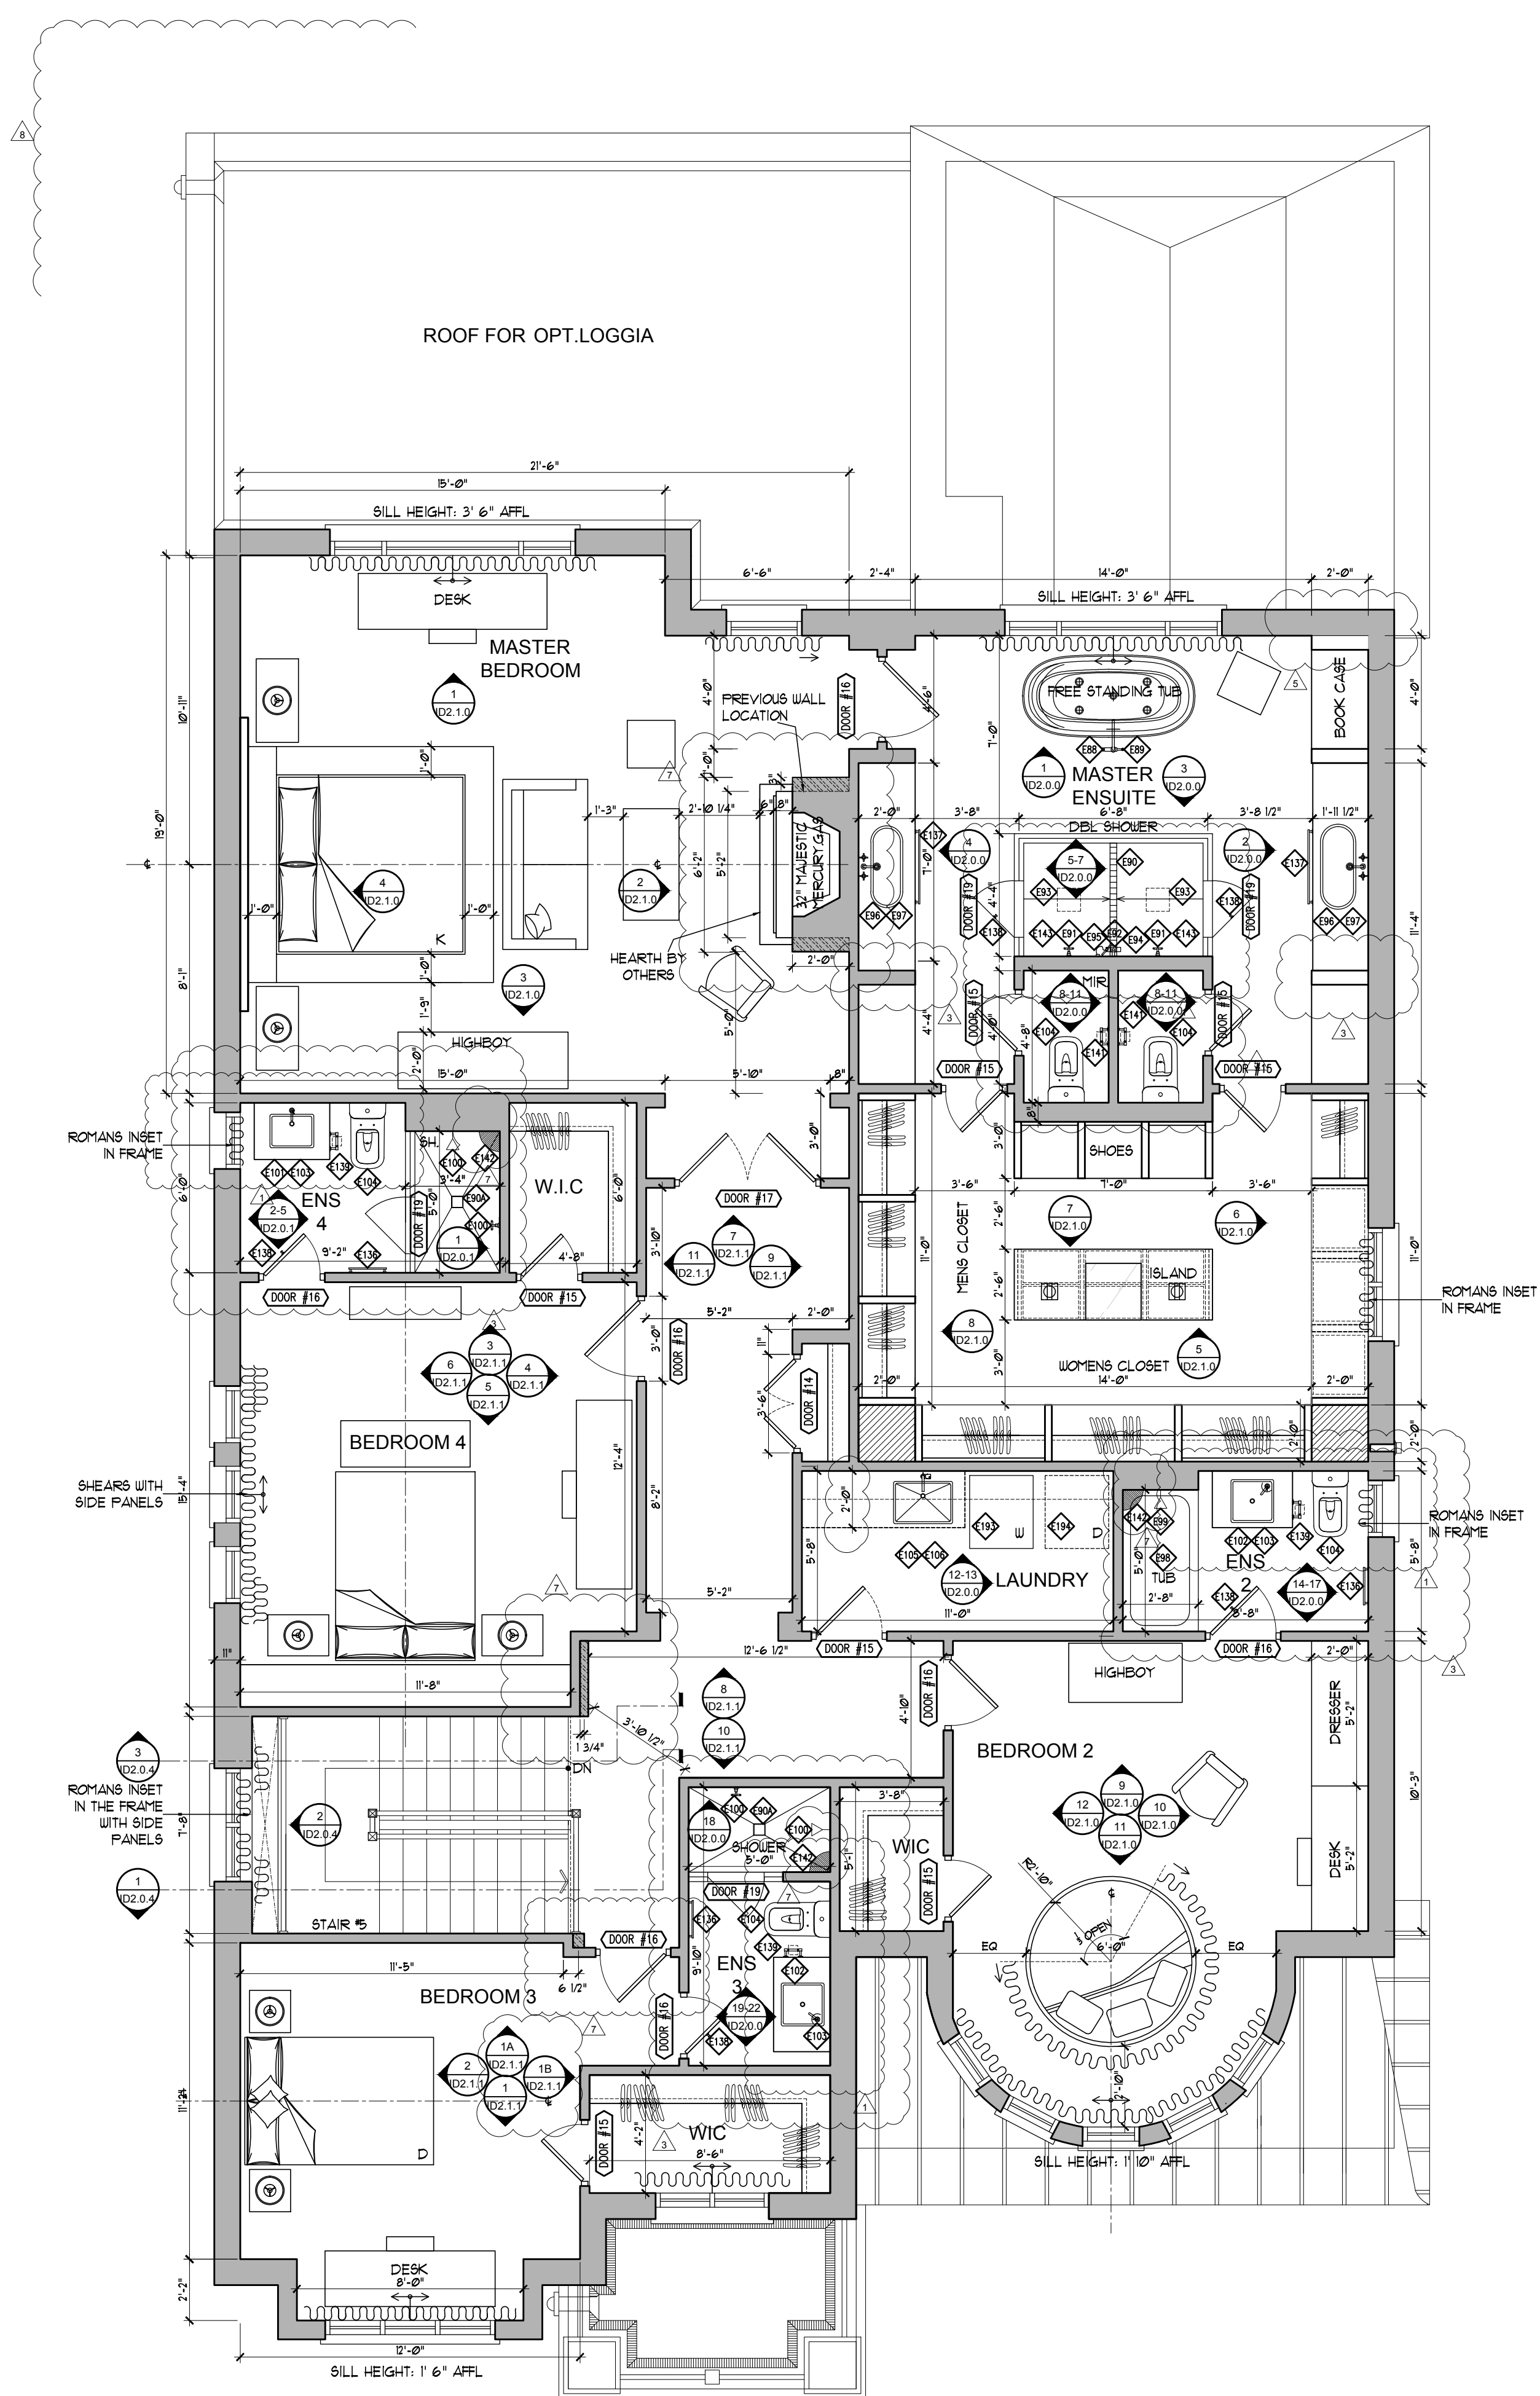

2 SECOND FLOOR
PARTITION PLAN
SCALE: 1:50

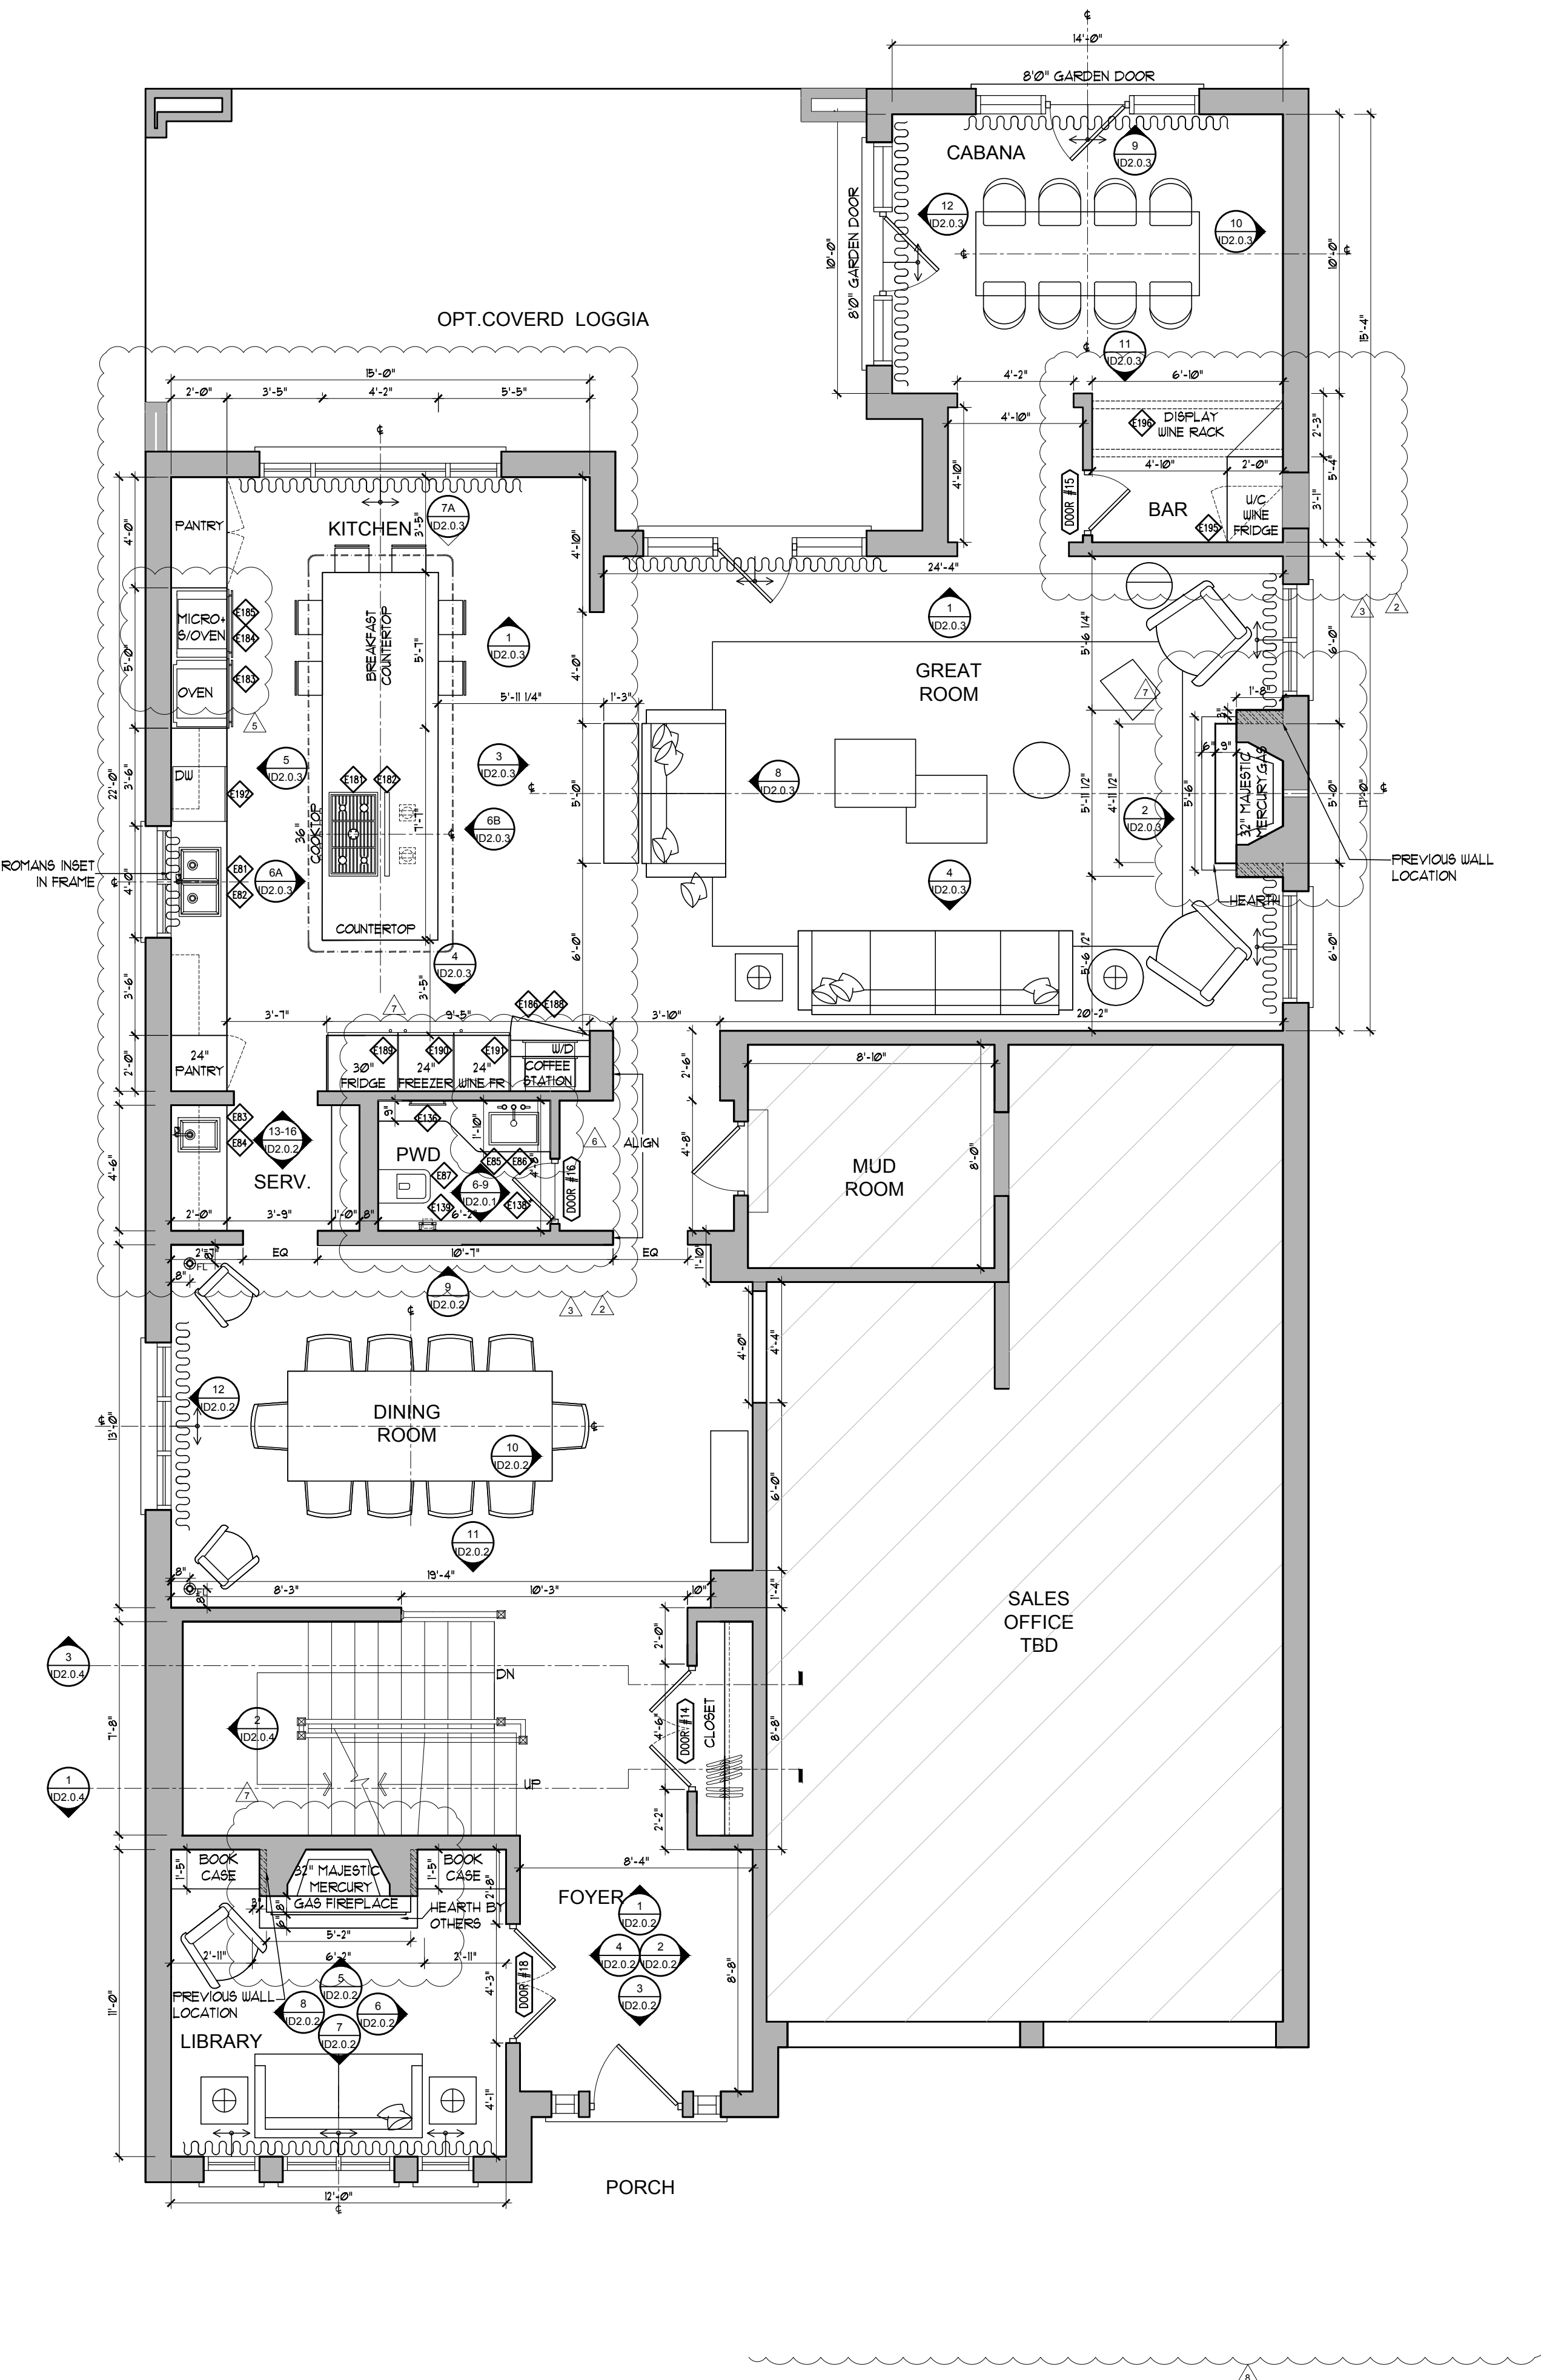

1 FIRST FLOOR
PARTITION PLAN
SCALE: 1:50

4	11/02/2019	ISSUED FOR PRICING FOR TRIM AND MILLWORK	RS	MM
3	10/22/2019	ISSUED FOR PRICING FOR GLASS AND TILES ONLY	HD	MM
2	15/05/2019	ISSUED FOR PLUMBING & APPLIANCES	RG	MM
1	18/04/2019	ISSUED FOR COORDINATION	RG	MM

NOTE: **DONOT SCALE DRAWINGS**
It is the contractor's responsibility to verify all specifications and dimensions and report any discrepancies to the designer prior to construction. Materials may not be substituted without designer's written approval.




PROJECT:
PINEVALLEY
KNIGHTSWOOD, LOT 93

GOLDPARK HOMES
CONCORD, ON

DRAWING:
PARTITION PLAN

DESIGNER'S:
MIKE NIVEN
DRAWN BY:
M-Tec Inc.
DATE:
FEB 2019
SCALE:
1:50
PROJECT NO:
2018-10


ID
1.1.0

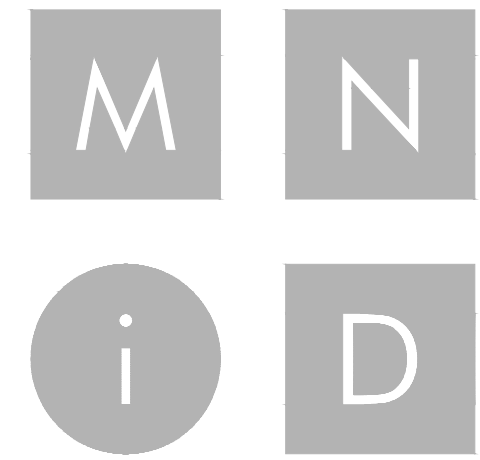


MIKE NIVEN INTERIOR DESIGN INC.
100 BROADVIEW AVE. S. 3RD FLOOR, TORONTO, CANADA M4M 3B3
TEL: 416.763.7404 • FAX: 416.763.7404

ISSUED FOR
PLUMBING &
APPLIANCES

No.	Date	Revision	Drawn	CHK
1	18/04/2019	ADJUSTED AS SHOWN	RG	MN
2	15/05/2019	ADJUSTED AS SHOWN	RG	MN
3	24/05/2019	ADJUSTED AS SHOWN	RG	MN
4	11/06/2019	ADJUSTED AS SHOWN	RG	MN
5	07/10/2019	CHANGE NOTICE #1	WV	MN
6	11/20/2019	CHANGE NOTICE #1	RS	MN
7	02/20/20	CHANGE NOTICE #1	NVRS	MN

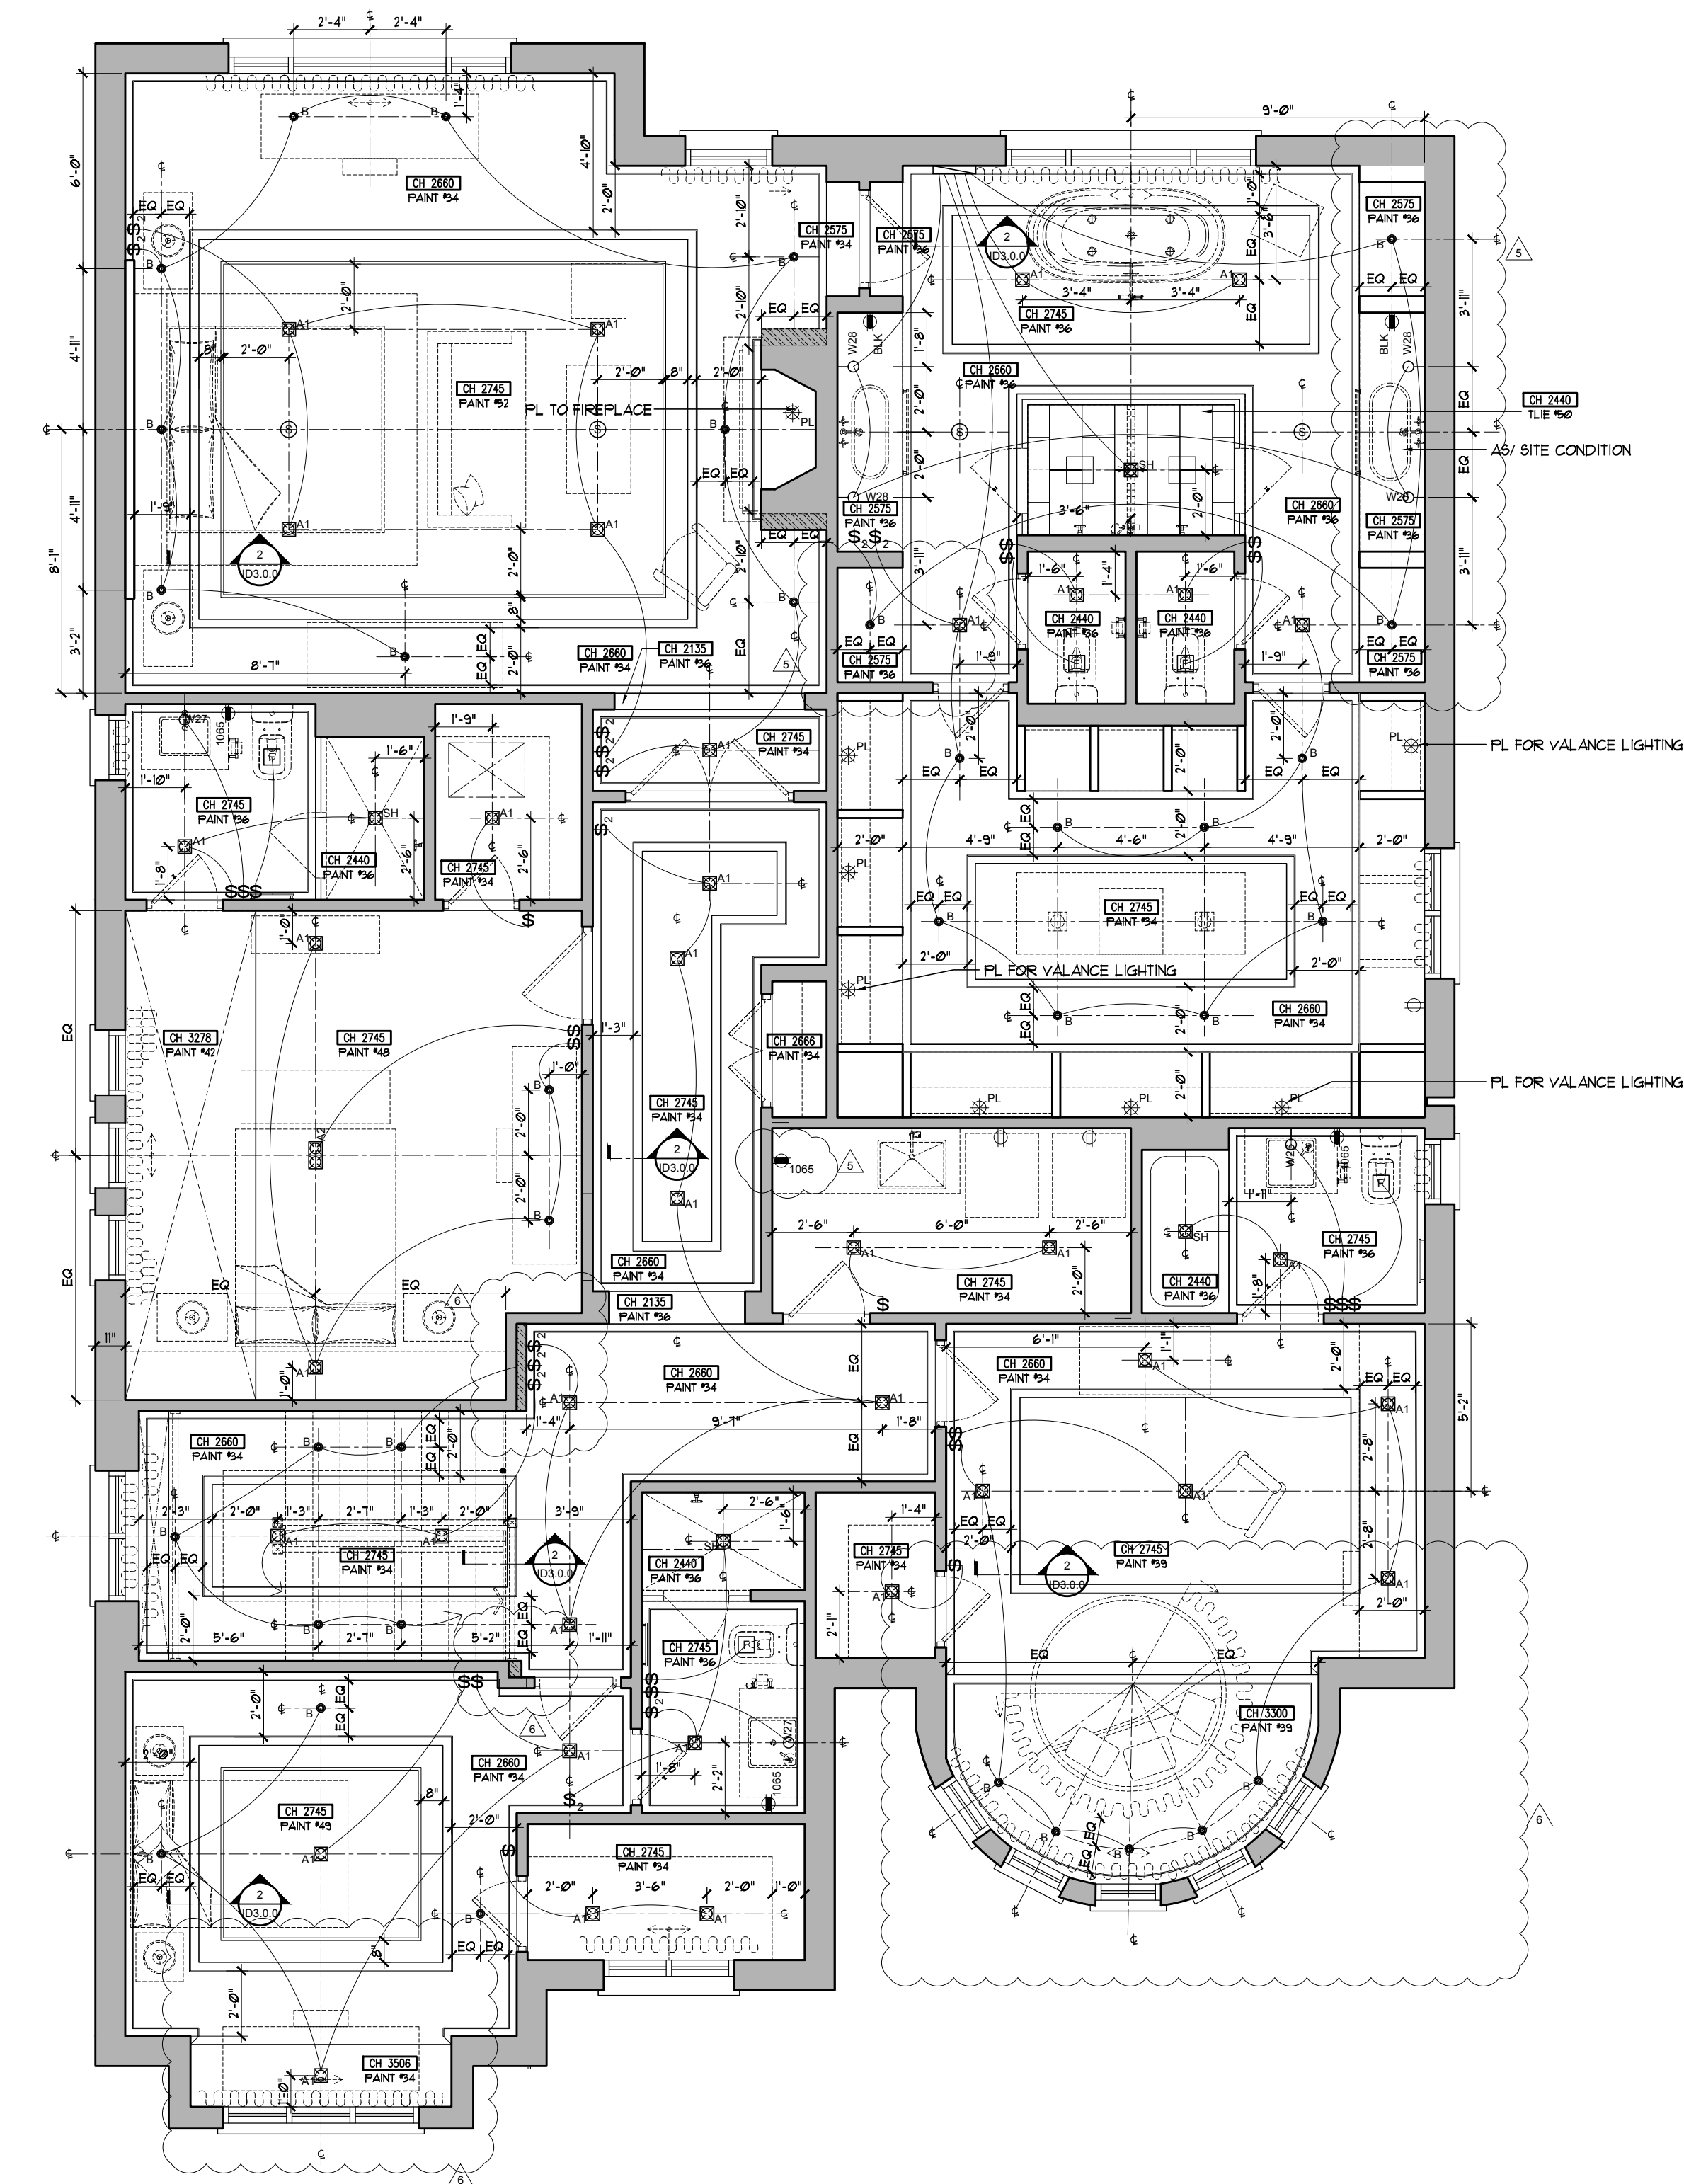

2 SECOND FLOOR
REFLECTIVE CEILING PLAN
SCALE: 1/8" = 1'-0"

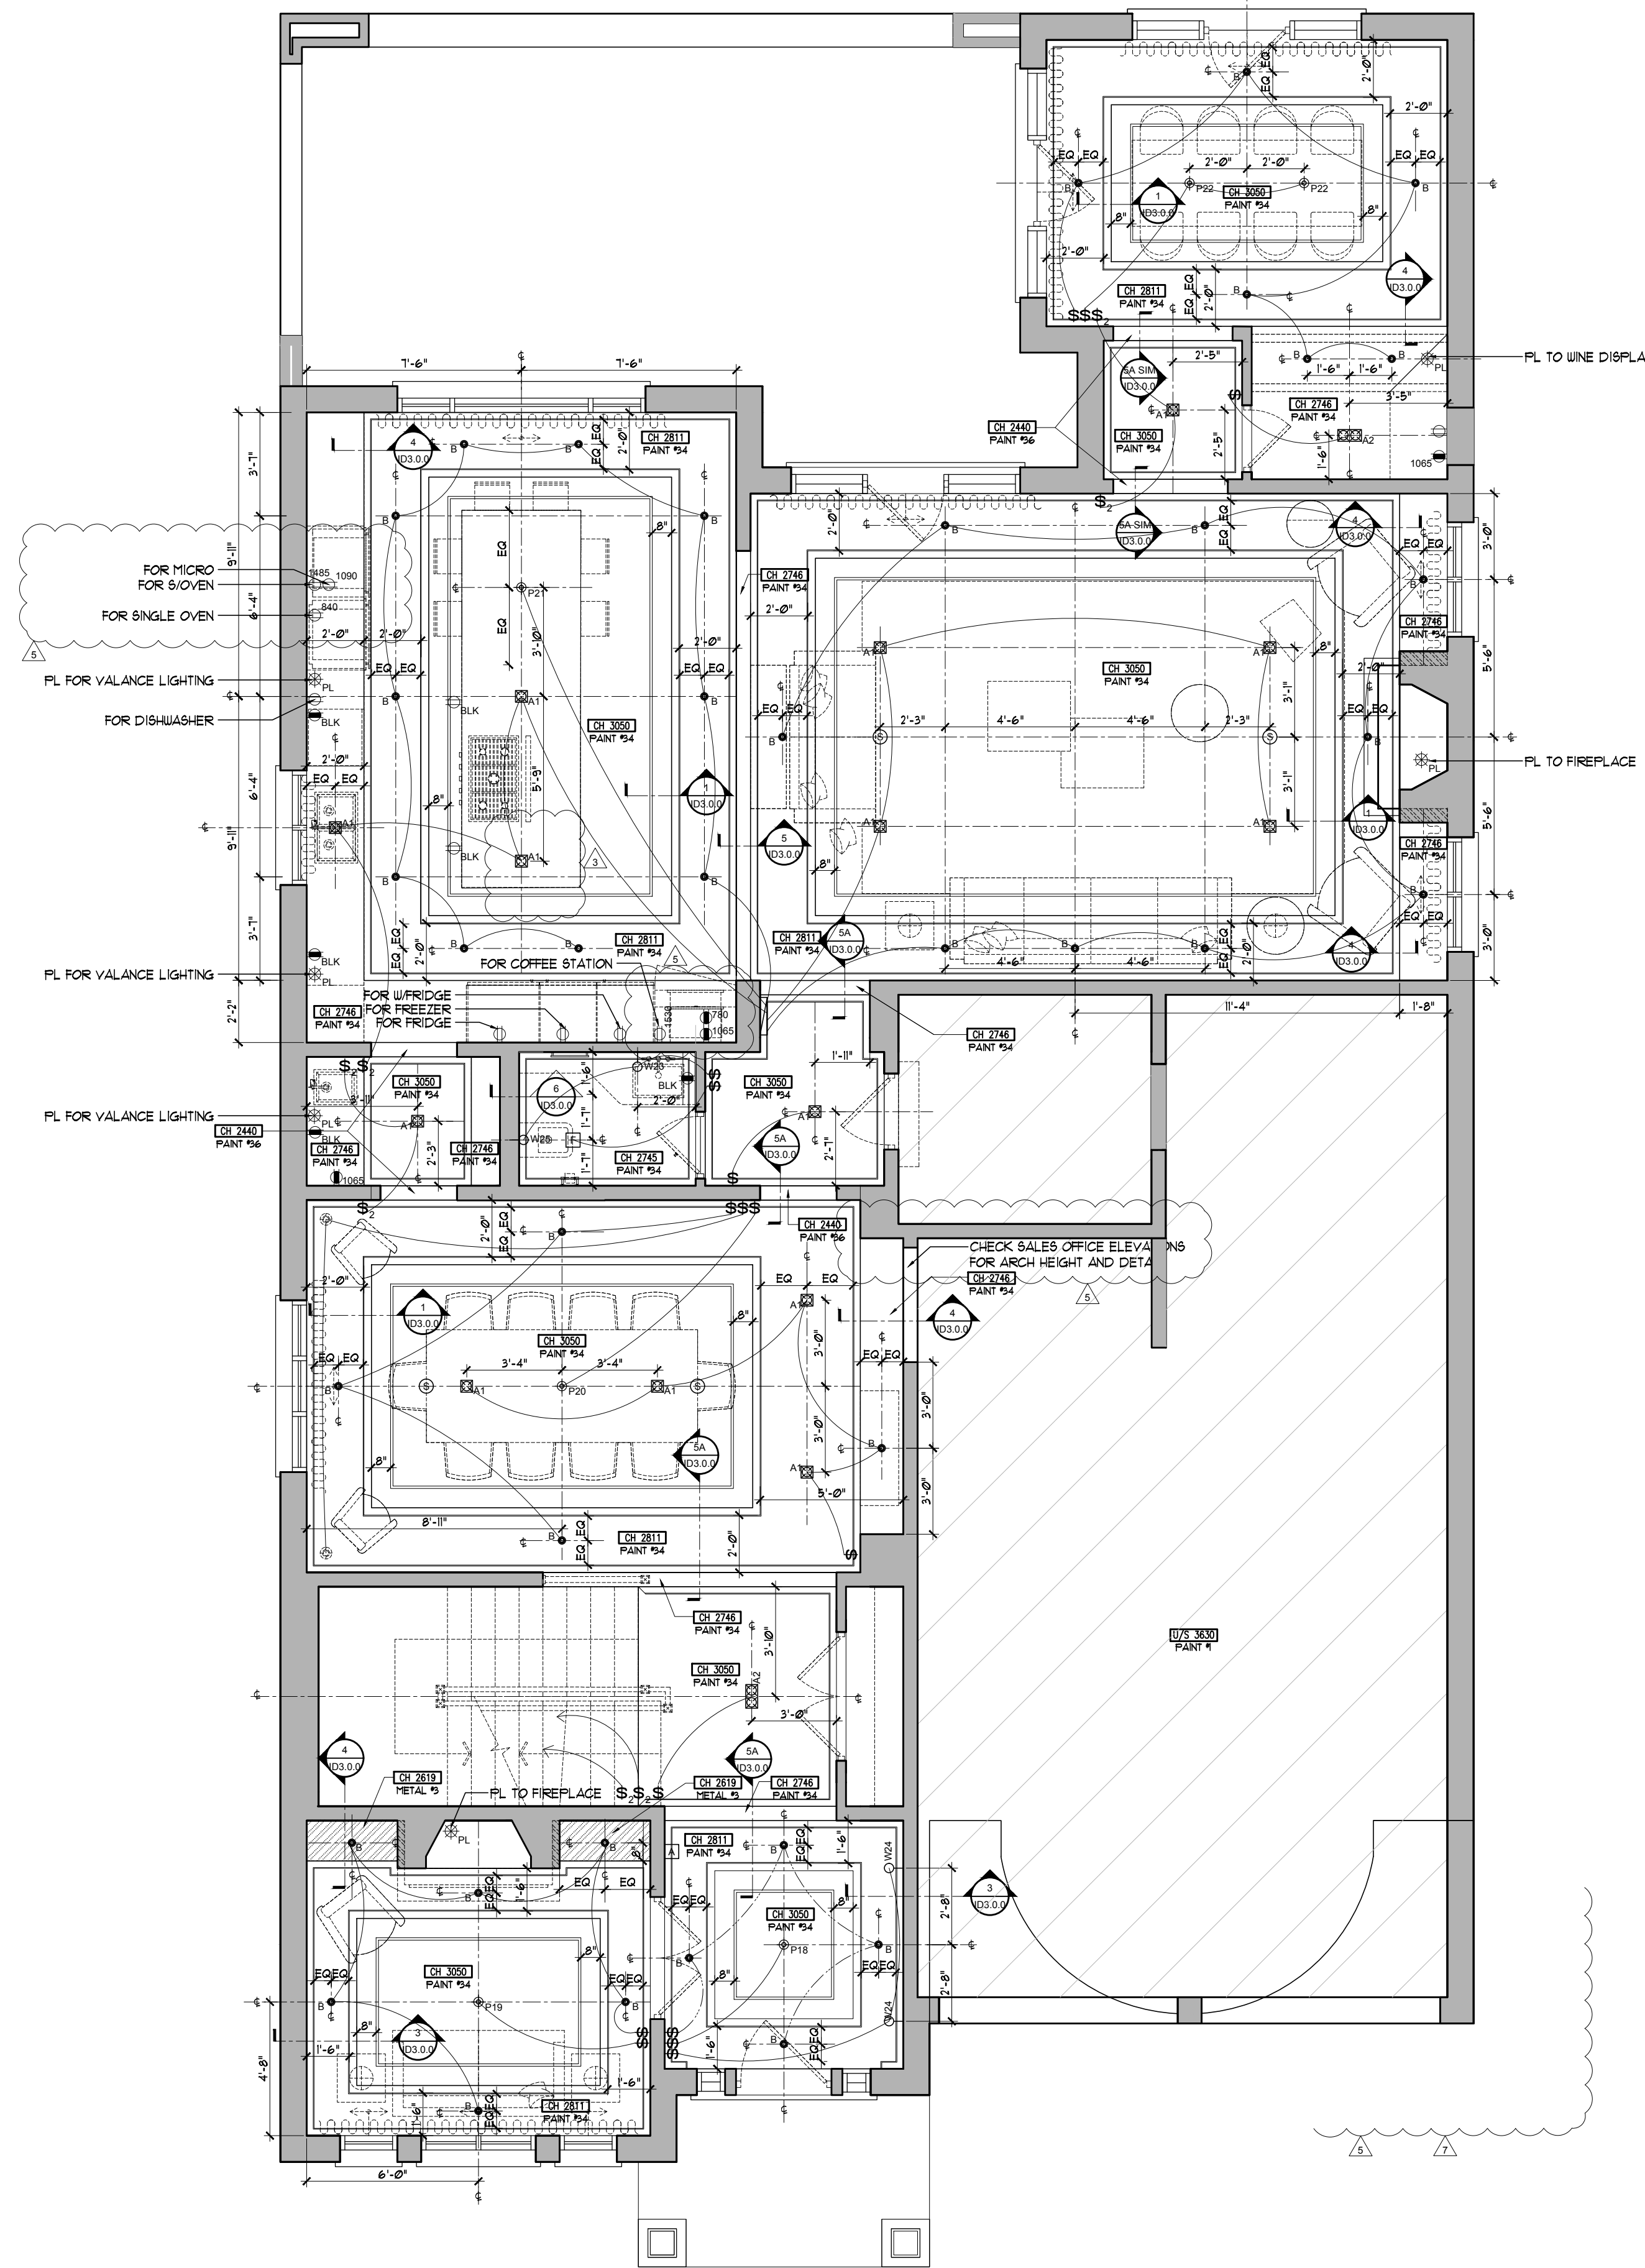

1 FIRST FLOOR
REFLECTIVE CEILING PLAN
SCALE: 1/8" = 1'-0"

4	11/20/2019	ISSUED FOR PRICING FOR TRIM AND MILLWORK	RS	MN
3	10/22/2019	ISSUED FOR PRICING FOR GLASS AND TILES ONLY	HD	MN
2	15/05/2019	ISSUED FOR PLUMBING & APPLIANCES	RG	MN
1	18/04/2019	ISSUED FOR COORDINATION	RG	MN

No.	Date	Issue	Drawn	CHK
-----	------	-------	-------	-----

NOTE: DO NOT SCALE DRAWINGS
It is the contractor's responsibility to verify all specifications and dimensions and report any discrepancies to the designer prior to construction. Materials may not be substituted without designer's written approval.



PROJECT:
PINEVALLEY
KNIGHTSWOOD, LOT 93
GOLDPARK HOMES
CONCORD, ON



DRAWING:
REFLECTIVE CEILING PLAN

DESIGNER'S:

MIKE NIVEN

DRAWN BY:

M-Tec Inc.

DATE:

FEB 2019


SCALE:

1/8" = 1'-0"

PROJECT NO:

2018-10


ID
1.1.1

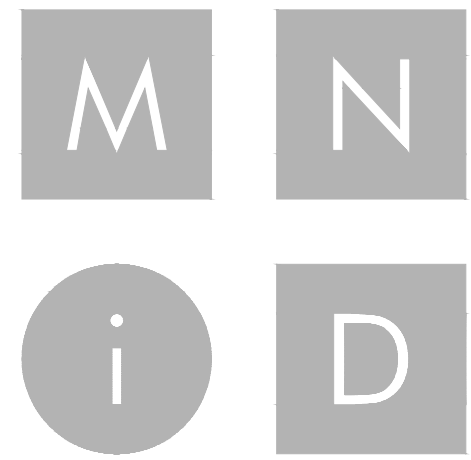


MIKE NIVEN INTERIOR DESIGN INC.
100 BROADVIEW AVE. S. 3RD FLOOR, TORONTO, CANADA M4M 3B3
TEL: 416.783.7404 • FAX: 416.783.7404

ISSUED FOR
PLUMBING &
APPLIANCES

No.	Date	Revision	Drawn	CHK
1	18/04/2019	ADJUSTED AS SHOWN	RG	MM
2	15/05/2019	ADJUSTED AS SHOWN	RG	MM
3	24/05/2019	ADJUSTED AS SHOWN	RG	MM
4	11/06/2019	ADJUSTED AS SHOWN	RG	MM
5	11/06/2019	CHANGE NOTICE #9	RS	MM
6	02/06/2020	CHANGE NOTICE #10	NVRS	MM

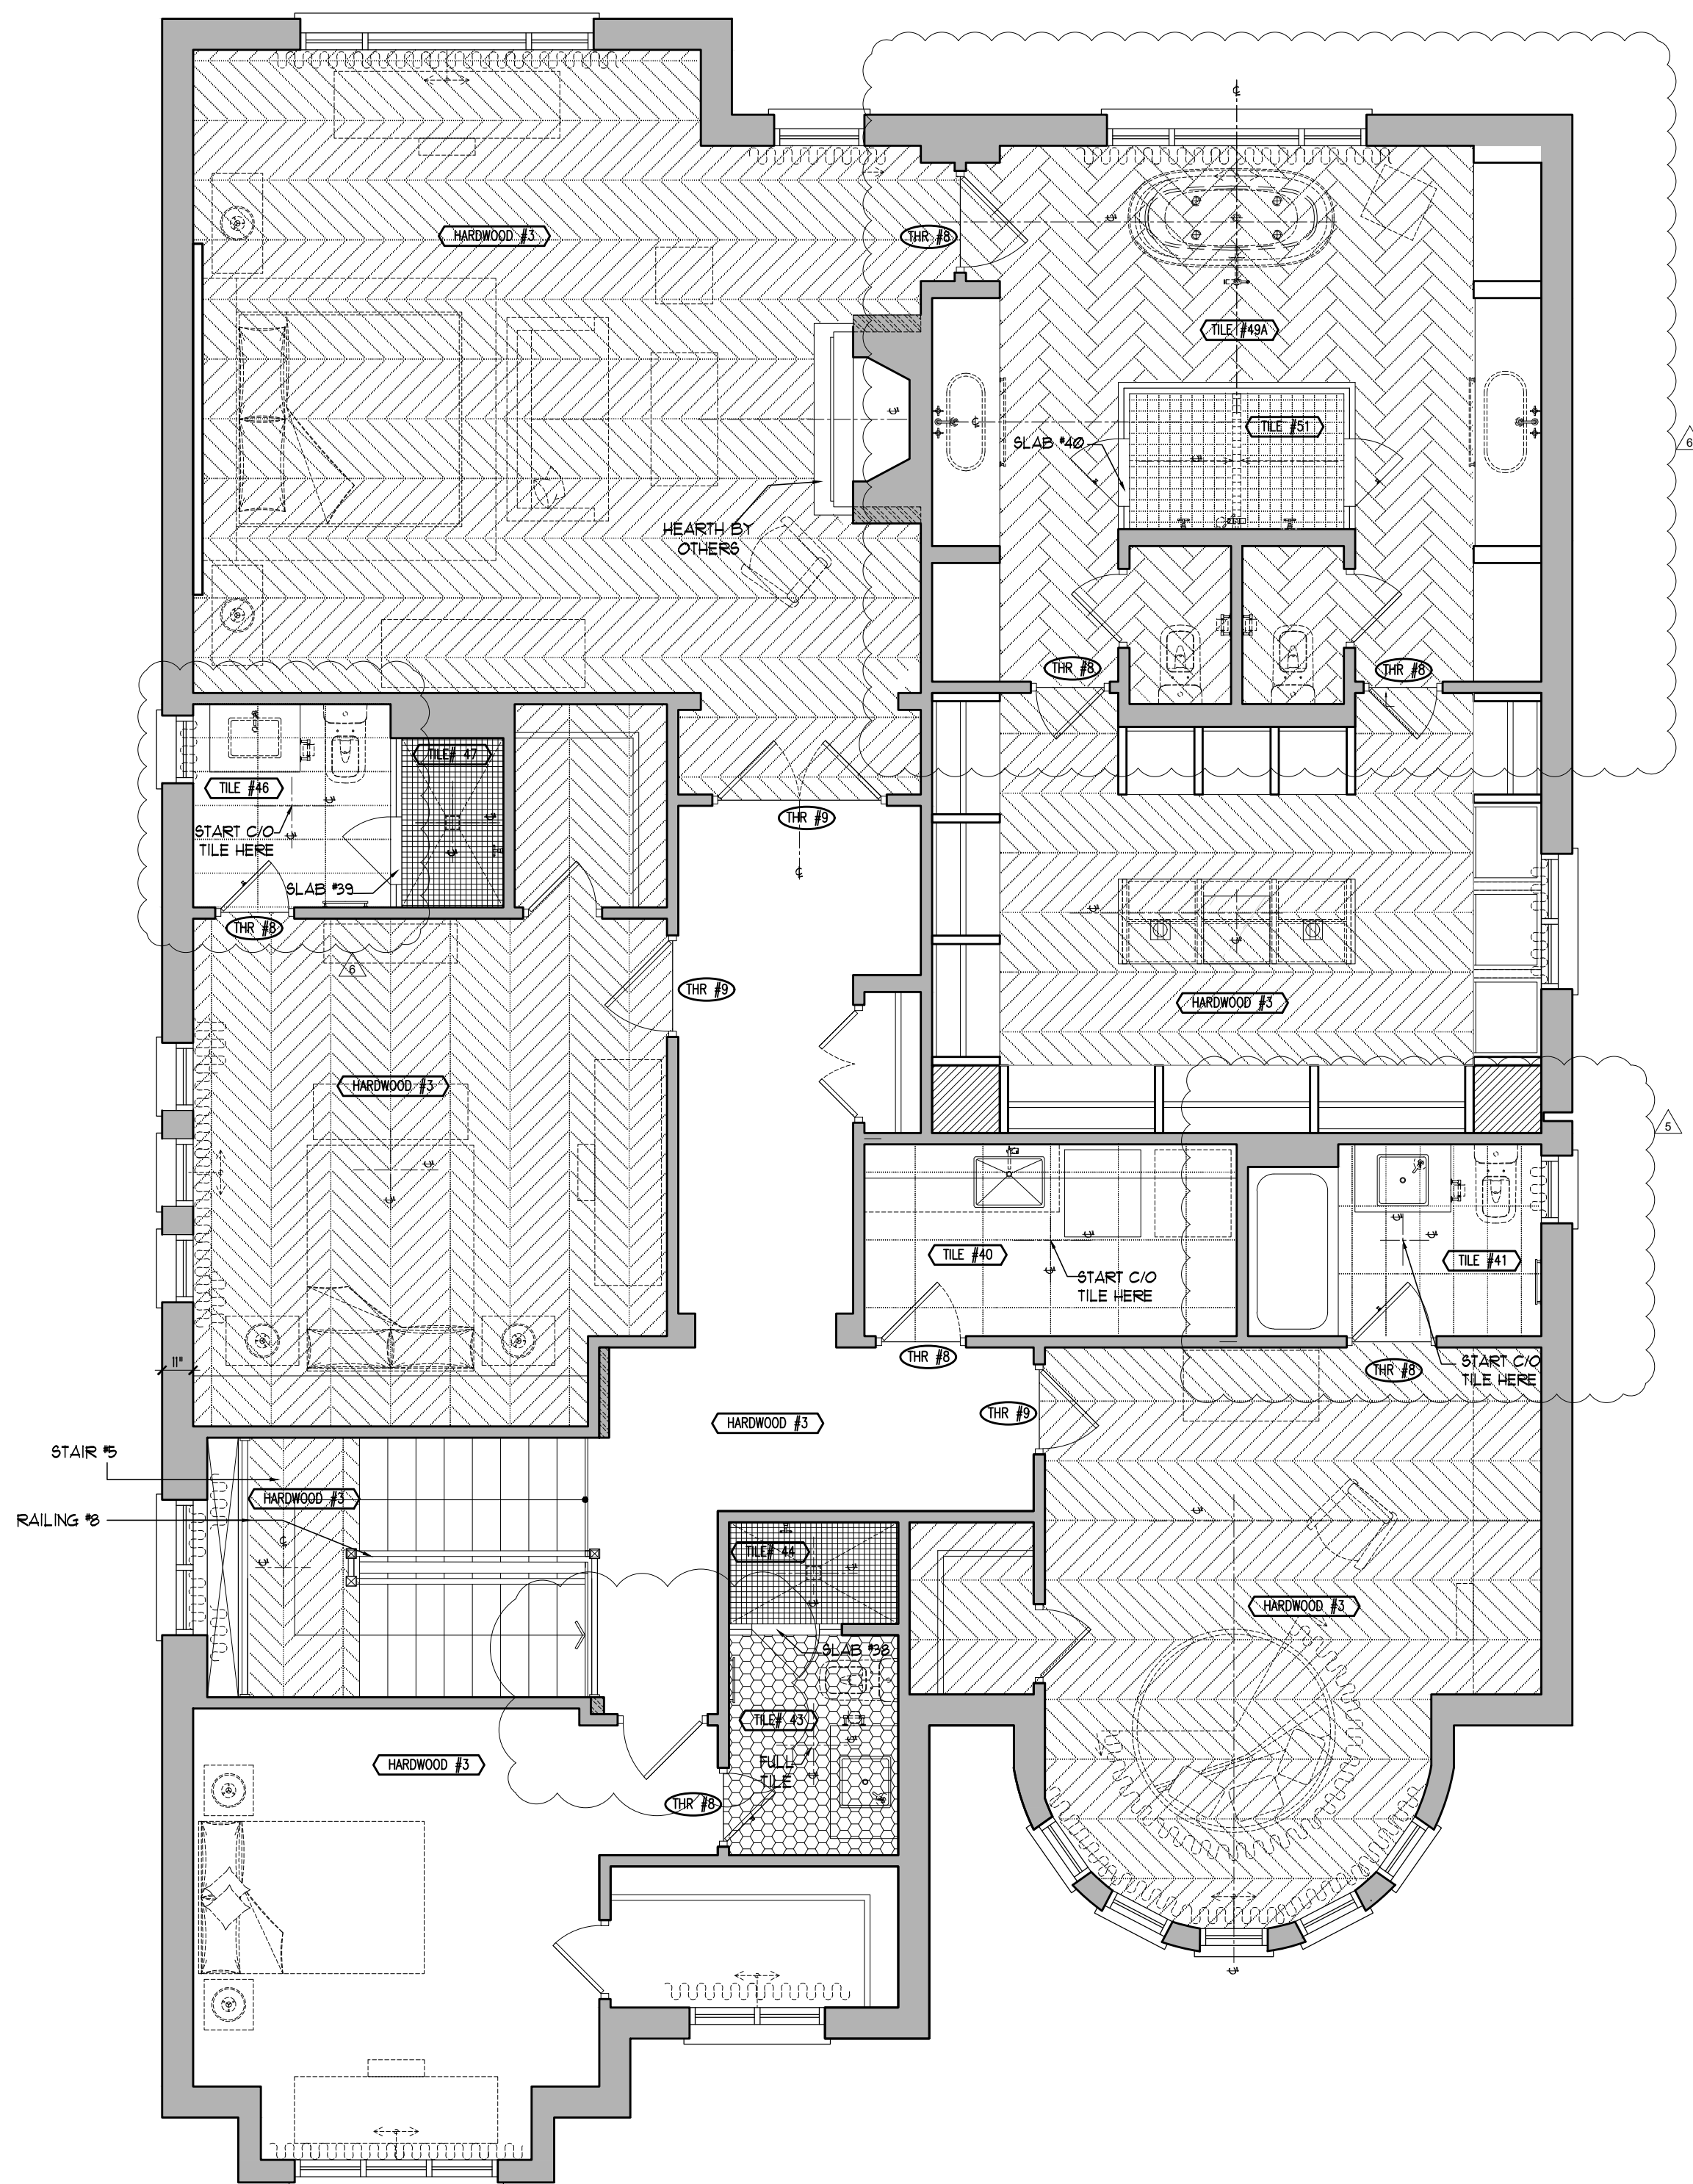

2 SECOND FLOOR
FINISHES PLAN
DT1.2 SCALE: 1:50

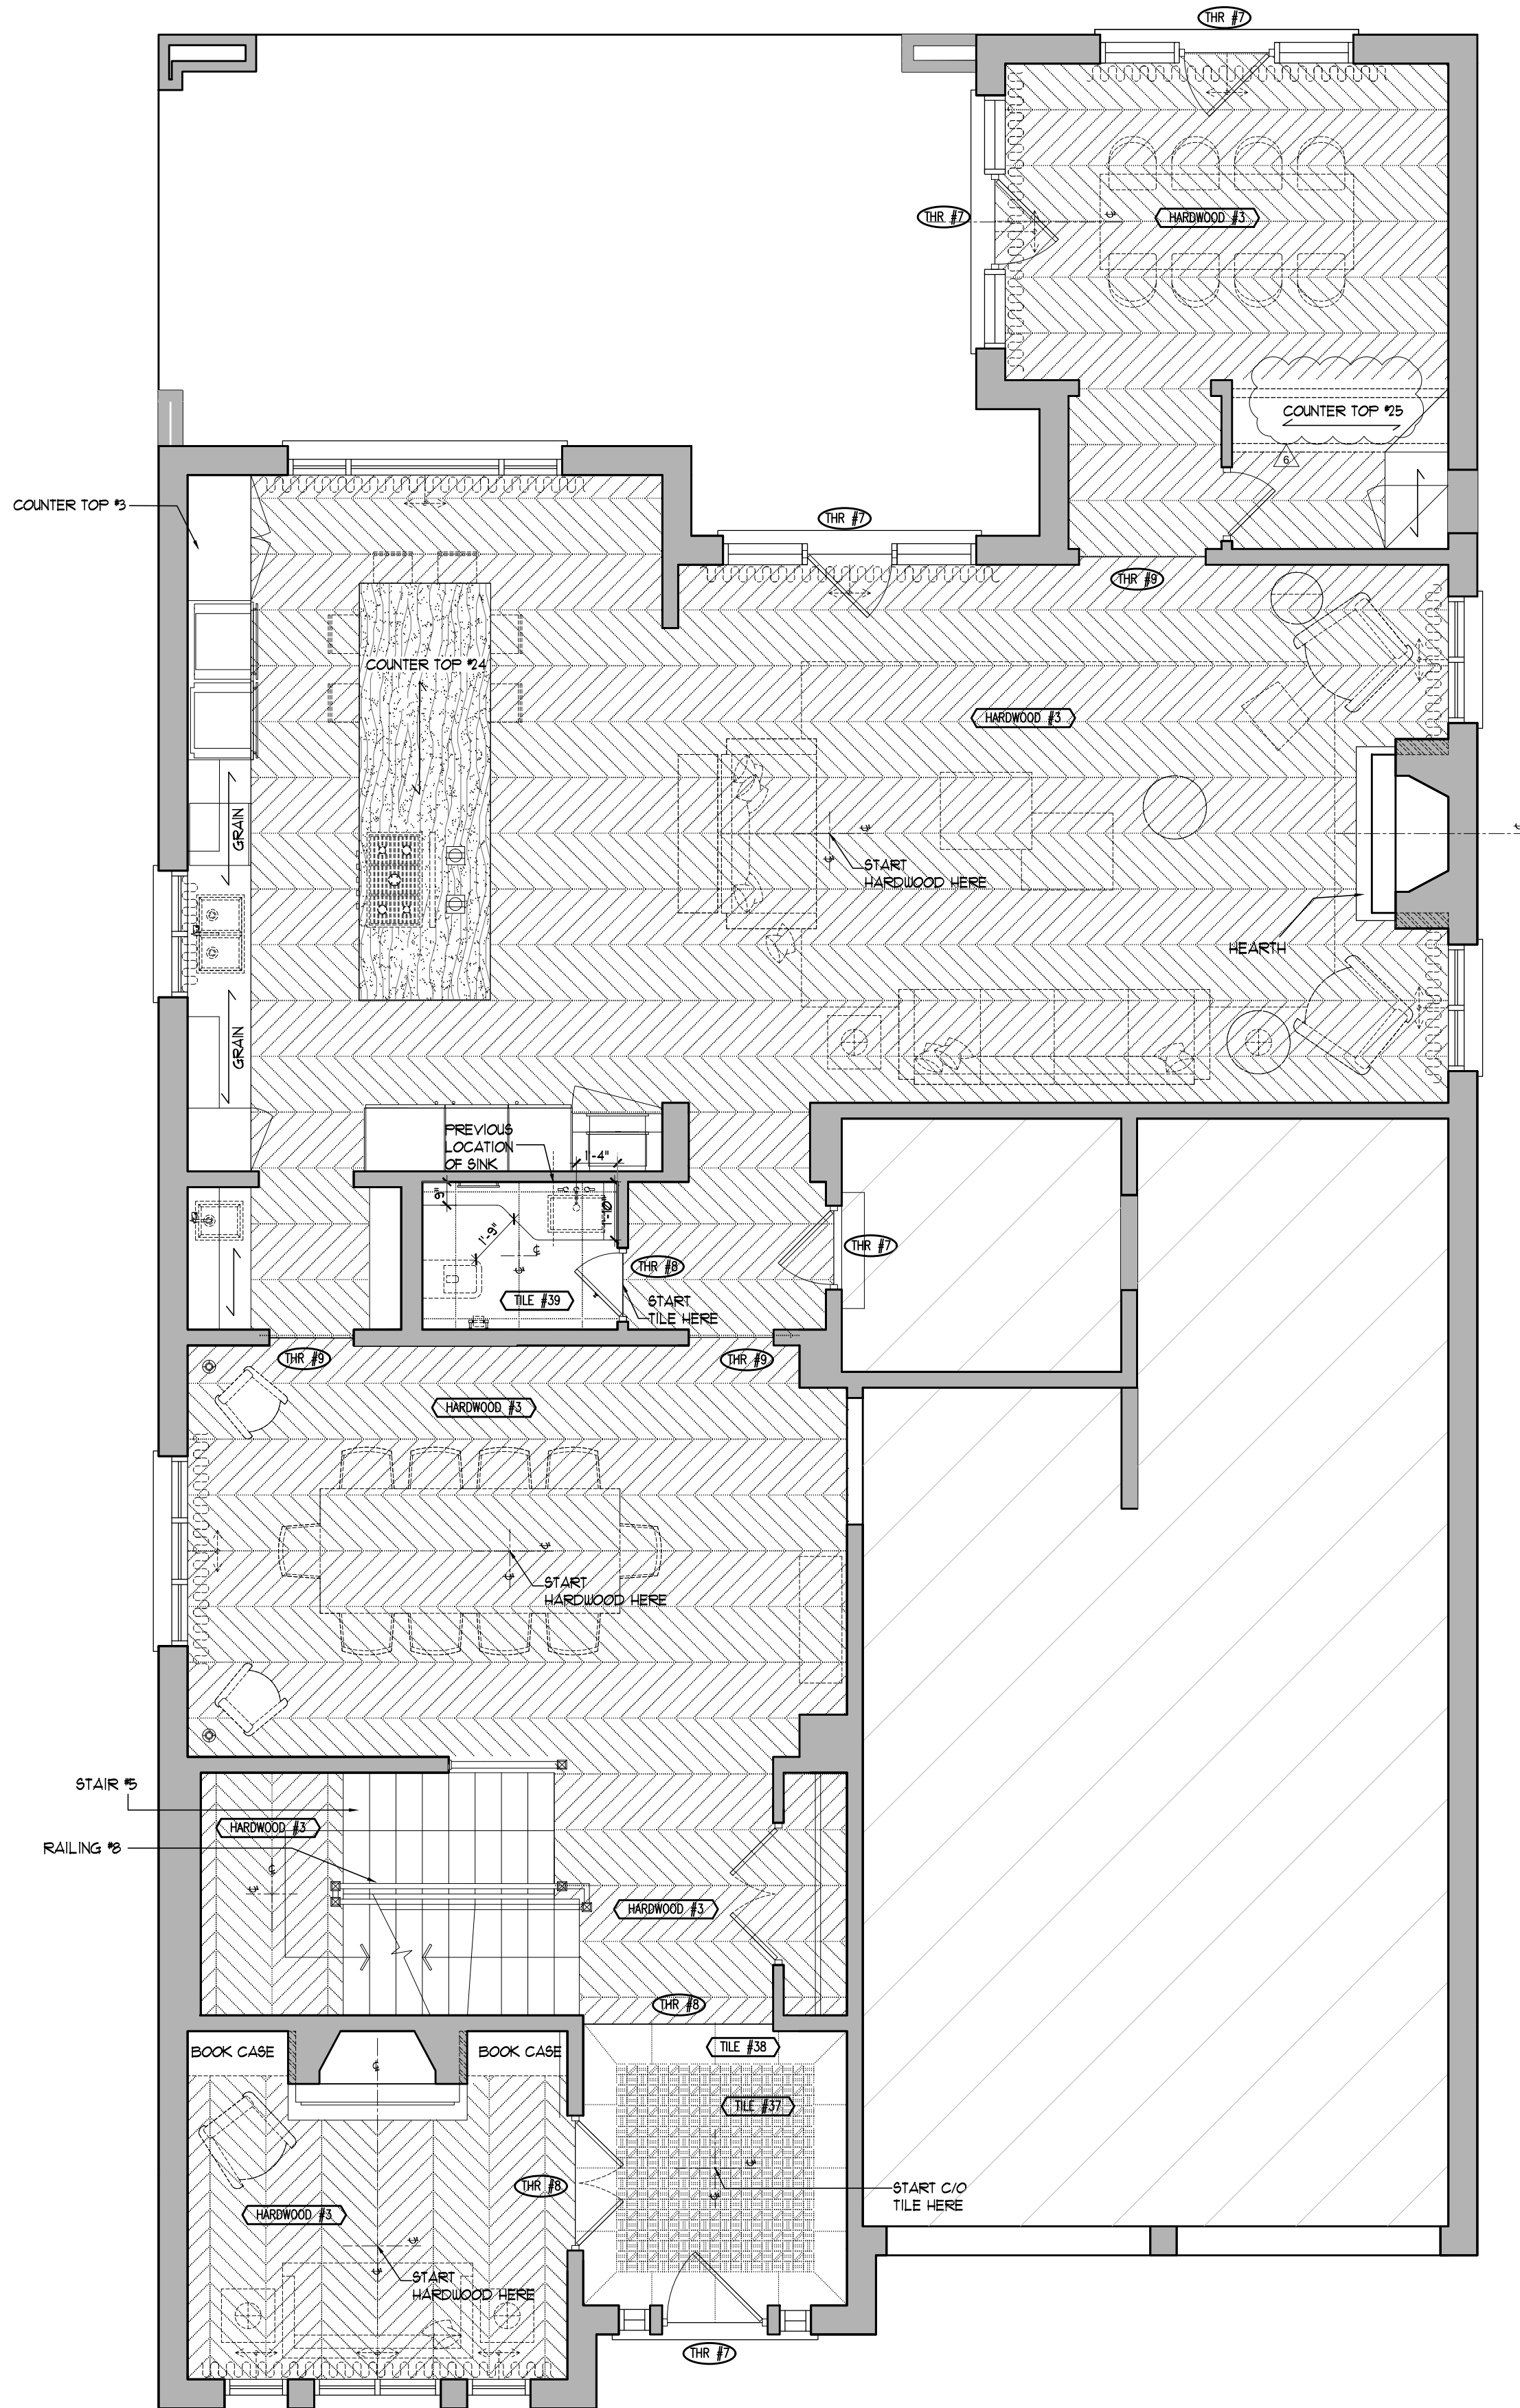

1 FIRST FLOOR
FINISHES PLAN
DT1.1 SCALE: 1:50

4	11/02/2019	ISSUED FOR PRICING FOR TRIM AND MILLWORK	RS	MM
3	10/22/2019	ISSUED FOR PRICING FOR GLASS AND TILES ONLY	HD	MM
2	15/05/2019	ISSUED FOR PLUMBING & APPLIANCES	RG	MM
1	18/04/2019	ISSUED FOR COORDINATION	RG	MM

No.	Date	Issue	Drawn	CHK
-----	------	-------	-------	-----

NOTE: **DONOT SCALE DRAWINGS**
It is the contractor's responsibility to verify all specifications and dimensions and report any discrepancies to the designer prior to construction. Materials may not be substituted without designer's written approval.



PROJECT:
PINEVALLEY
KNIGHTSWOOD, LOT 93
GOLDPARK HOMES
CONCORD, ON



DRAWING:

FINISHES PLAN

DESIGNER'S:

DRAWN BY:

DATE:

SCALE:

PROJECT NO:

2018-10

ID
1.1.2

ISSUED FOR
PLUMBING &
APPLIANCES

No.	Date	Revision	By	CHK
1	18/04/2019	ADJUSTED AS SHOWN	RG	MM
2	15/05/2019	ADJUSTED AS SHOWN	RG	MM
3	24/05/2019	ADJUSTED AS SHOWN	RG	MM
4	11/06/2019	ADJUSTED AS SHOWN	RG	MM
5	11/06/2019	CHANGE NOTICE #9	RS	MM
6	02/06/20	CHANGE NOTICE #10	NVRS	MM



No.	Date	Issue	By	CHK
4	11/02/2019	ISSUED FOR PRICING FOR TRIM AND MILLWORK	RS	MM
3	10/22/2019	ISSUED FOR PRICING FOR SLAB AND TILE ONLY	HD	MM
2	15/05/2019	ISSUED FOR PLUMBING & APPLIANCES	RG	MM
1	18/04/2019	ISSUED FOR COORDINATION	RG	MM

NOTE: **DON'T SCALE DRAWINGS**
It is the contractor's responsibility to verify all specifications and dimensions and report any discrepancies to the designer prior to construction. Materials may not be substituted without designer's written approval.




PROJECT:
PINEVALLEY
KNIGHTSWOOD, LOT 93

GOLDPARK HOMES
CONCORD, ON

BATHROOM
ELEVATIONS

DESIGNER'S:
MIKE NIVEN
DRAWN BY:
M-Tec Inc.
DATE:
FEB 2019
SCALE:
1:25
PROJECT NO:
2018-10















ID
2.0.0

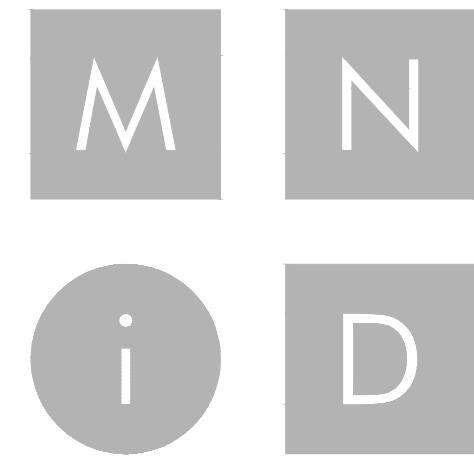

MIKE NIVEN INTERIOR DESIGN INC.
100 BROADVIEW AVE. S. 3RD FLOOR, TORONTO, ONT. M4M 3B3
TEL: 416.763.7404 • FAX: 416.763.7404

ISSUED FOR
PLUMBING &
APPLIANCES

No.	Date	Revision	Drawn	CHK
1	18/04/2019	ADJUSTED AS SHOWN	RG	MM
2	15/05/2019	ADJUSTED AS SHOWN	RG	MM
3	24/05/2019	ADJUSTED AS SHOWN	RG	MM
4	11/06/2019	ADJUSTED AS SHOWN	RG	MM
5	10/03/2019	CHANGE NOTICE #8	WV	MM
6	11/03/2019	CHANGE NOTICE #9	RS	MM
7	02/2020	CHANGE NOTICE #10	NVRS	MM

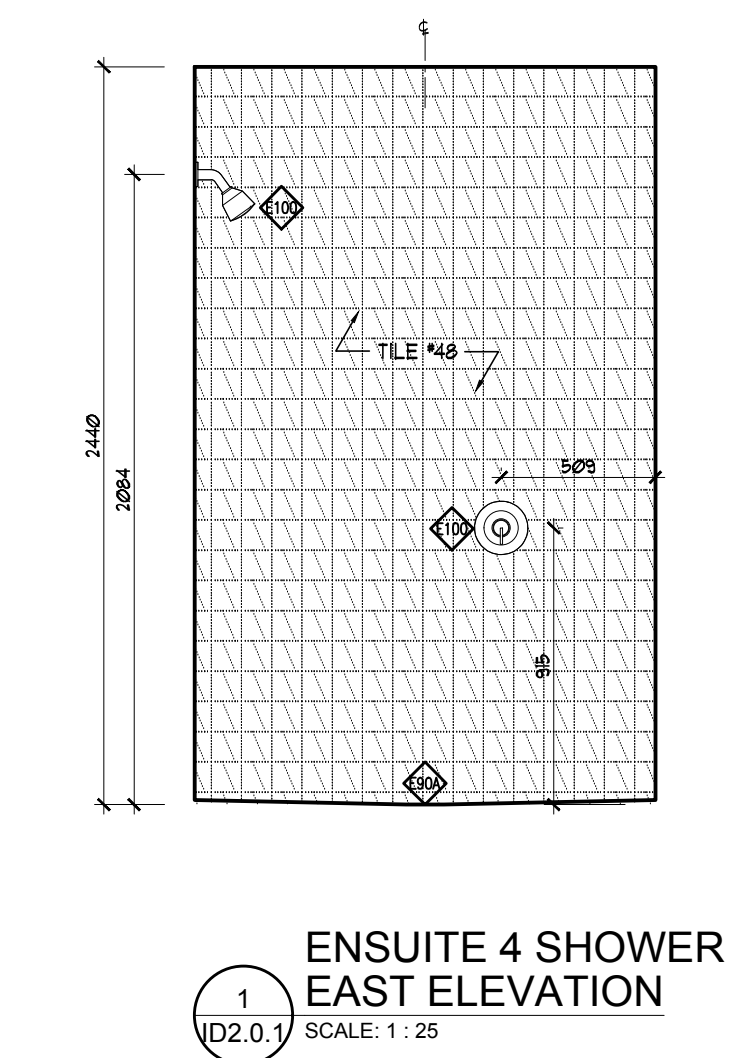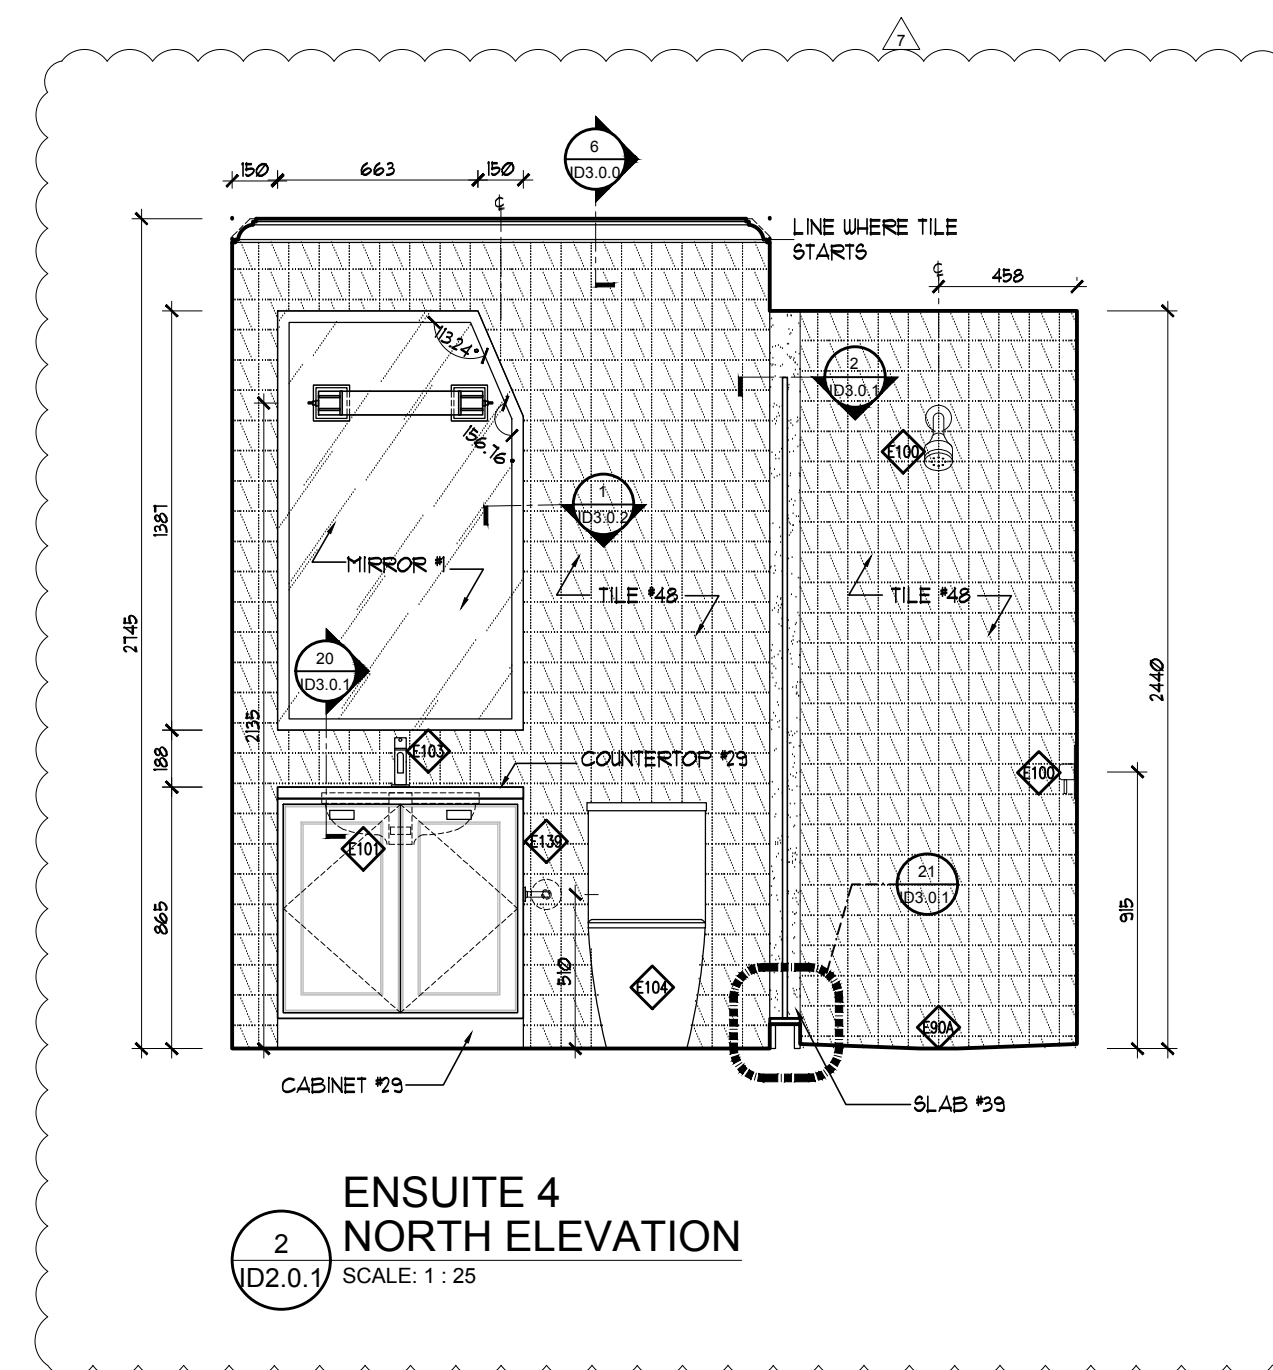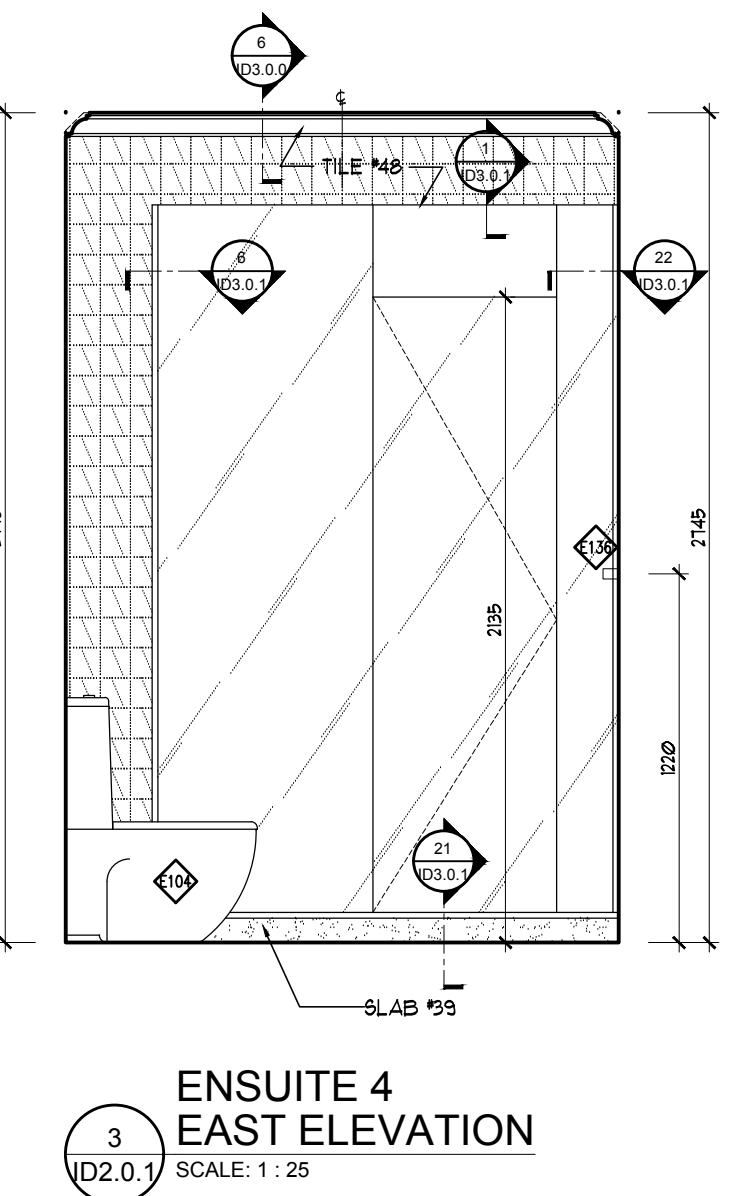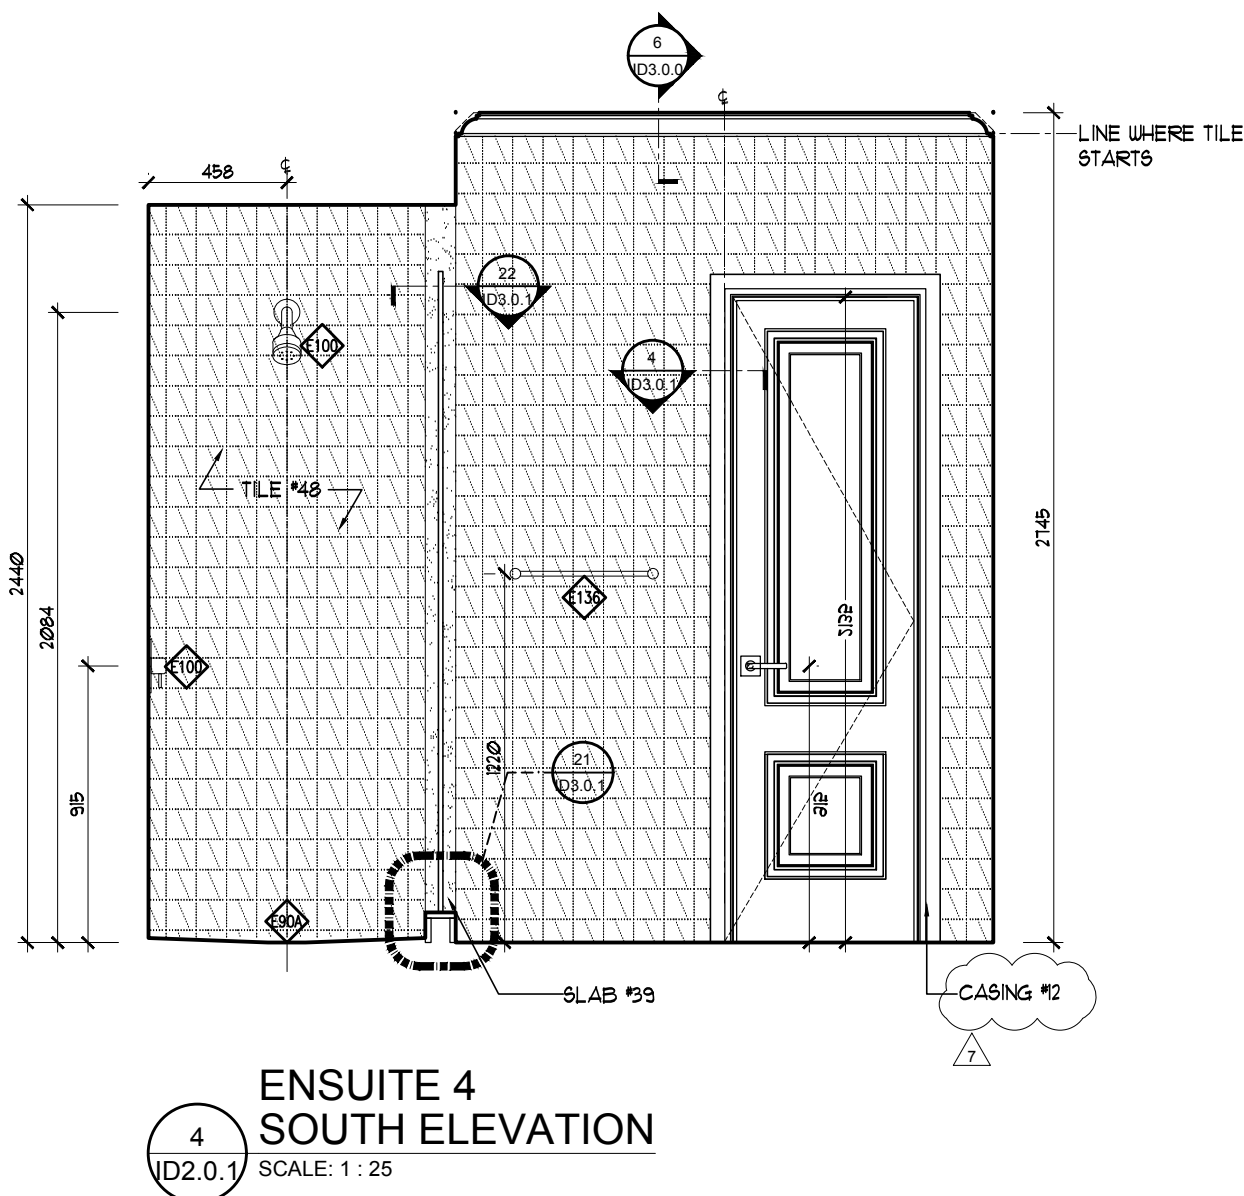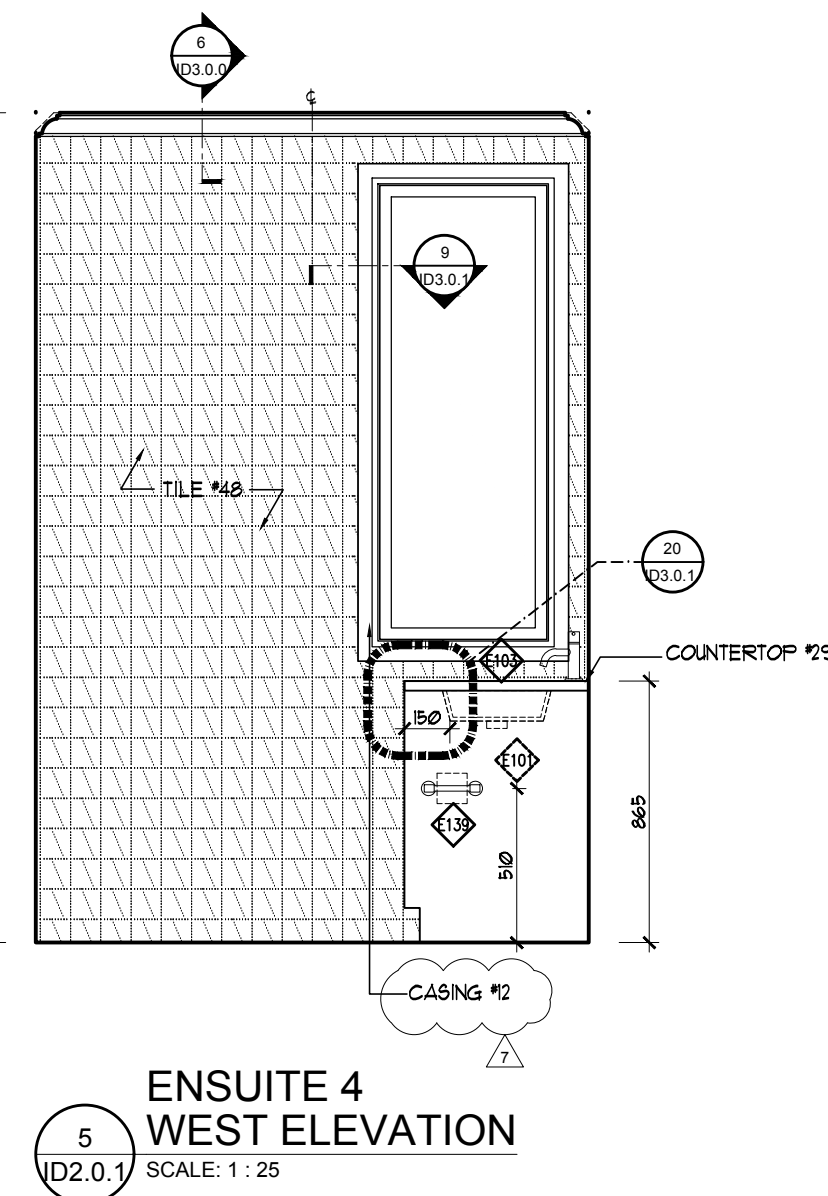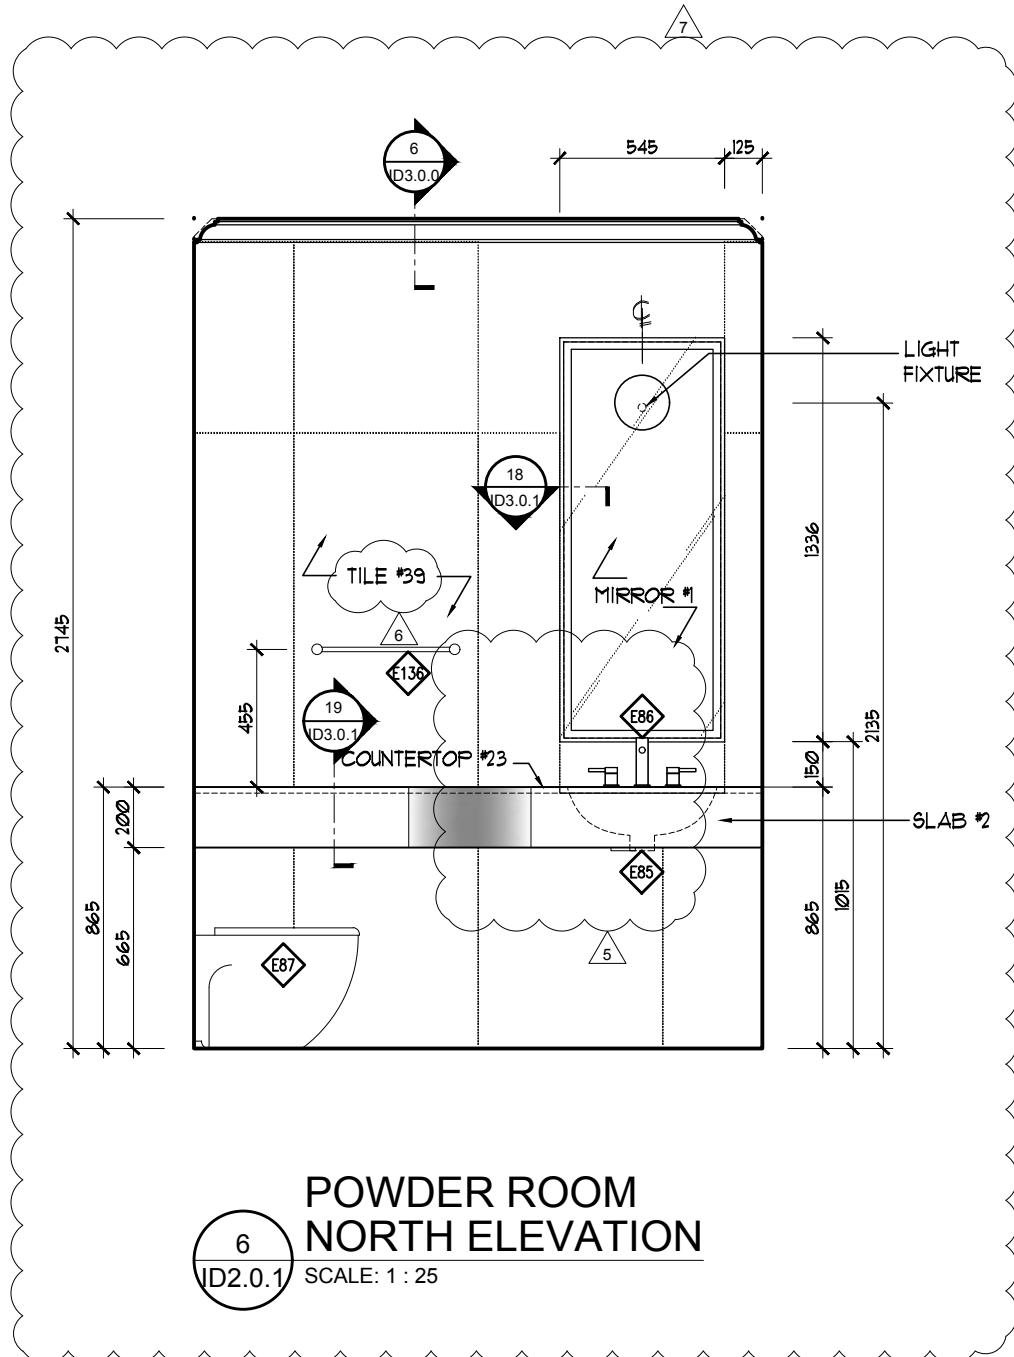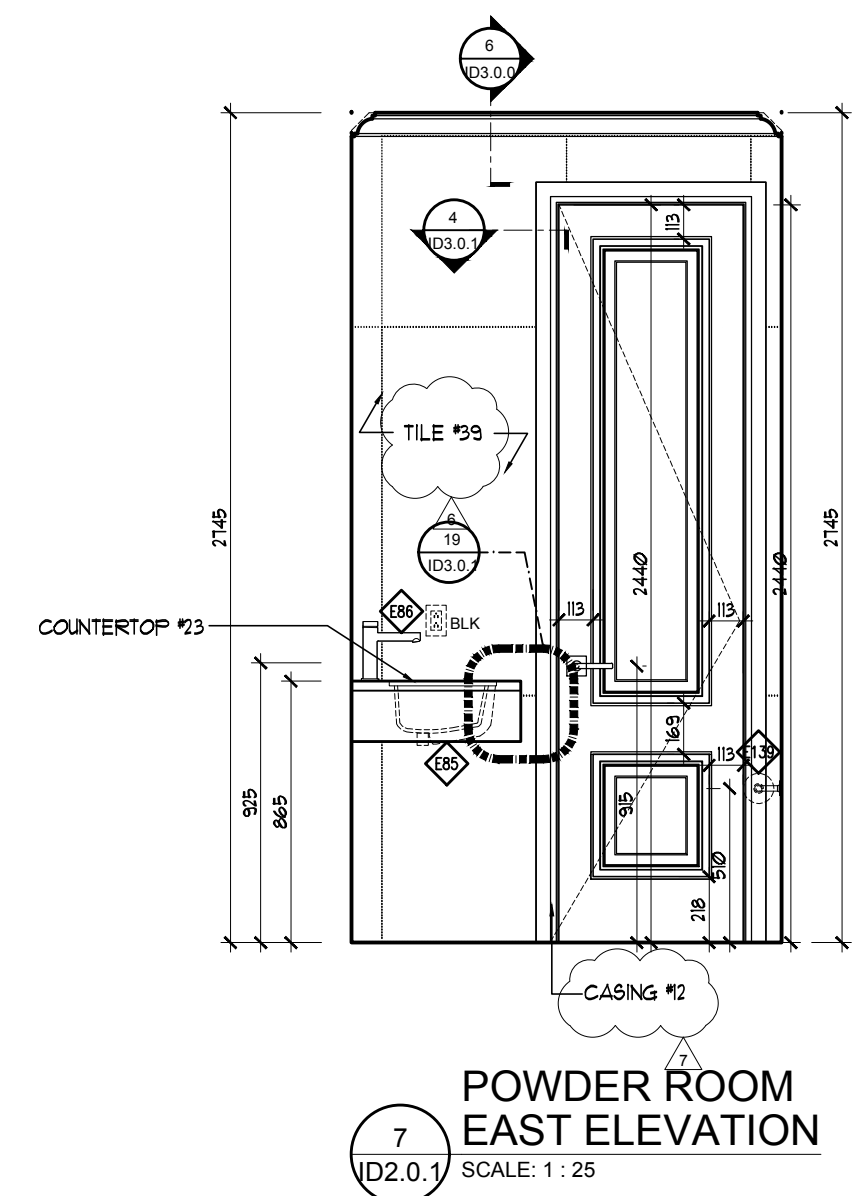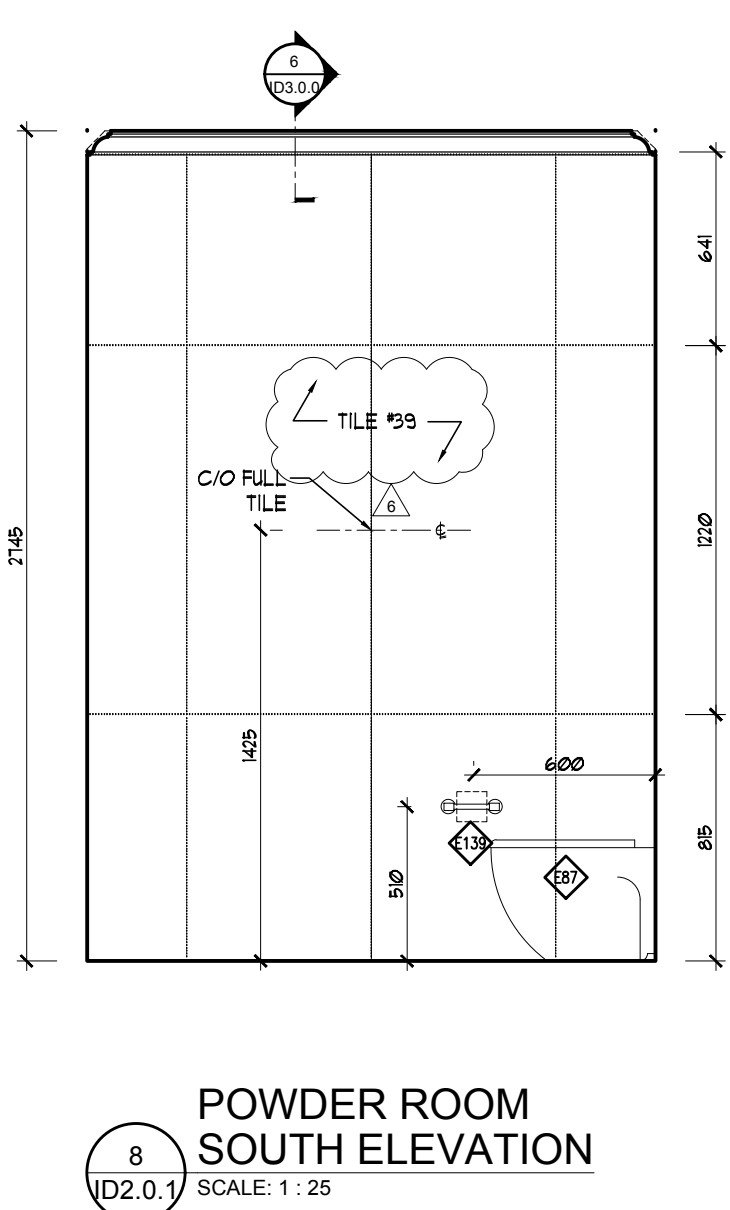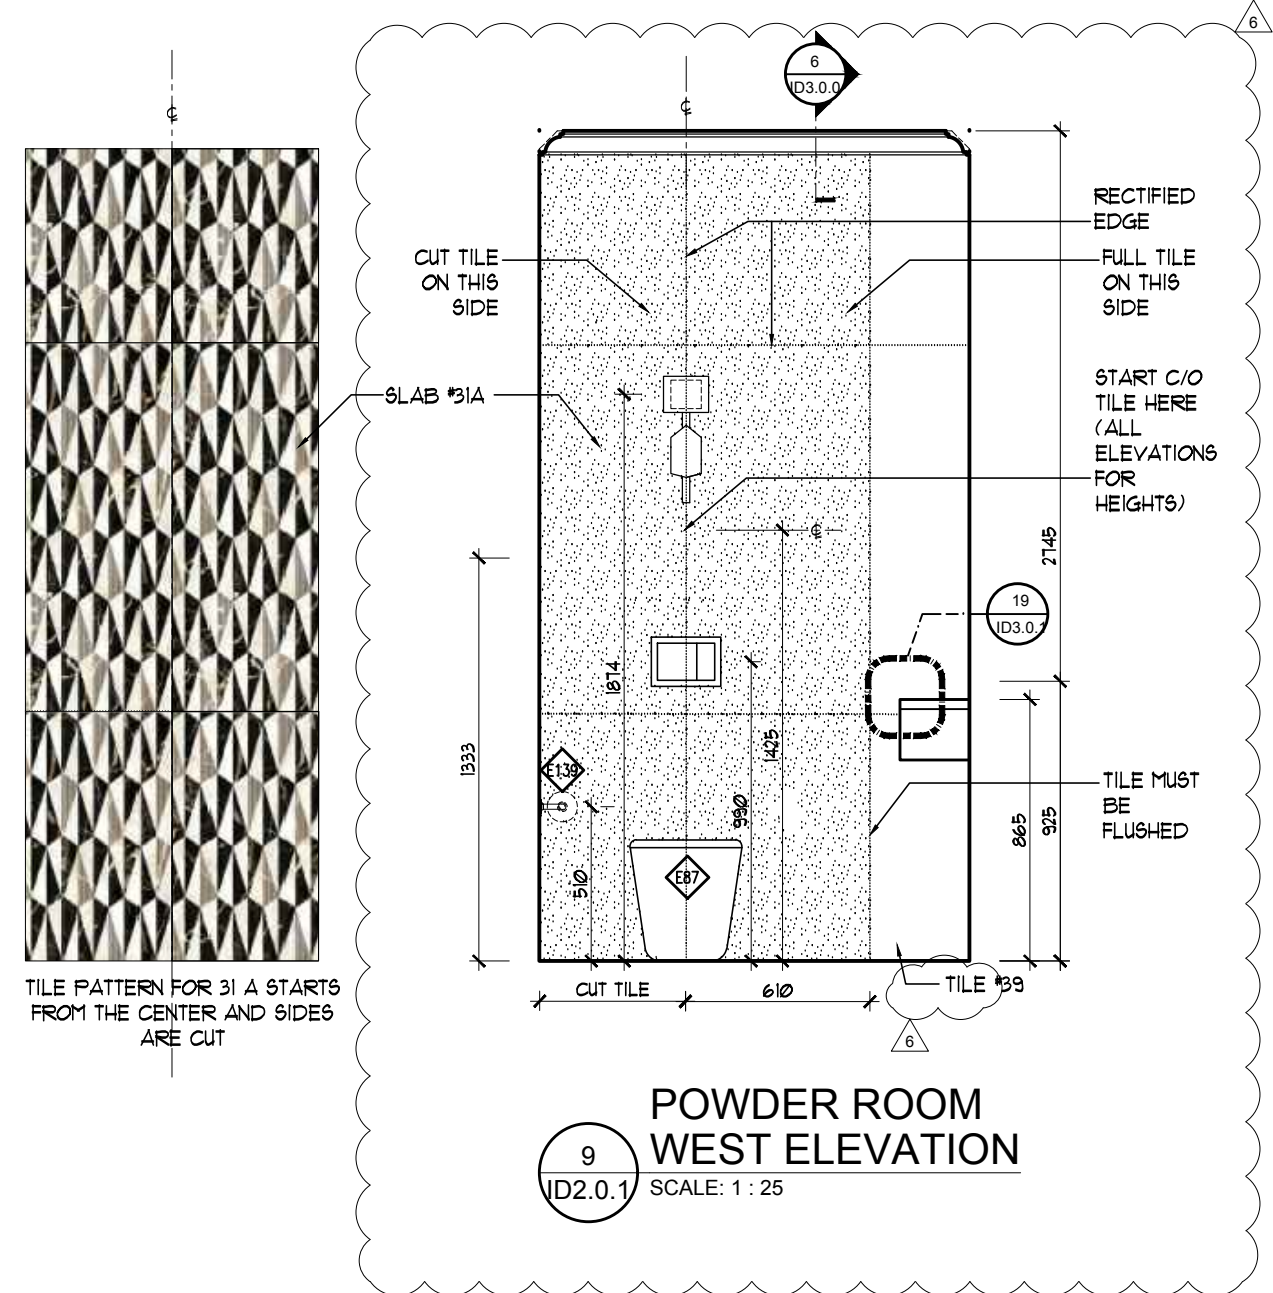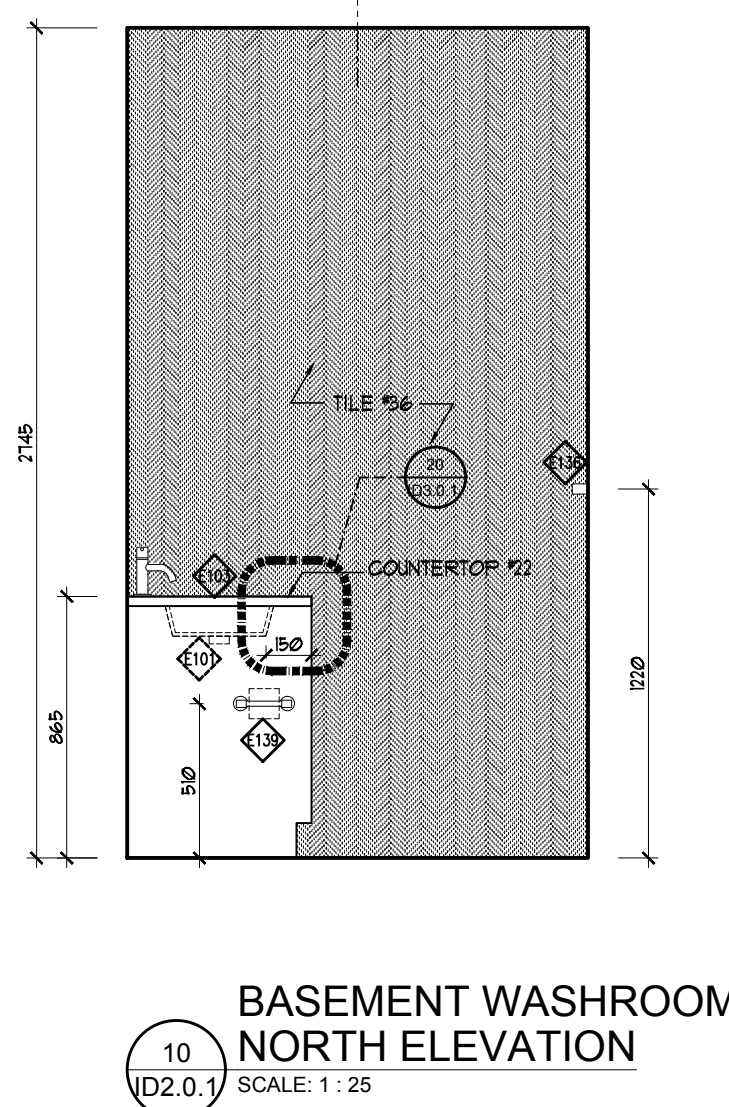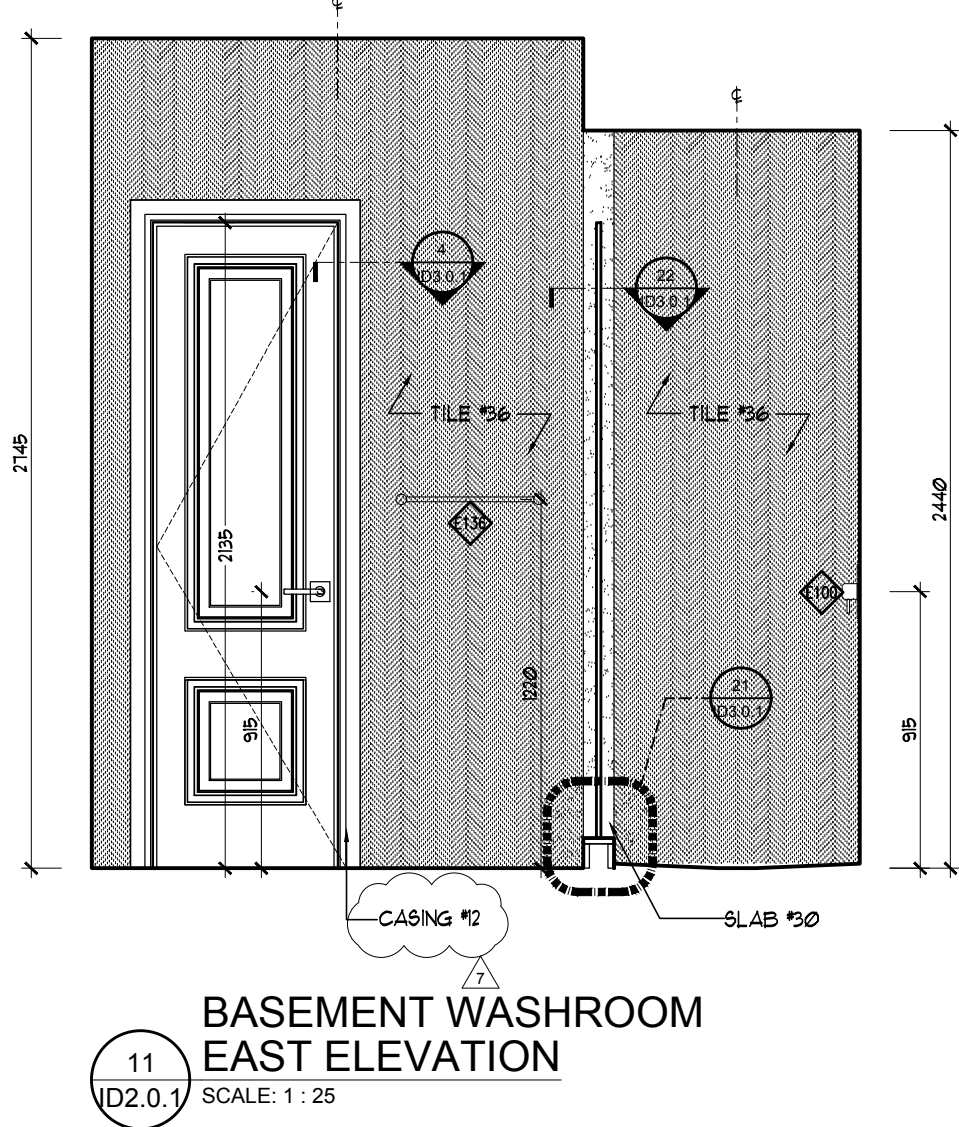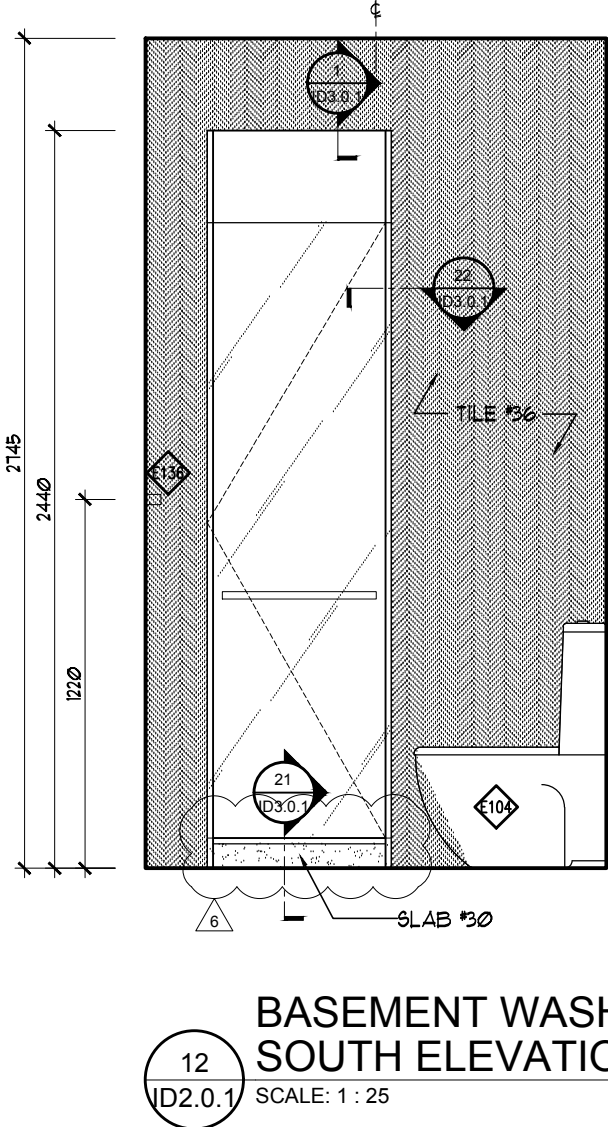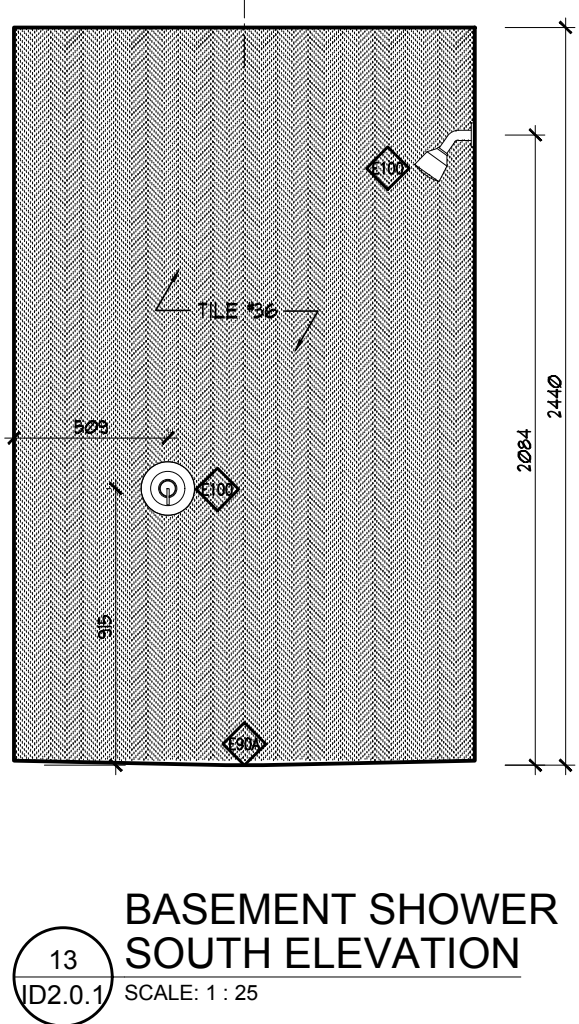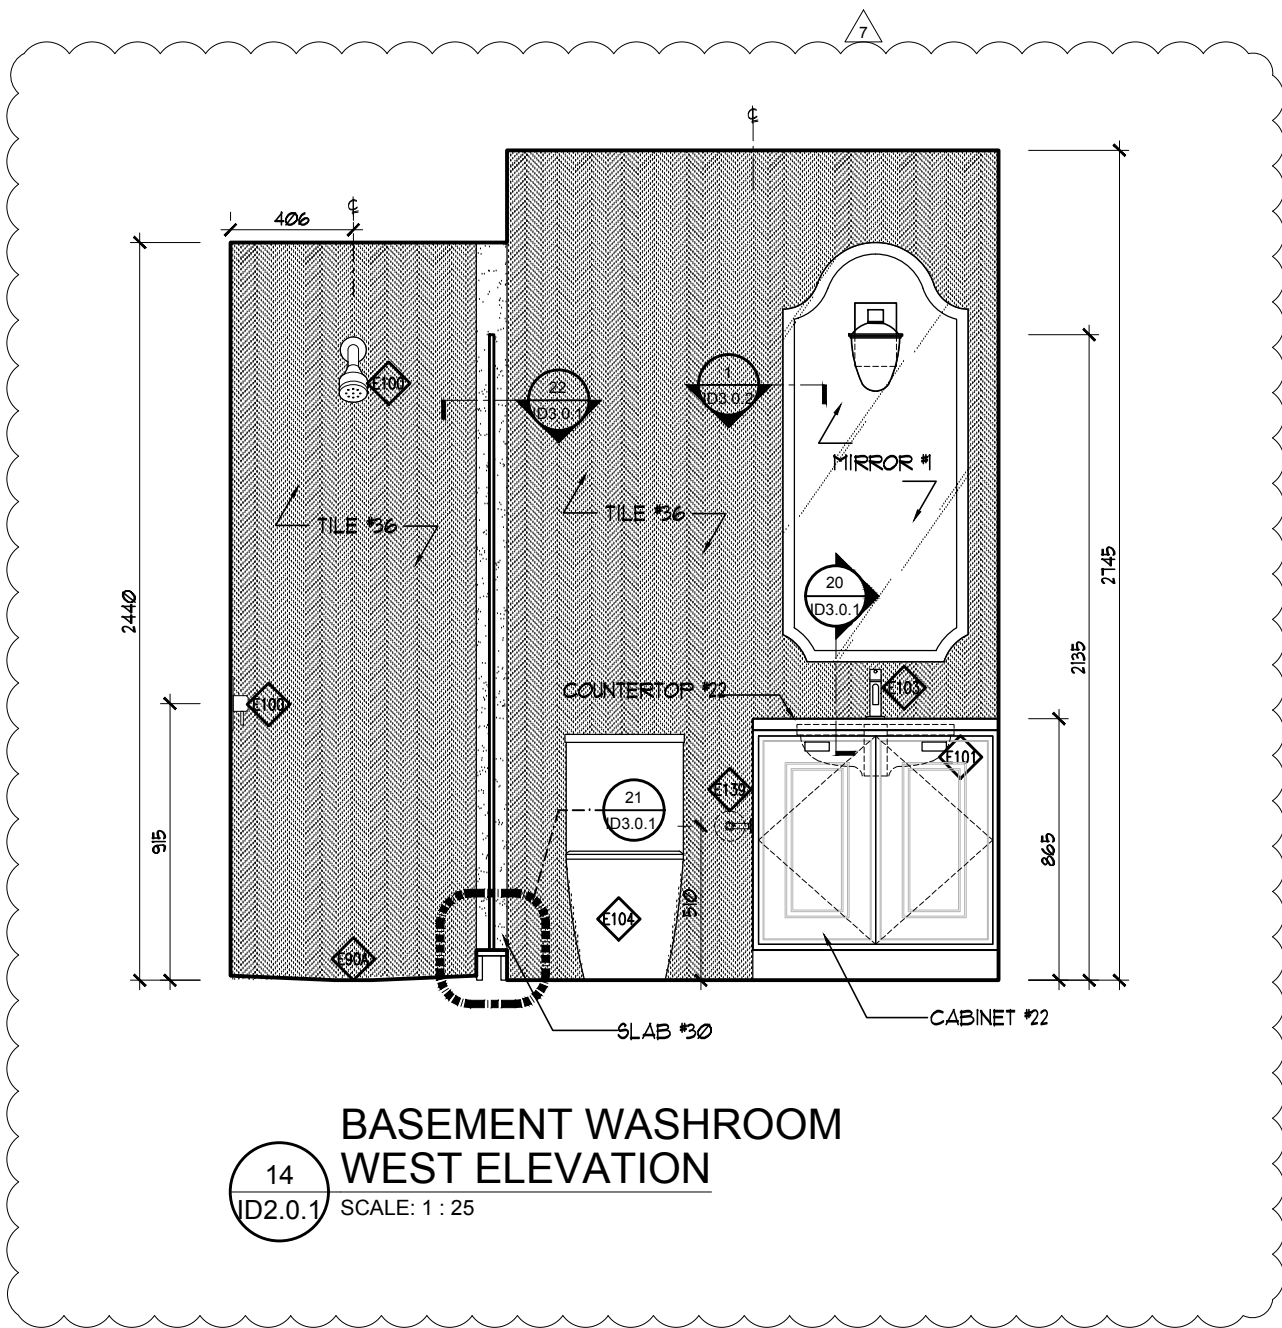

4	11/03/2019	ISSUED FOR PRICING FOR TRIM AND MILLWORK	RS	MM
3	10/03/2019	ISSUED FOR PRICING FOR SLAB AND TILE ONLY	HD	MM
2	15/05/2019	ISSUED FOR PLUMBING & APPLIANCES	RG	MM
1	18/04/2019	ISSUED FOR COORDINATION	RG	MM

No.	Date	Issue	Drawn	CHK
-----	------	-------	-------	-----

NOTE: **DON'T SCALE DRAWINGS**
It is the contractor's responsibility to verify all specifications and dimensions and report any discrepancies to the designer prior to construction. Materials may not be substituted without designer's written approval.



PROJECT:
PINEVALLEY
KNIGHTSWOOD, LOT 93
GOLDPARK HOMES
CONCORD, ON
DRAWING:
BATHROOM
ELEVATIONS

DESIGNER:
MIKE NIVEN
DRAWN BY:
M-Tec Inc.
DATE:
FEB 2019
SCALE:
1:25
PROJECT NO:
2018-10


ID
2.0.1




MIKE NIVEN INTERIOR DESIGN INC.
100 BROADVIEW AVE. S. 3RD FLOOR, TORONTO, CANADA M4M 3B3
TEL: 416.763.7404 • FAX: 416.763.7404

ISSUED FOR
PLUMBING &
APPLIANCES


No.	Date	Revision	By	CHK
1	18/04/2019	ADJUSTED AS SHOWN	RG	MN
2	15/05/2019	ADJUSTED AS SHOWN	RG	MN
3	24/05/2019	ADJUSTED AS SHOWN	RG	MN
4	11/06/2019	ADJUSTED AS SHOWN	RG	MN
5	11/06/2019	CHANGE NOTICE #9	RS	MN

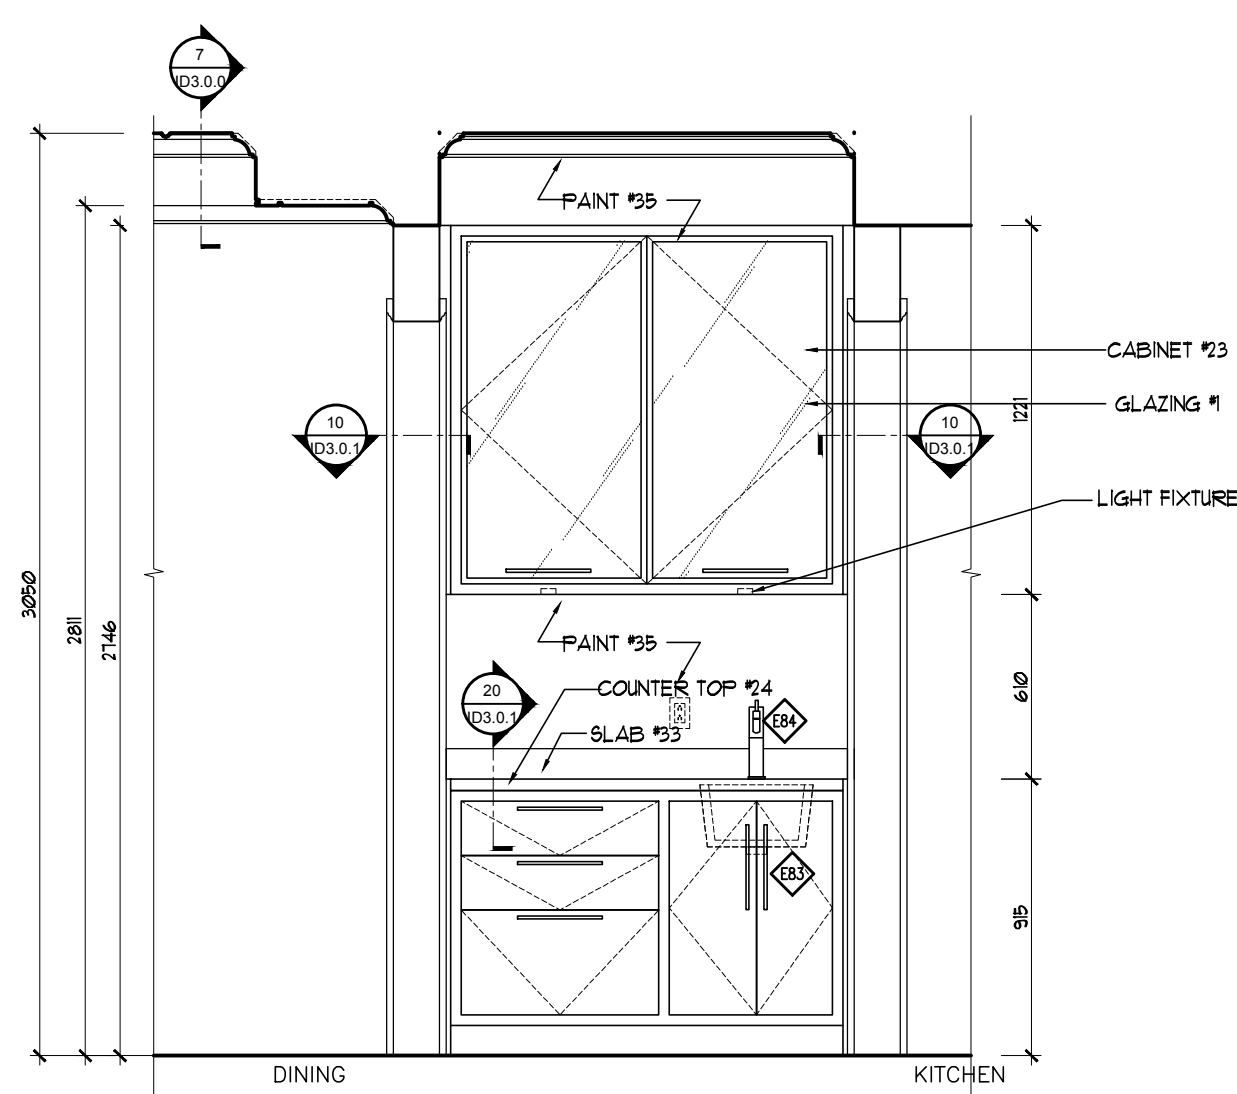


SERVEDY
WEST ELEVATION
16
02.0.2 SCALE: 1:25

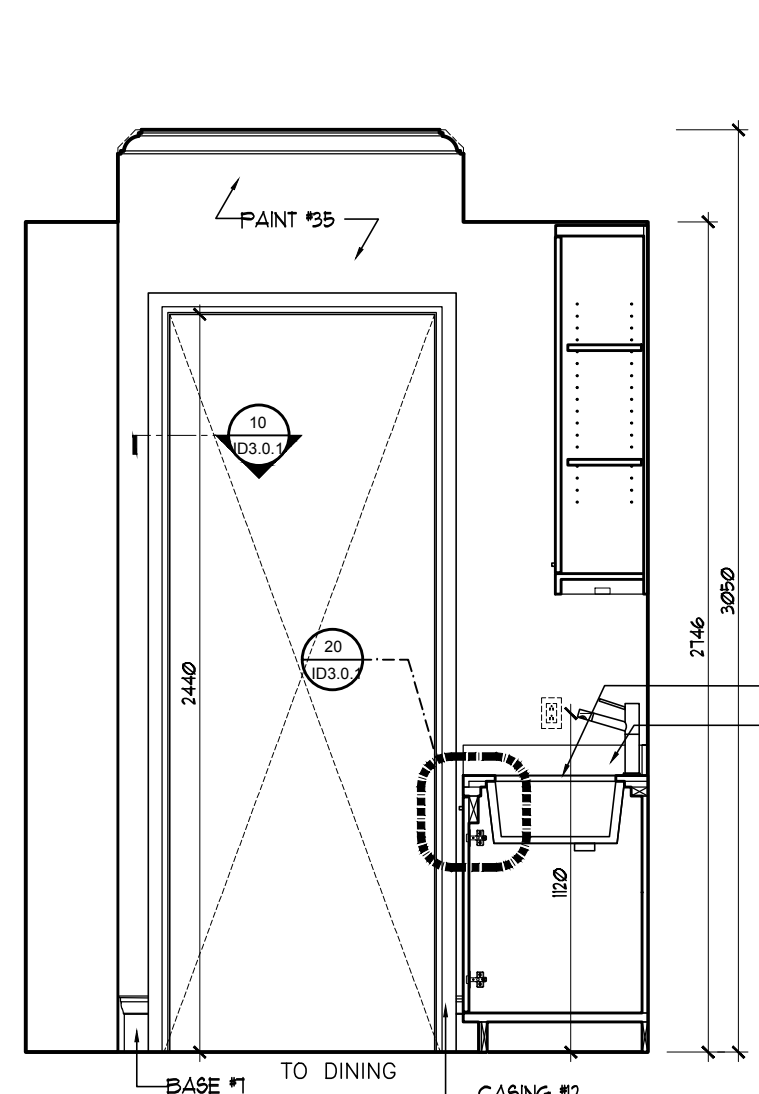


SERVEDY
SOUTH ELEVATION
15
02.0.2 SCALE: 1:25

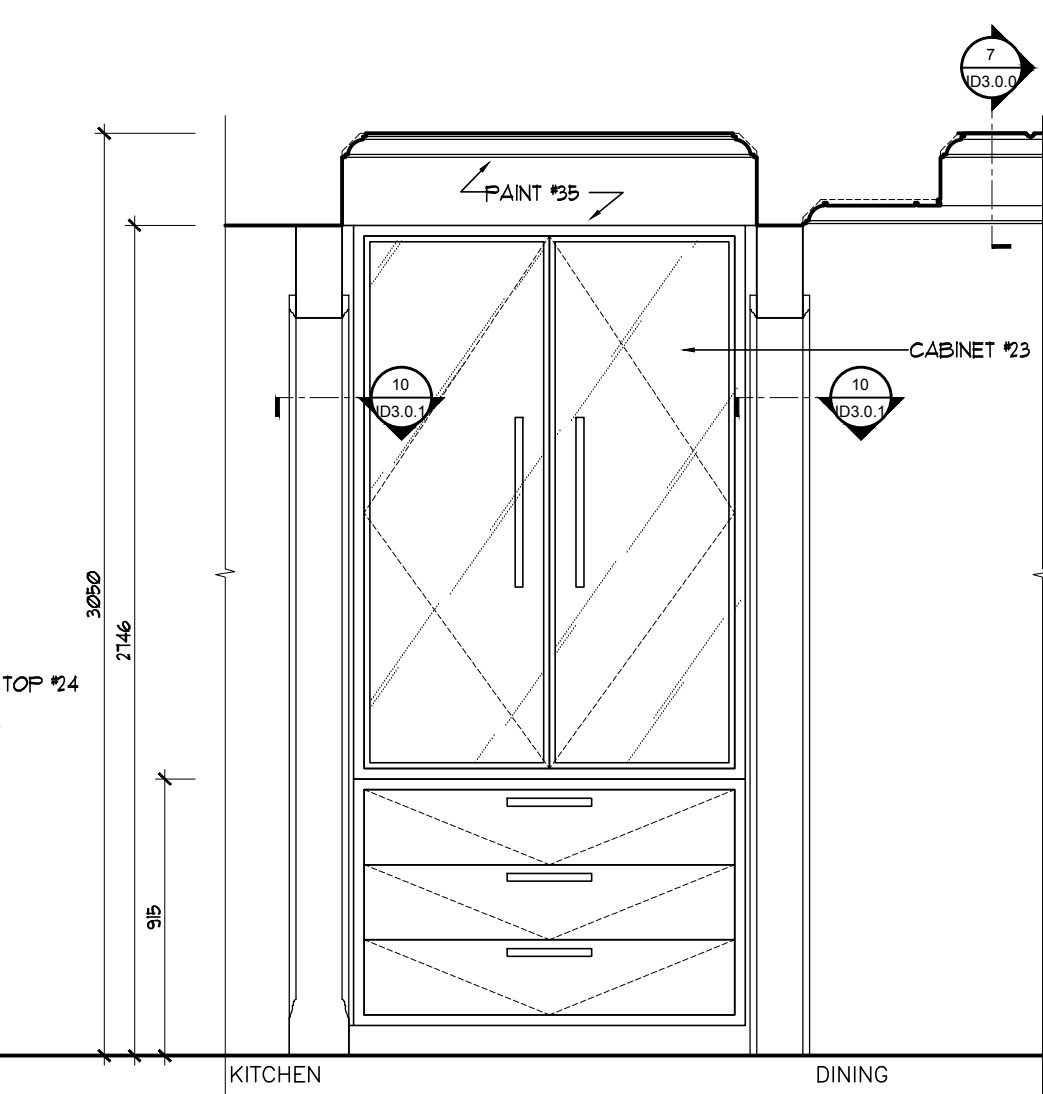


SERVEDY
EAST ELEVATION
14
02.0.2 SCALE: 1:25

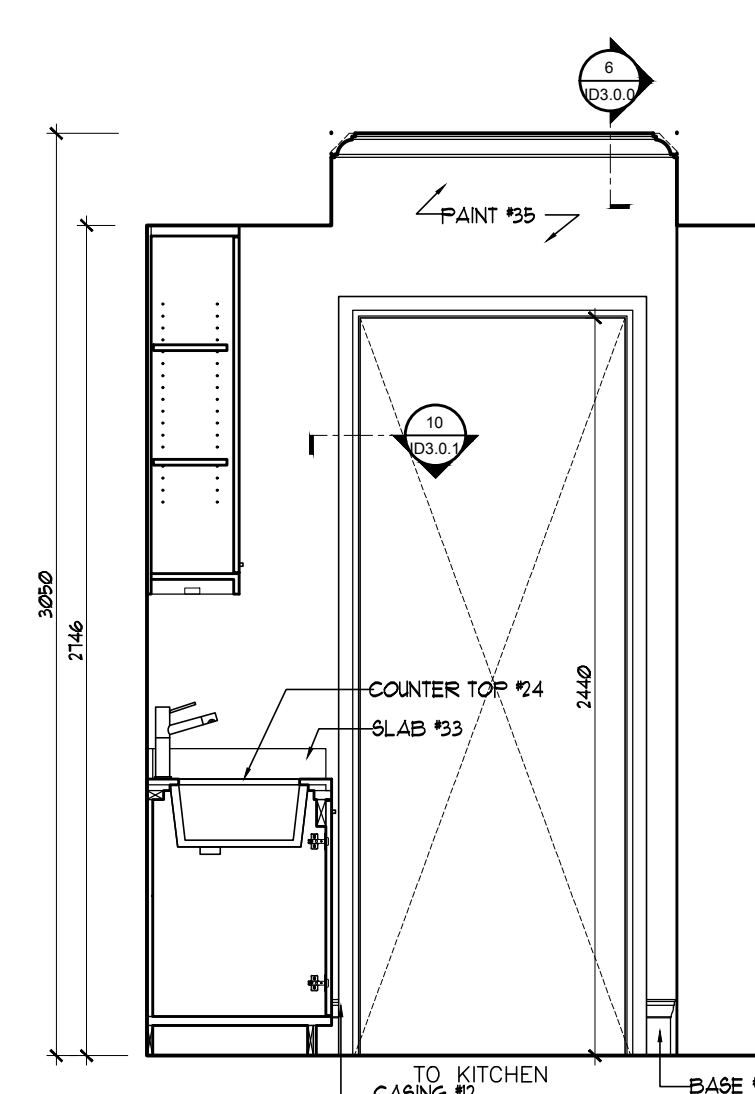


SERVEDY
NORTH ELEVATION
13
02.0.2 SCALE: 1:25

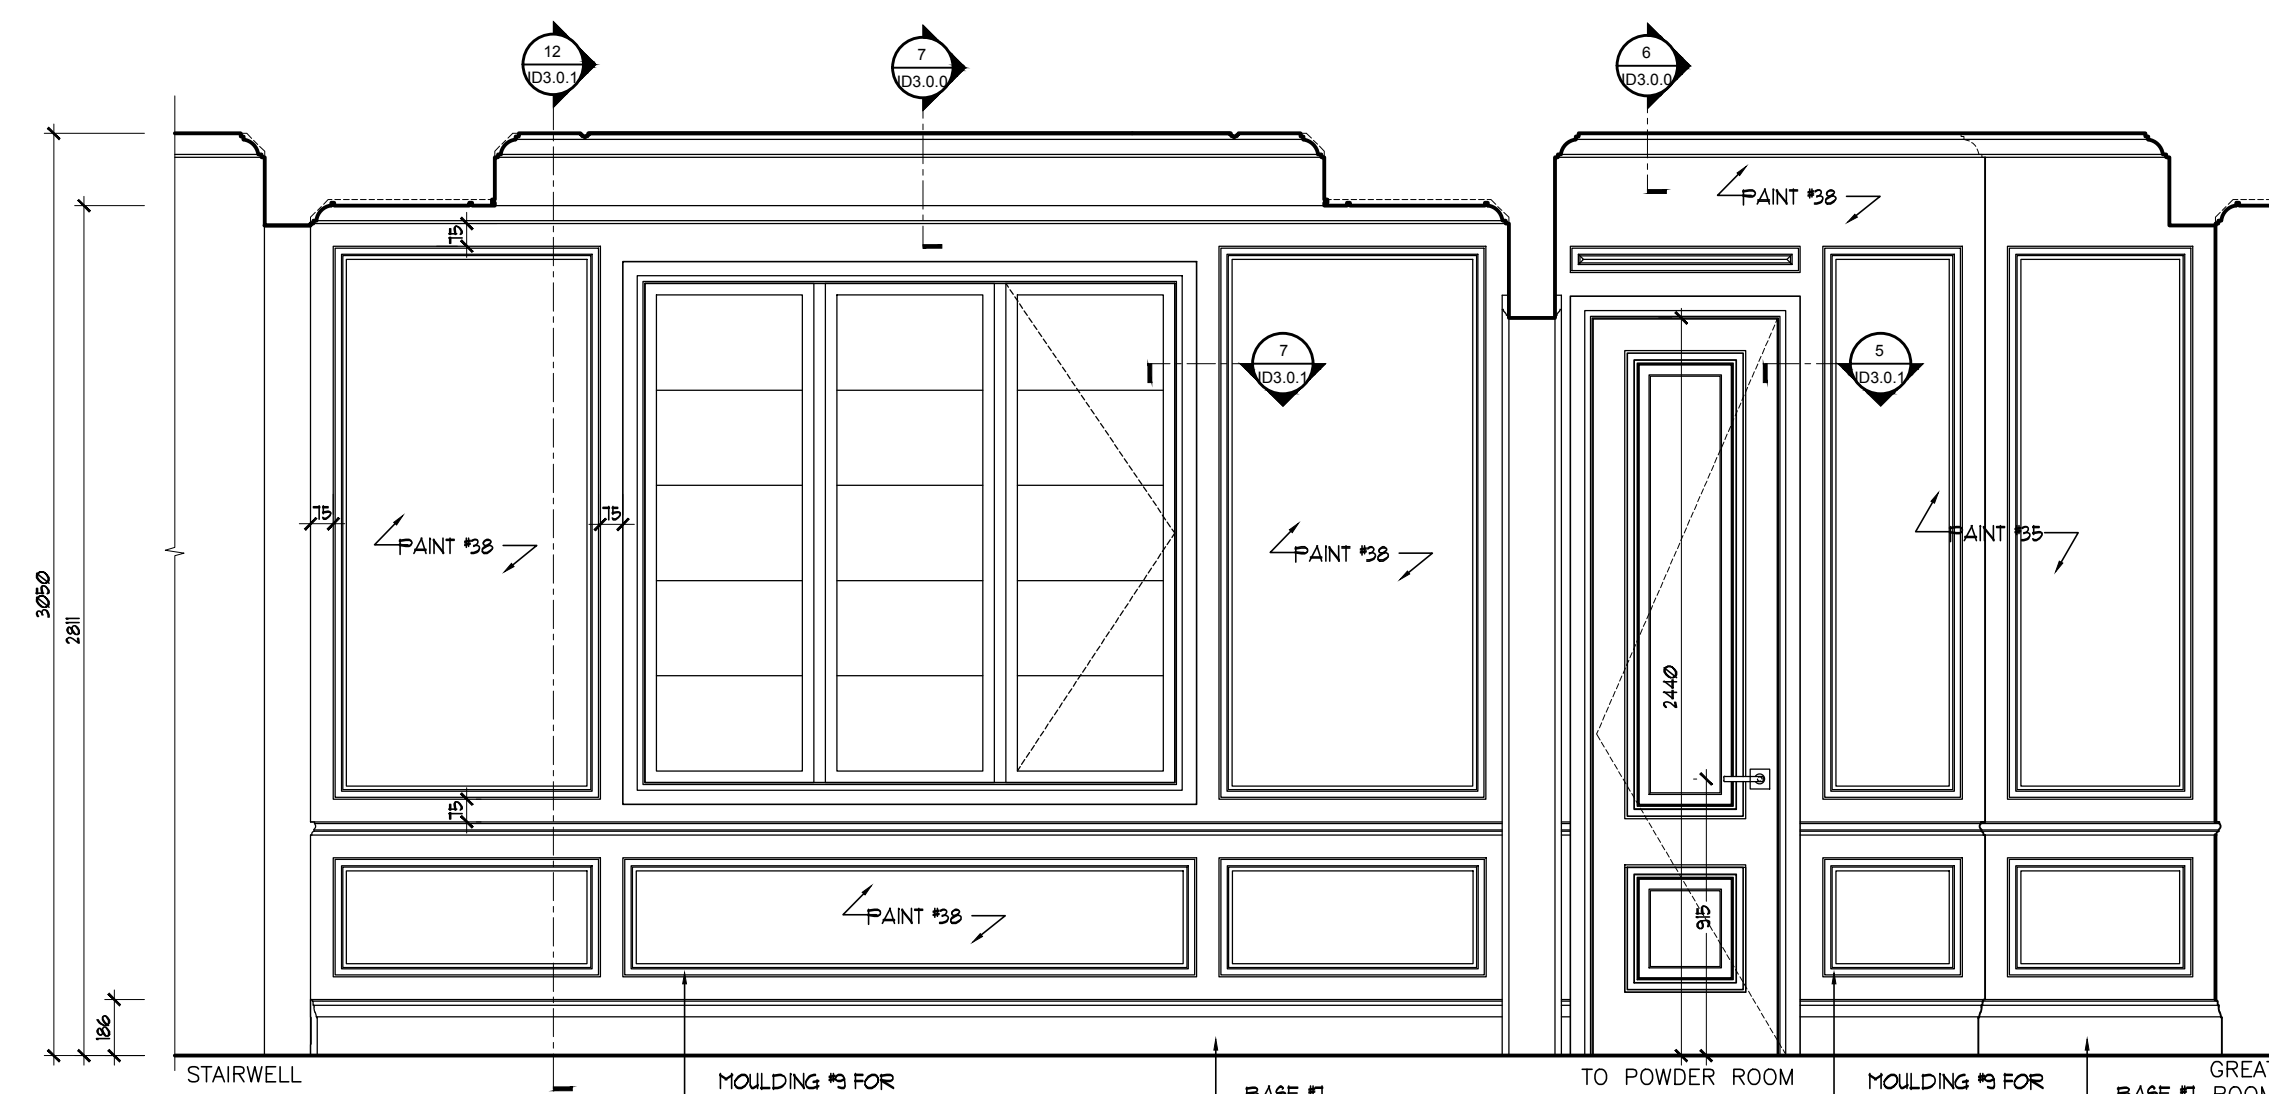


DINING AND GREAT ROOM FOYER
WEST ELEVATION
12
02.0.2 SCALE: 1:25

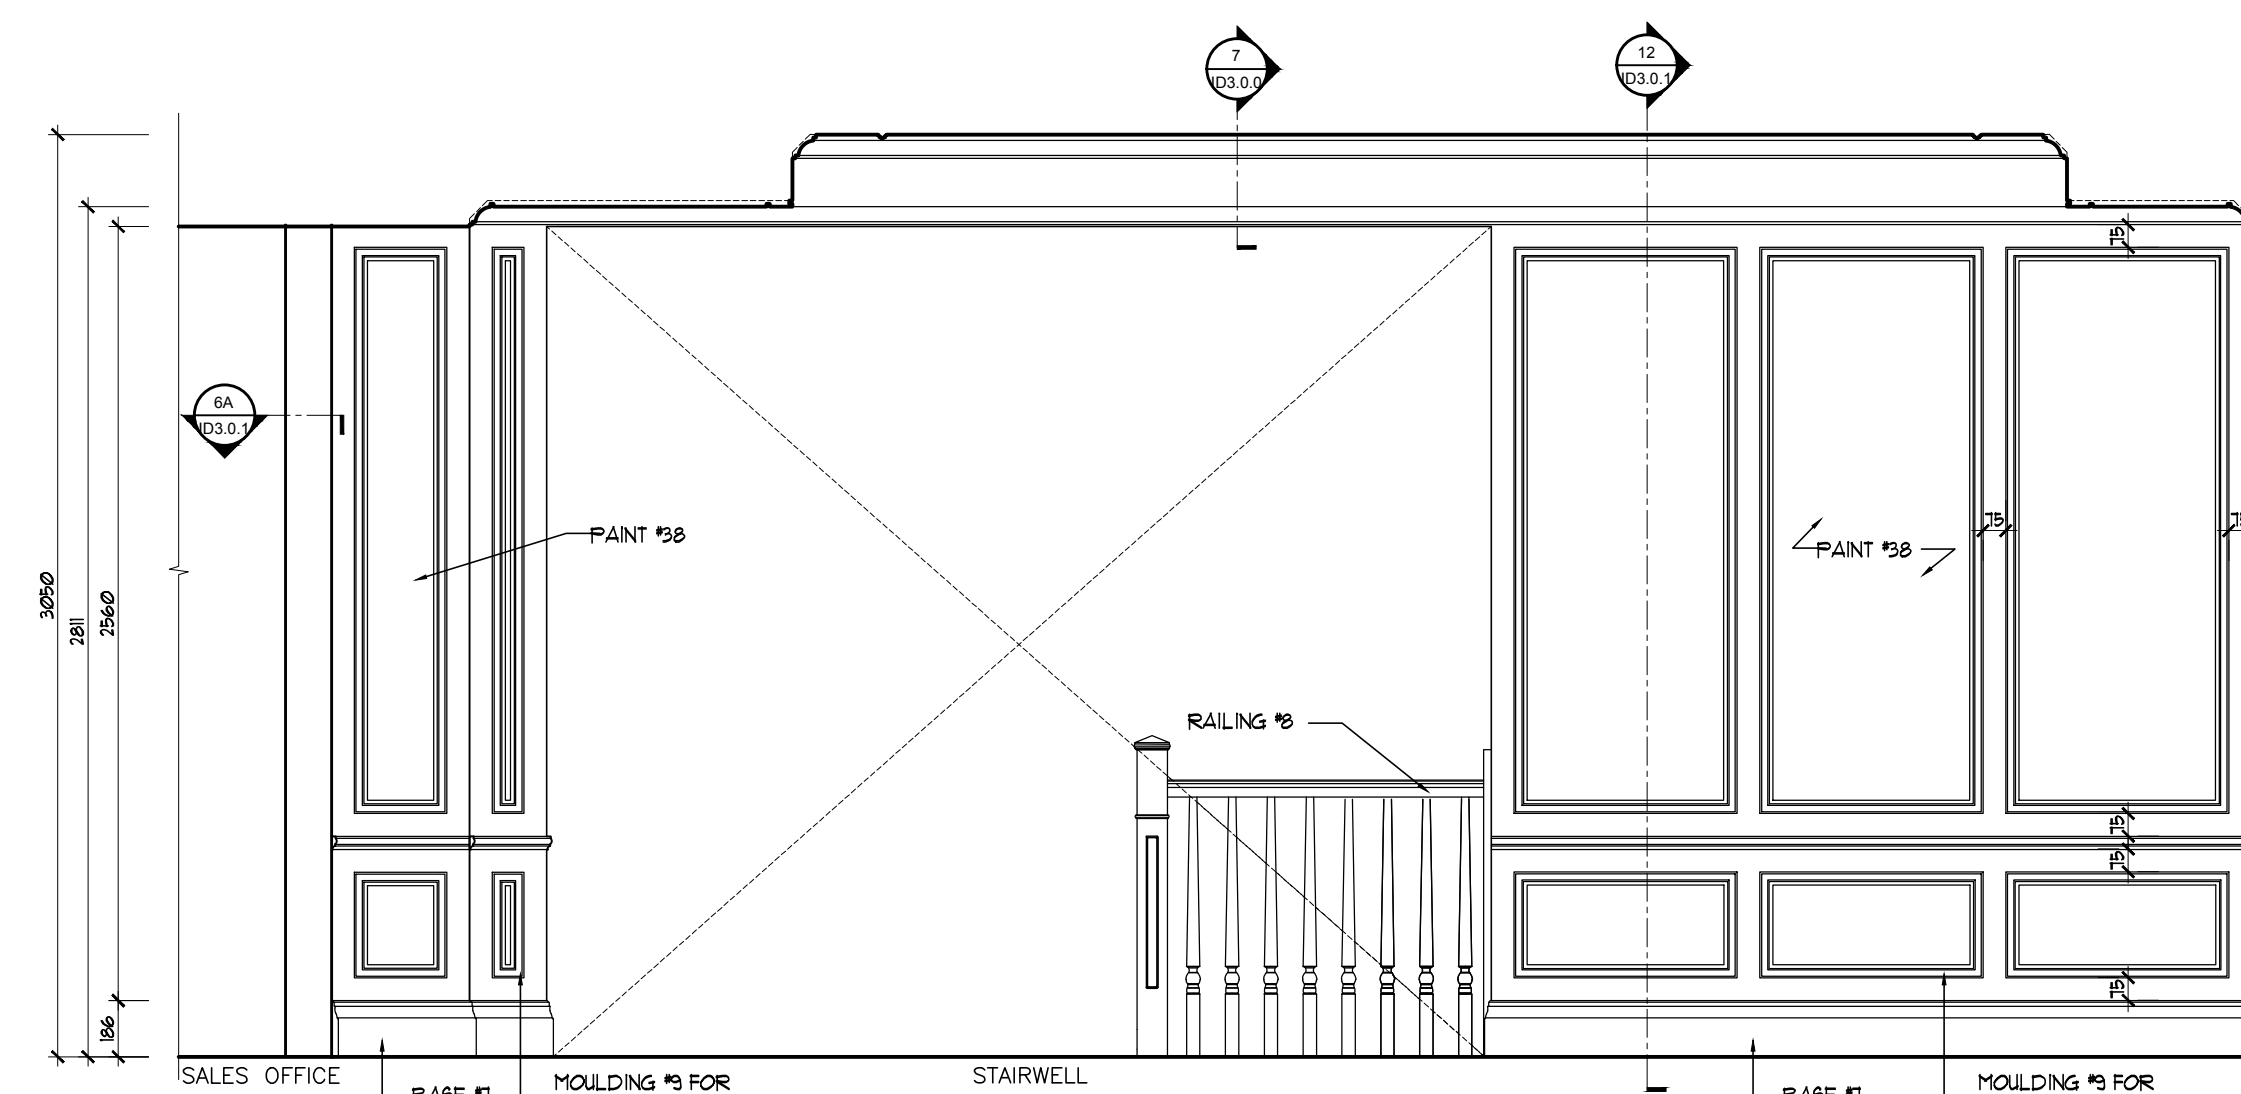


DINING
SOUTH ELEVATION
11
02.0.2 SCALE: 1:25

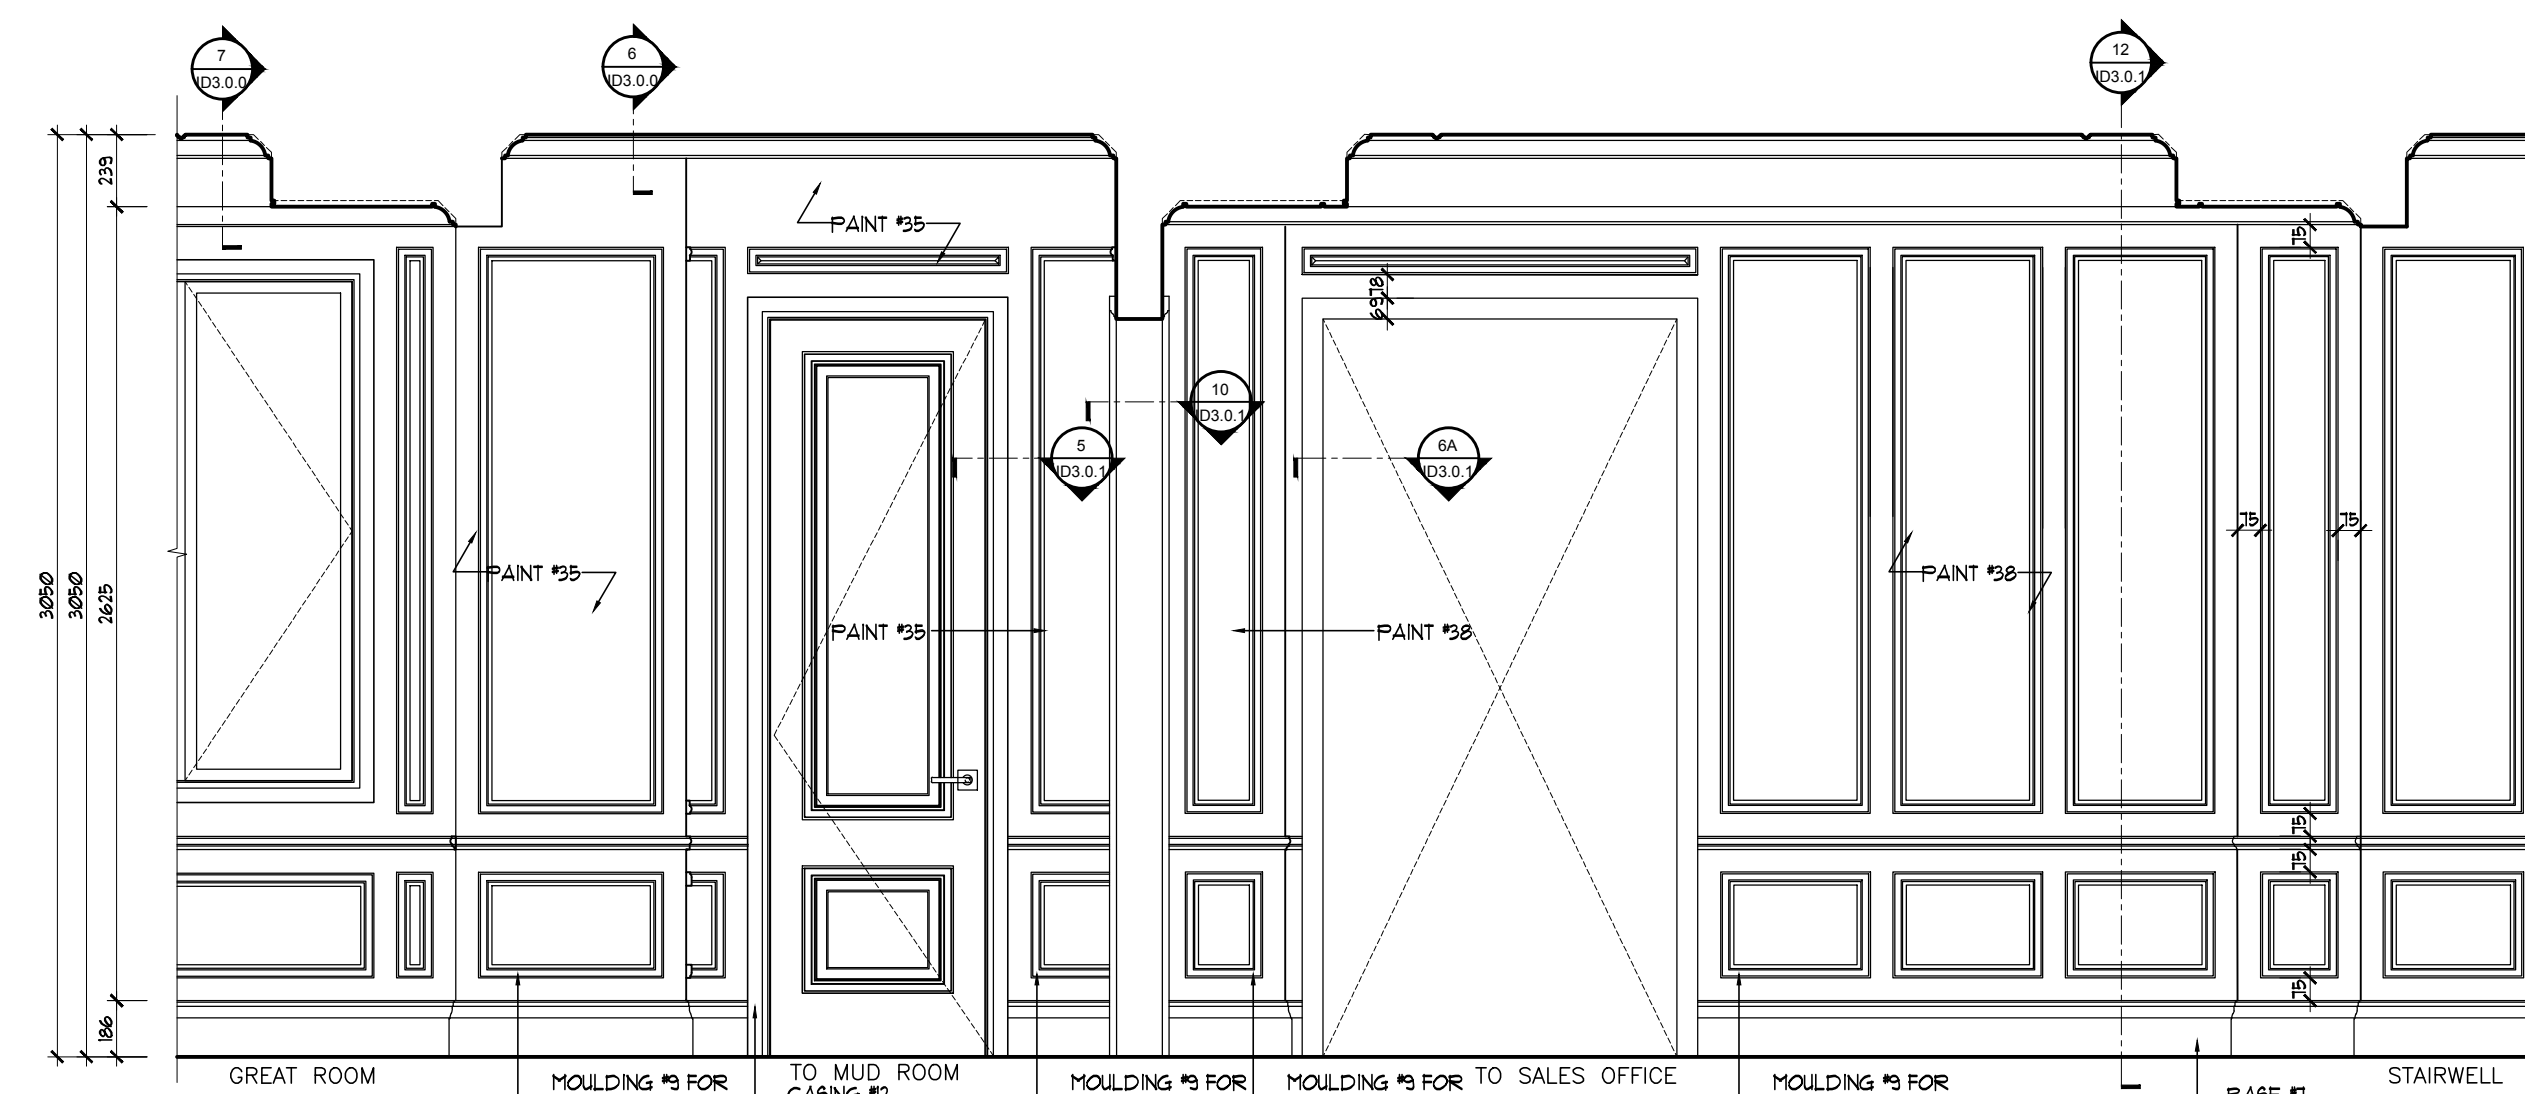


DINING AND GREAT ROOM FOYER
EAST ELEVATION
10
02.0.2 SCALE: 1:25

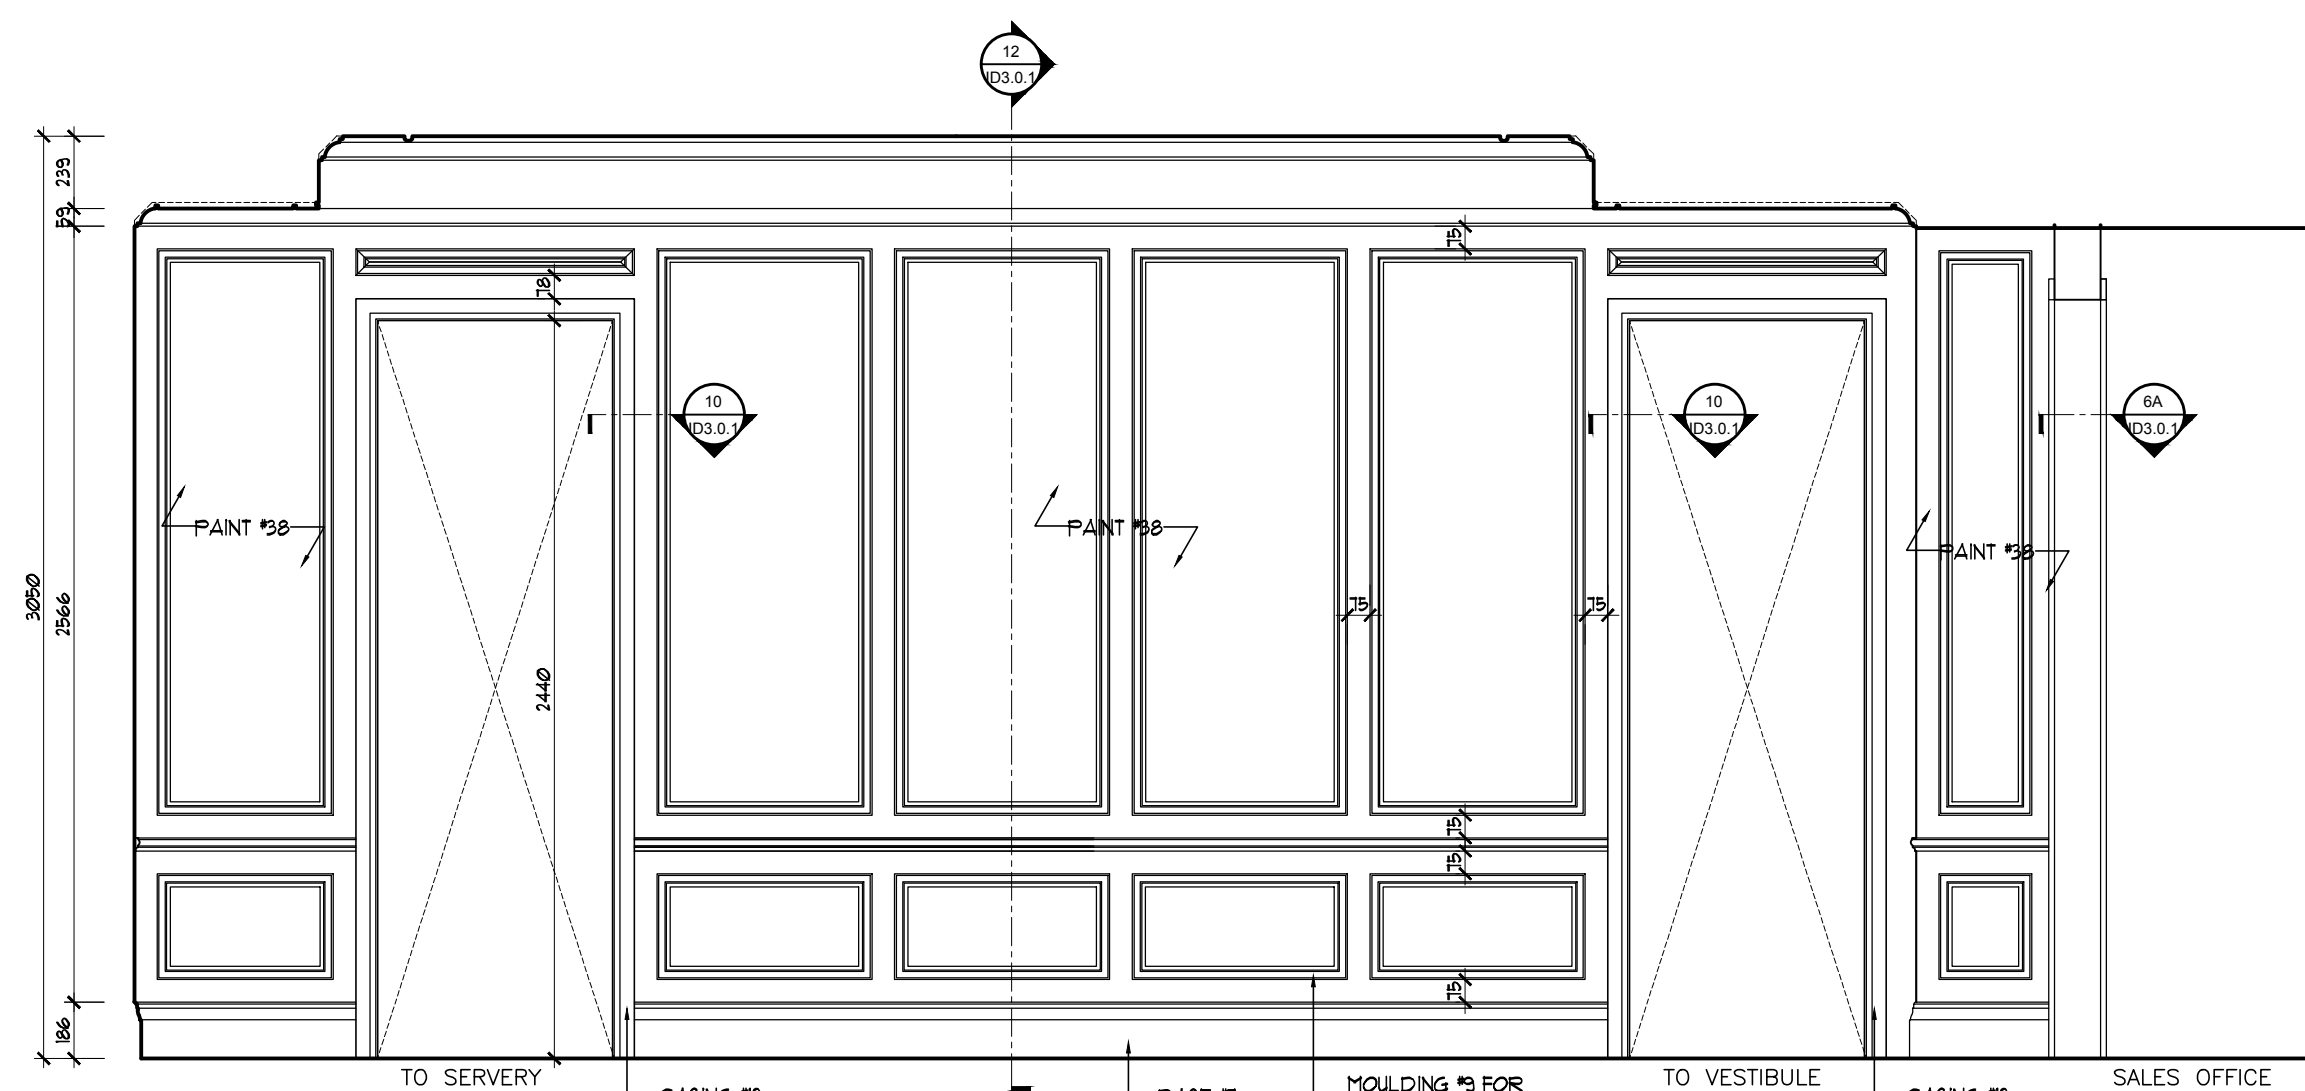


DINING
NORTH ELEVATION
9
02.0.2 SCALE: 1:25

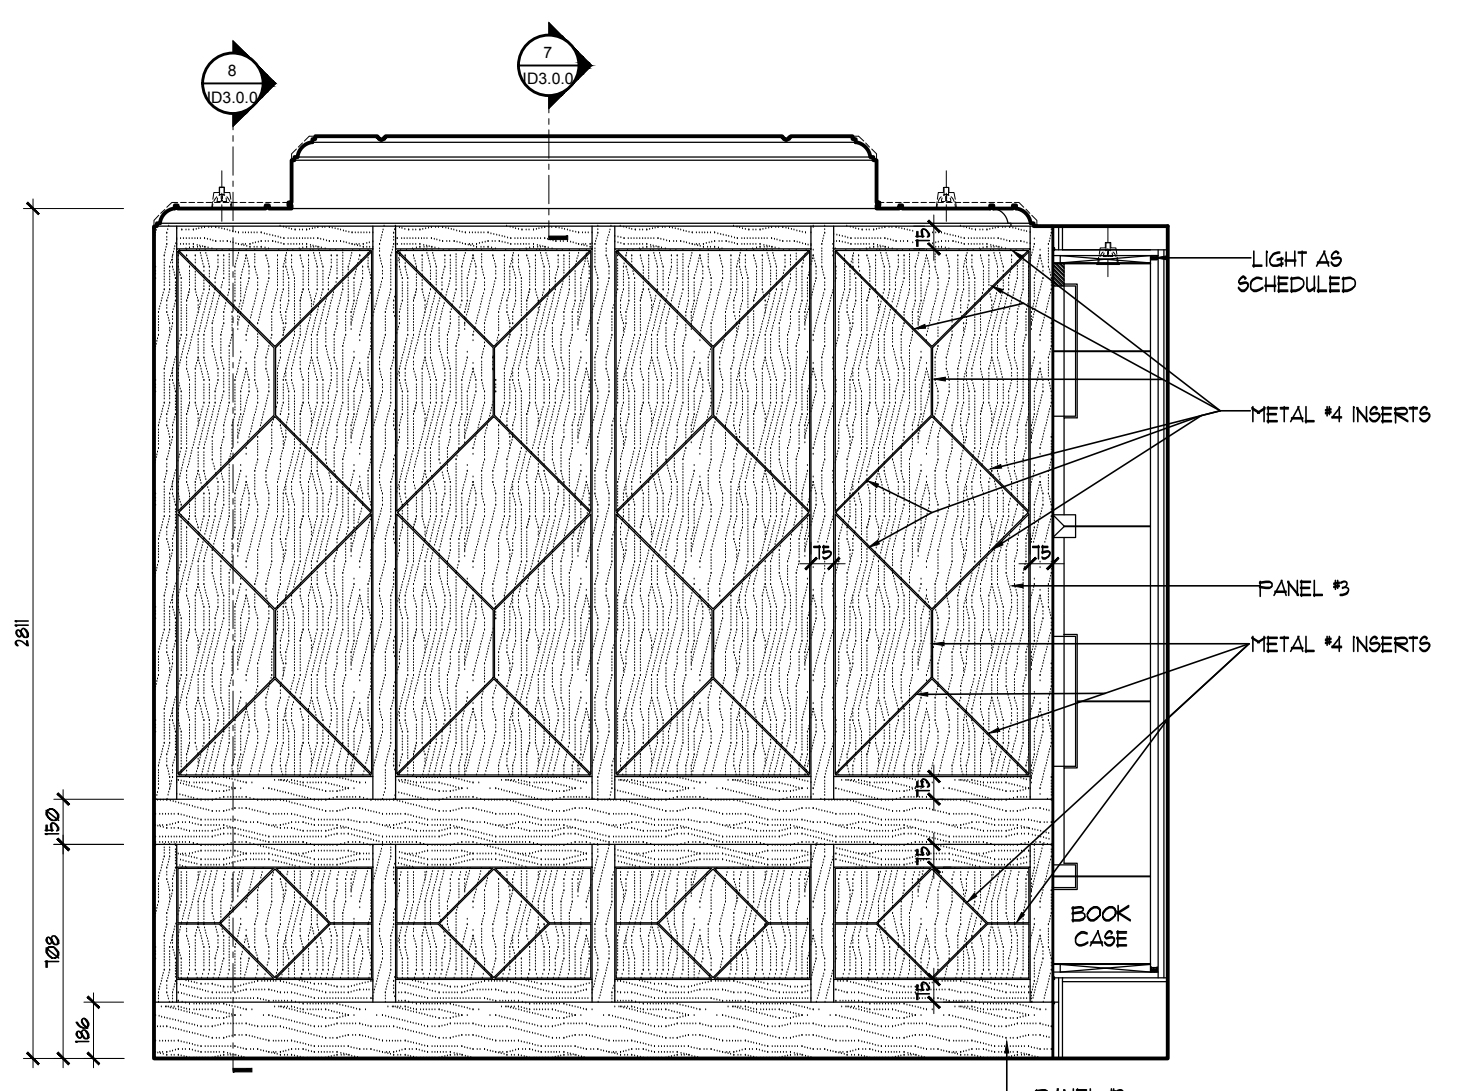


LIBRARY
WEST ELEVATION
8
02.0.2 SCALE: 1:25

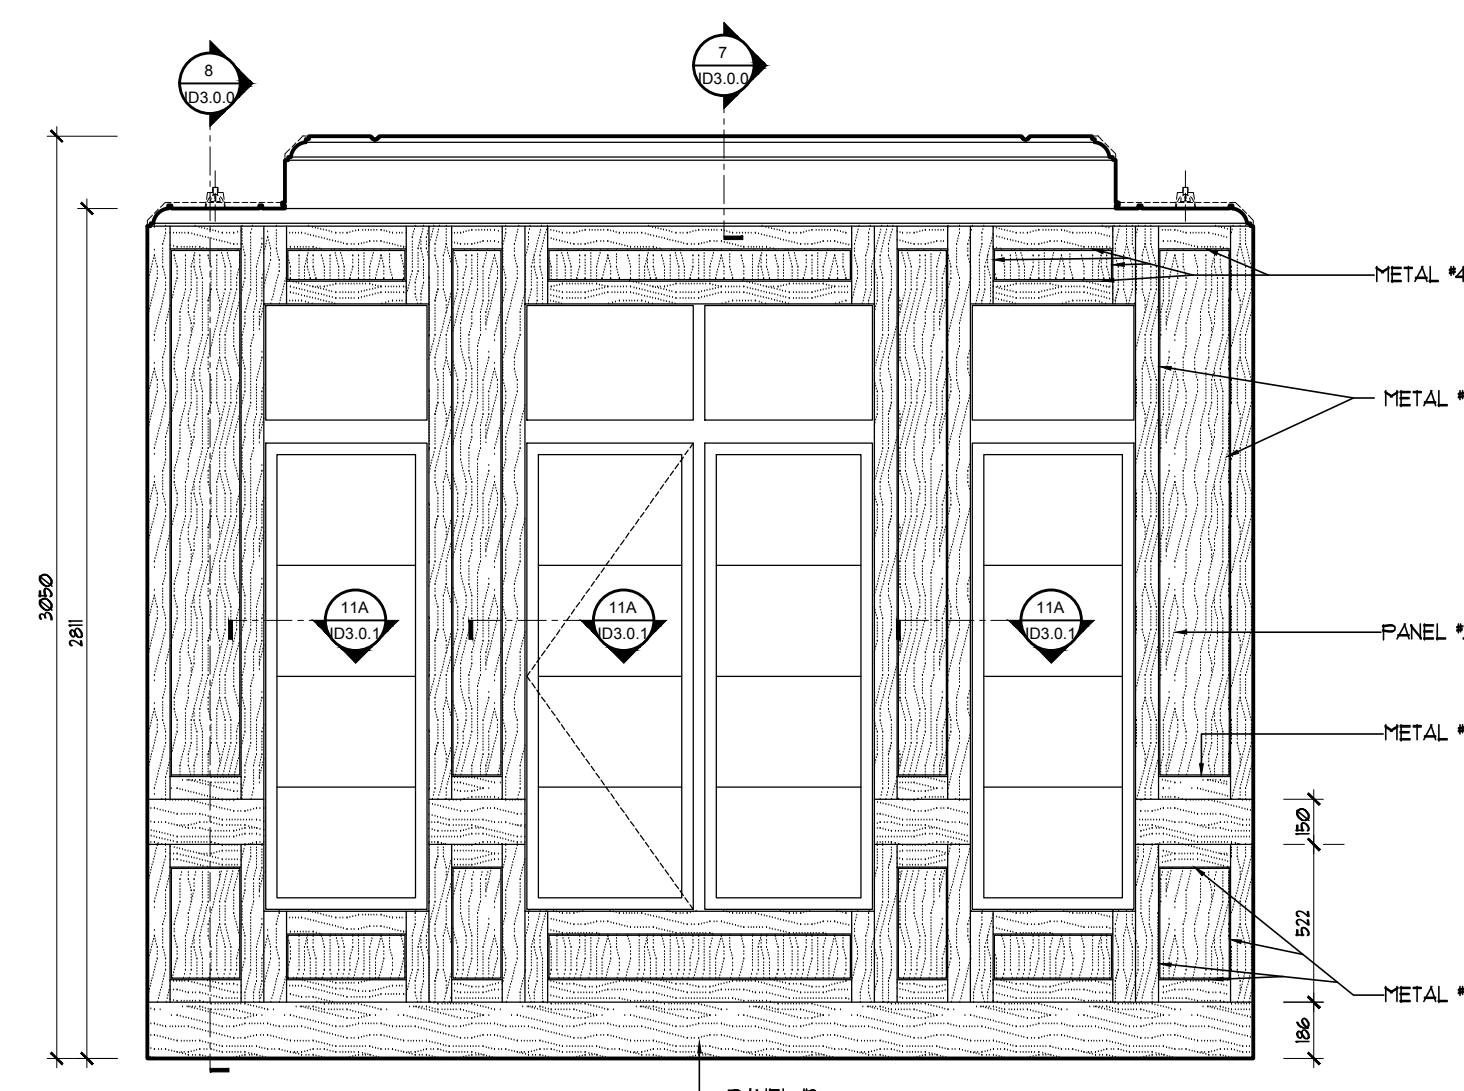


LIBRARY
SOUTH ELEVATION
7
02.0.2 SCALE: 1:25

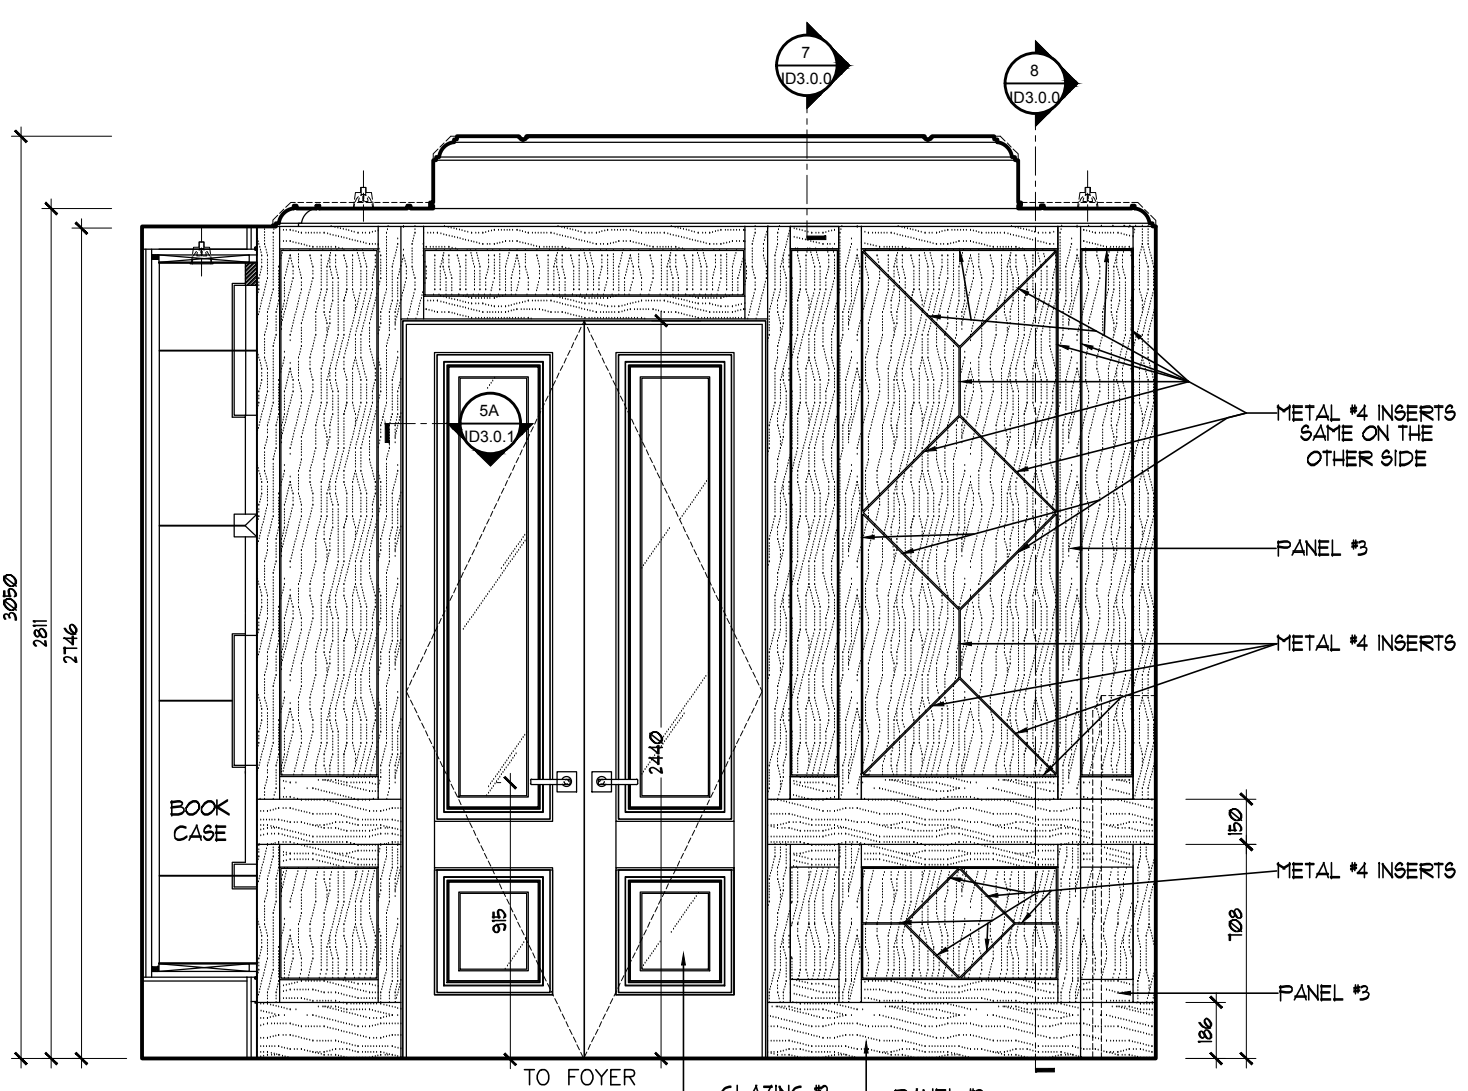


LIBRARY
EAST ELEVATION
6
02.0.2 SCALE: 1:25

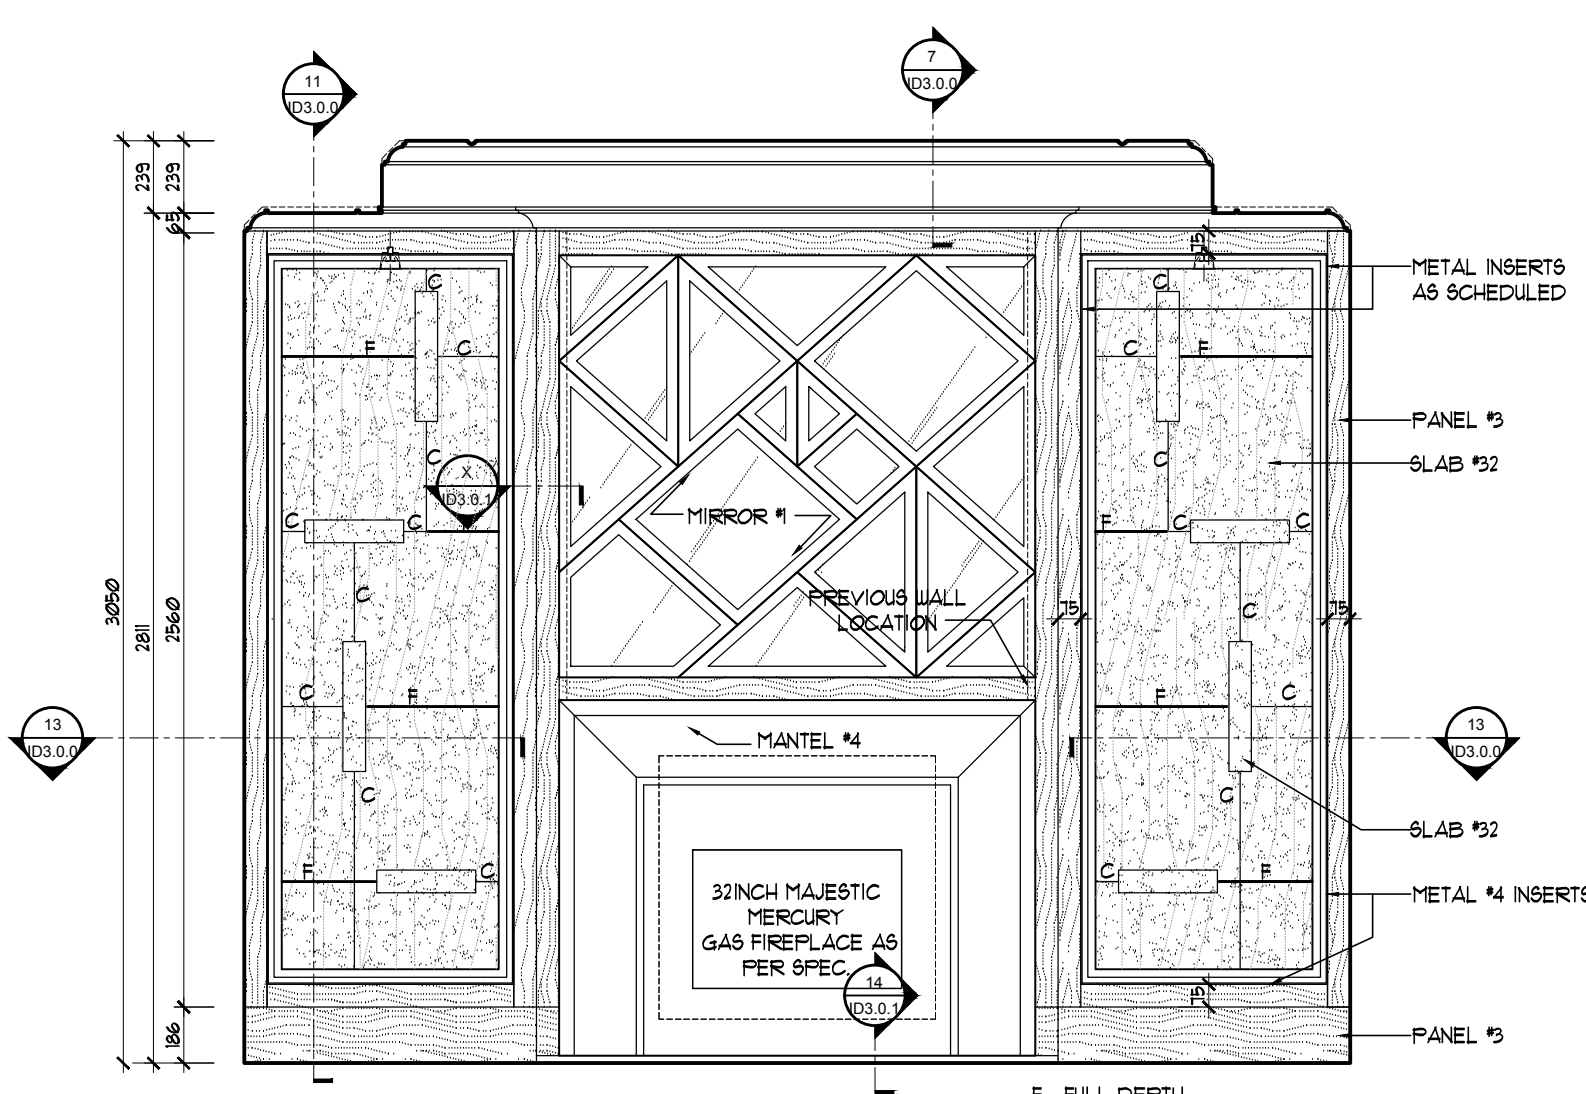


LIBRARY
NORTH ELEVATION
5
02.0.2 SCALE: 1:25

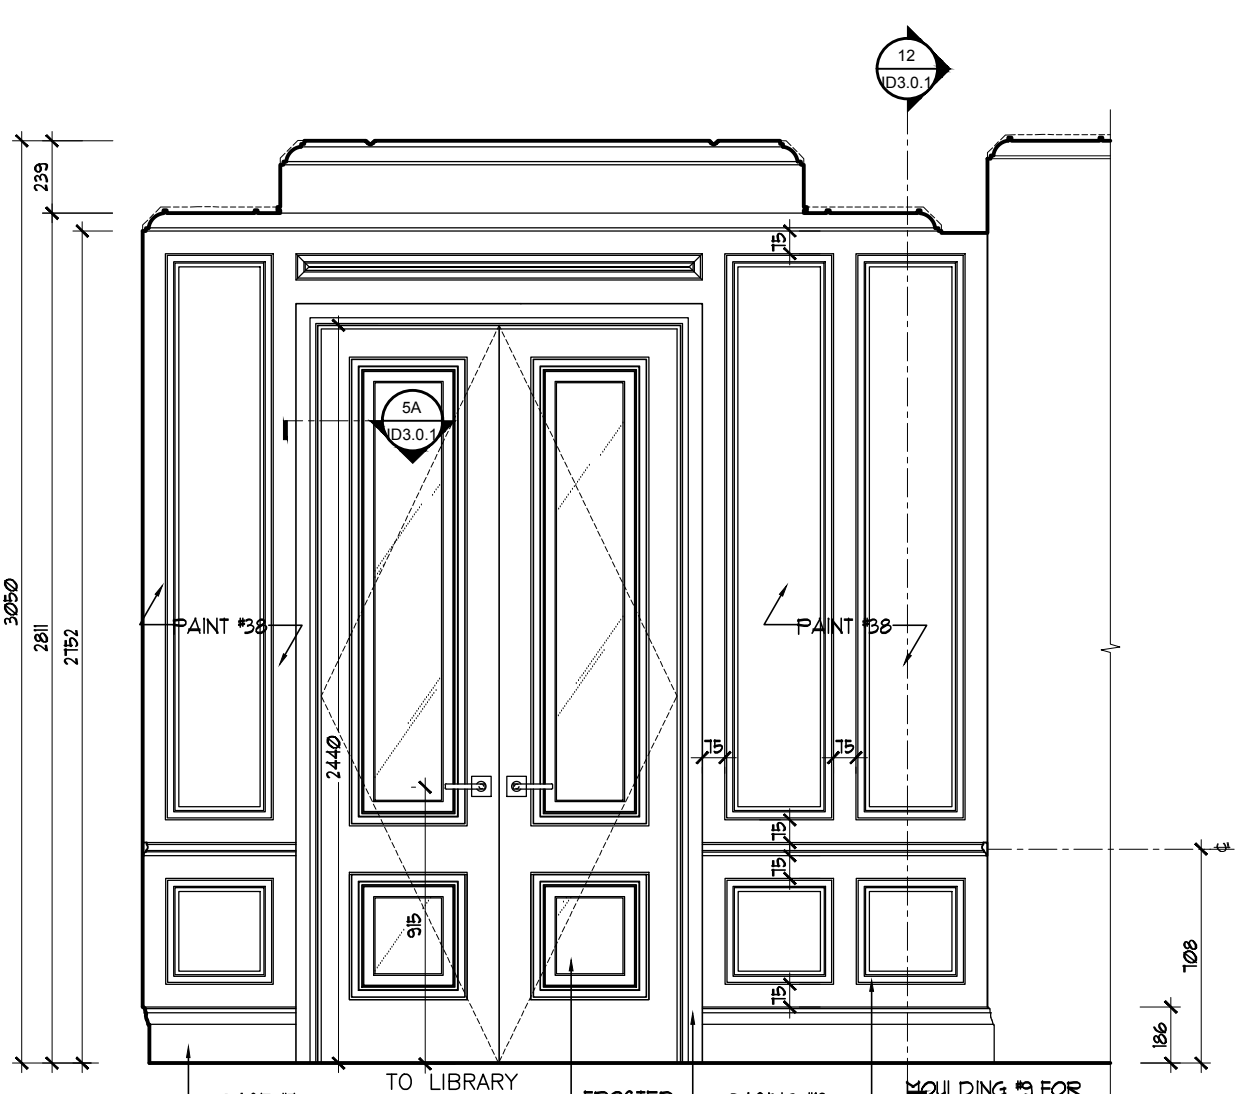


FOYER
WEST ELEVATION
4
02.0.2 SCALE: 1:25

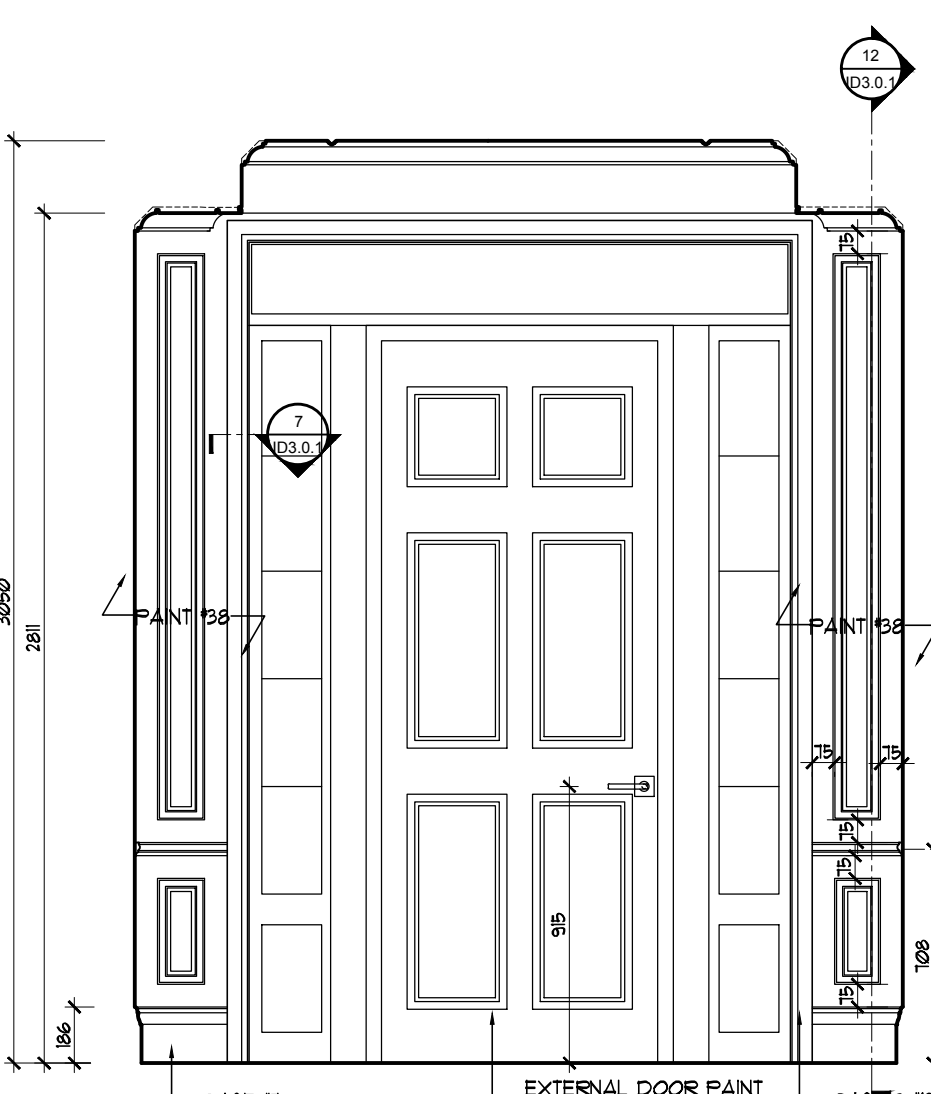

FOYER
SOUTH ELEVATION
3
02.0.2 SCALE: 1:25

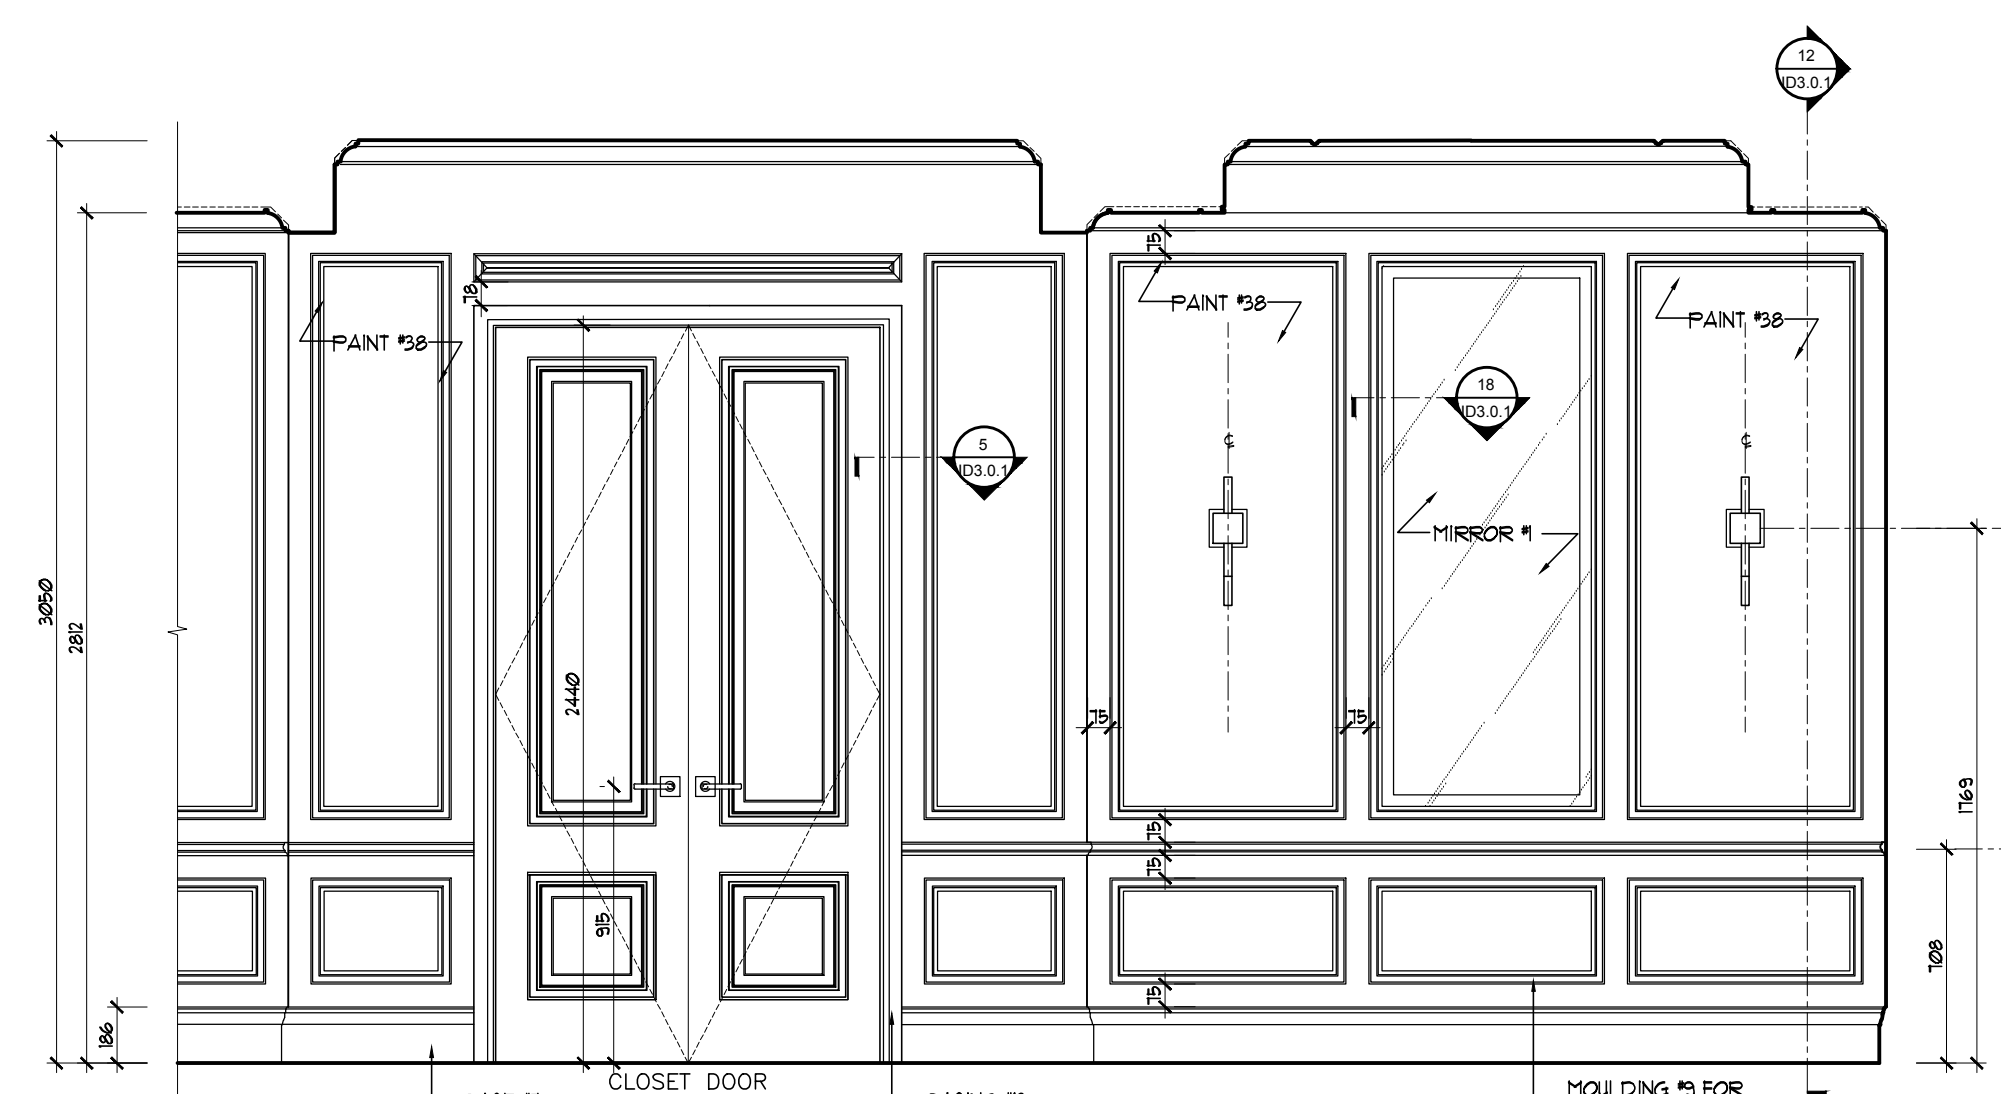

FOYER
EAST ELEVATION
2
02.0.2 SCALE: 1:25

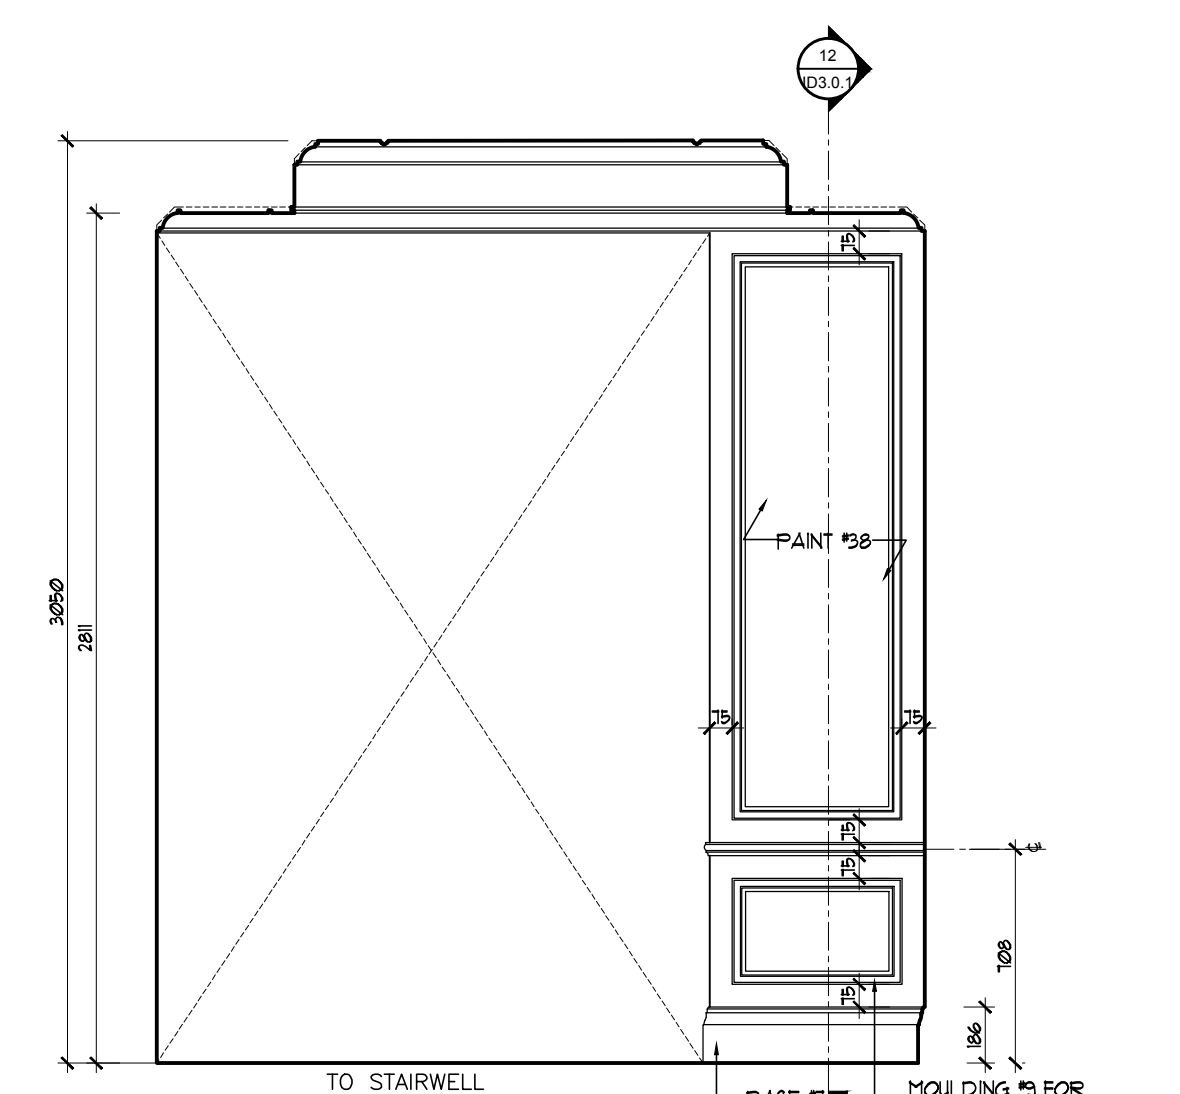

FOYER
NORTH ELEVATION
1
02.0.2 SCALE: 1:25

NOTE: **DONOT SCALE DRAWINGS**
It is the contractor's responsibility to verify all specifications and dimensions and report any discrepancies to the designer prior to construction. Materials may not be substituted without designer's written approval.



PROJECT:
PINEVALLEY
KNIGHTSWOOD, LOT 93
GOLDPARK HOMES
CONCORD, ON



DRAWING:
GROUND FLOOR
ELEVATIONS

DESIGNER:
MIKE NIVEN
DRAWN BY:
M-Tec Inc.
DATE:
FEB 2019
SCALE:
1:25
PROJECT NO:
2018-10

ID
2.0.2



MIKE NIVEN INTERIOR DESIGN INC.
100 BROADVIEW AVE. S. 3RD FLOOR, TORONTO, CANADA M4M 3B3
TEL: 416.763.7404 • FAX: 416.763.7404

ISSUED FOR
PLUMBING &
APPLIANCES

No.	Date	Revision	Drawn	CHK
1	18/04/2019	ADJUSTED AS SHOWN	RG	MM
2	15/05/2019	ADJUSTED AS SHOWN	RG	MM
3	24/05/2019	ADJUSTED AS SHOWN	RG	MM
4	11/06/2019	ADJUSTED AS SHOWN	RG	MM
5	02/06/20	CHANGE NOTICE #10	NURS	MM

No.	Date	Issue	Drawn	CHK
4	11/20/2019	ISSUED FOR PRICING FOR TRIM AND MILL WORK	RS	MM
3	10/22/2019	ISSUED FOR PRICING FOR SLABS AND TILES ONLY	HD	MM
2	15/05/2019	ISSUED FOR PLUMBING & APPLIANCES	RG	MM
1	18/04/2019	ISSUED FOR COORDINATION	RG	MM

NOTE: **DONOT SCALE DRAWINGS**
It is the contractor's responsibility to verify all specifications and dimensions and report any discrepancies to the designer prior to construction. Materials may not be substituted without designer's written approval.




PROJECT:
PINEVALLEY
KNIGHTSWOOD, LOT 93


GOLDPARK HOMES
CONCORD, ON

DRAWING:
SECOND FLOOR
ELEVATIONS

DESIGNER'S:
MIKE NIVEN
DRAWN BY:
M-Tec Inc.
DATE:
FEB 2019
SCALE:
1:25
PROJECT NO:
2018-10

ID
2.0.3

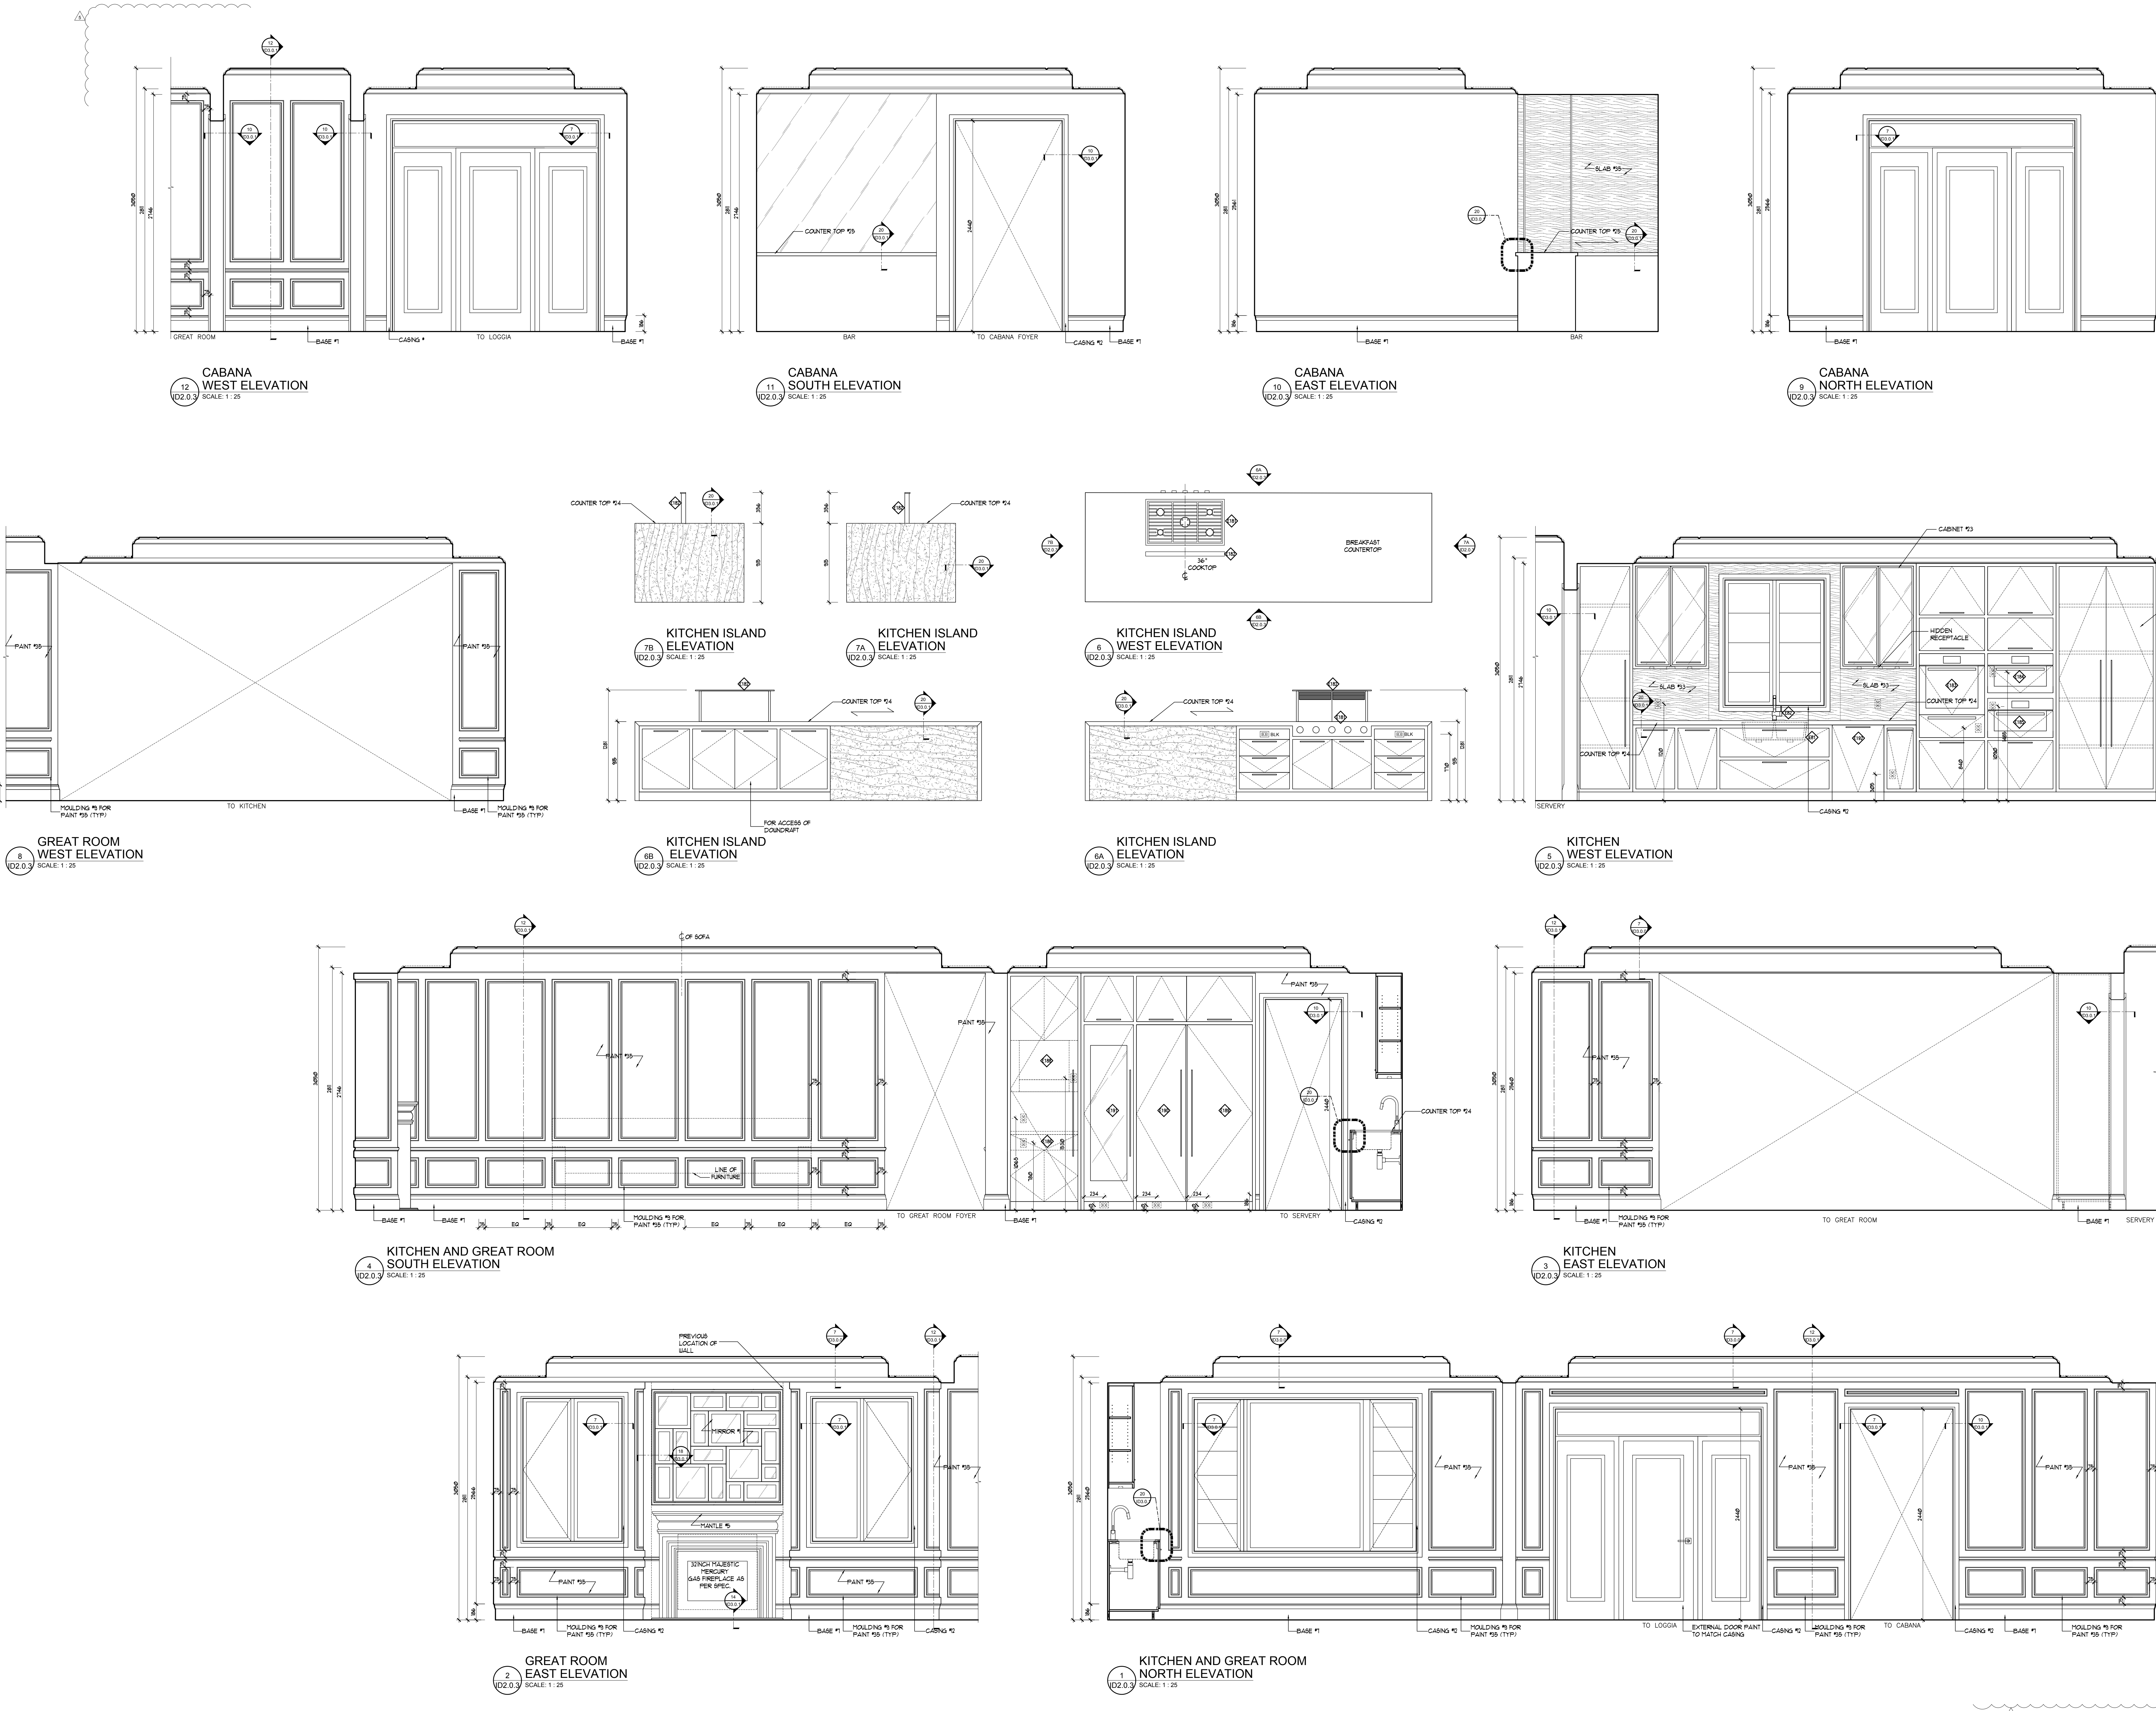

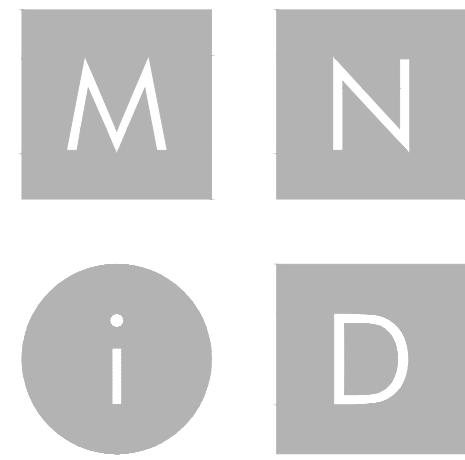

MIKE NIVEN INTERIOR DESIGN INC.
100 BROADVIEW AVE. S. 3RD FLOOR, TORONTO, CANADA M4M 3B3
TEL: 416.783.7404 • FAX: 416.783.7404

ISSUED FOR
PLUMBING &
APPLIANCES

No.	Date	Revision	Drawn	CHK
1	18/04/2019	ADJUSTED AS SHOWN	RG	MM
2	15/05/2019	ADJUSTED AS SHOWN	RG	MM
3	24/05/2019	ADJUSTED AS SHOWN	RG	MM
4	11/06/2019	ADJUSTED AS SHOWN	RG	MM
5	02/2020	CHANGE NOTICE #10	NURS	MM

4	11/20/2019	ISSUED FOR PRICING FOR TRIM AND MILLWORK	RS	MM
3	10/22/2019	ISSUED FOR PRICING FOR GLASS AND TILES ONLY	HD	MM
2	15/05/2019	ISSUED FOR PLUMBING & APPLIANCES	RG	MM
1	18/04/2019	ISSUED FOR COORDINATION	RG	MM

No.	Date	Issue	Drawn	CHK
-----	------	-------	-------	-----

NOTE: DO NOT SCALE DRAWINGS
It is the contractor's responsibility to verify all specifications and dimensions and report any discrepancies to the designer prior to construction. Materials may not be substituted without designer's written approval.




PROJECT:
PINEVALLEY
KNIGHTSWOOD, LOT 93

GOLDPARK HOMES
CONCORD, ON


DRAWING:
GROUND FLOOR
ELEVATIONS

DESIGNER'S:
MIKE NIVEN
DRAWN BY:
M-Tec Inc.
DATE:
FEB 2019
SCALE:
1:25
PROJECT NO:
2018-10


ID
2.0.4

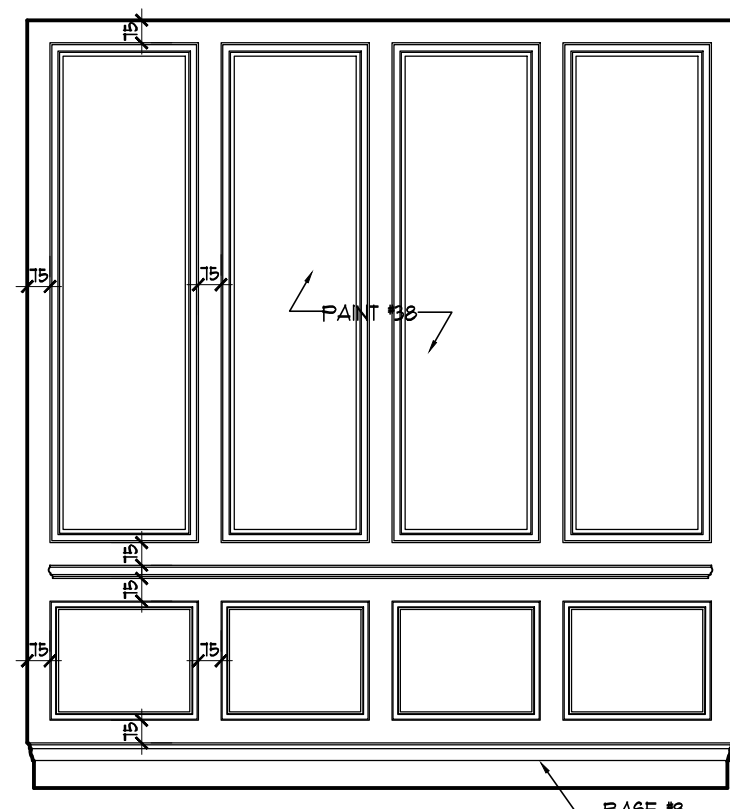


4
FINISHED FOYER
EAST ELEVATION
SCALE: 1:25

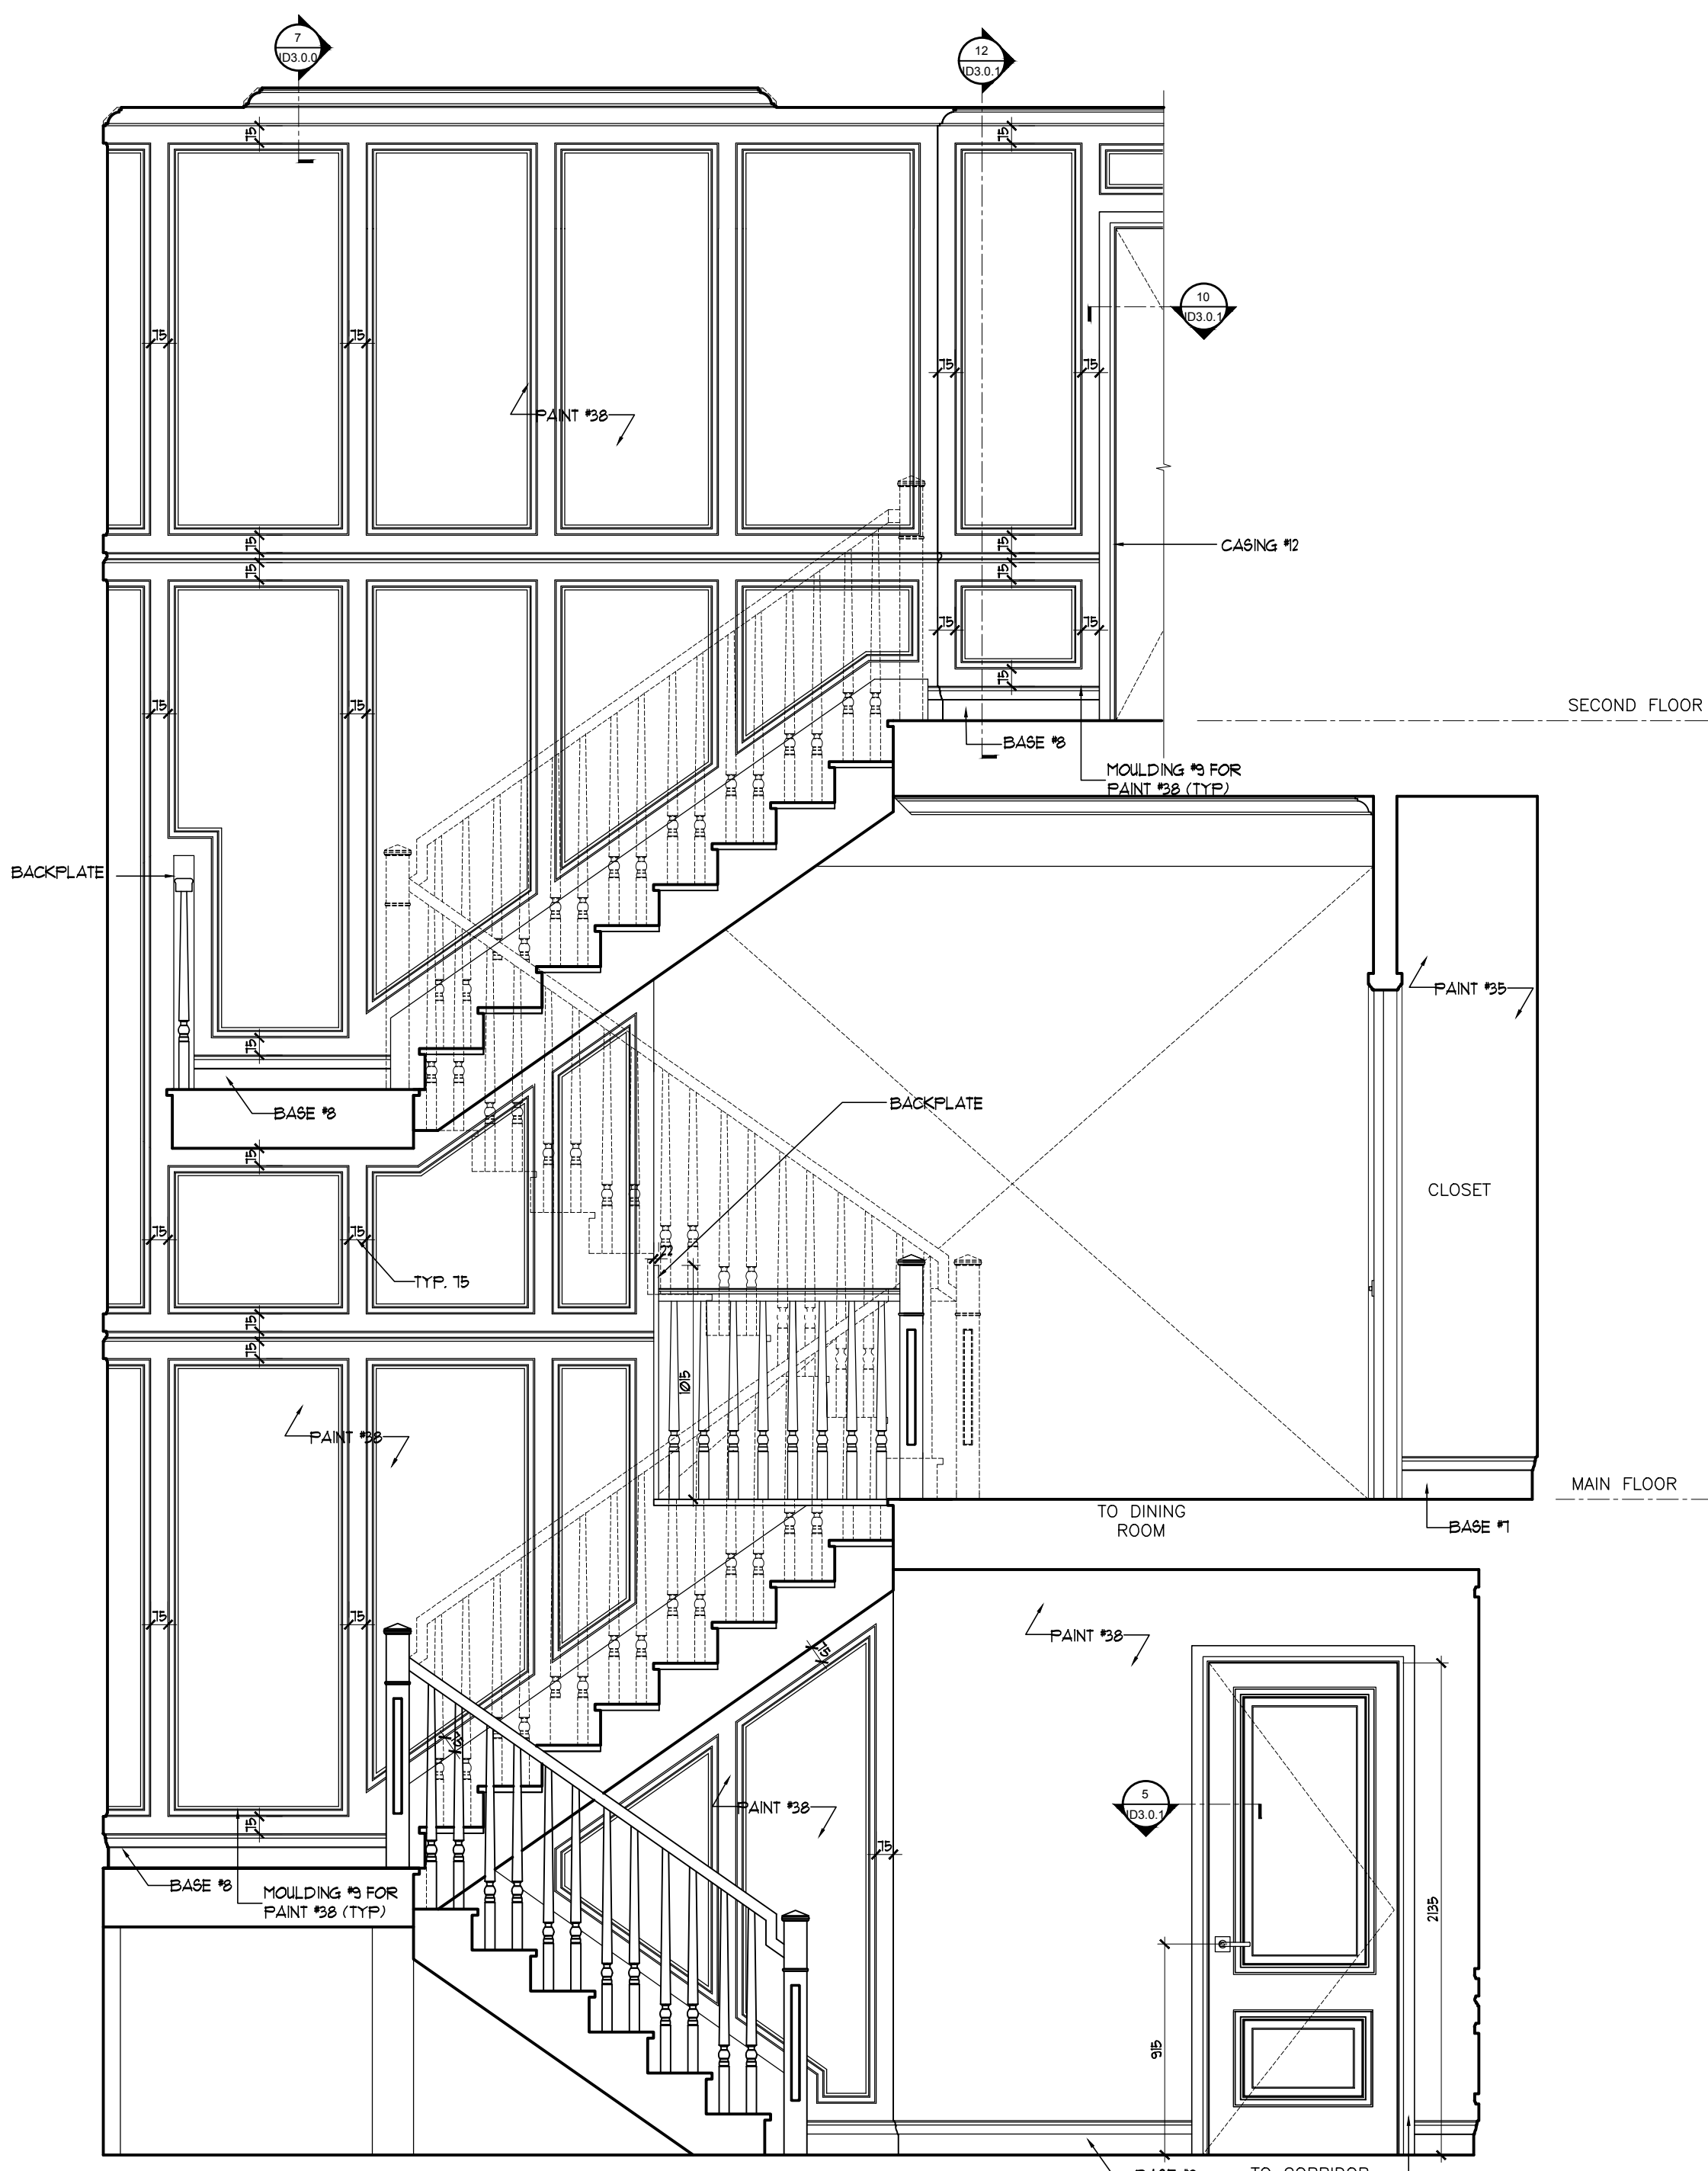

3
STAIRWELL
NORTH ELEVATION
SCALE: 1:25

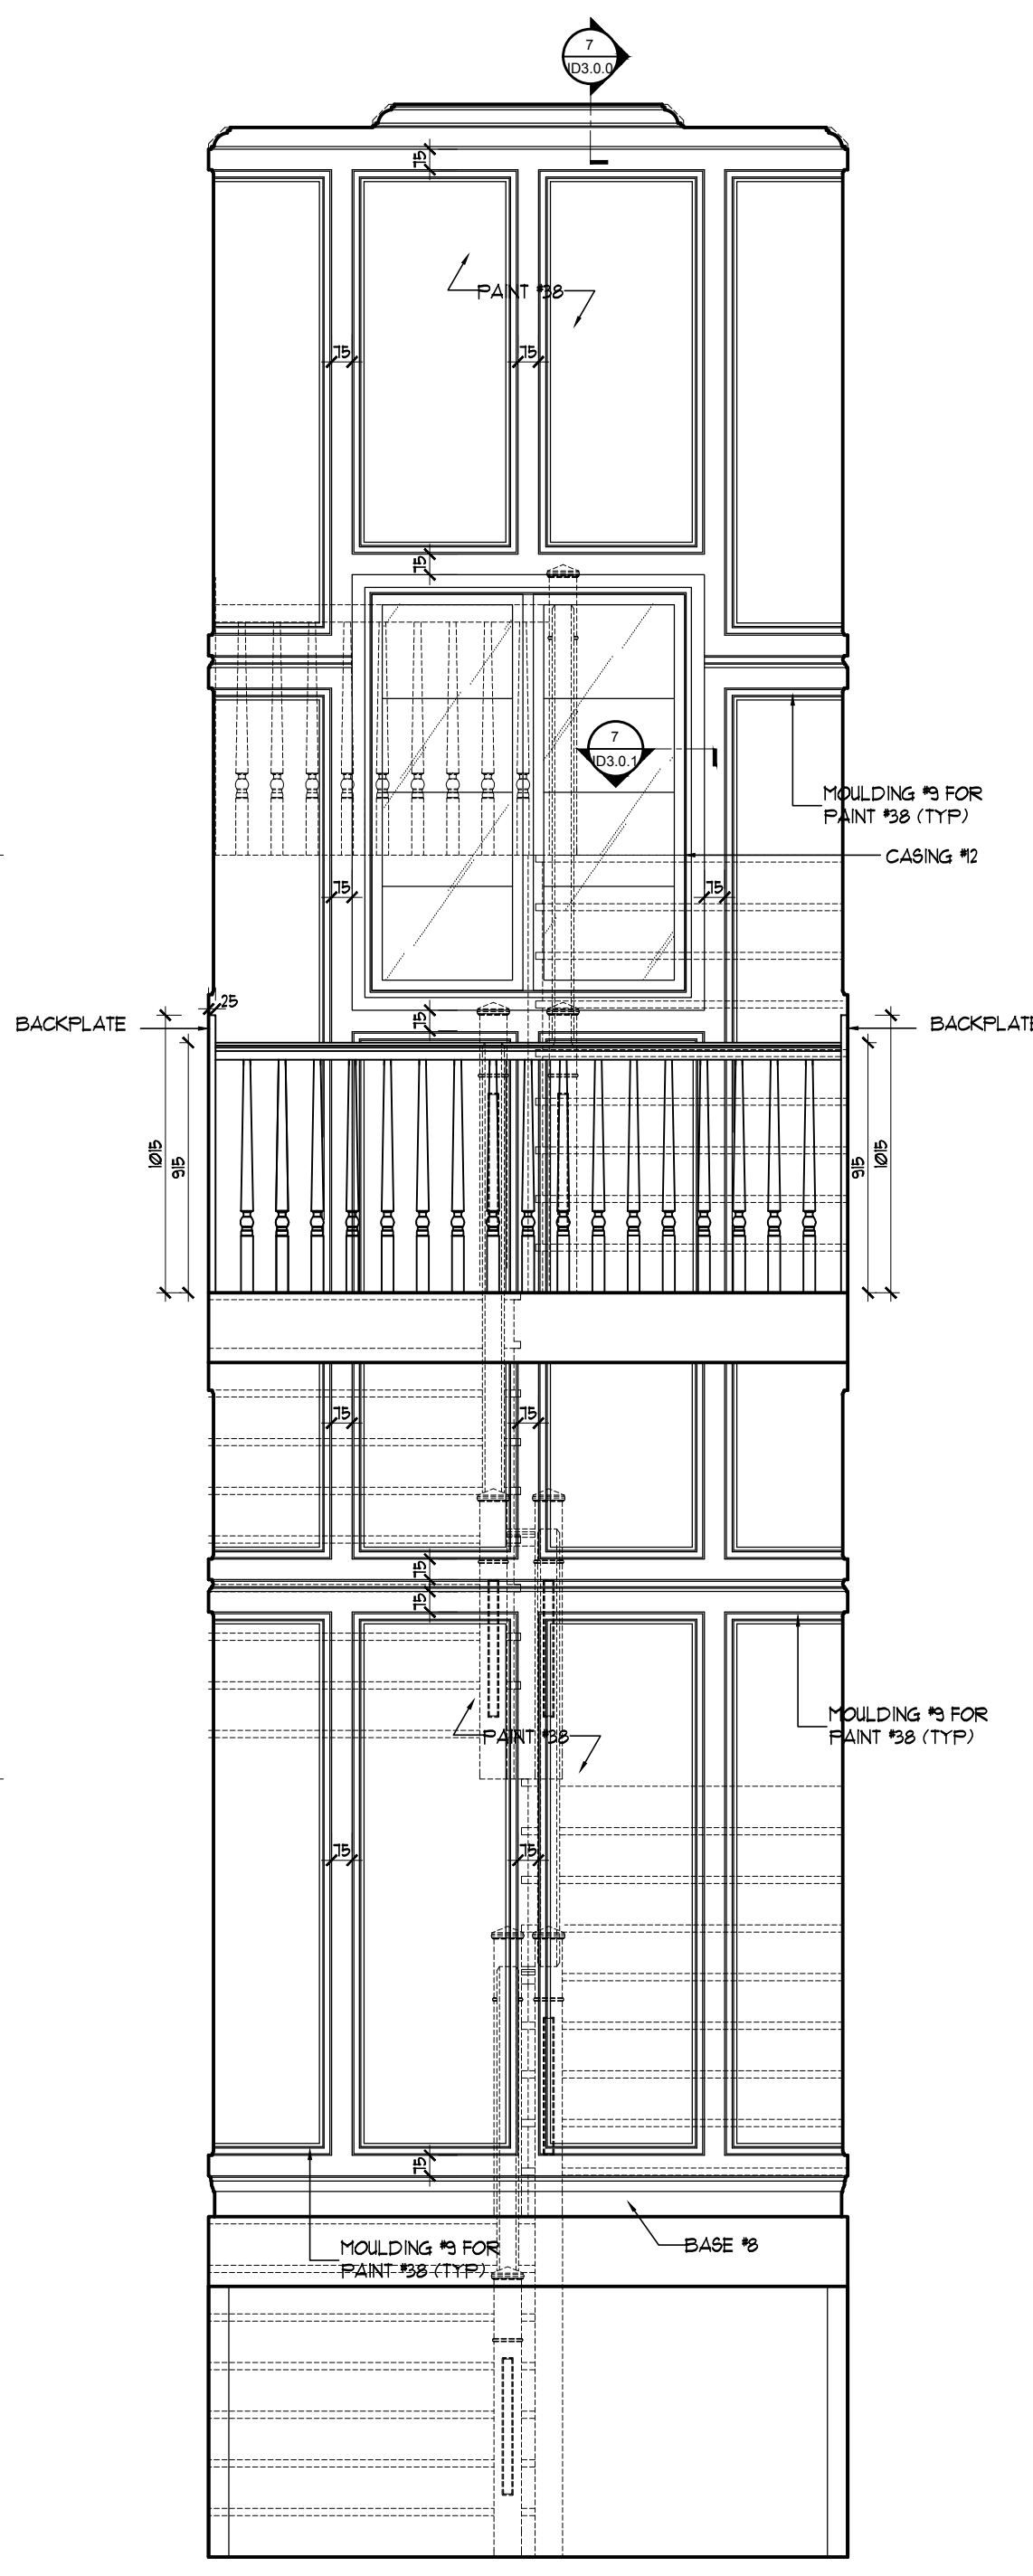

2
STAIRWELL
WEST ELEVATION
SCALE: 1:25

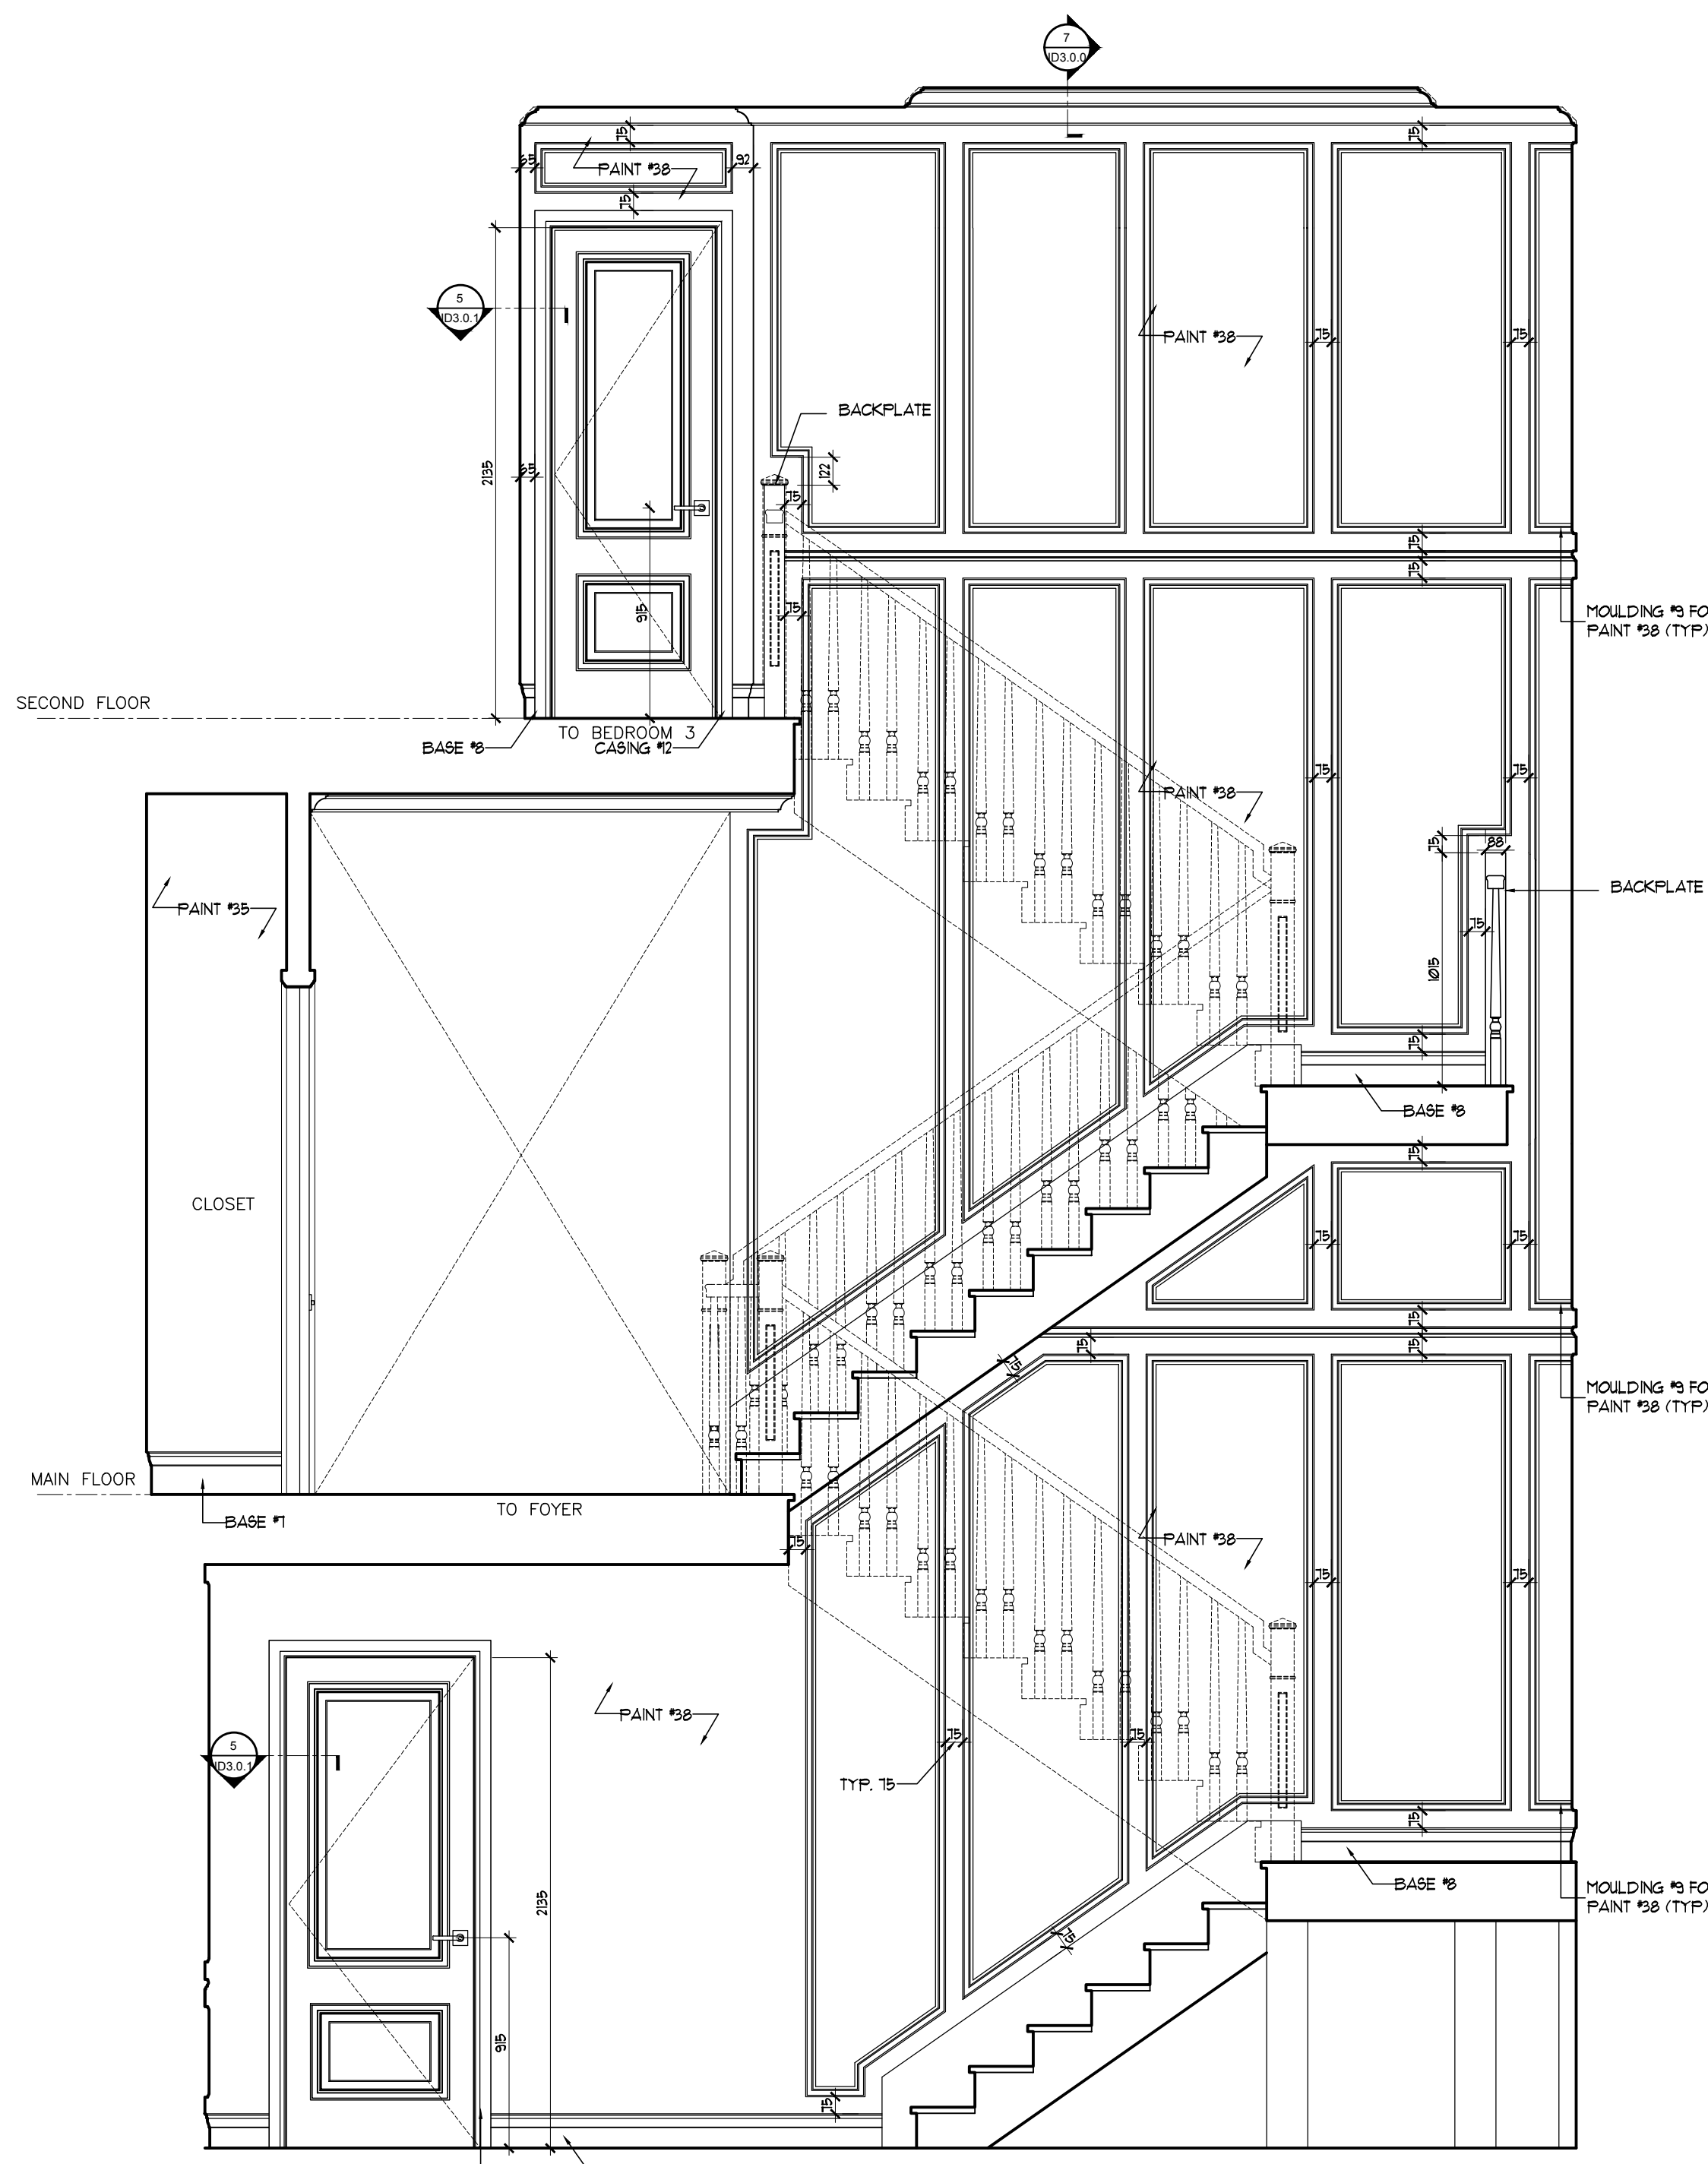

1
STAIRWELL
SOUTH ELEVATION
SCALE: 1:25



MIKE NIVEN INTERIOR DESIGN INC.
100 BROADVIEW AVE. S. 3RD FLOOR, TORONTO, CANADA M4M 3B3
TEL: 416.783.7404 • FAX: 416.783.7404

ISSUED FOR
PLUMBING &
APPLIANCES

No.	Date	Revision	By	CHK
1	18/04/2019	ADJUSTED AS SHOWN	RG	MM
2	15/05/2019	ADJUSTED AS SHOWN	RG	MM
3	24/05/2019	ADJUSTED AS SHOWN	RG	MM
4	11/06/2019	ADJUSTED AS SHOWN	RG	MM
5	02/2020	CHANGE NOTICE #10	NURS	MM

4	11/22/2019	ISSUED FOR PRICING FOR TRIM AND MILL WORK	RS	MM
3	10/22/2019	ISSUED FOR PRICING FOR GLASS AND TILES ONLY	HD	MM
2	15/05/2019	ISSUED FOR PLUMBING & APPLIANCES	RG	MM
1	18/04/2019	ISSUED FOR COORDINATION	RG	MM

No.	Date	Issue	By	CHK
-----	------	-------	----	-----

NOTE: **DONOT SCALE DRAWINGS**
It is the contractor's responsibility to verify all specifications and dimensions and report any discrepancies to the designer prior to construction. Materials may not be substituted without designer's written approval.



PROJECT:
PINEVALLEY
KNIGHTSWOOD, LOT 93

GOLDPARK HOMES
CONCORD, ON

SECOND FLOOR
ELEVATIONS


DESIGNER:
MIKE NIVEN
DRAWN BY:
M-Tec Inc.

DATE:
FEB 2019


SCALE:
1:25

PROJECT NO:
2018-10


ID
2.10

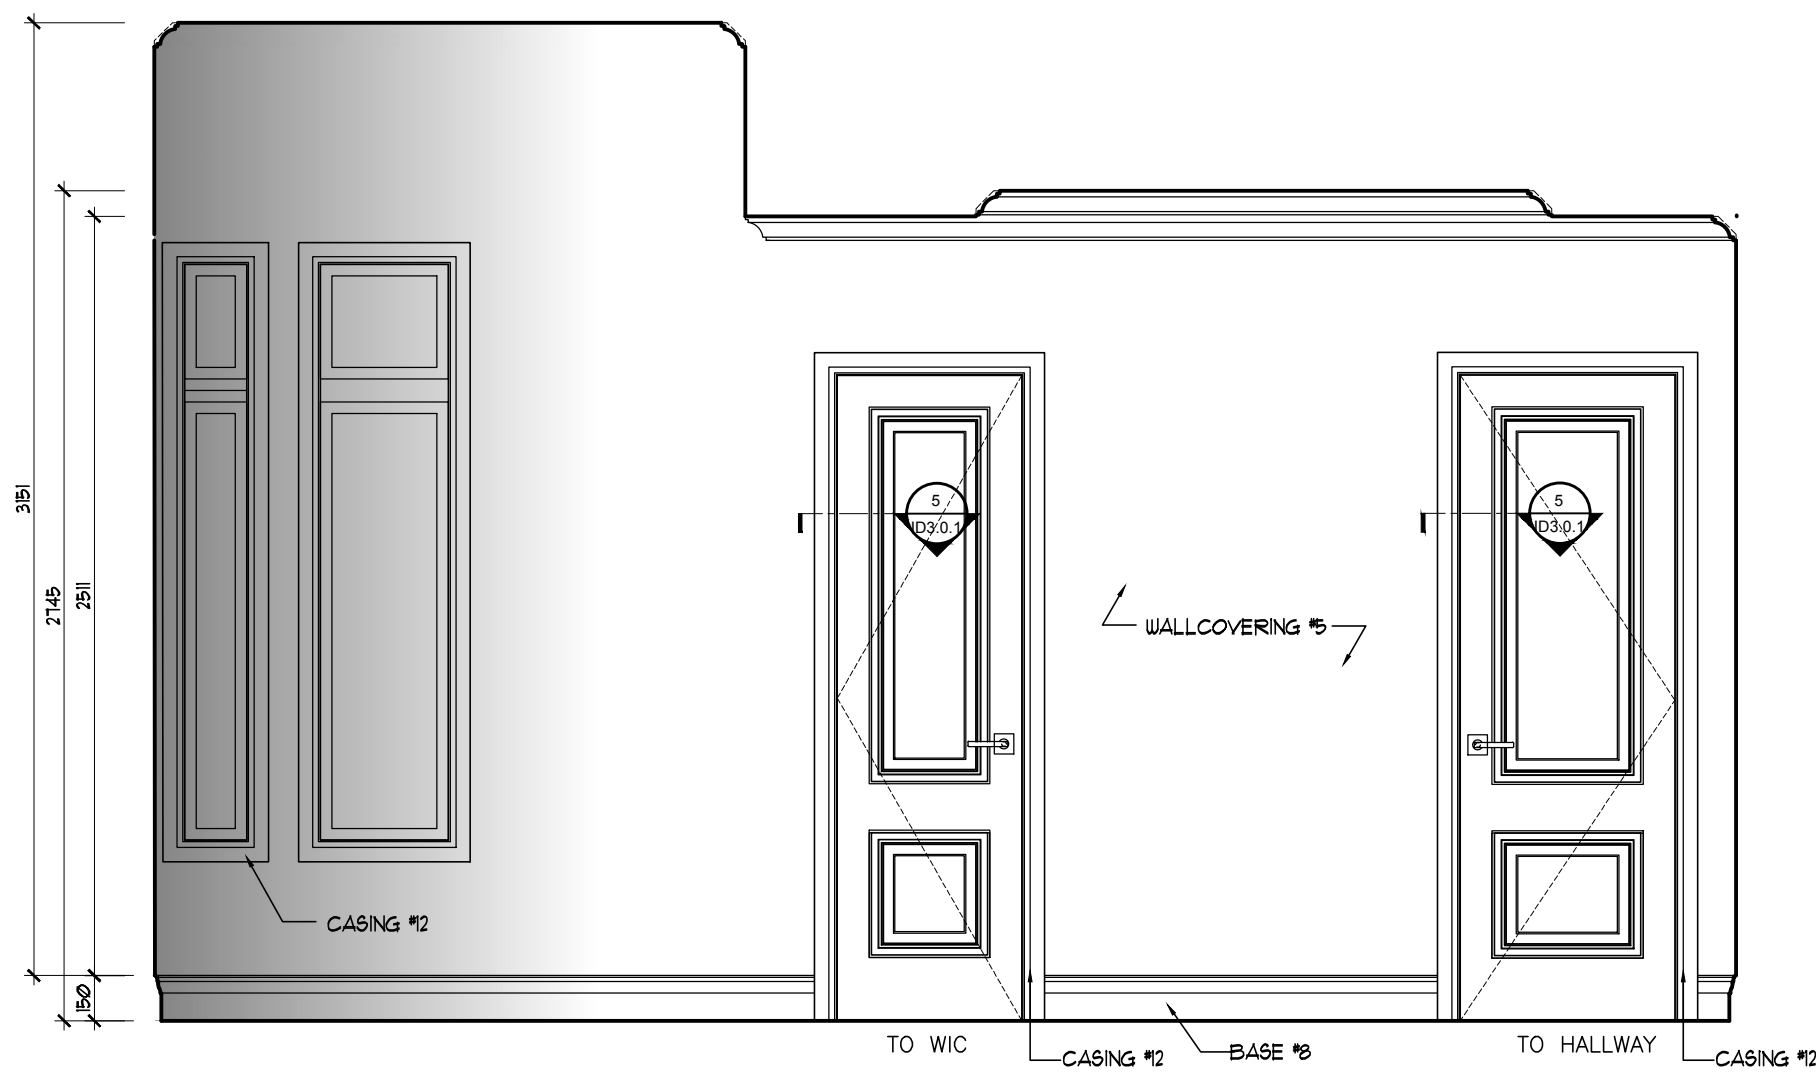


BEDROOM 2
WEST ELEVATION
12
ID2.1.0 SCALE: 1:25

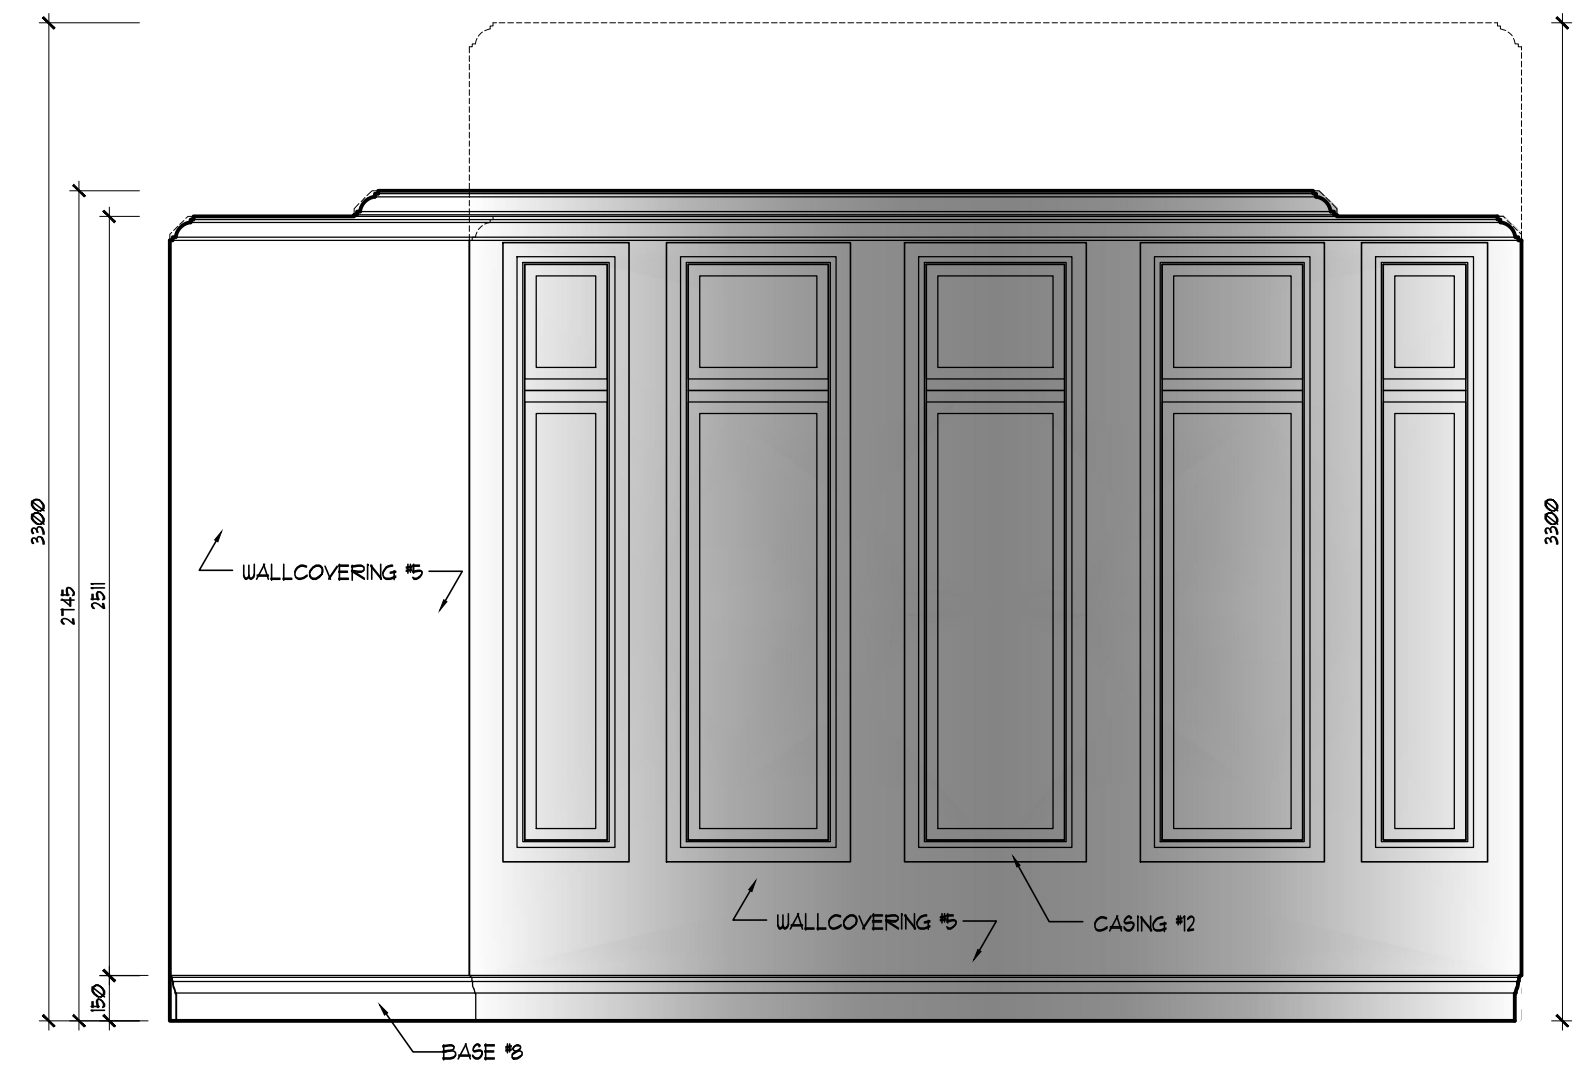


BEDROOM 2
SOUTH ELEVATION
11
ID2.1.0 SCALE: 1:25

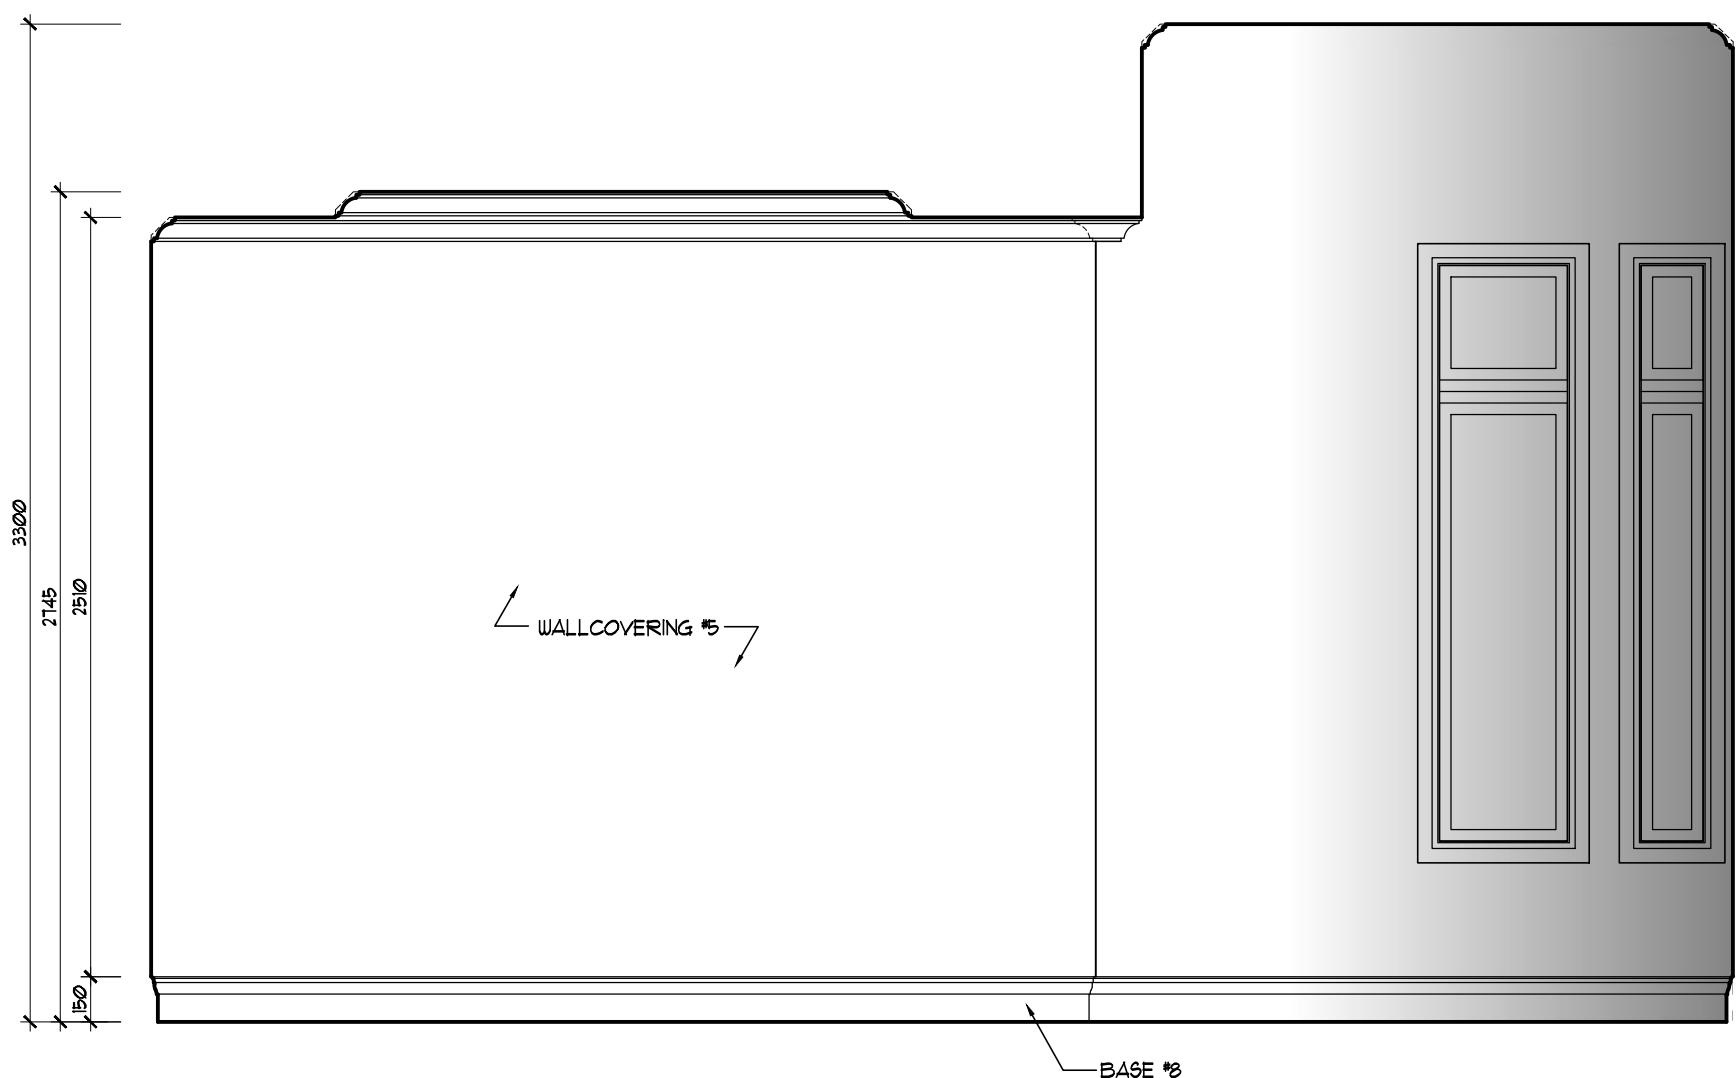


BEDROOM 2
EAST ELEVATION
10
ID2.1.0 SCALE: 1:25

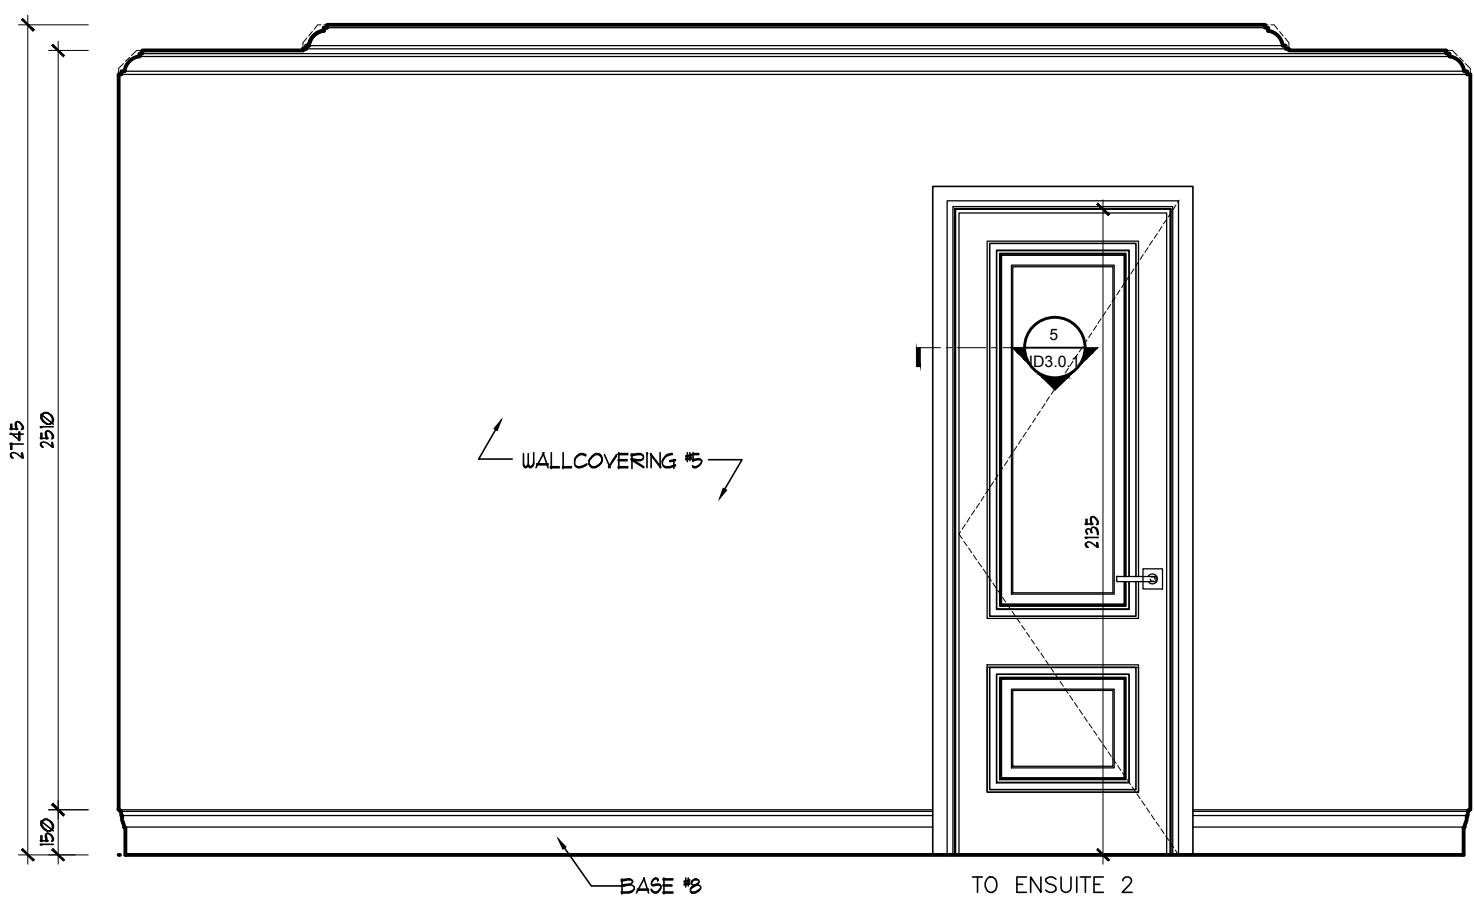


BEDROOM 2
NORTH ELEVATION
9
ID2.1.0 SCALE: 1:25

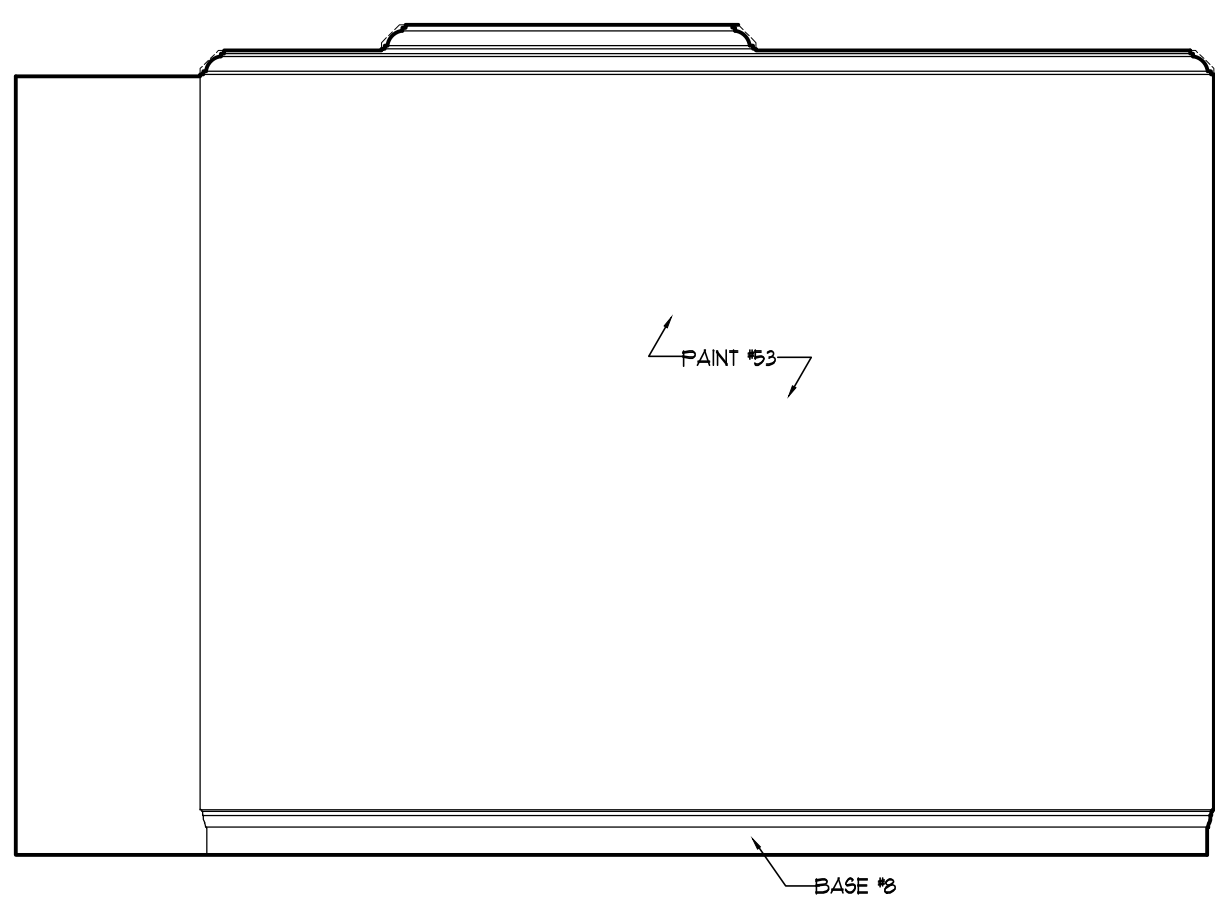


MASTER CLOSET
WEST ELEVATION
8
ID2.1.0 SCALE: 1:25

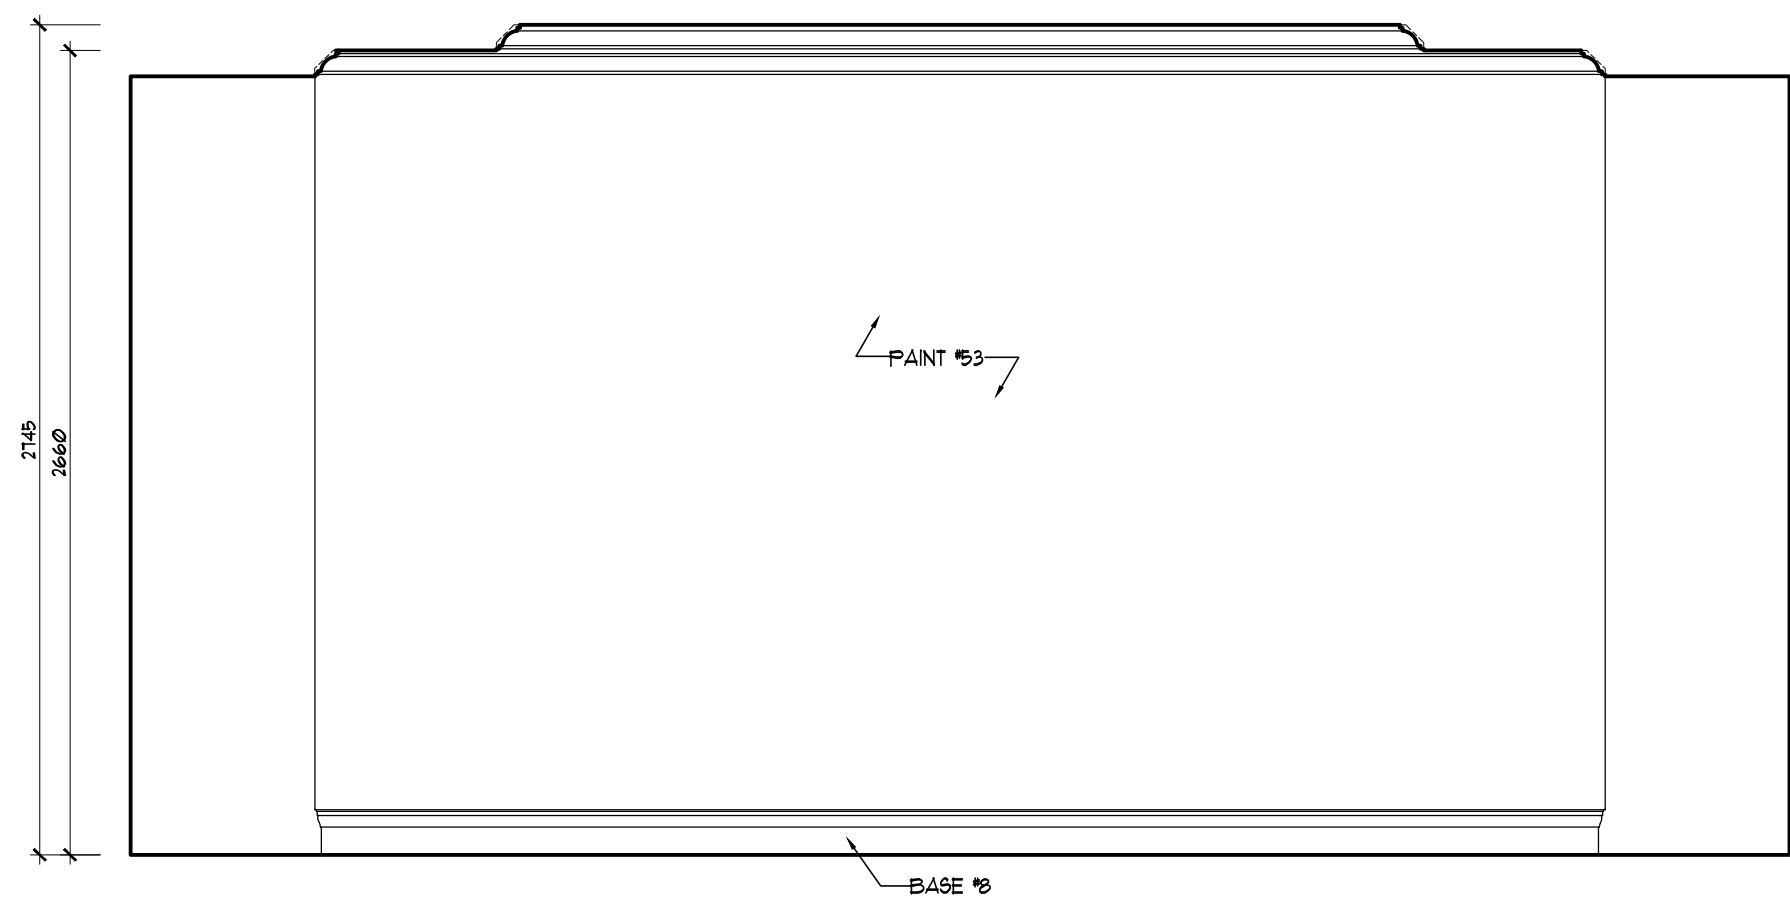


MASTER CLOSET
SOUTH ELEVATION
7
ID2.1.0 SCALE: 1:25

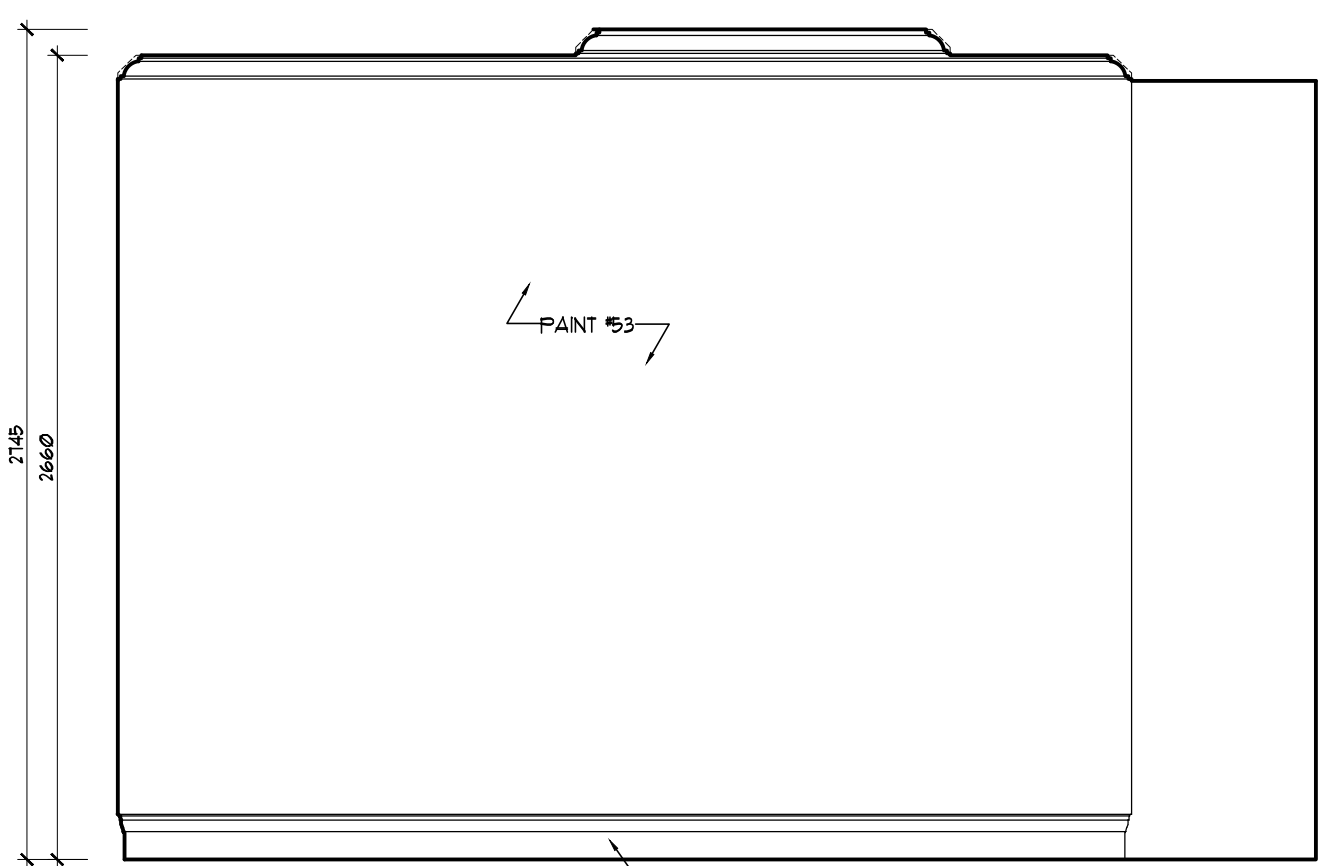


MASTER CLOSET
EAST ELEVATION
6
ID2.1.0 SCALE: 1:25

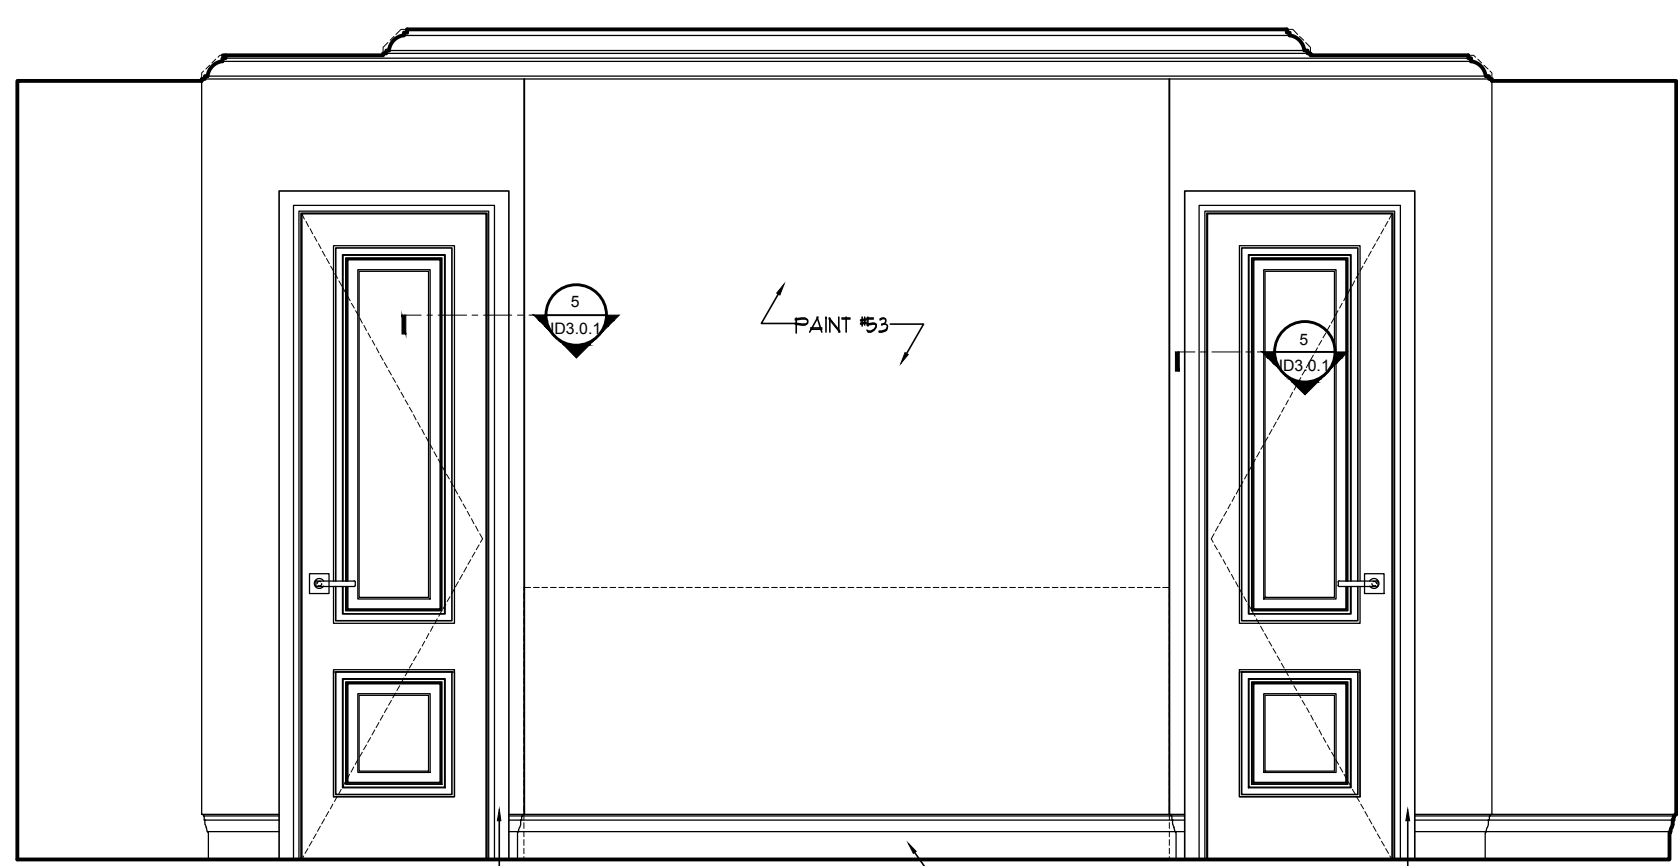


MASTER CLOSET
NORTH ELEVATION
5
ID2.1.0 SCALE: 1:25

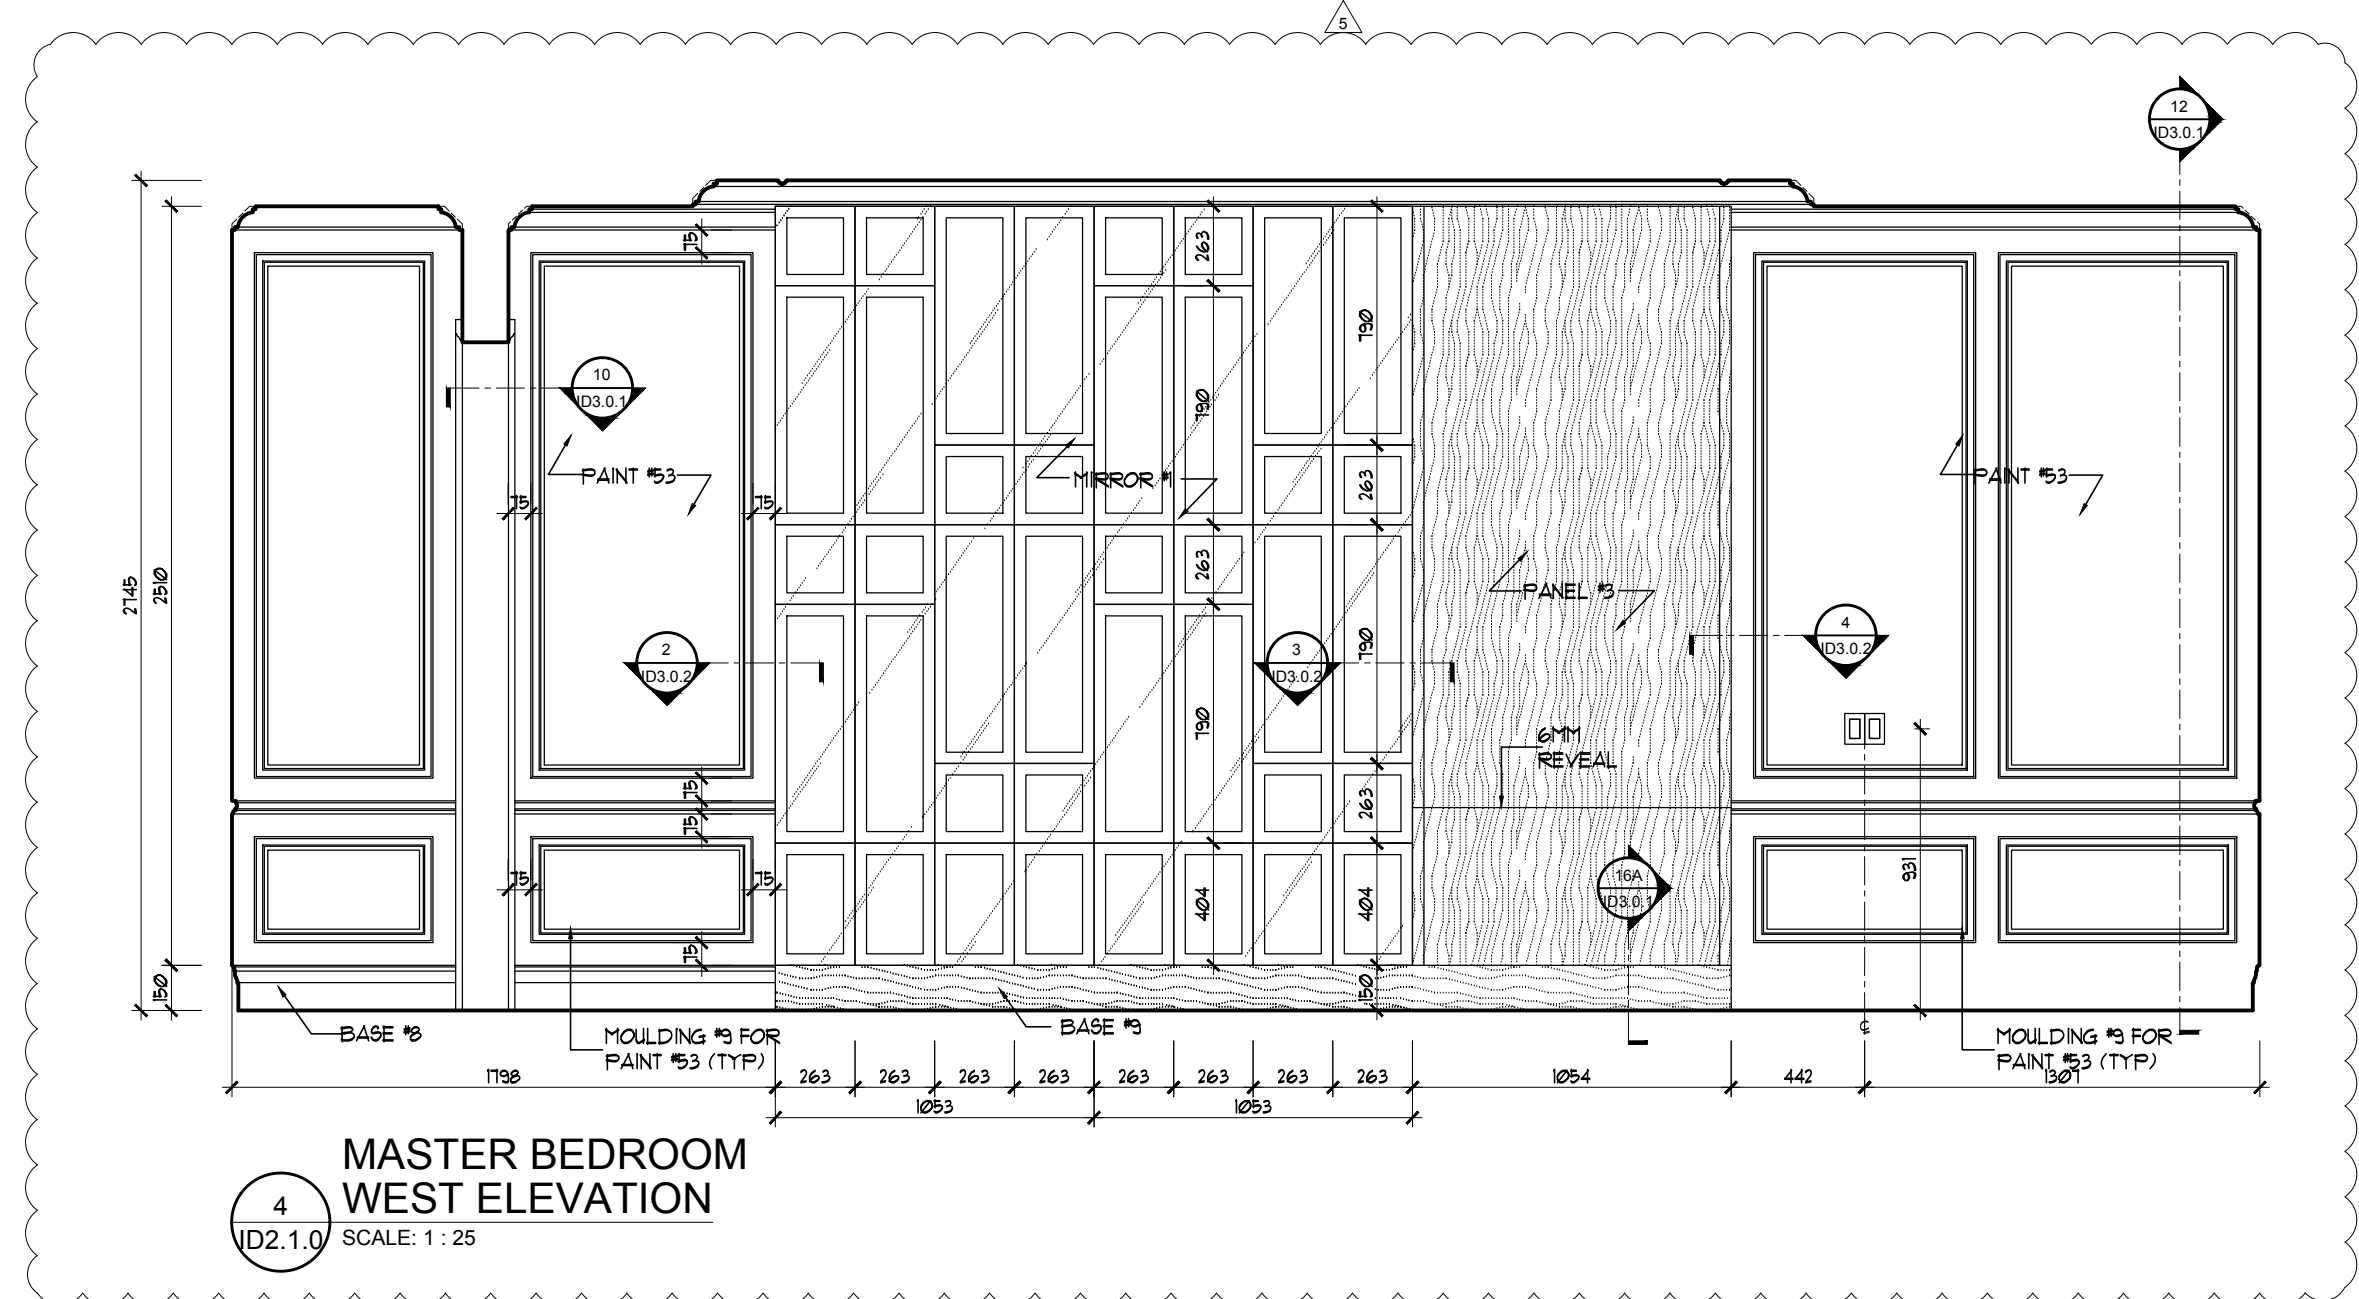


MASTER BEDROOM
WEST ELEVATION
4
ID2.1.0 SCALE: 1:25

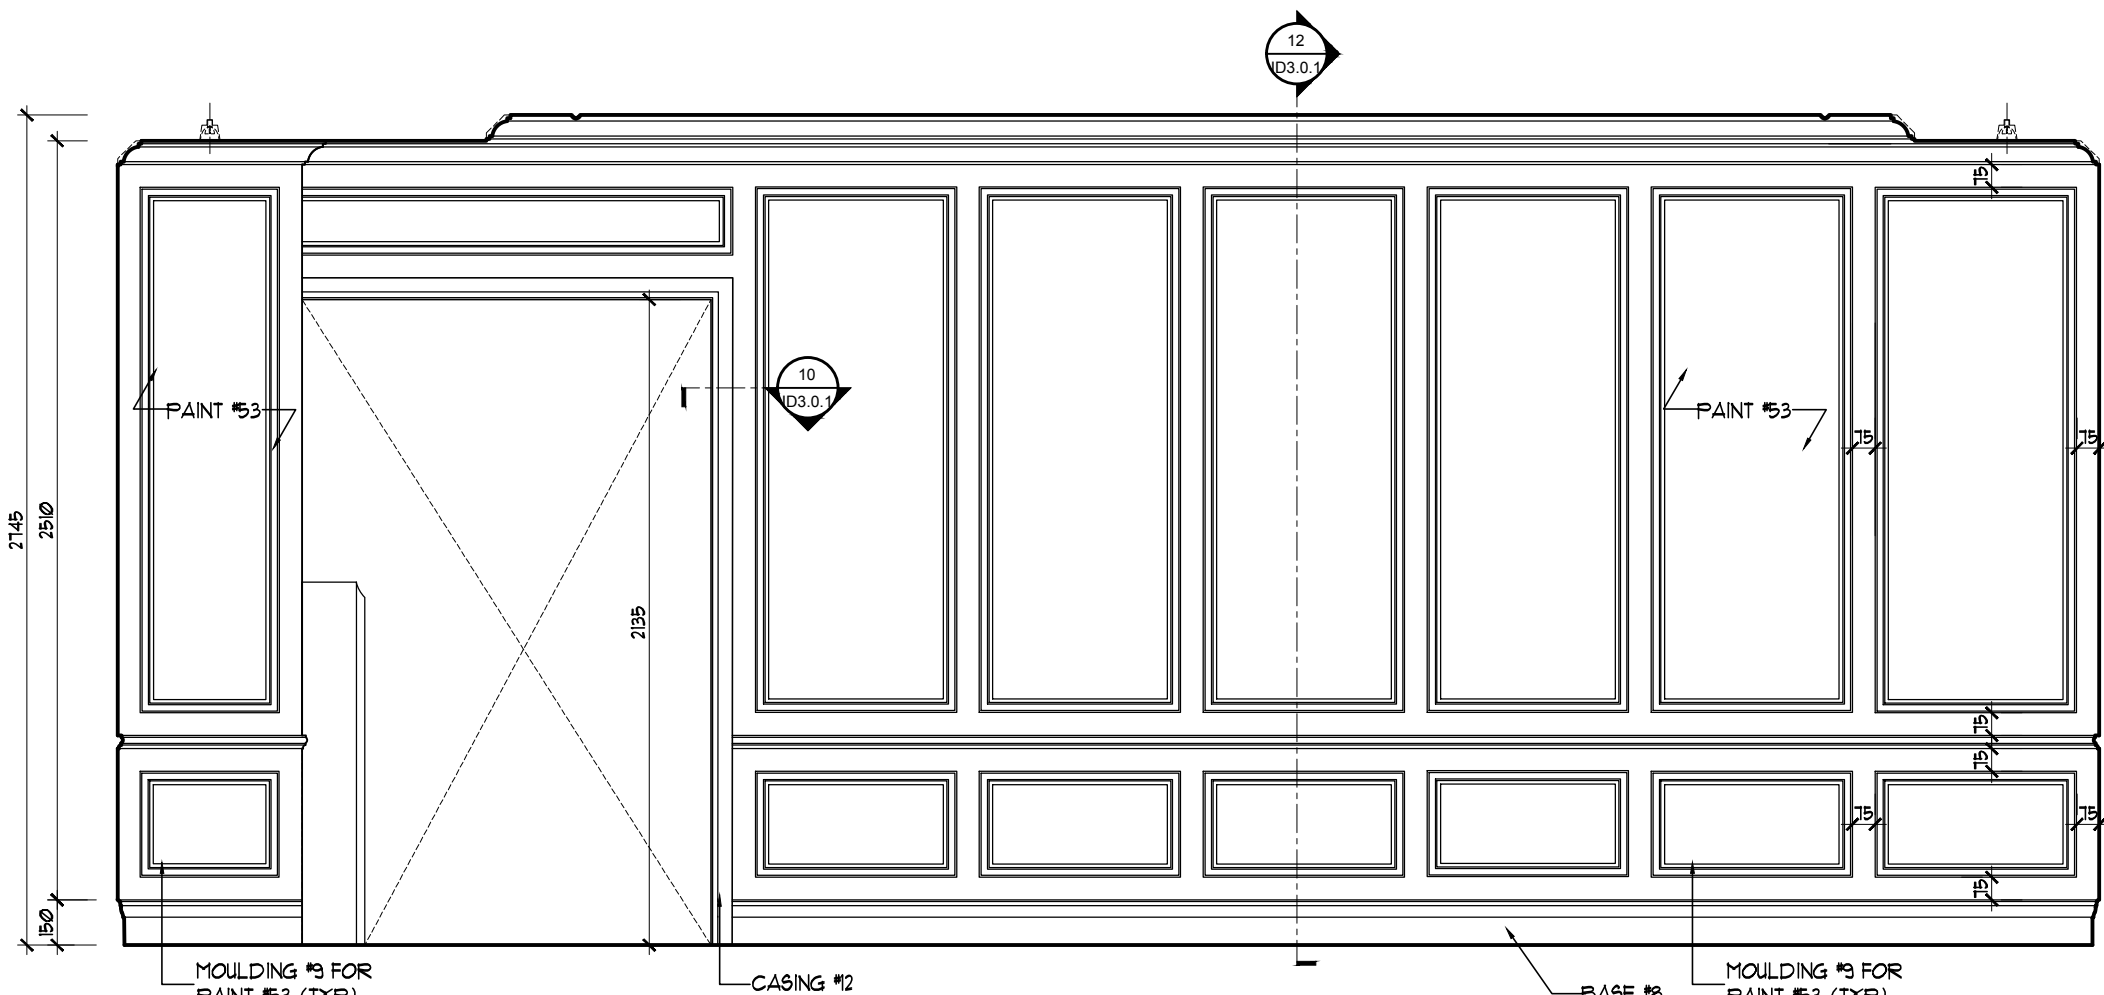


MASTER BEDROOM
SOUTH ELEVATION
3
ID2.1.0 SCALE: 1:25

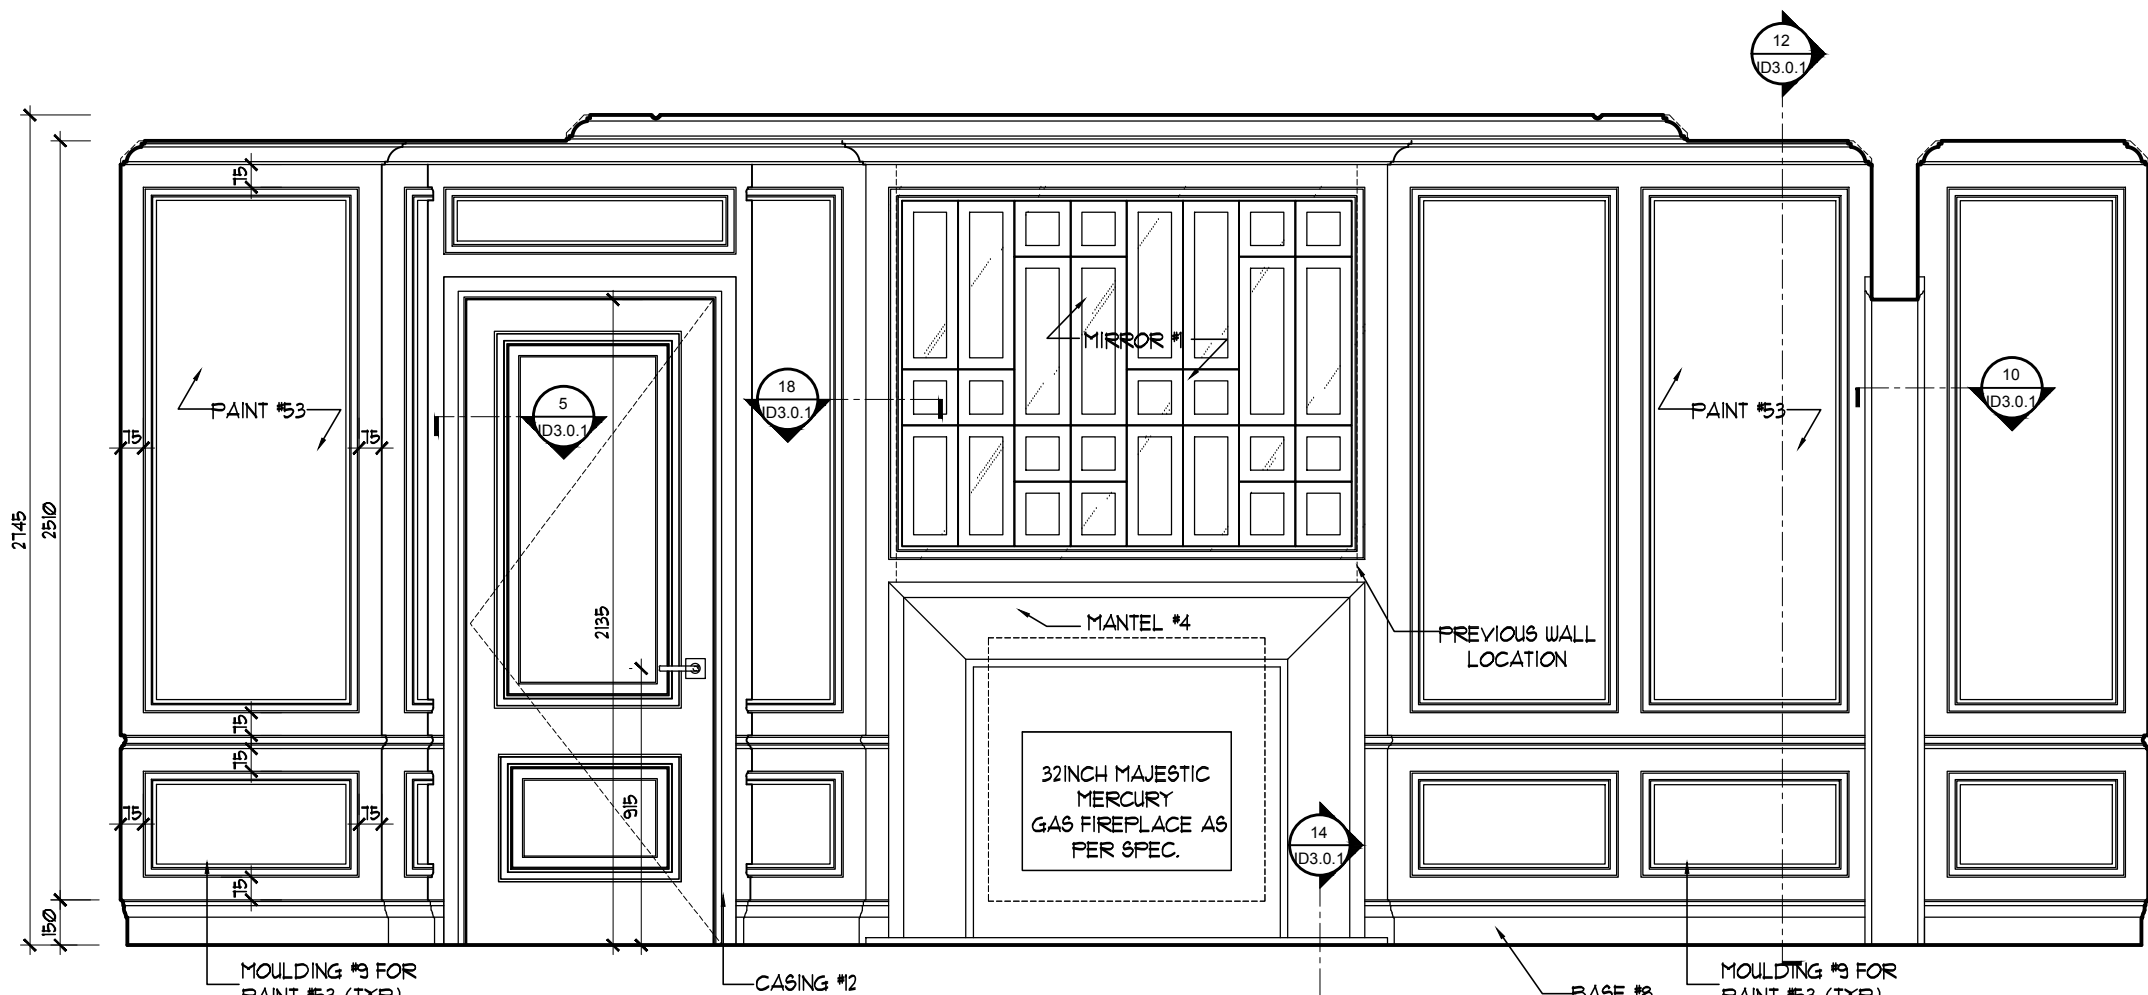

MASTER BEDROOM
EAST ELEVATION
2
ID2.1.0 SCALE: 1:25

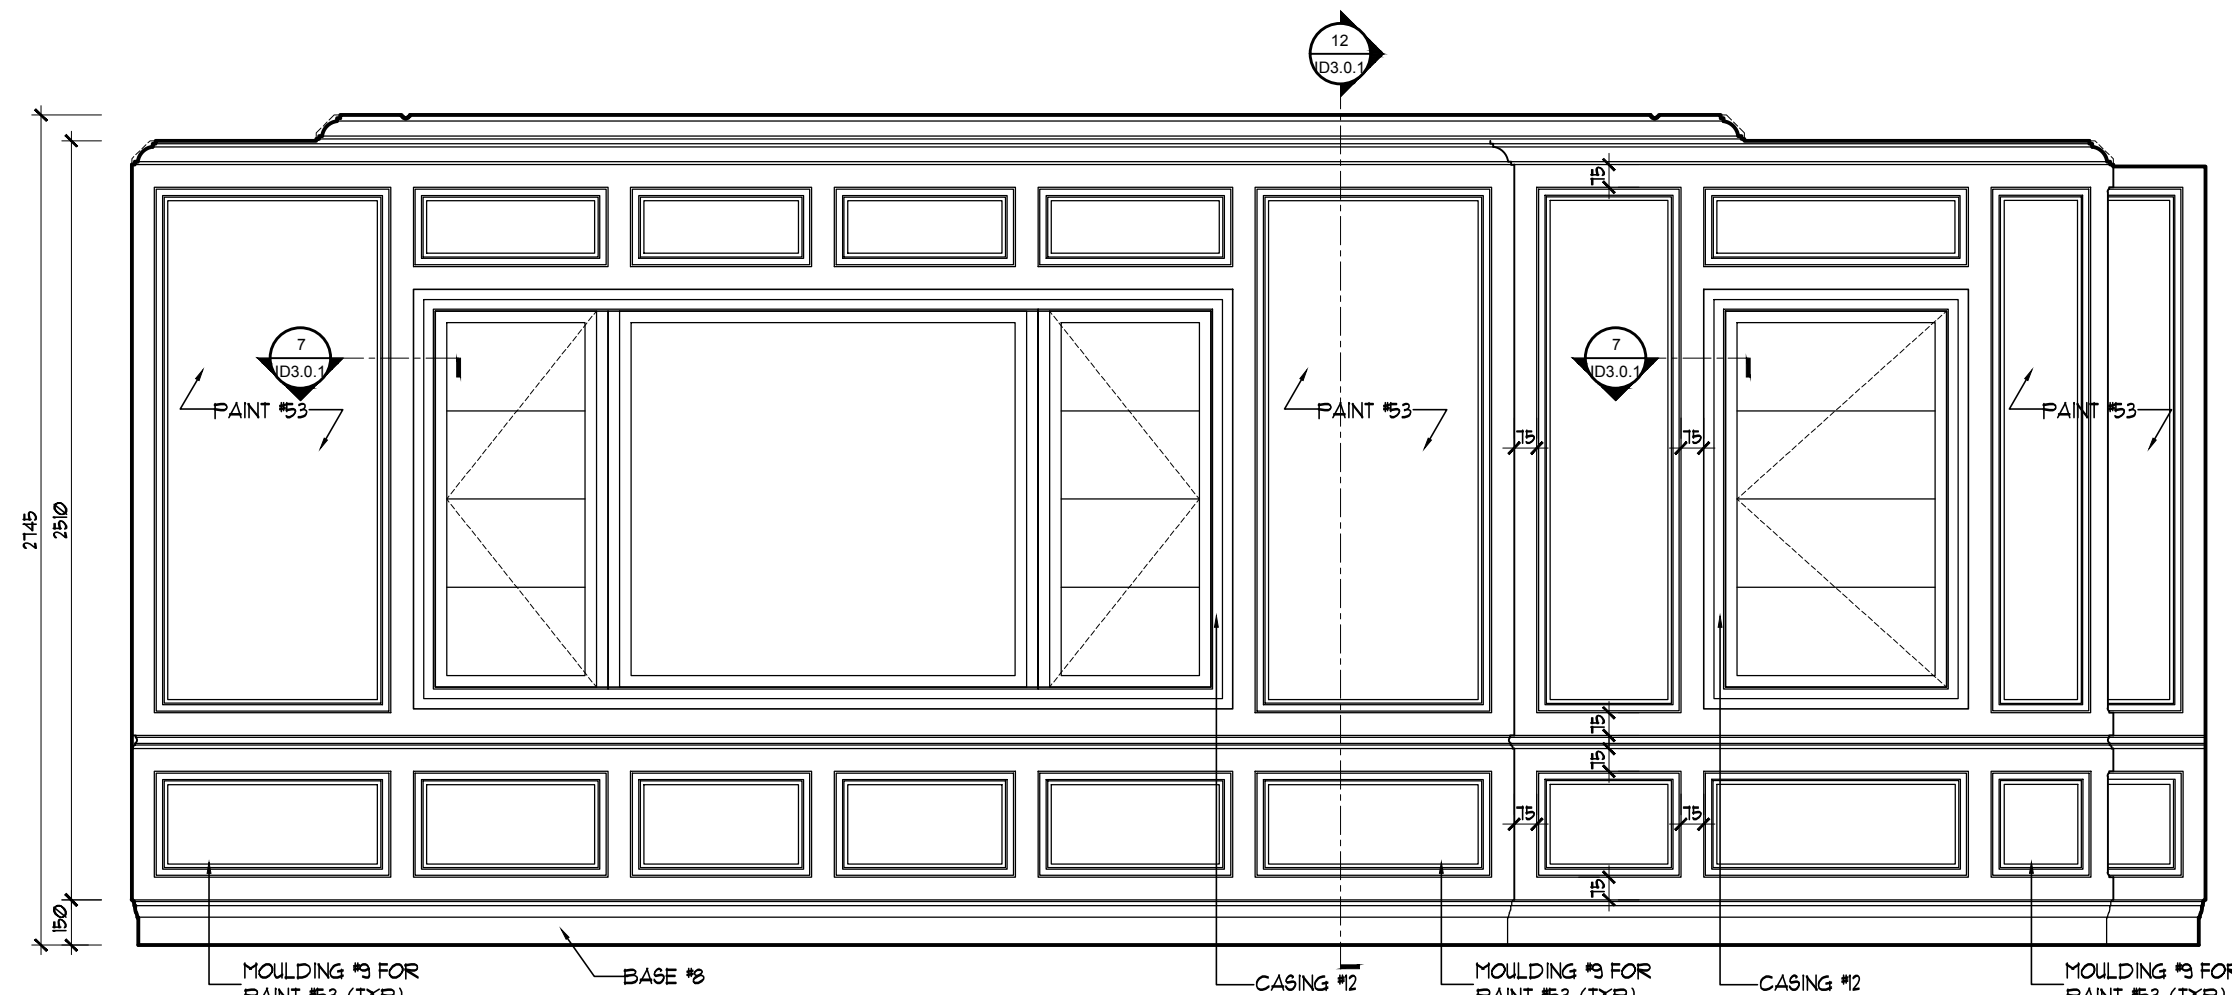

MASTER BEDROOM
NORTH ELEVATION
1
ID2.1.0 SCALE: 1:25

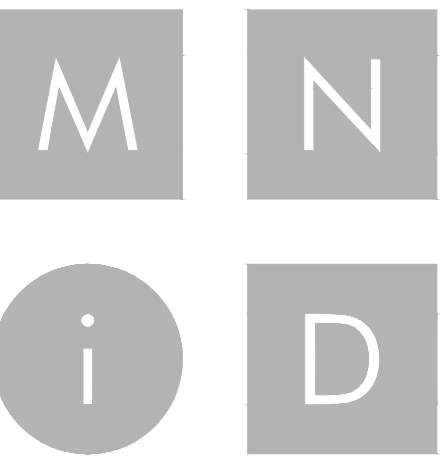

MIKE NIVEN INTERIOR DESIGN INC.
100 BROADVIEW AVE. S. 3RD FLOOR, TORONTO, CANADA M4M 3B3
TEL: 416.783.7404 • FAX: 416.783.7404

ISSUED FOR
PLUMBING &
APPLIANCES

No.	Date	Revision	By	CHK
1	18/04/2019	ADJUSTED AS SHOWN	RG	MM
2	15/05/2019	ADJUSTED AS SHOWN	RG	MM
3	24/05/2019	ADJUSTED AS SHOWN	RG	MM
4	11/06/2019	ADJUSTED AS SHOWN	RG	MM
5	11/06/2019	CHANGE NOTICE #9	RS	MM
6	02/06/20	CHANGE NOTICE #10	NVRS	MM

4	11/02/2019	ISSUED FOR PRICING FOR TRIM AND MILLWORK	RS	MM
3	10/22/2019	ISSUED FOR PRICING FOR GLASS AND TILES ONLY	HD	MM
2	15/05/2019	ISSUED FOR PLUMBING & APPLIANCES	RG	MM
1	18/04/2019	ISSUED FOR COORDINATION	RG	MM

No.	Date	Issue	By	CHK
-----	------	-------	----	-----

NOTE: **DONOT SCALE DRAWINGS**
It is the contractor's responsibility to verify all specifications and dimensions and report any discrepancies to the designer prior to construction. Materials may not be substituted without designer's written approval.
















PROJECT:
PINEVALLEY
KNIGHTSWOOD, LOT 93

GOLDPARK HOMES
CONCORD, ON

DRAWING:
SECOND FLOOR
ELEVATIONS

DESIGNER'S:
MIKE NIVEN
DRAWN BY:
M-Tec Inc.
DATE:
FEB 2019
SCALE:
1:25
PROJECT NO:
2018-10

ID
2.1.1

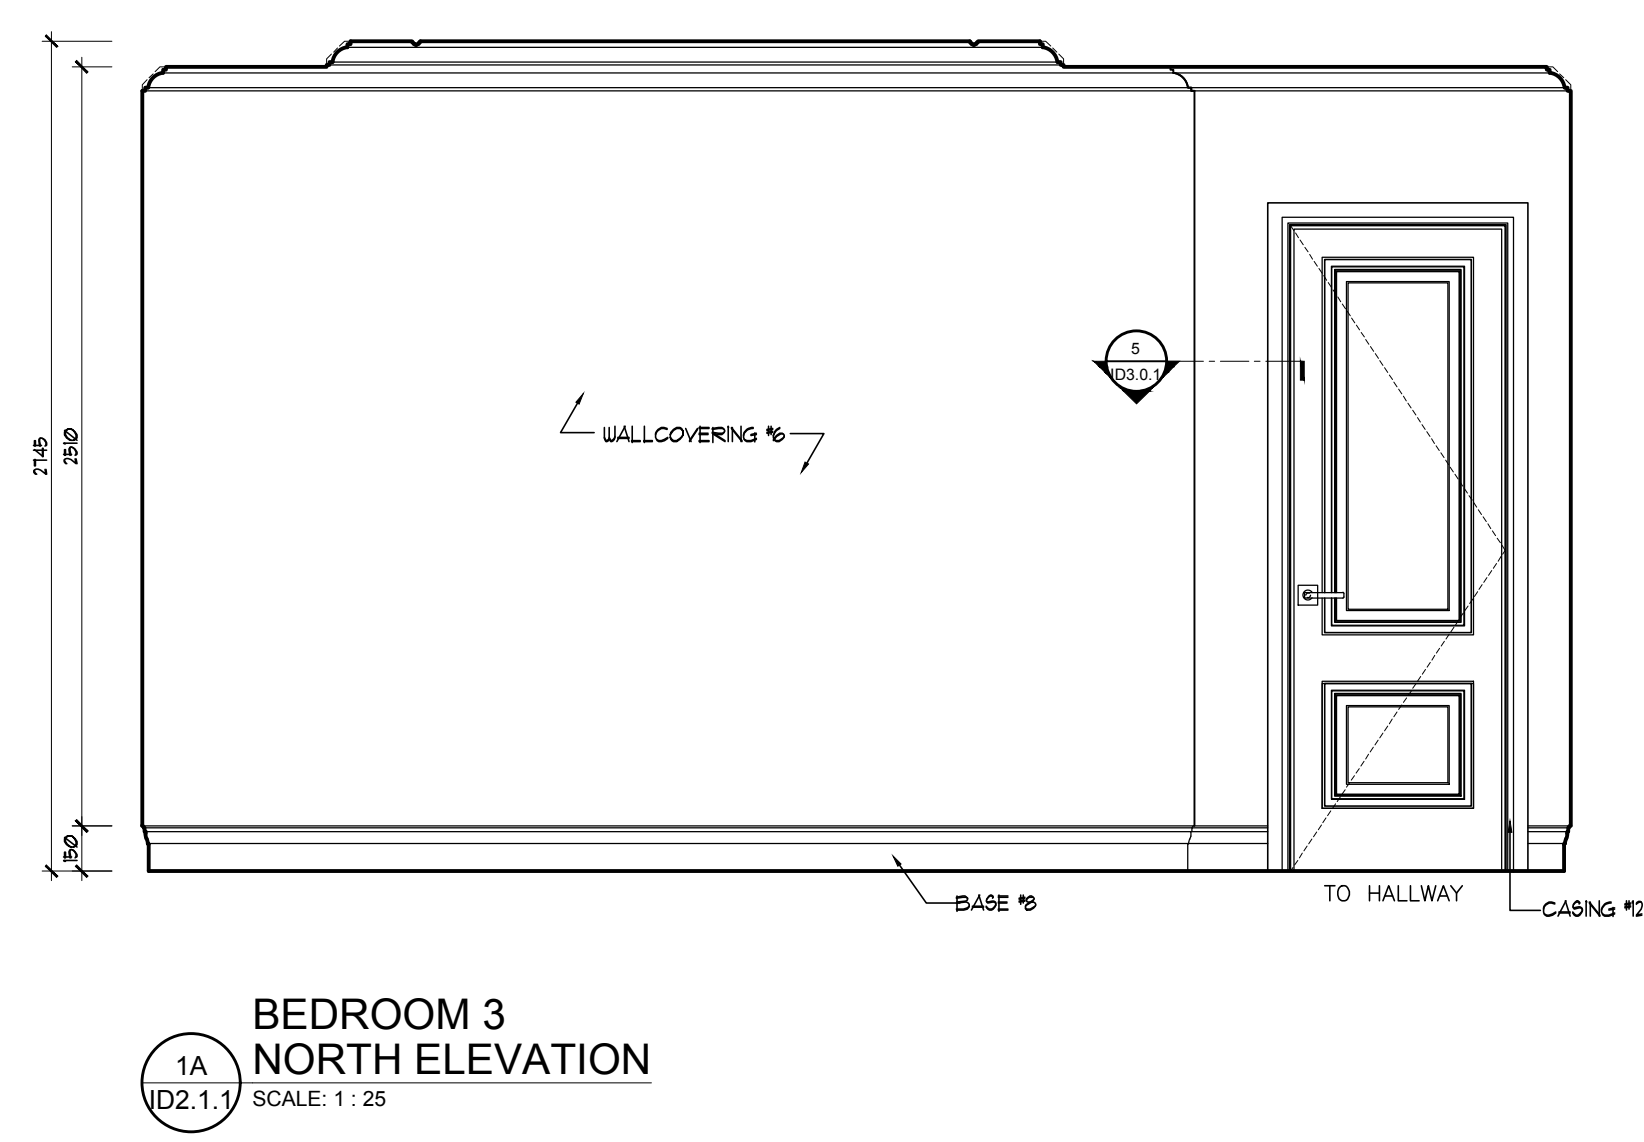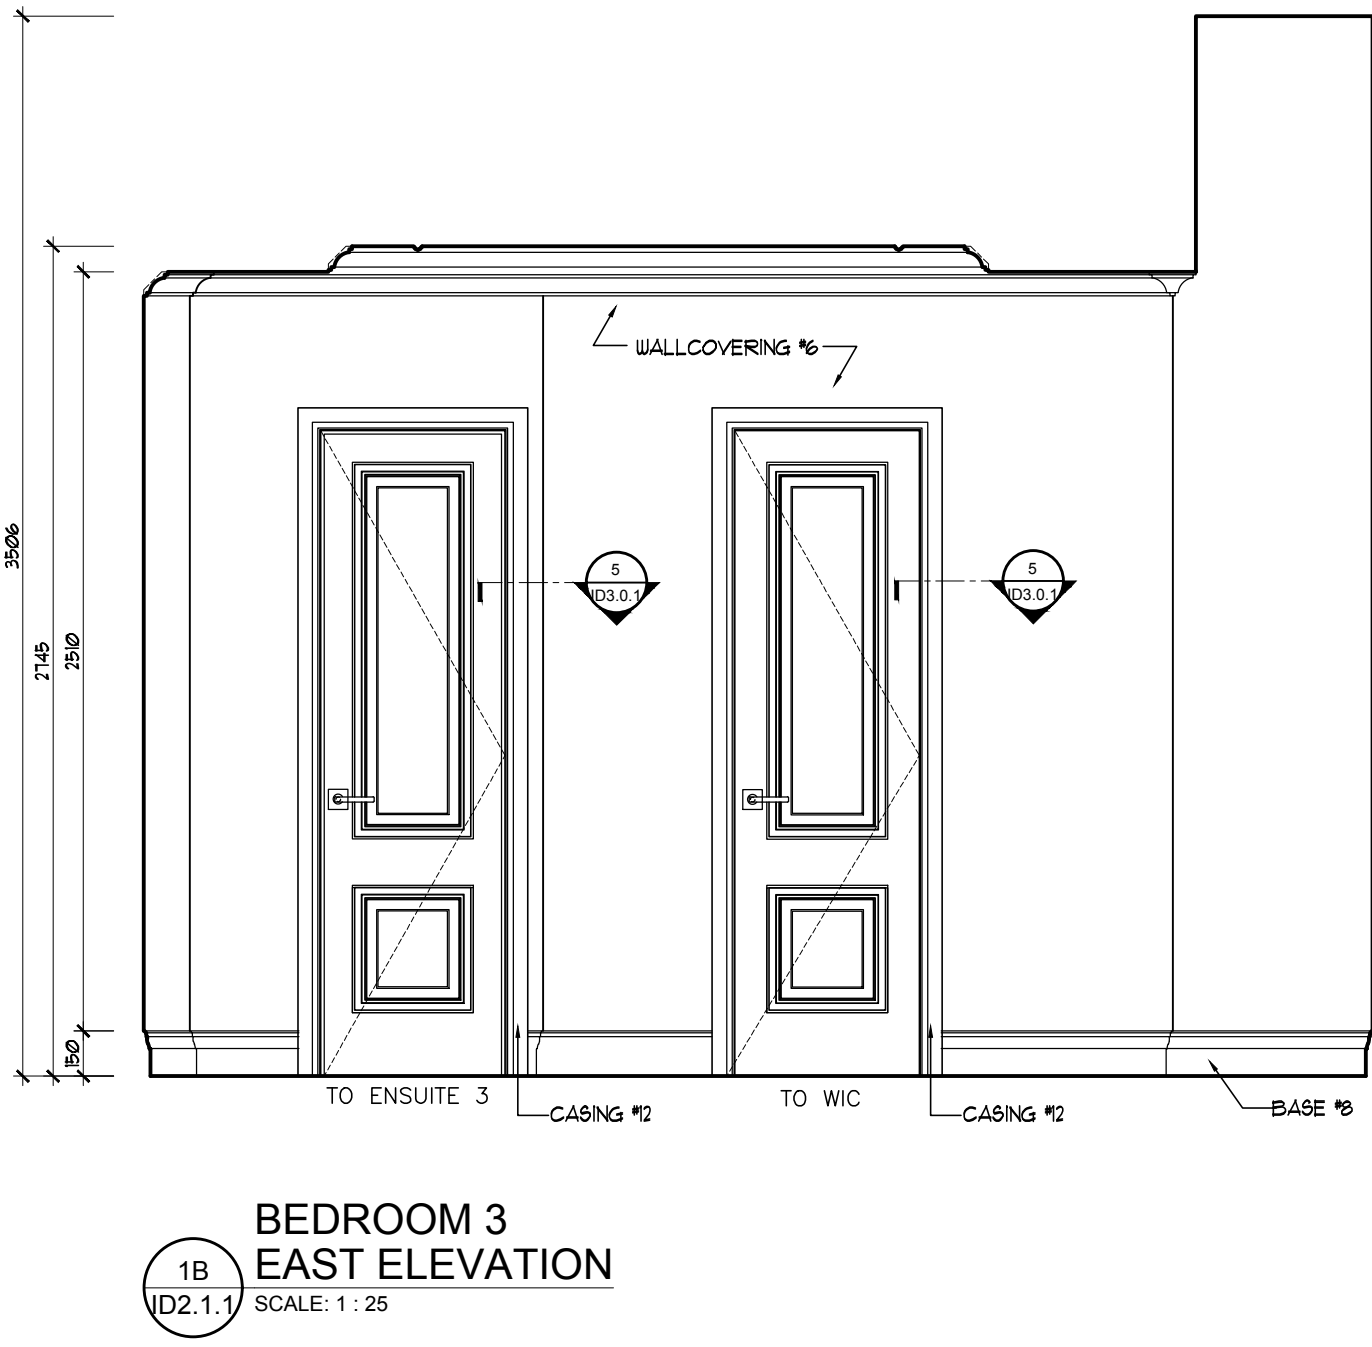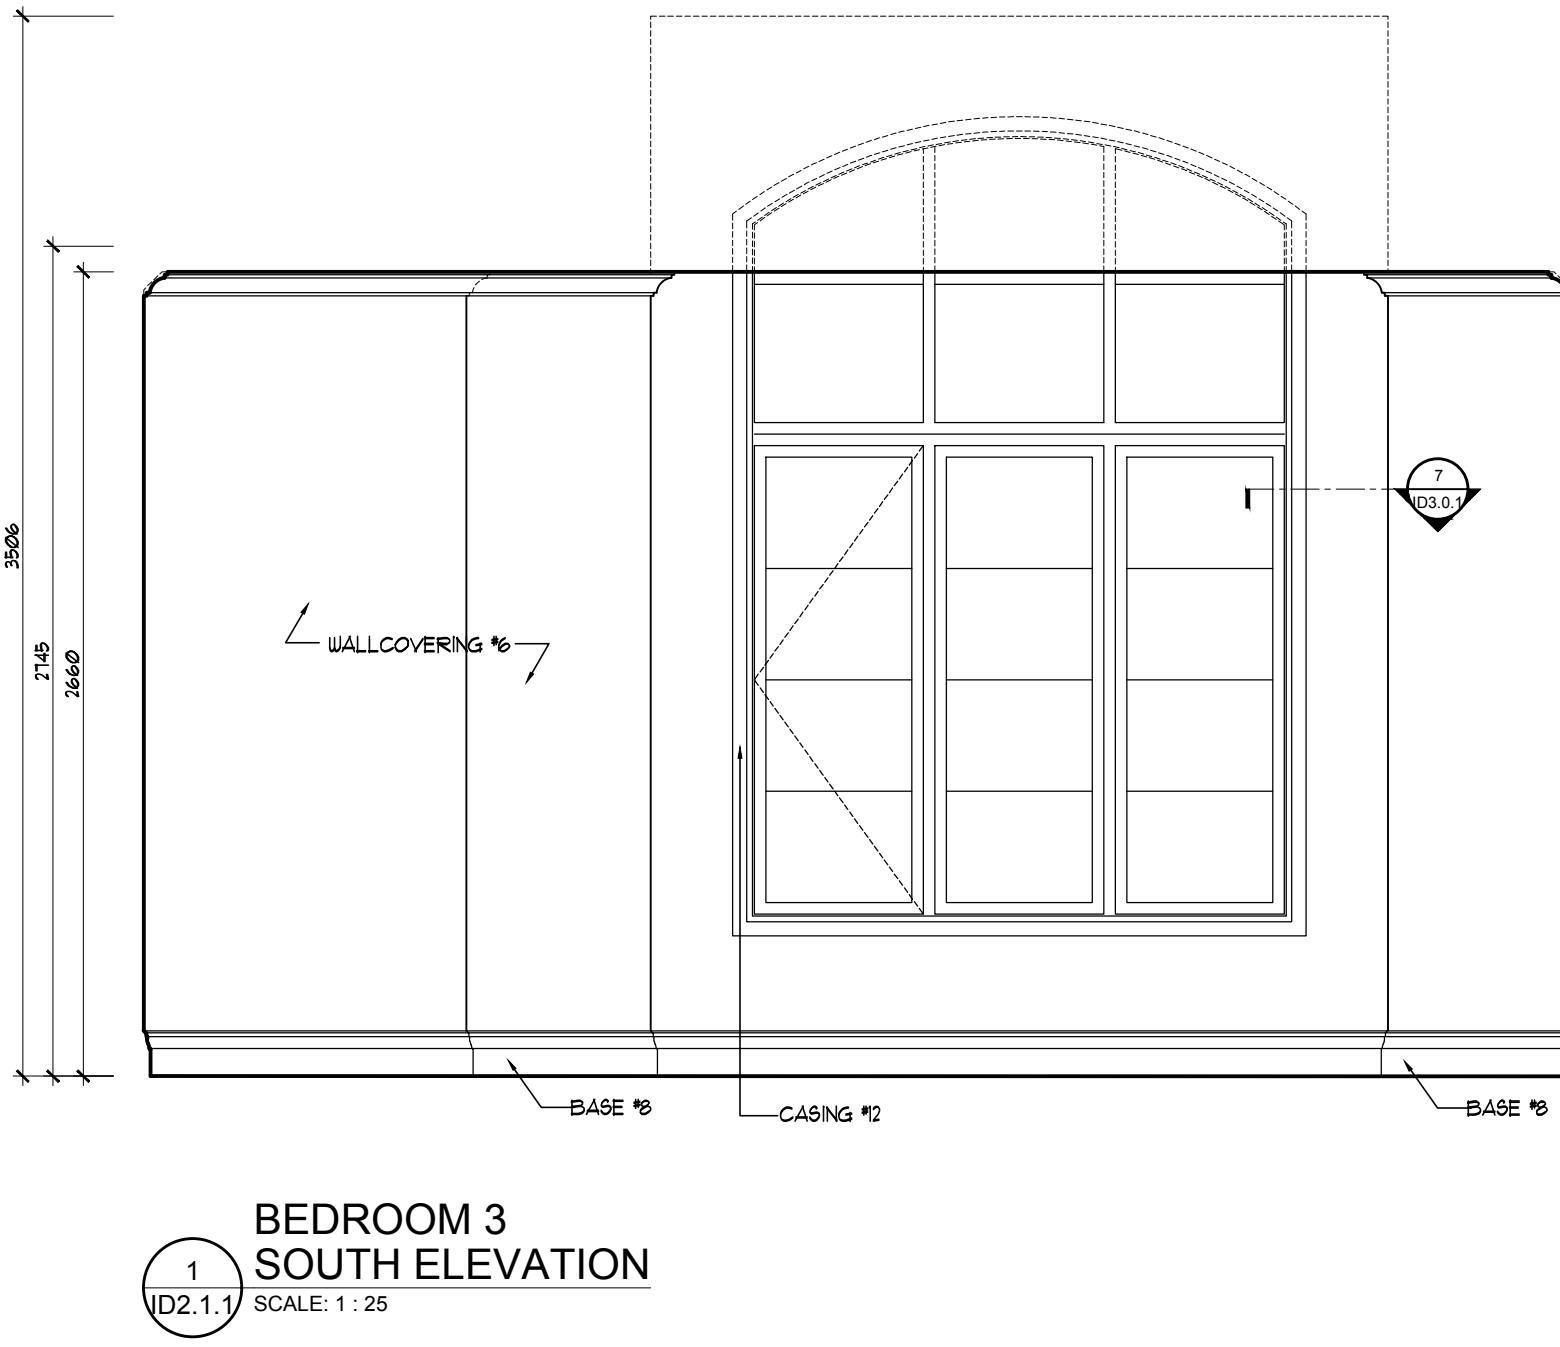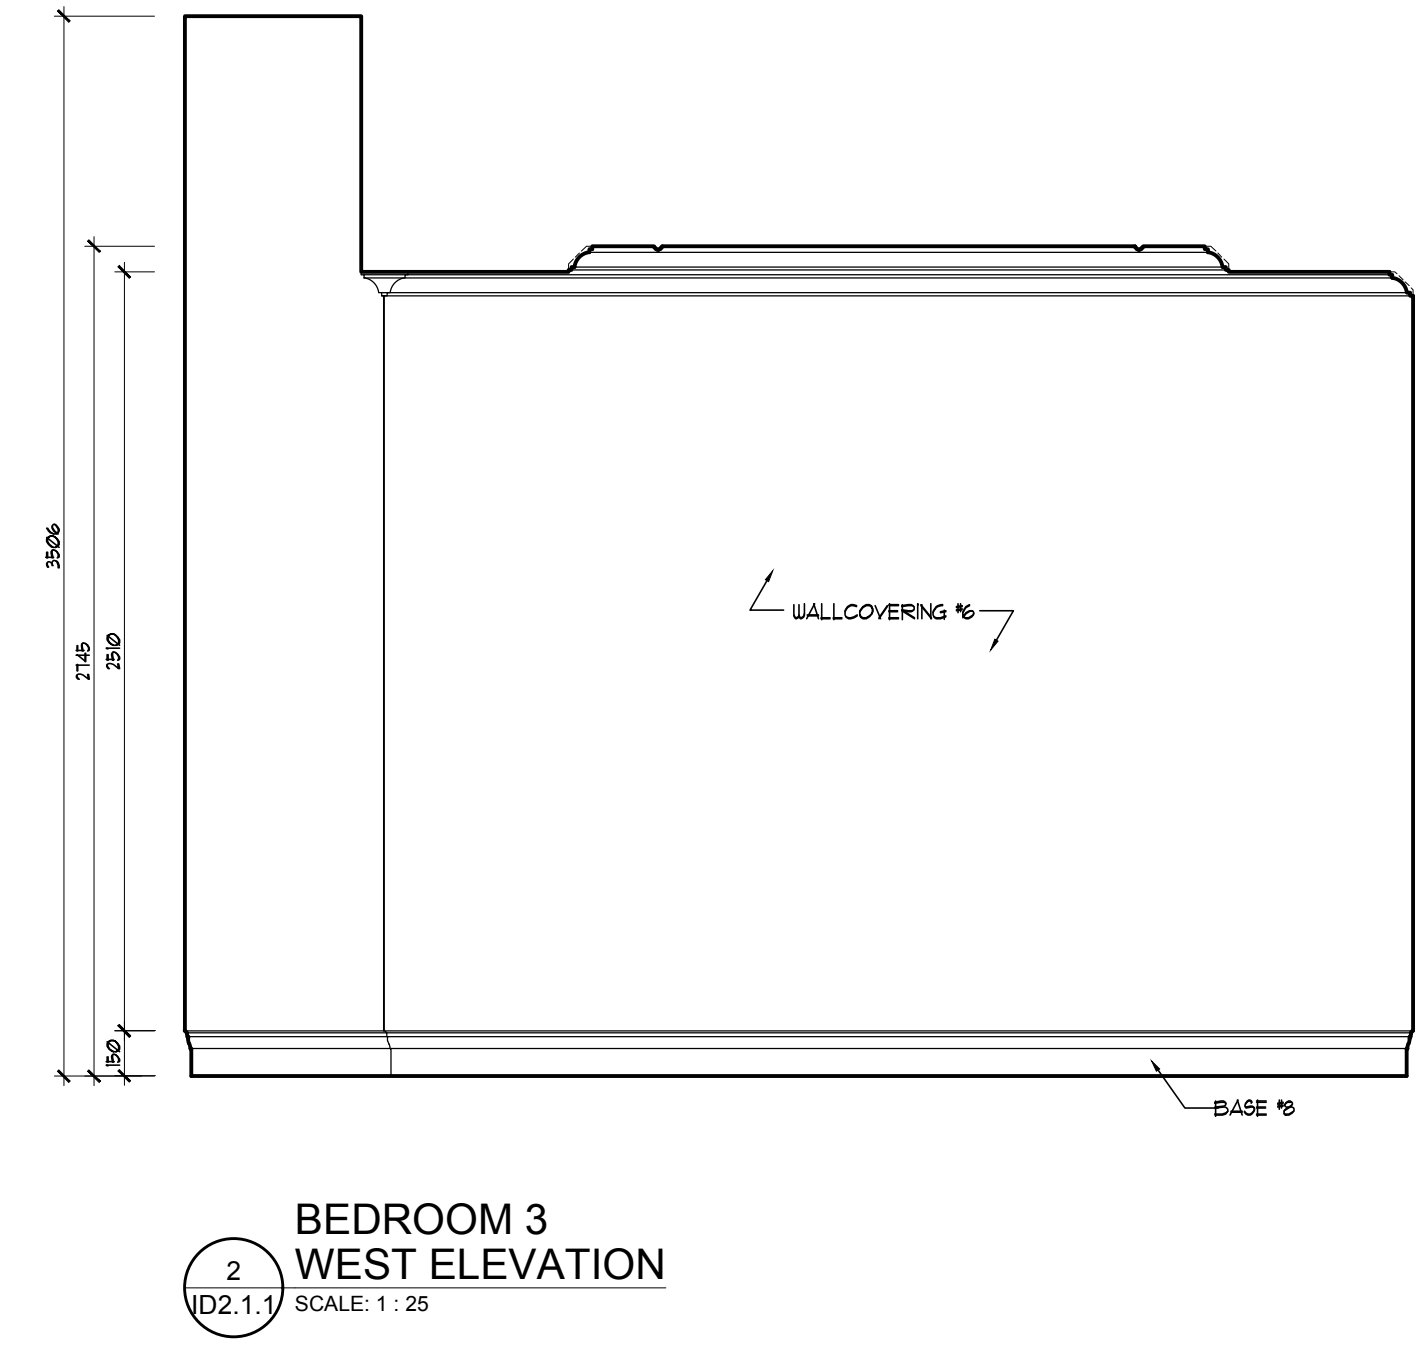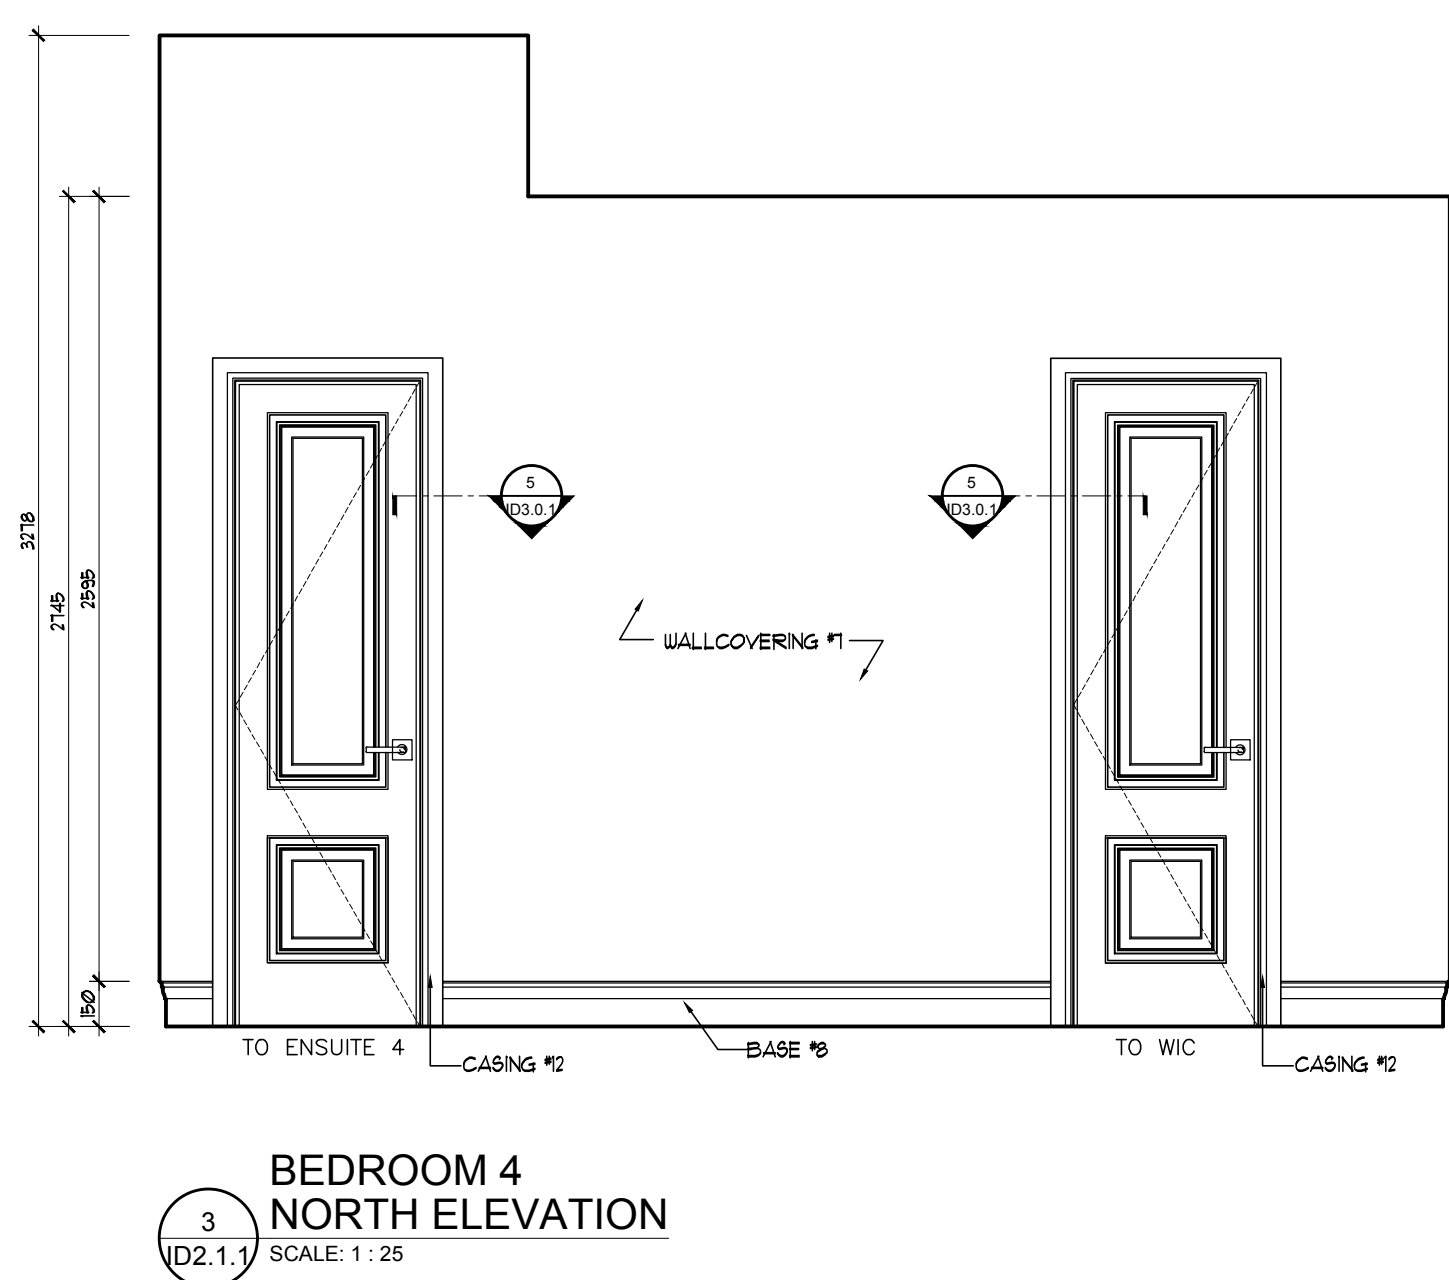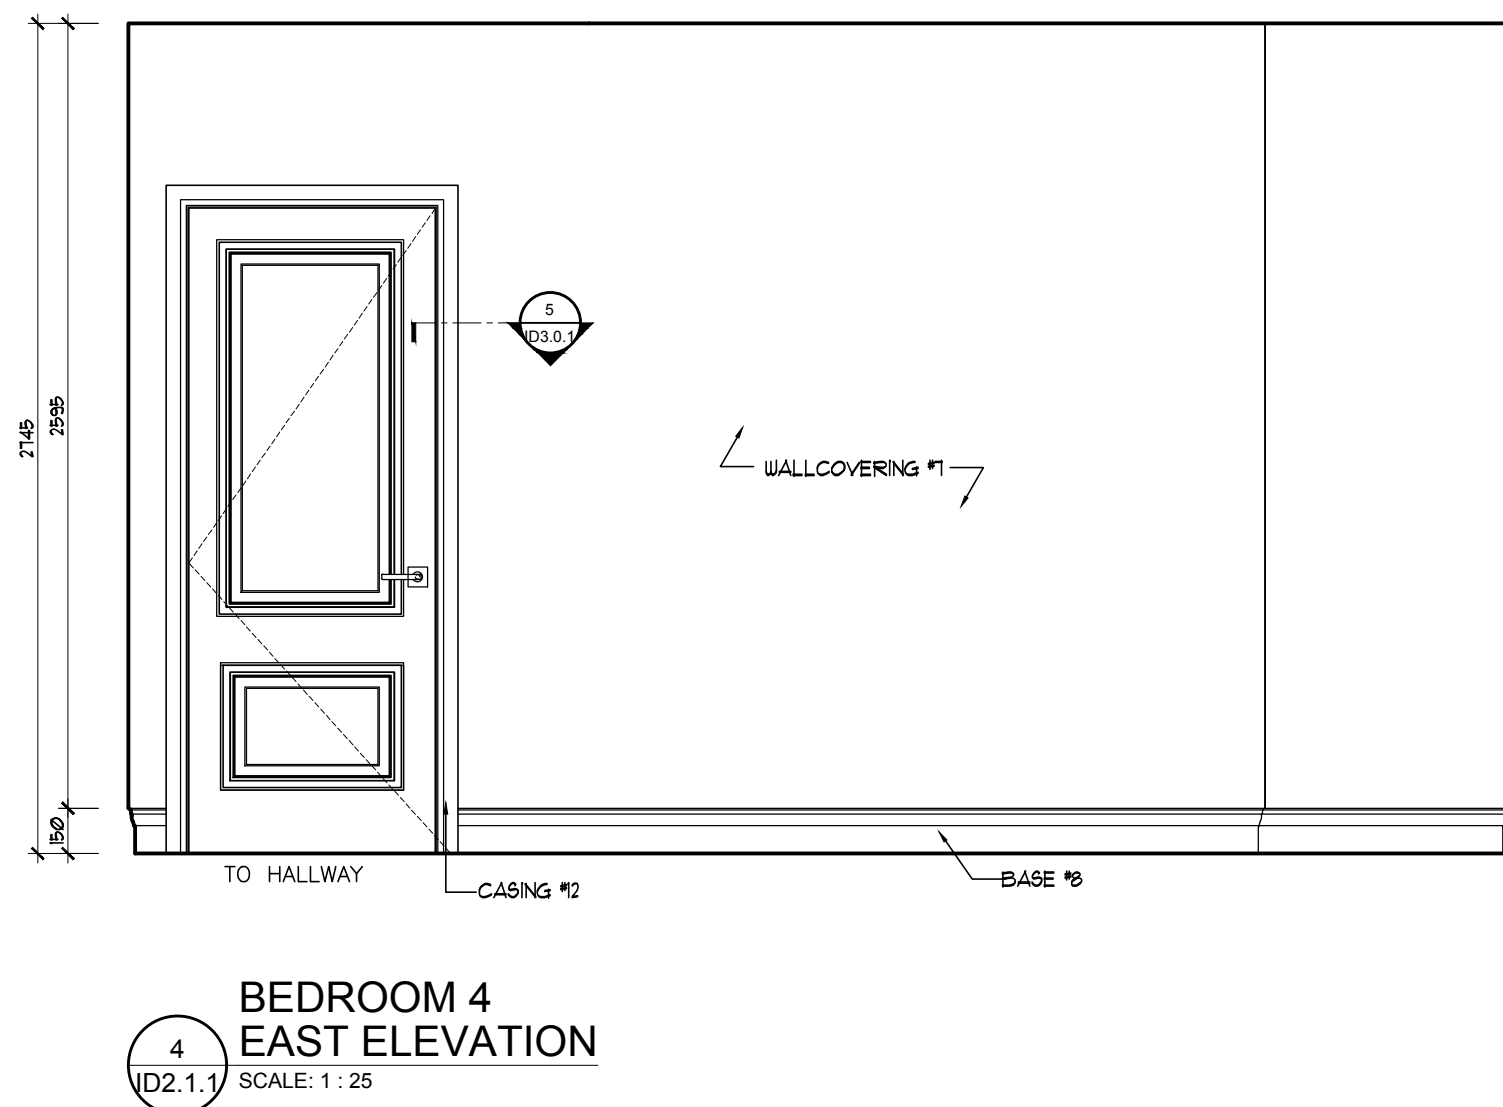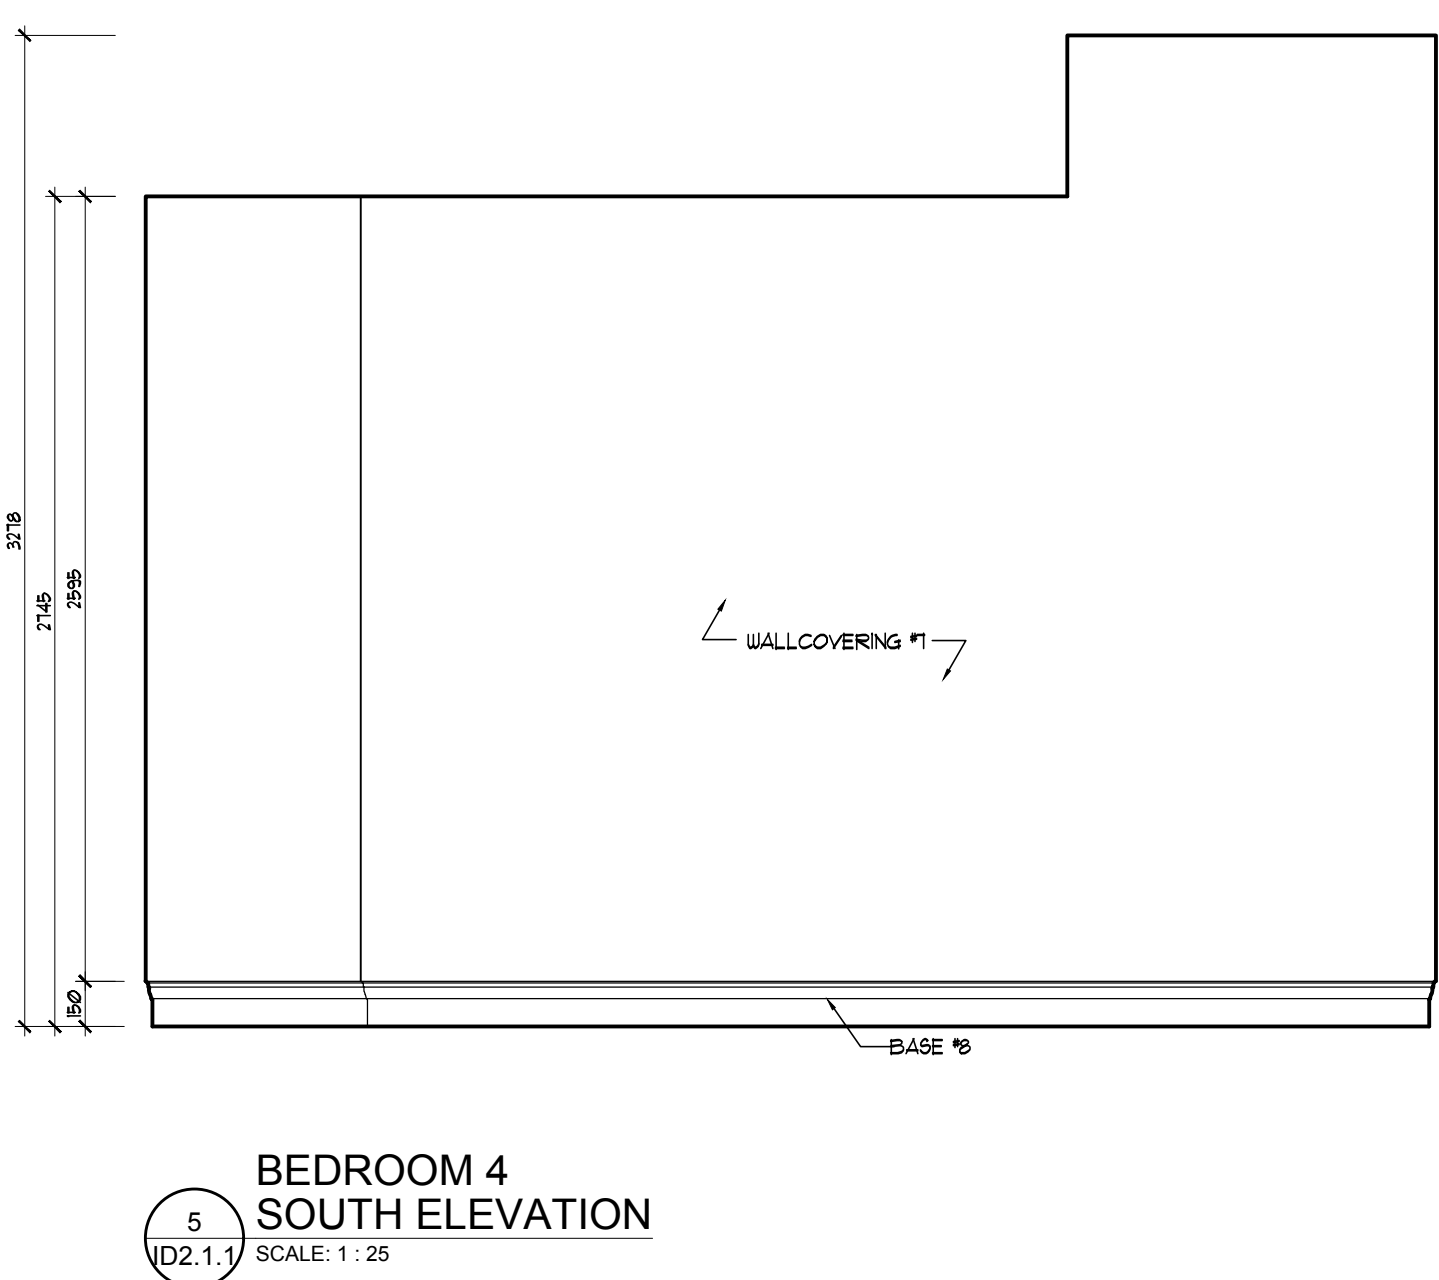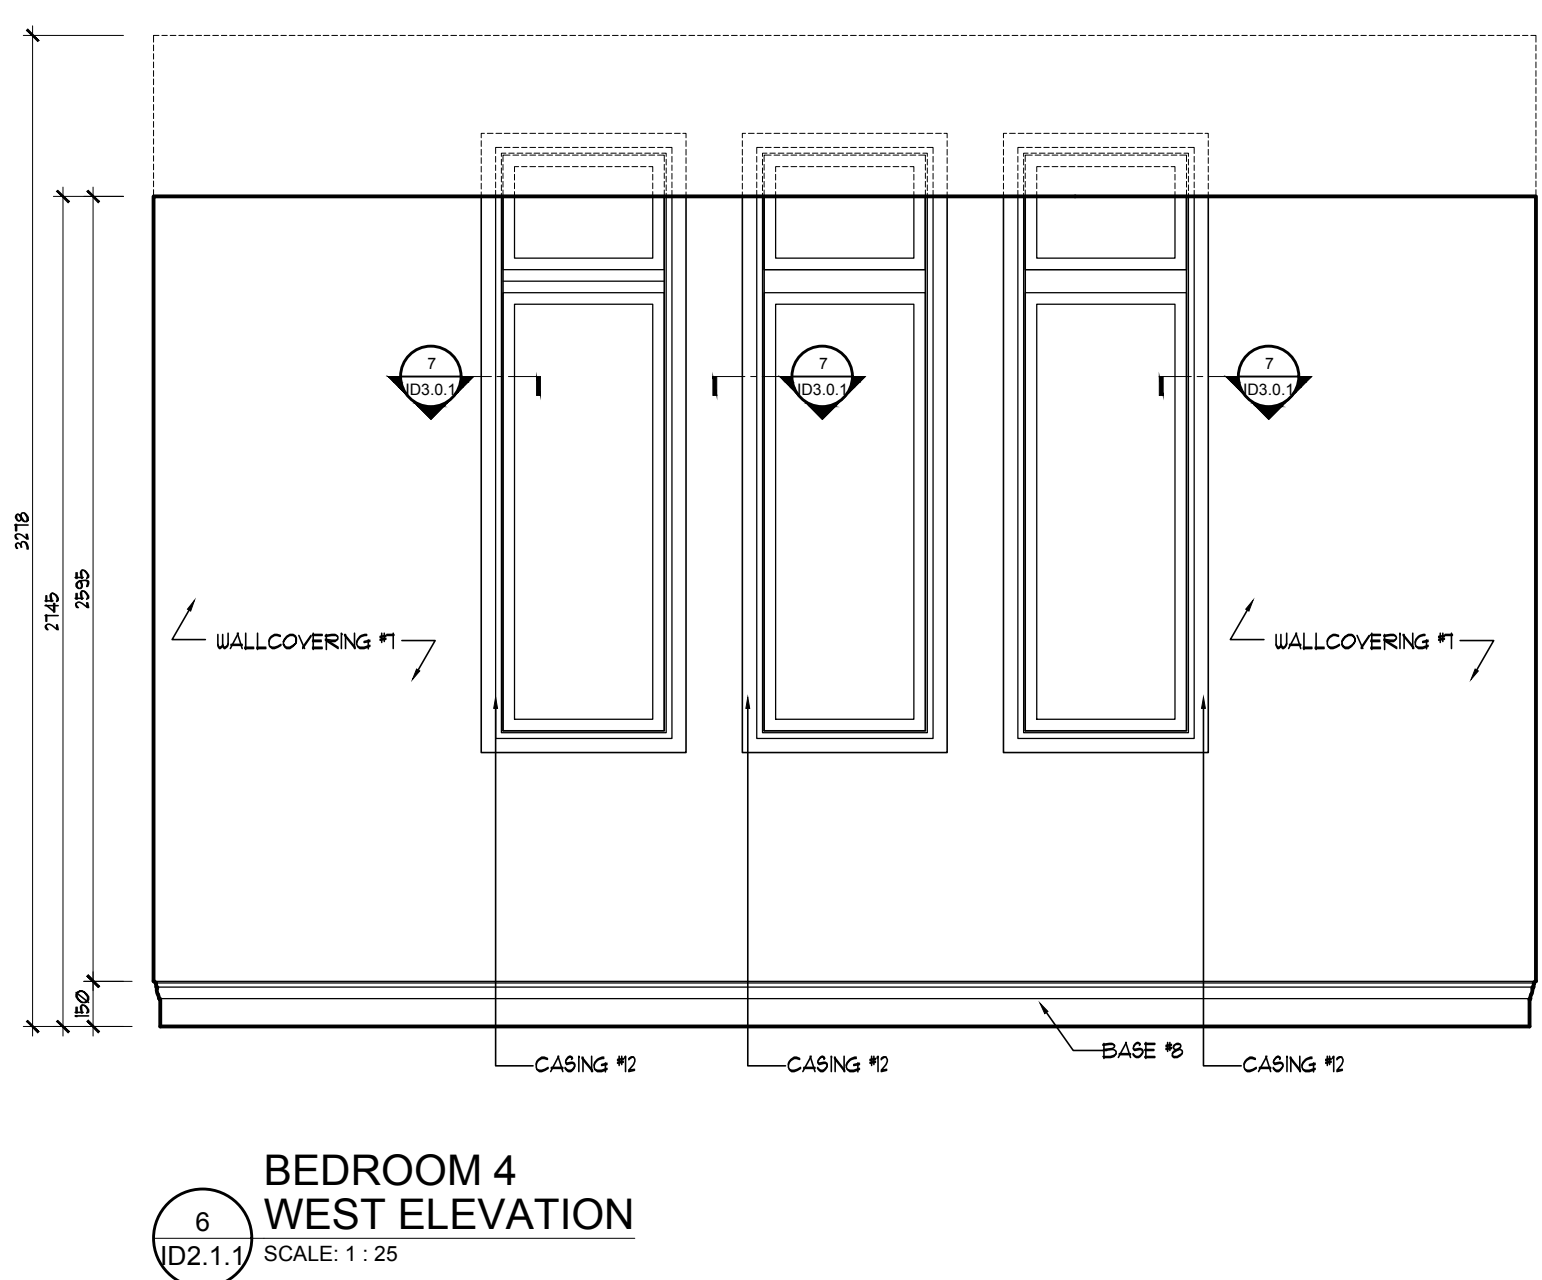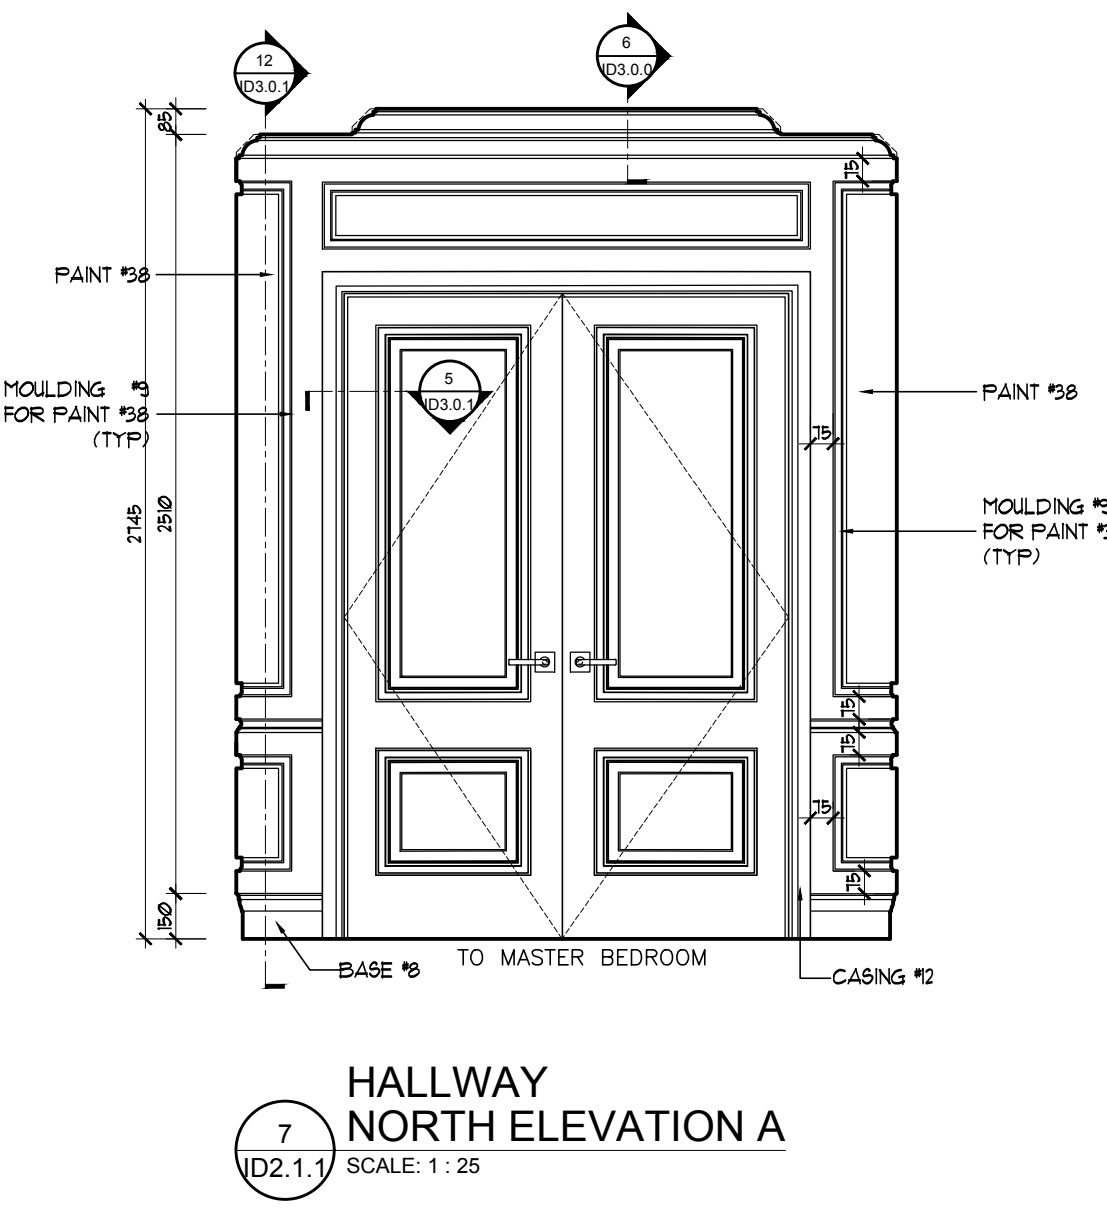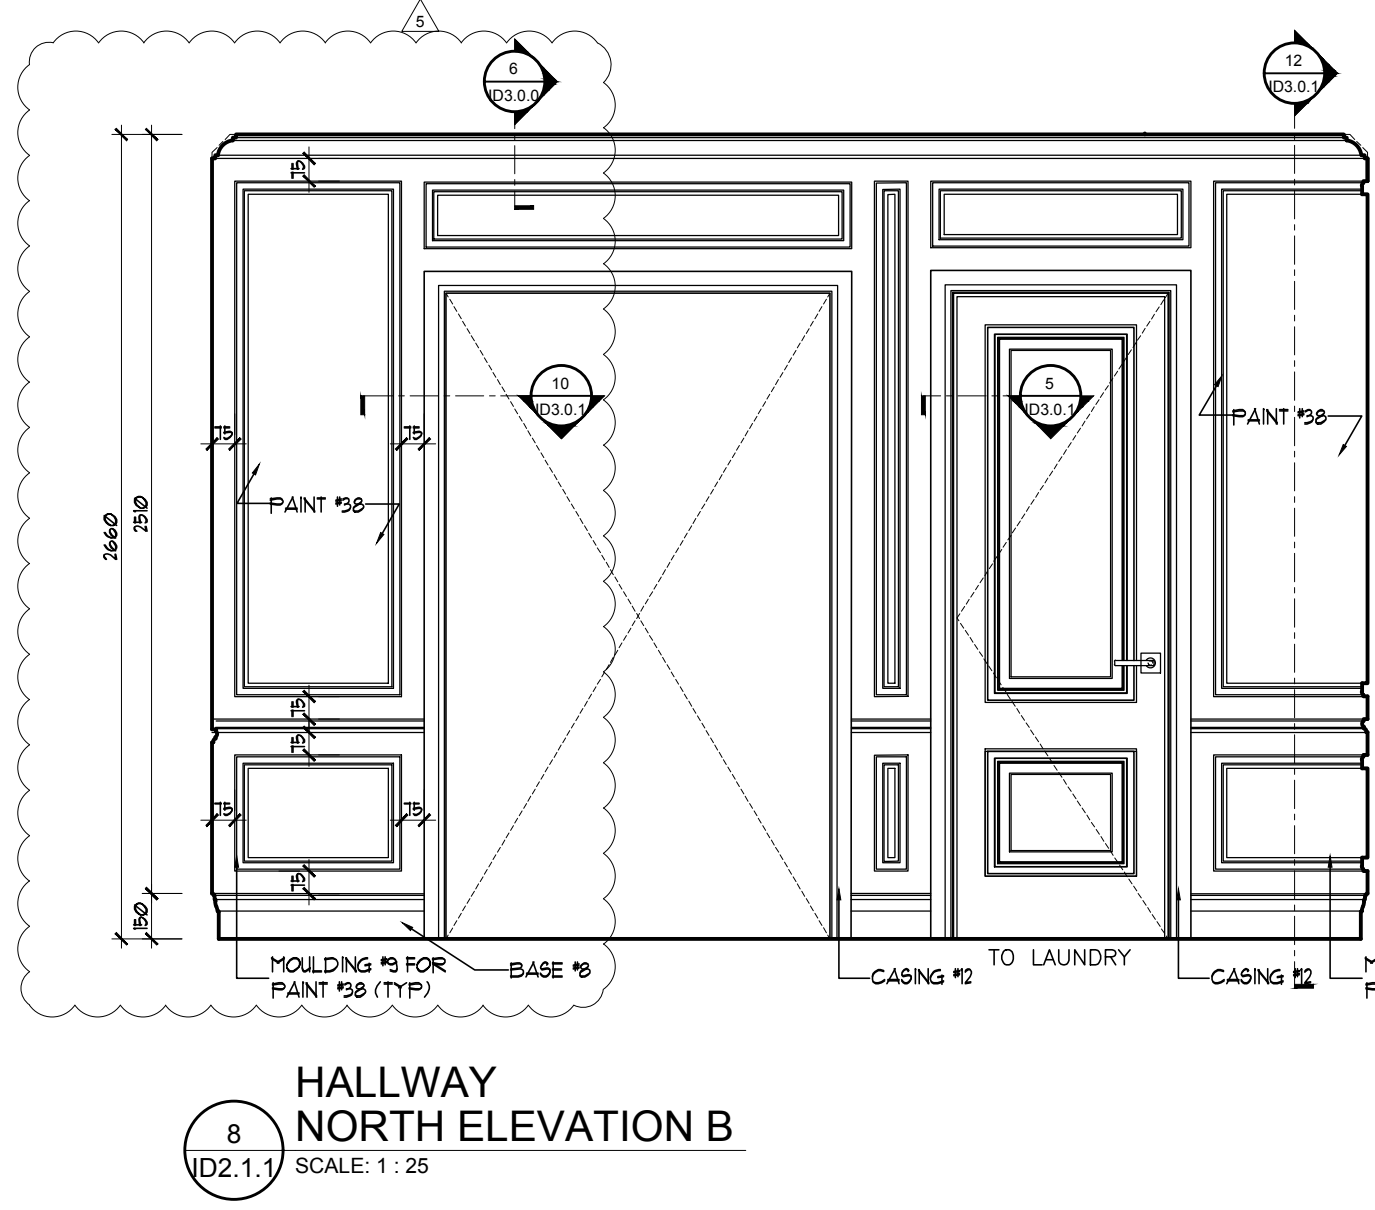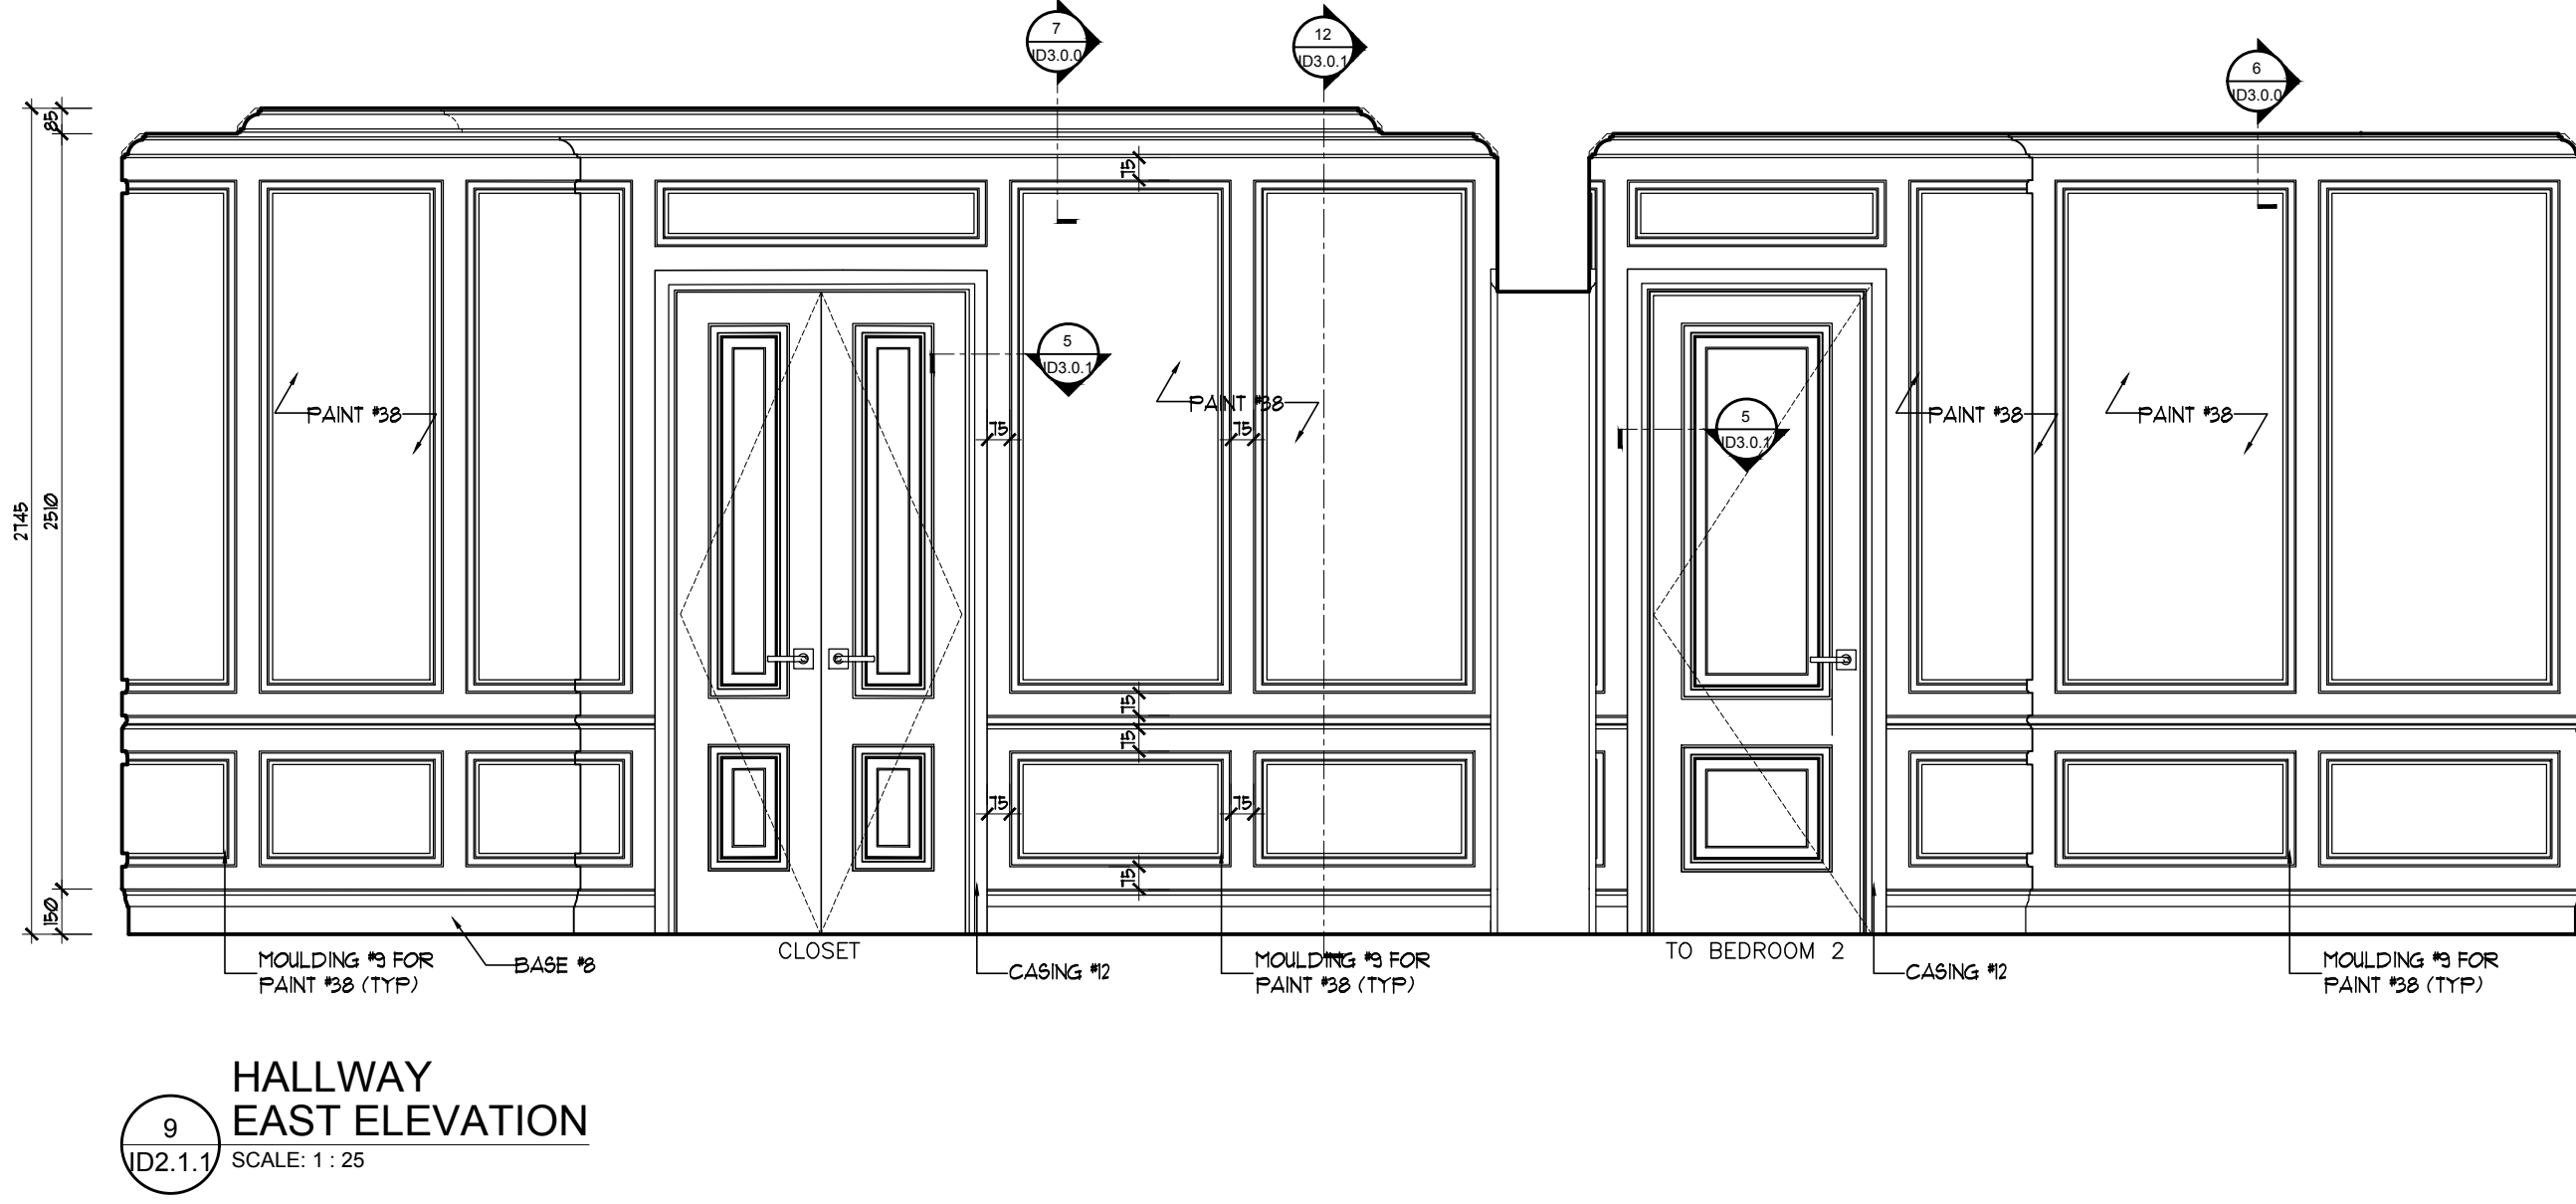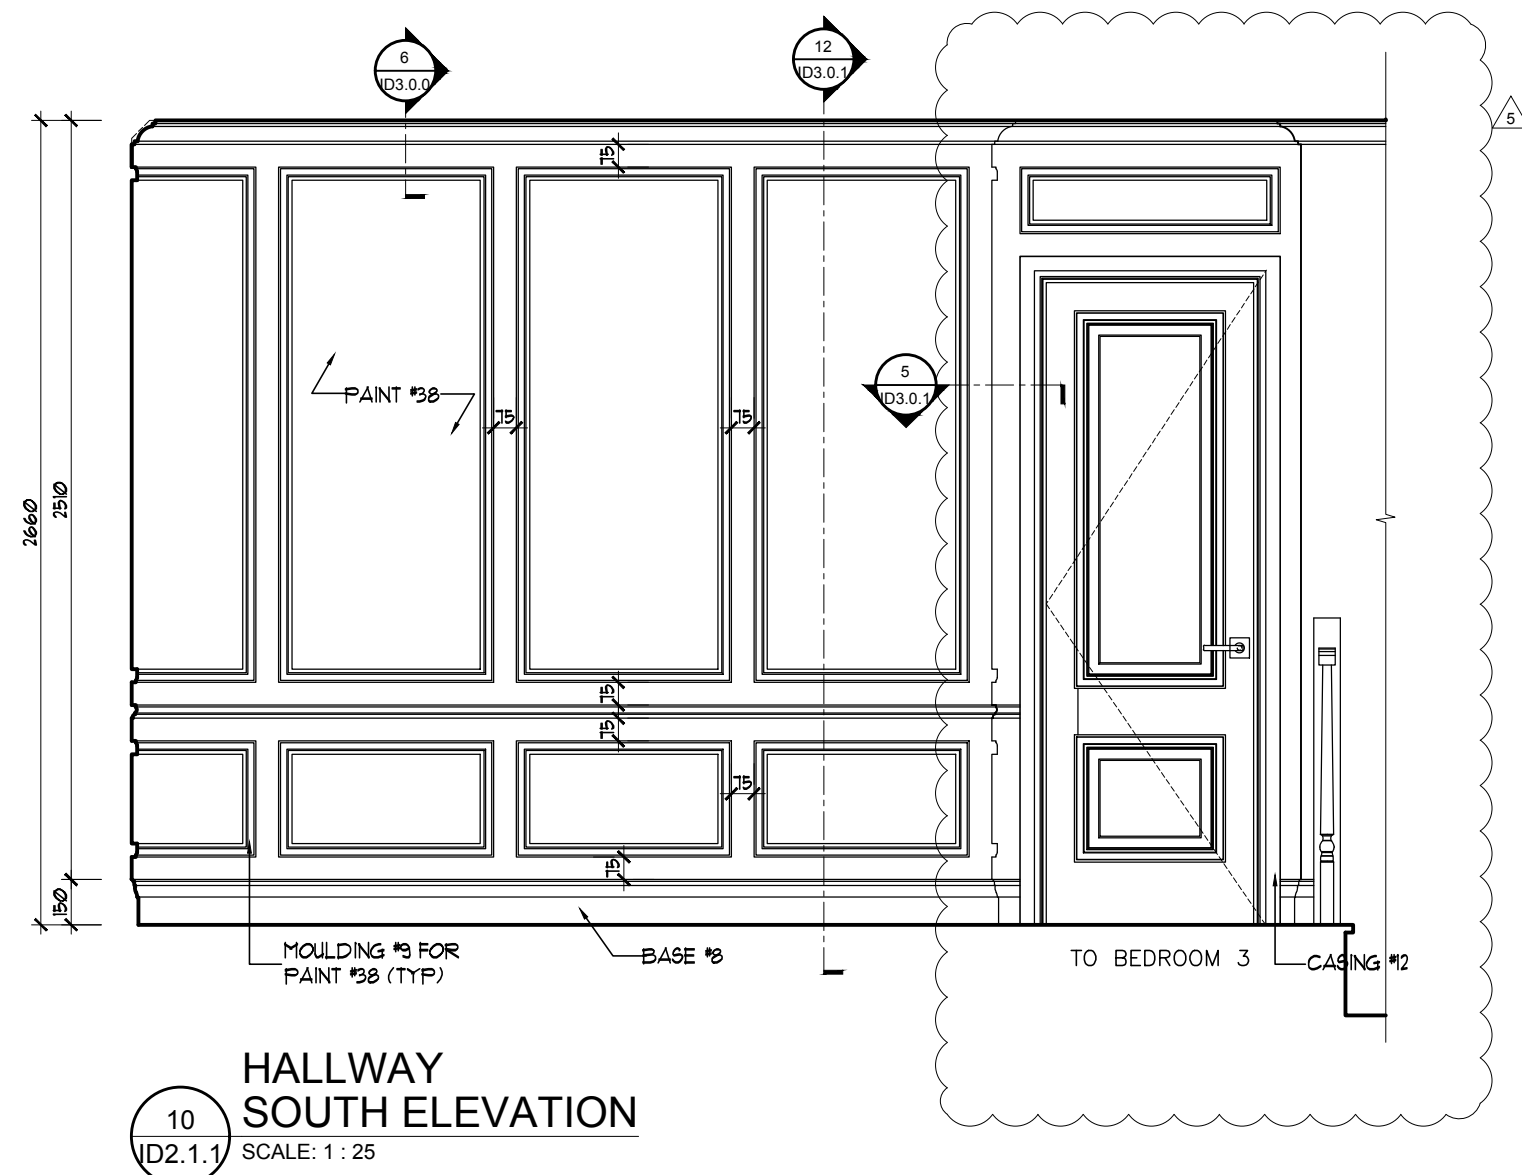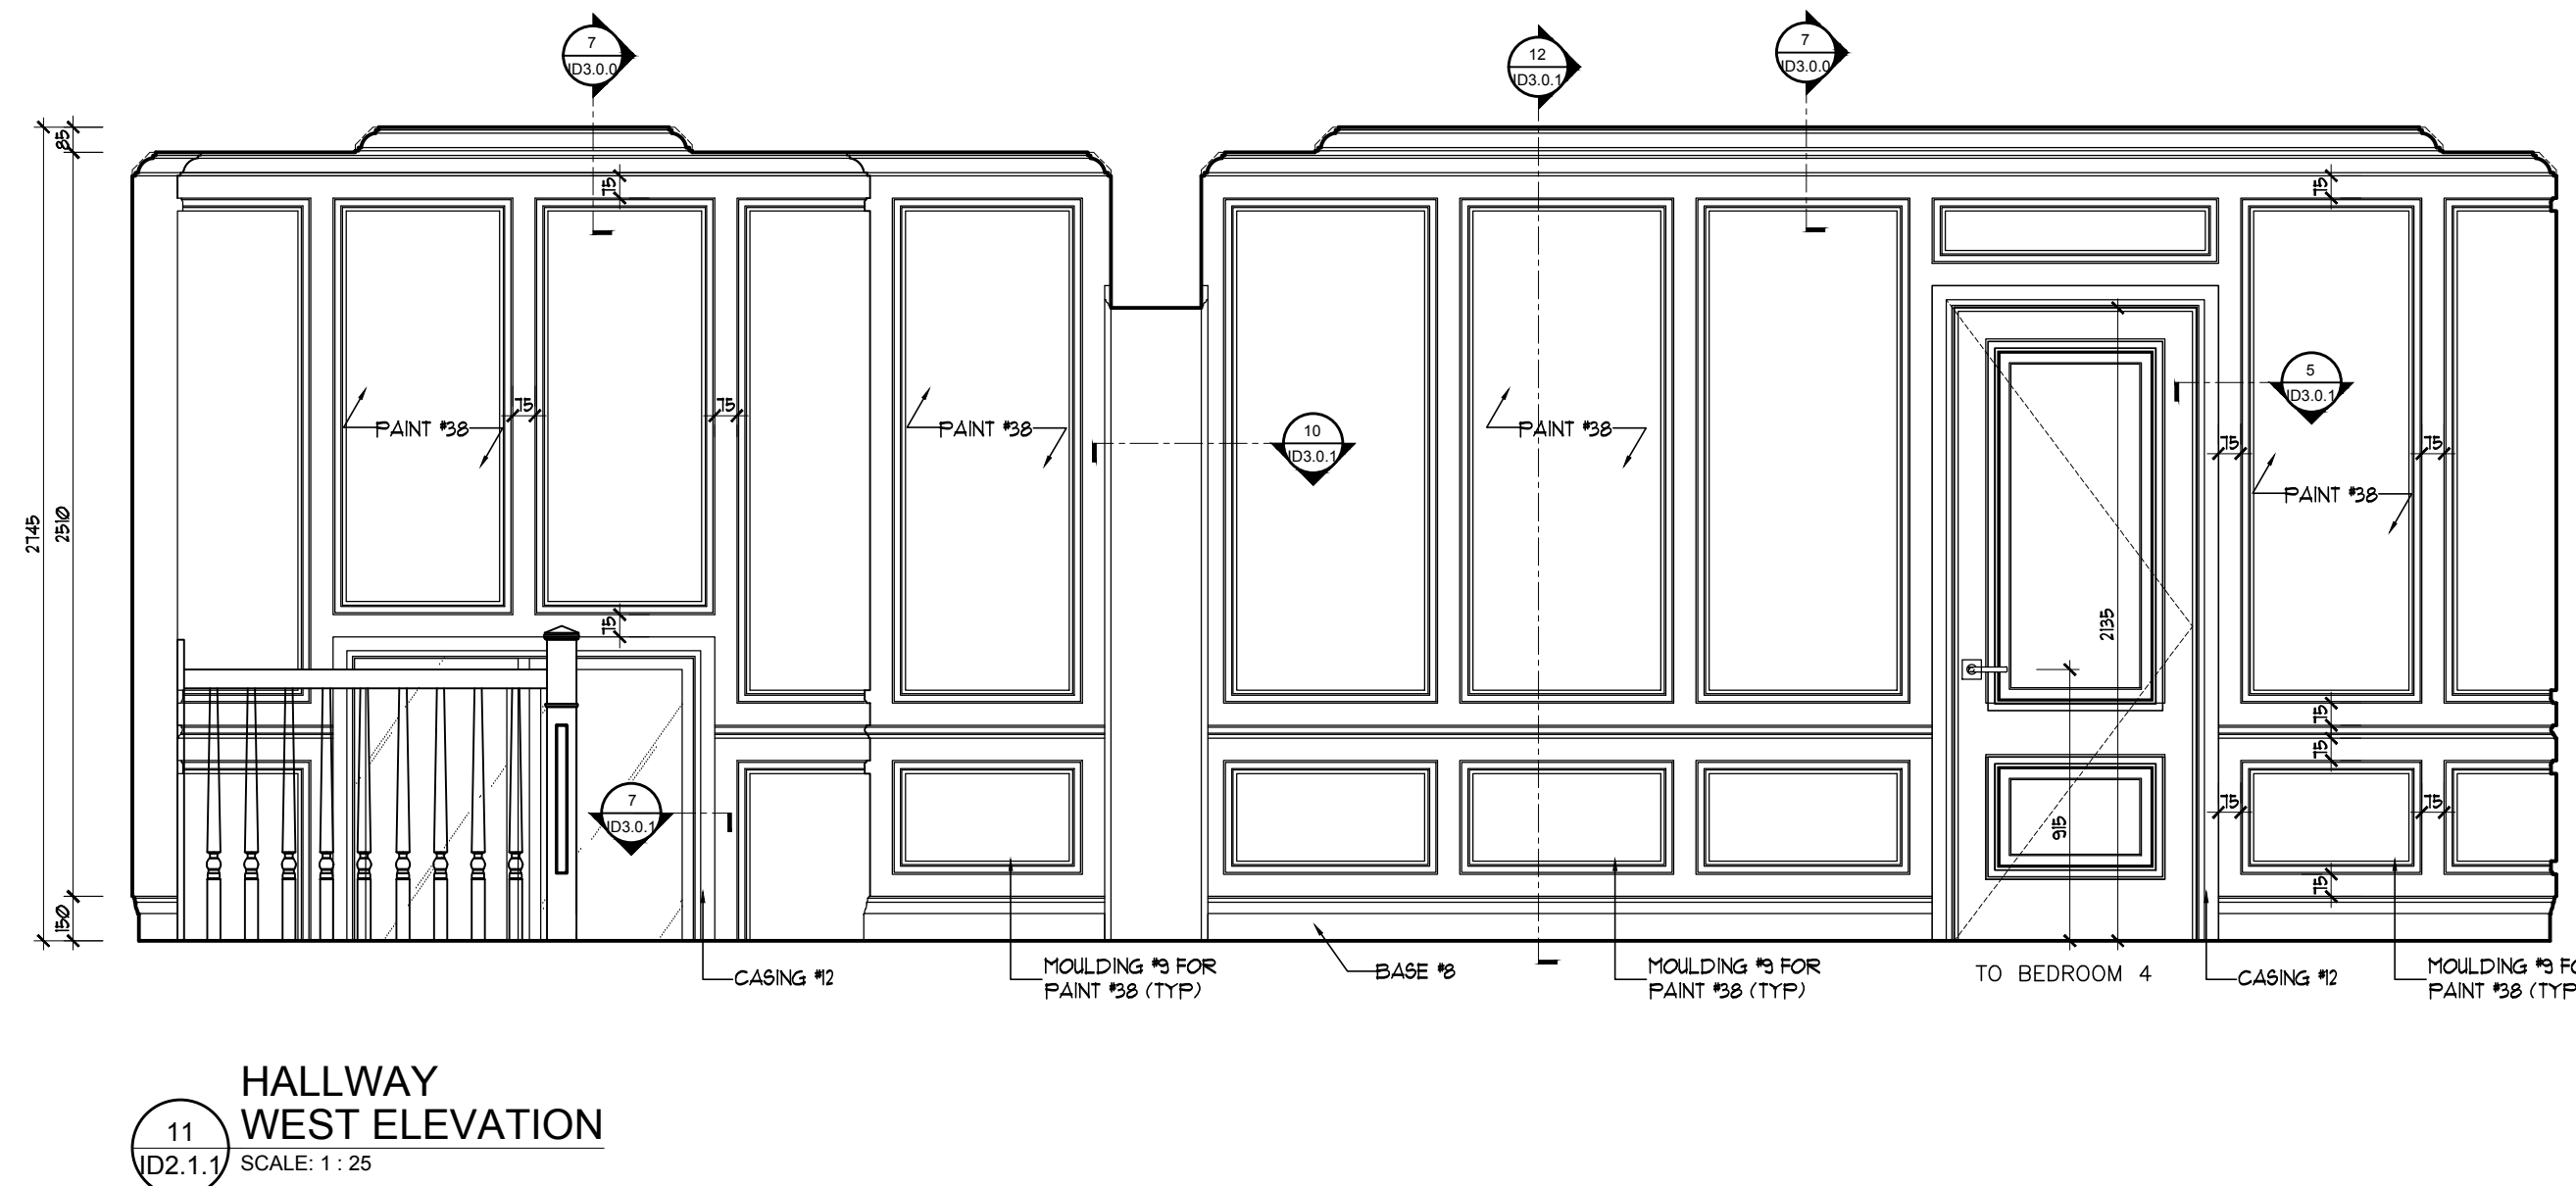



MIKE NIVEN INTERIOR DESIGN INC.
100 BROADVIEW AVE. S. 302 TORONTO, CANADA M4M 3B3
TEL: 416.703.7404 • FAX: 416.783.7404

ISSUED FOR
PLUMBING &
APPLIANCES

No.	Date	Revision	By	CHK
1	18/04/2019	ADJUSTED AS SHOWN	RG	MN
2	15/05/2019	ADJUSTED AS SHOWN	RG	MN
3	24/05/2019	ADJUSTED AS SHOWN	RG	MN
4	11/06/2019	ADJUSTED AS SHOWN	RG	MN
5	07/10/2019	CHANGE NOTICE #6	WV	MN
6	11/20/2019	CHANGE NOTICE #9	RS	MN
7	03/20/20	CHANGE NOTICE #10	NVRS	MN

No.	Date	Issue	By	CHK
4	11/20/2019	ISSUED FOR PRICING FOR TRIM AND MILLWORK	RS	MN
3	10/22/2019	ISSUED FOR PRICING FOR SLABS AND TILES ONLY	HD	MN
2	15/05/2019	ISSUED FOR PLUMBING & APPLIANCES	RG	MN
1	18/04/2019	ISSUED FOR COORDINATION	RG	MN

NOTE: **DONOT SCALE DRAWINGS**
It is the contractor's responsibility to verify all specifications and dimensions and report any discrepancies to the designer prior to construction. Materials may not be substituted without designer's written approval.



PROJECT:
PINEVALLEY
KNIGHTSWOOD, LOT 93

GOLDPARK HOMES

CONCORD, ON

DRAWING:

DETAILS

DESIGNER'S:

MIKE NIVEN

DRAWN BY:

M-Tec Inc.

DATE:

FEB 2019


SCALE:

1:50


PROJECT NO:

2018-10


ID
3.0.0

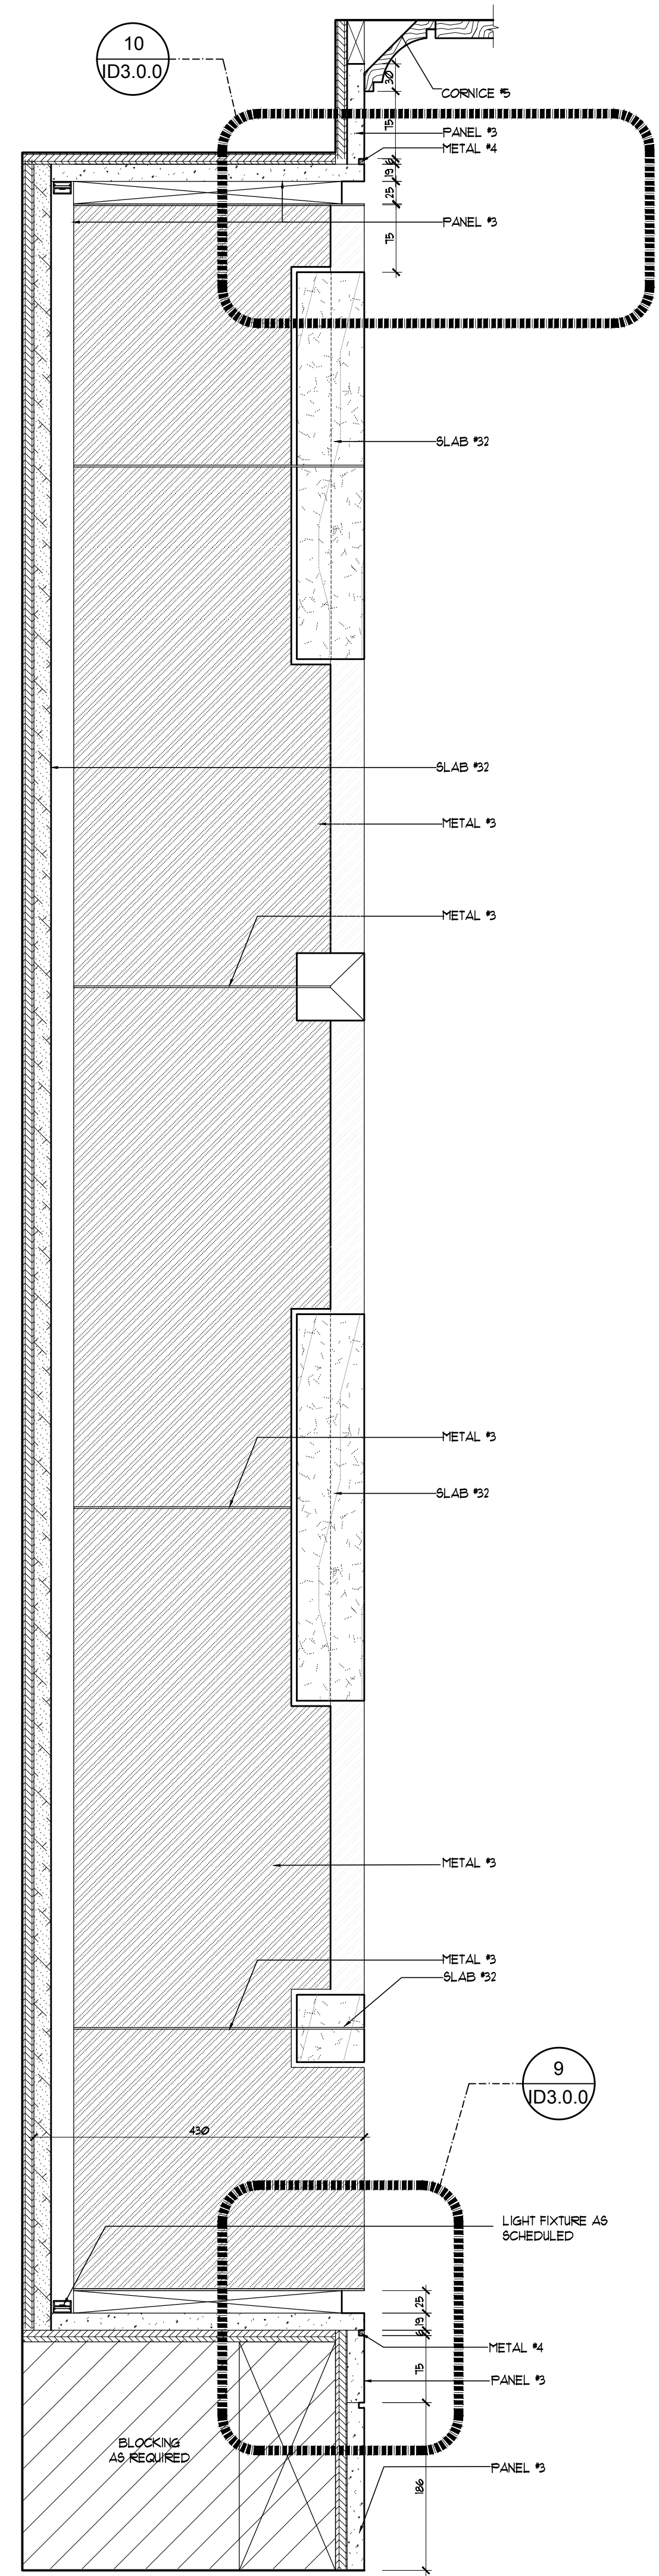


LIBRARY BOOK CASE
VERTICAL SECTION
11
ID3.0.0 SCALE: 1:5

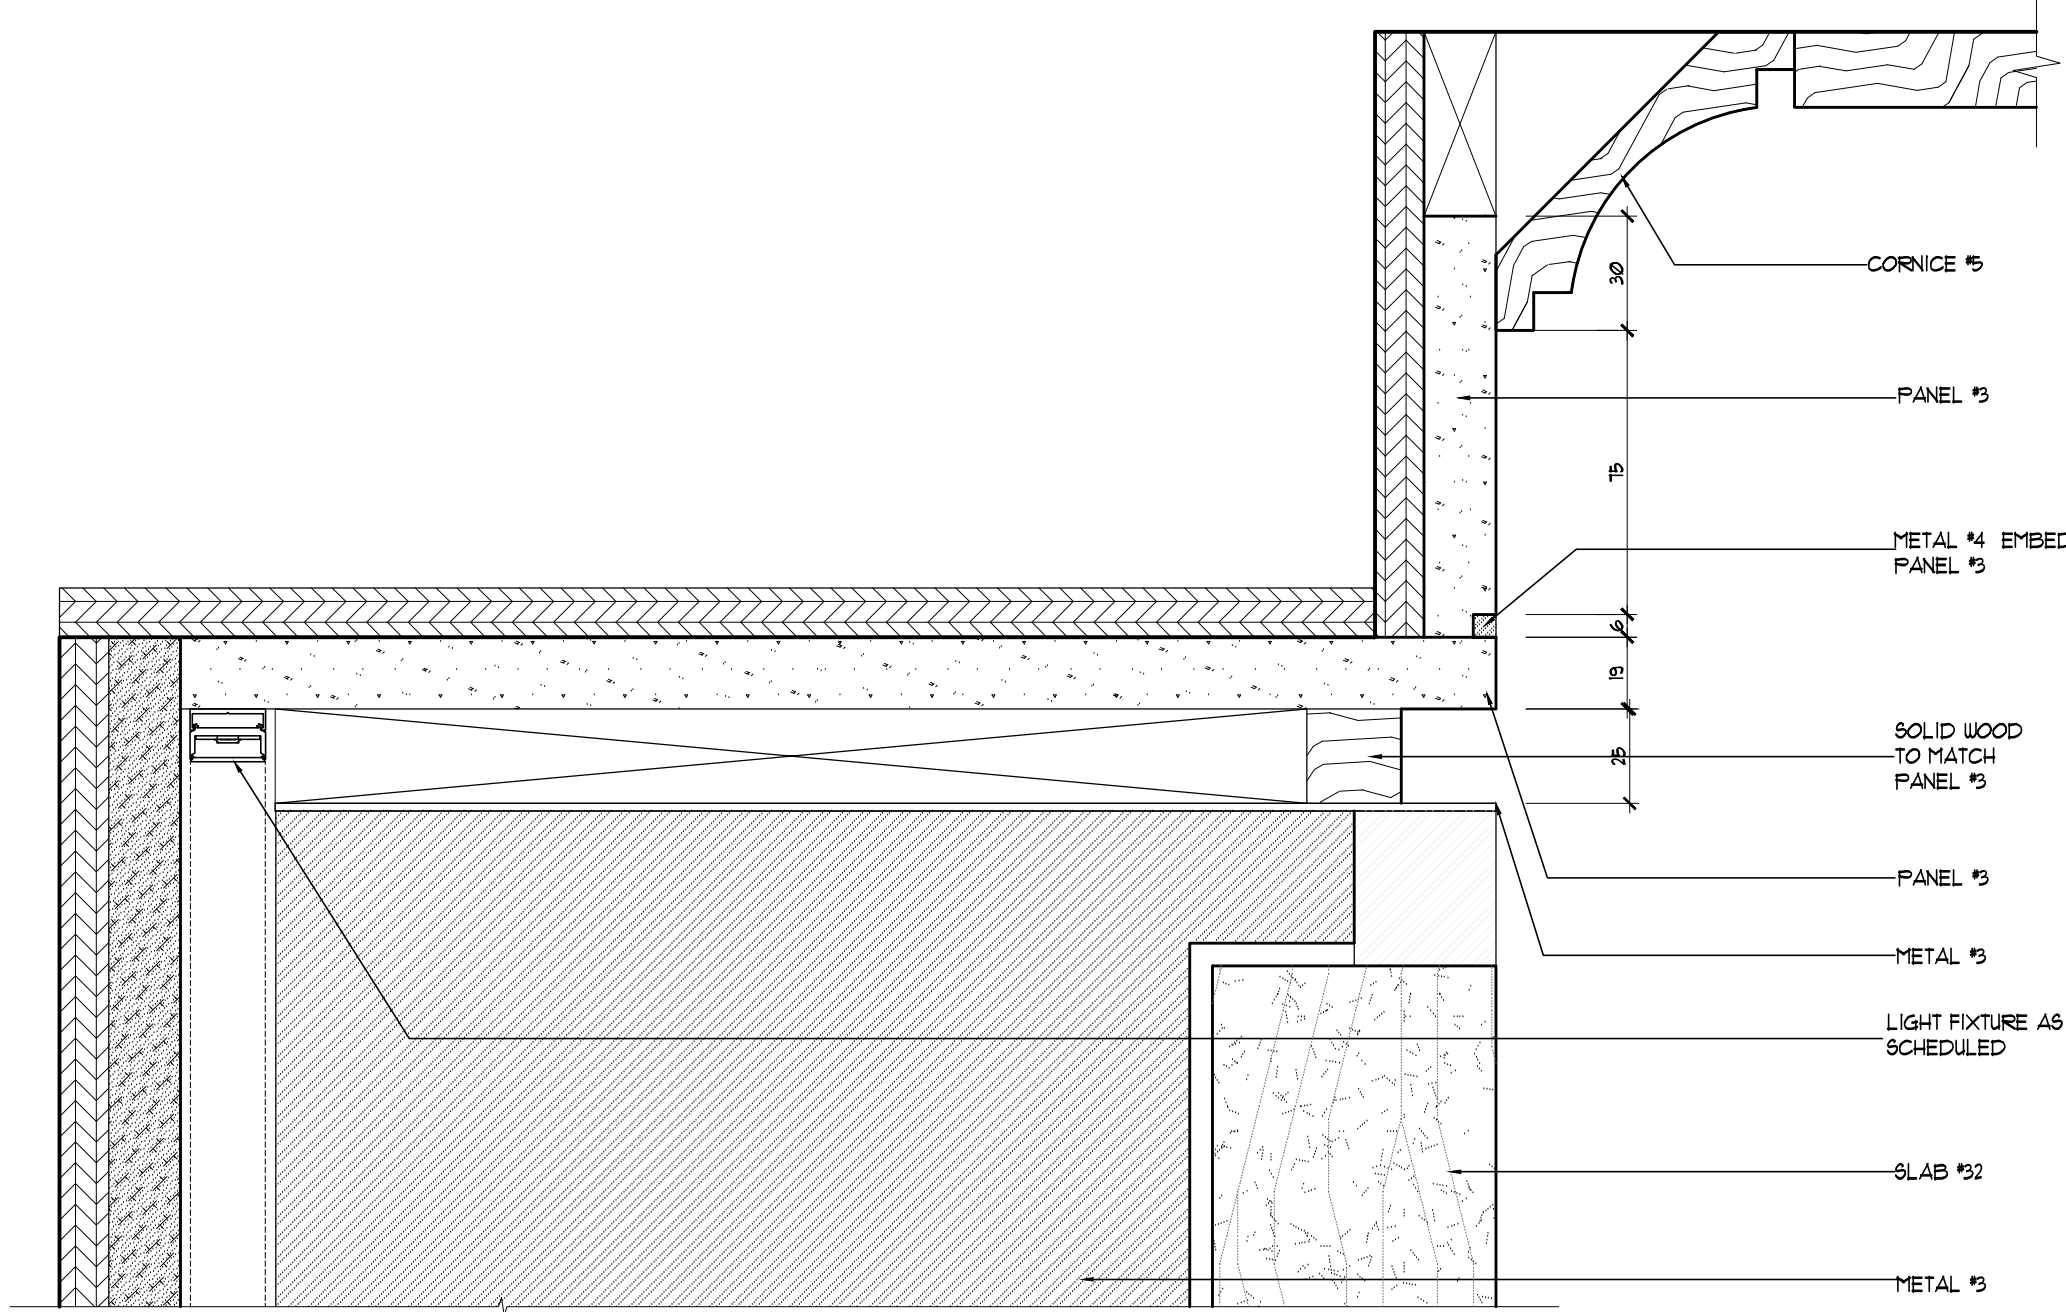


BOOK CASE AT LIBRARY
VERTICAL SECTION
10
ID3.0.0 SCALE: 1:2

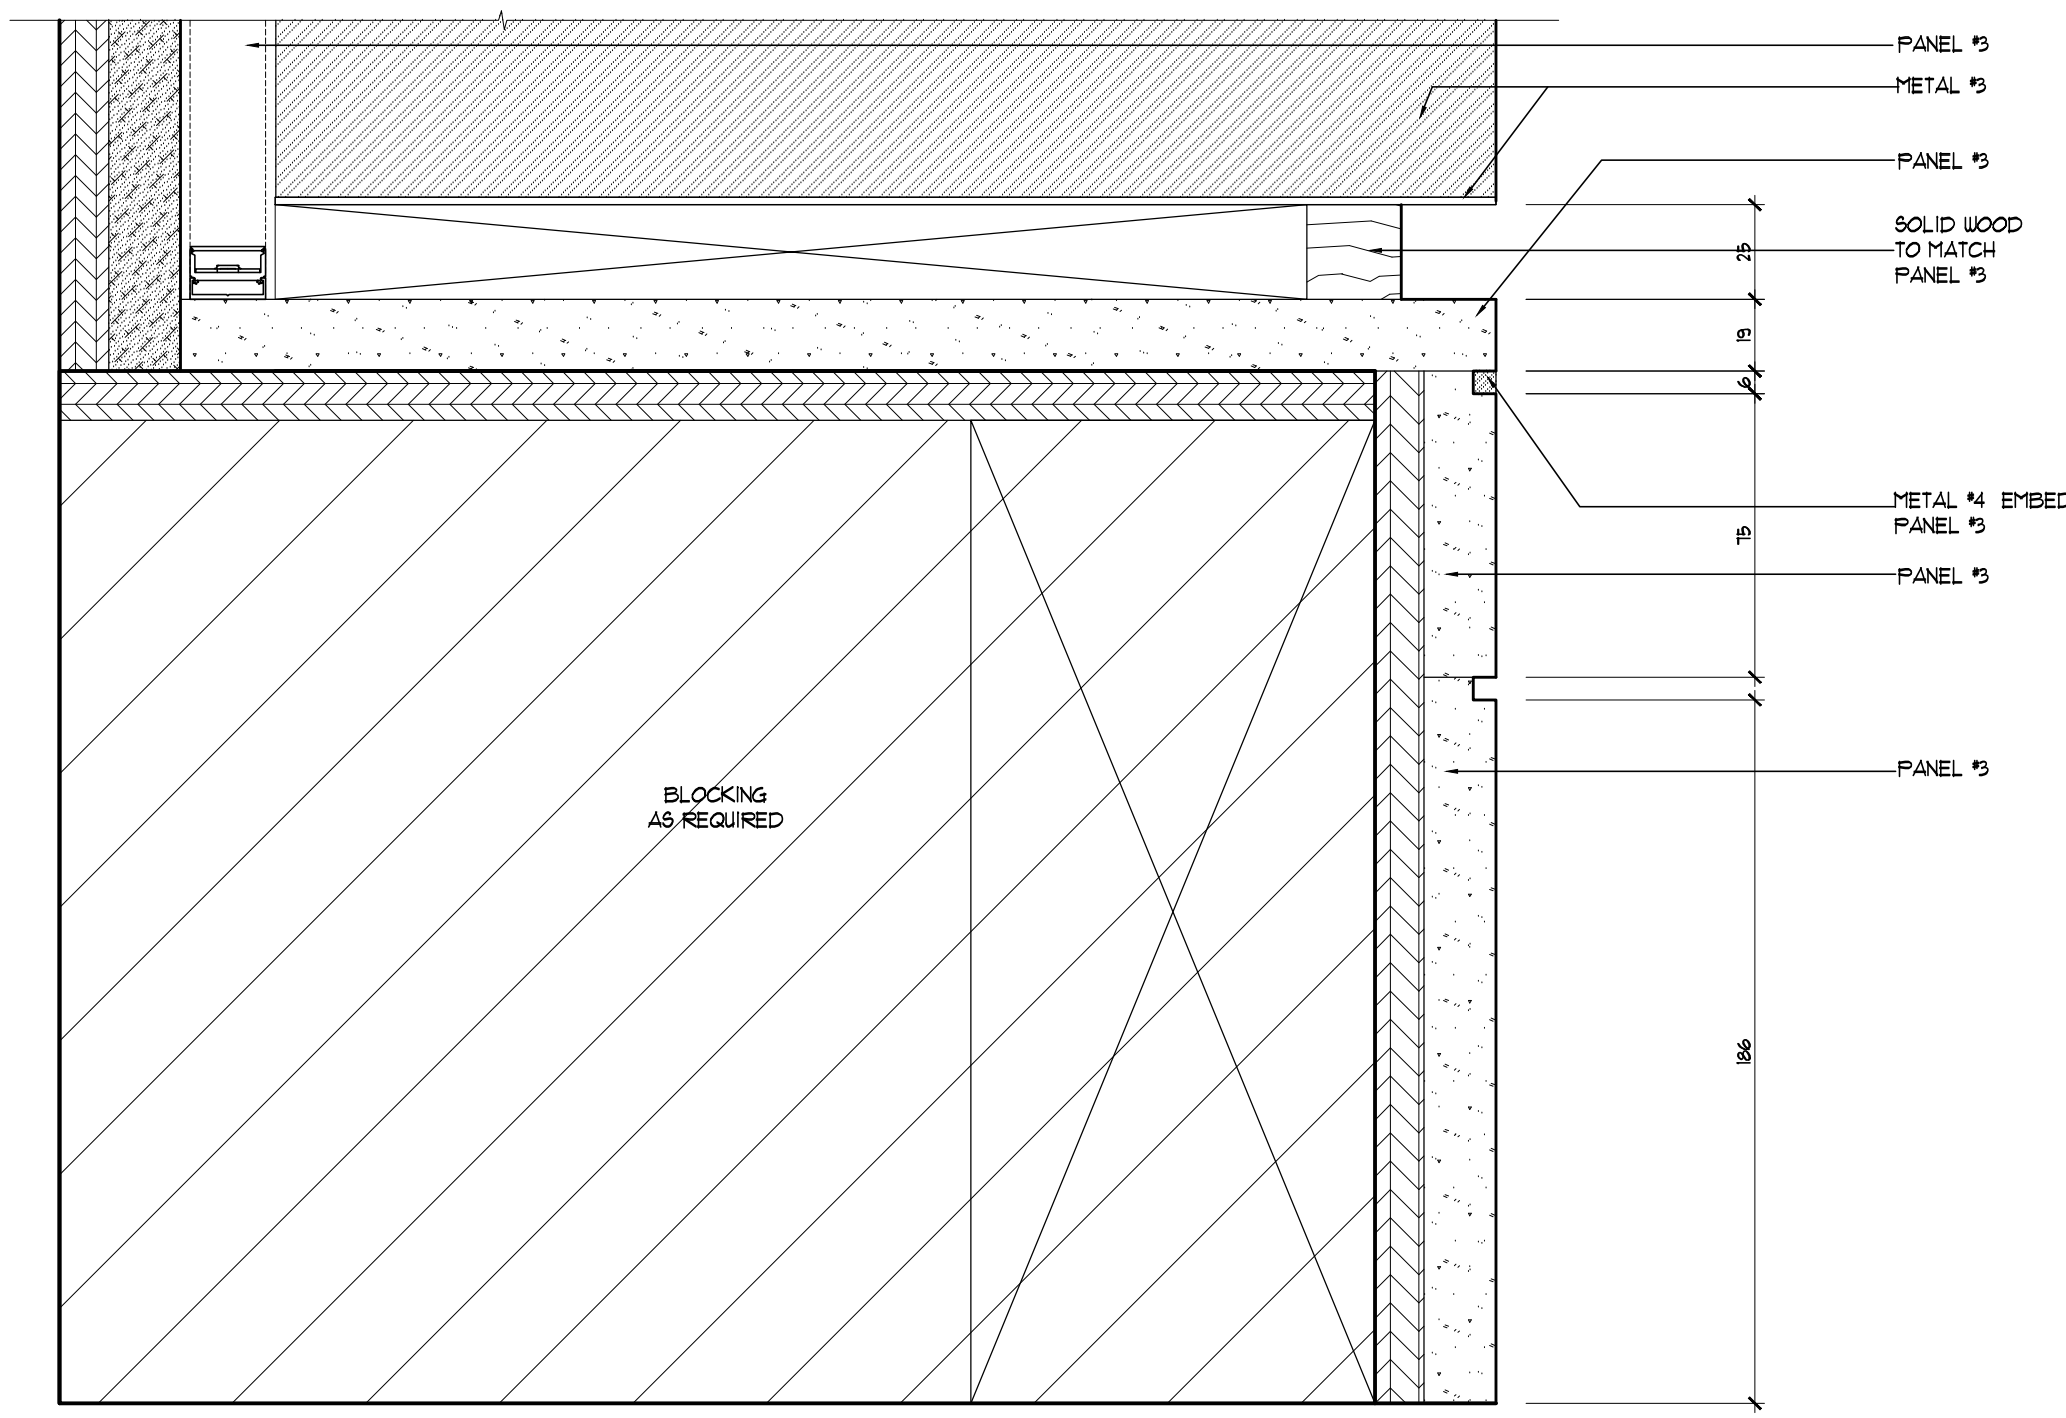


BOOK CASE AT LIBRARY
VERTICAL SECTION
9
ID3.0.0 SCALE: 1:5

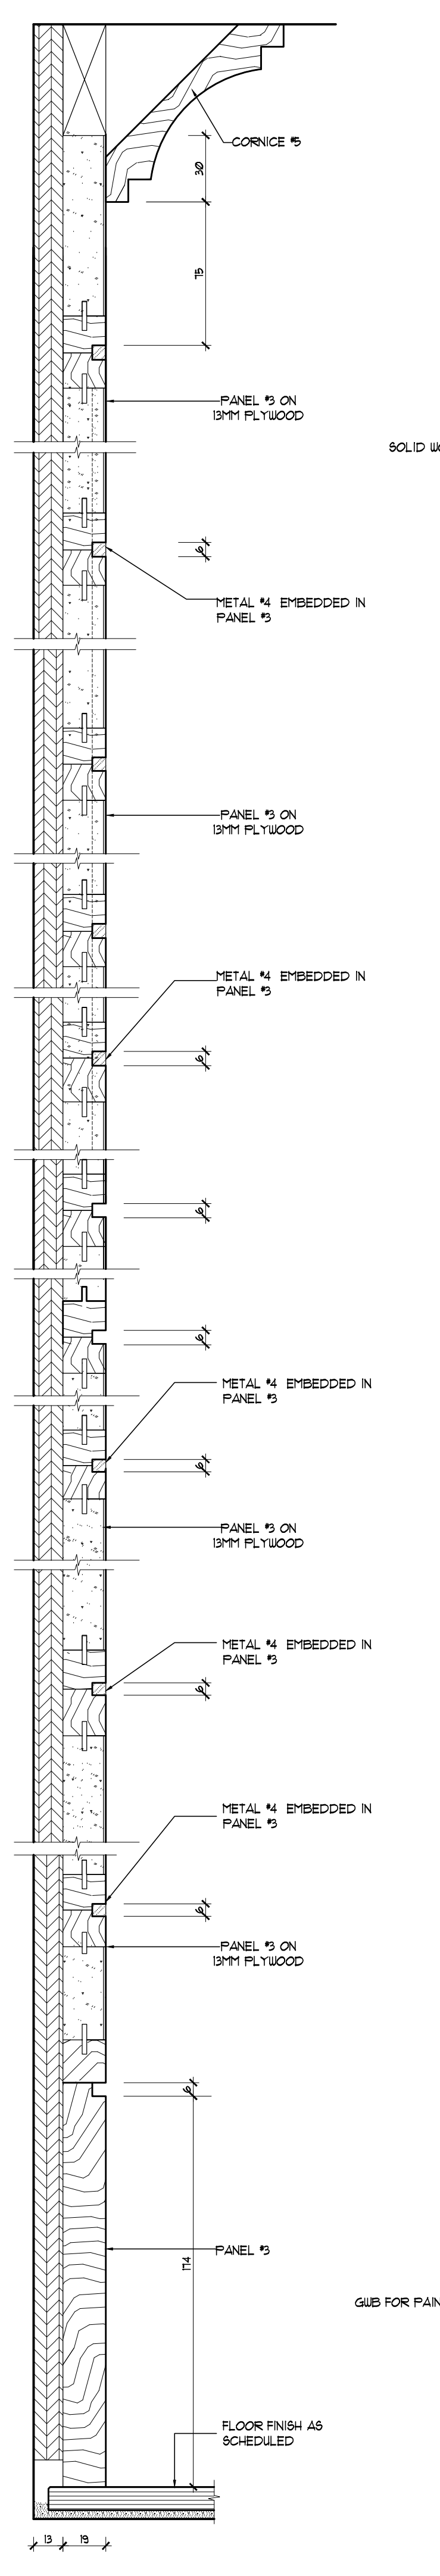


PANEL DETAIL AT LIBRARY
VERTICAL SECTION
8
ID3.0.0 SCALE: 1:2

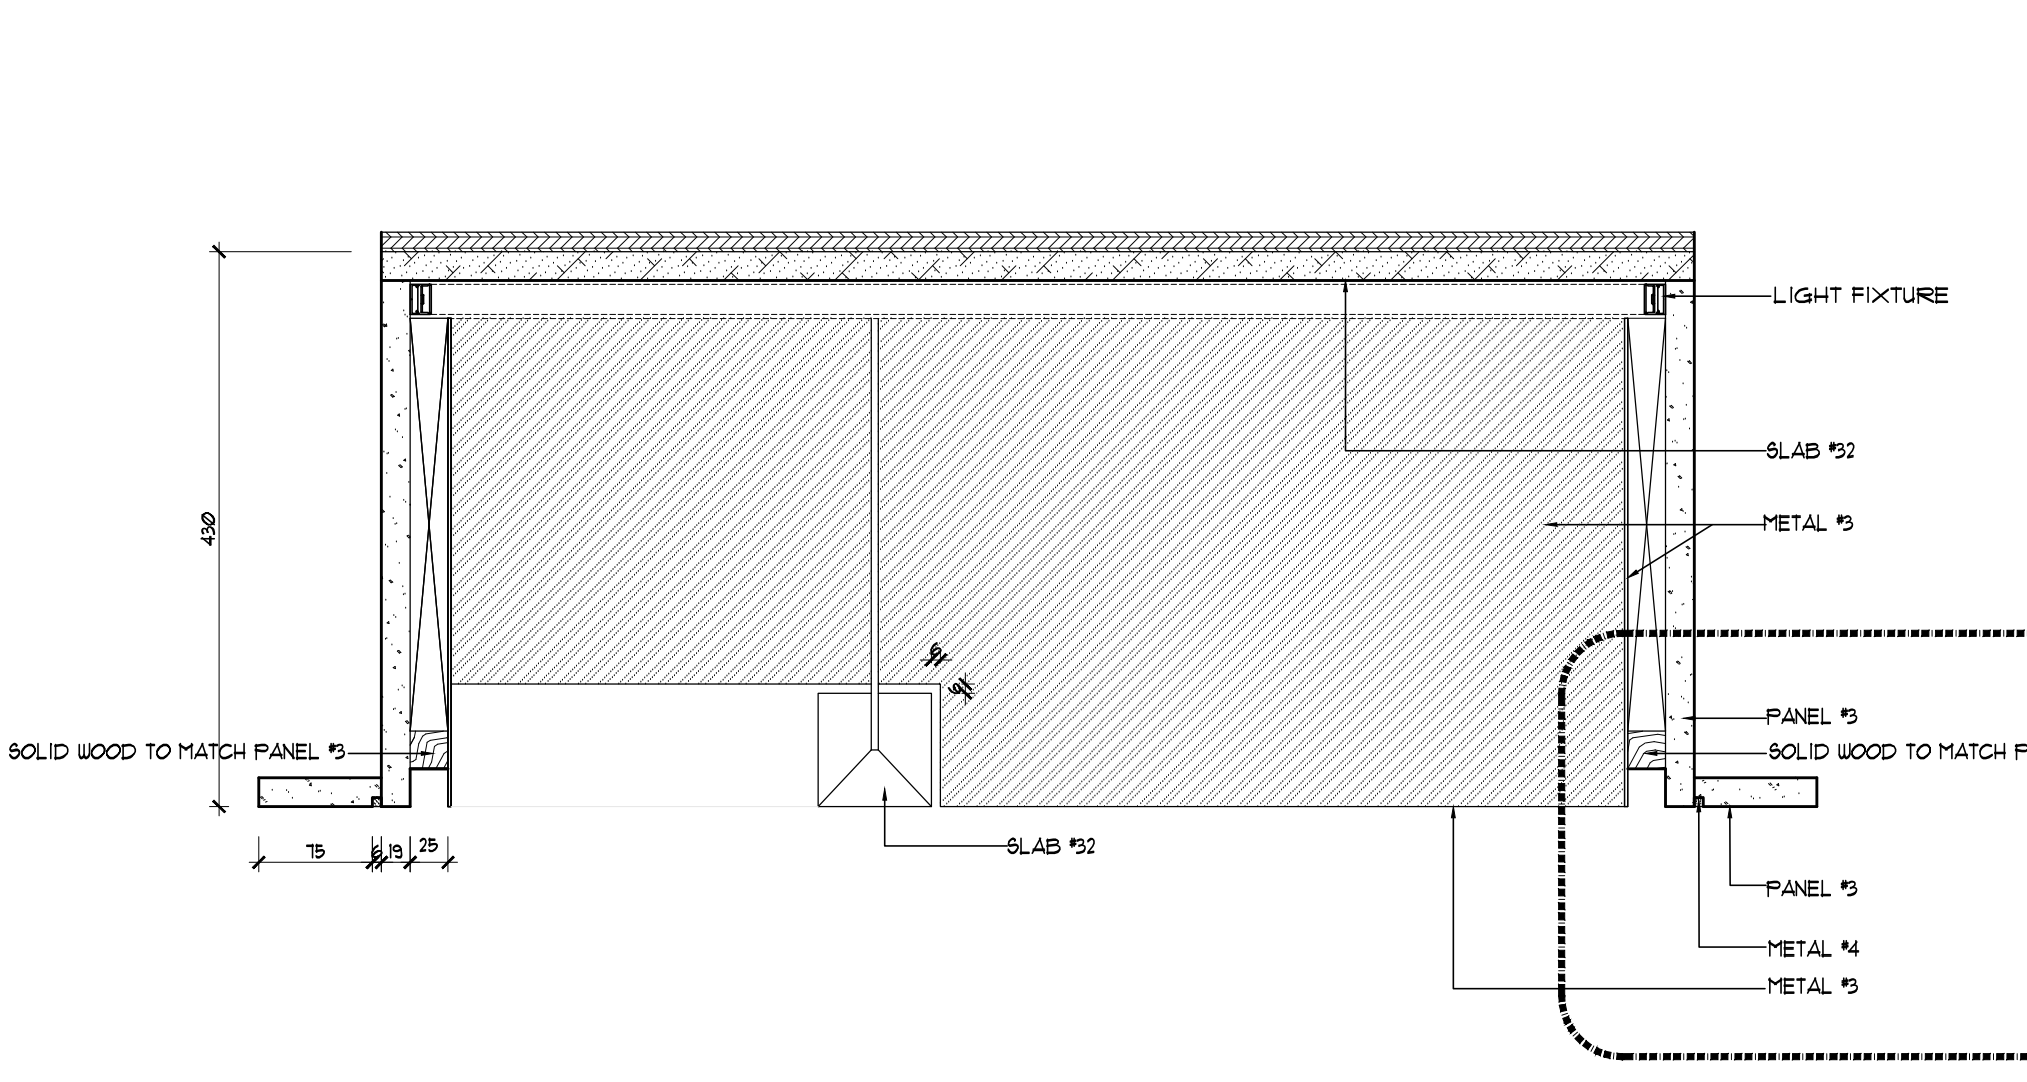


LIBRARY BOOK CASE
HORIZONTAL SECTION
13
ID3.0.0 SCALE: 1:5

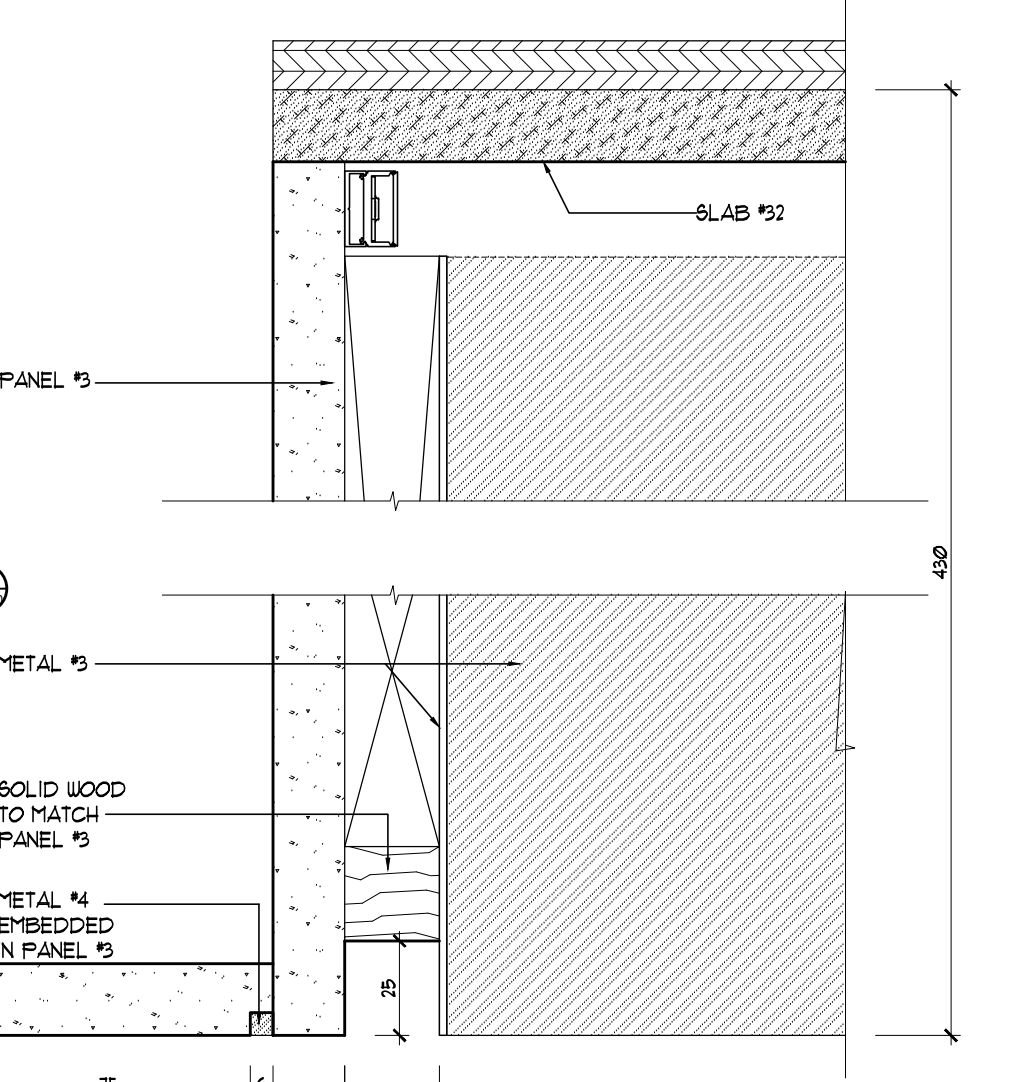


BOOK CASE AT LIBRARY
VERTICAL SECTION
12
ID3.0.0 SCALE: 1:2

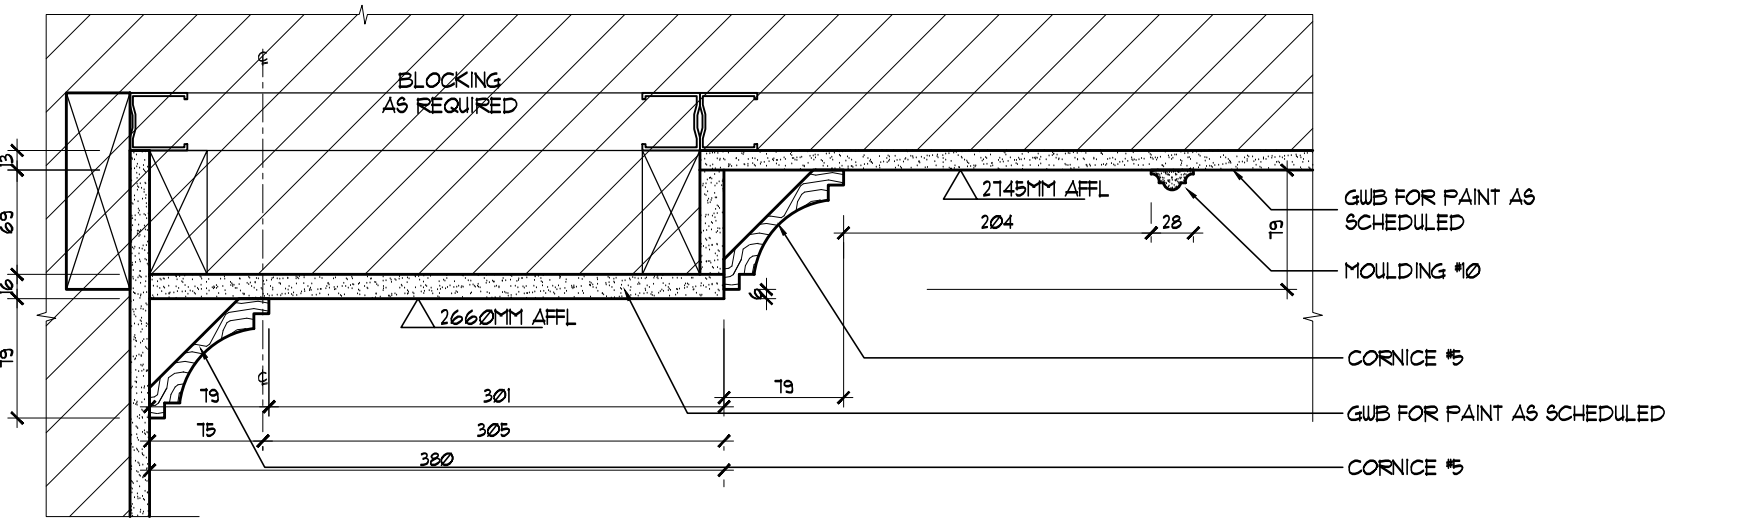


SECOND FLOOR TYP. CORNICE DETAIL
VERTICAL SECTION
7
ID3.0.0 SCALE: 1:5

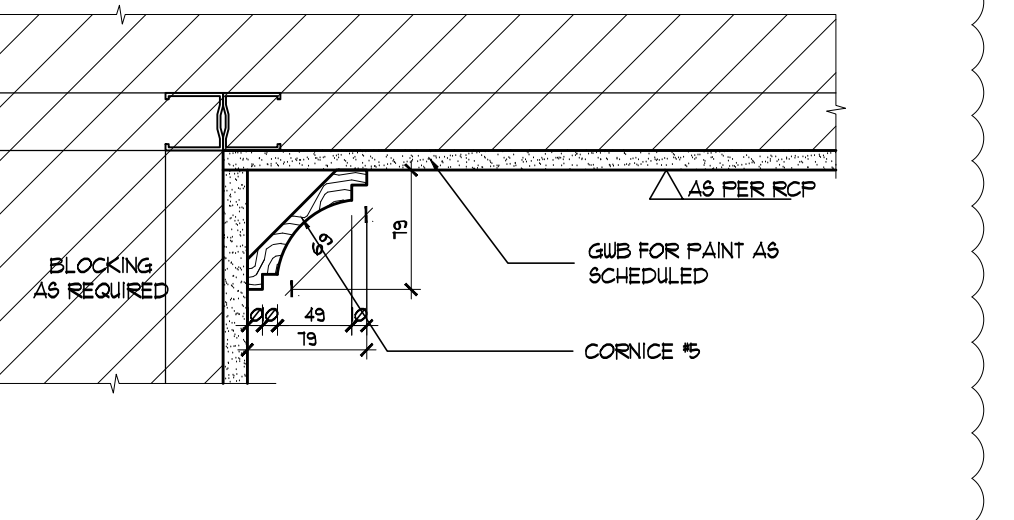


FIRST FLOOR TYP. CORNICE DETAIL
VERTICAL SECTION
6
ID3.0.0 SCALE: 1:5

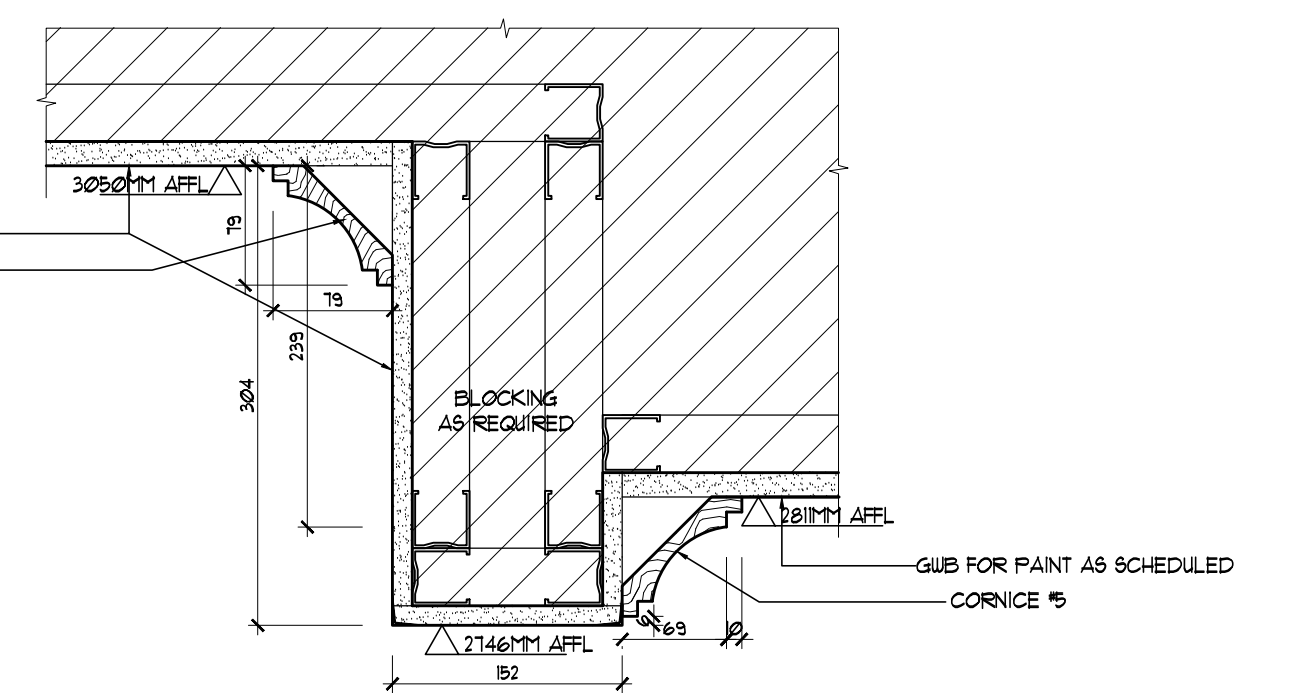


CEILING DETAIL @HEADER
VERTICAL SECTION
5A
ID3.0.0 SCALE: 1:5

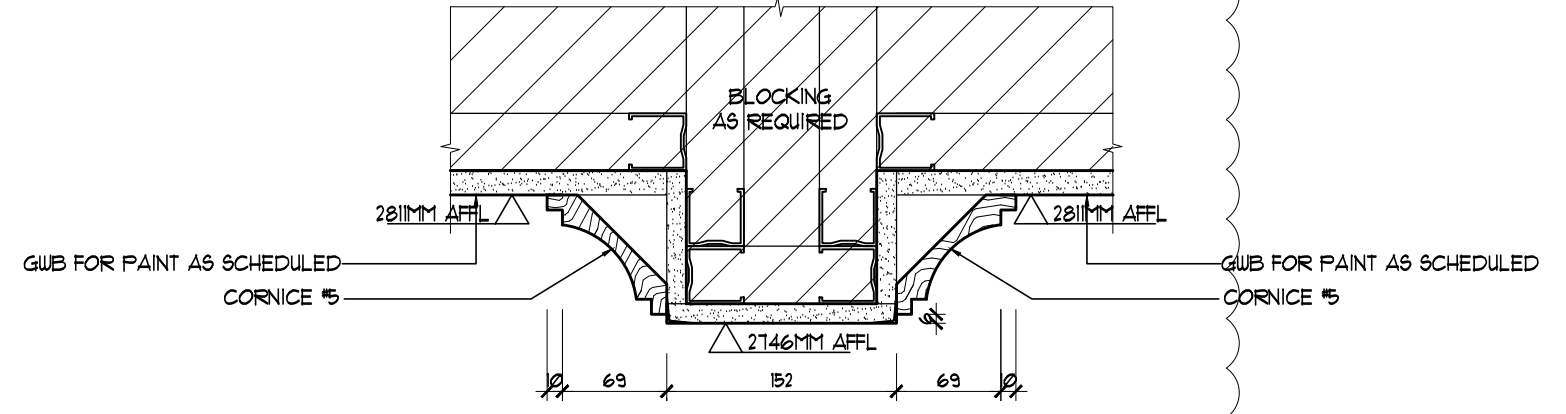


CEILING DETAIL @HEADER
VERTICAL SECTION
5
ID3.0.0 SCALE: 1:5

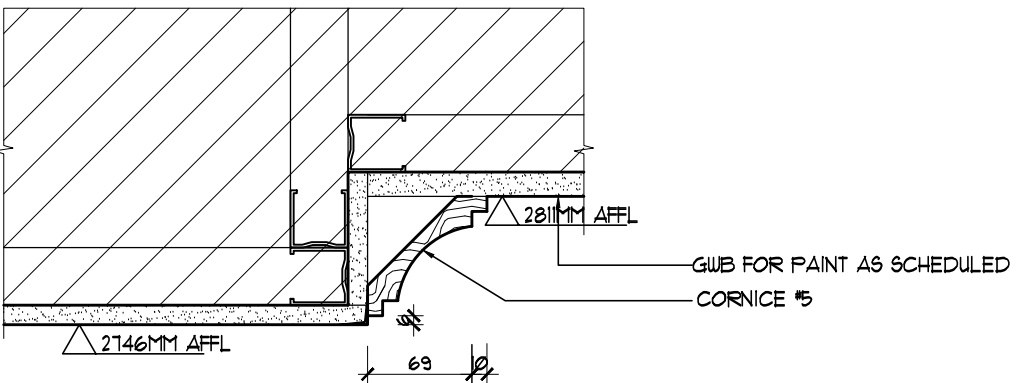


CEILING DETAIL @HEADER
VERTICAL SECTION
4
ID3.0.0 SCALE: 1:5

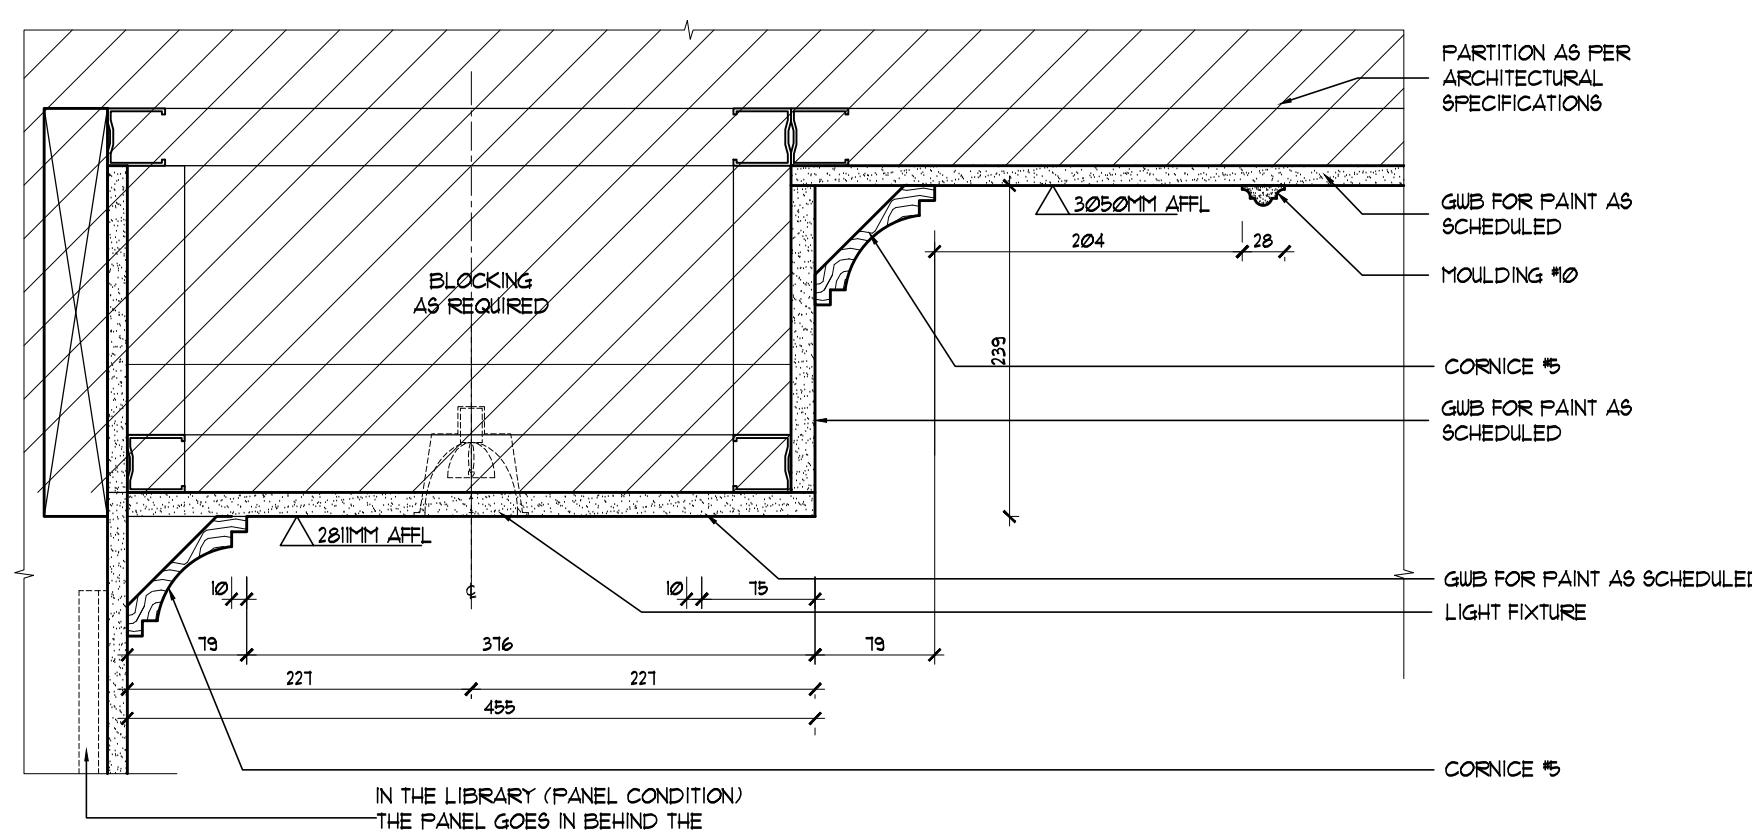



FIRST FLOOR TYP. CORNICE DETAIL
VERTICAL SECTION
3
ID3.0.0 SCALE: 1:5

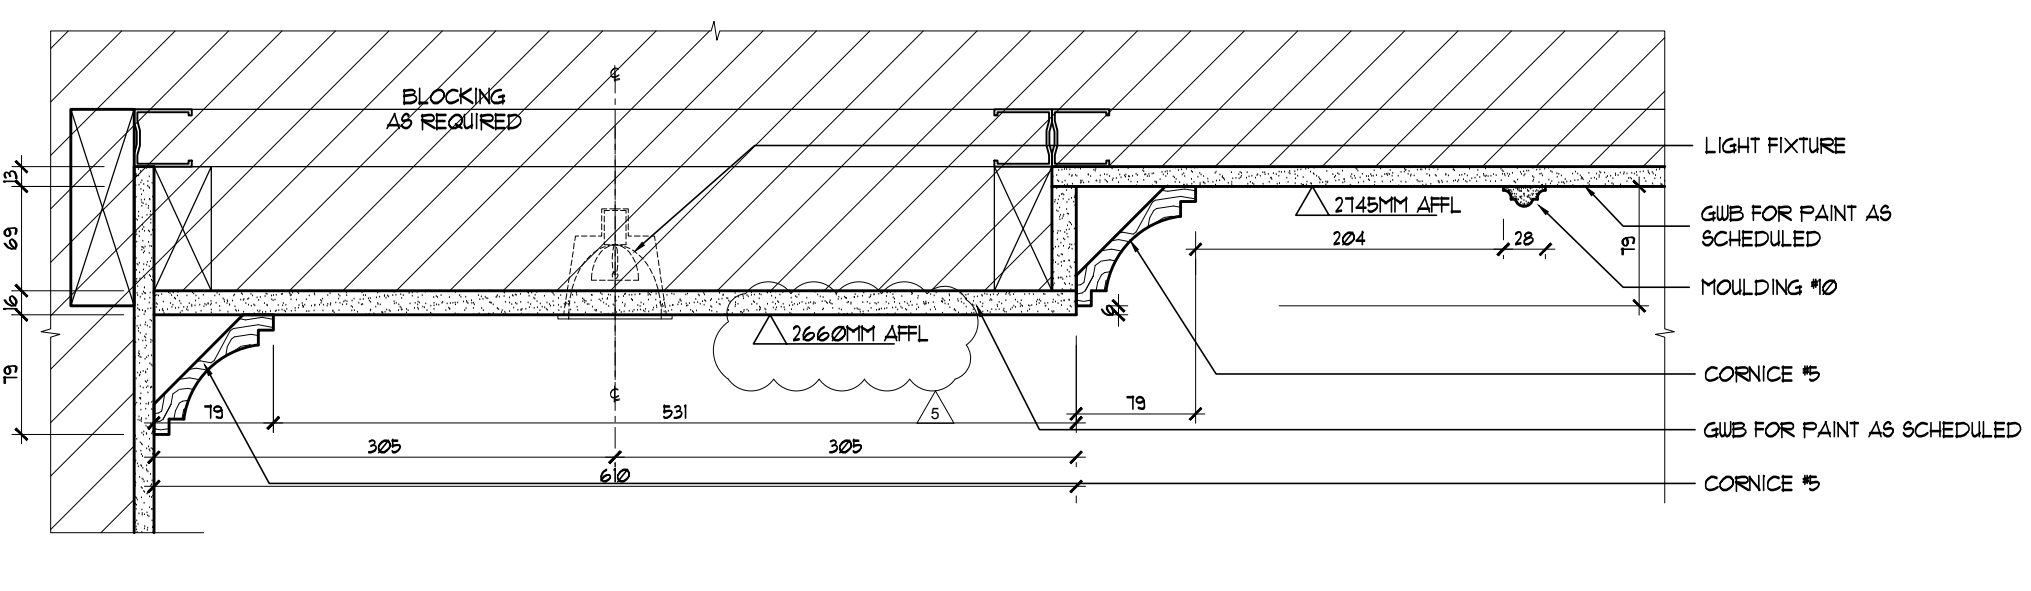


SECOND FLOOR TYP. CORNICE DETAIL
VERTICAL SECTION
2
ID3.0.0 SCALE: 1:5

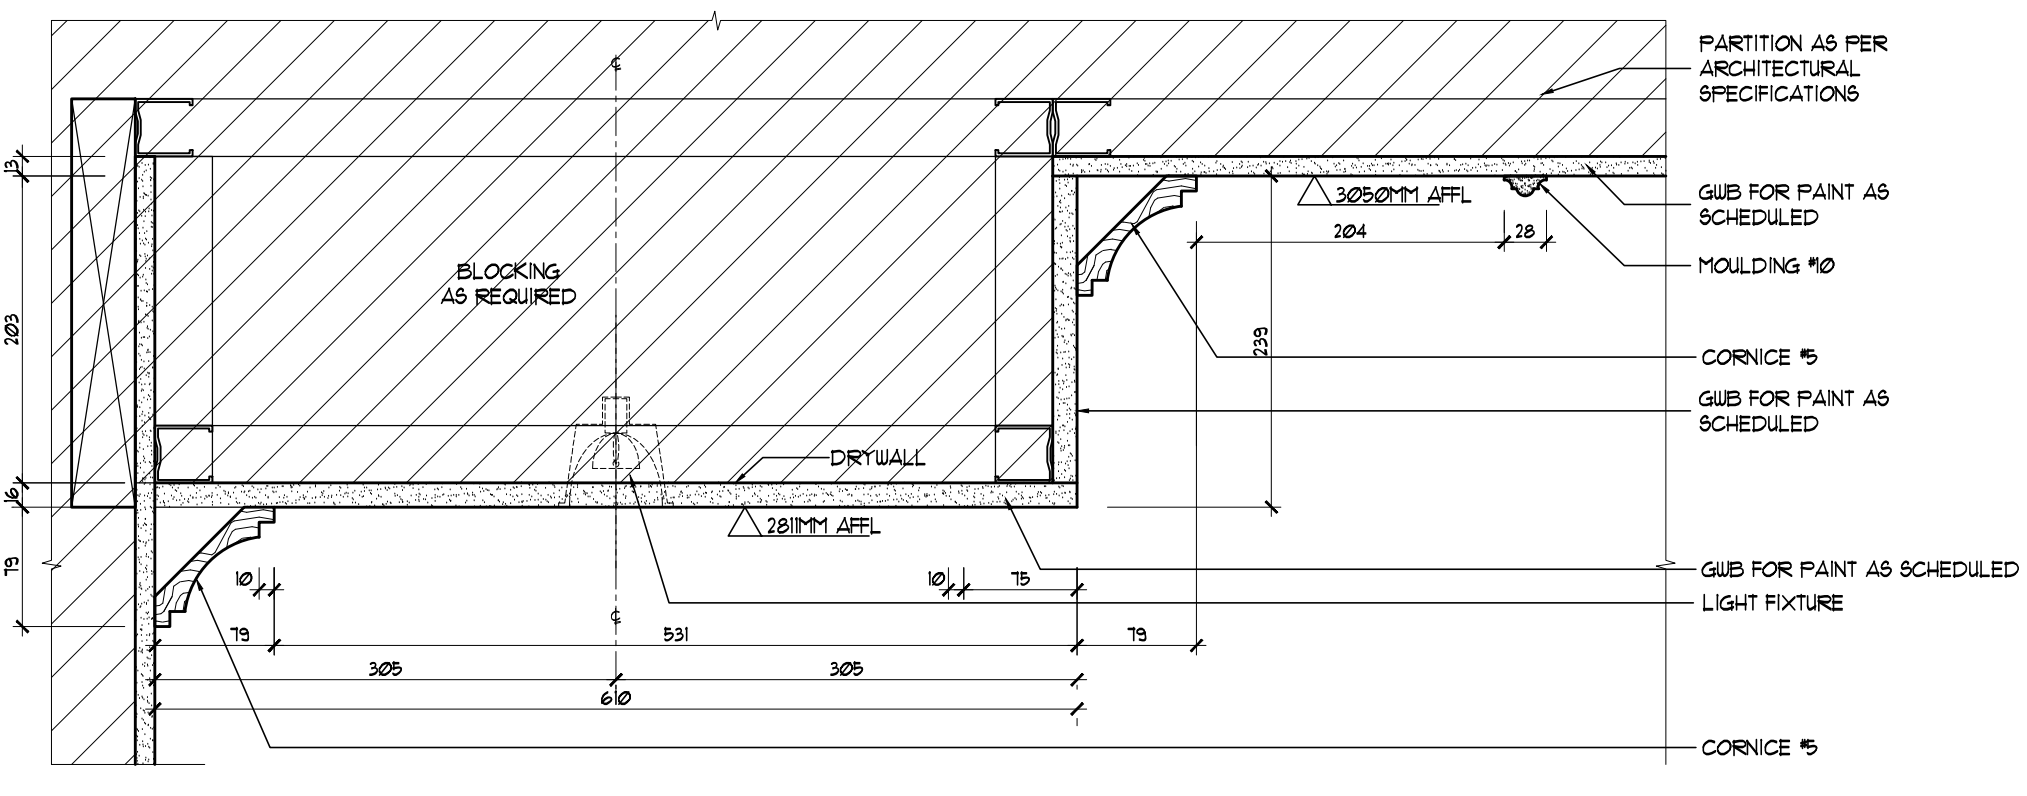


FIRST FLOOR TYP. CORNICE DETAIL
VERTICAL SECTION
1
ID3.0.0 SCALE: 1:5

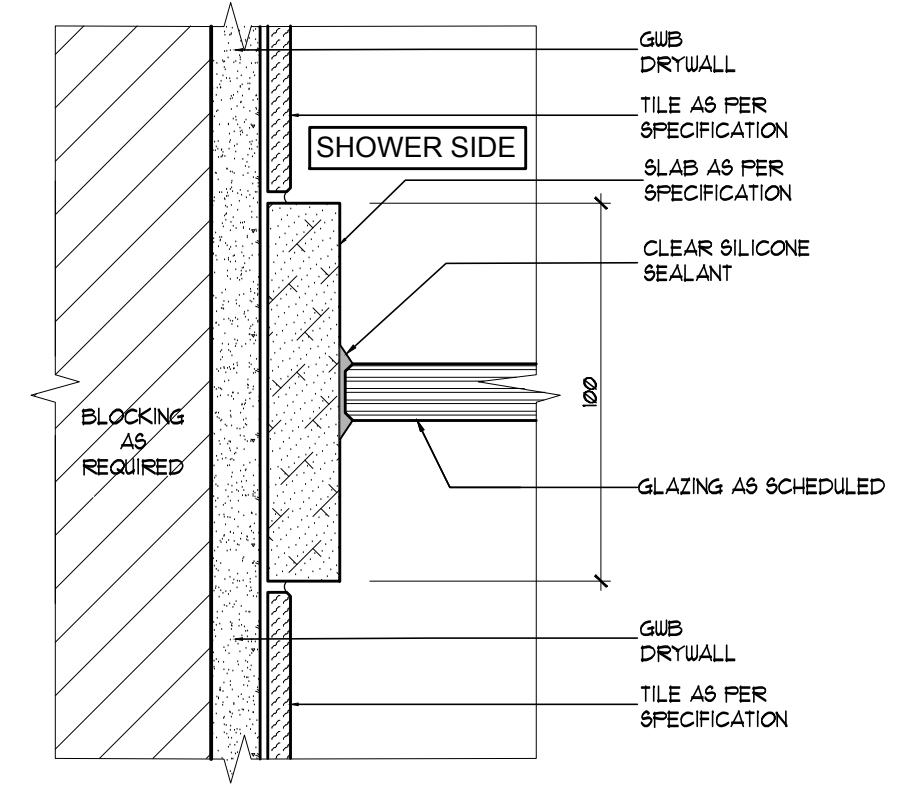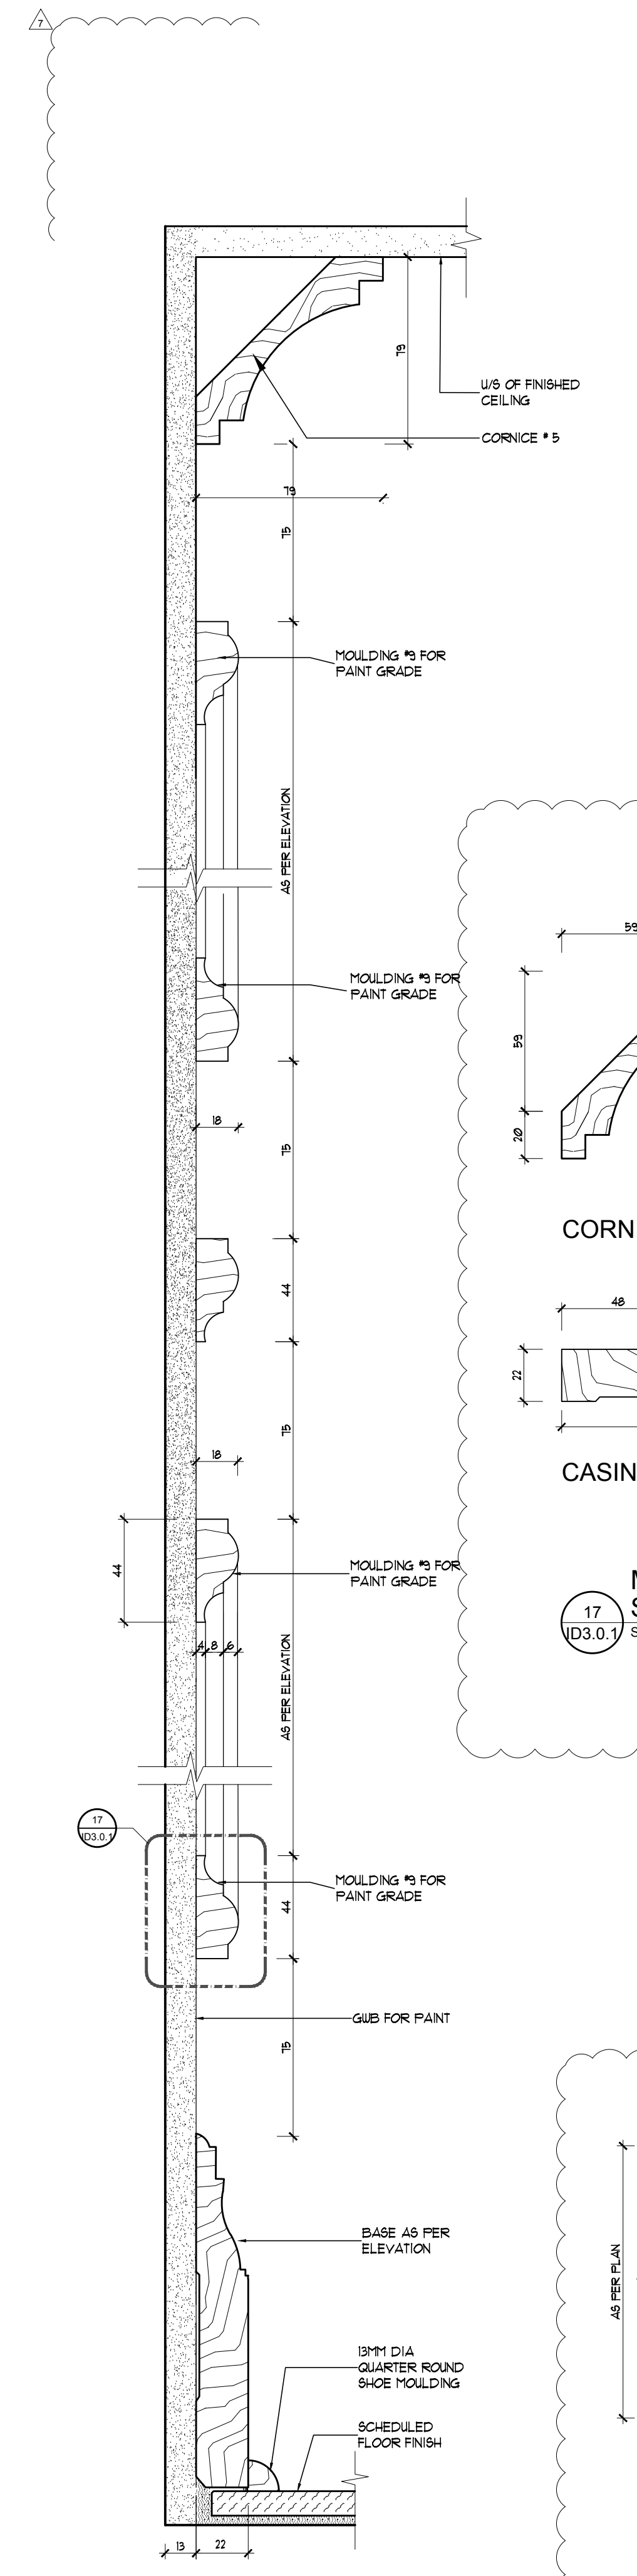


22 (D3.0.1) SHOWER ENCLOSURE HORIZONTAL SECTION SCALE: 1:2

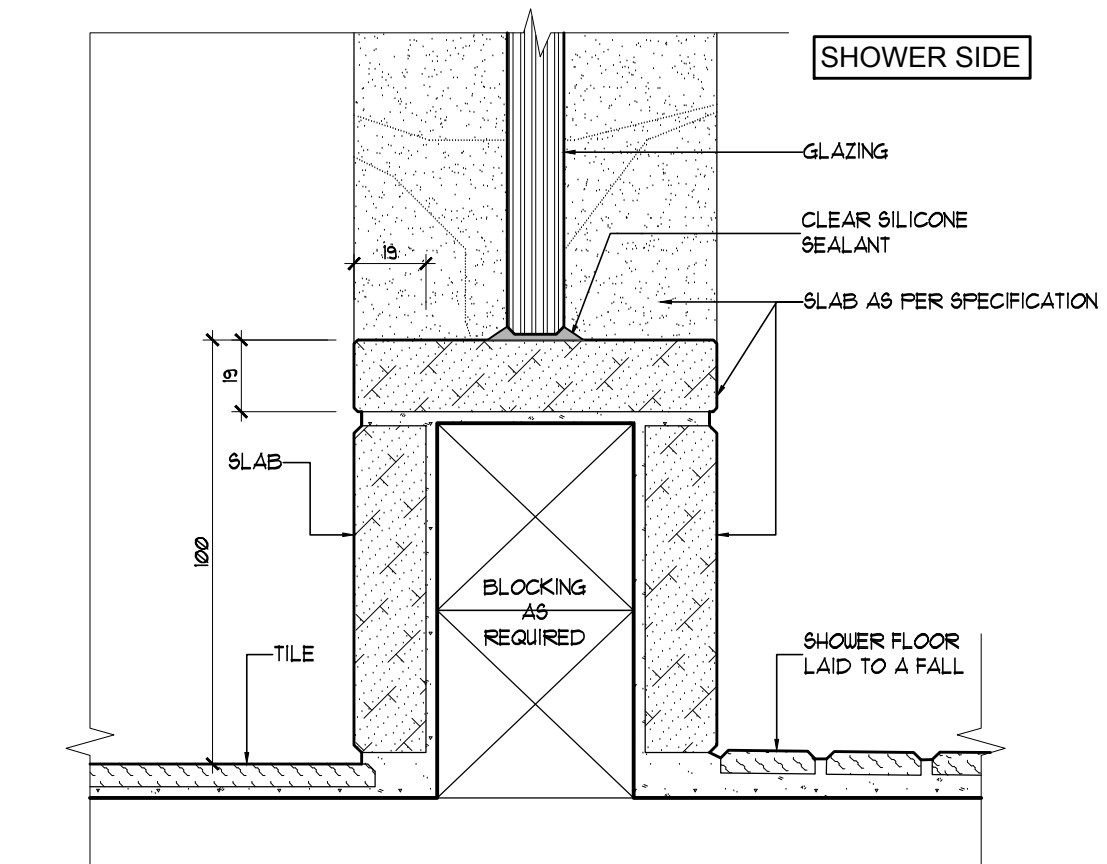


21 (D3.0.1) TYP. SHOWER CURB SECTION SCALE: 1:2

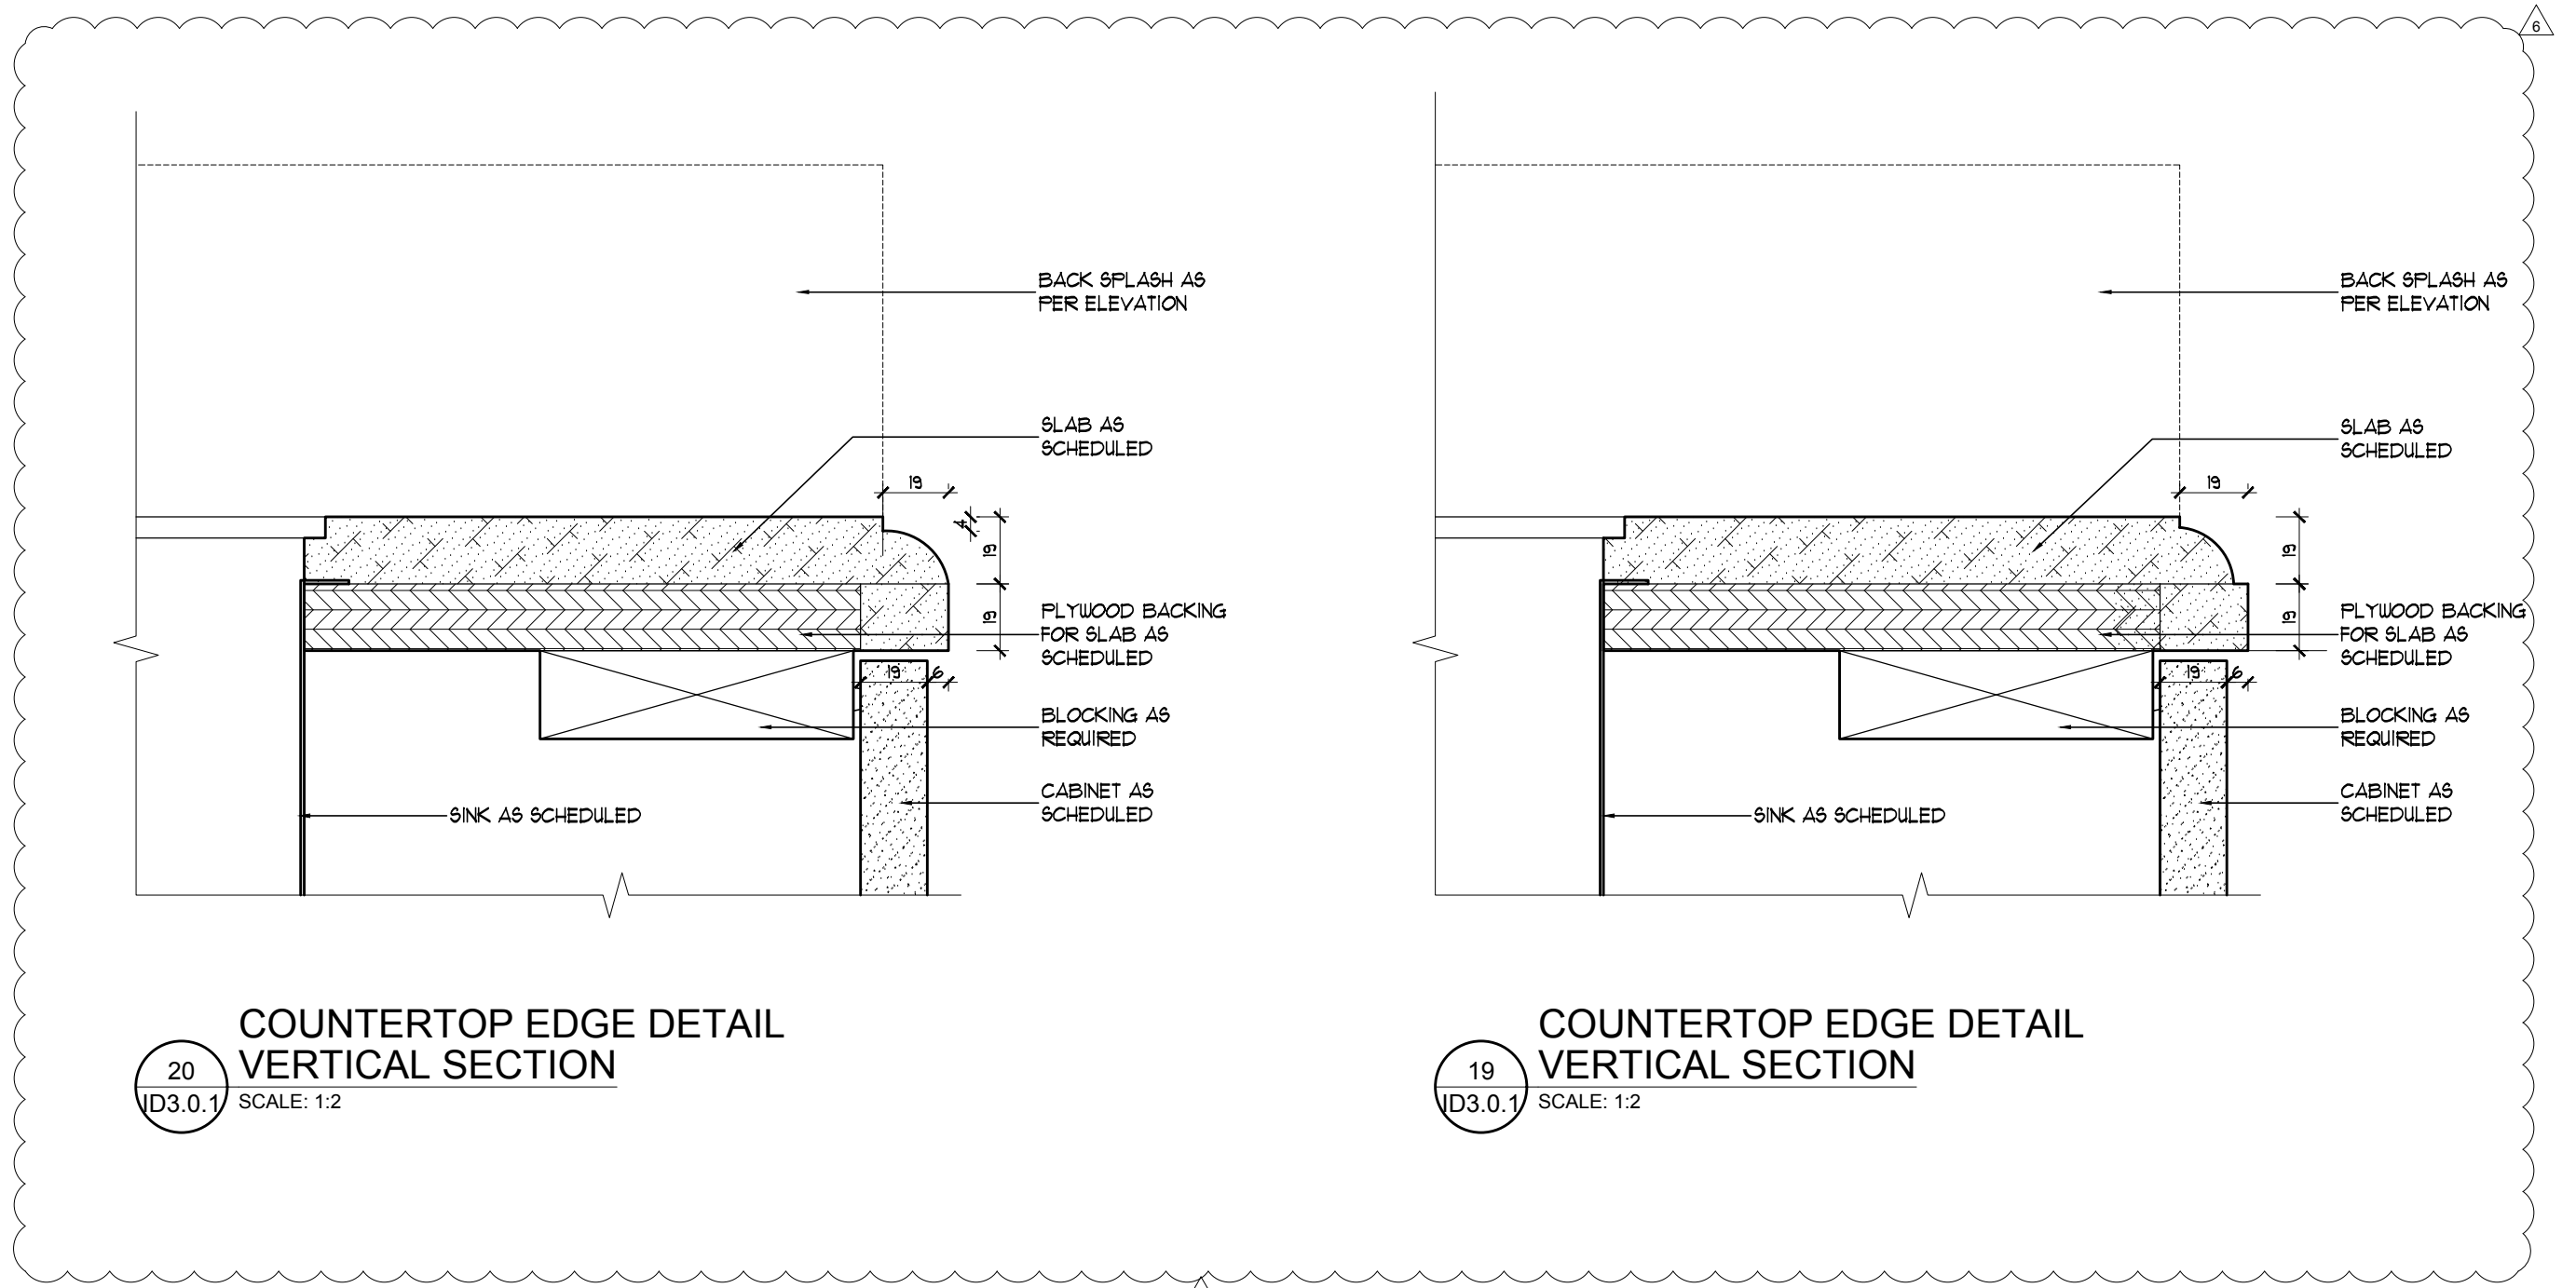


20 (D3.0.1) COUNTERTOP EDGE DETAIL VERTICAL SECTION SCALE: 1:2

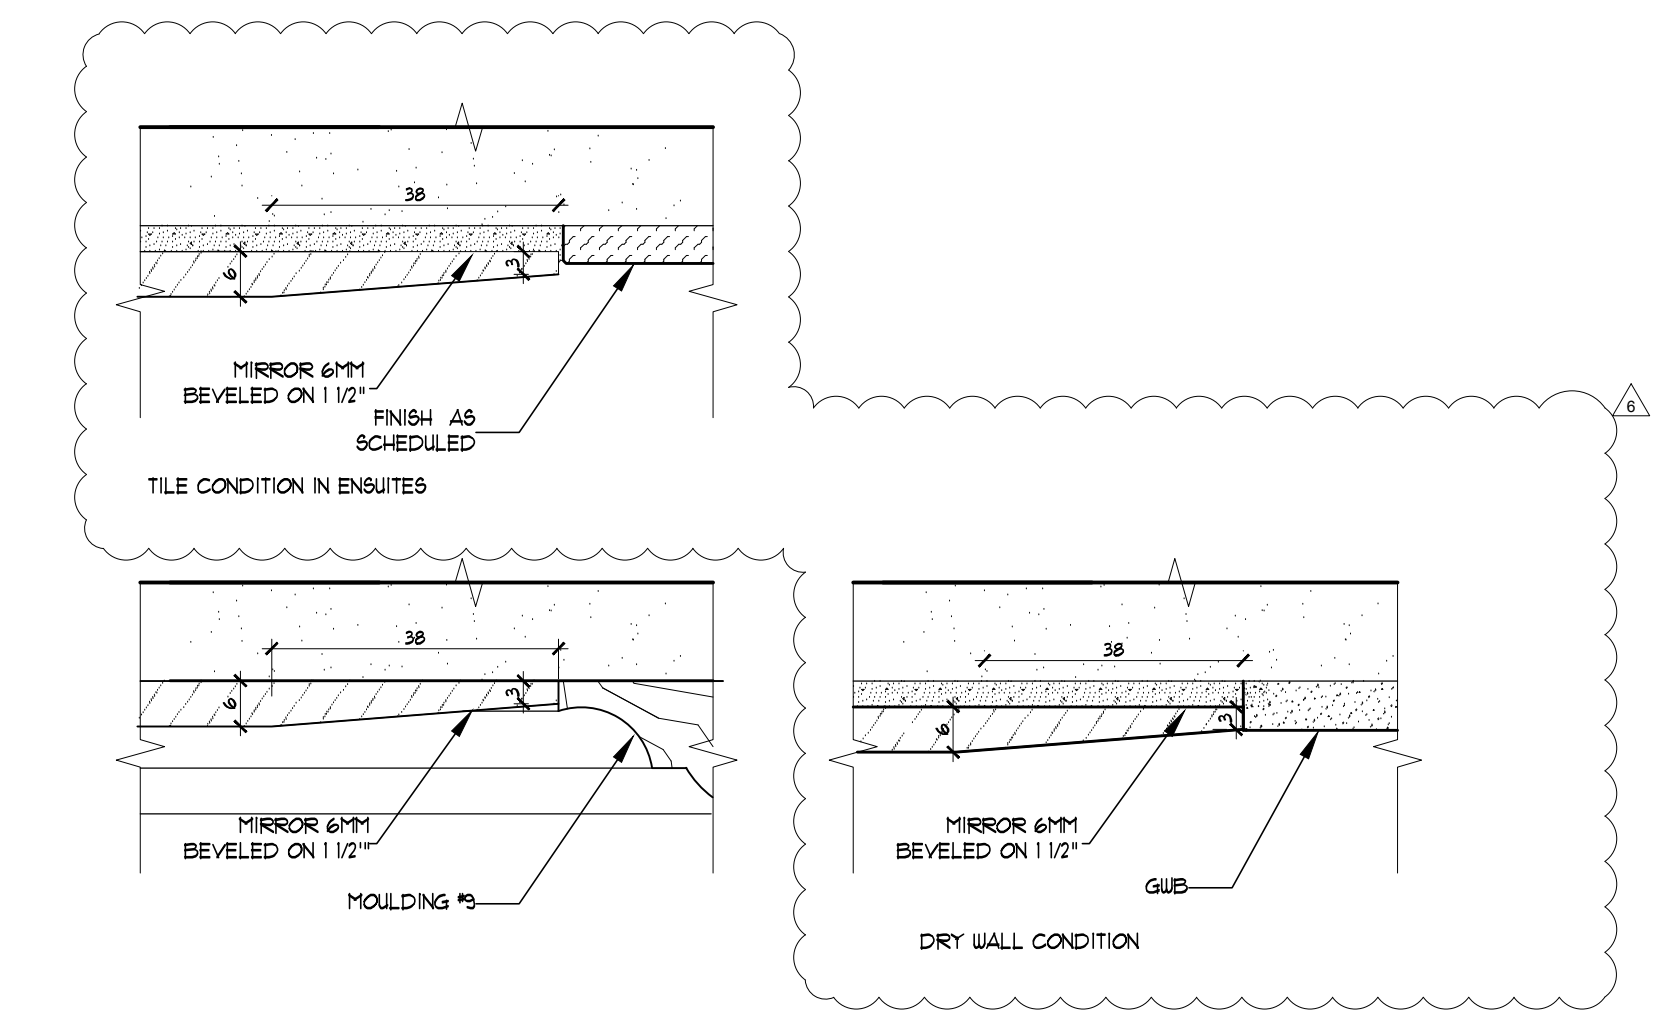


18 (D3.0.1) MIRROR, MOULDING DETAIL SECTION SCALE: 1:2

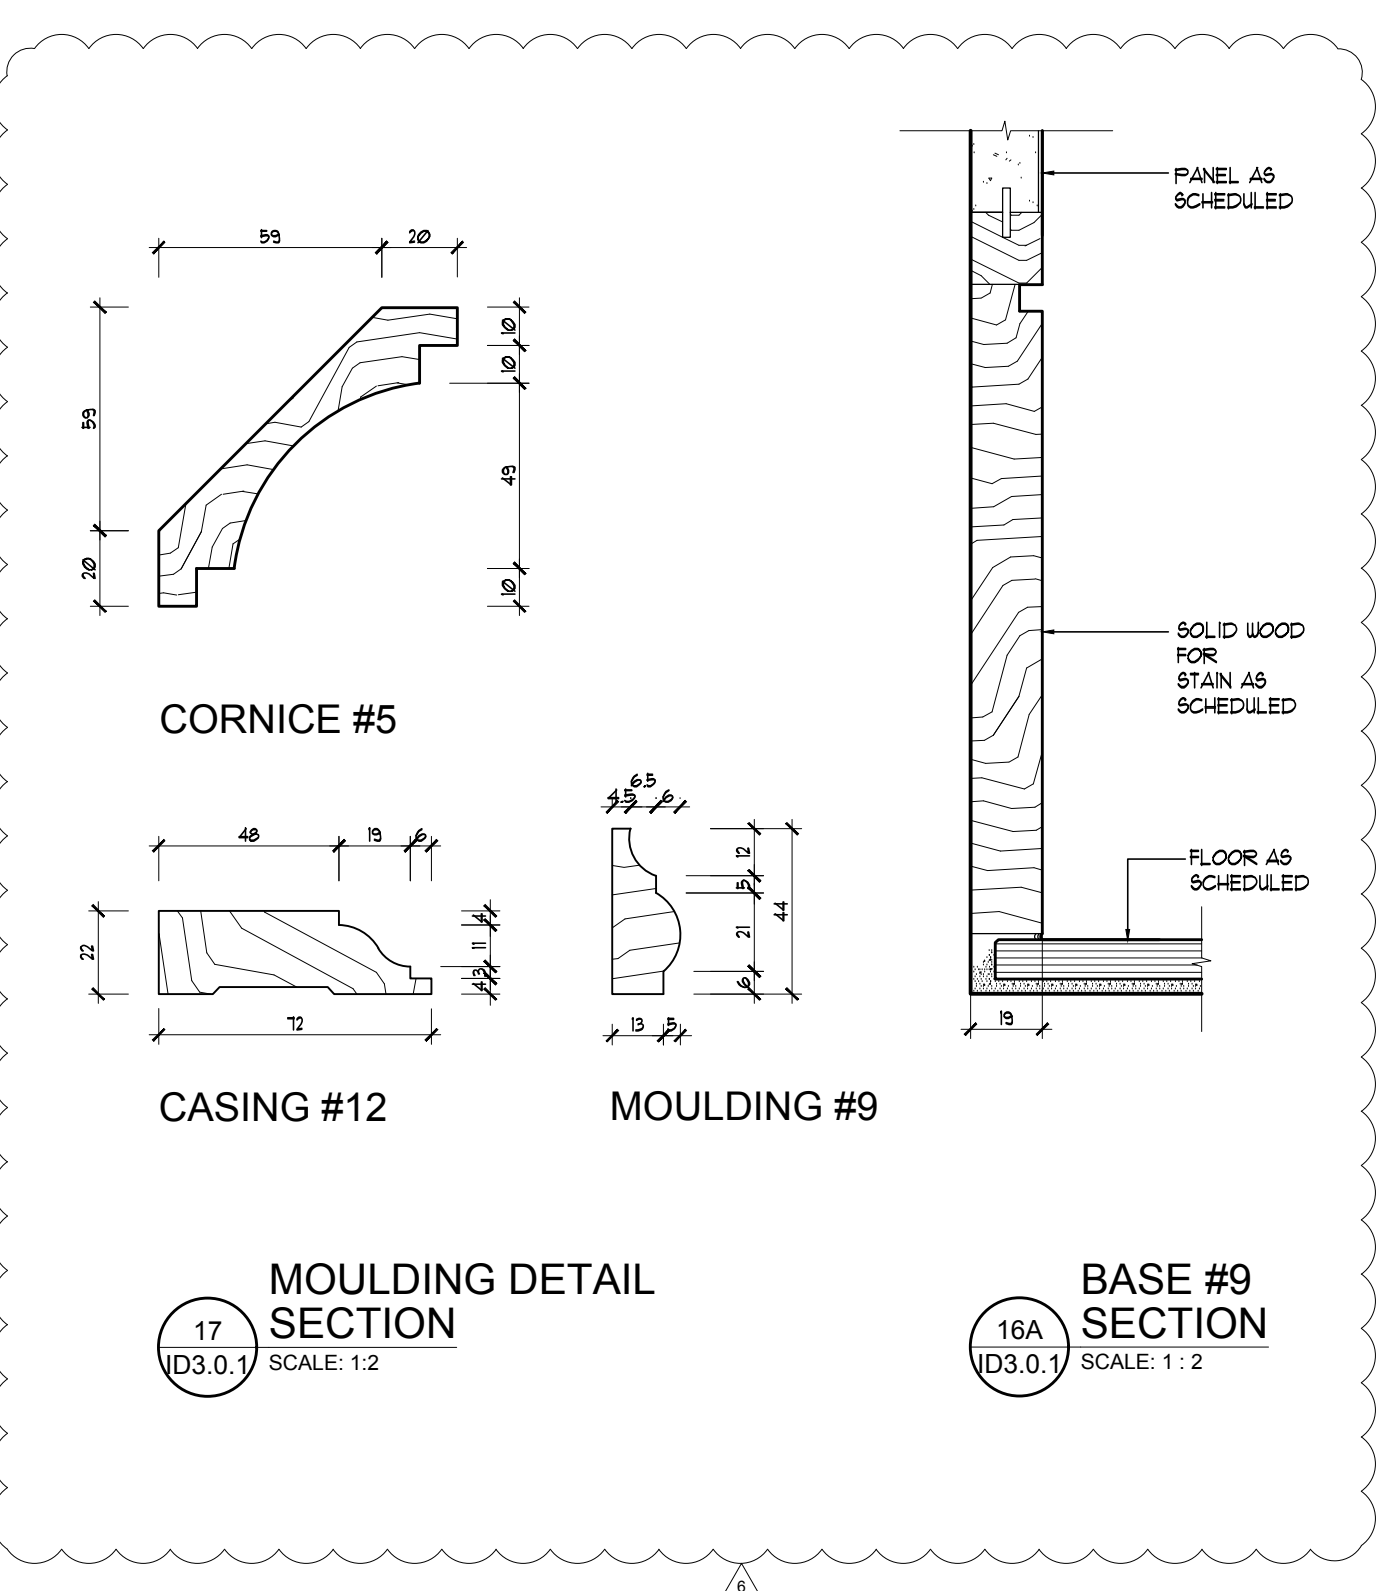


17 (D3.0.1) MOULDING DETAIL SECTION SCALE: 1:2

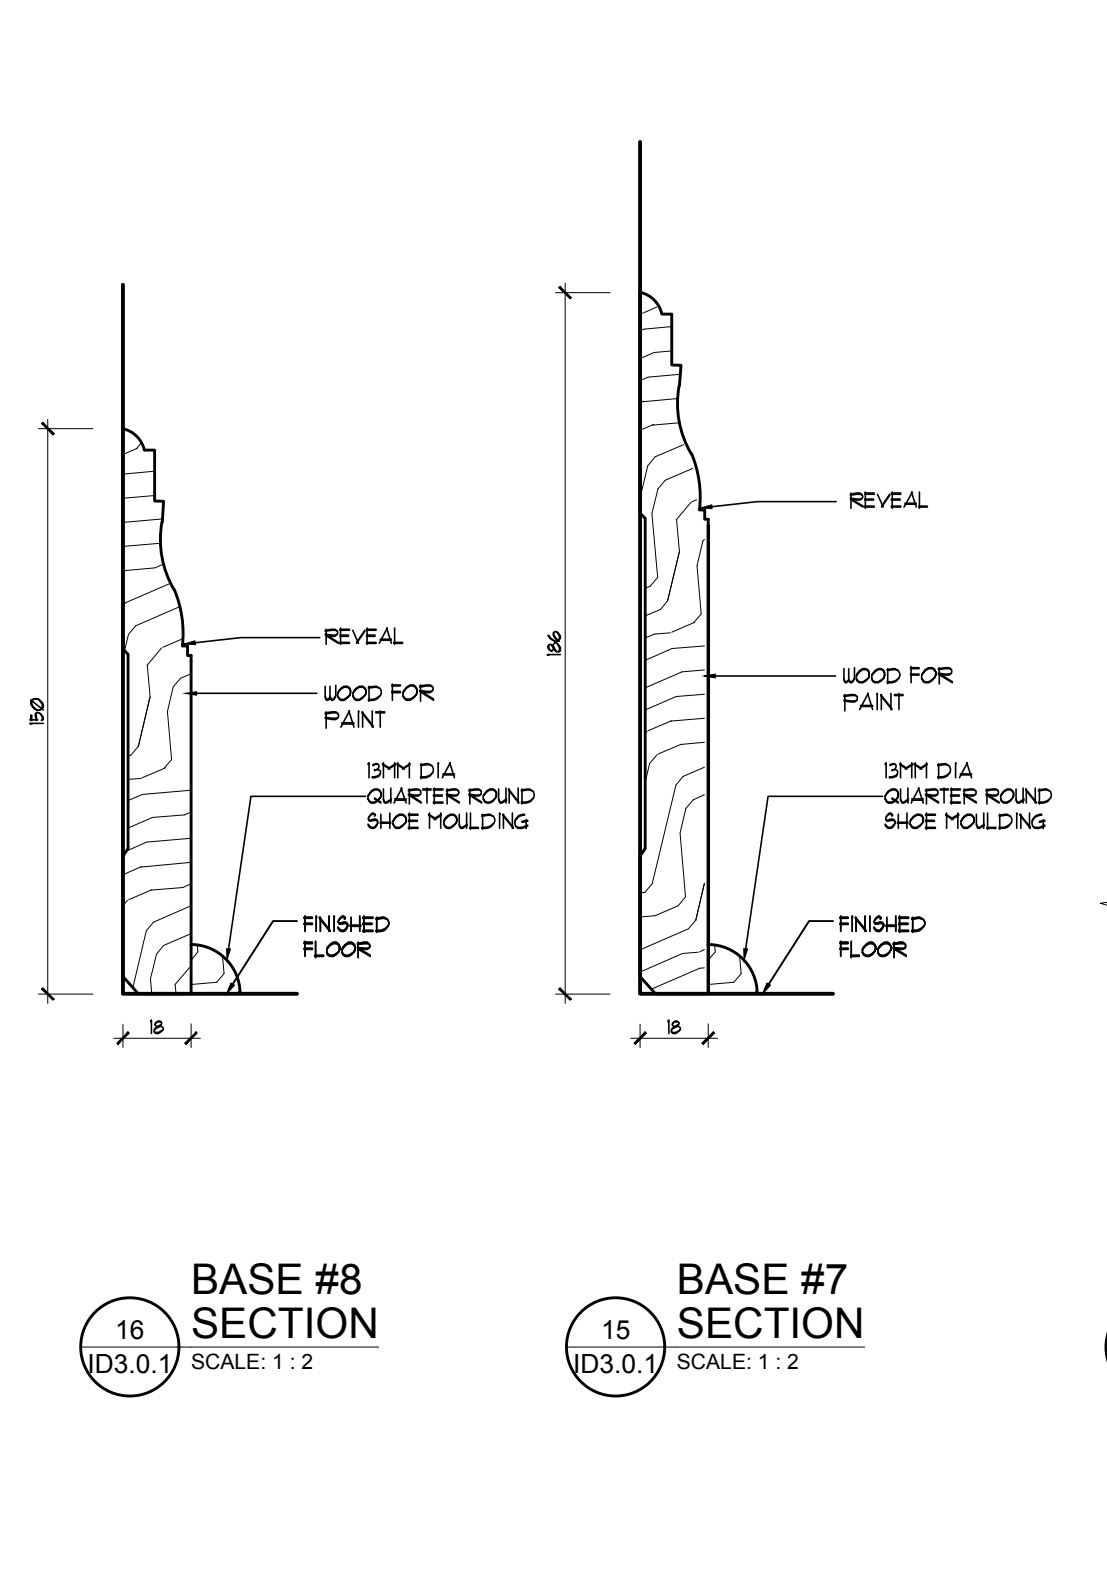


16 (D3.0.1) BASE #8 SECTION SCALE: 1:2

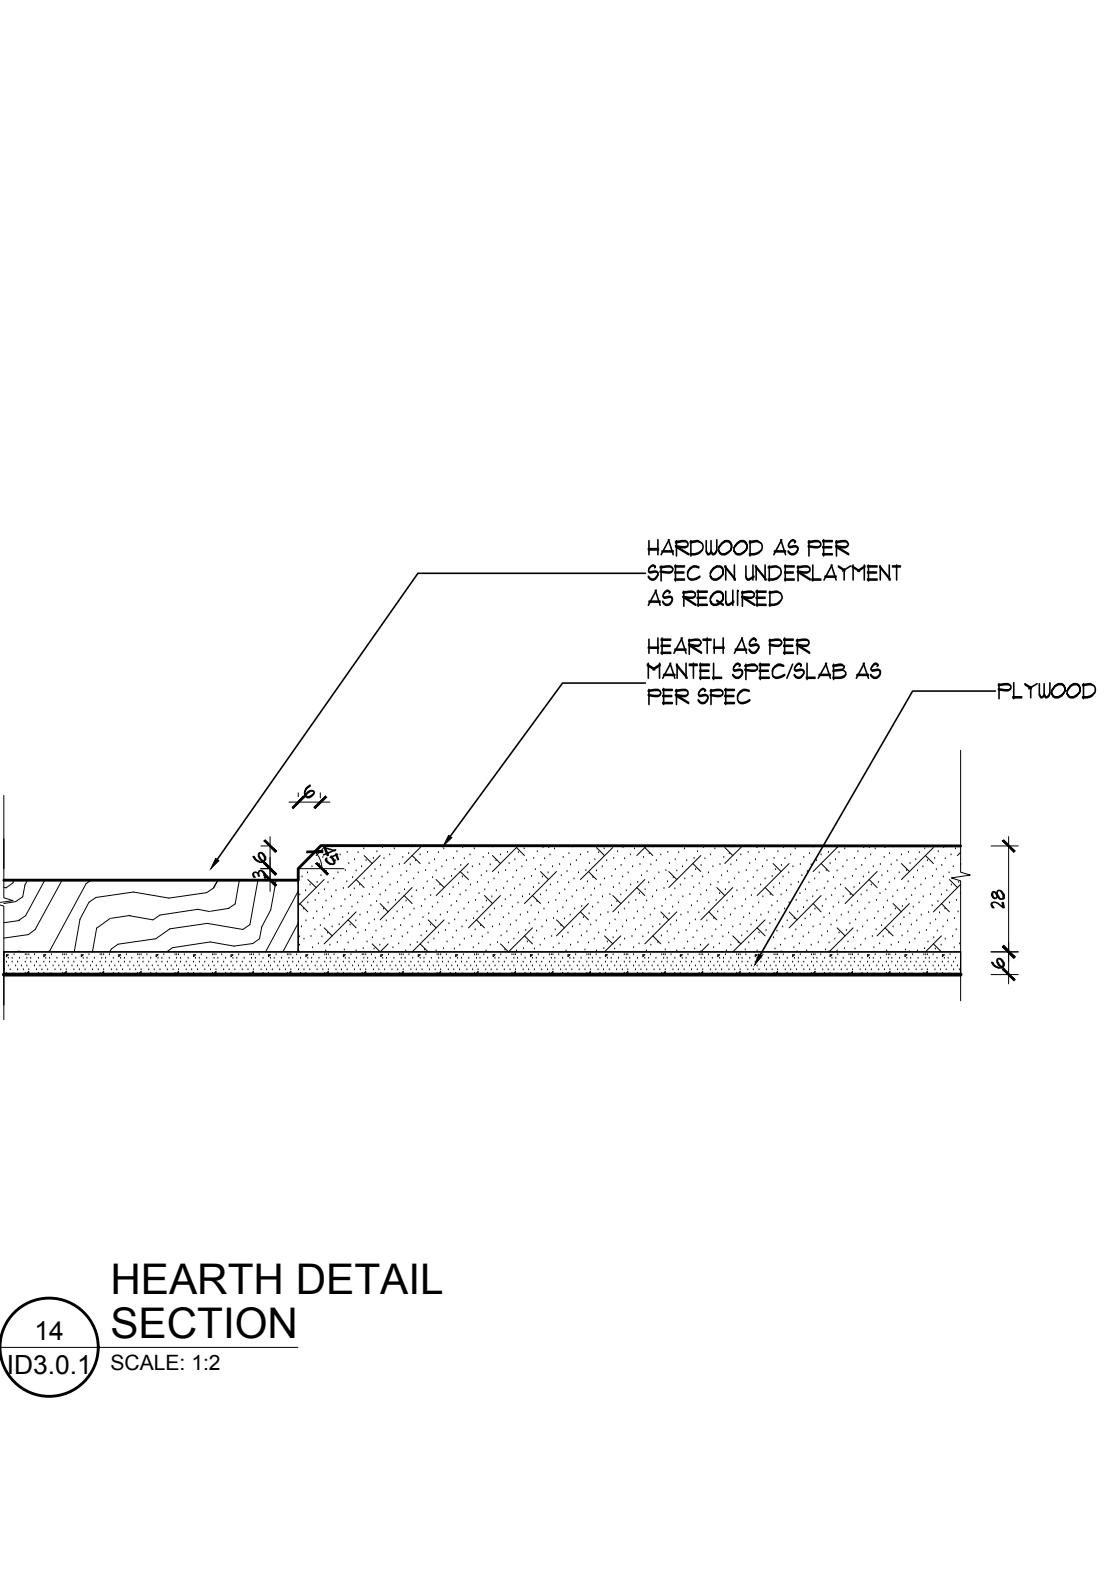


14 (D3.0.1) HEARTH DETAIL SECTION SCALE: 1:2

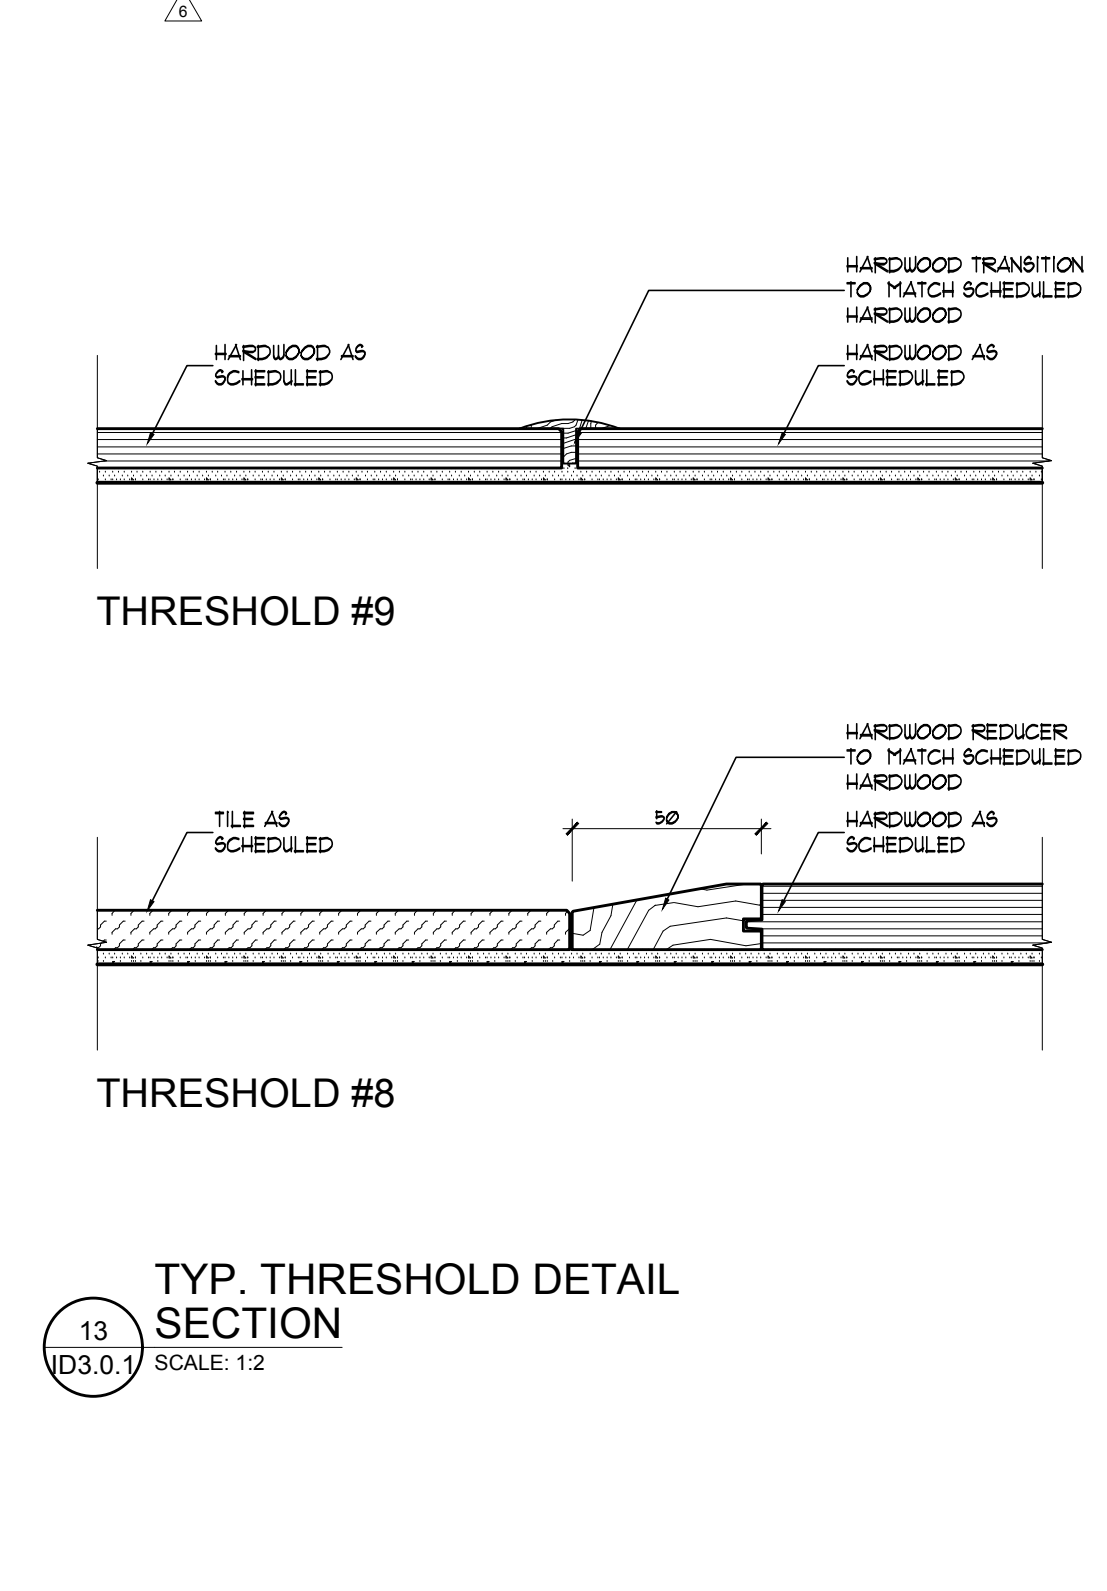


13 (D3.0.1) TYP. THRESHOLD DETAIL SECTION SCALE: 1:2

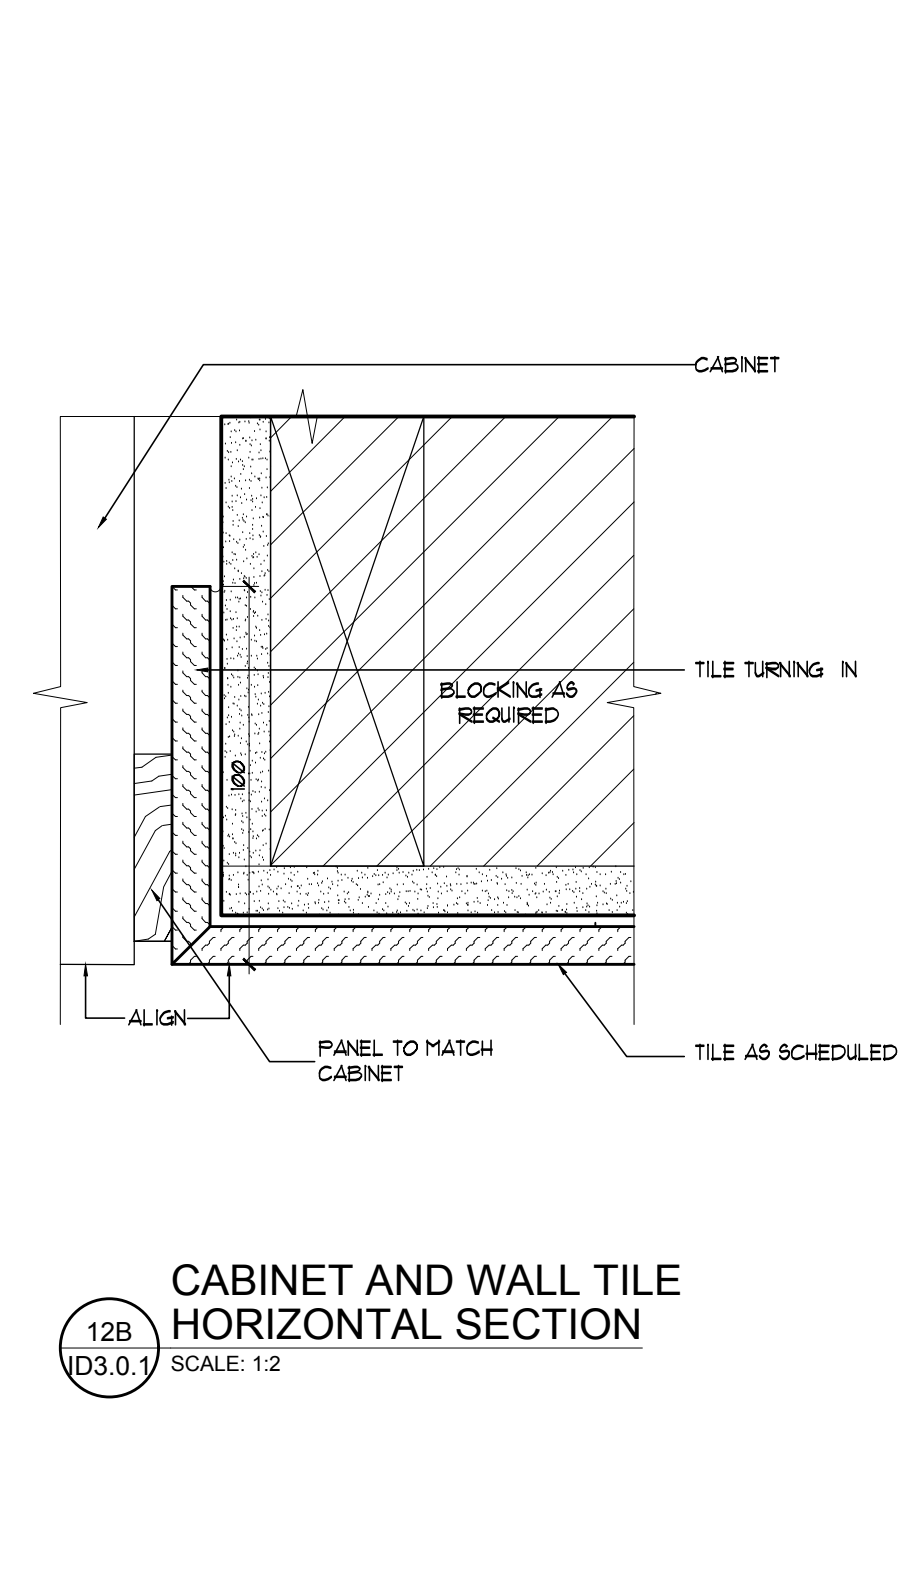


12B (D3.0.1) CABINET AND WALL TILE HORIZONTAL SECTION SCALE: 1:2

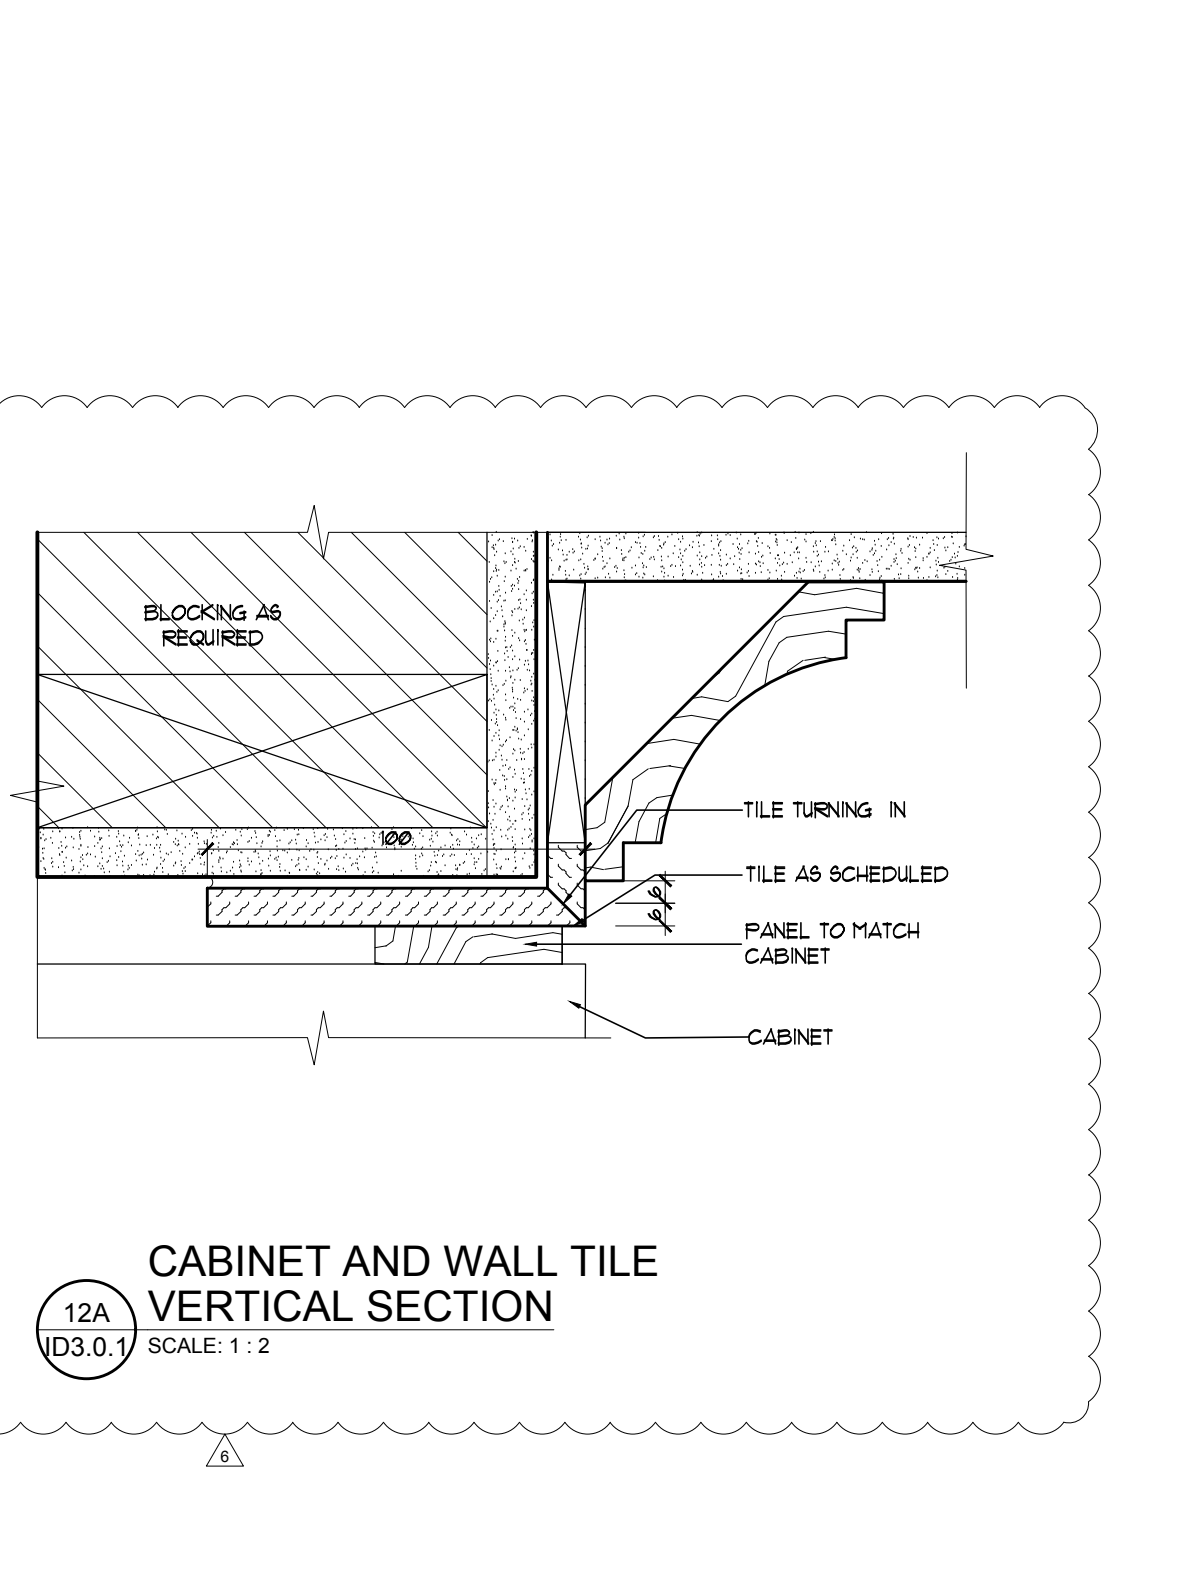


12A (D3.0.1) CABINET AND WALL TILE VERTICAL SECTION SCALE: 1:2

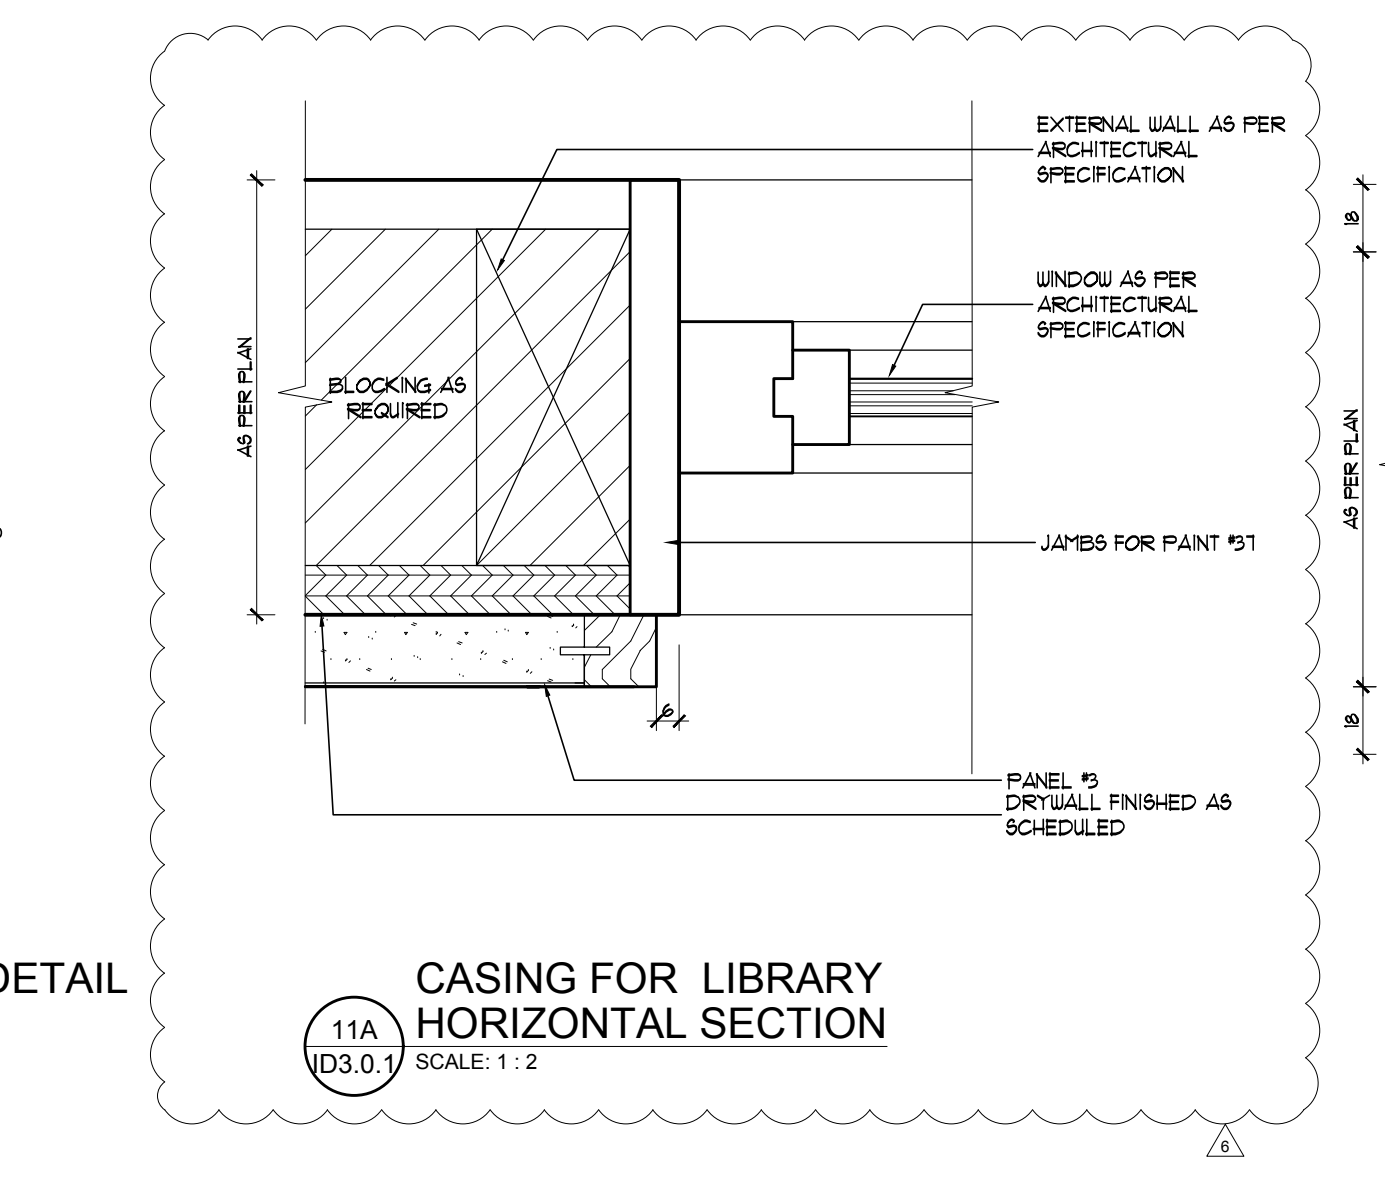


11A (D3.0.1) CASING FOR LIBRARY HORIZONTAL SECTION SCALE: 1:2

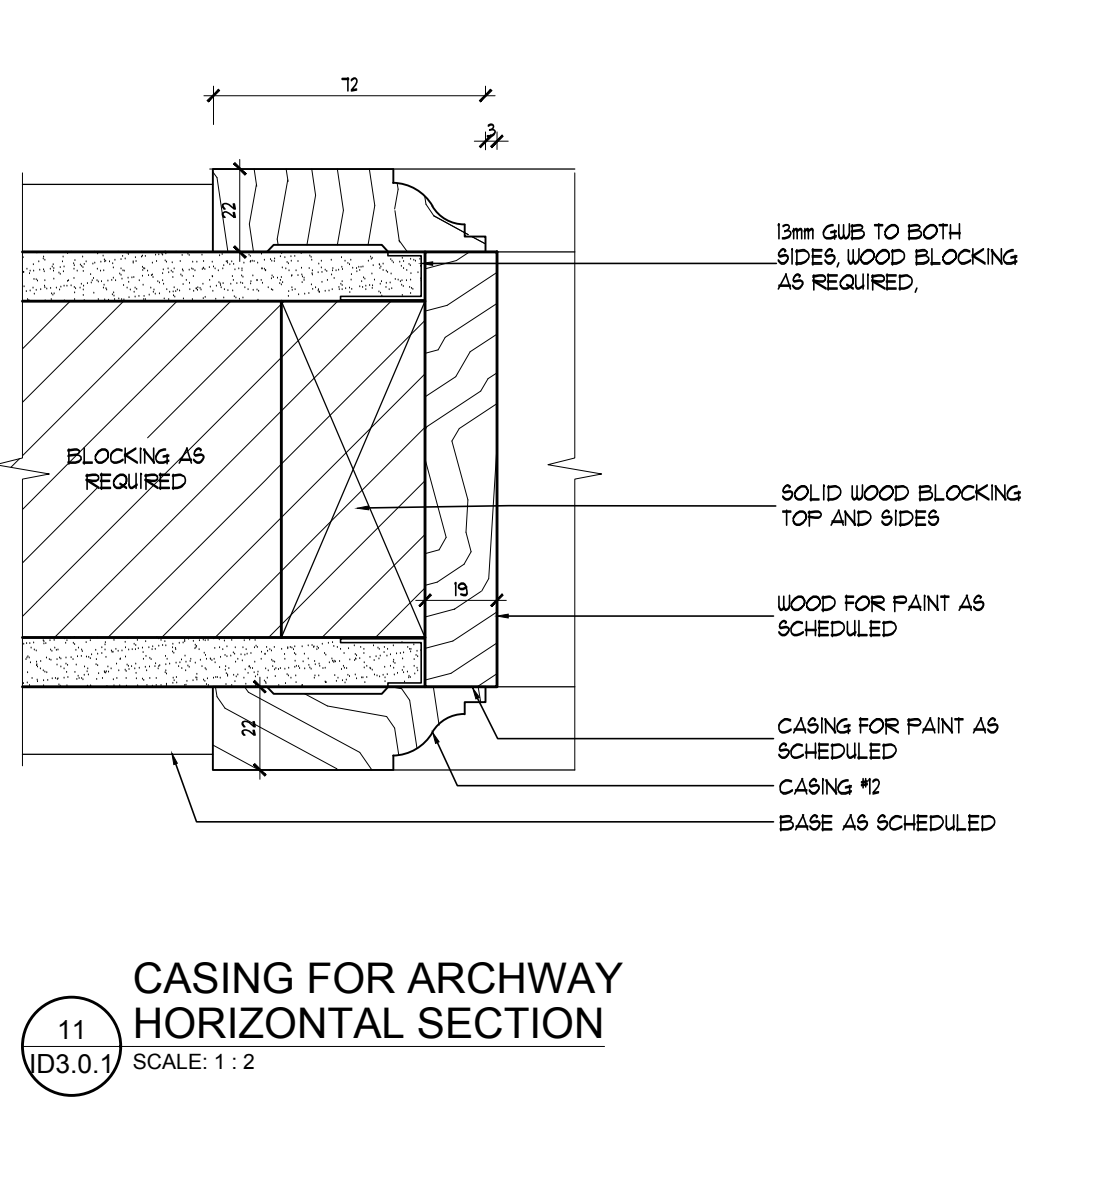


11 (D3.0.1) CASING FOR ARCHWAY HORIZONTAL SECTION SCALE: 1:2

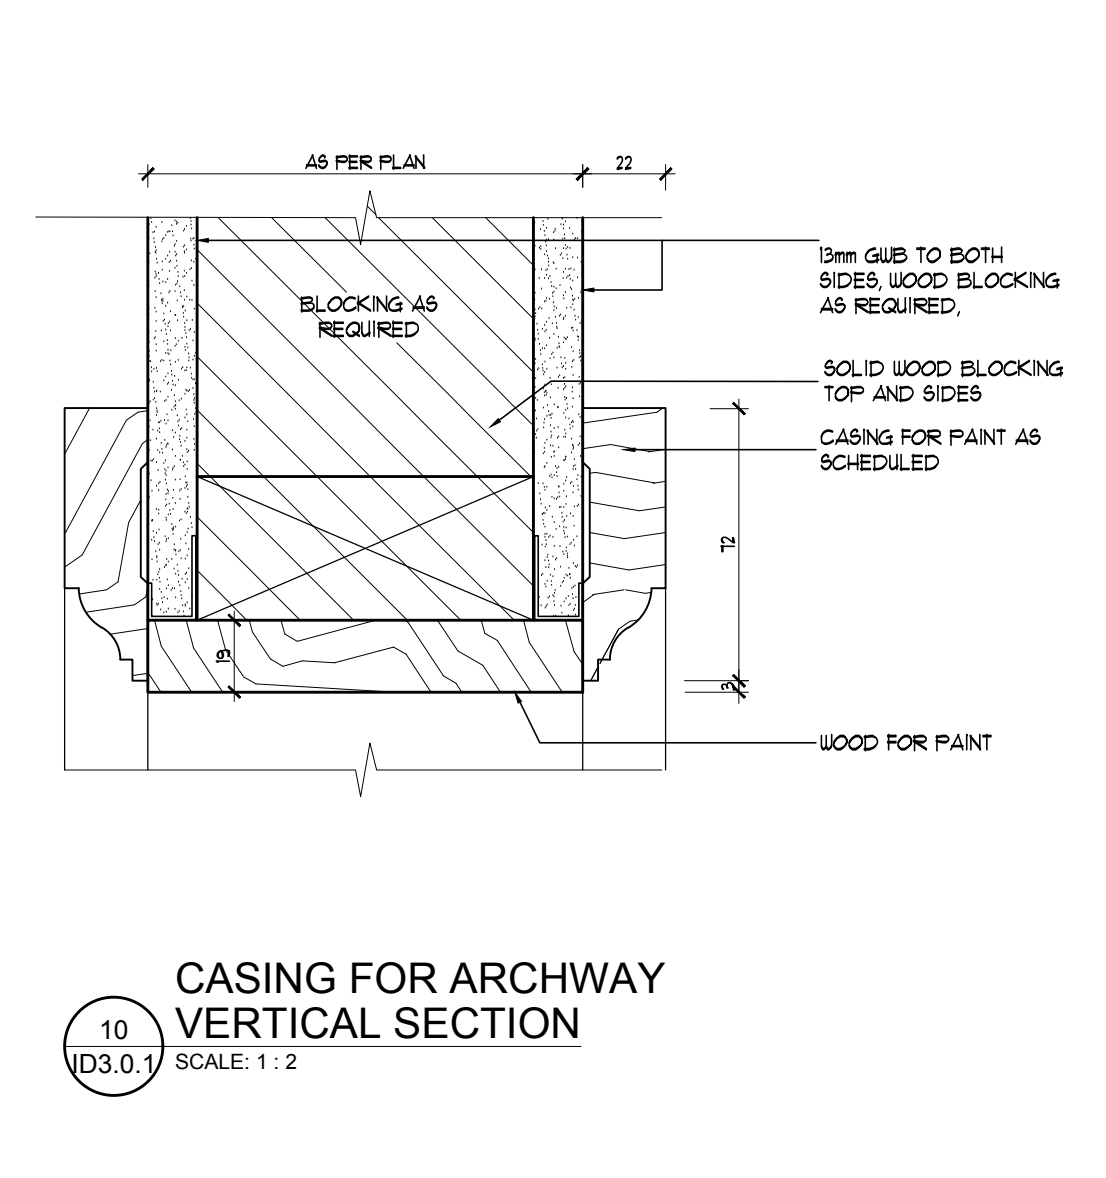


10 (D3.0.1) CASING FOR ARCHWAY VERTICAL SECTION SCALE: 1:2

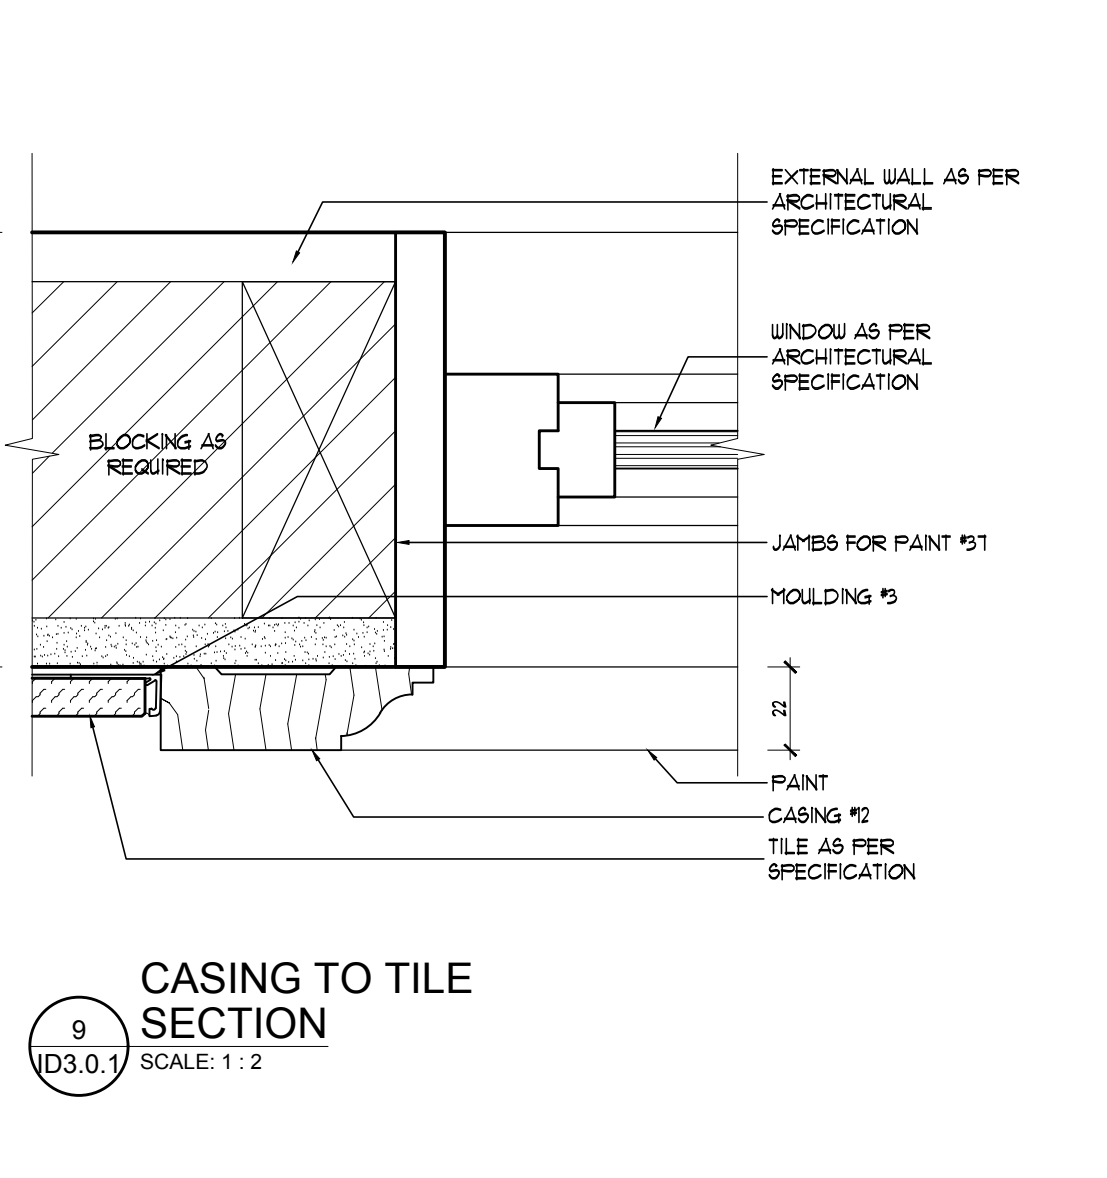


9 (D3.0.1) CASING TO TILE SECTION SCALE: 1:2

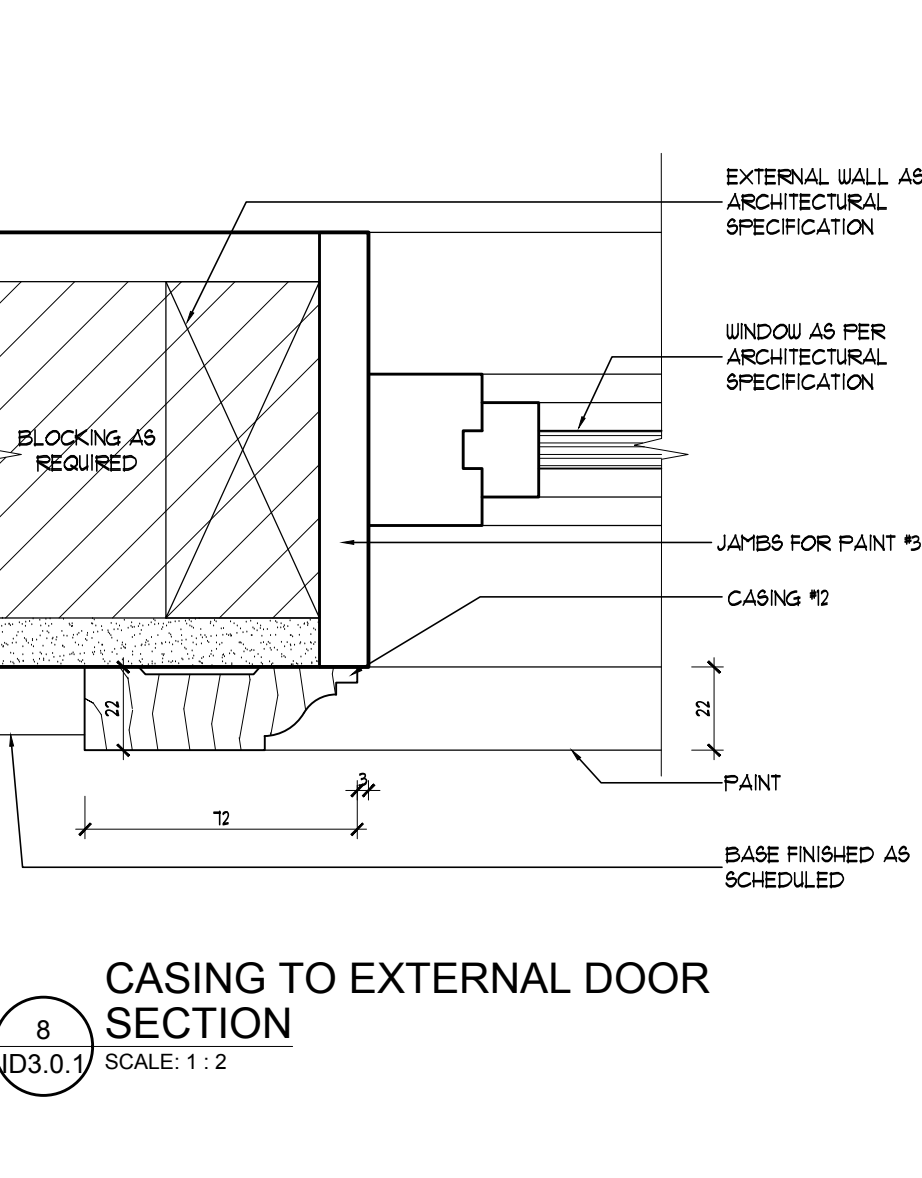


8 (D3.0.1) CASING TO EXTERNAL DOOR SECTION SCALE: 1:2

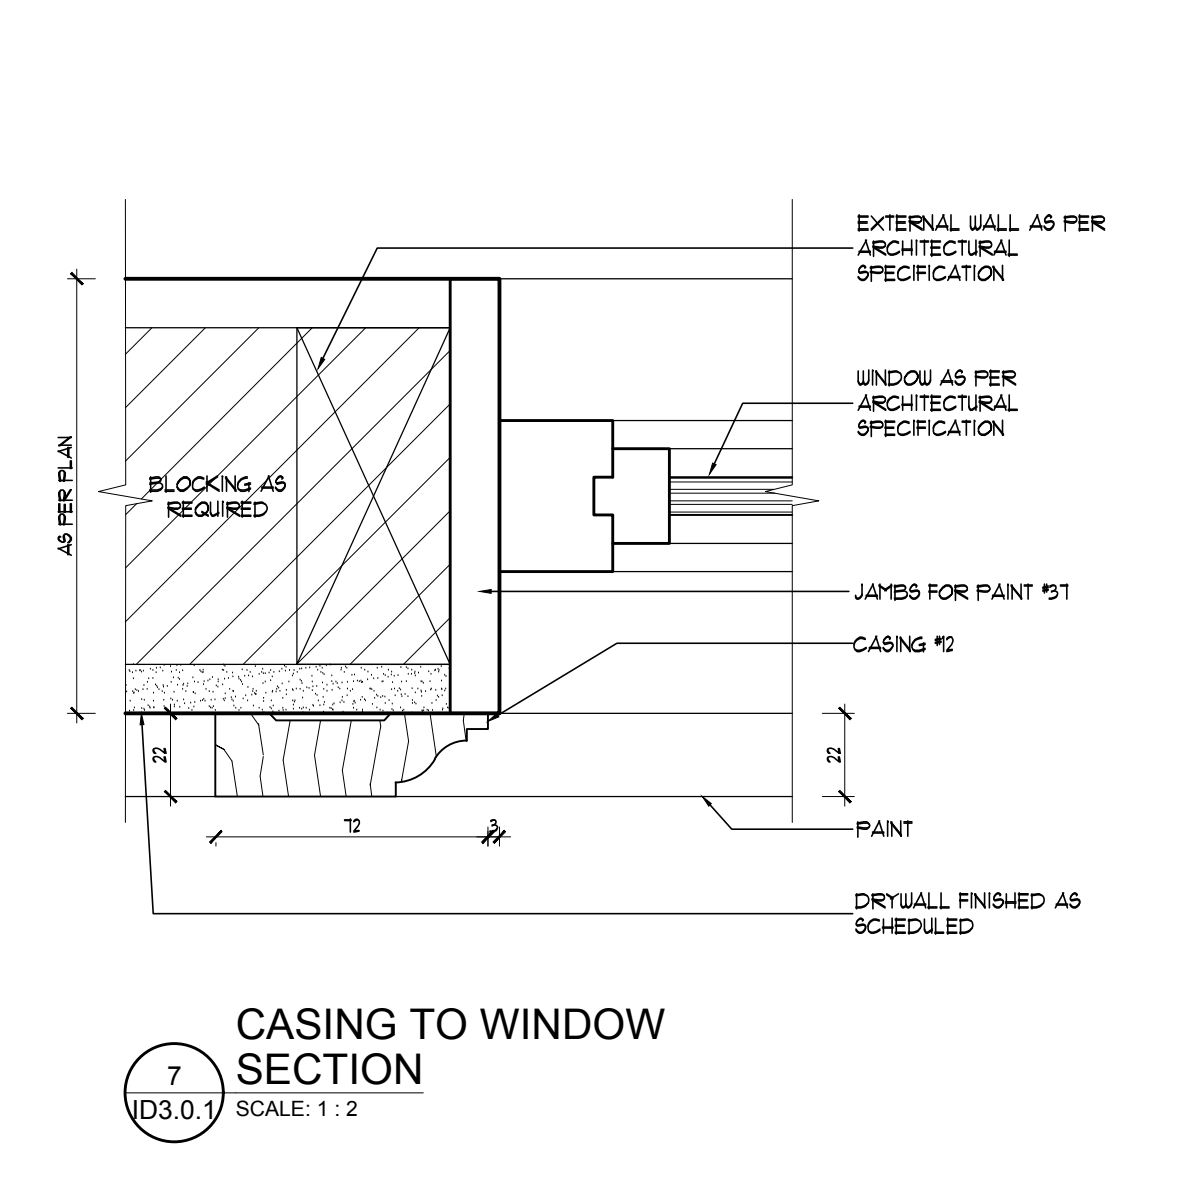


7 (D3.0.1) CASING TO WINDOW SECTION SCALE: 1:2

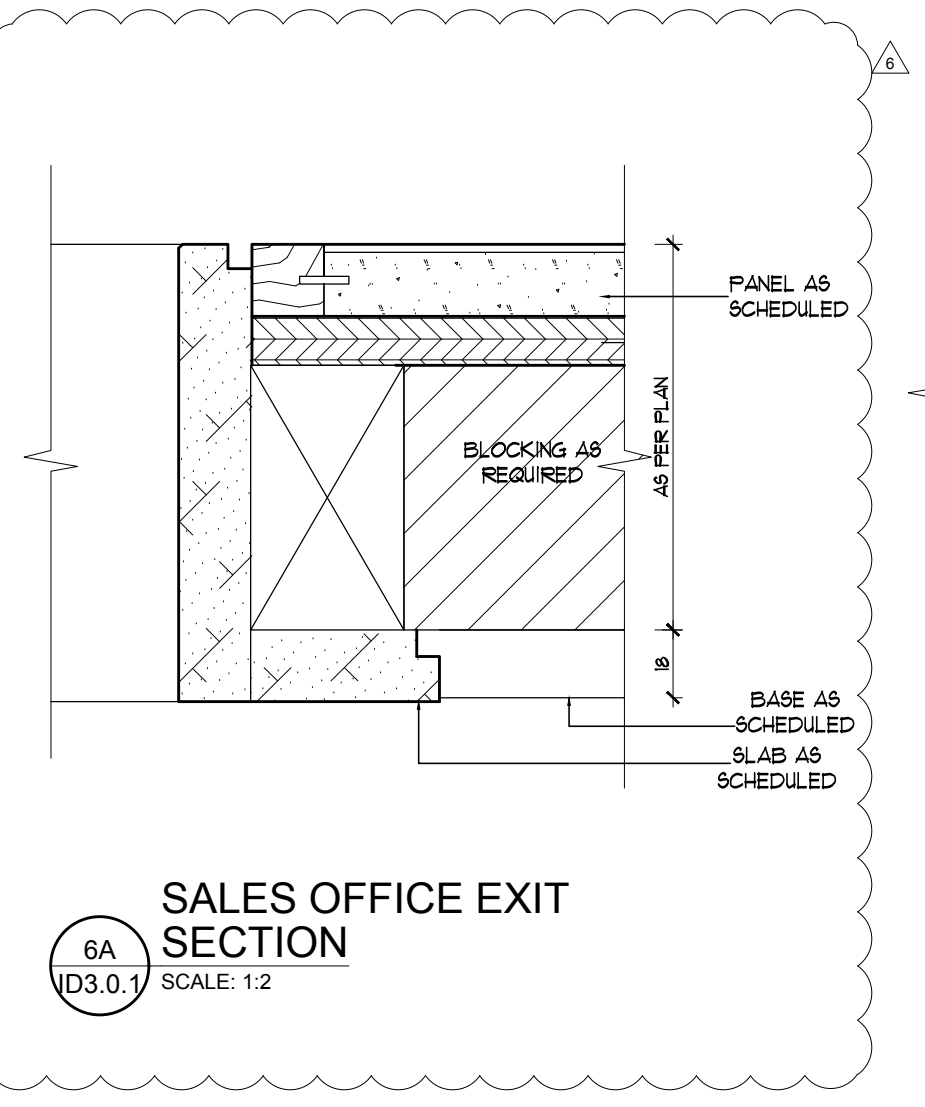


8A (D3.0.1) SALES OFFICE EXIT SECTION SCALE: 1:2

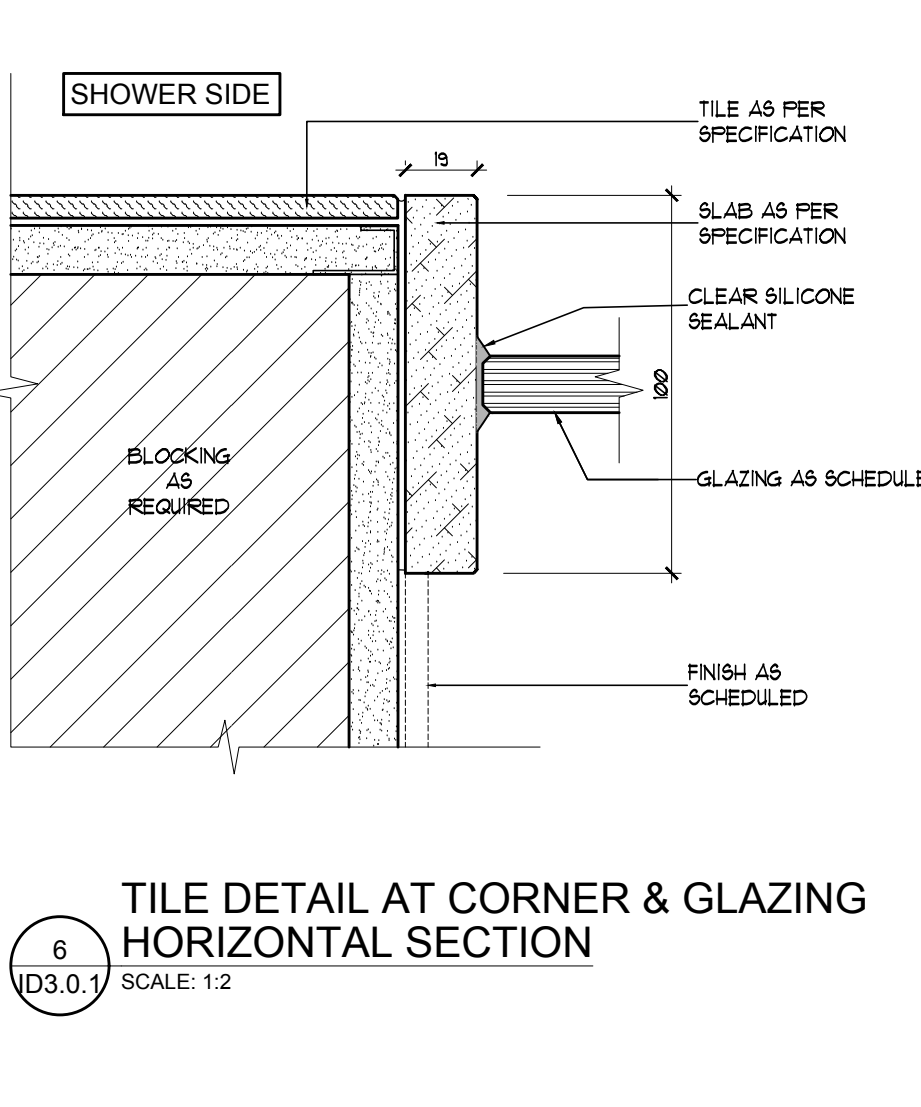


6 (D3.0.1) TILE DETAIL AT CORNER & GLAZING HORIZONTAL SECTION SCALE: 1:2

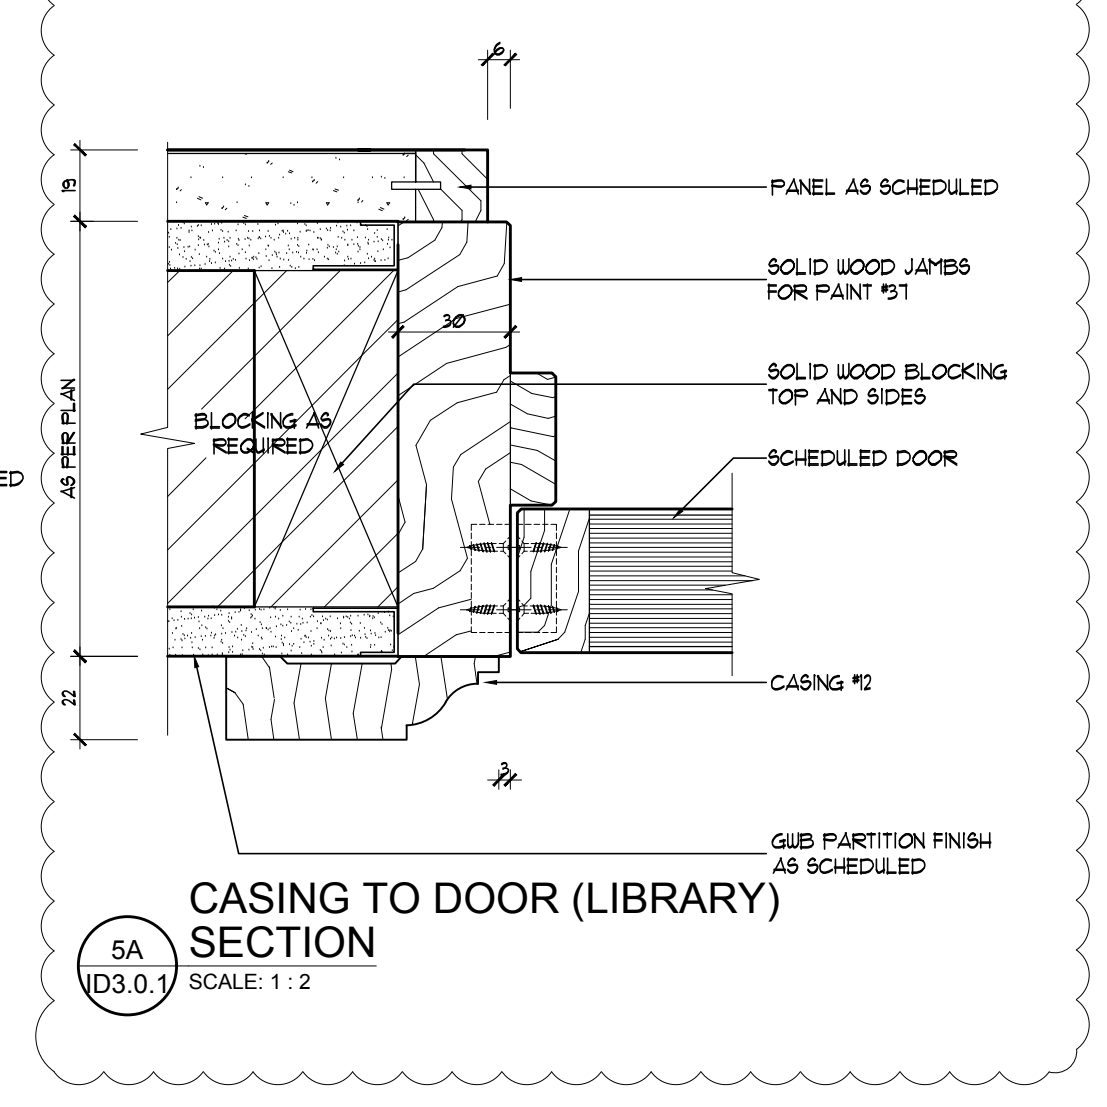


5A (D3.0.1) CASING TO DOOR (LIBRARY) SECTION SCALE: 1:2

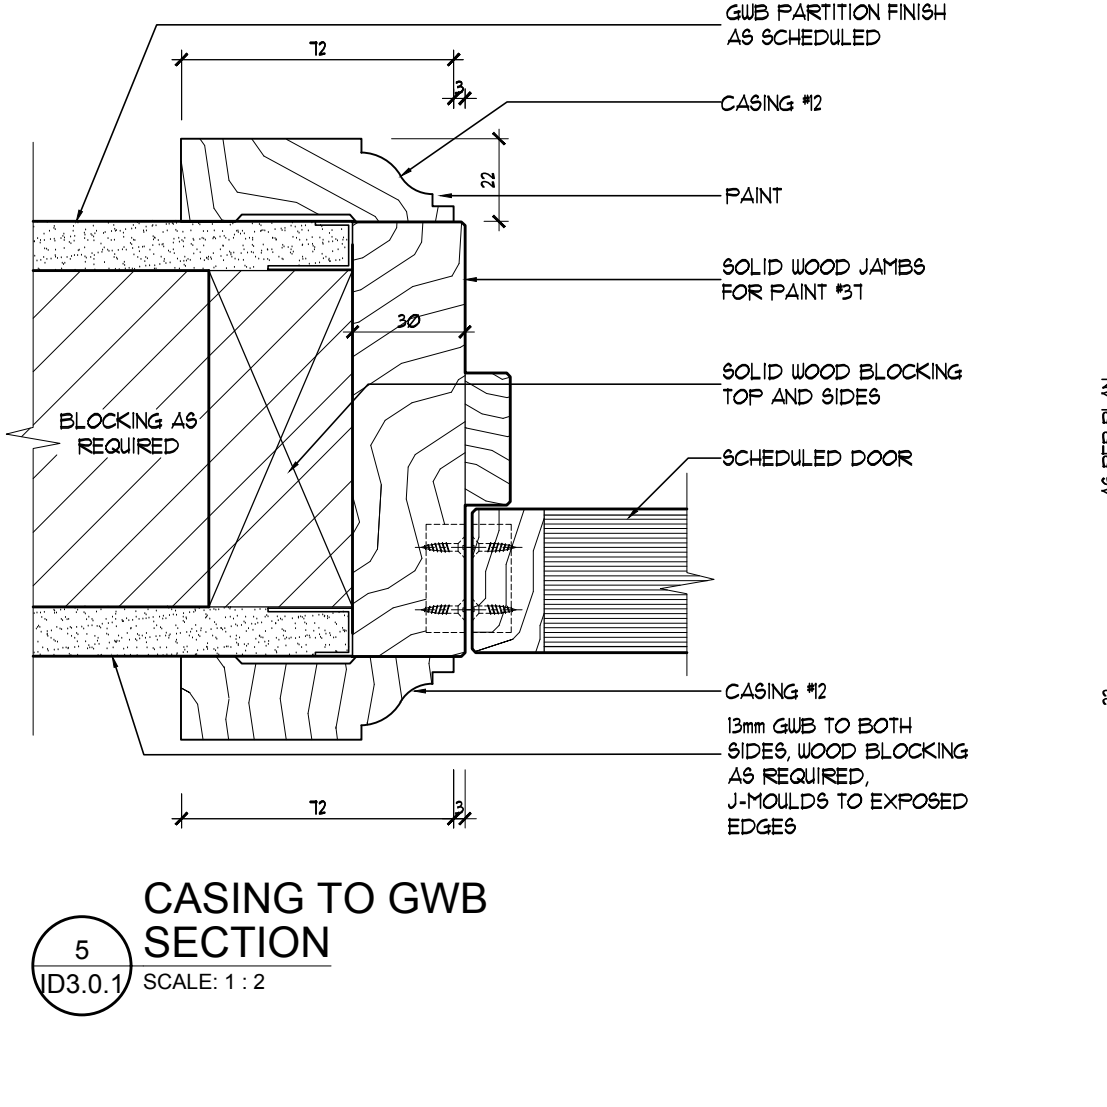


5 (D3.0.1) CASING TO GWB SECTION SCALE: 1:2

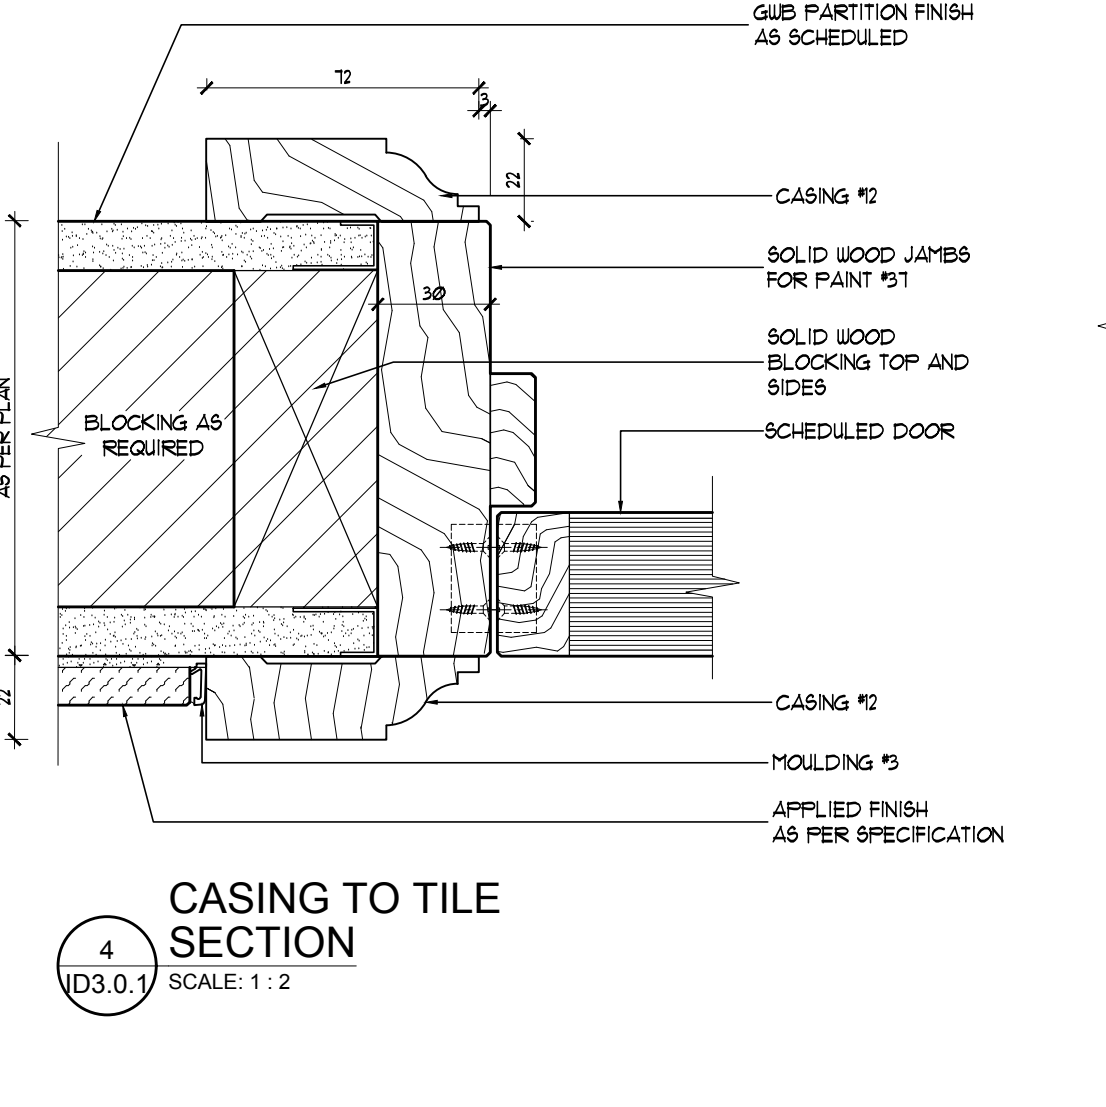


4 (D3.0.1) CASING TO TILE SECTION SCALE: 1:2

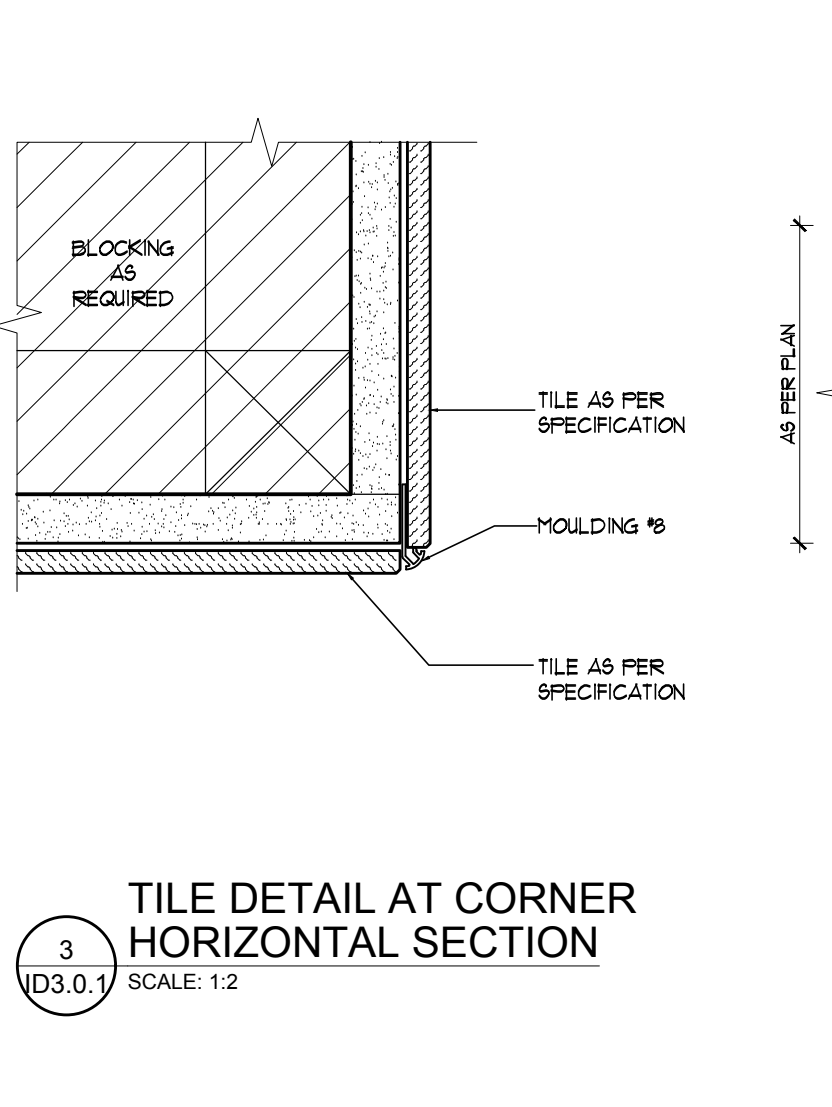


3 (D3.0.1) TILE DETAIL AT CORNER HORIZONTAL SECTION SCALE: 1:2

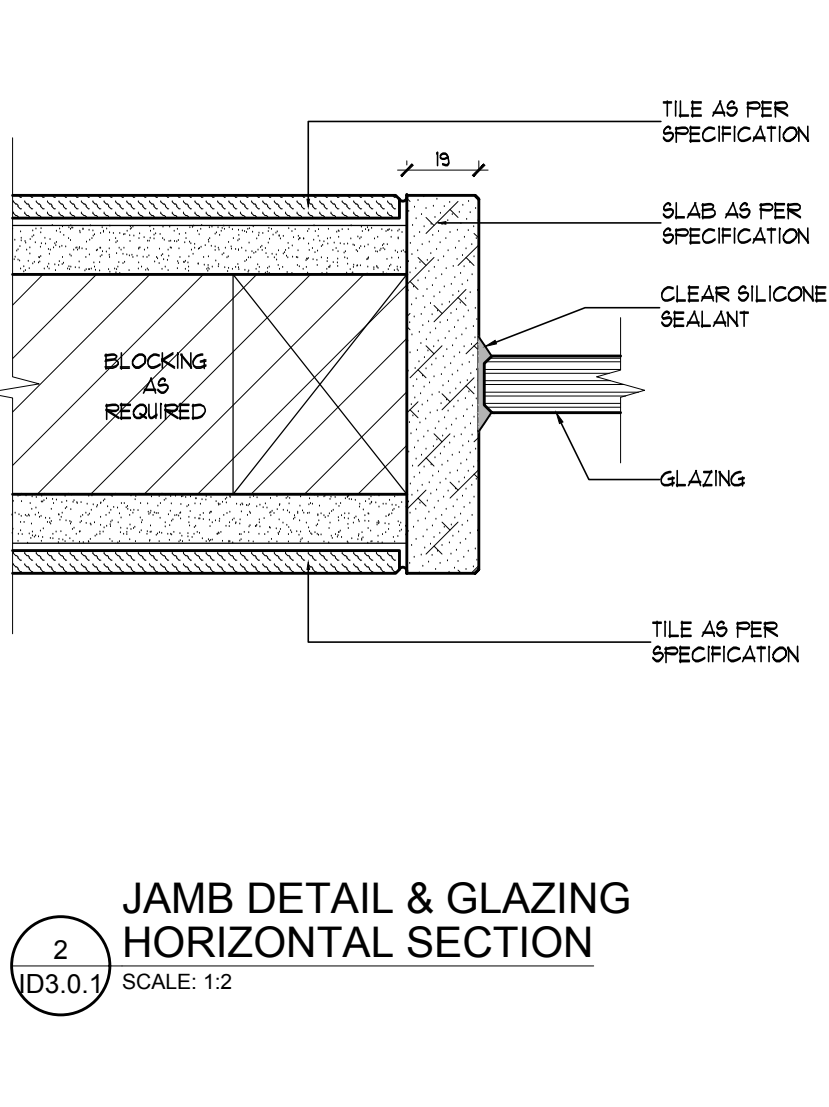

2 (D3.0.1) JAMB DETAIL & GLAZING HORIZONTAL SECTION SCALE: 1:2

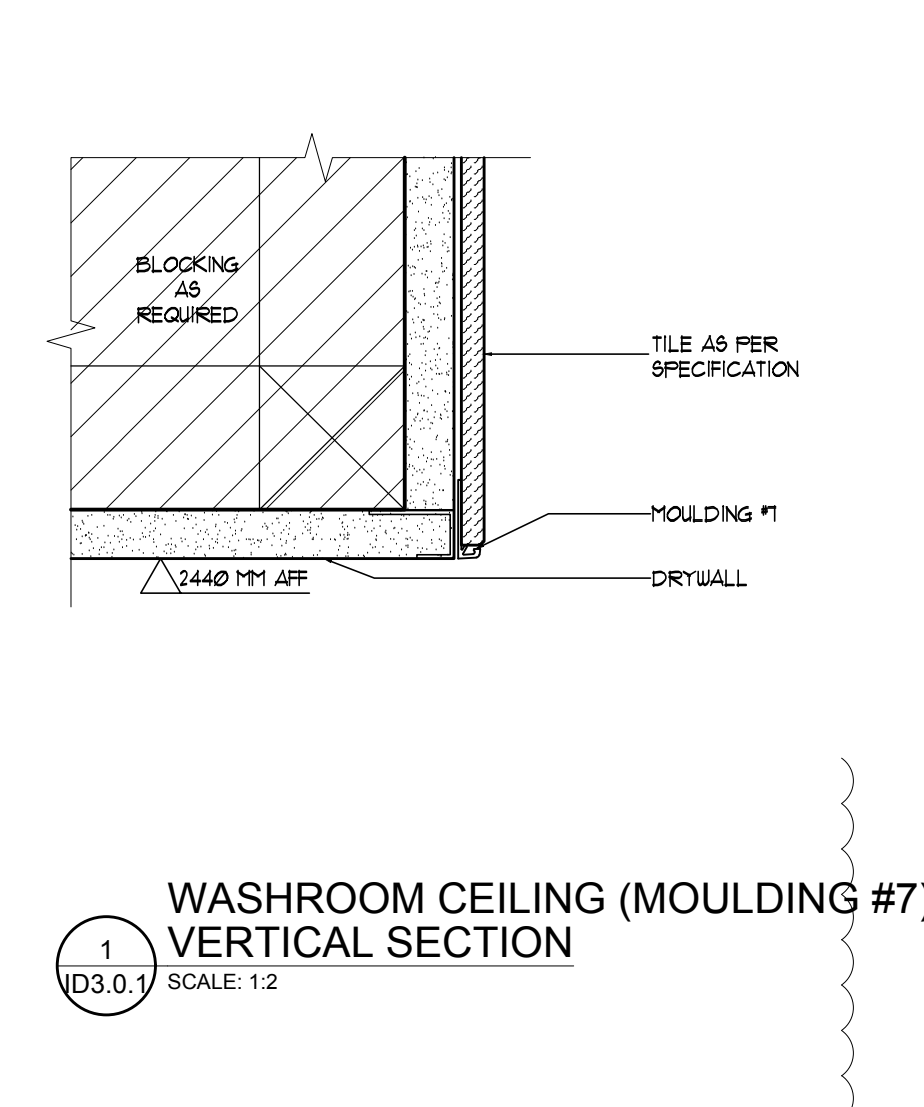

1 (D3.0.1) WASHROOM CEILING (MOULDING #7) VERTICAL SECTION SCALE: 1:2

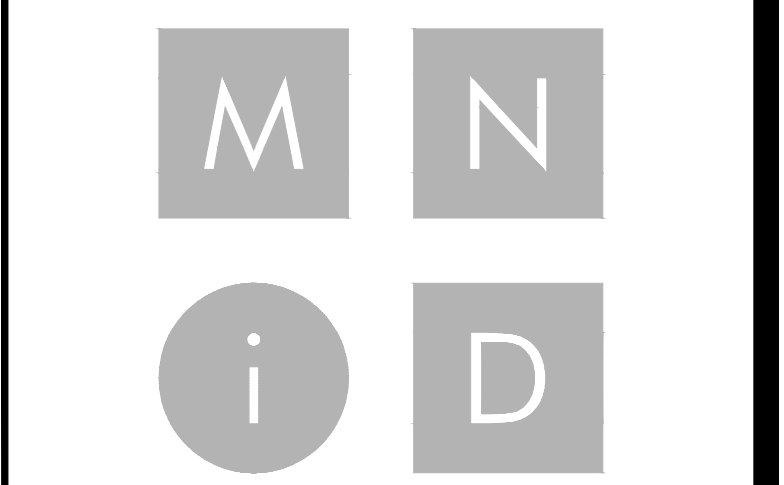


MIKE NIVEN INTERIOR DESIGN INC.
100 BROADVIEW AVE. S. 3RD FLOOR, TORONTO, CANADA M4M 3B3
TEL: 416.783.7404 • FAX: 416.783.7404

ISSUED FOR
PLUMBING &
APPLIANCES

No.	Date	Revision	By	CHK
1	18/04/2019	ADJUSTED AS SHOWN	RG	MM
2	15/05/2019	ADJUSTED AS SHOWN	RG	MM
3	24/05/2019	ADJUSTED AS SHOWN	RG	MM
4	11/06/2019	ADJUSTED AS SHOWN	RG	MM
5	07/10/2019	CHANGE NOTICE #6	WV	MM
6	11/20/2019	CHANGE NOTICE #9	RS	MM
7	03/20/2020	CHANGE NOTICE #10	NVRS	MM


No.	Date	Issue	By	CHK
4	11/20/2019	ISSUED FOR PRICING FOR TRIM AND MILLWORK	RS	MM
3	10/22/2019	ISSUED FOR PRICING FOR SLABS AND TILES ONLY	HD	MM
2	15/05/2019	ISSUED FOR PLUMBING & APPLIANCES	RG	MM
1	18/04/2019	ISSUED FOR COORDINATION	RG	MM

NOTE: **DONOT SCALE DRAWINGS**
It is the contractor's responsibility to verify all specifications and dimensions and report any discrepancies to the designer prior to construction. Materials may not be substituted without designer's written approval.

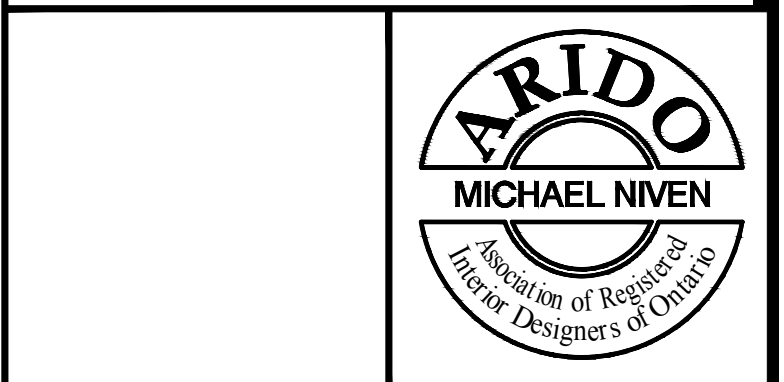

PROJECT:
PINEVALLEY
KNIGHTSWOOD, LOT 93
GOLDPARK HOMES
CONCORD, ON

DESIGNER: MIKE NIVEN	ID 3.0.1
DRAWN BY: M-Tec Inc.	
DATE: FEB 2019	
SCALE: AS MENTIONED	
PROJECT NO: 2018-10	

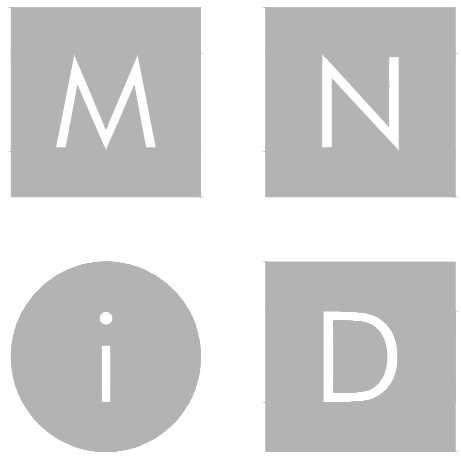

MIKE NIVEN INTERIOR DESIGN INC.
100 BROADVIEW AVE. S. 302 TORONTO, CANADA M4M 3B3
TEL: 416.793.7404 • FAX: 416.793.7404

ISSUED FOR
PLUMBING &
APPLIANCES

No.	Date	Revision	D'wn	Ch'd
1	18042019	ADJUSTED AS SHOWN	RS	MN
2	19052019	ADJUSTED AS SHOWN	RS	MN
3	24052019	ADJUSTED AS SHOWN	RS	MN
4	11062019	ADJUSTED AS SHOWN	RS	MN
5	022020	CHANGE NOTICE #10	NVRS	MN

4	11022019	ISSUED FOR FINISH FOR TRIM AND ML WORK	RS	MN
3	10222019	ISSUED FOR FINISH FOR SLABS AND TILES ONLY	HD	MN
2	15052019	ISSUED FOR PLUMBING & APPLIANCES	RS	MN
1	18042019	ISSUED FOR COORDINATION	RS	MN

No.	Date	Issue	D'wn	Ch'd
-----	------	-------	------	------

NOTE: DO NOT SCALE DRAWINGS
It is the contractor's responsibility to verify all specifications and dimensions and report any discrepancies to the designer prior to construction. Materials may not be substituted without designer's written approval.



PROJECT:
PINEVALLEY
KNIGHTSWOOD, LOT 93


GOLDPARK HOMES
CONCORD, ON




DRAWING:

DETAILS


DESIGNER: MIKE NIVEN	ID 3.0.2
DRAWN BY: M+Tec Inc.	
DATE: FEB 2019	
SCALE: AS MENTIONED	
PROJECT NO: 2018-10	

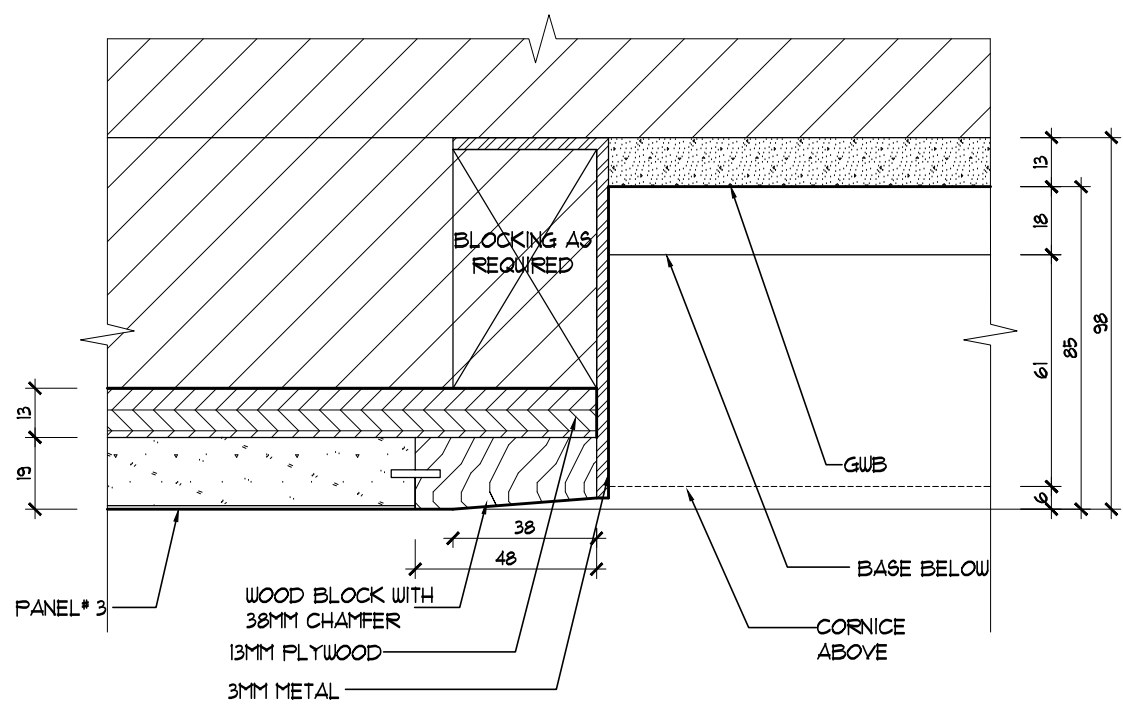


4
ID3.0.2
SLAB TO GWB (MASTER BEDROOM)
SECTION
SCALE: 1:2

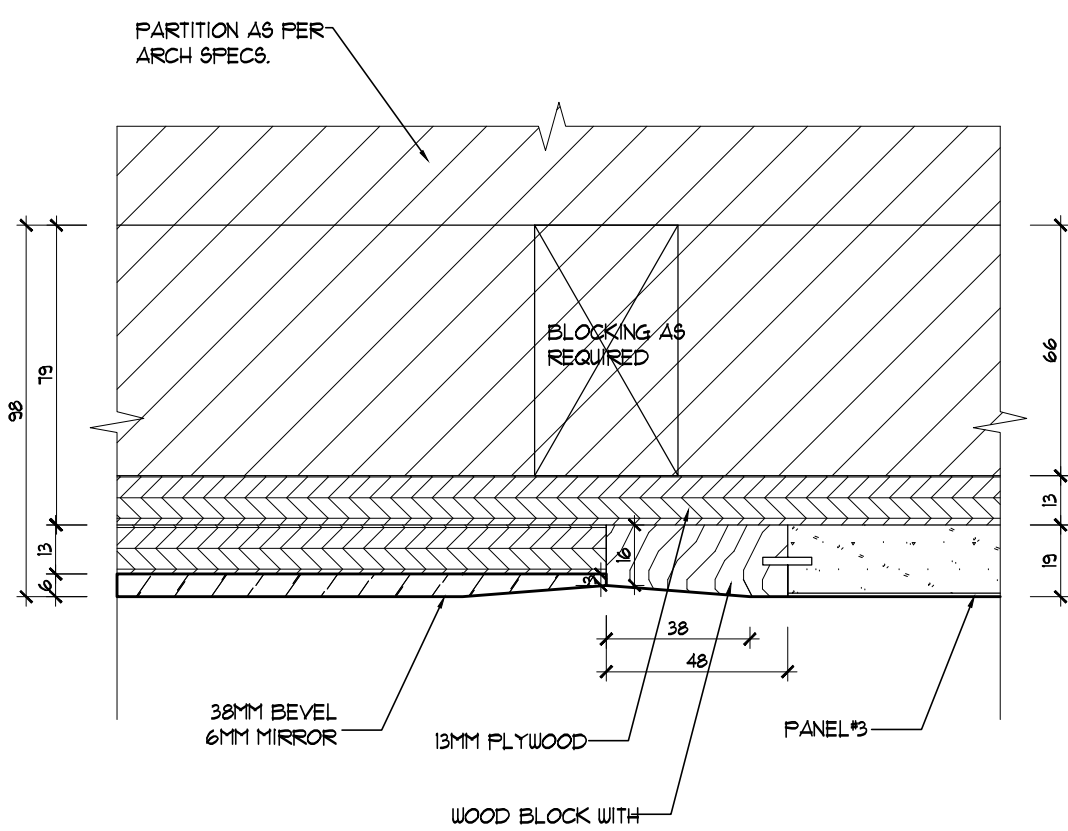

3
ID3.0.2
MIRROR TO SLAB DETAIL (MASTER BEDROOM)
SECTION
SCALE: 1:2

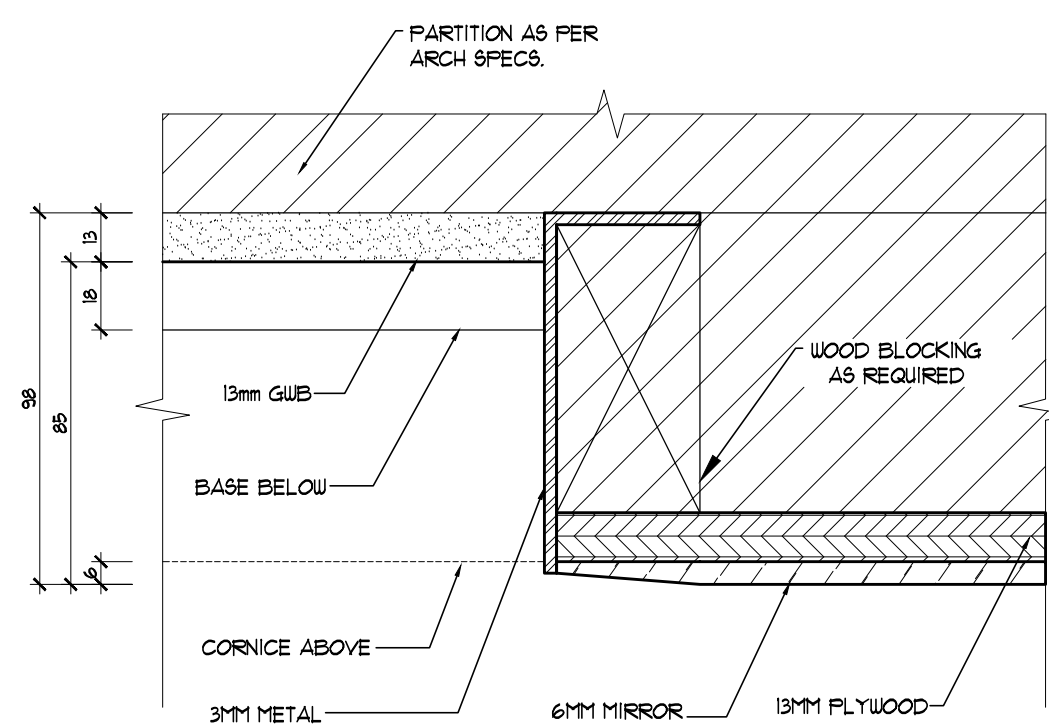

2
ID3.0.2
MIRROR TO GWB DETAIL (MASTER BEDROOM)
SECTION
SCALE: 1:2

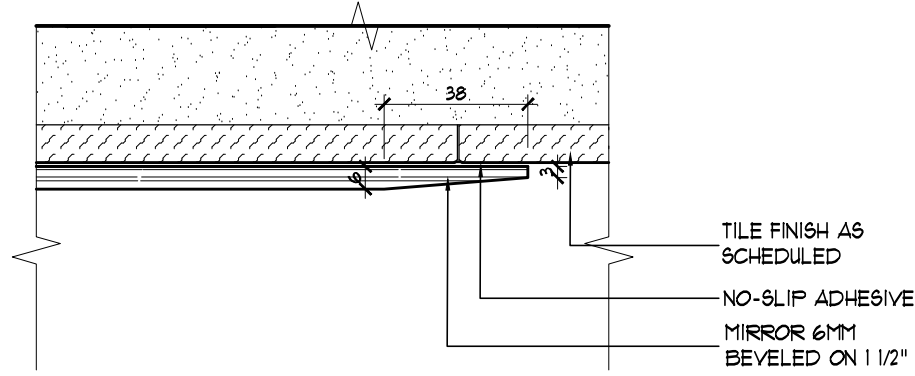

1
ID3.0.2
MIRROR BEVEL DETAIL
HORIZONTAL SECTION
SCALE: 1:2