


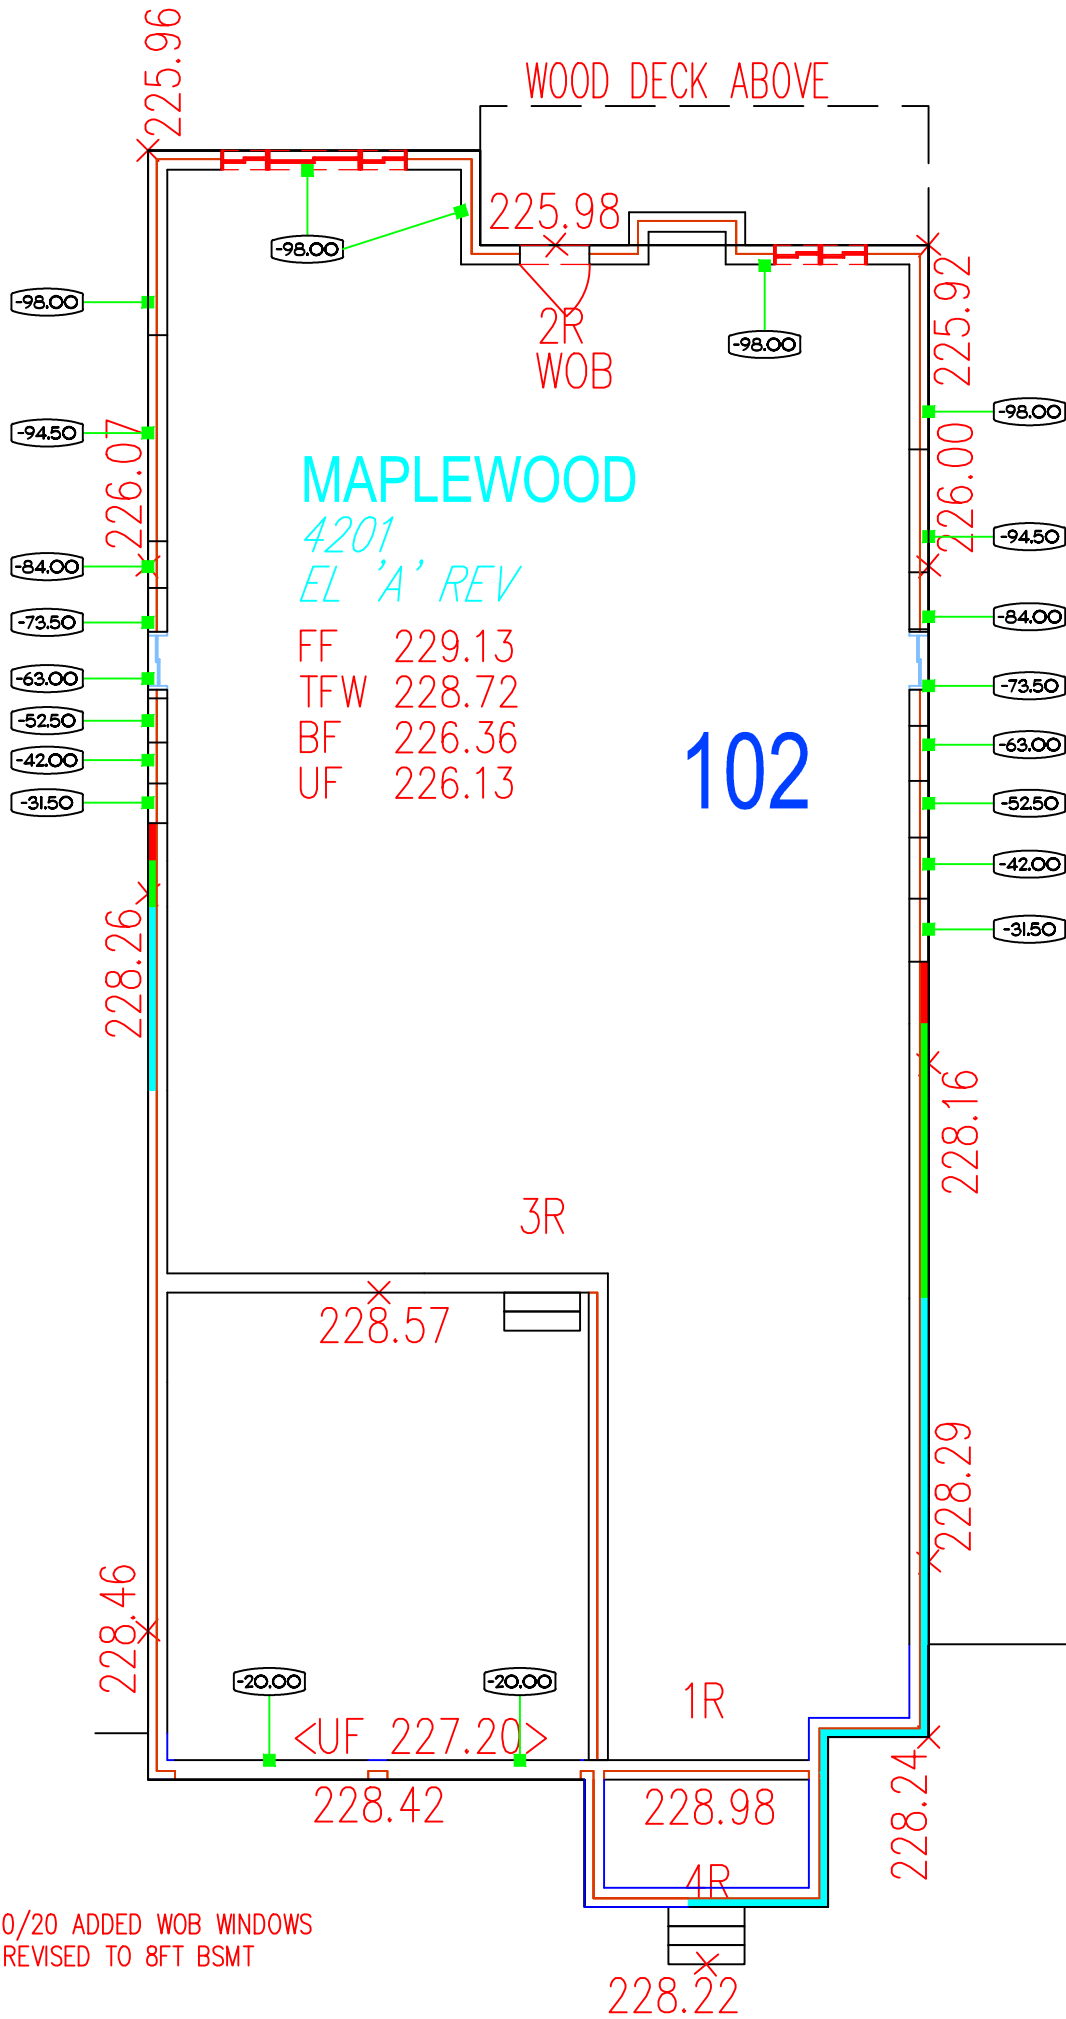

REV #1 - 03/20/20 ADDED WOB WINDOWS
AND REVISED TO 8FT BSMT

PLAN

Legend			
1 Brck (5")		Standard Wall	
2 Brcks (8.5")		Garage Wall	
3 Brcks (12")		1 Riser reverse	
4 Brcks (15.5")		2 Riser reverse	
5 Brcks (19")		3 Riser reverse	
6 Brcks (22.5")		4 Riser reverse	
7 Brcks (26")		Cut Pour	
8 Brcks (29.5")			

Site Name : Pine Valley		Job No.
Location : Vaughan, Ontario		
Date: 03/20/2020	Lot # 102	
By : jamesp	Scale : n.t.s.	

PHASE:

Total Stone Area Sq. Ft. + 5% Waste = 13 SQFT

Total Bricks + 4% Waste 3108